


FED. ROAD DIST. NO.	STATE	FEDERAL AID PROJ. NO.	FISCAL YEAR	SHEET NO.	TOTAL SHEETS
HAWAII	HAW.	BR-019-2(61)	2013	C.O. 11	117

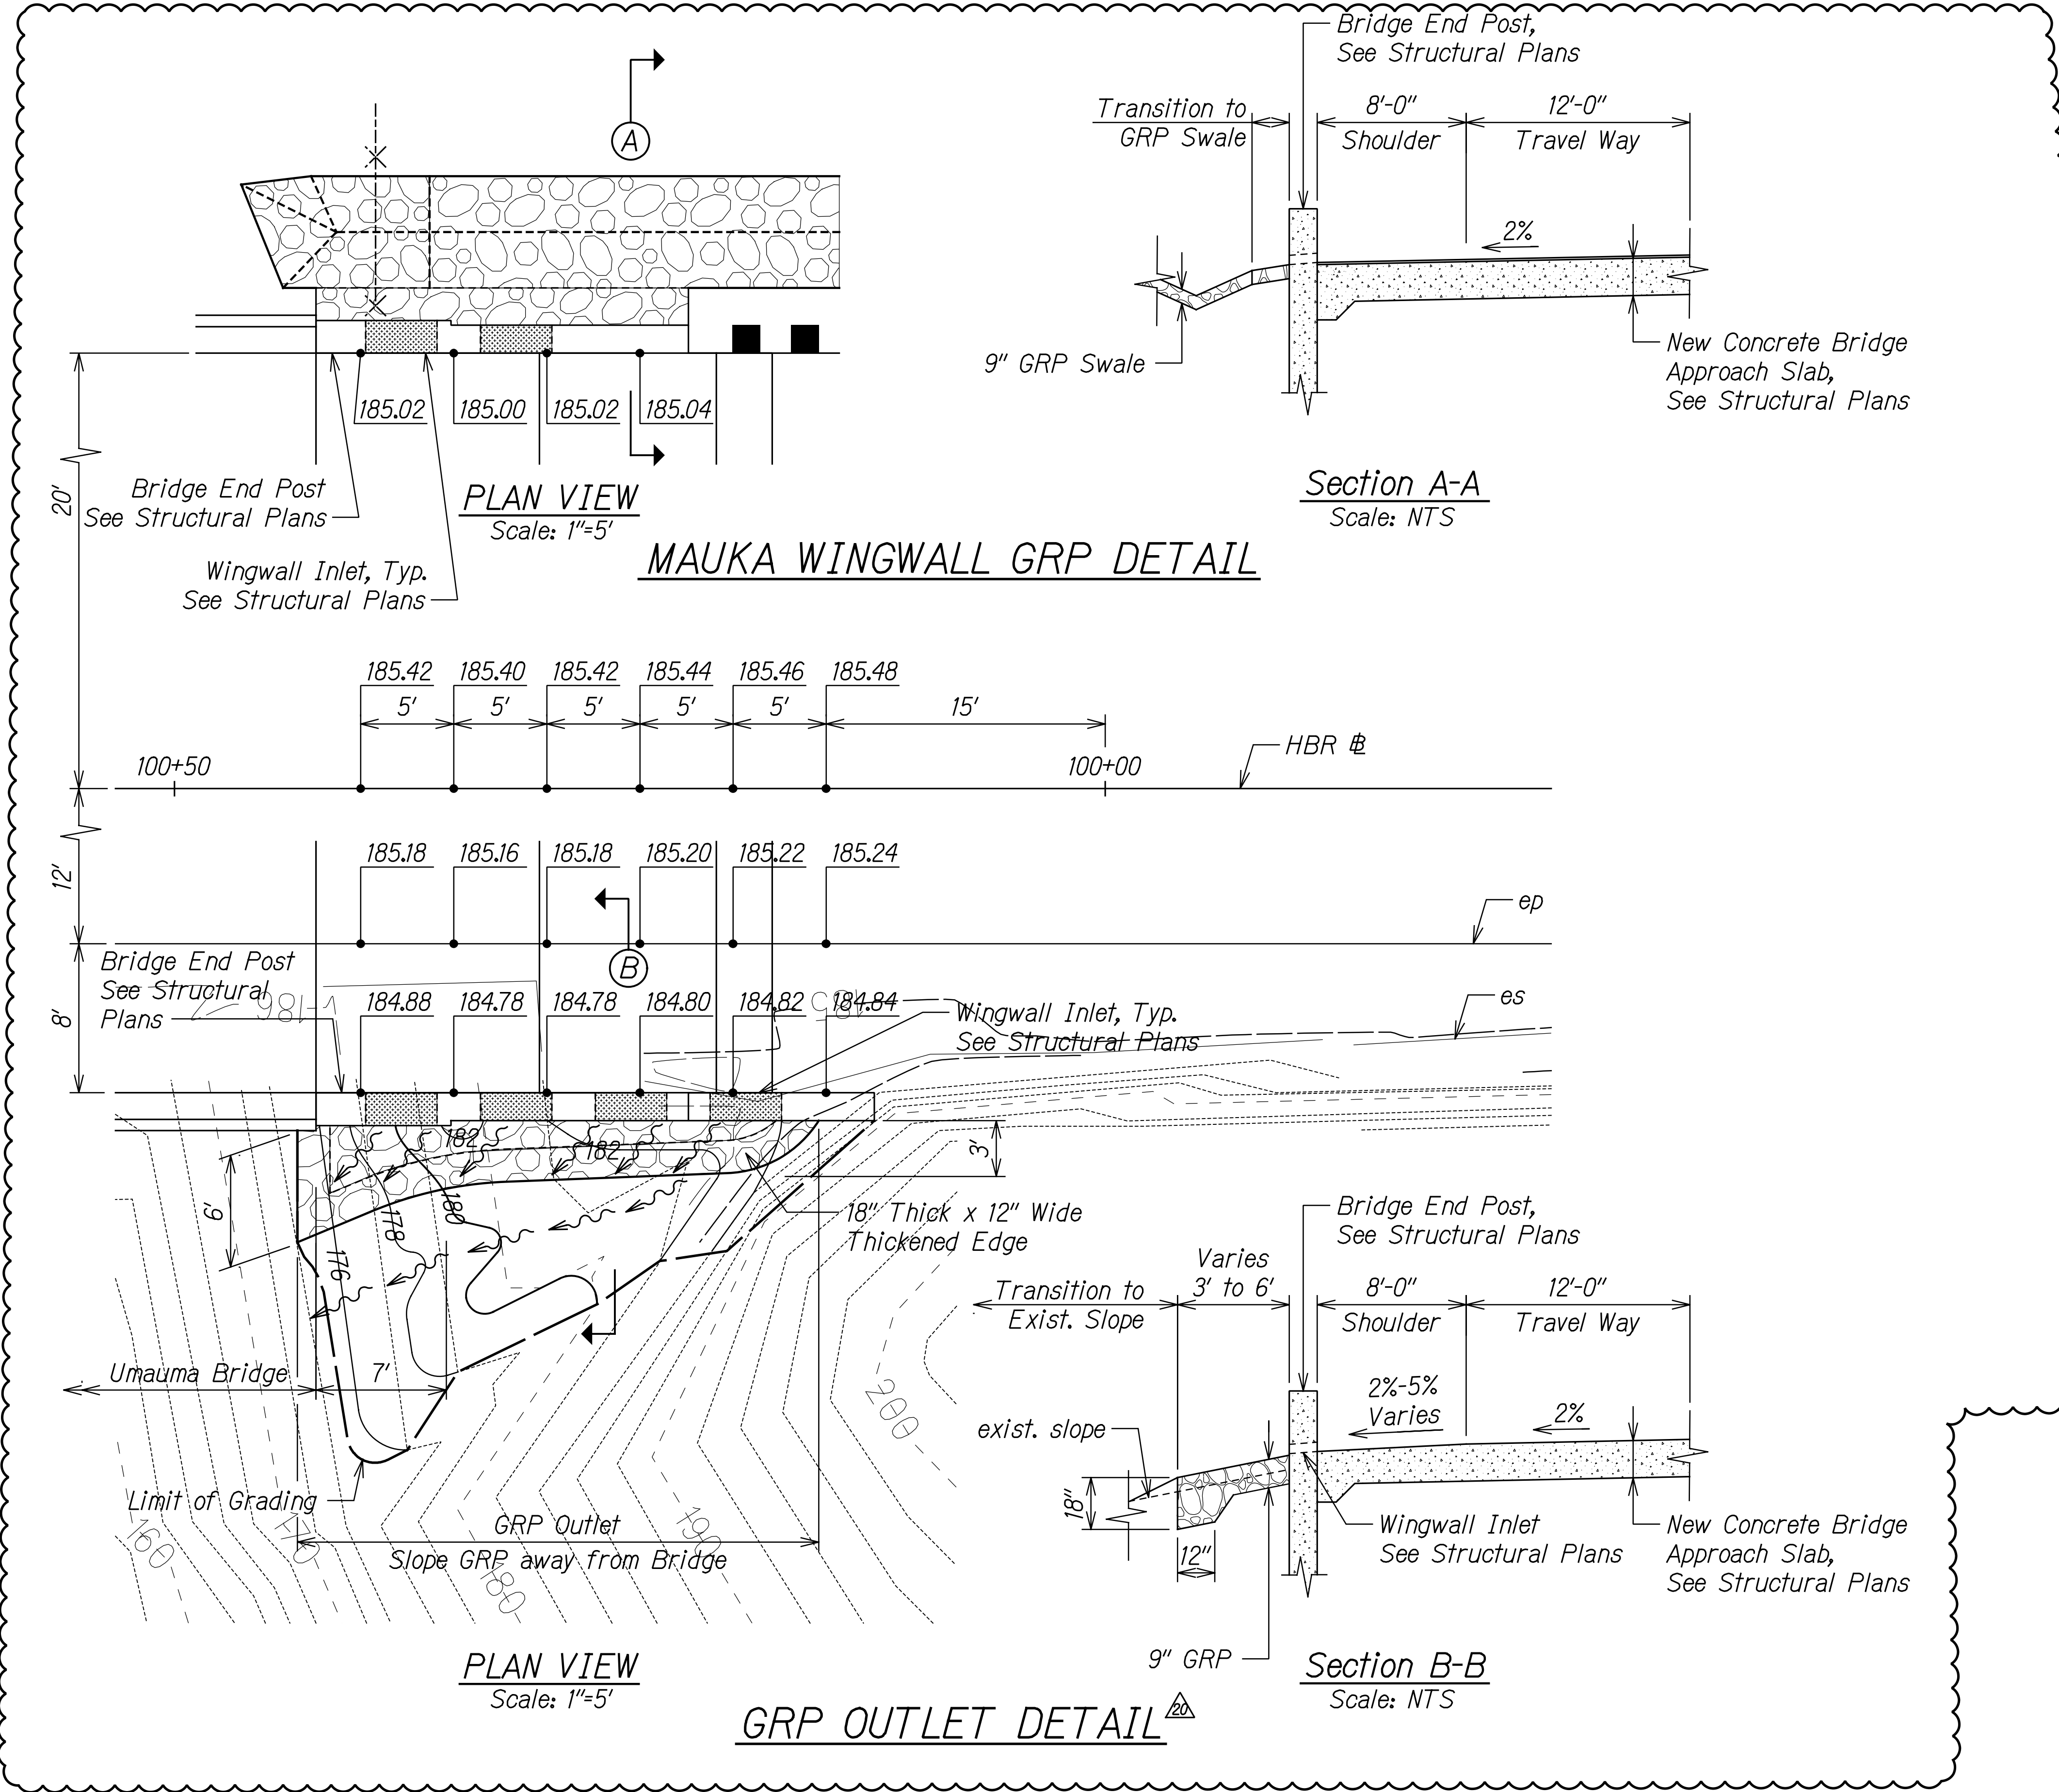

DATE	_____
SURVEY PLOTTED BY	_____
DRAWN BY	_____
DESIGNED BY	_____
NOTE BOOK	_____
QUANTITIES BY	_____
CHECKED BY	_____

CCO#2

1/23/17

Revised GRP & Grades

9/15/14

Deleted Inertial Barrier System Detail & Edited Abutment Inlet Detail

Date	Revision
------	----------

STATE OF HAWAII

DEPARTMENT OF TRANSPORTATION

HIGHWAYS DIVISION

ROADWAY DETAIL

HAWAII BELT ROAD

Rehabilitation of Umauma Stream Bridge

FAP NO. BR-019-2(61)

THIS WORK WAS PREPARED BY ME OR UNDER MY SUPERVISION.

04/30/16

EXPIRATION DATE OF THE LICENSE

CCO#2

CCO#2

Scale: As Shown

Date: July 15, 2014

SHEET No. R-5 OF 10 SHEETS

C.O.11