



FED. ROAD DIST. NO.	STATE	FEDERAL AID PROJ. NO.	FISCAL YEAR	SHEET NO.	TOTAL SHEETS
HAWAII	HAW.	BR-019-2(61)	2013	C.O. 23	117

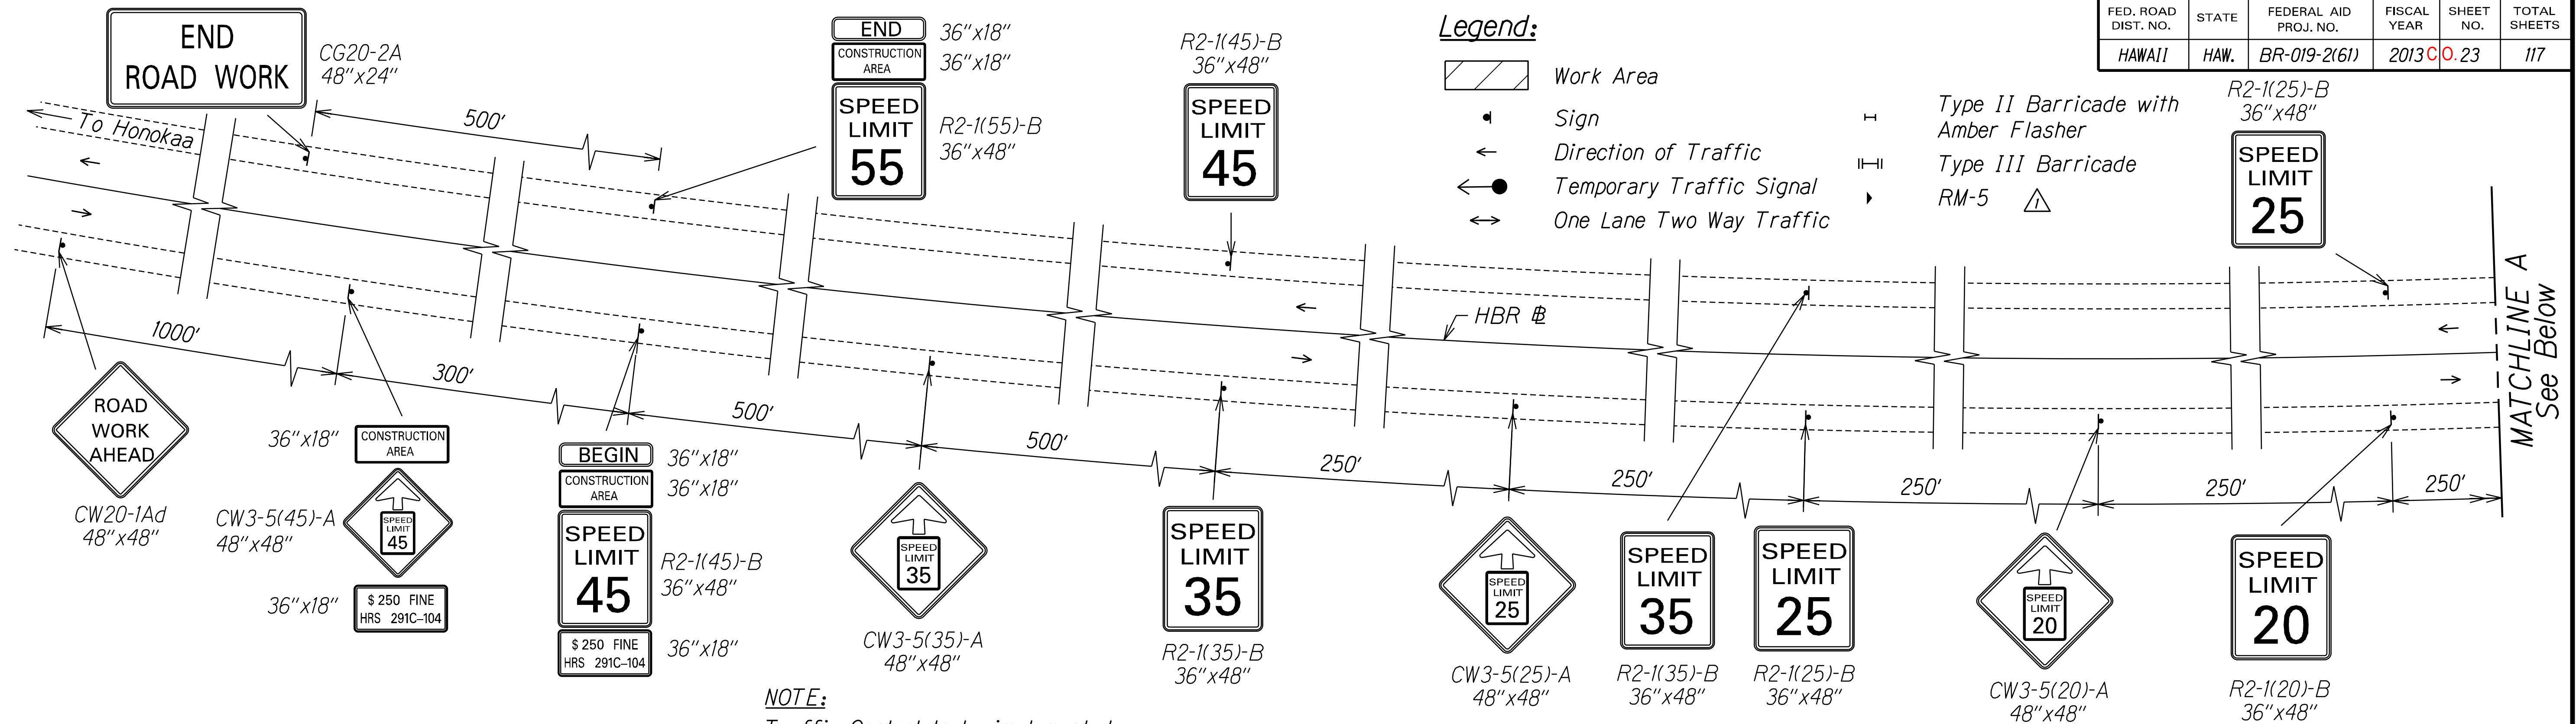

NOTE:
Traffic Control to be implemented during work hours: 7:00 am to 5:00 pm. Signs and Traffic Signal to be covered at the end of each day.

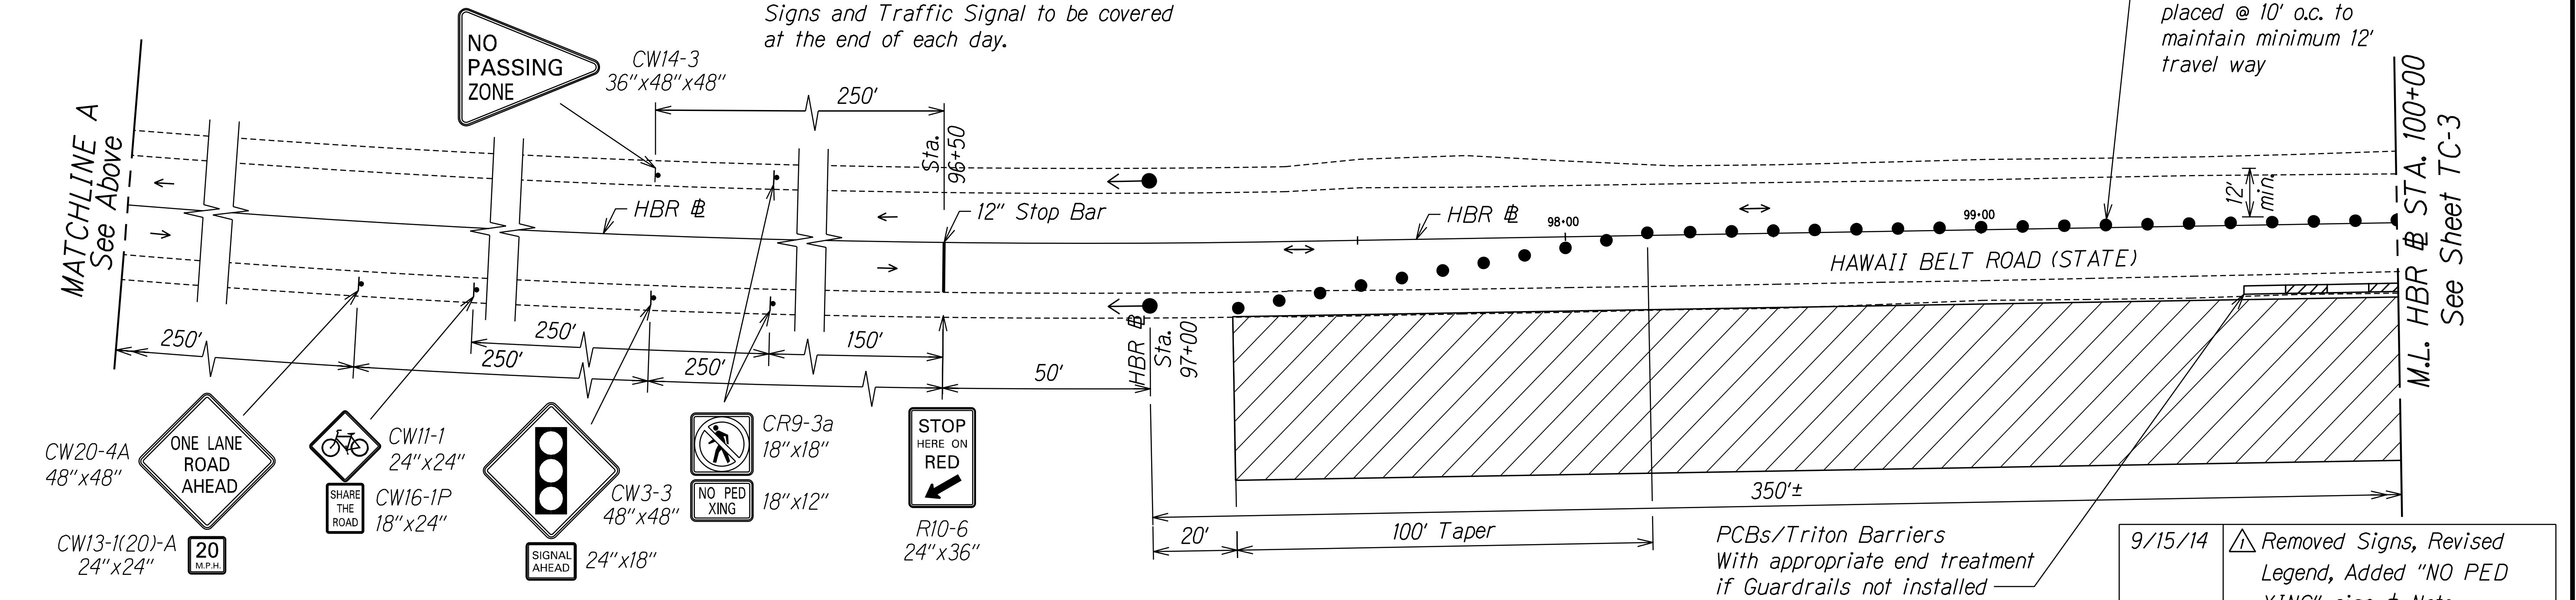

Legend:

- Work Area
- Sign
- Direction of Traffic
- Temporary Traffic Signal
- One Lane Two Way Traffic



NOTES:

Traffic Control for CCO#1 ACROW Bridge shall remain in place until rehabilitation of Umauma Bridge completed. Traffic Control Plans shown here for VECF CCO, Shts 23-25, shall be implemented after Umauma Bridge is rehabilitated, so that the ACROW Bridge can be removed and the mauka hillside restored.

CCO#2

DATE

2/17/17

DESIGNED BY

TRACED BY

NOTED BY

CHECKED BY

ORIGINAL PLAN

DATE

THIS WORK WAS PREPARED BY ME OR UNDER MY SUPERVISION.

RANDALL M. URASAKI

LICENSED PROFESSIONAL ENGINEER

No. 7289-C

HAWAII, U.S.A.

SIGNATURE

04/30/18

EXPIRATION DATE OF THE LICENSE

STATE OF HAWAII

DEPARTMENT OF TRANSPORTATION

HIGHWAYS DIVISION

TRAFFIC CONTROL PLAN - 1

HAWAII BELT ROAD


Rehabilitation of Umauma Stream Bridge

FAP NO. BR-019-2(61)


Scale: 1"=20'

Date: July 15, 2014

FED. ROAD DIST. NO.	STATE	FEDERAL AID PROJ. NO.	FISCAL YEAR	SHEET NO.	TOTAL SHEETS
HAWAII	HAW.	BR-019-2(61)	2013	C.O. 24	117

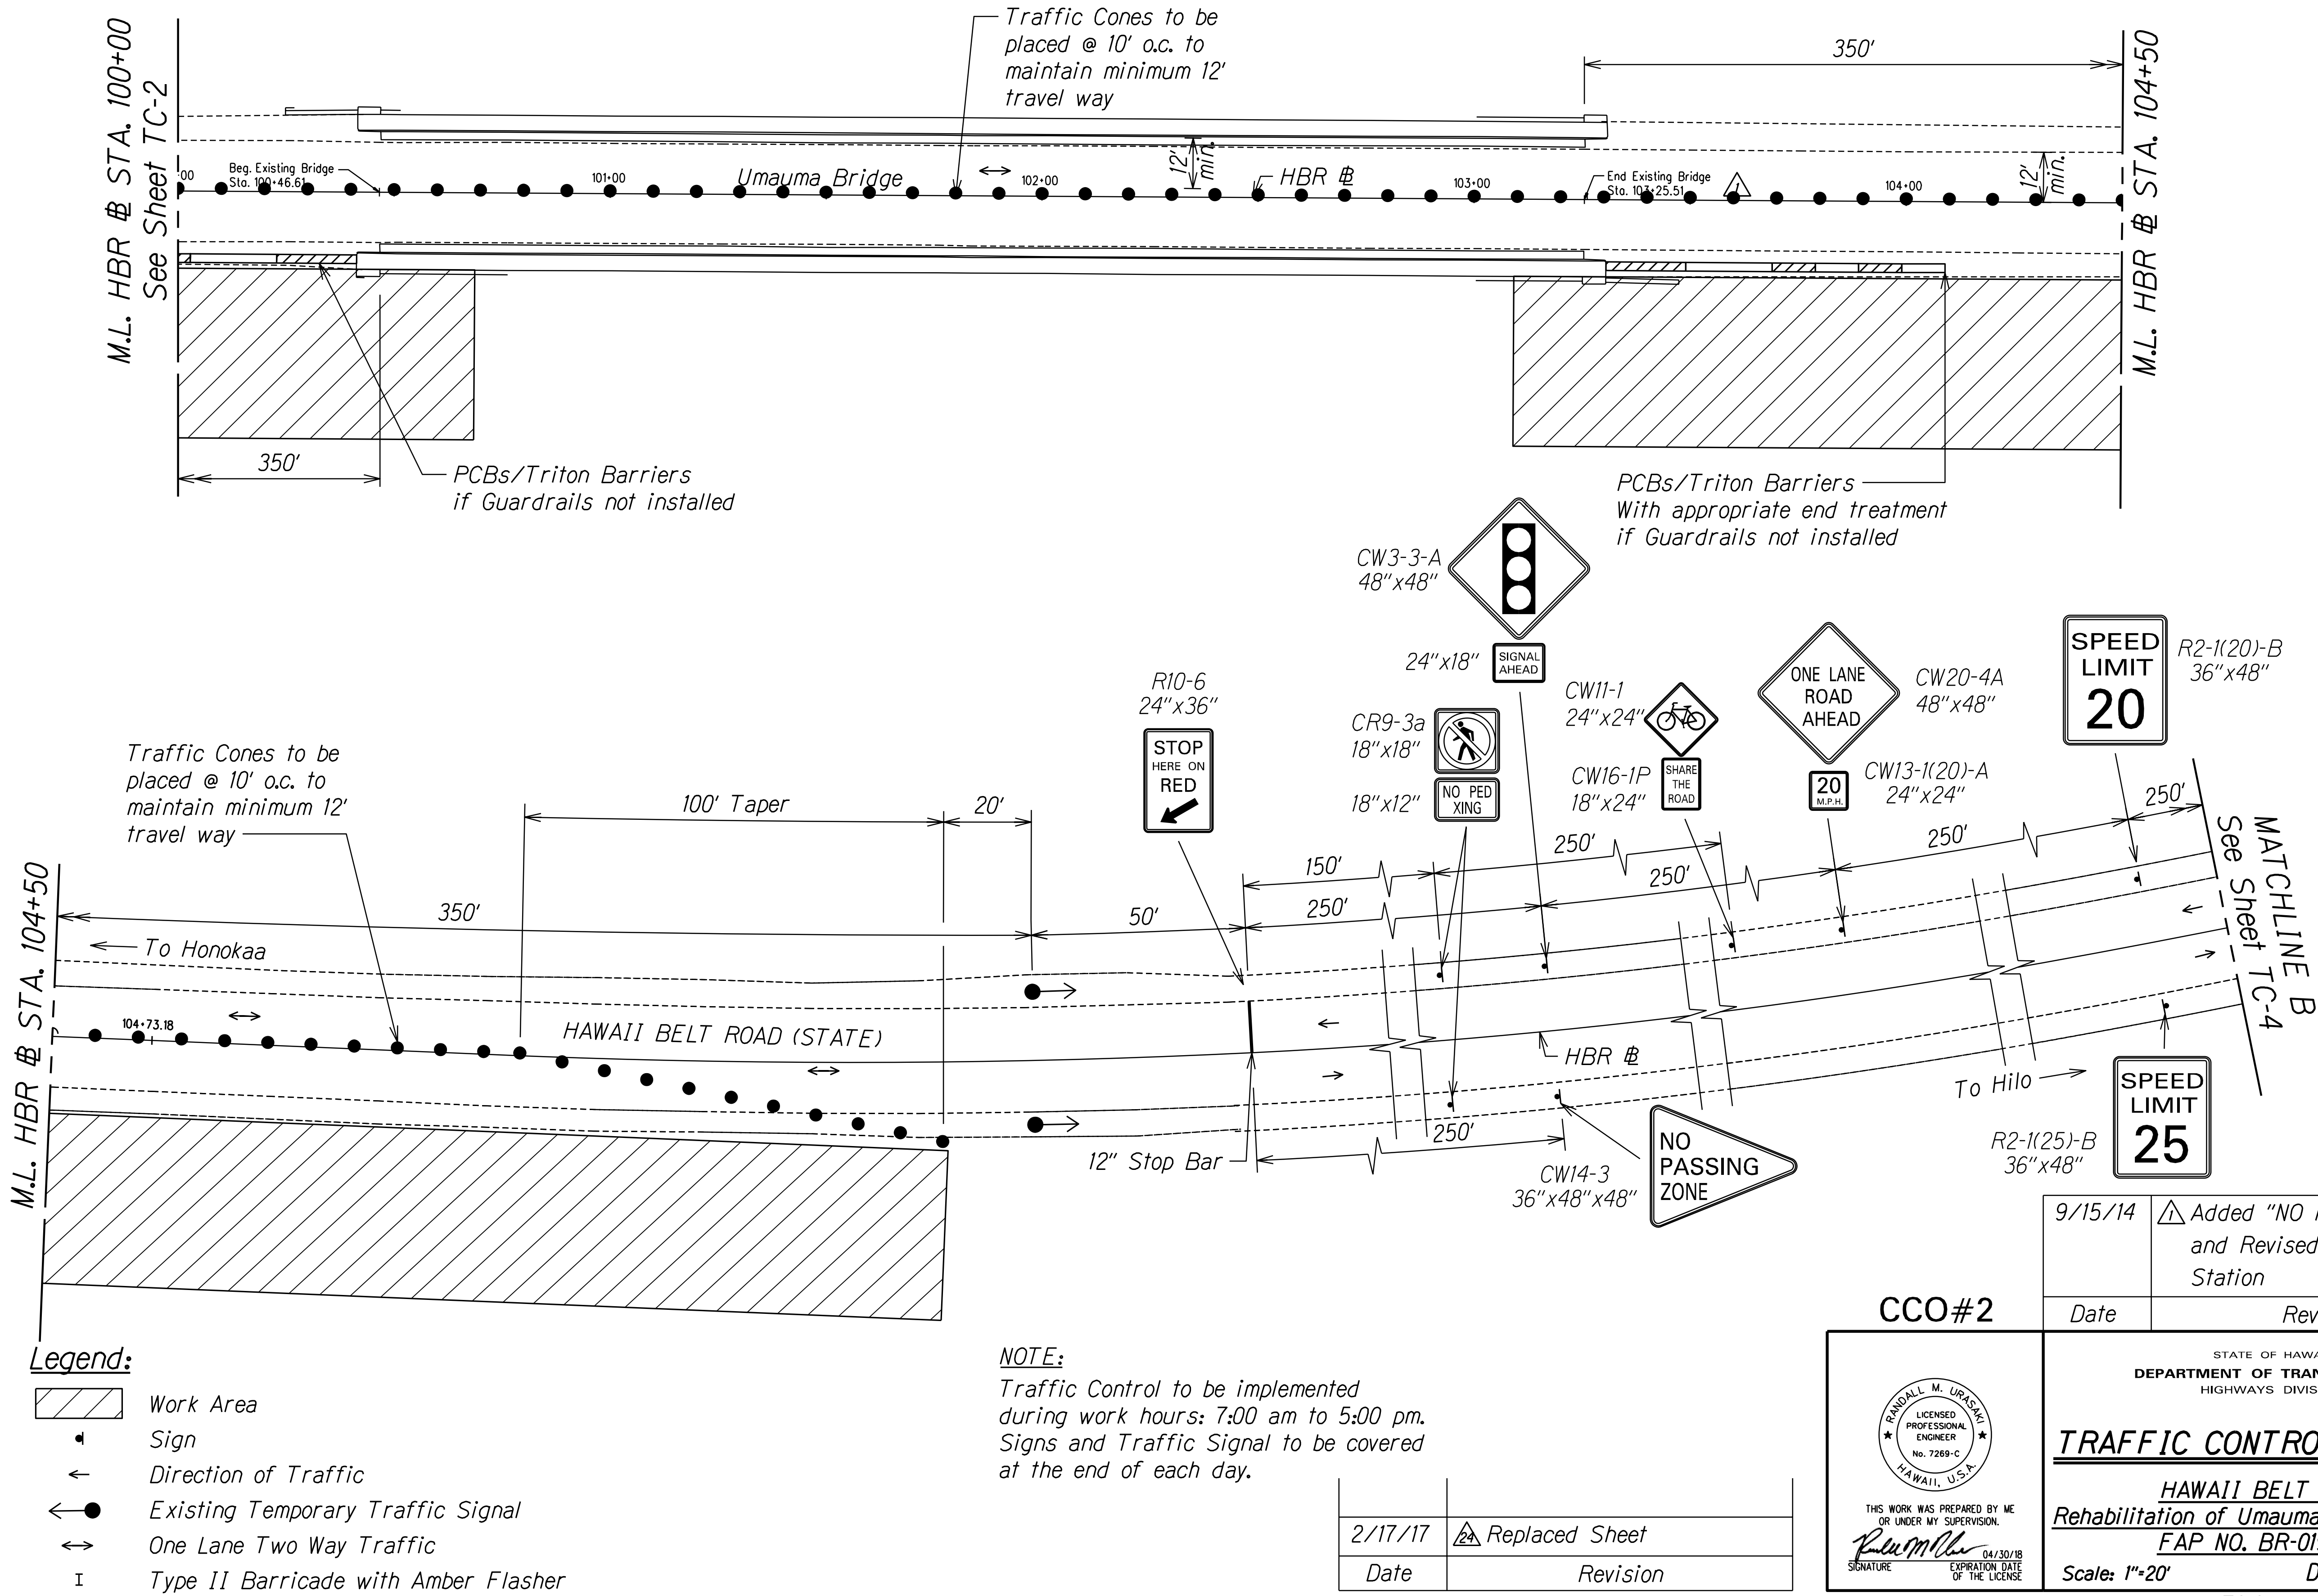

FED. ROAD DIST. NO.	STATE	FEDERAL AID PROJ. NO.	FISCAL YEAR	SHEET NO.	TOTAL SHEETS
HAWAII	HAW.	BR-019-2(61)	2013	C.O.25	117

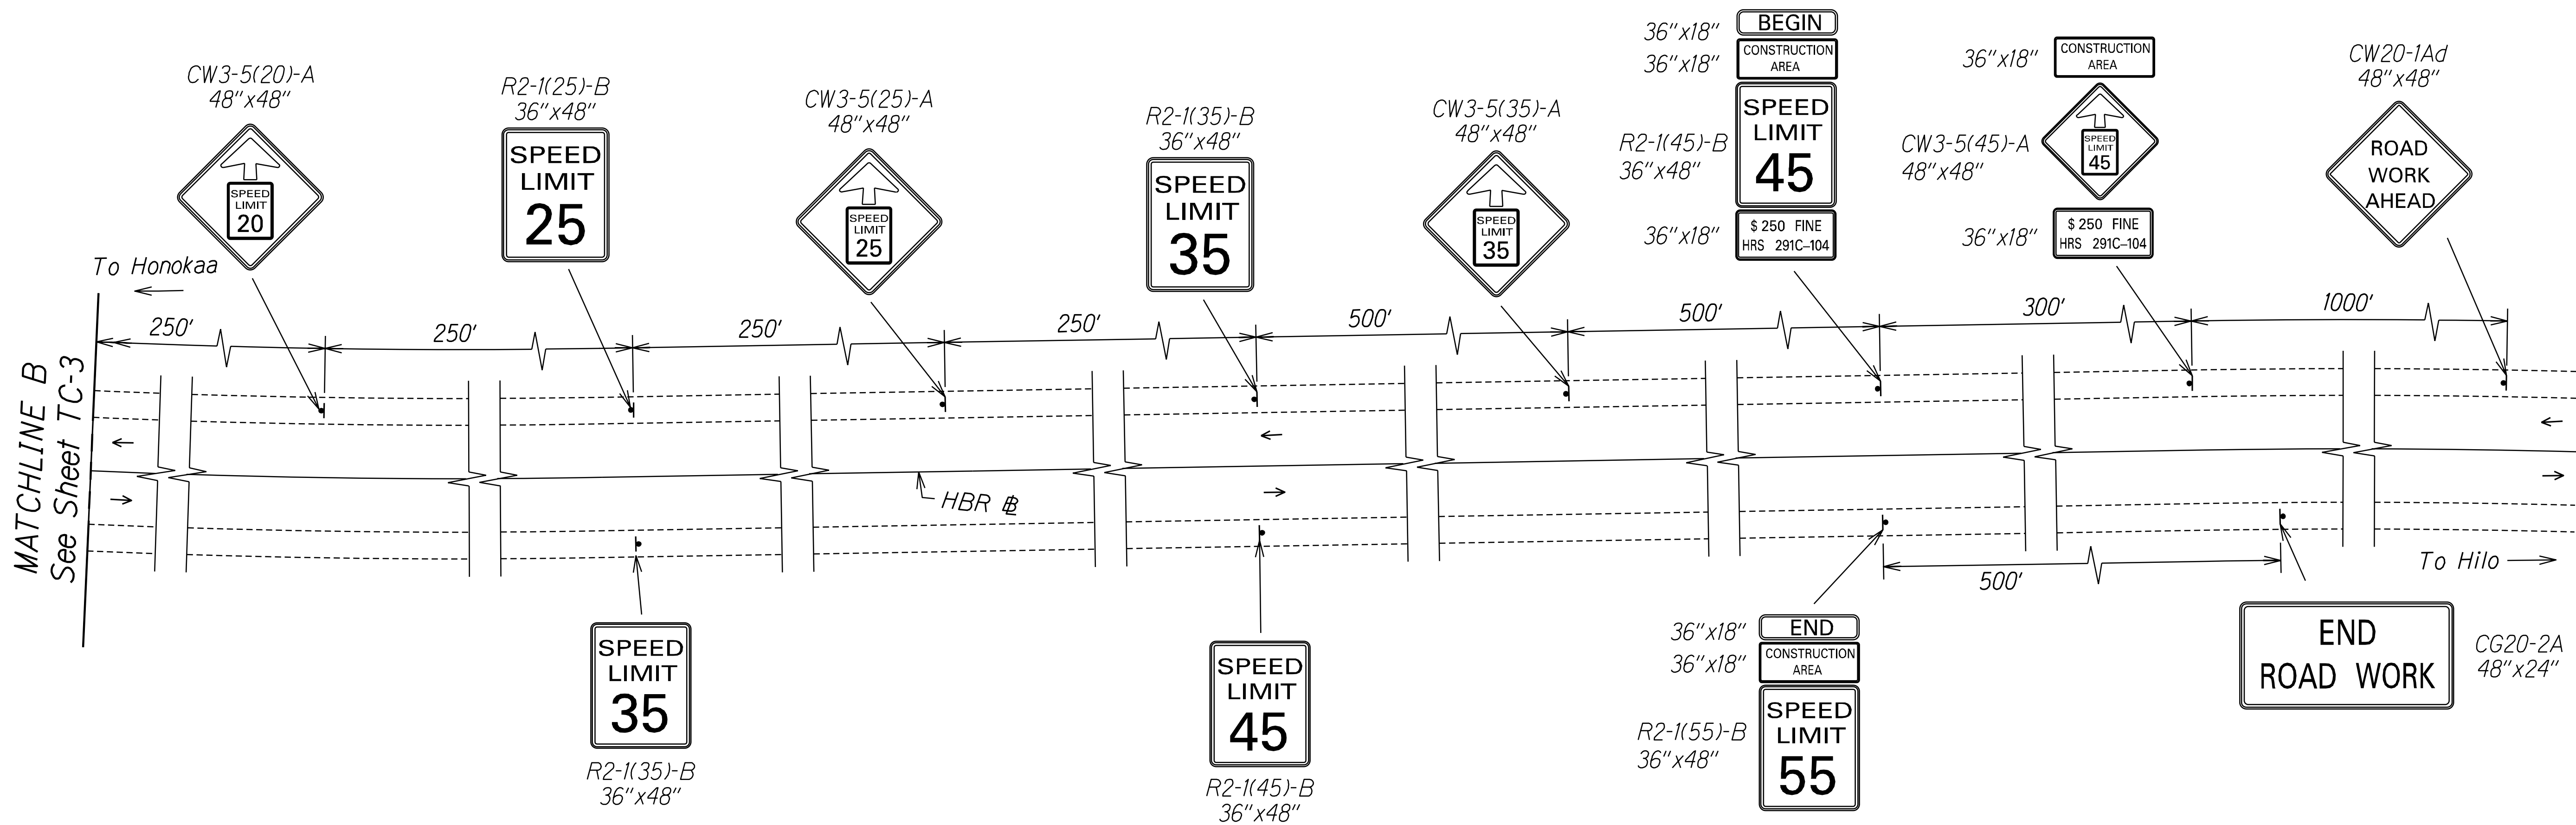

Legend:

- Sign
- Direction of Traffic

SURVEY PLOTTED BY	DATE
DRAWN BY	
DESIGNED BY	
NOTE BOOK	
CHECKED BY	
N.	

CCO#2

2/17/17 Replaced Sheet

9/15/14 Removed Signs #

Revised Legend

Date Revision

STATE OF HAWAII

DEPARTMENT OF TRANSPORTATION

HIGHWAYS DIVISION

TRAFFIC CONTROL PLAN - 3

HAWAII BELT ROAD

Rehabilitation of Umauma Stream Bridge

FAP NO. BR-019-2(61)

Scale: 1"=20' Date: July 15, 2014

SHEET No. TC-4 OF 4 SHEETS

RANDALL M. URASAKI

LICENSED PROFESSIONAL ENGINEER

No. 7289-C

HAWAII, U.S.A.

THIS WORK WAS PREPARED BY ME OR UNDER MY SUPERVISION.

R. M. Urasaki

SIGNATURE

04/30/18

EXPIRATION DATE OF THE LICENSE