




FED. ROAD DIST. NO.	STATE	FEDERAL AID PROJ. NO.	FISCAL YEAR	SHEET NO.	TOTAL SHEETS
HAWAII	HAW.	BR-019-2(61)	2013	C.O. 6	117

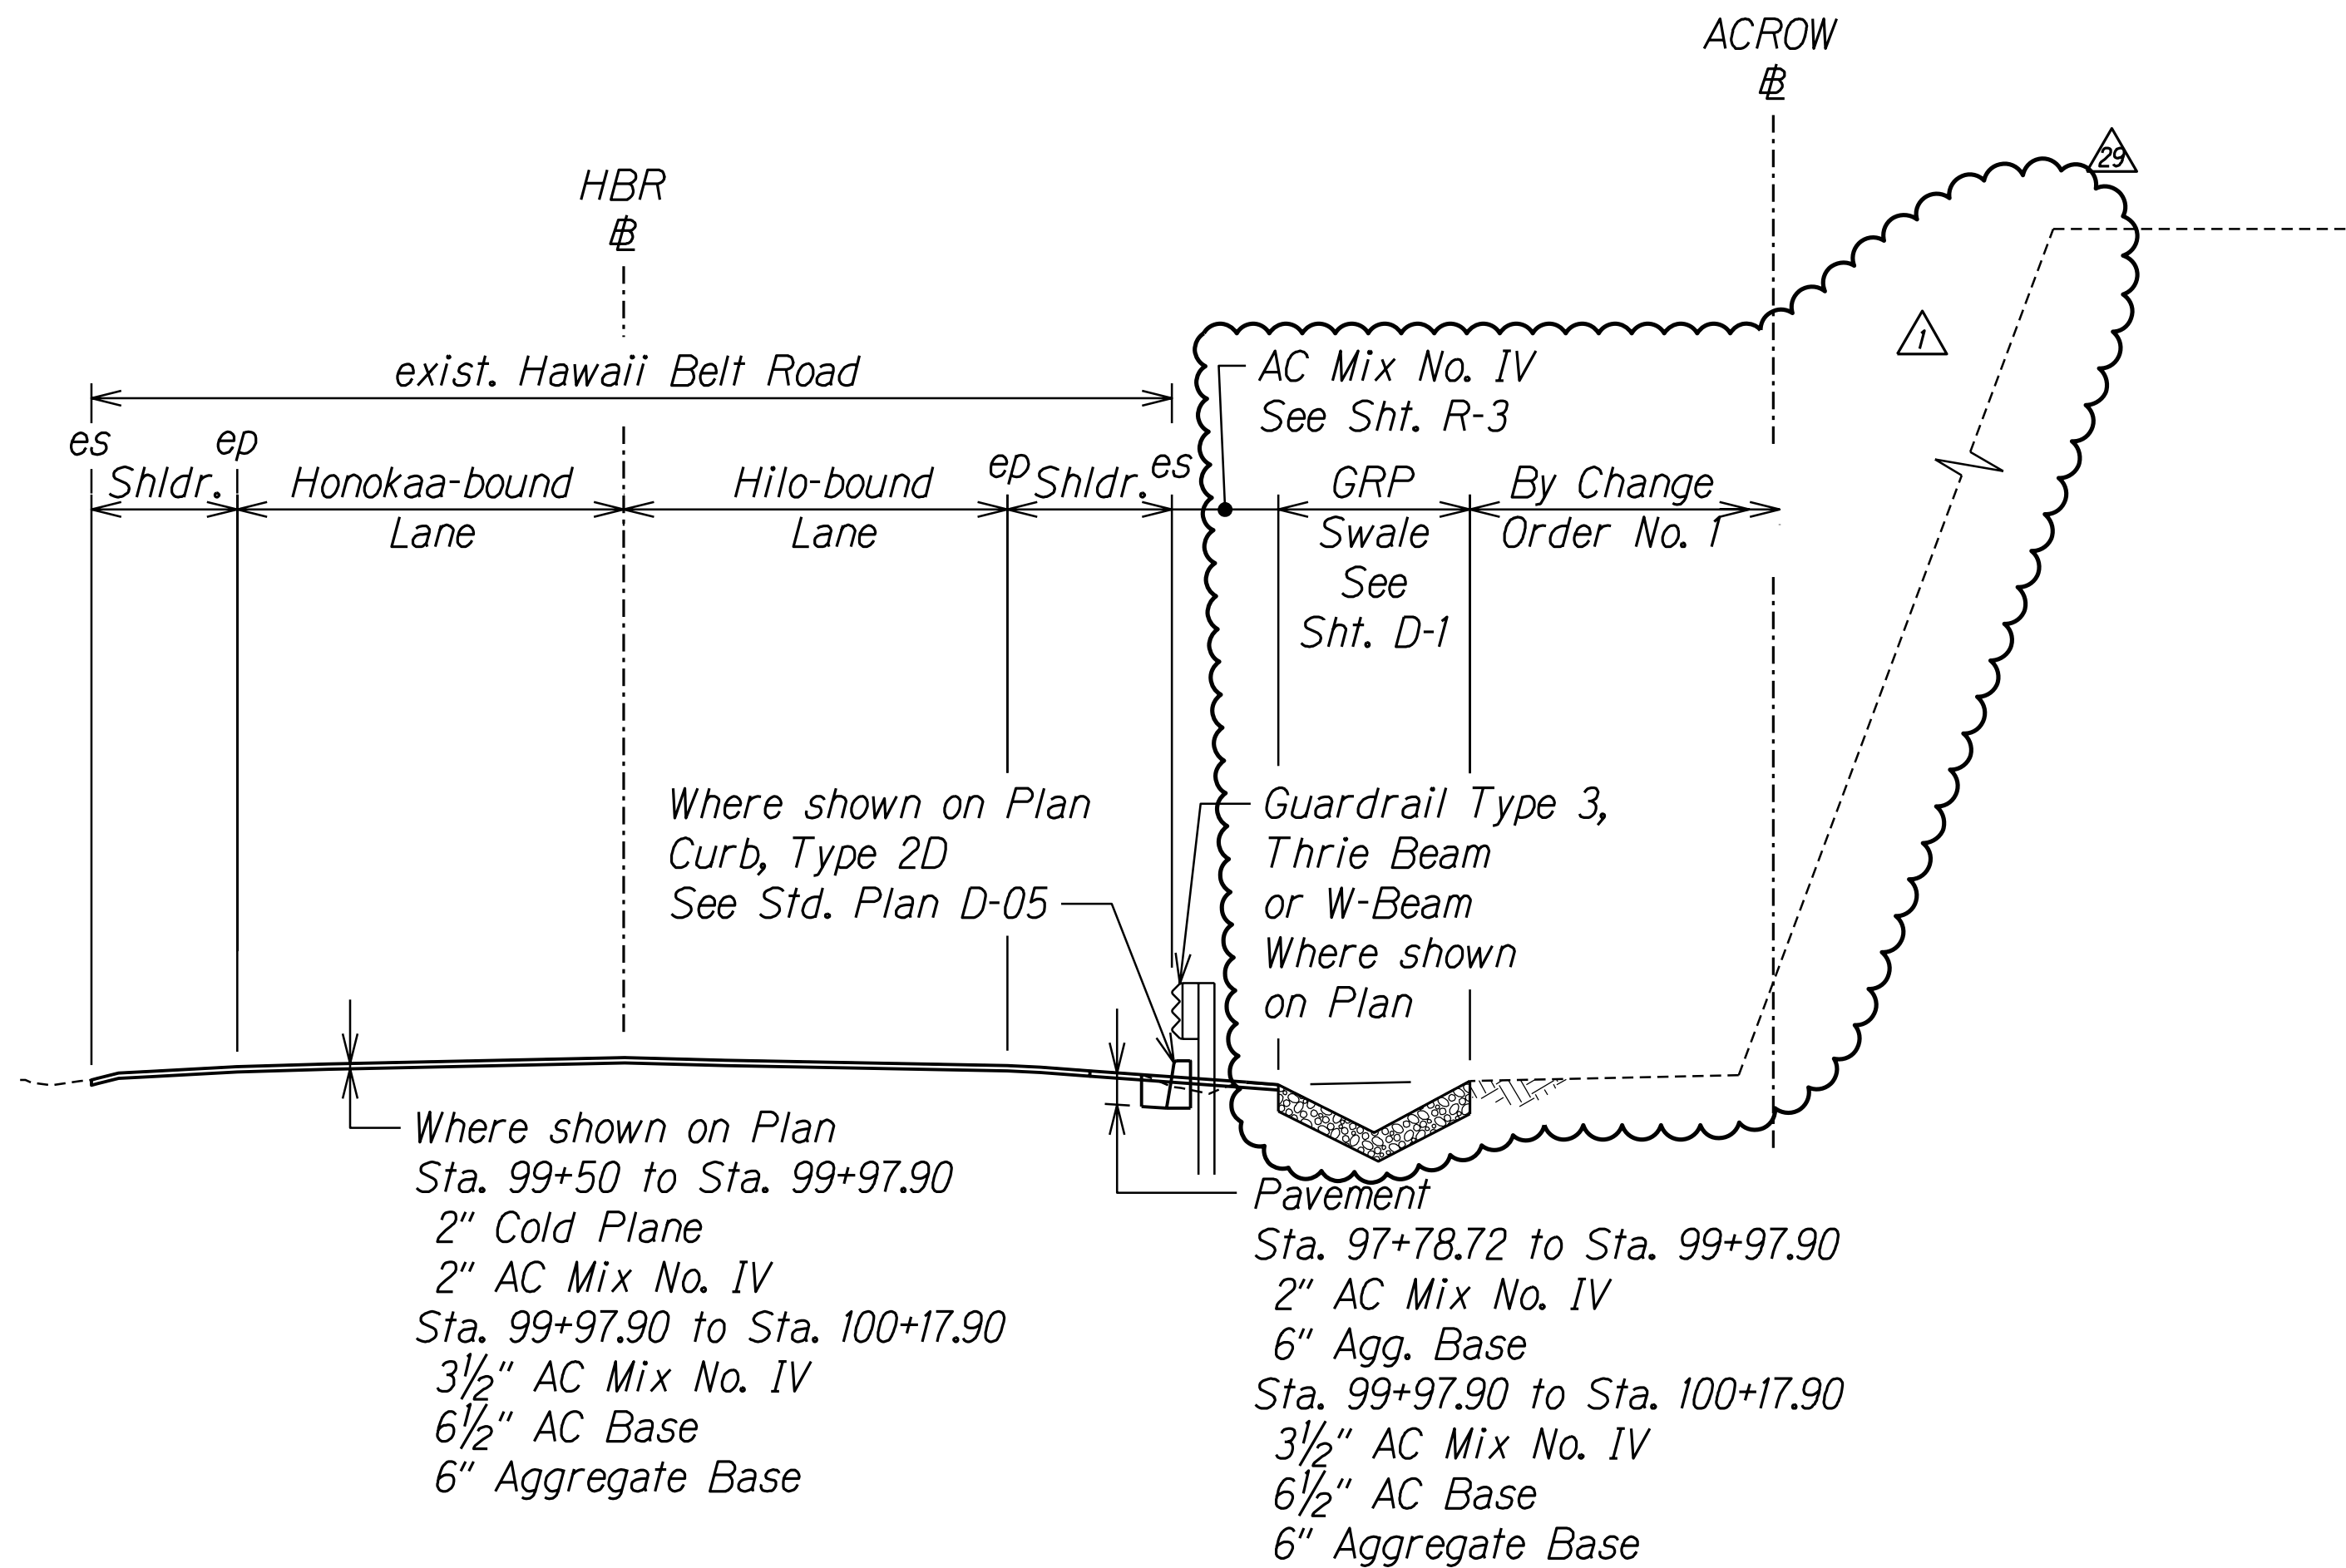


TYPICAL SECTION - HBR # STA. 100+17.90 TO 97+78.72
Scale: 1"=5'

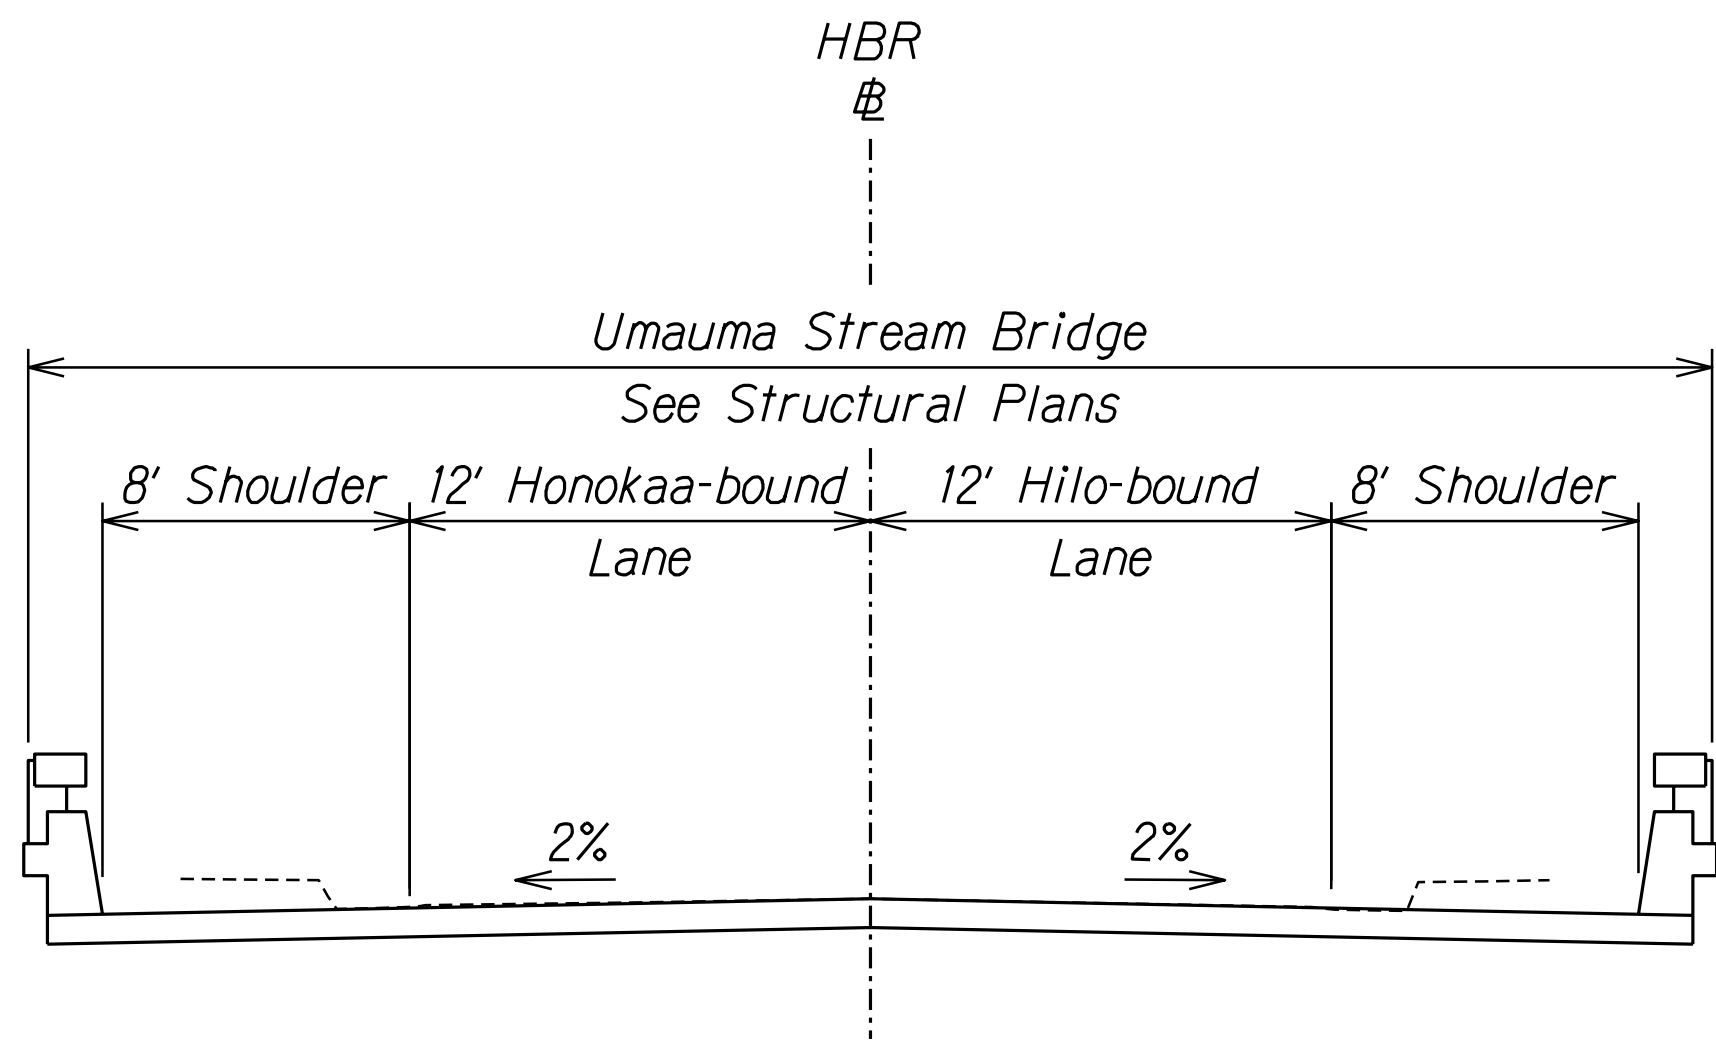

TYPICAL SECTION - HBR # STA. 103+48.90 TO 100+17.90
Scale: 1"=5'

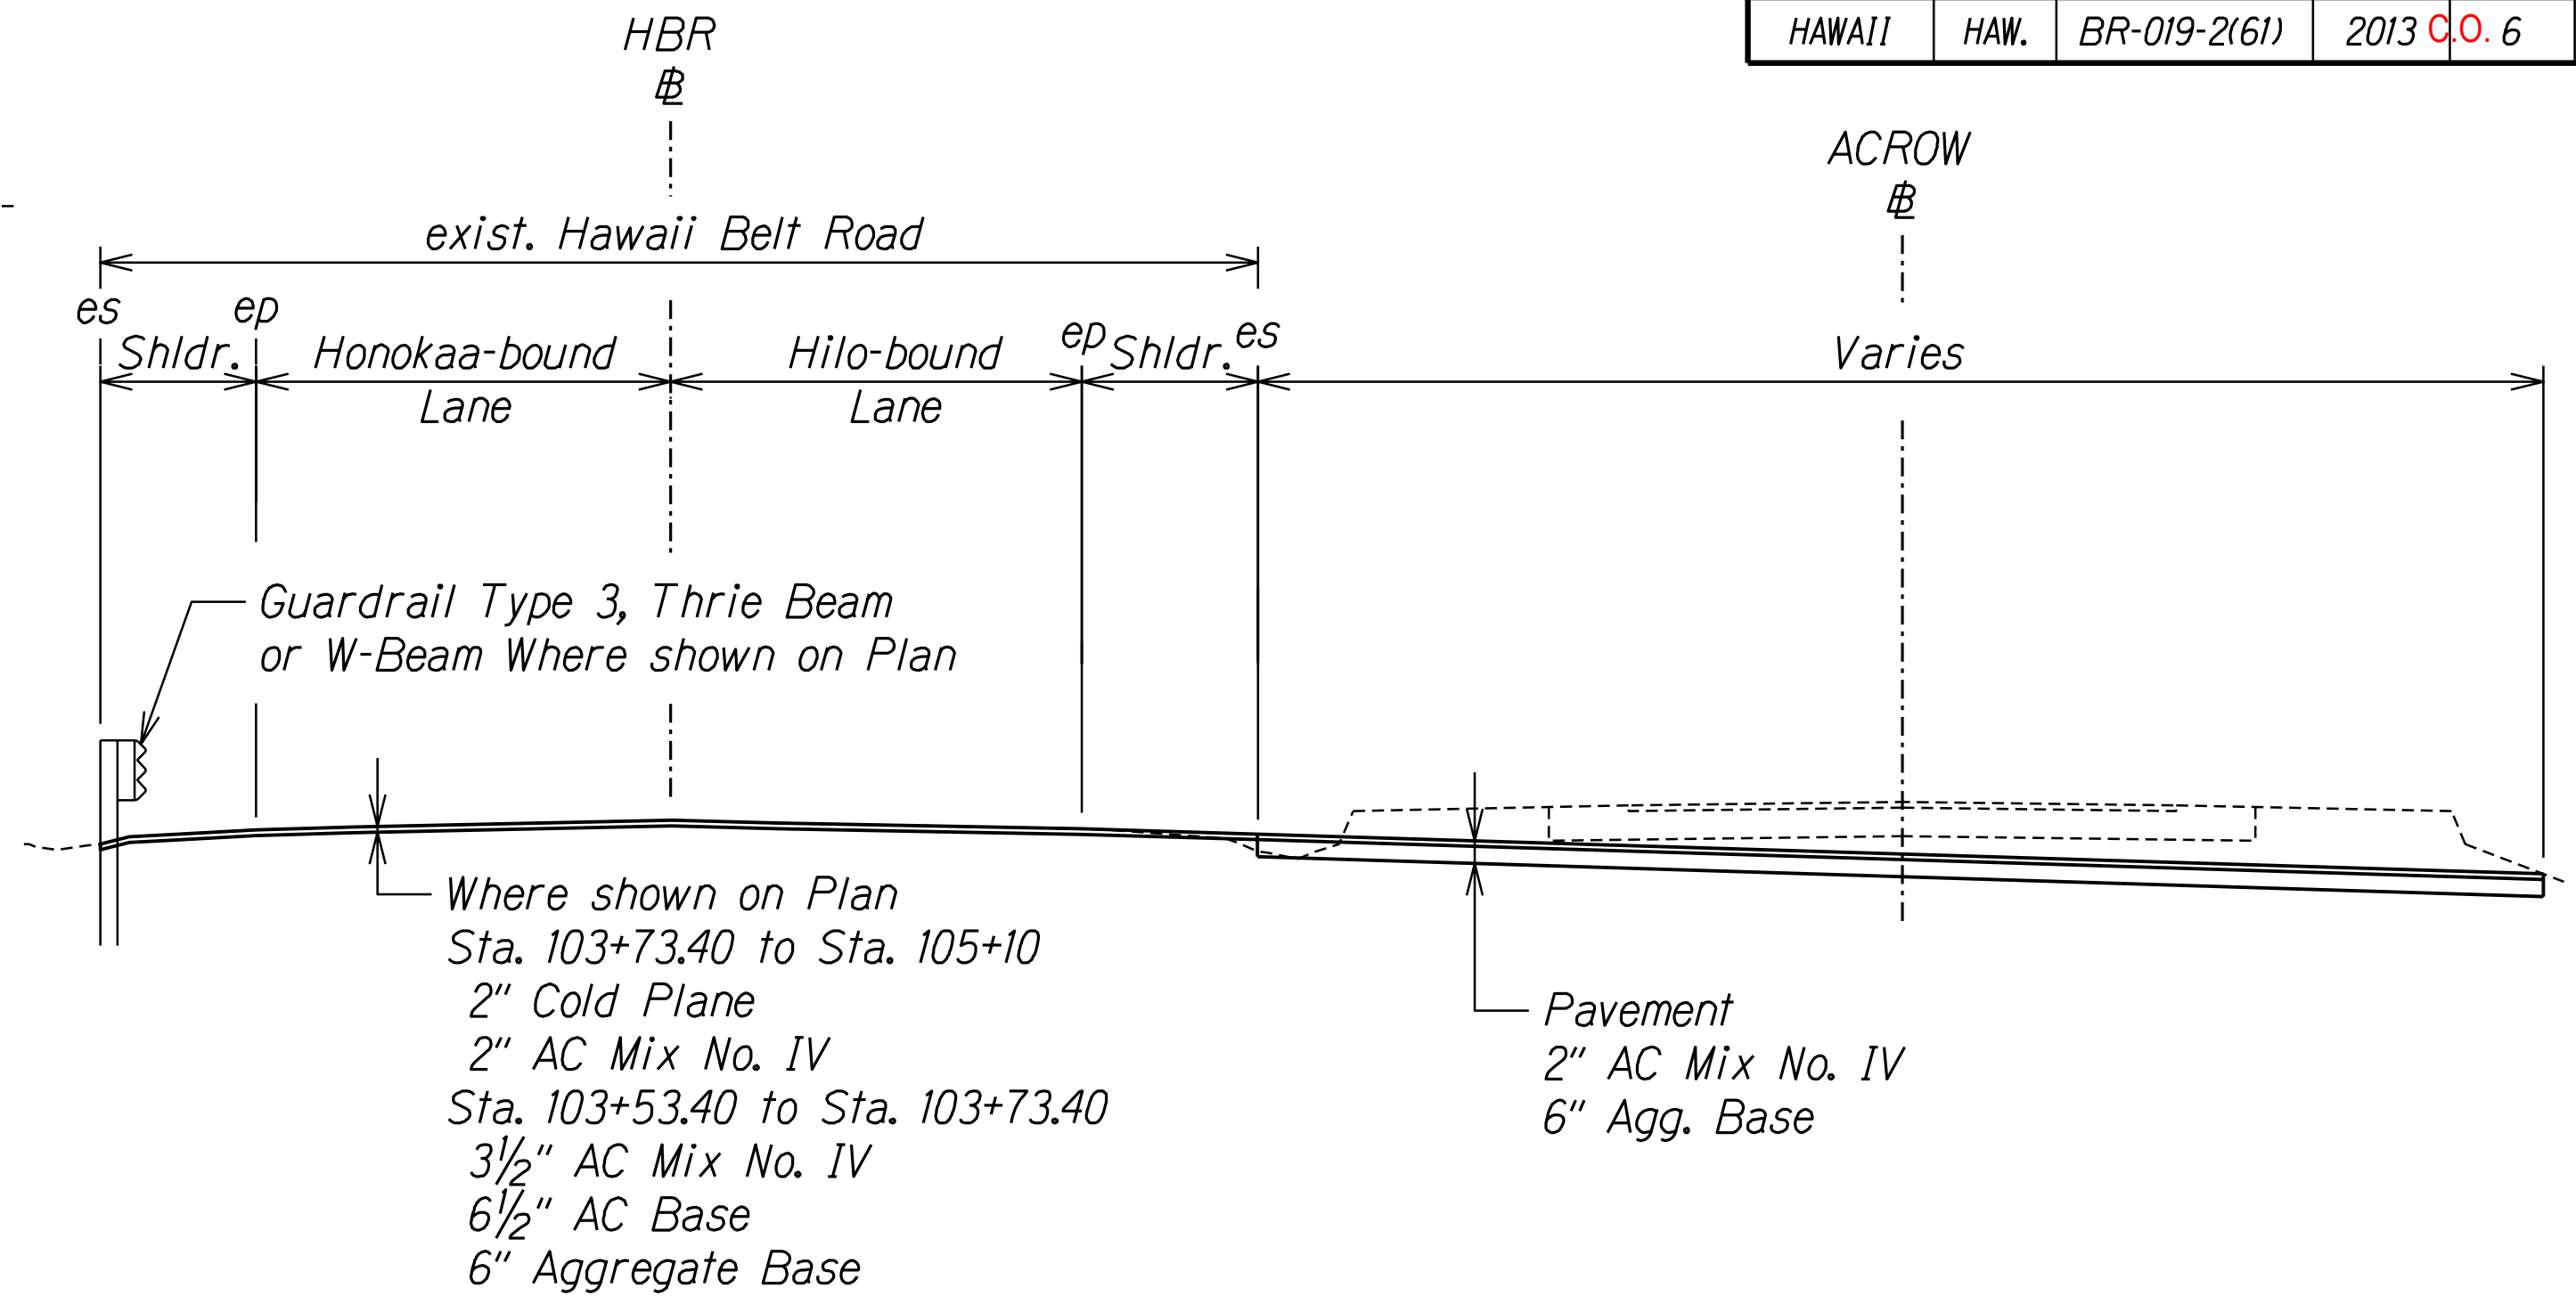

TYPICAL SECTION - HBR # STA. 104+20± TO 103+48.90
Scale: 1"=5'

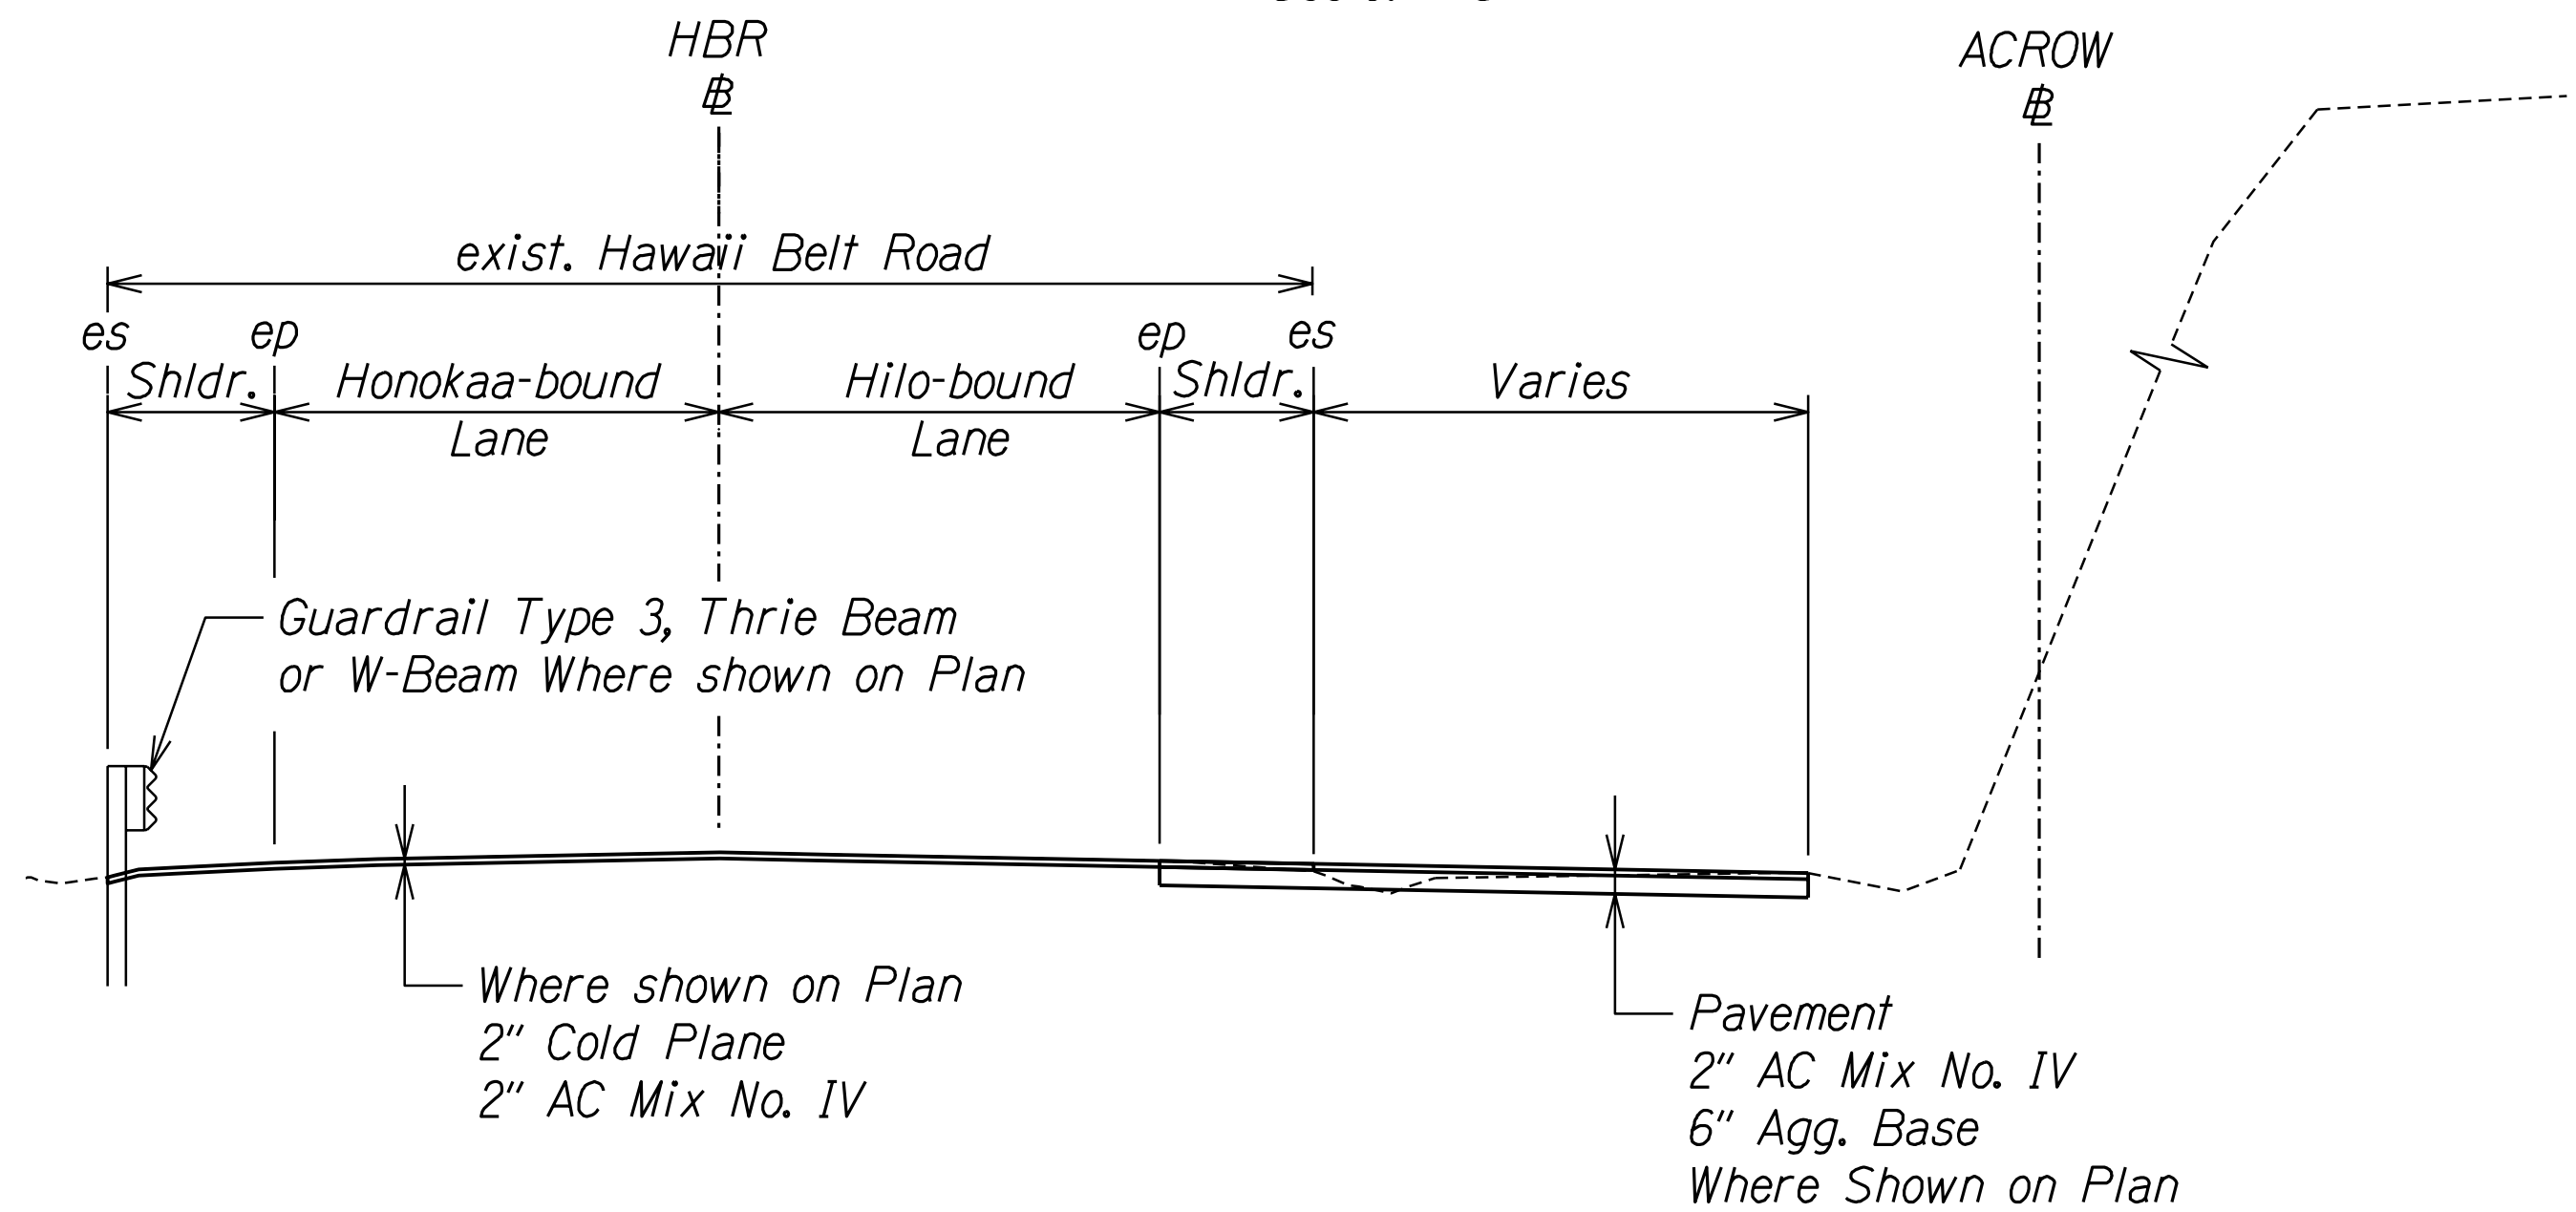

TYPICAL SECTION - HBR # STA. 105+10 TO 104+20±
Scale: 1"=5'

12/1/17	Revised GRP Swale and Grading
9/15/14	Revised Typical Section
Date	Revision

CCO#2

THIS WORK WAS PREPARED BY ME OR UNDER MY SUPERVISION.

Signature: *R. Urasaki* Date: 04/30/16
EXPIRATION DATE OF THE LICENSE

STATE OF HAWAII
DEPARTMENT OF TRANSPORTATION
HIGHWAYS DIVISION

TYPICAL SECTION

HAWAII BELT ROAD
Rehabilitation of Umauma Stream Bridge
FAP NO. BR-019-2(61)

Scale: 1"=5' Date: July 15, 2014

DATE	_____
SURVEY PLOTTED BY	_____
DRAWN BY	_____
DESIGNED BY	_____
NOTE BOOK	_____
QUANTITIES BY	_____
CHECKED BY	_____
Nº	_____