



FED. ROAD DIST. NO.	STATE	FED. AID PROJ. NO.	FISCAL YEAR	SHEET NO.	TOTAL SHEETS
HAWAII	HAW.	ER-15(21)	2010	22	89

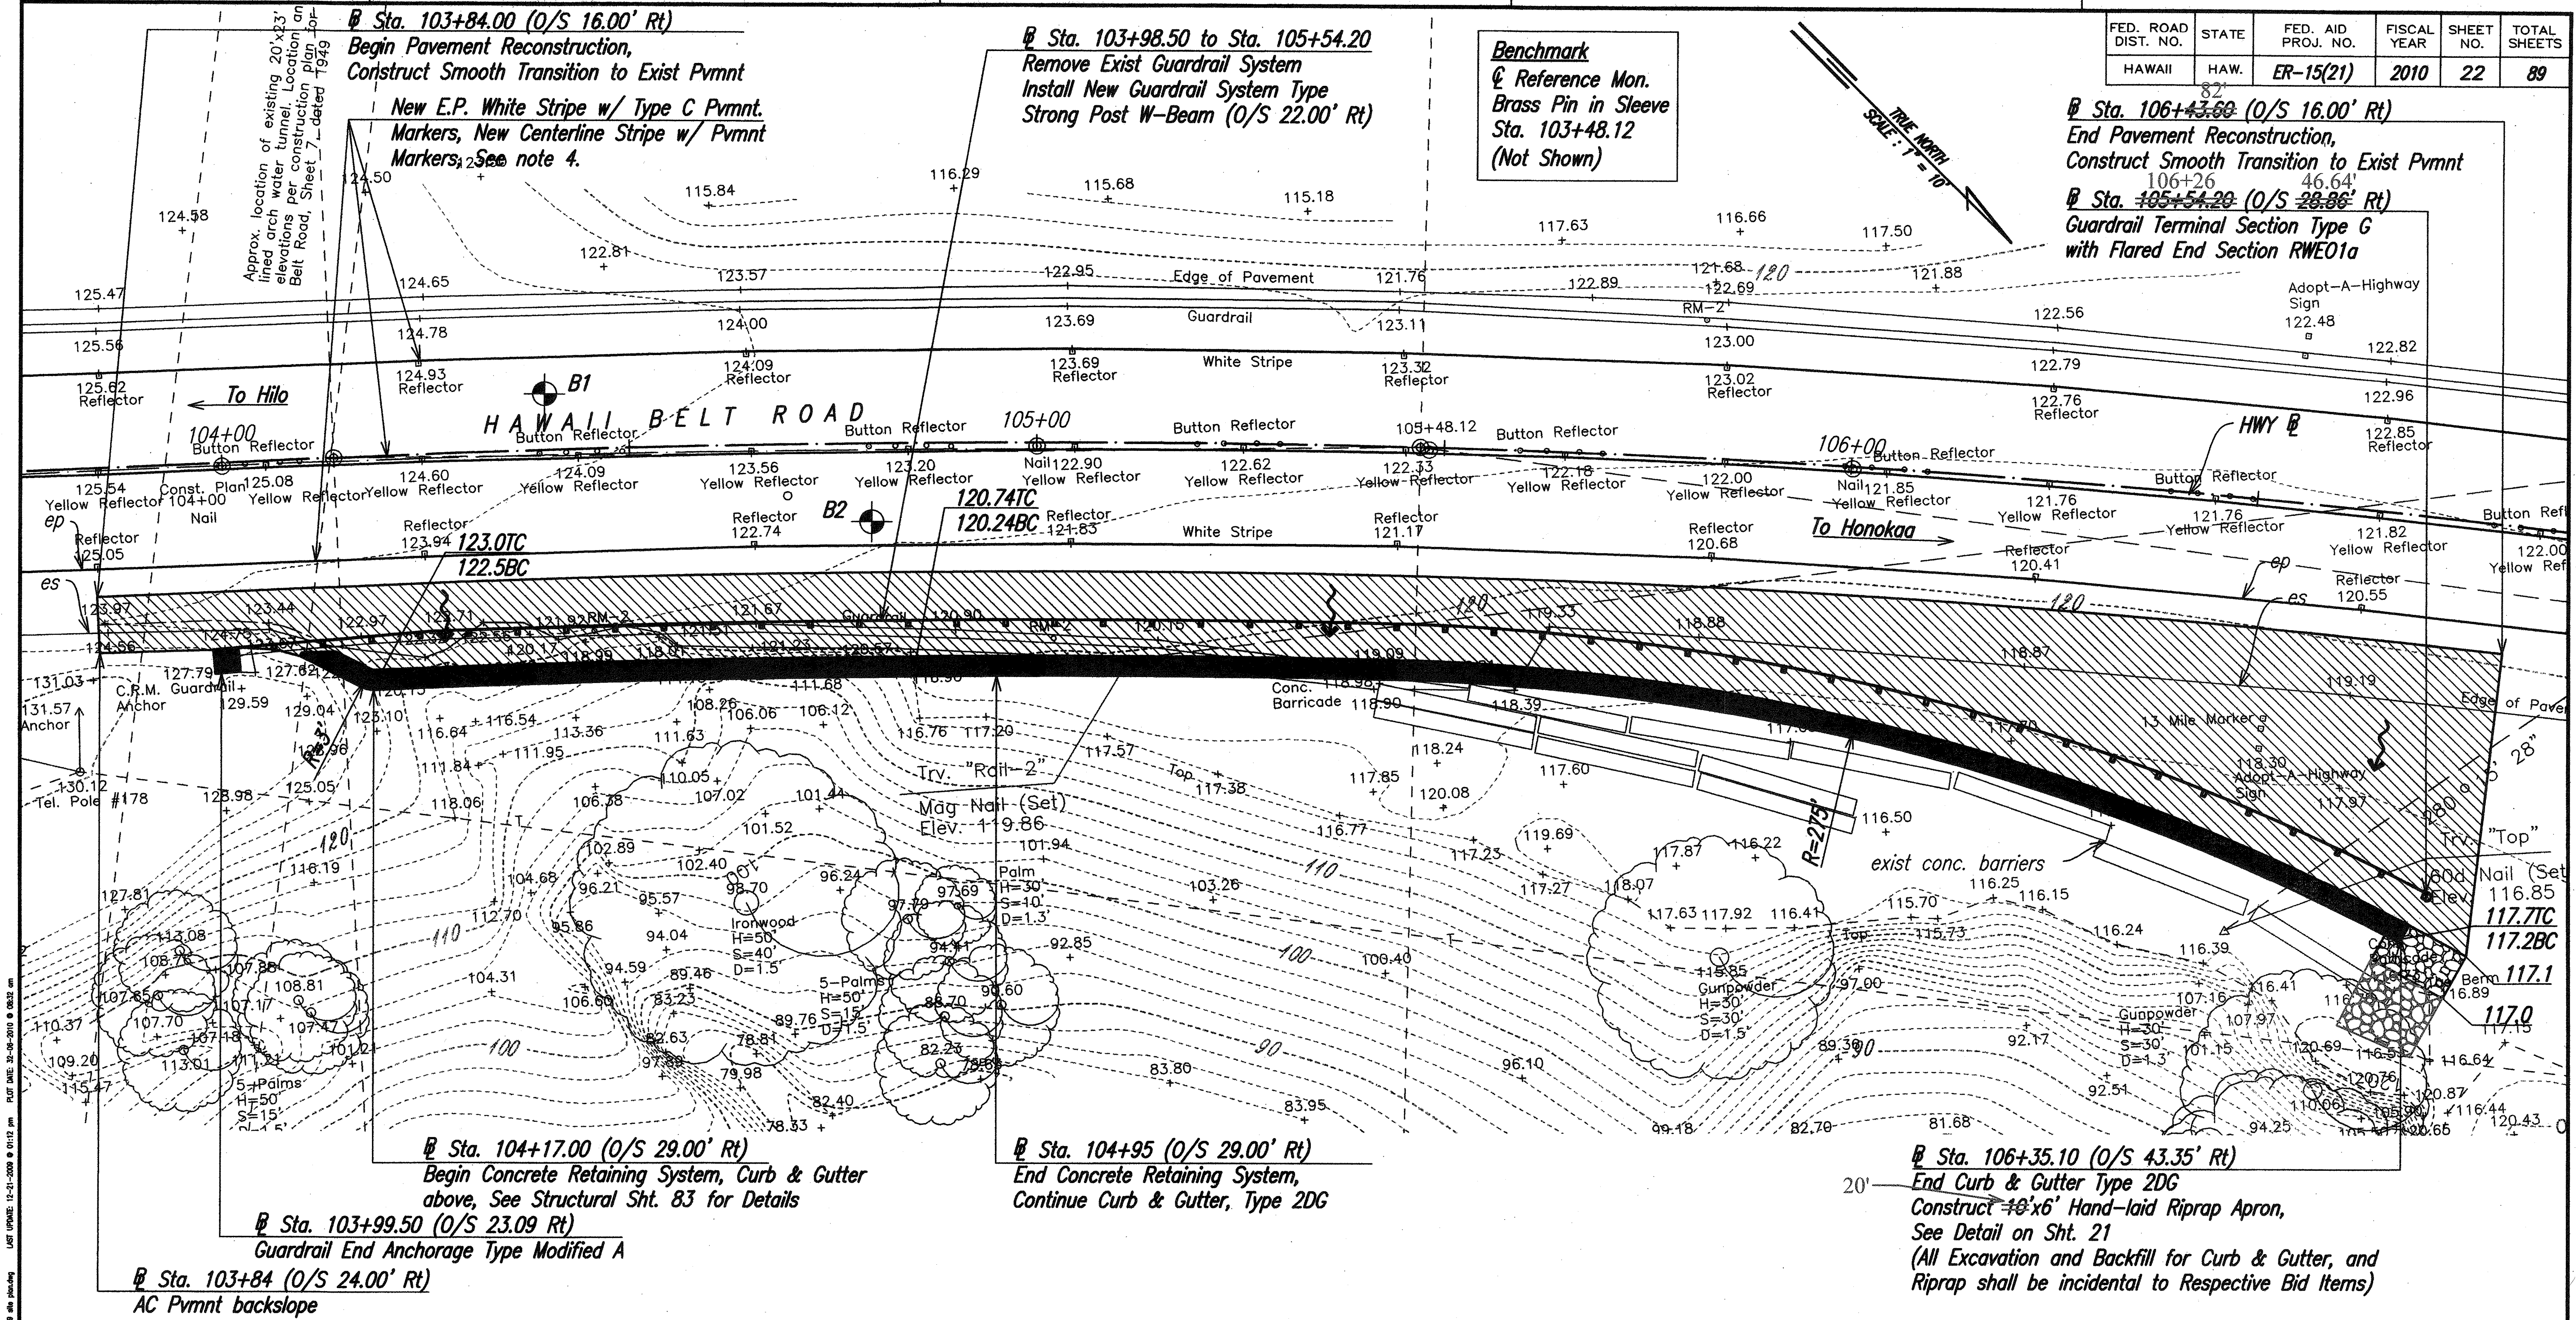

MP 12.9 SITE PLAN
Scale: 1"=10'

LEGEND FOR AS-BUILT POSTINGS	
~~~~~	Squiggly line for as-built deletion
==00.00==	Double line for as-built deletion
Roadway	Text for as-built posting

**AECOM**

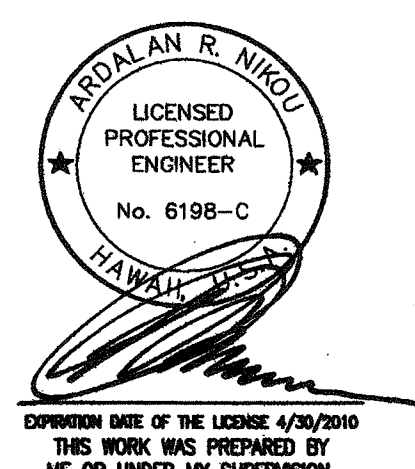

STATE OF HAWAII  
DEPARTMENT OF TRANSPORTATION  
HIGHWAYS DIVISION

**MP 12.9 SITE PLAN**

**EMERGENCY EARTHQUAKE ROCKFALL REPAIRS AT VARIOUS LOCATIONS**

**F.A. Project No. ER-15(21)**


Scale: As Noted Date: December, 2009

SHEET No. 1 OF 4 SHEETS

"AS-BUILT"



FED. ROAD DIST. NO.	STATE	FED. AID PROJ. NO.	FISCAL YEAR	SHEET NO.	TOTAL SHEETS
HAWAII	HAW.	ER-15(21)	2010	24	89

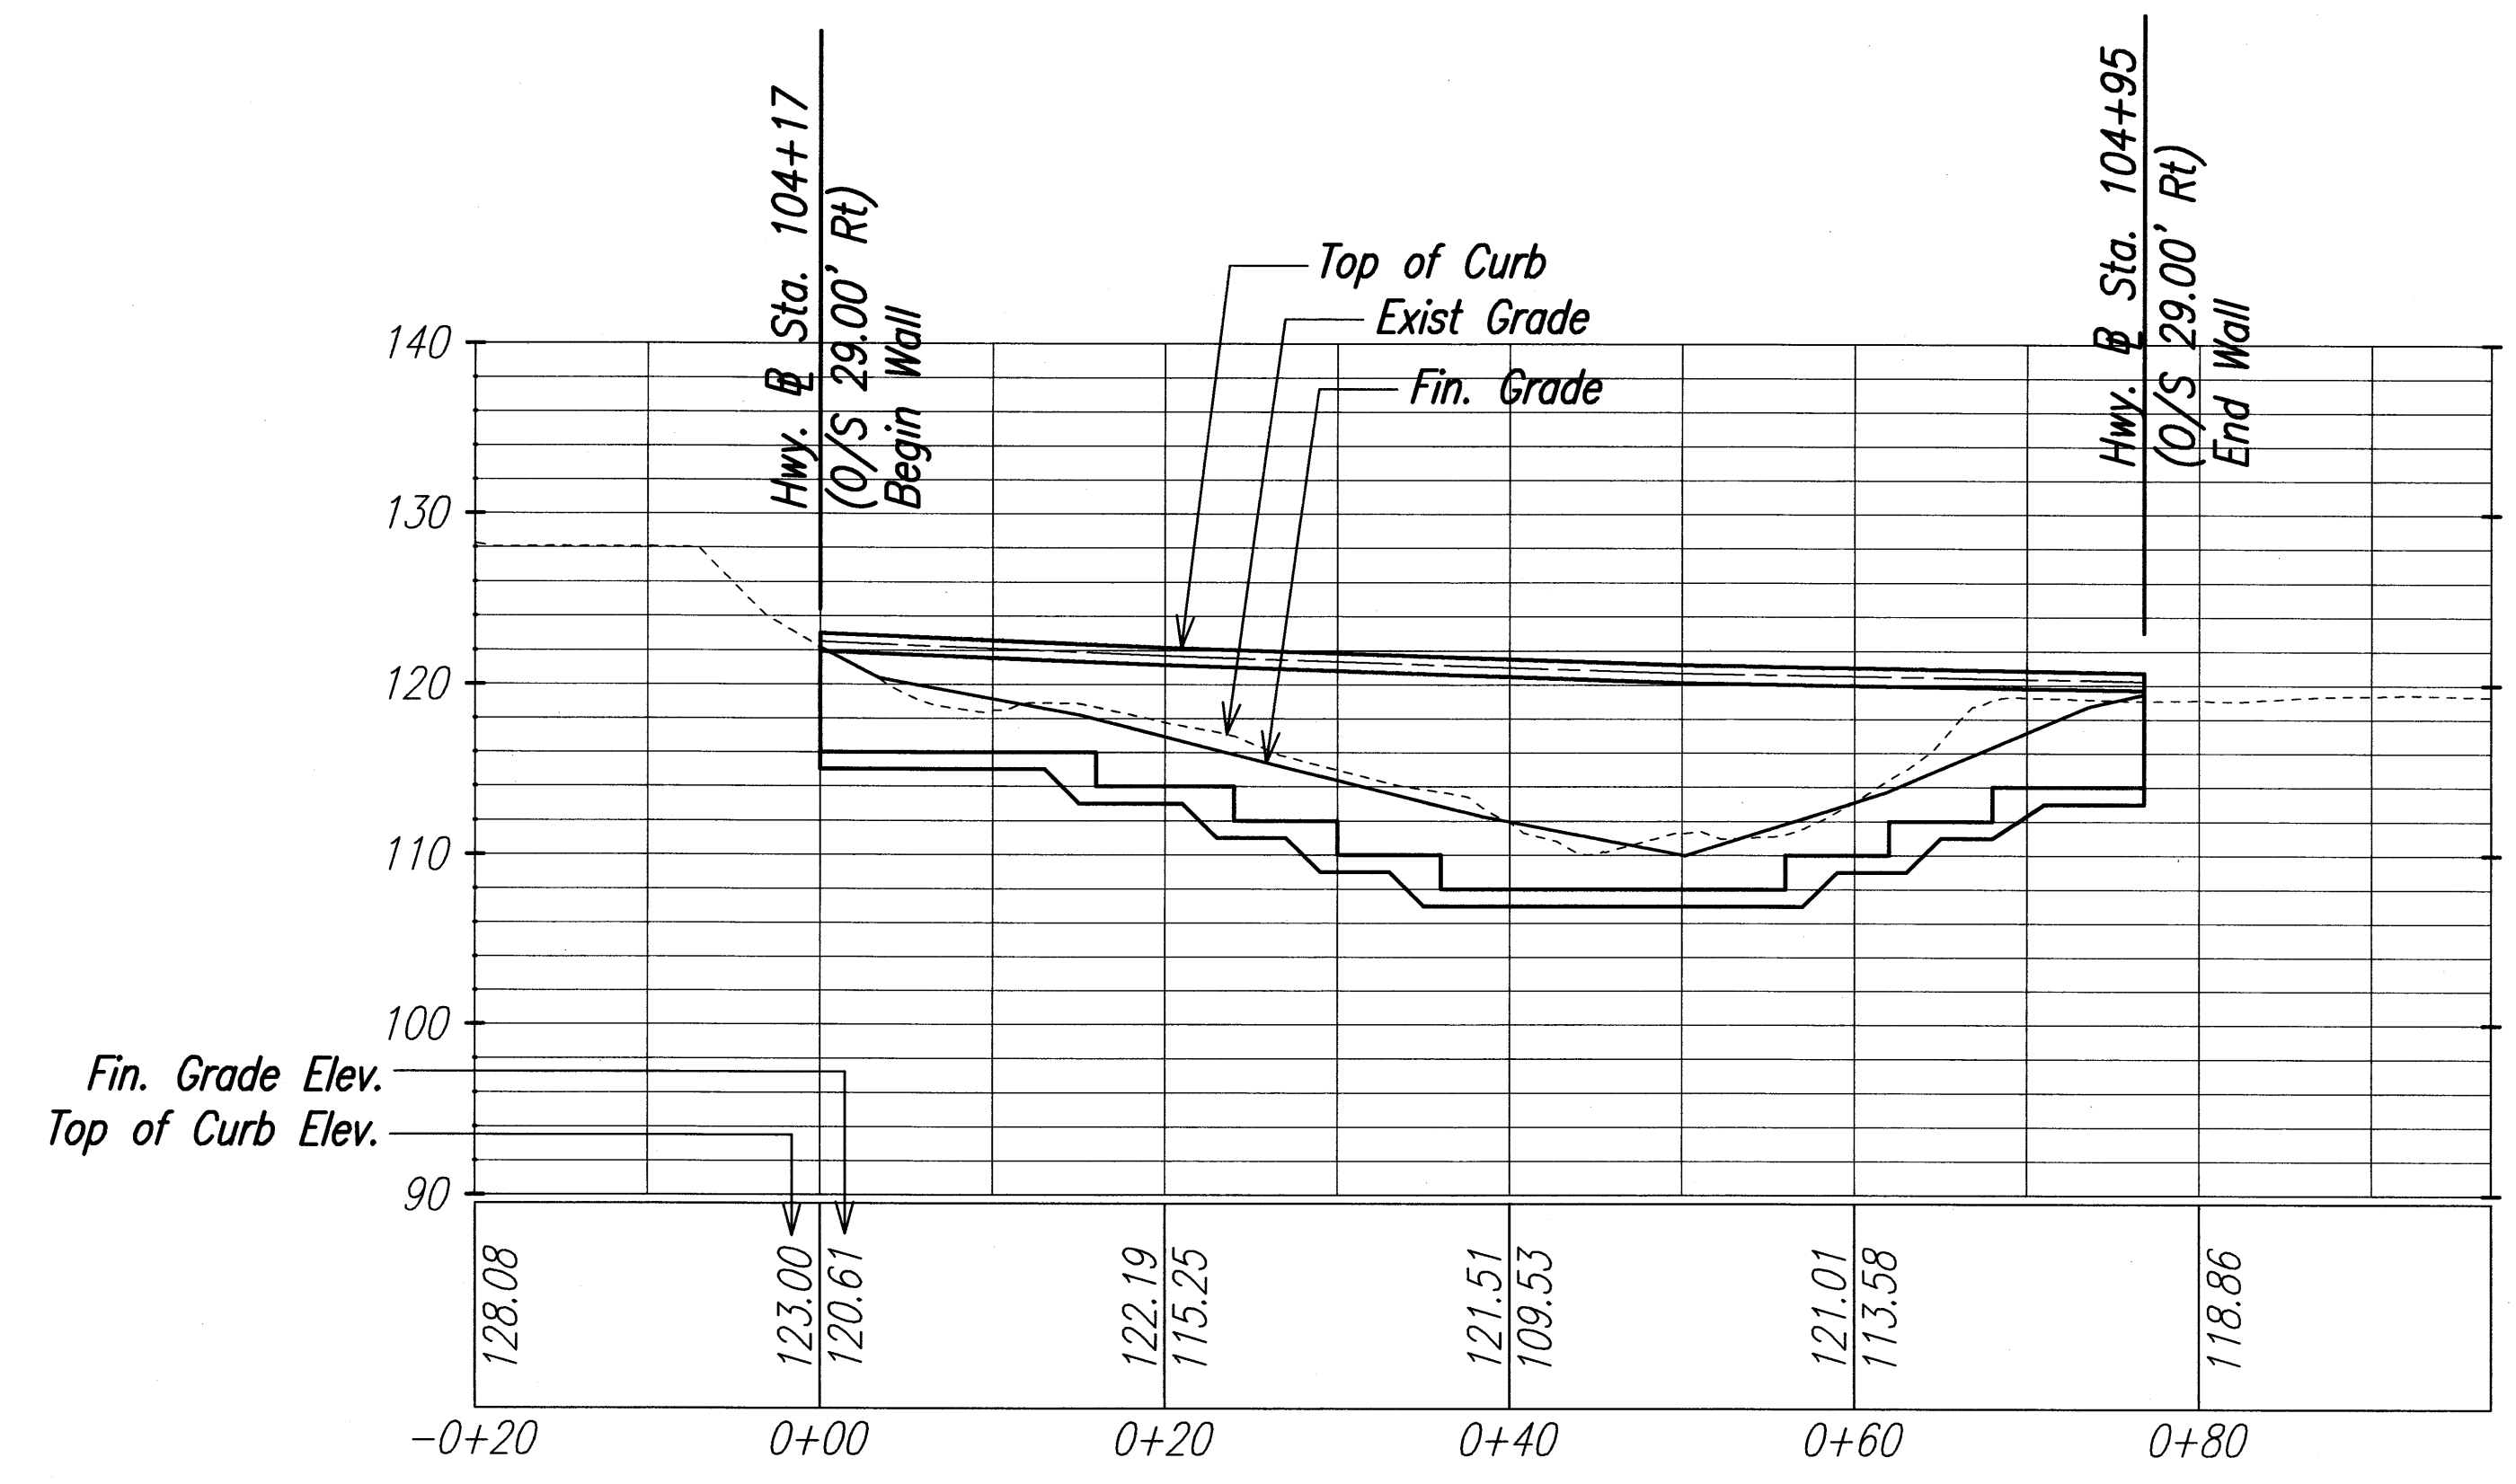


**MP 12.9 WALL PROFILE**  
 Horiz. Scale: 1"=10'  
 Vert. Scale: 1"=10'

ORIGINAL PLAN	DATE
NO.	
DESIGNED BY	
CHECKED BY	
DATE	

2010/12/04 PM 1:13:00 PLOT DATE: 12-04-2010 01:13 PM PLOT DATE: 12-04-2010 01:13 PM

**AECOM**







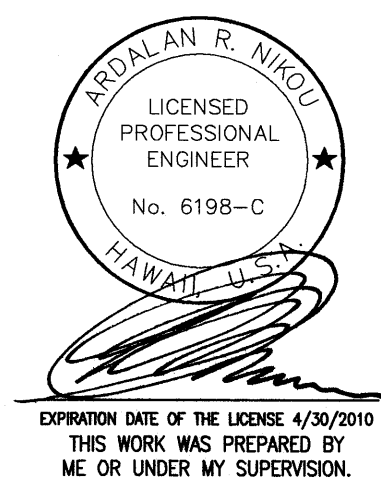


STATE OF HAWAII  
DEPARTMENT OF TRANSPORTATION  
HIGHWAYS DIVISION

**MP 12.9 WALL PROFILE**  
**EMERGENCY EARTHQUAKE ROCKFALL REPAIRS**  
**AT VARIOUS LOCATIONS**  
**F.A. Project No. ER-15(21)**  
Scale: As Noted      Date: December, 2009

SHEET No. 3 OF 4 SHEETS

FED. ROAD DIST. NO.	STATE	FED. AID PROJ. NO.	FISCAL YEAR	SHEET NO.	TOTAL SHEETS
HAWAII	HAW.	ER-15(21)	2010	25	89

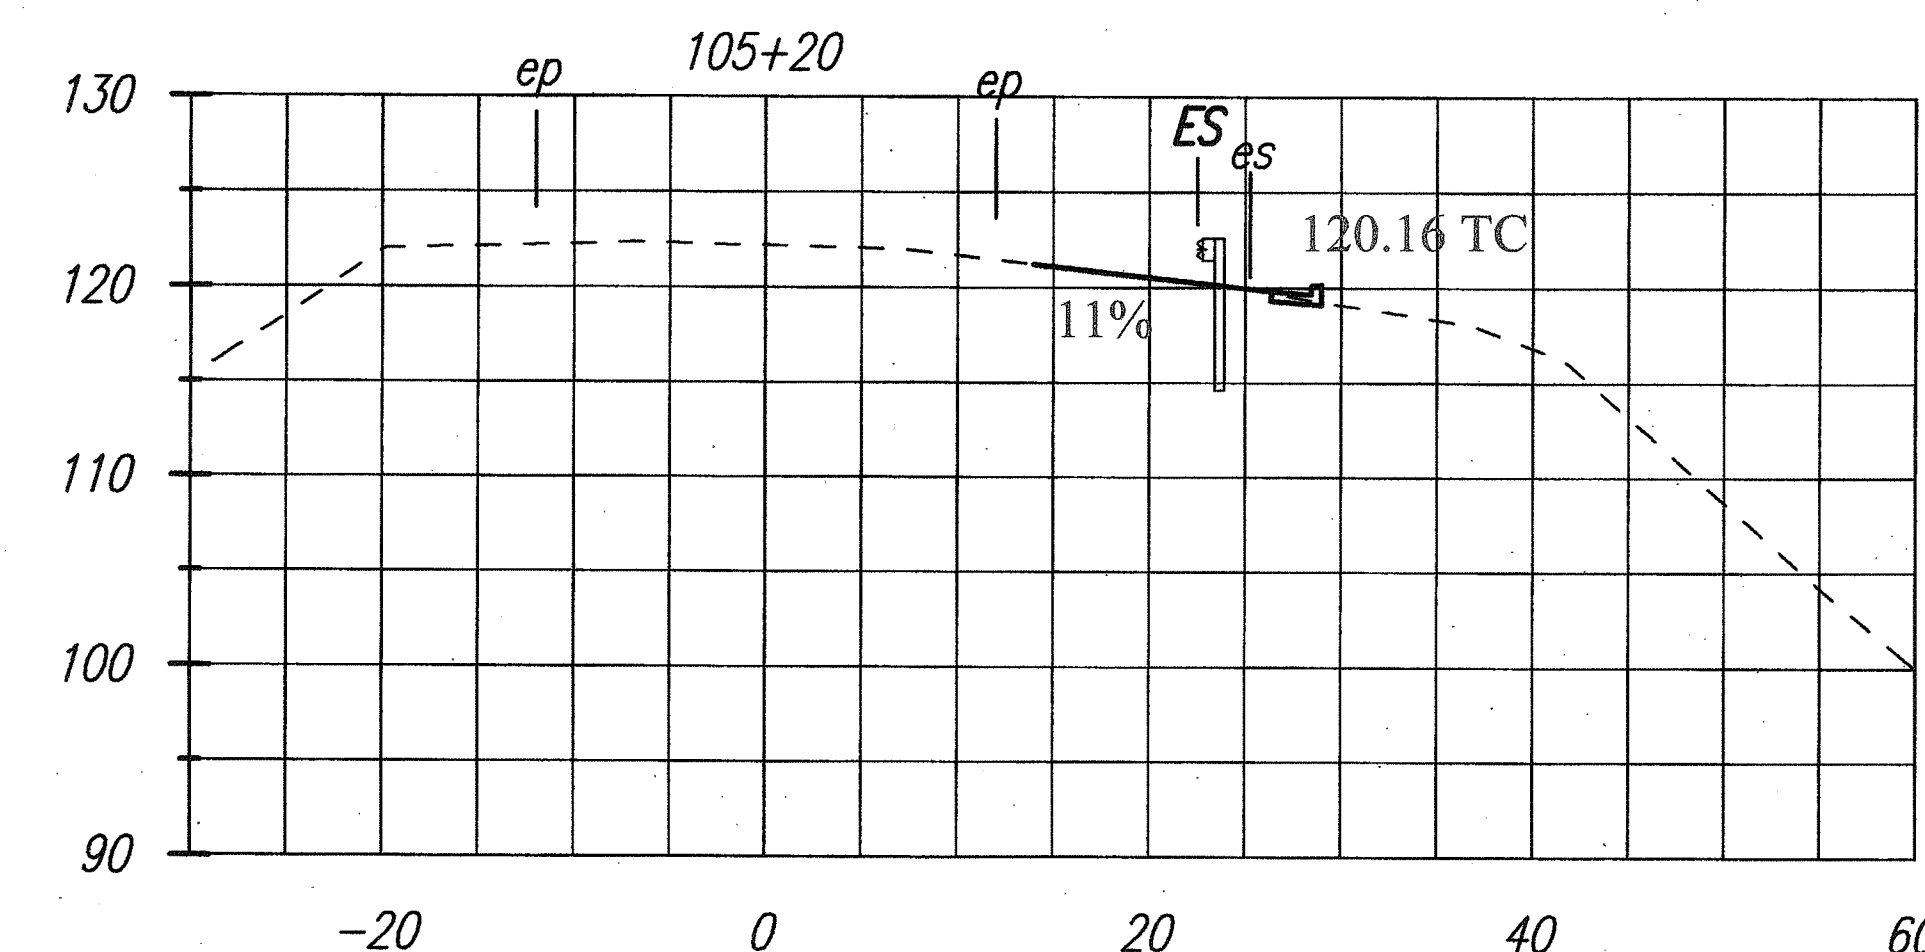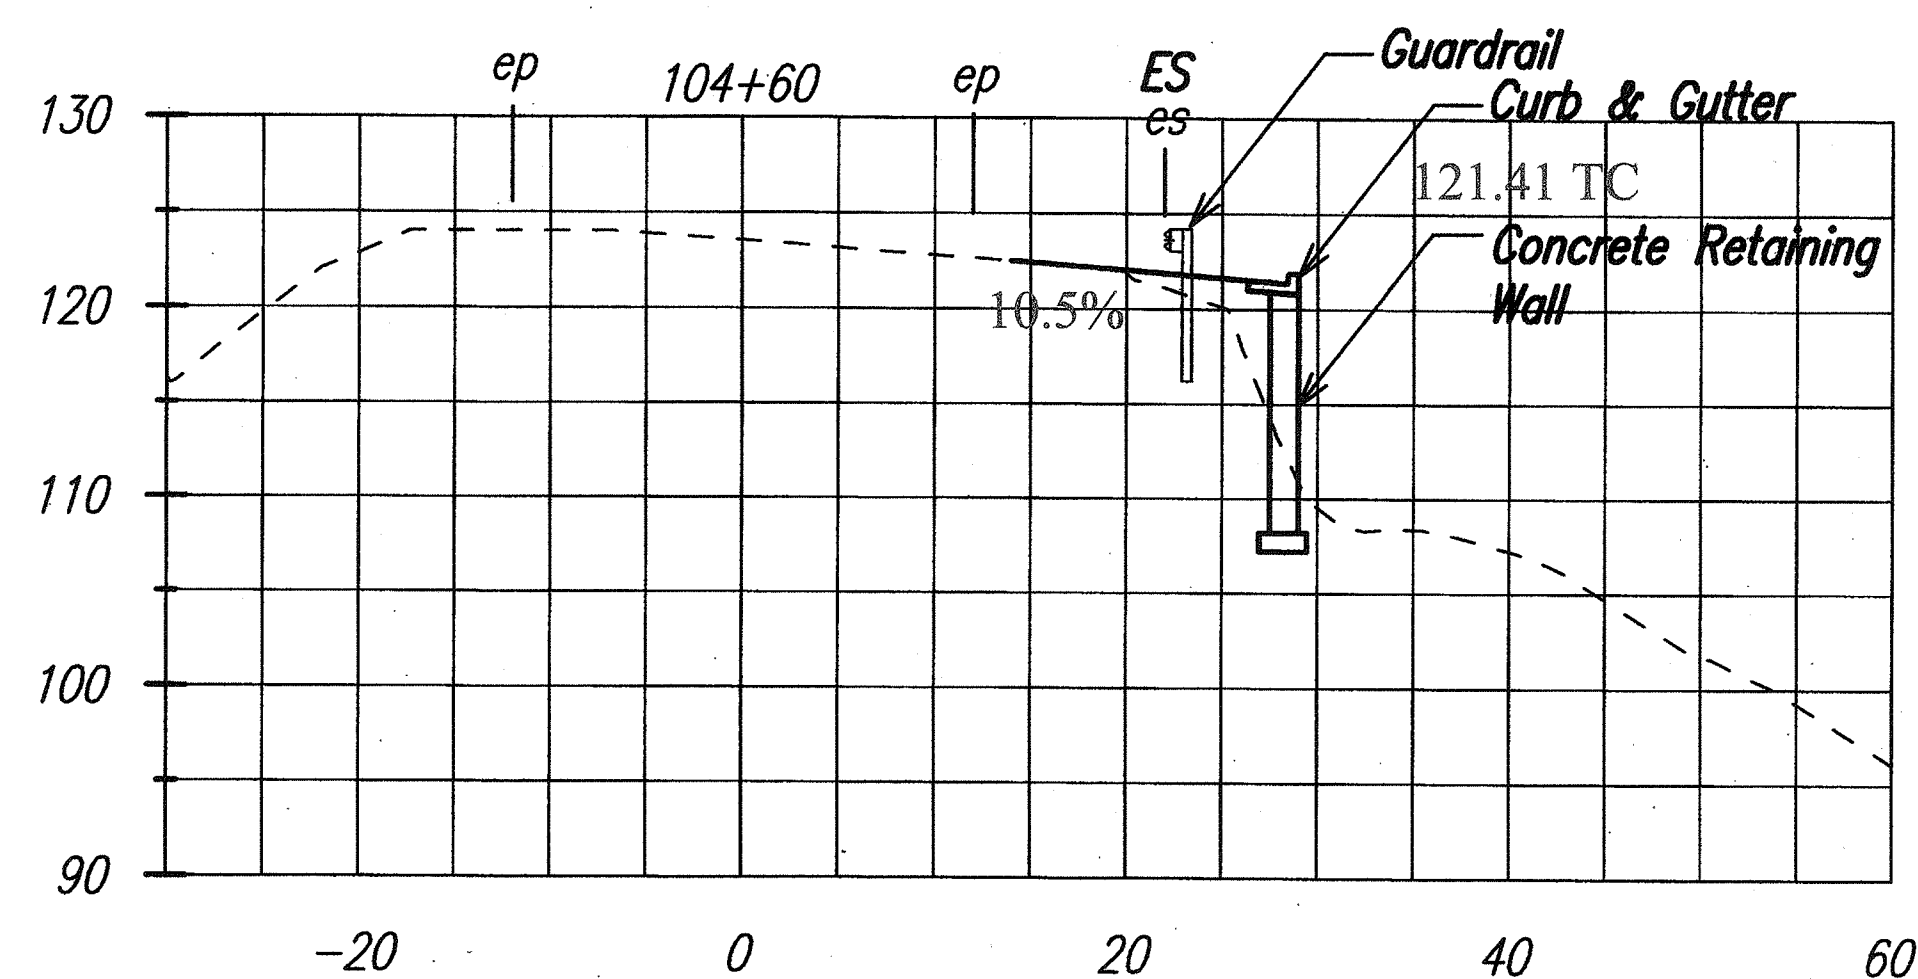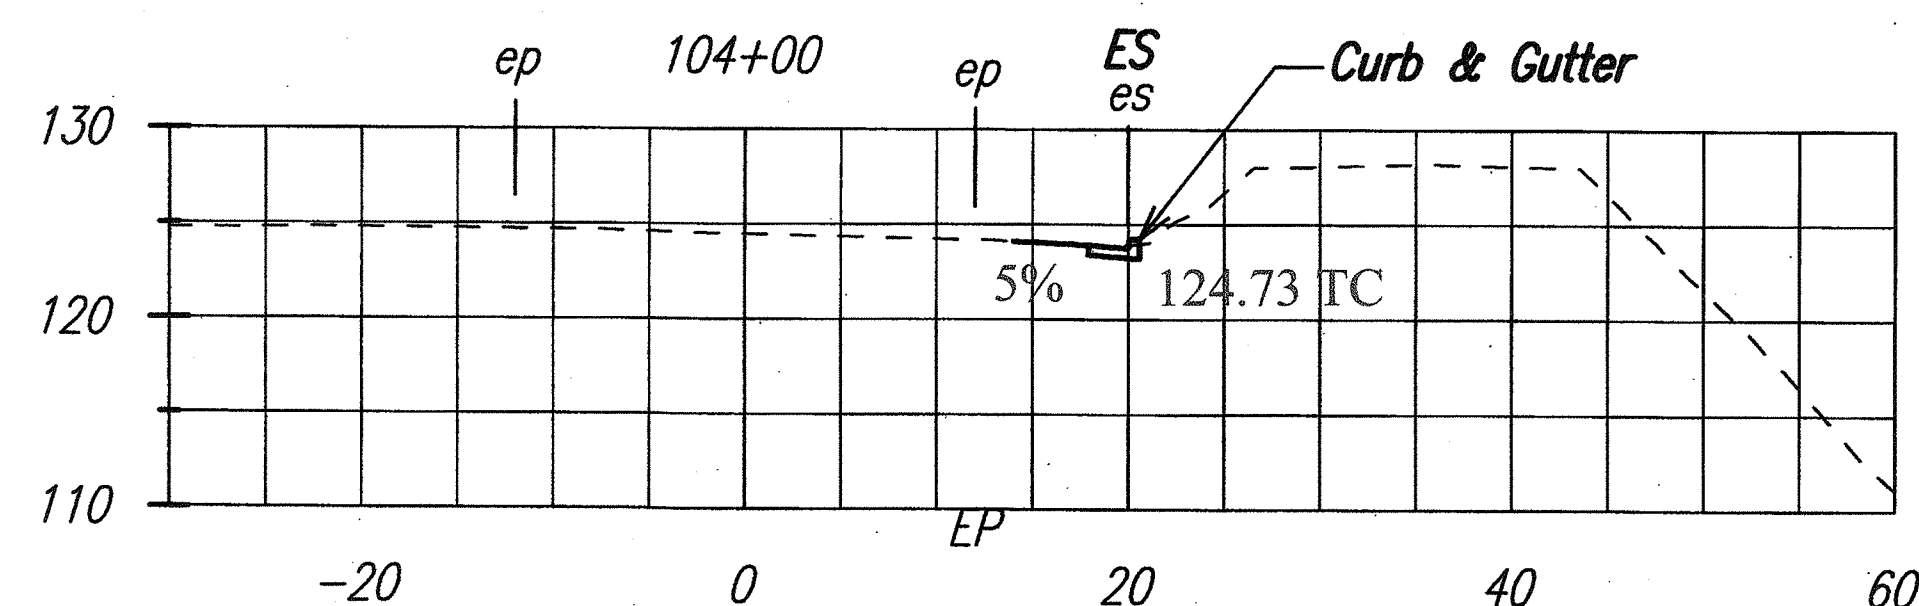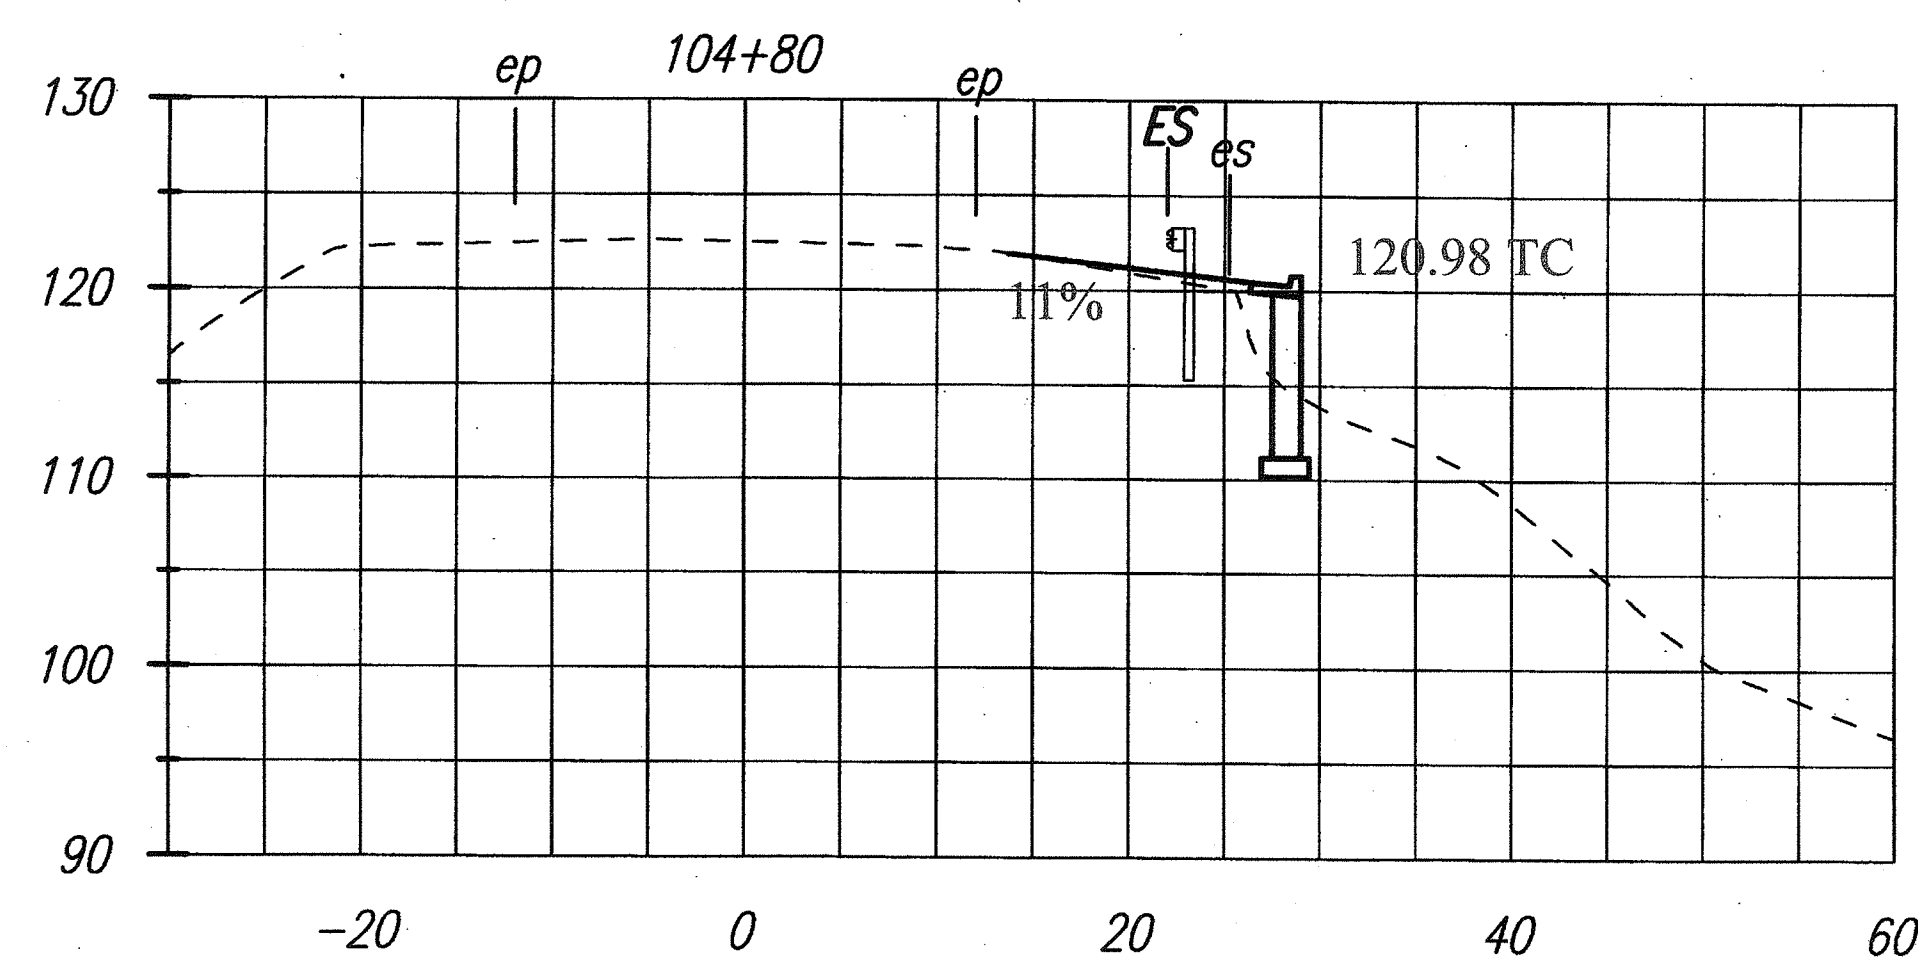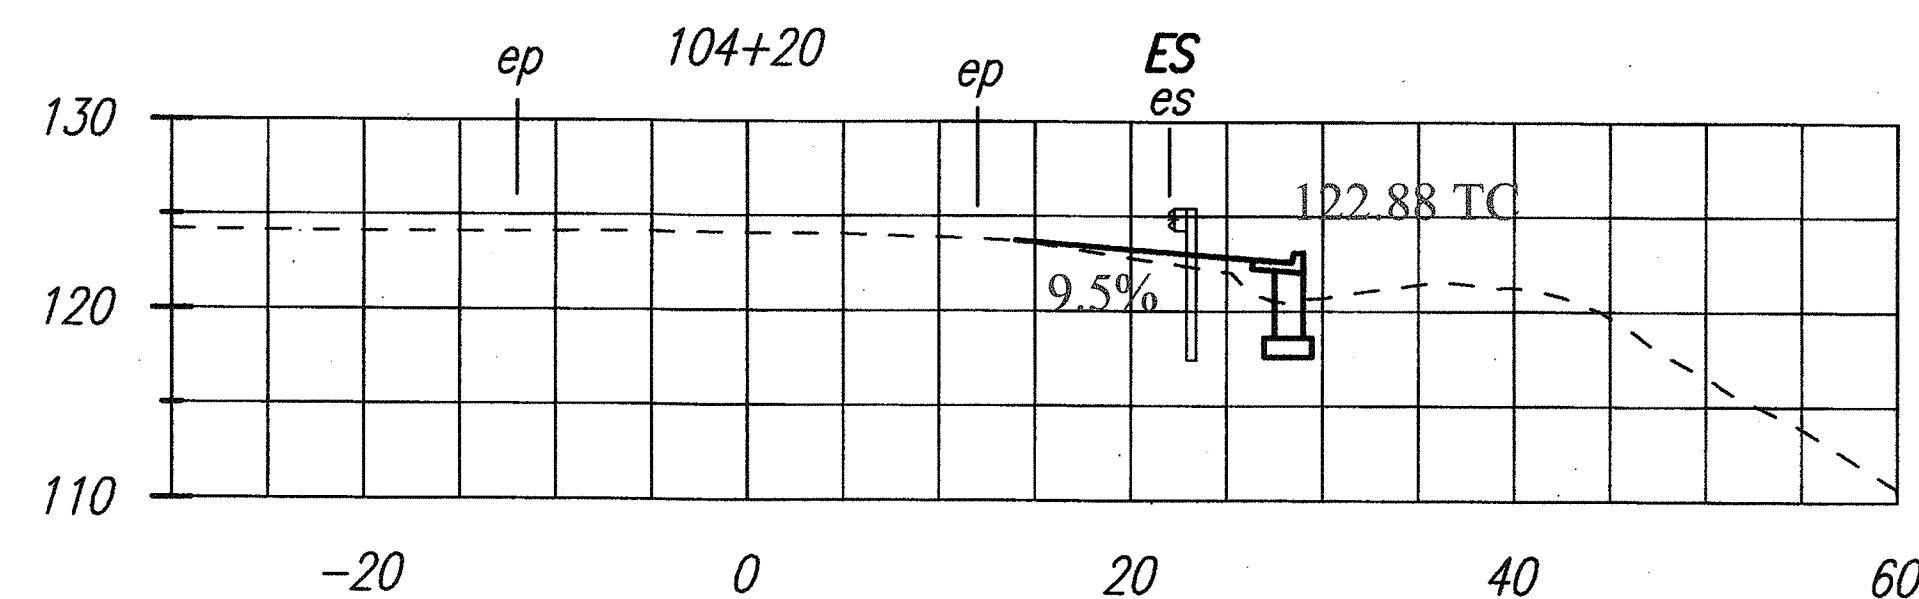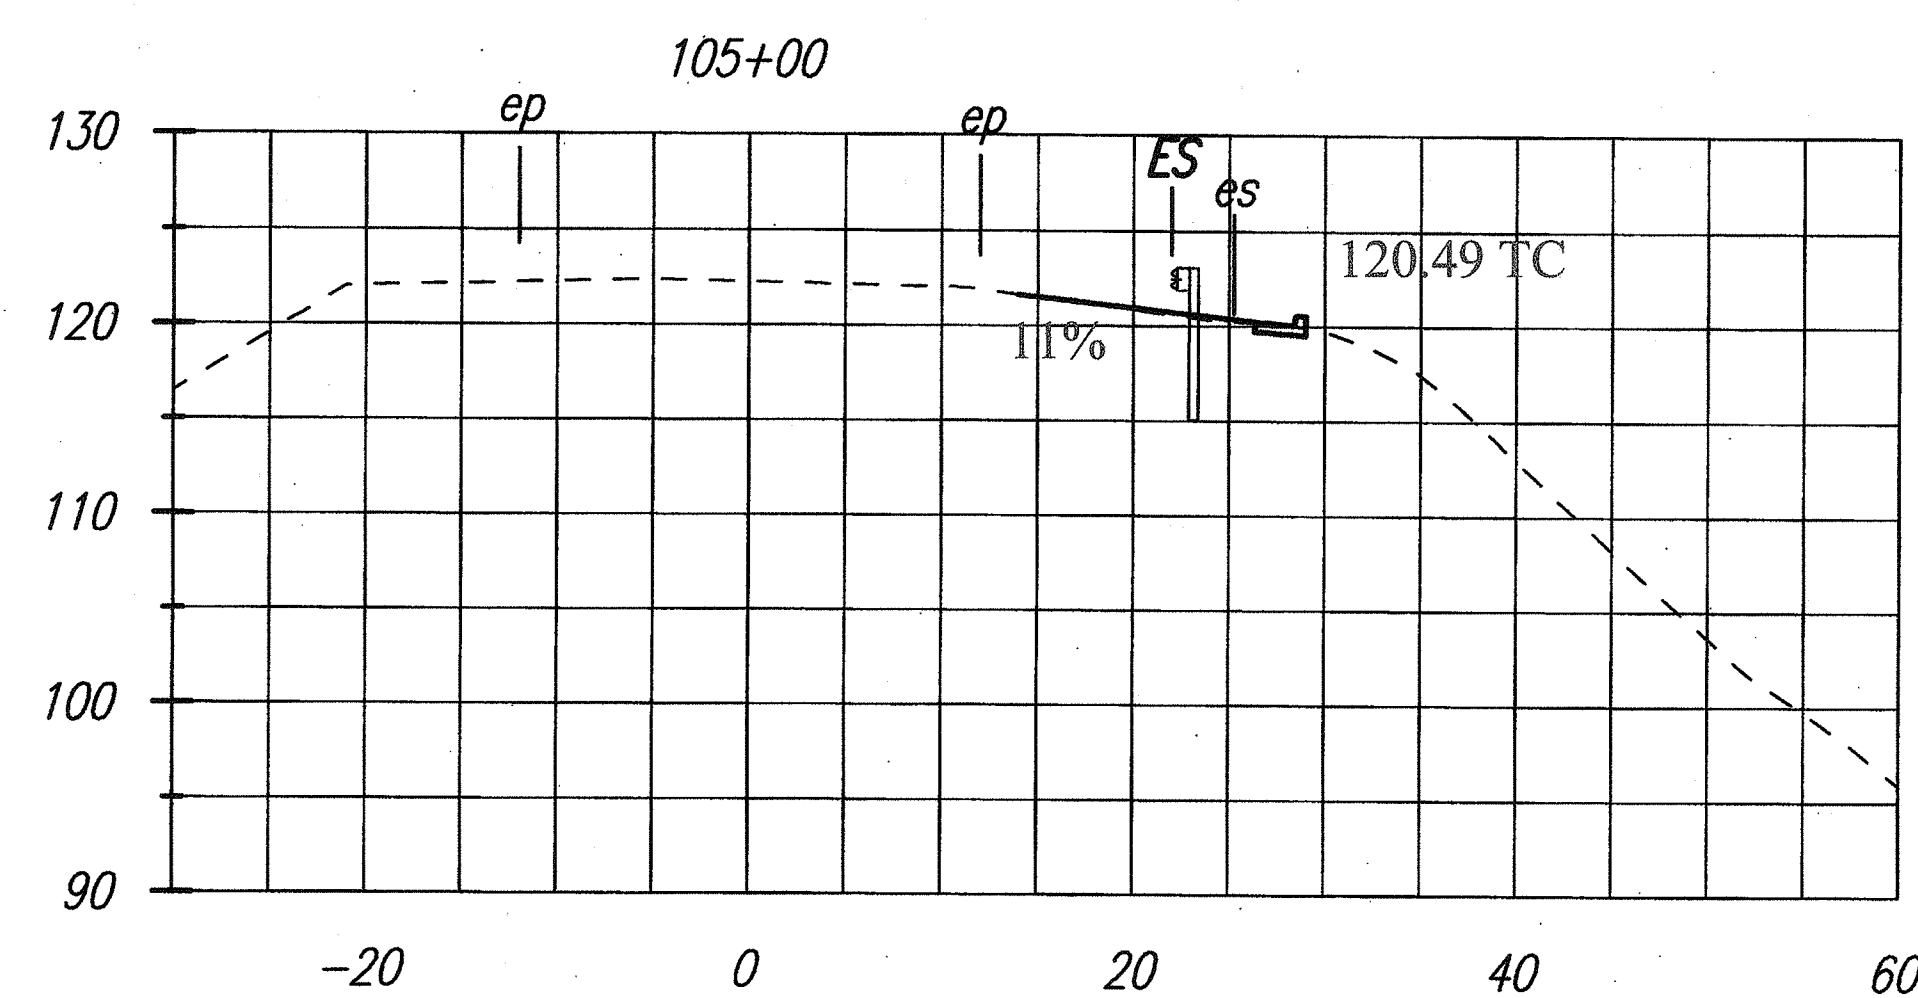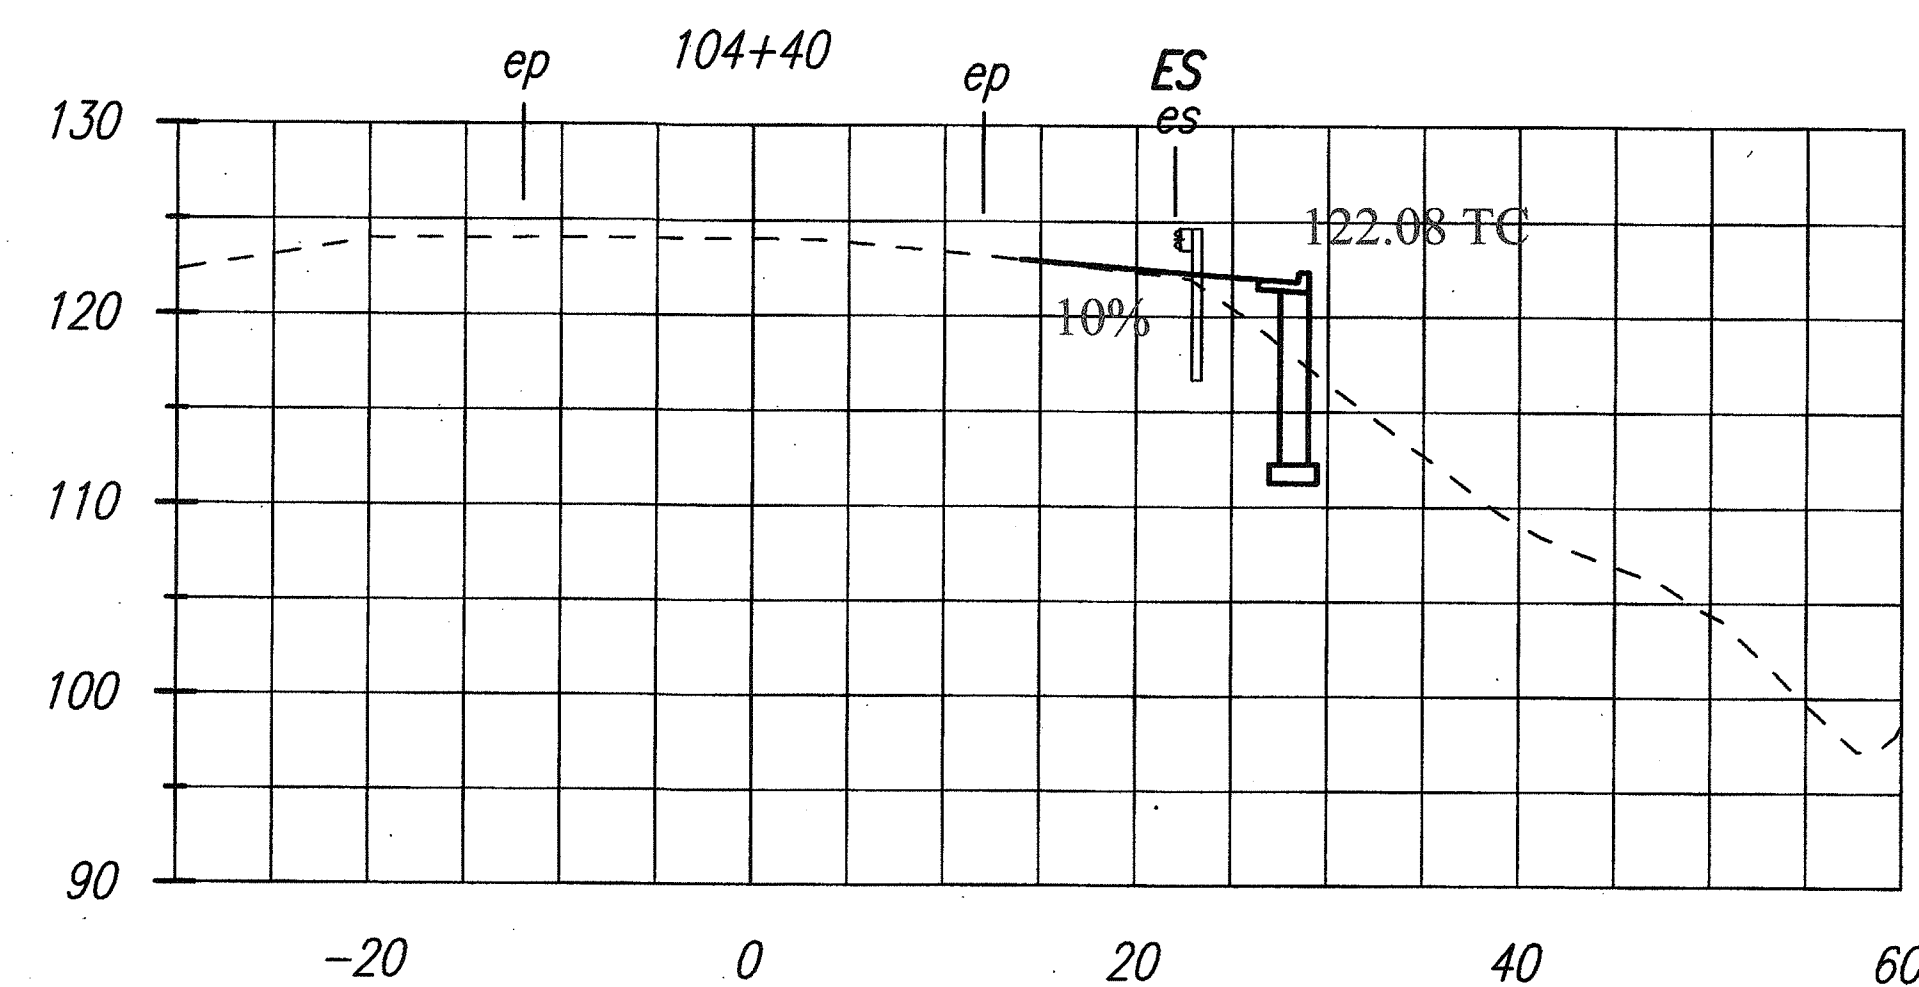


**Note:**  
Soil Anchors are not shown. See the structural drawing for soil anchor details

## MP 12.9 CROSS SECTIONS

Horiz. Scale: 1"=10'  
Vert. Scale: 1"=10'

**LEGEND FOR AS-BUILT POSTINGS**  
 - - - - - Squiggly line for as-built deletion  
 = = = = = Double line for as-built deletion  
 Roadway Text for as-built posting

**AECOM**

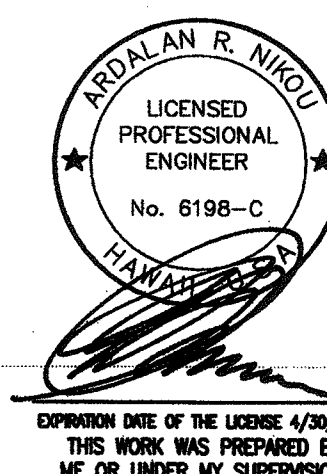

STATE OF HAWAII  
DEPARTMENT OF TRANSPORTATION  
HIGHWAYS DIVISION  
**MP 12.9 CROSS SECTIONS**  
**EMERGENCY EARTHQUAKE ROCKFALL REPAIRS**  
**AT VARIOUS LOCATIONS**  
**F.A. Project No. ER-15(21)**  
Scale: As Noted Date: December, 2009  
SHEET No. 4 OF 4 SHEETS

"AS-BUILT"

