


FED. ROAD DIST. NO.	STATE	FED. AID PROJ. NO.	FISCAL YEAR	SHEET NO.	TOTAL SHEETS
HAWAII	HAW.	ER-15(21)	2010	40	89

TRUE NORTH
SCALE: 1" = 20'

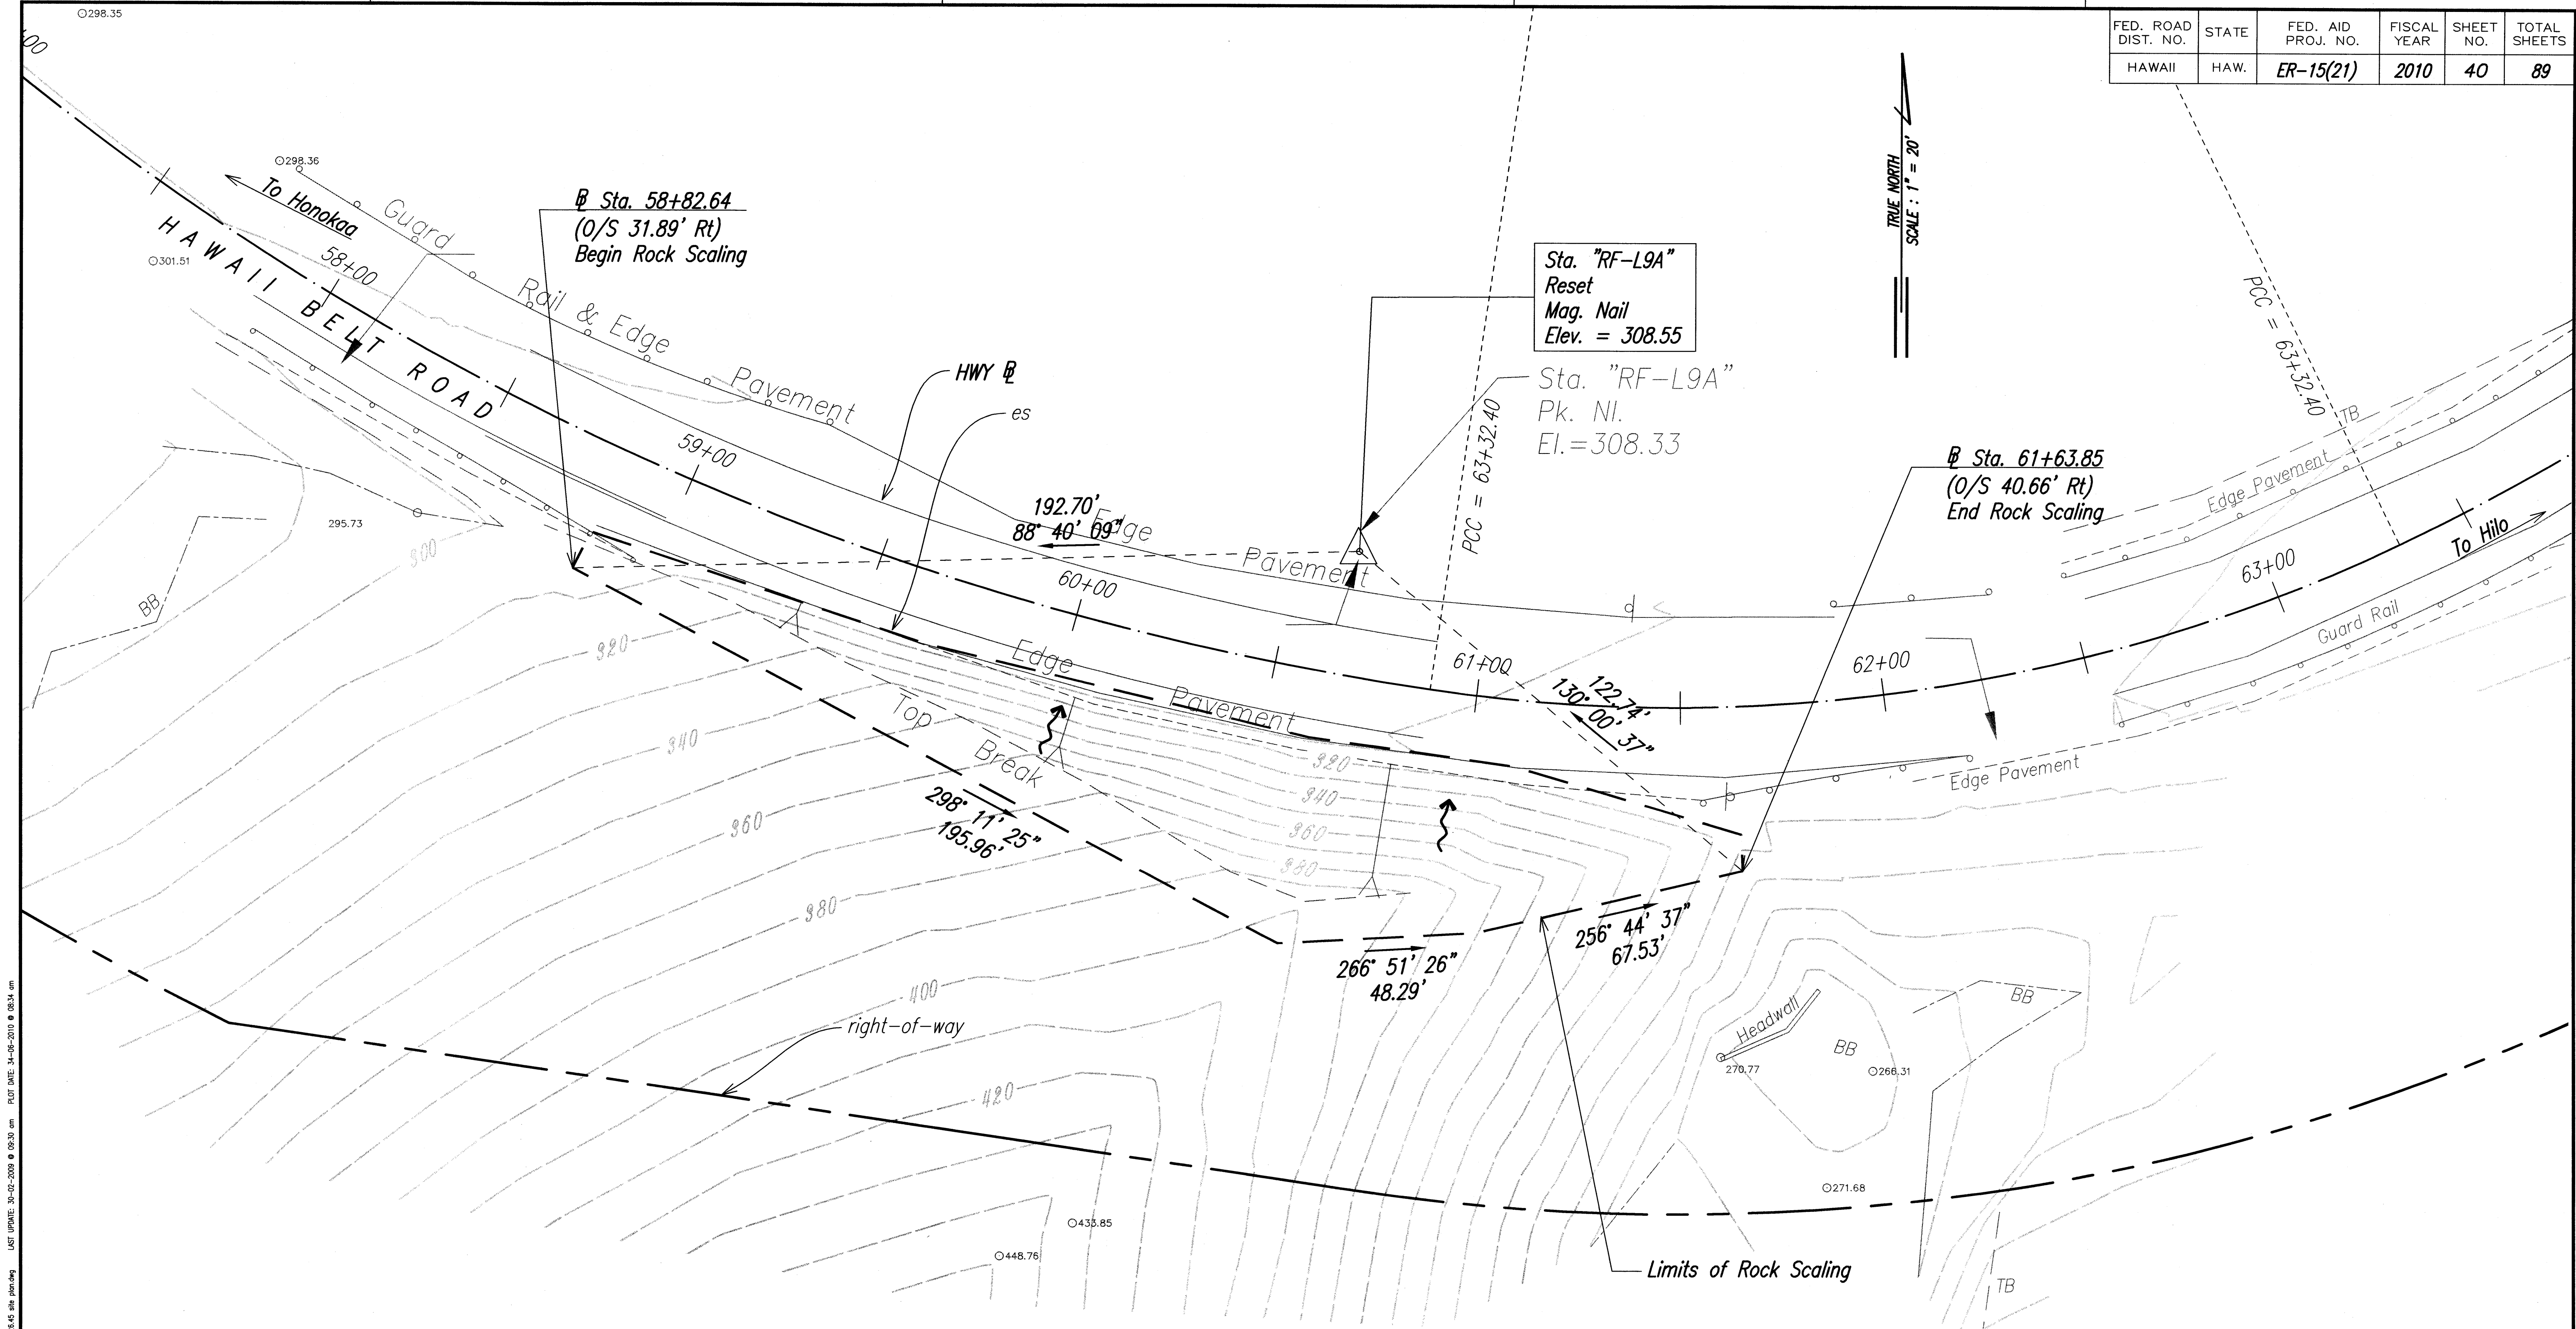

Notes:


1. Rock Scaling Limits are shown in plan view.
2. Provide a general sweep to remove all loose rocks within the rock scaling limits. See notes on Sht. 6.

Legend:

--- Rock Scaling Limits

MP 26.45 SITE PLAN
Scale: 1"=20'

AECOM

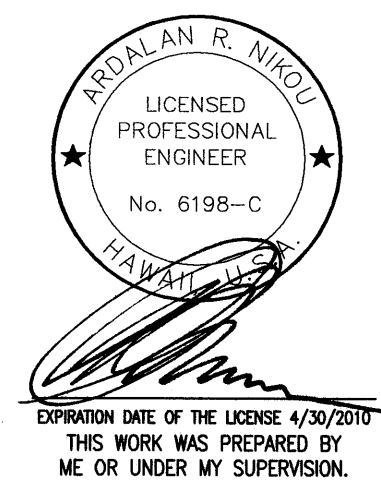

STATE OF HAWAII
DEPARTMENT OF TRANSPORTATION
HIGHWAYS DIVISION

MP 26.45 SITE PLAN
EMERGENCY EARTHQUAKE ROCKFALL REPAIRS
AT VARIOUS LOCATIONS
F.A. Project No. ER-15(21)
Scale: As Noted Date: December, 2009