



FED. ROAD DIST. NO.	STATE	FED. AID PROJ. NO.	FISCAL YEAR	SHEET NO.	TOTAL SHEETS
HAWAII	HAW.	ER-15(21)	2010	52	89

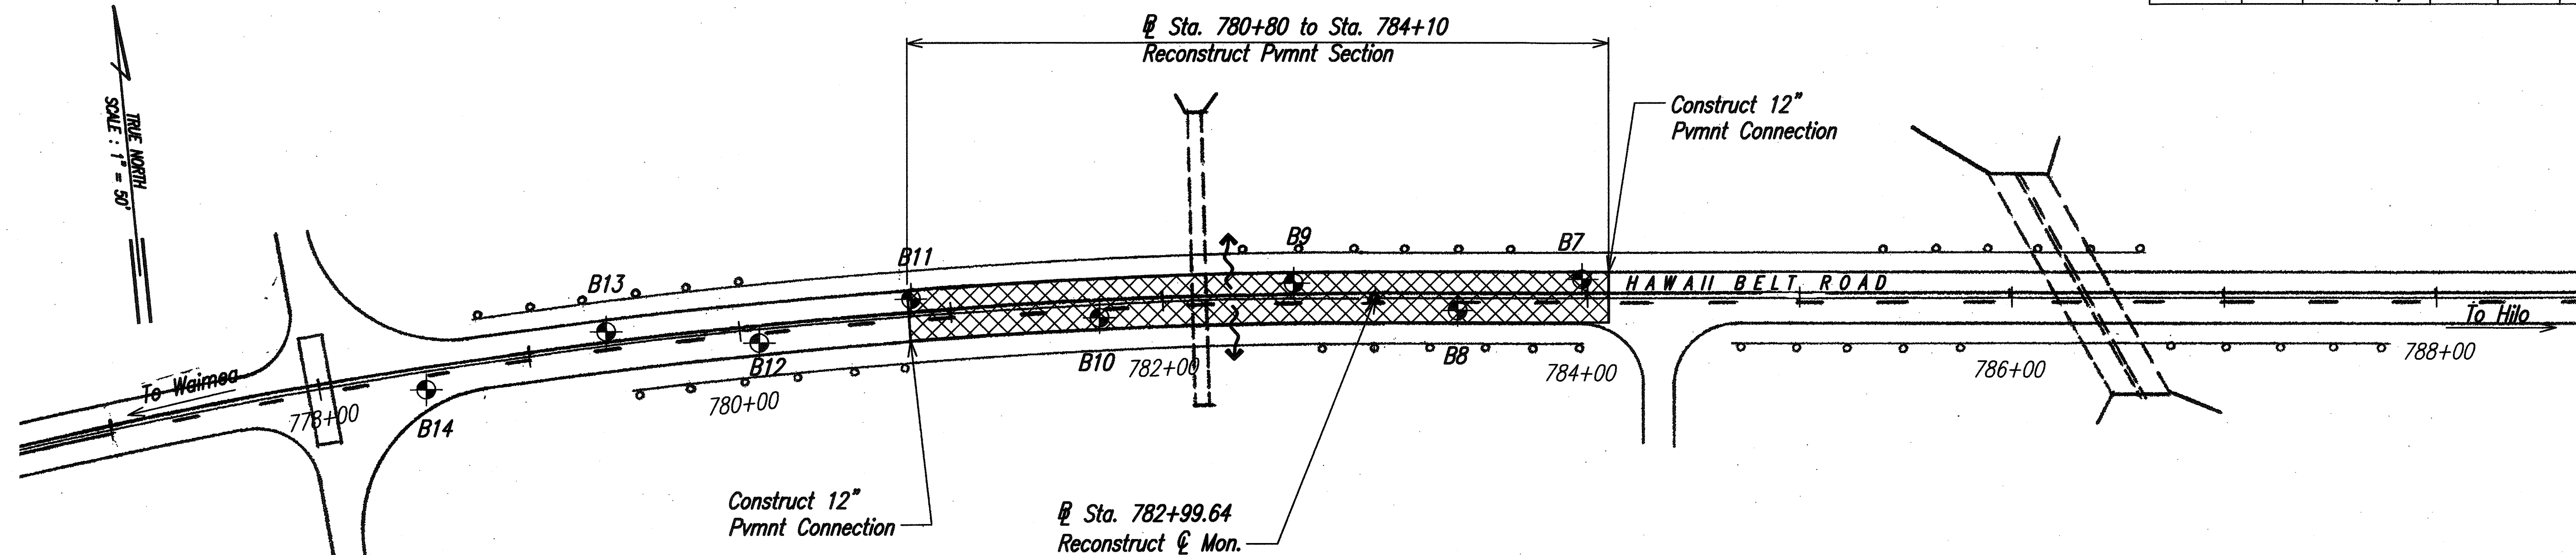


MP 44.9 ROADWAY PLAN
Scale: 1"=40'

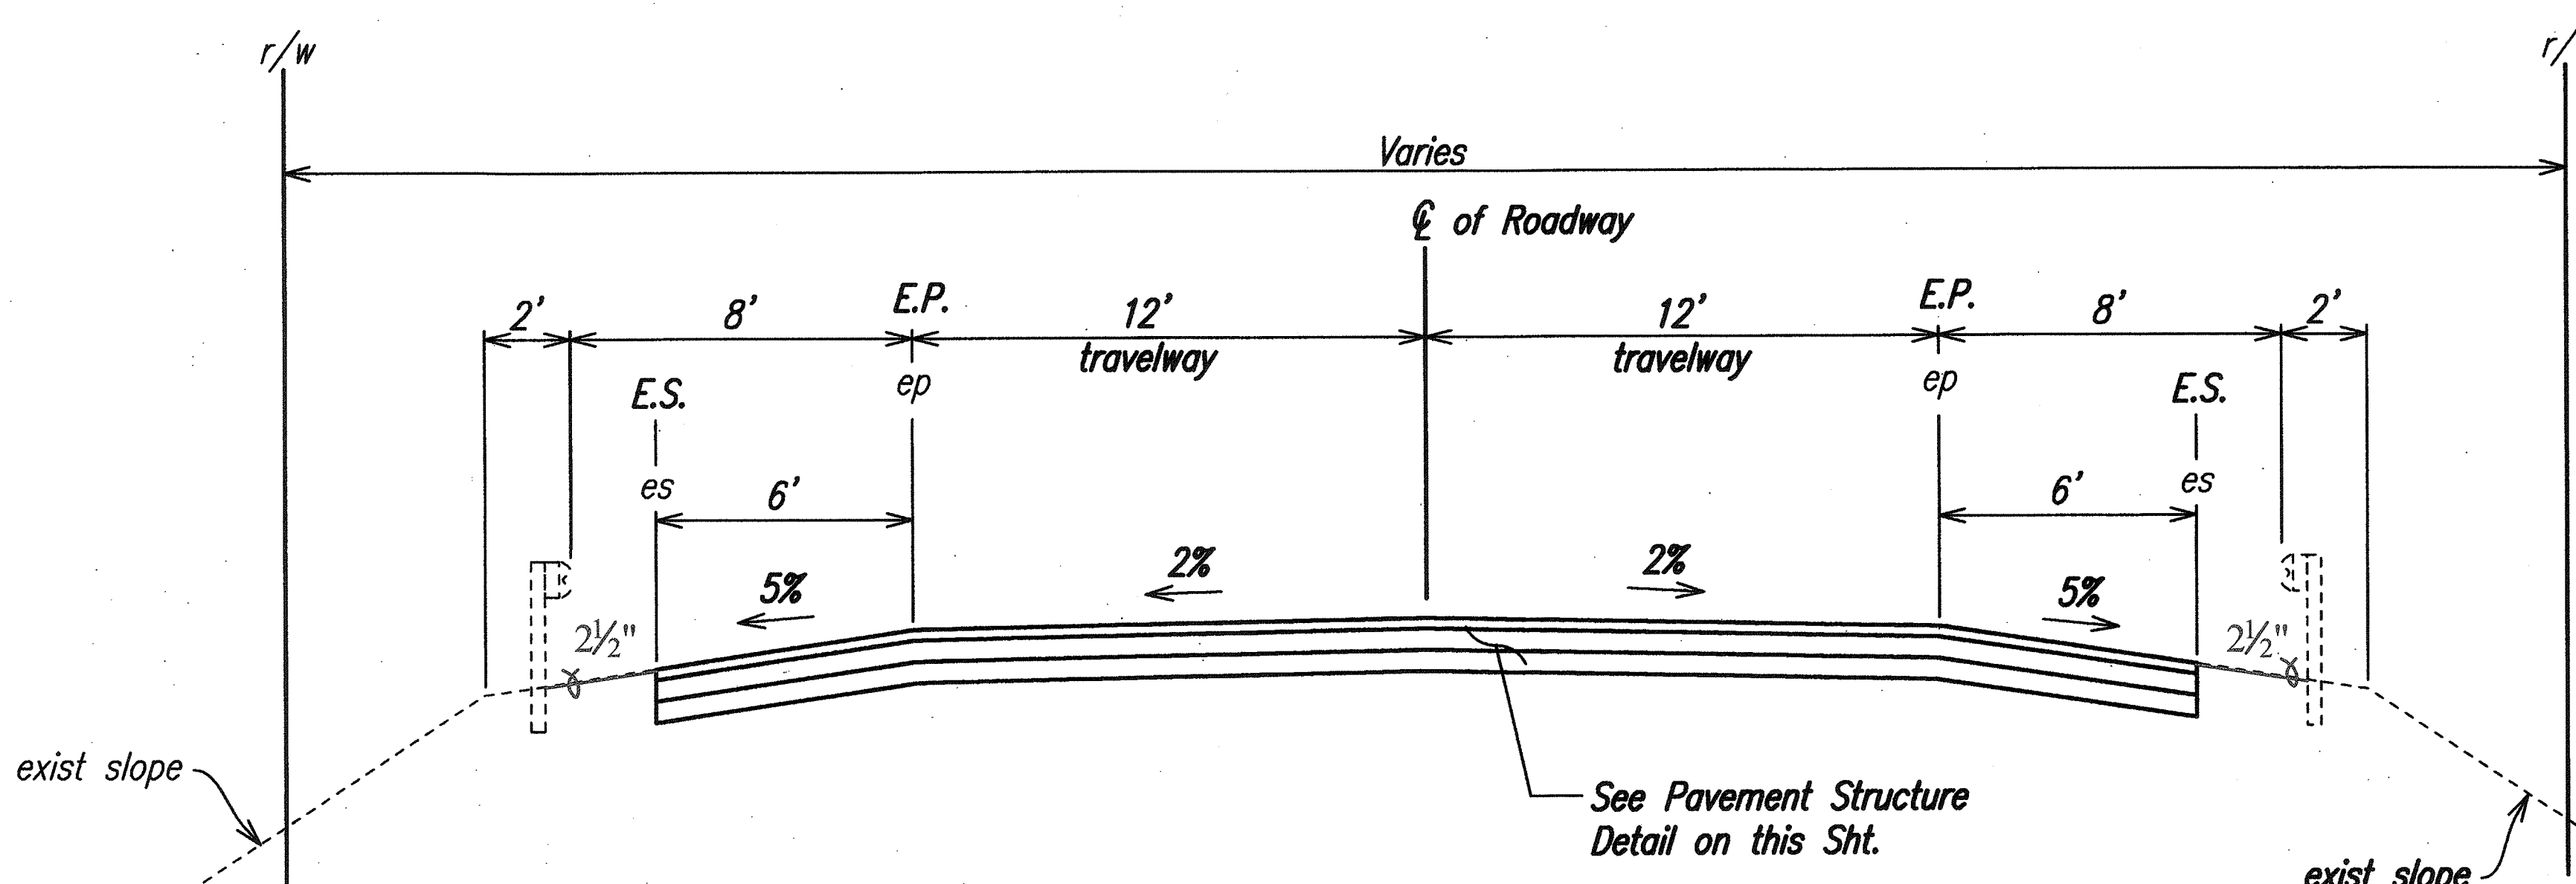

MP 44.9 TYPICAL SECTION
Not To Scale

- Notes:**
- For connection to existing adjacent pavement, see Pavement Connection Detail on sheet 21. This work shall be incidental to Pavement Reconstruction.
 - Prior to placement of geogrid, scarify existing subgrade to 6" deep, moisture condition to slightly above ideal moisture content, compact to 95% Relative Compaction (ASTM D 1557).

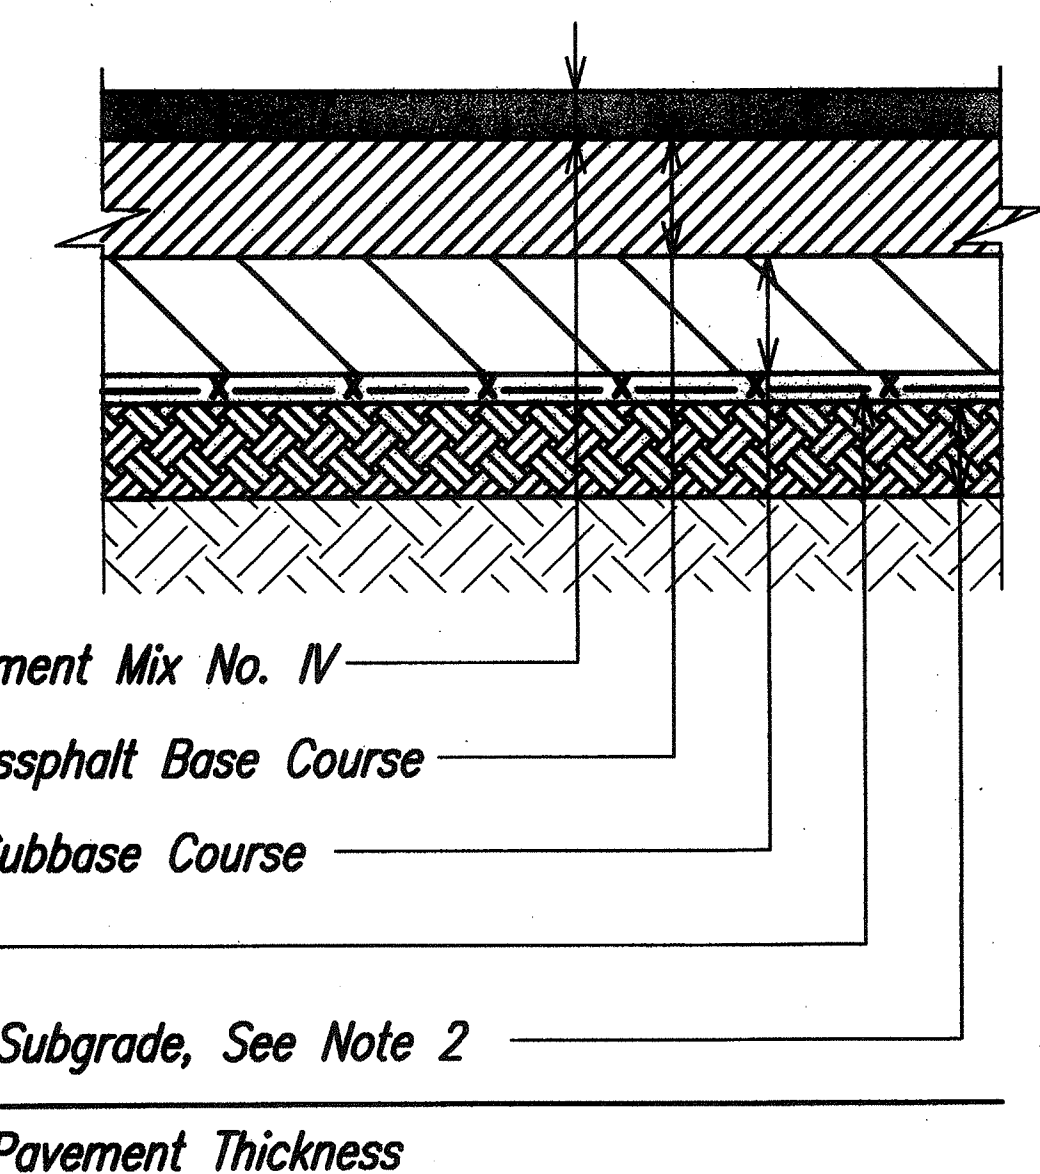

PAVEMENT STRUCTURE
Not To Scale

AECOM

ARULAN R. NIKOL
LICENSED PROFESSIONAL ENGINEER
No. 6198-C
HAWAII

EXPIRATION DATE OF THE LICENSE: 4/30/2010
THIS WORK WAS PREPARED BY ME OR UNDER MY SUPERVISION.

STATE OF HAWAII
DEPARTMENT OF TRANSPORTATION
HIGHWAYS DIVISION

MP 44.9 SITE PLAN & DETAILS

EMERGENCY EARTHQUAKE ROCKFALL REPAIRS
AT VARIOUS LOCATIONS
F.A. Project No. ER-15(21)

Scale: As Noted Date: December, 2009

SHEET No. 1 OF 1 SHEETS

DATE	_____
DESIGNED BY	_____
CHECKED BY	_____
NO.	_____