

6. Geocomposite Drain:

- A. Submit manufacturer's literature and product data for geocomposite drain for Engineer's approval prior to placing the order.
- B. Submit manufacturer's installation instruction for geocomposite drain for Engineer's review and approval.
- C. Geocomposite drains shall be installed to ensure that the drains are hydraulically connected from the top to bottom of the retaining wall.
- D. Geocomposite drains shall be attached to excavation surface by placing geotextile fabric directly against cut surface.
- E. Geocomposite drains shall be placed in strips and connected in accordance with manufacturer's instructions to maintain continuity of flow channel through the drain.
- F. Geocomposite drain strips shall be 2 feet wide and placed as shown in plans.
- G. Geocomposite drain shall be suitably wrapped and protected from exposure to direct sunlight.
- H. If the geotextile cover fabric become damaged during installation by tearing or puncturing, the damaged section shall be completely cut out and replaced. If, in the judgment of the engineer, the damage is not serious enough to warrant removal, the damaged area shall be repaired by overlaying with a piece of fabric, large enough to cover the damaged area and provide a 4 inch overlap on all sides, and taping it in place with 3 inch wide strips of waterproof, plastic tape.
- I. Geocomposite drains shall be protected from damage and deleterious contamination where drains must remain exposed until they are covered with embankment or backfill material.
- J. The cost for all components shall be considered incidental to various structural items. This includes, but not limited to, geocomposite drain strip, filter materials, geotextile fabric, PVC weep holes, and drain grates.

5. Concrete:


- A. Concrete shall be regular weight hard rock concrete and shall have a minimum 28-day compressive strength of 4000 psi.
- B. All inserts, anchor bolts, plates, etc. embedded in concrete shall be hot-dip galvanized unless otherwise noted.
- C. Conduits, pipes, and sleeves passing through a wall not conforming to typical details shall be located and submitted to the Engineer for approval.
- D. Construction joints may be located by the Contractor and submitted to the Engineer for approval. Construction joints shall be made and located as not to impair the strength of the structure and to minimize shrinkage stresses. All construction joints shall be cleaned, laitance removed and wetted. See typical details for specific requirements.
- E. Non-shrink grout shall be a premixed compound consisting of non-staining, non-metallic aggregate, cement, water reducing and plasticizing agents capable of developing minimum compressive strength of 4,000 psi in 3 days and 7,000 psi in 28 days.
- F. Unless otherwise noted, chamfer all concrete edges 3/4".
- G. Concrete delivery tickets shall record all free water in the mix: at batching by plant, for consistency by driver, and any additional request by Contractor if permitted by the mix design.
- H. Reinforcing bars, anchor bolts, inserts and other items to be cast in the concrete shall be secured in position prior to placement of concrete.

3. Foundation:

- A. *Retaining system design values are based on geotechnical investigations by Hirata and Associates, dated July 24, 2009.*
- B. *Contractor shall provide for design and installation of all cribbing, sheefing, and shoring necessary for personnel safety and to preserve excavations and earth banks, and adjacent structures and property for damage.*
- C. *Excavation boundaries and grade elevations for footing shall be approved by the Engineer prior to placing the concrete and reinforcing.*
- D. *Fill and backfill shall consist of non-expansive granular material such as crushed coral or basalt. The select granular fill shall be well graded from coarse to fine with no particles larger than 3 inches in largest dimension. The material also shall contain less than 15 percent particles passing the No. 200 sieve. The material shall have a laboratory CBR value of 25 or more and shall have a maximum swell value of 1 percent or less.*

ORIGINAL PLAN	SURVEY PLOTTED BY	DATE
	DRAWN BY	<i>R. Yamanoto</i>
	TRACED BY	
	DESIGNED BY	<i>L. Chan</i>
	QUANTITIES BY	<i>L. Chan</i>
	CHECKED BY	<i>L. Chan</i>
NO.		

PATH/FILENAME: C:\Documents and Settings\jaramoncho\local settings\tempo\AcP\ajinh_5592\2234_S-1.dwg
LAST UPDATE: 21-08-2010 @ 10:21 am
PLOT DATE: 22-08-2010 @ 10:22 am

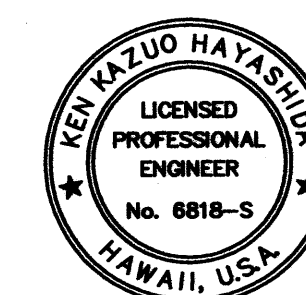

EXPIRATION DATE OF THE LICENSE 4/30/2010
THIS WORK WAS PREPARED BY
ME OR UNDER MY SUPERVISION.

STATE OF HAWAII
DEPARTMENT OF TRANSPORTATION
HIGHWAYS DIVISION


STRUCTURAL GENERAL NOTES

EMERGENCY EARTHQUAKE ROCKFALL REPAIRS
AT VARIOUS LOCATIONS
F.A. Project No. ER-15(21)

Scale: As Noted Date: December, 2009

SHEET No. 5-1 OF 9 SHEETS


Minimum Splice and Development Lengths					
Bar Size	Concrete Strength = 4,000 PSI				
	Lap Splice		Development		
	Top Bars	Other Bars	Straight Top Bars	Other Bars	with Standard Hook
#3	26"	20"	20"	16"	8"
#4	34"	26"	26"	20"	10"
#5	42"	32"	32"	24"	12"
#6	50"	38"	38"	30"	16"
#7	72"	54"	54"	42"	18"
#8	82"	62"	62"	48"	20"

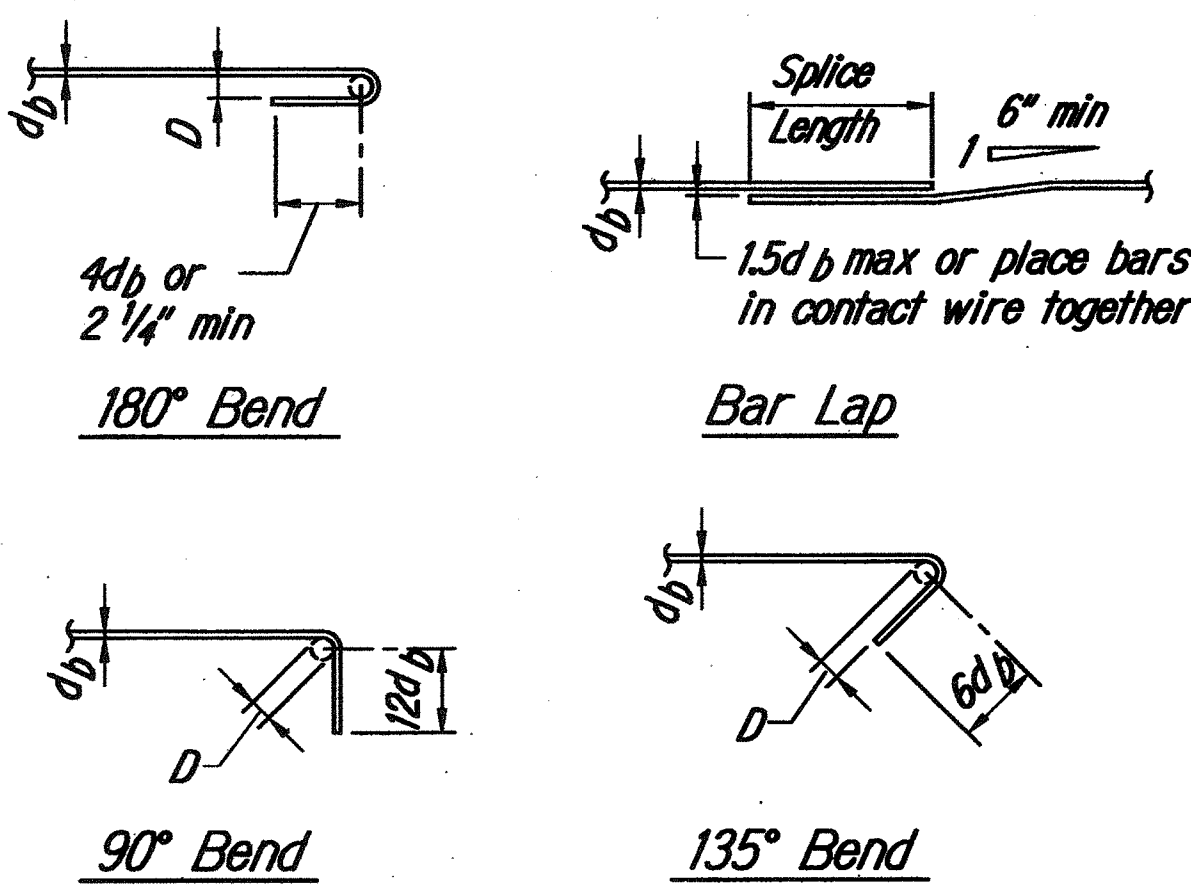


- Notes:
- Lengths are for concrete with rebar space 6 bar diameters minimum. Increase 25% for bars spaced less than 6 bar diameters.
 - "Top Bars" are horizontal bars with 12" or more of concrete cast below.

$$D = 6db$$


TYPICAL REBAR SPLICE AND EMBEDMENT LENGTH SCHEDULE
Not to Scale

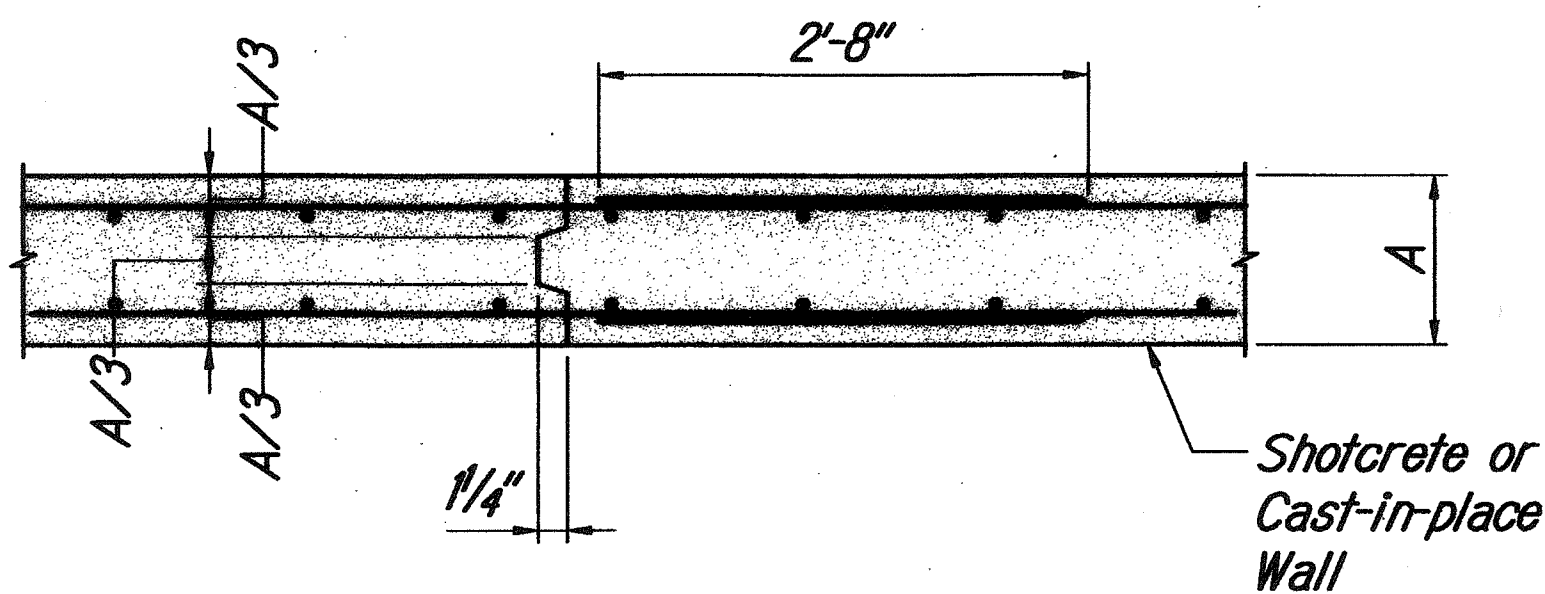


TYPICAL WALL CONSTRUCTION JOINT DETAIL
Not to Scale

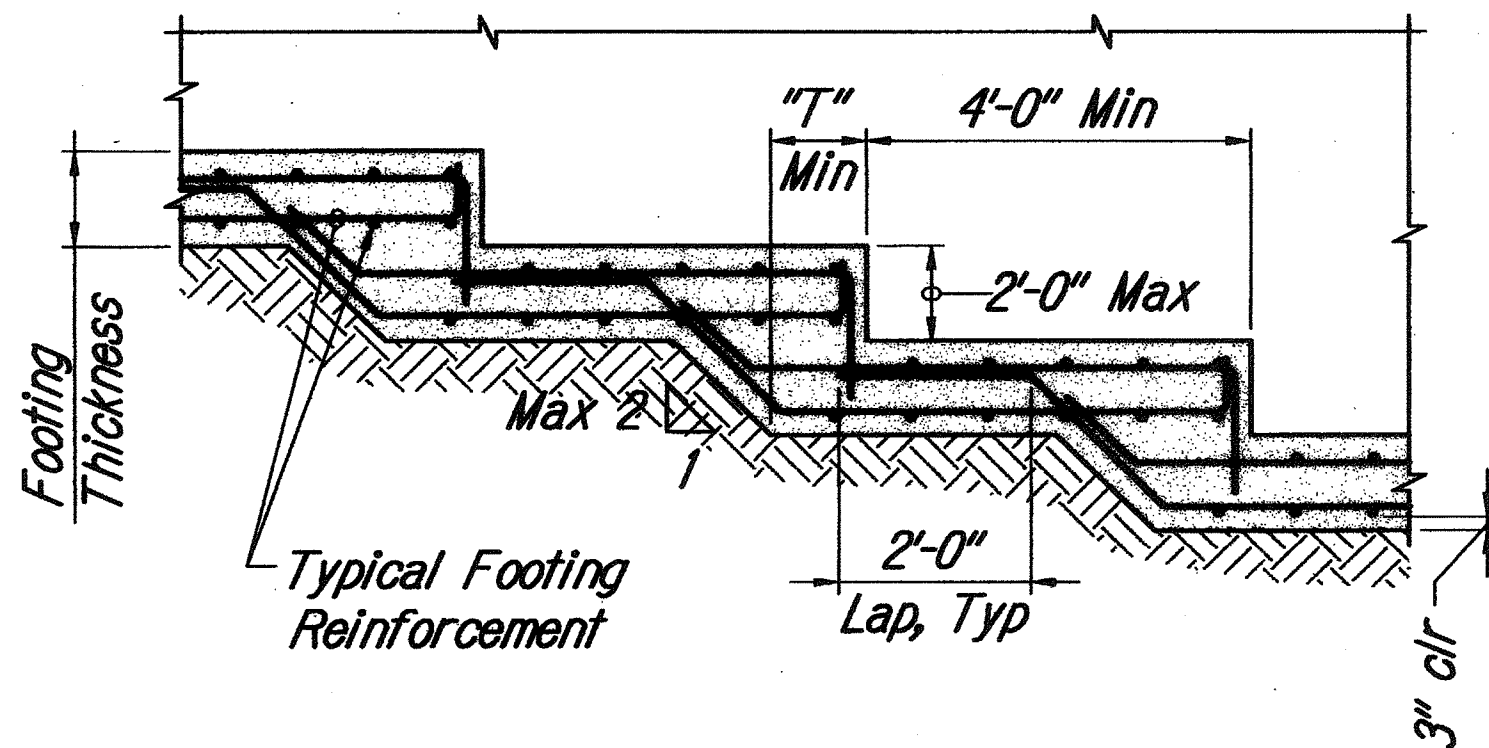


STEPPED FOOTING DETAIL
Not to Scale

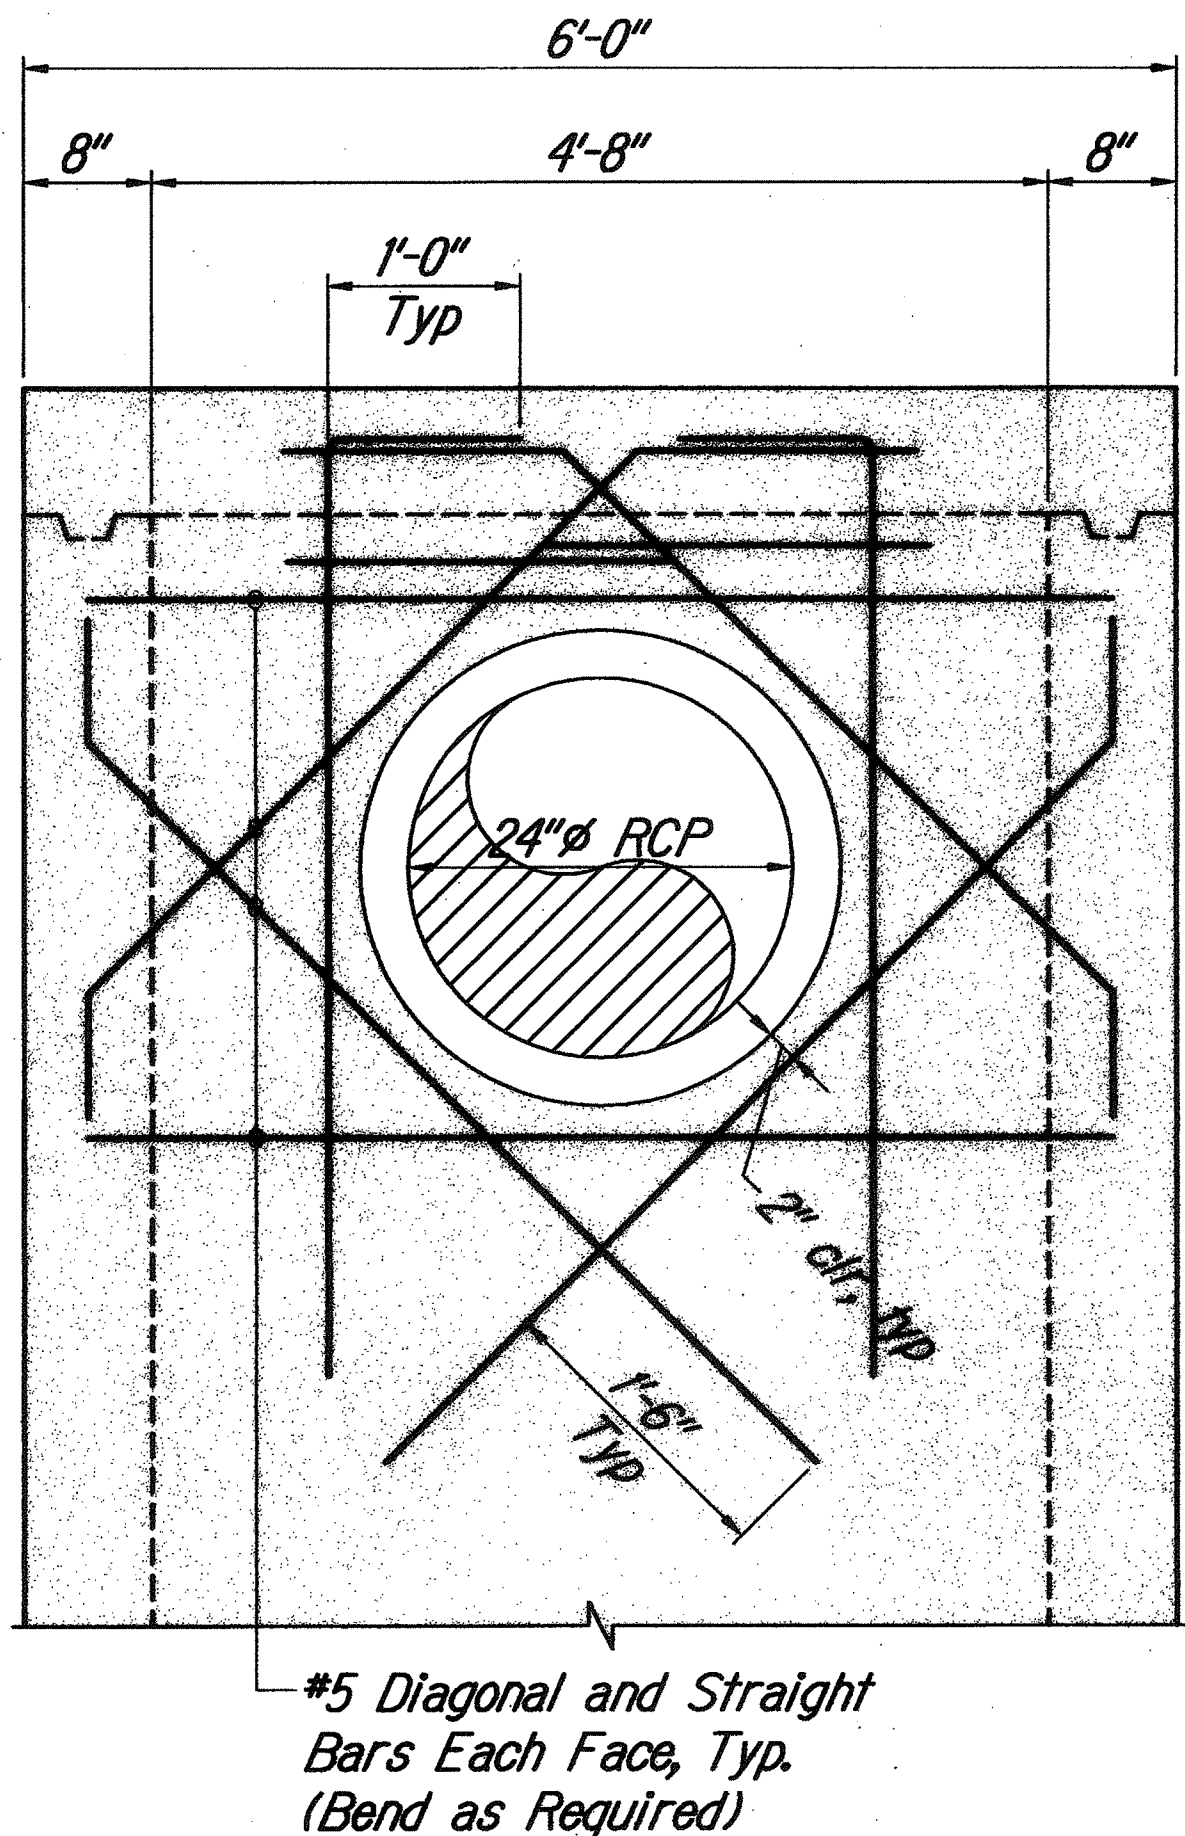

PIPE PENETRATION DETAIL
Not to Scale

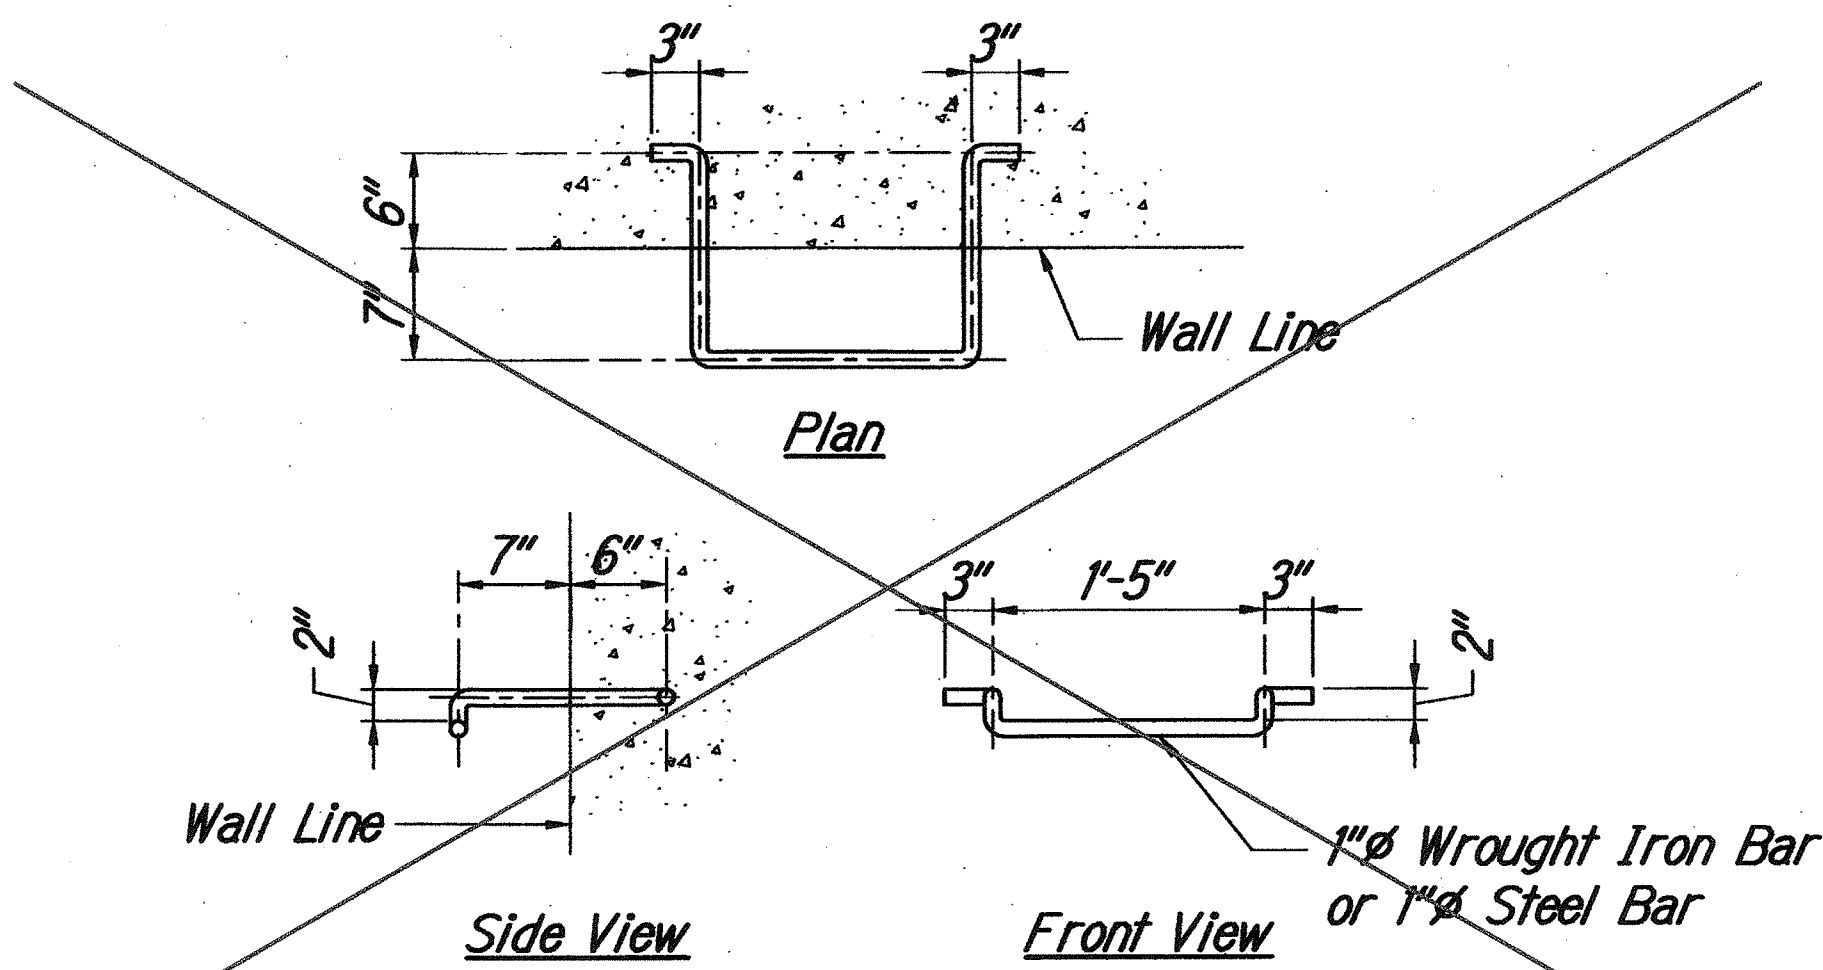

RUNG DETAIL
Not to Scale

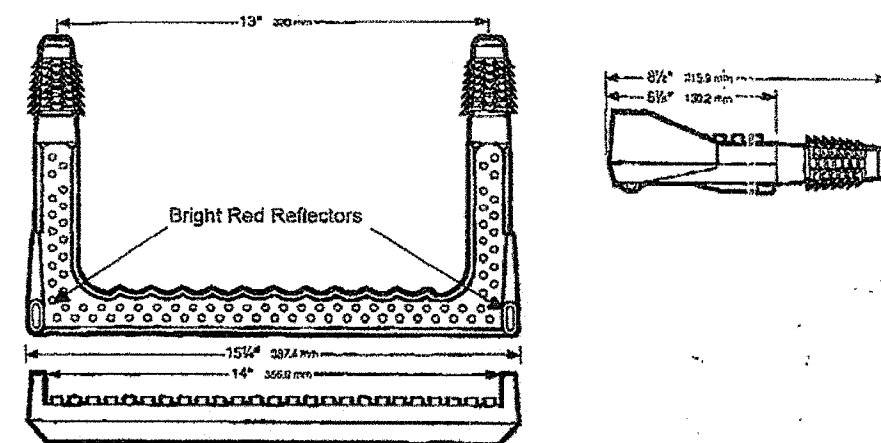

SPECIFICATIONS
All Lane Poly Steps meet the requirements of ASTM C-478 and AASHTO M-199. The polypropylene conforms to ASTM D-4101. The 1/2" Grade 60 deformed reinforcing bar meets ASTM A-615.


LANE POLYPROPYLENE MANHOLE STEPS

LANE INTERNATIONAL CORPORATION

P.O. Box 925 • 18067 S.W. Lower Beeson Ferry Rd. • Tualatin, OR 97062 • 503-684-0077 • 800-666-0076
Fax 503-684-0075 • www.laneinternational.com

LEGEND FOR AS-BUILT POSTINGS

- Squiggly line for as-built deletion
- Double line for as-built deletion
- Text for as-built posting

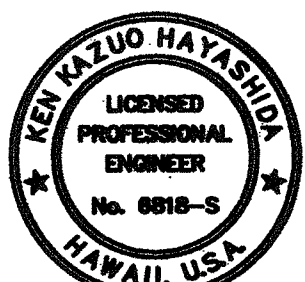

THIS WORK WAS PREPARED BY ME OR UNDER MY SUPERVISION.
DATE OF THE DESIGN: 4/20/2010

STATE OF HAWAII
DEPARTMENT OF TRANSPORTATION
HIGHWAYS DIVISION


TYPICAL DETAILS
EMERGENCY EARTHQUAKE ROCKFALL REPAIRS
AT VARIOUS LOCATIONS
F.A. Project No. ER-15(21)

Scale: As Noted Date: December, 2009

SHEET No. 5-2 OF 9 SHEETS

"AS-BUILT"


FED. ROAD DIST. NO.	STATE	FED. AID PROJ. NO.	FISCAL YEAR	SHEET NO.	TOTAL SHEETS
HAWAII	HAW.	ER-15(21)	2010	83	89

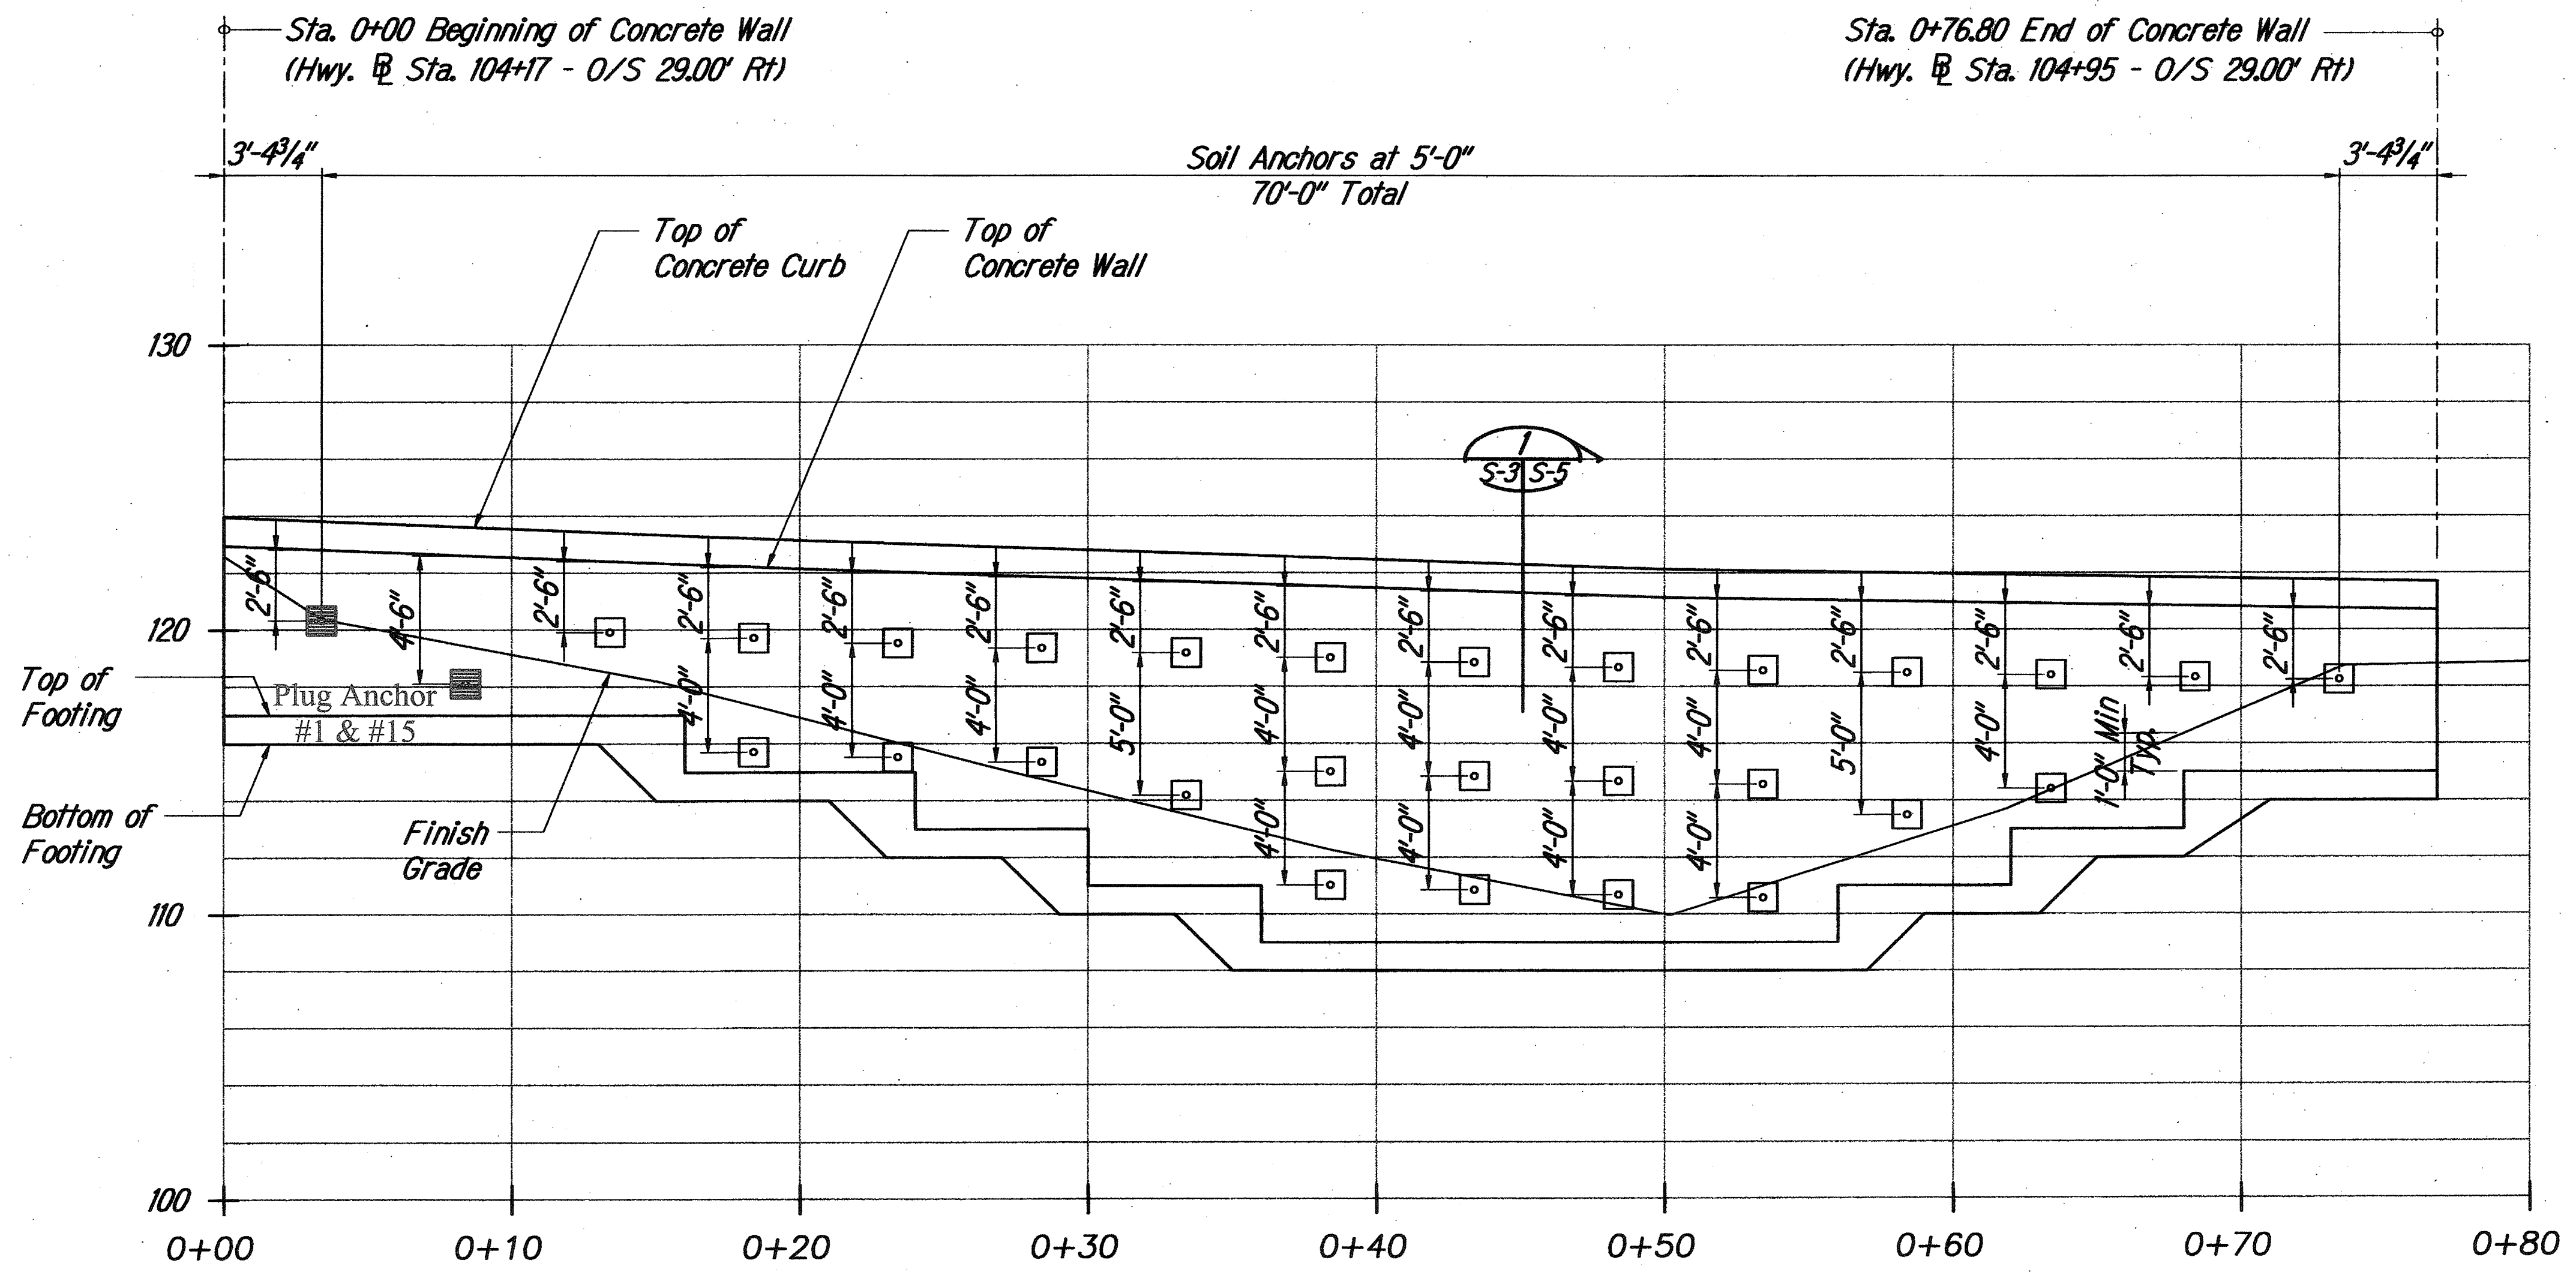

MP 12.9 ELEVATION (STATIONS ALONG FACE OF WALL)
Scale: 1/4" = 1'-0"

ORIGINAL SURVEY PLOTTED BY	DATE
DRAIN BY	8/20/06
DESIGNED BY	
CHECKED BY	
NO.	


LEGEND FOR AS-BUILT POSTINGS	
	Squiggly line for as-built deletion
	Double line for as-built deletion
	Roadway Text for as-built posting

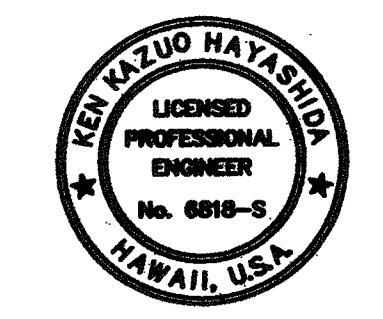

STATE OF HAWAII
DEPARTMENT OF TRANSPORTATION
HIGHWAYS DIVISION
MP 12.9 CONCRETE RETAINING WALL ELEVATION
EMERGENCY EARTHQUAKE ROCKFALL REPAIRS
AT VARIOUS LOCATIONS
F.A. Project No. ER-15(21)
Scale: As Noted Date: December, 2009
SHEET No. 5-3 OF 9 SHEETS

"AS-BUILT"


FED. ROAD DIST. NO.	STATE	FED. AID PROJ. NO.	FISCAL YEAR	SHEET NO.	TOTAL SHEETS
HAWAII	HAW.	ER-15(21)	2010	84	89

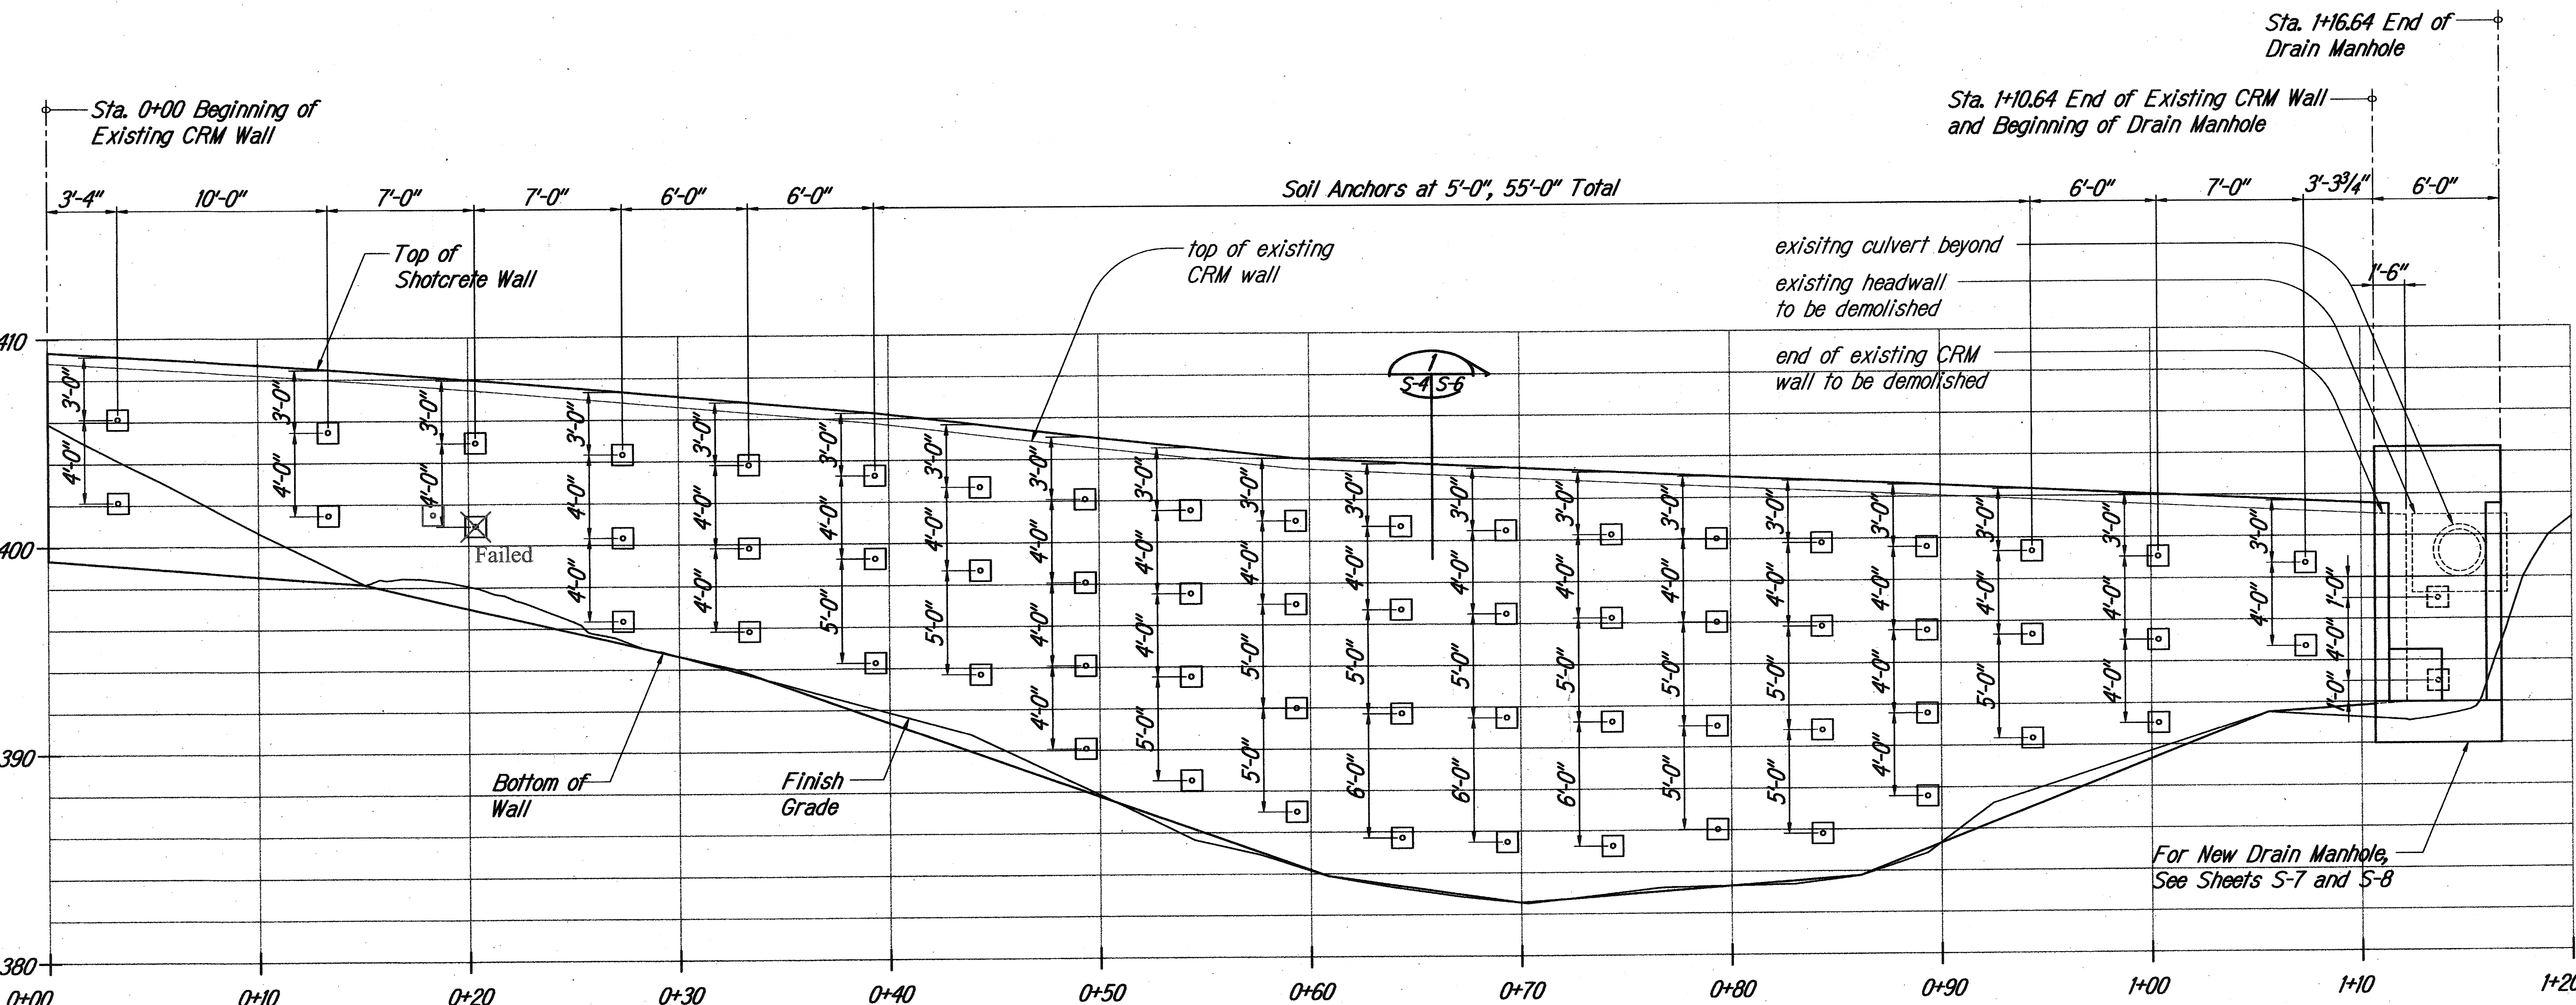


MP 26.1 ELEVATION (STATIONS ALONG FACE OF WALL)
Scale: 1/4" = 1'-0"

$$\frac{1}{S-4 \mid S-4}$$


LEGEND FOR AS-BUILT POSTINGS

	Squiggly line for as-built deletion
100.00	Double line for as-built deletion
Roadway	Text for as-built posting

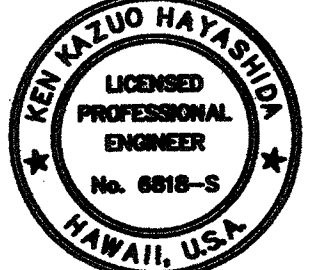



STATE OF HAWAII
DEPARTMENT OF TRANSPORTATION
HIGHWAYS DIVISION
MP 26.1 SHOTCRETE
RETAINING WALL ELEVATION
EMERGENCY EARTHQUAKE ROCKFALL REPAIRS
AT VARIOUS LOCATIONS
F.A. Project No. ER-15(21)
Scale: As Noted Date: December, 2001
SHEET NO. 54 OF 9 SHEETS

FED. ROAD DIST. NO.	STATE	FED. AID PROJ. NO.	FISCAL YEAR	SHEET NO.	TOTAL SHEETS
HAWAII	HAW.	ER-15(21)	2010	85	89

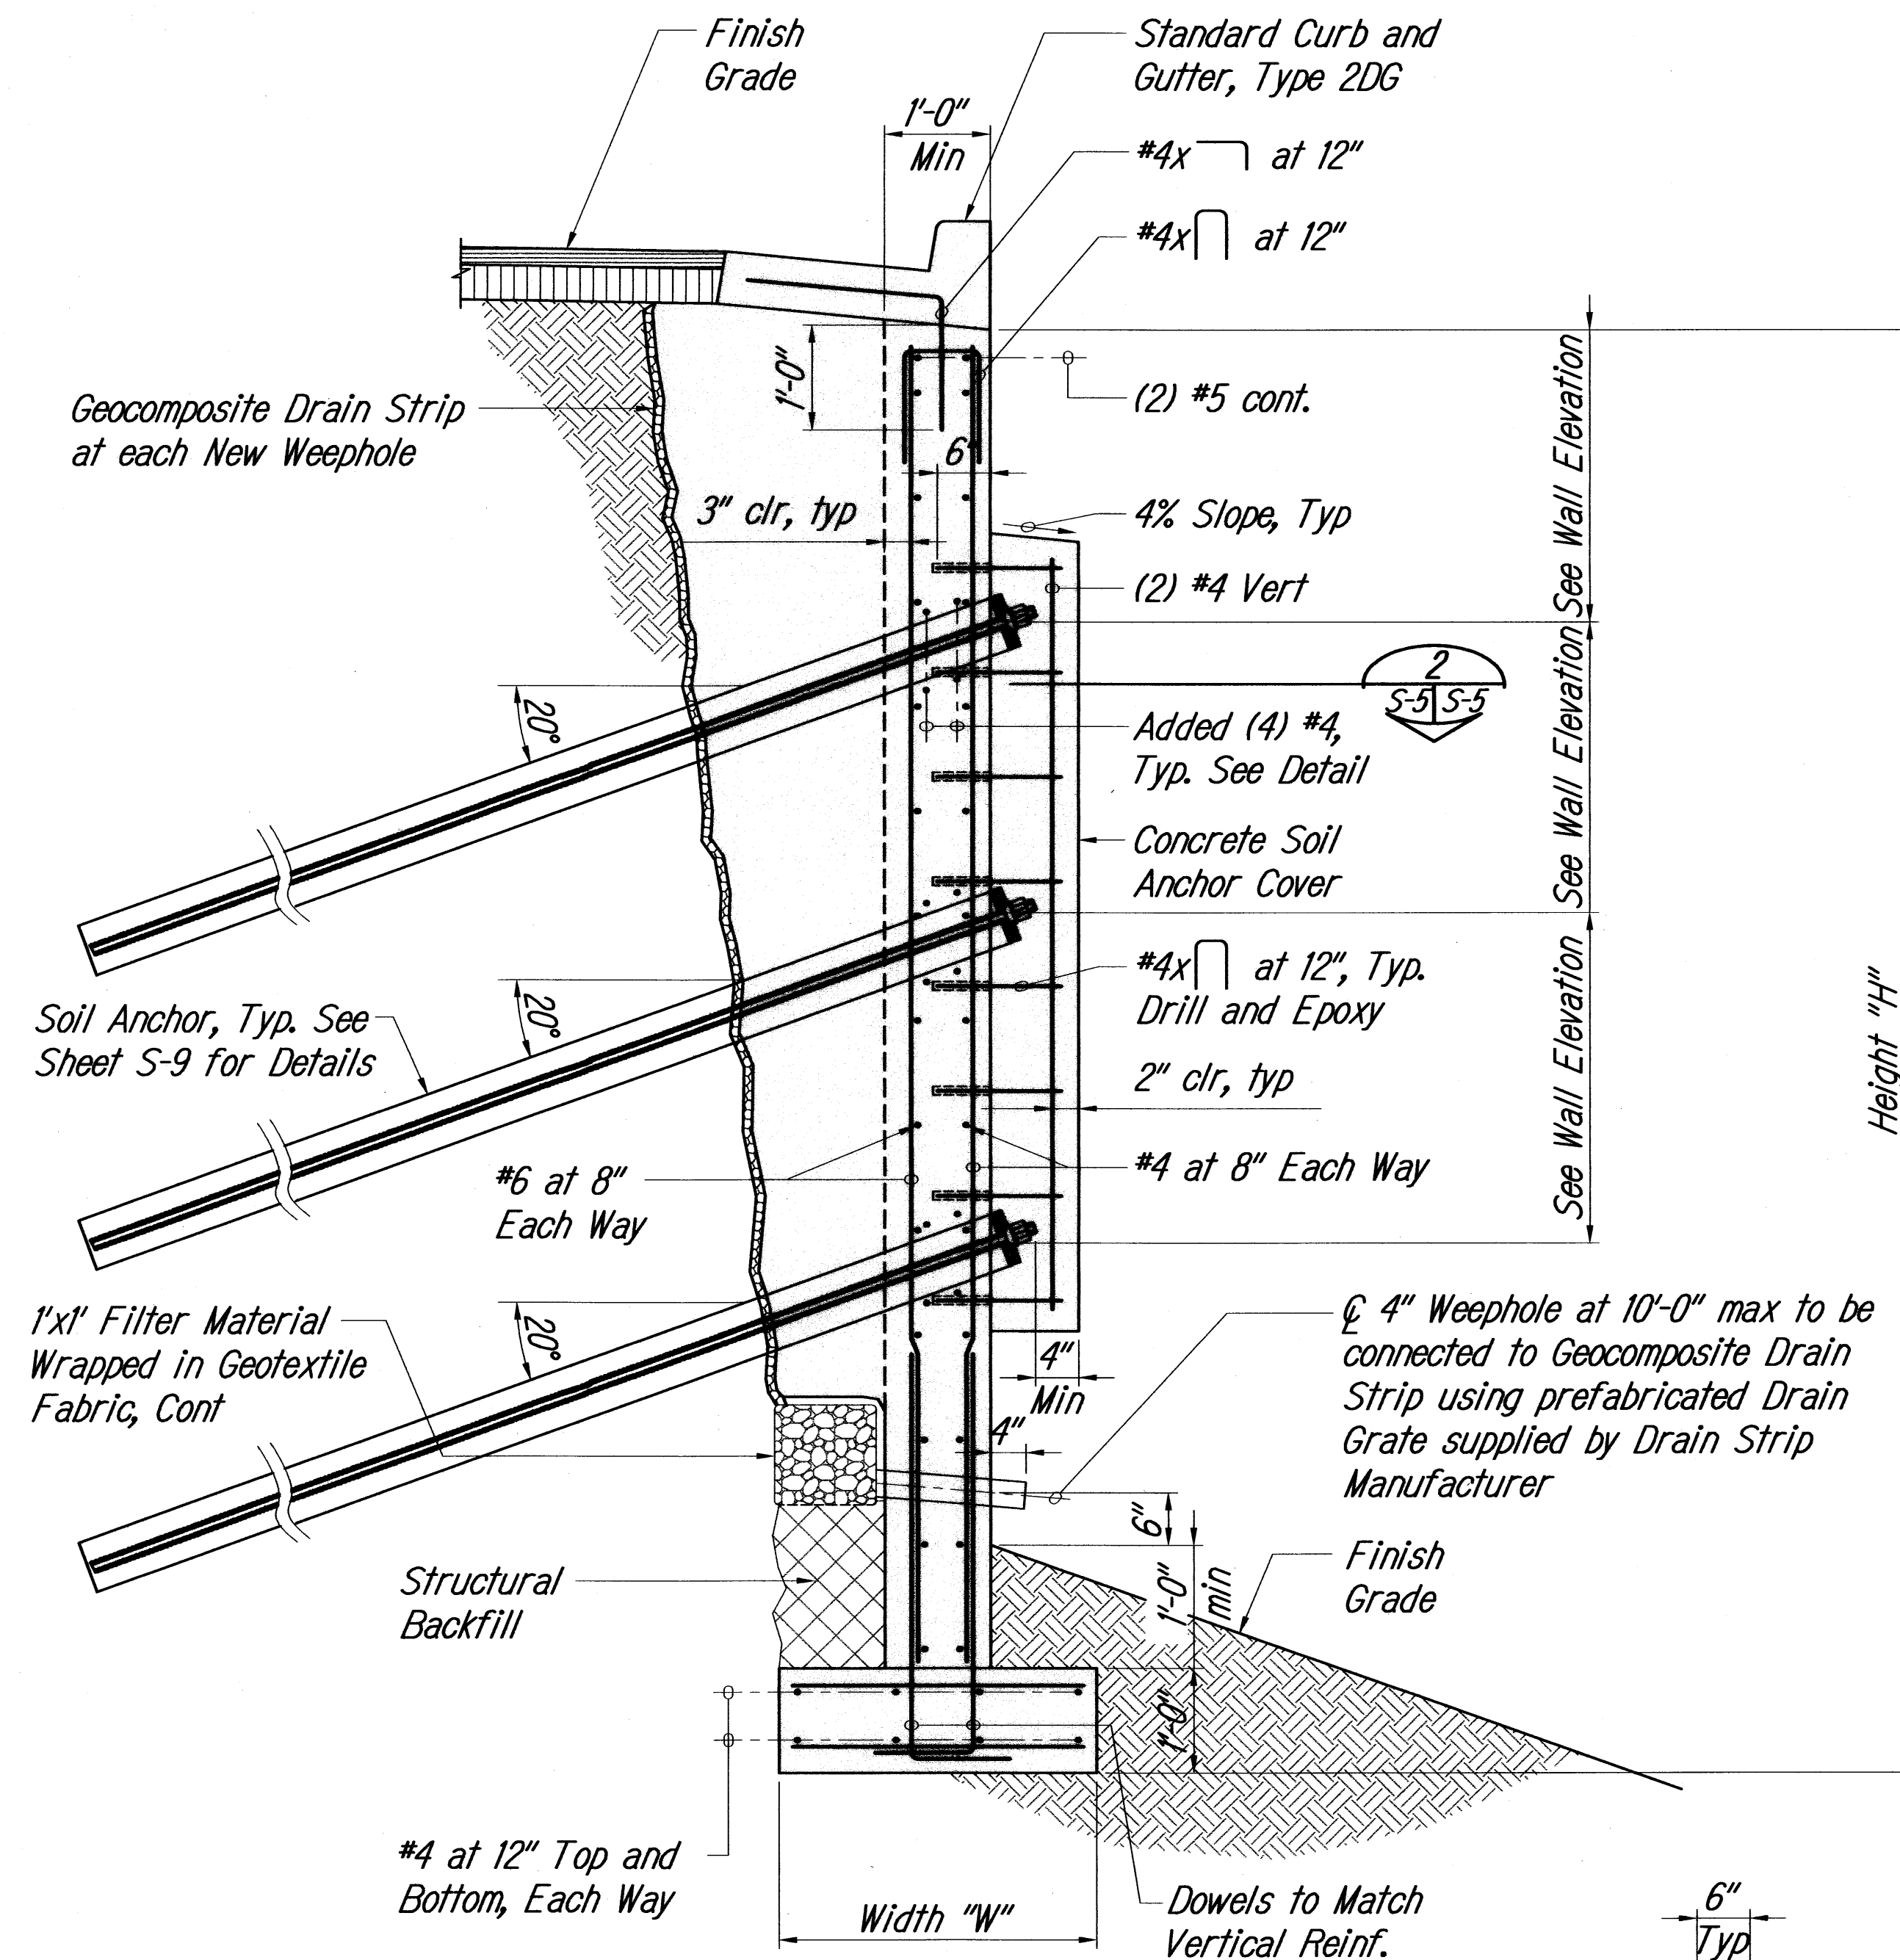

RETAINING WALL SCHEDULE	
HEIGHT "H"	"W"
≤ 14'-0"	3'-0"
≤ 12'-0"	2'-6"
≤ 10'-0"	2'-0"

CONCRETE RETAINING SYSTEM SECTION AT MP 12.9
Scale: $3/4" = 1'-0"$

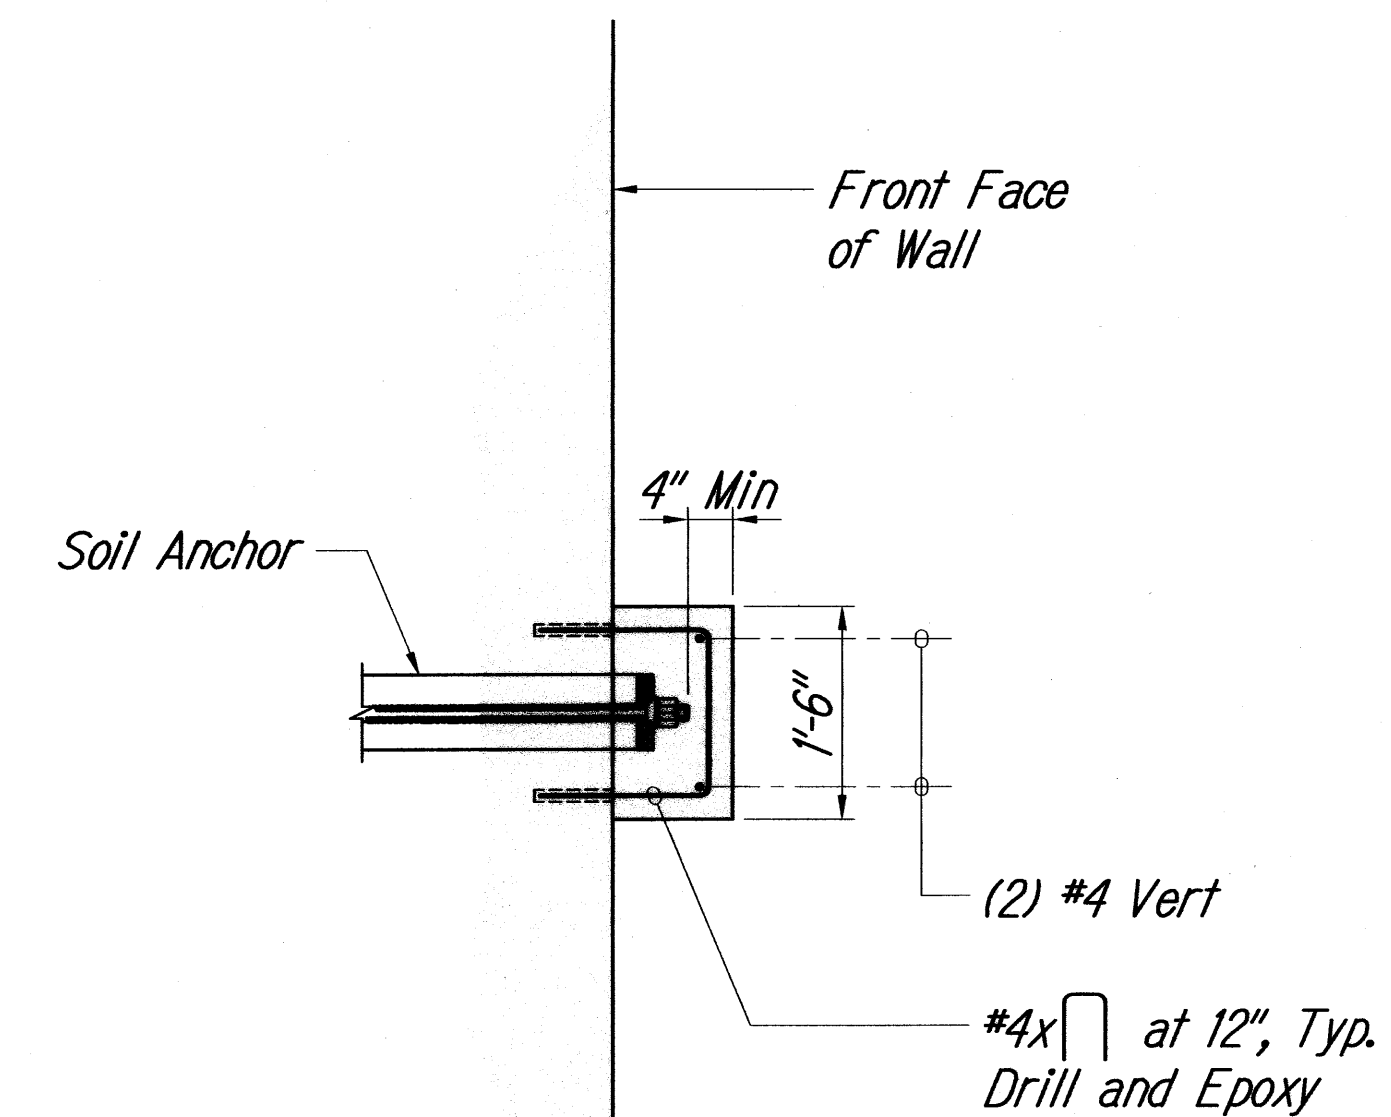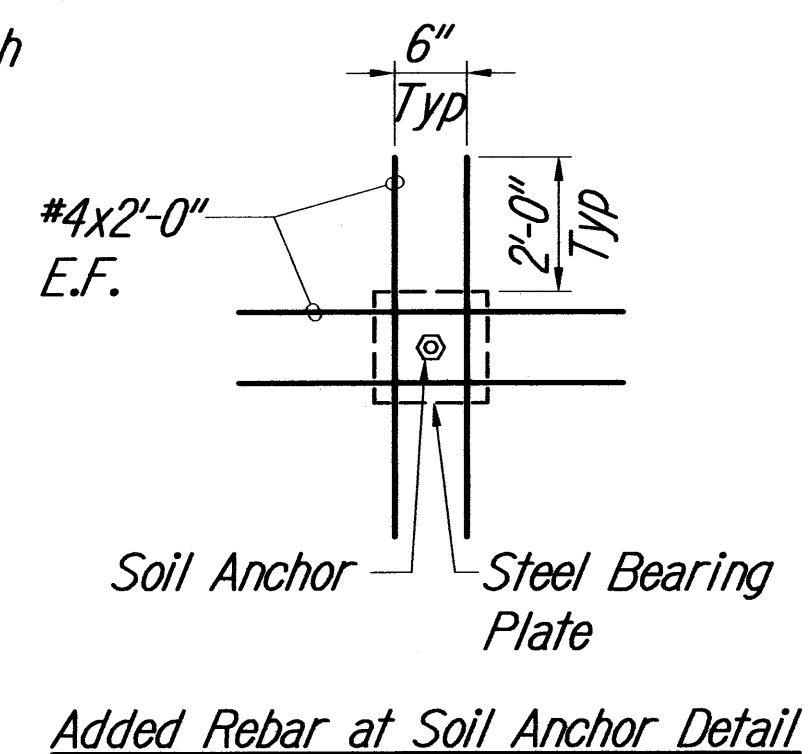


Note:
Soil Anchor Covers shall be considered
incidental to Item No. 512.0100 Soil Anchor.


SECTION
Scale: $3/4" = 1'-0"$

$$\frac{2}{s-5 \mid s-5}$$

ORIGINAL PLAN	SURVEY PLOTTED BY	DATE
	DRAWN BY	"
	DESIGNED BY	"
	QUANTITIES BY	"
	CHECKED BY	"

PATH/FI ENAME: P:\Drafting\2010-01-05 2234\2234 S-5.dwg


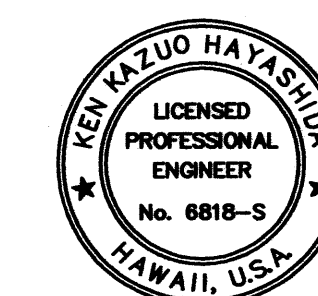



 EXPIRATION DATE OF THE LICENSE 4/30/2010
 THIS WORK WAS PREPARED BY
 ME OR UNDER MY SUPERVISION.

STATE OF HAWAII
DEPARTMENT OF TRANSPORTATION
HIGHWAYS DIVISION
CONCRETE RETAINING
WALL SECTIONS
EMERGENCY EARTHQUAKE ROCKFALL REPAIRS
AT VARIOUS LOCATIONS
F.A. Project No. ER-15(21)
Scale: As Noted Date: December, 2009
SHEET No. 5-5 OF 9 SHEETS


FED. ROAD DIST. NO.	STATE	FED. AID PROJ. NO.	FISCAL YEAR	SHEET NO.	TOTAL SHEETS
HAWAII	HAW.	ER-15(21)	2010	86	89

- Notes:
- Shotcrete concrete shall have 4,000 psi compressive strength at 28 days.
 - Contractor shall remove loose concrete and all other bond inhibiting material from face of CRM walls before applying Shotcrete.
 - Weephole pipes shall be placed inline with the existing weepholes before placement of Shotcrete.
 - See Civil Drawings for limits of clearing and grubbing.

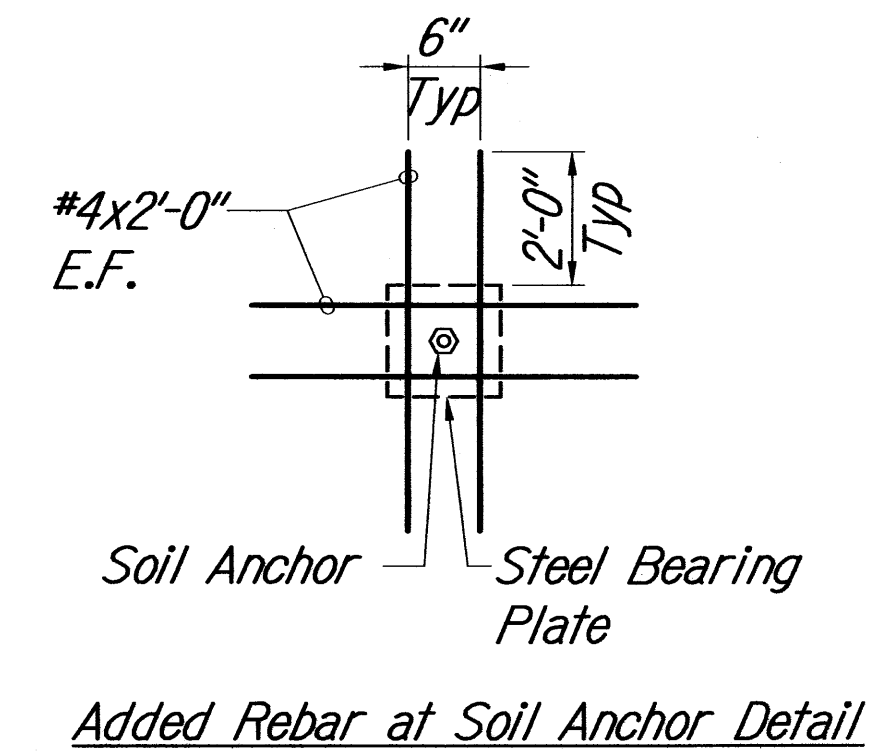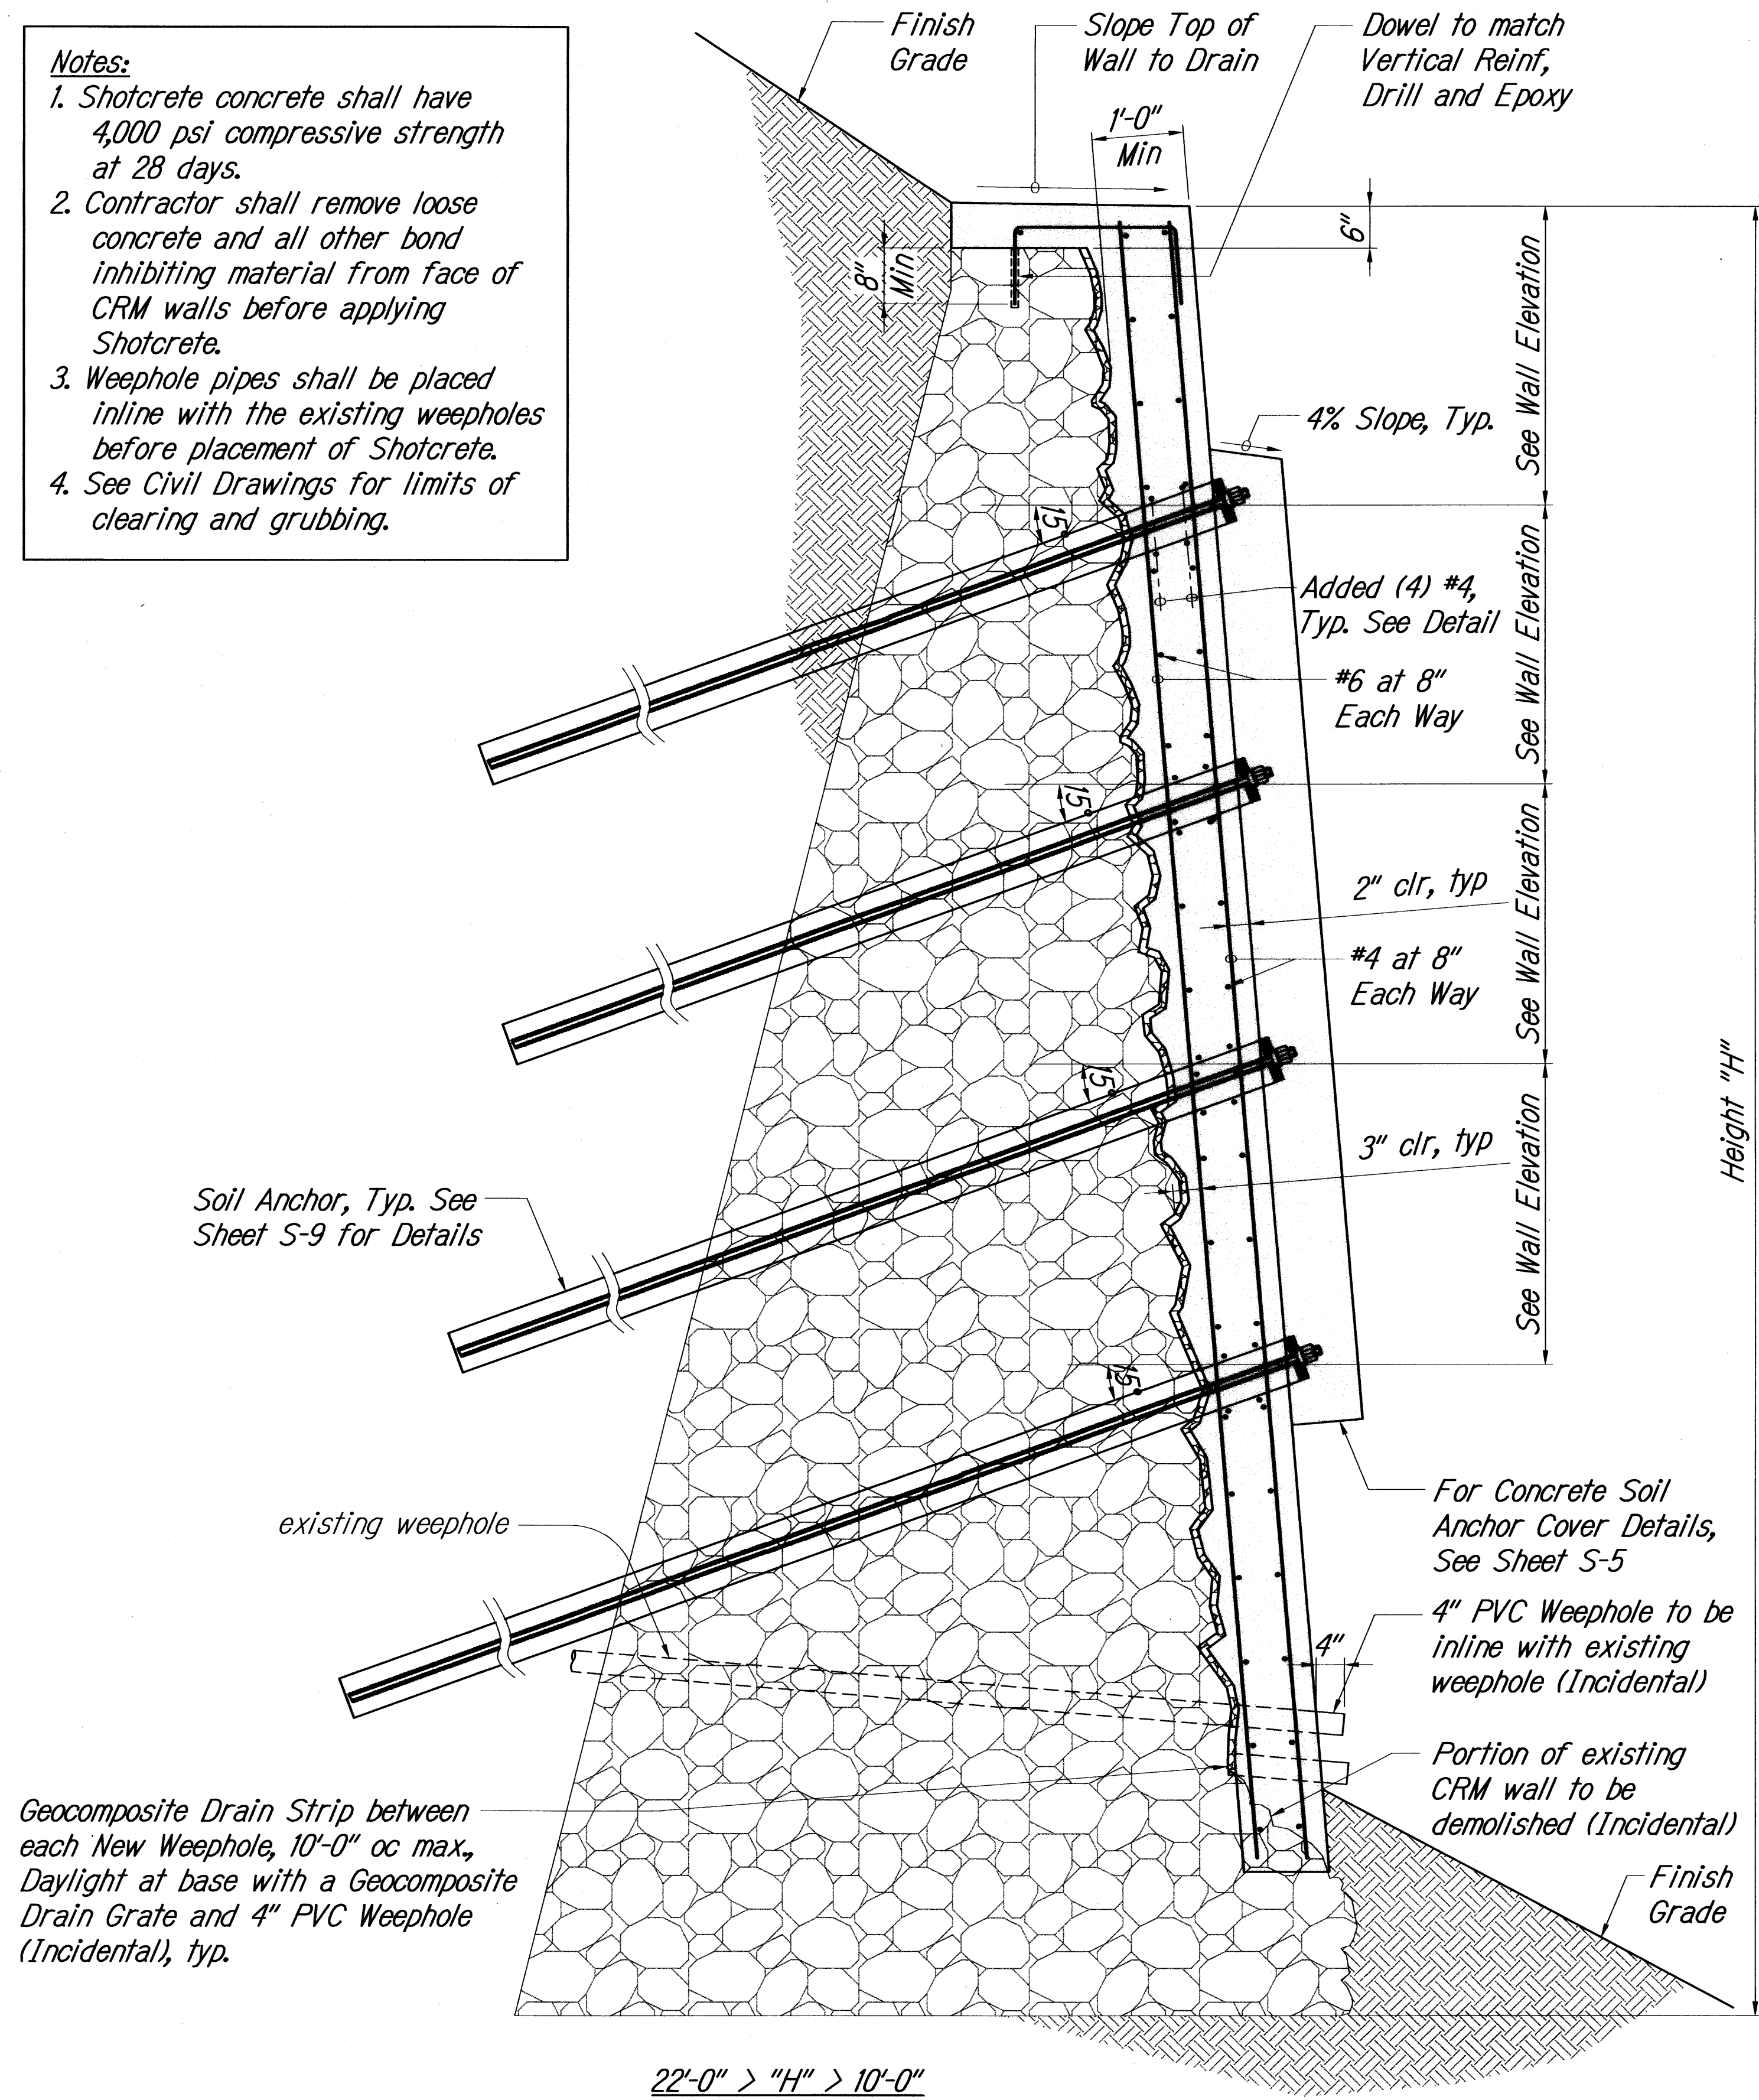


Soil Anchor, Typ. See Sheet S-9 for Details

Geocomposite Drain Strip between each New Weephole, 10'-0" oc max., Daylight at base with a Geocomposite Drain Grate and 4" PVC Weephole (Incidental), typ.

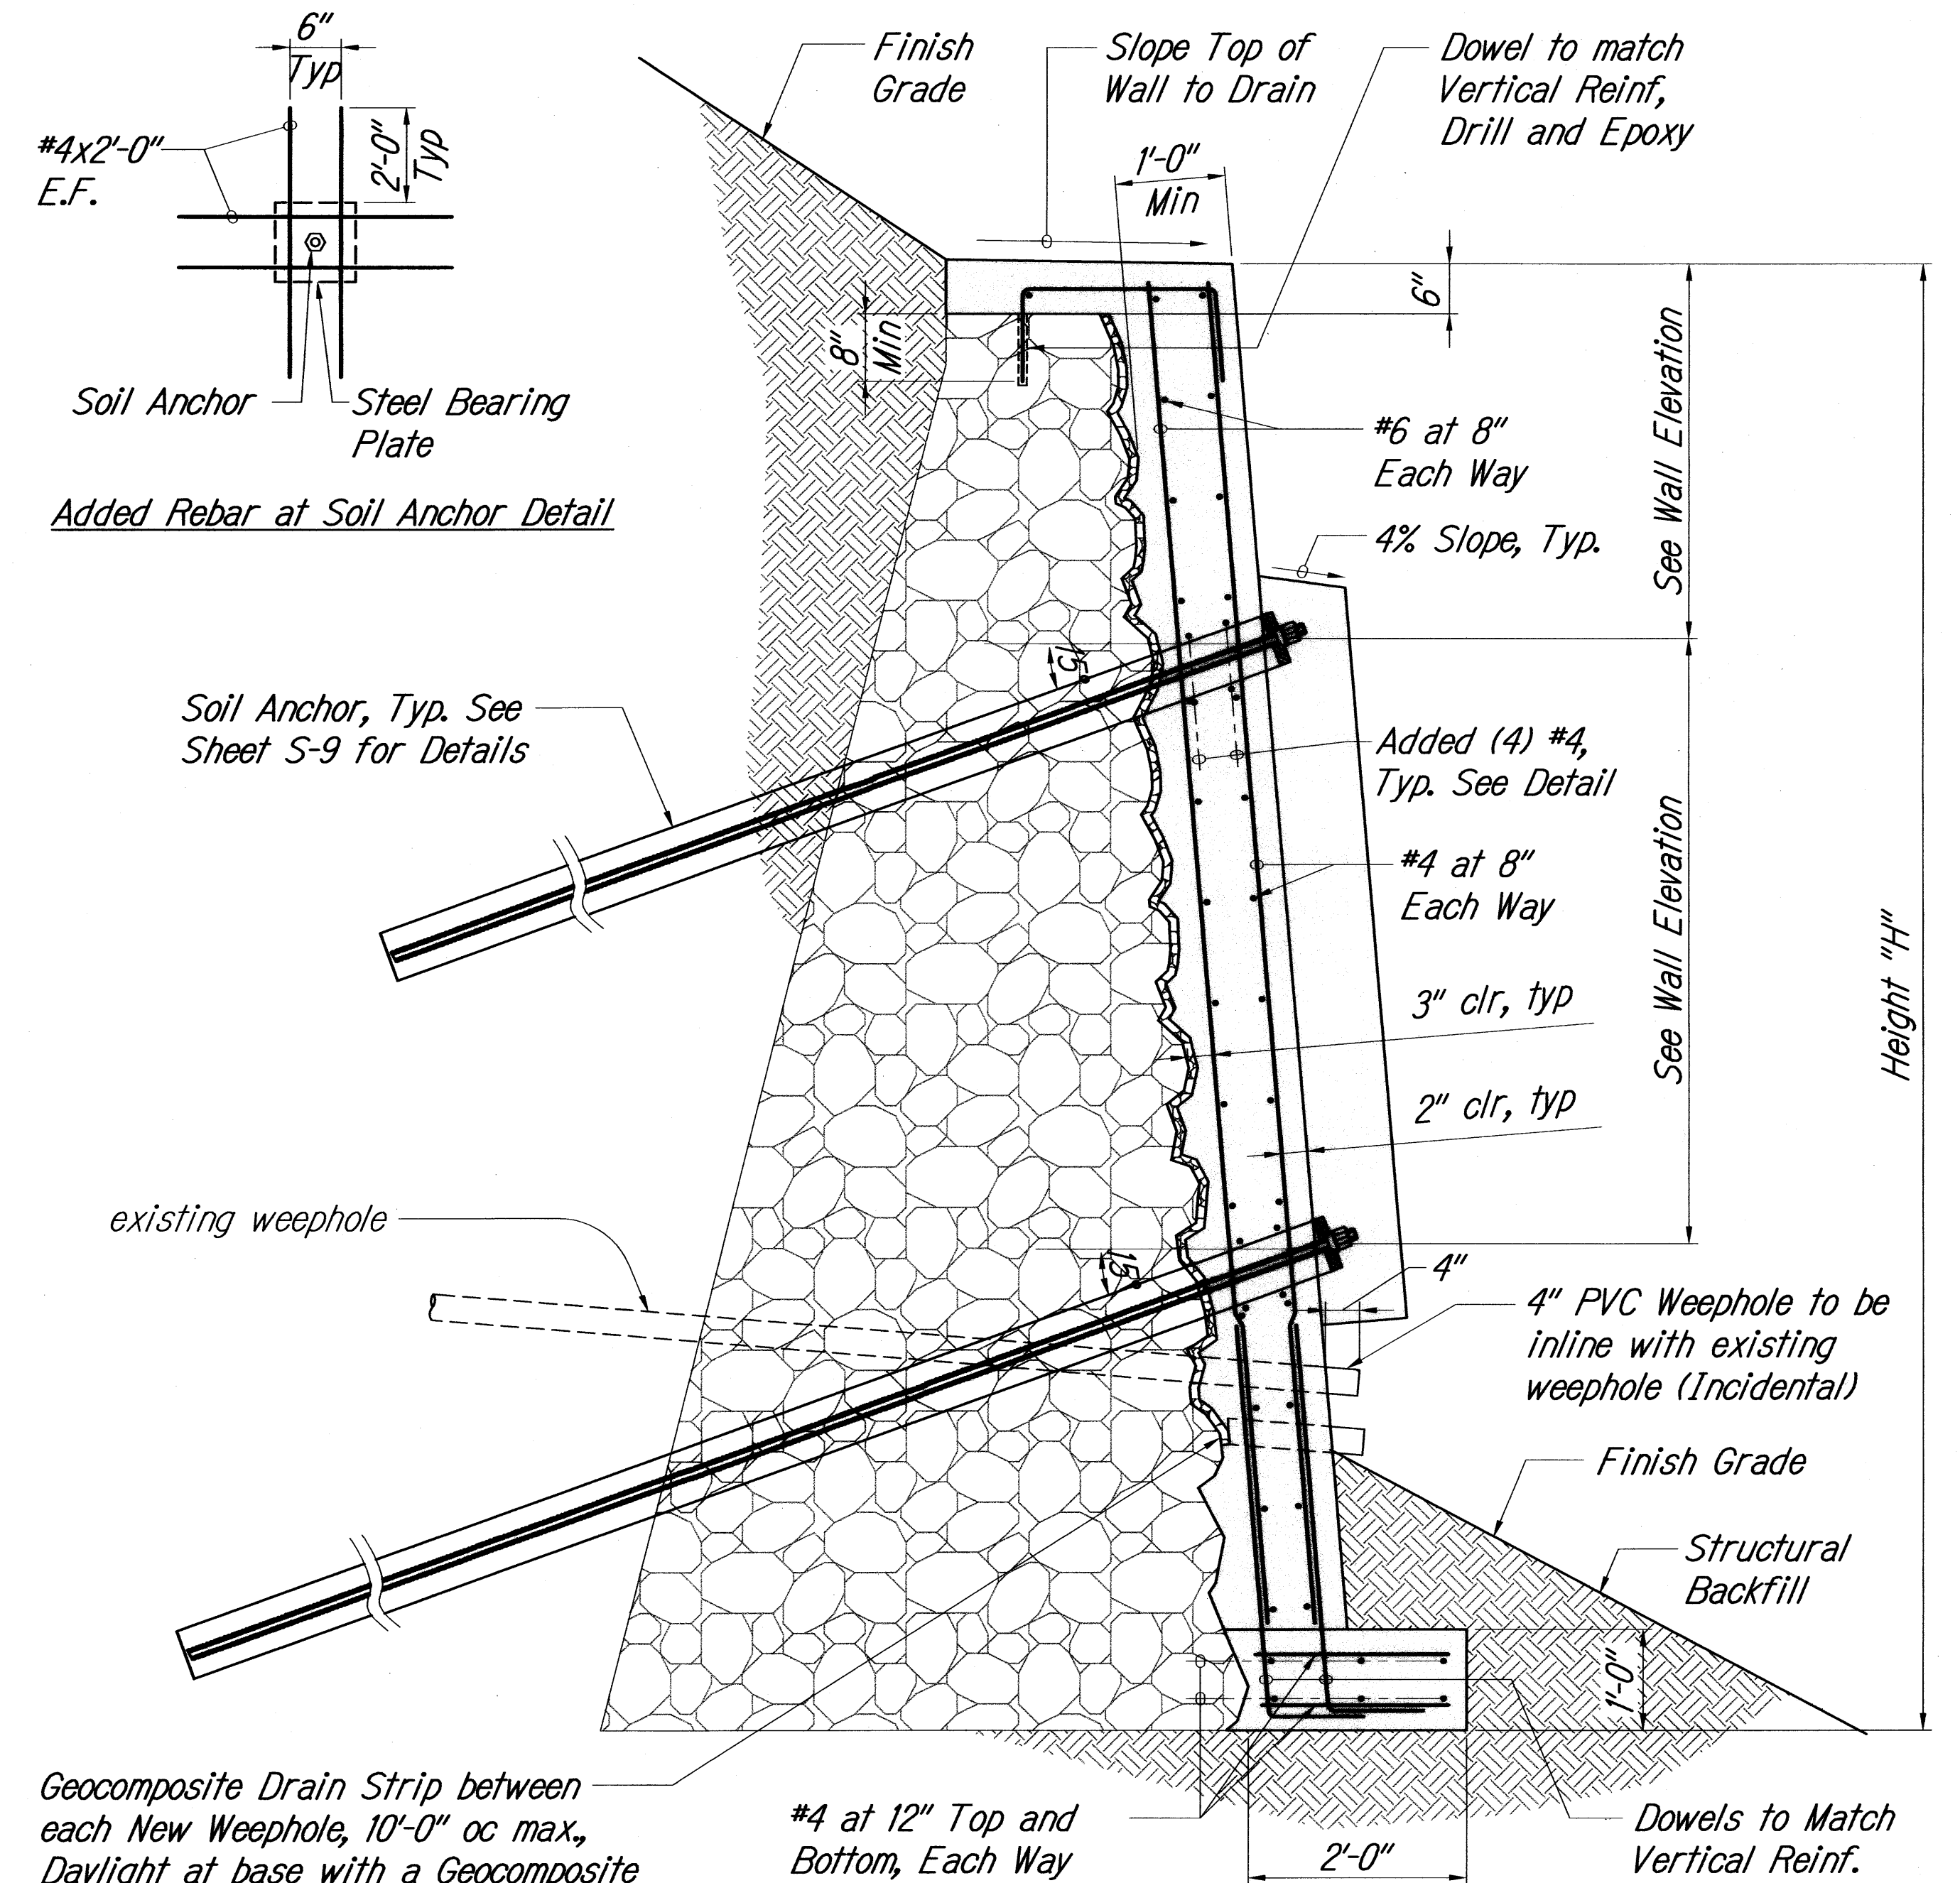

Note:
Structural backfill over wall footings backfill shall consist of non-expansive granular material. See Note 3.D.

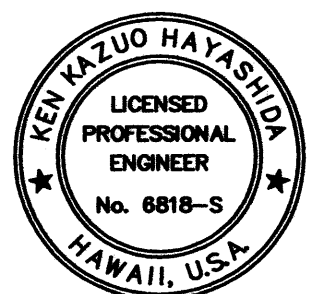

EXPIRATION DATE OF THE LICENSE 4/30/2010
THIS WORK WAS PREPARED BY
ME OR UNDER MY SUPERVISION.

STATE OF HAWAII
DEPARTMENT OF TRANSPORTATION
HIGHWAYS DIVISION

SHOTCRETE RETAINING WALL SECTIONS

EMERGENCY EARTHQUAKE ROCKFALL REPAIRS
AT VARIOUS LOCATIONS

F.A. Project No. ER-15(21)

Scale: As Noted Date: December, 2009


SHEET No. S-6 OF 9 SHEETS

SHOTCRETE RETAINING SYSTEM SECTION AT EXISTING CRM WALL AT MP 26.1


Scale: 3/4" = 1'-0"

1
S-4 S-6


FED. ROAD DIST. NO.	STATE	FED. AID PROJ. NO.	FISCAL YEAR	SHEET NO.	TOTAL SHEETS
HAWAII	HAW.	ER-15(21)	2010	87	89

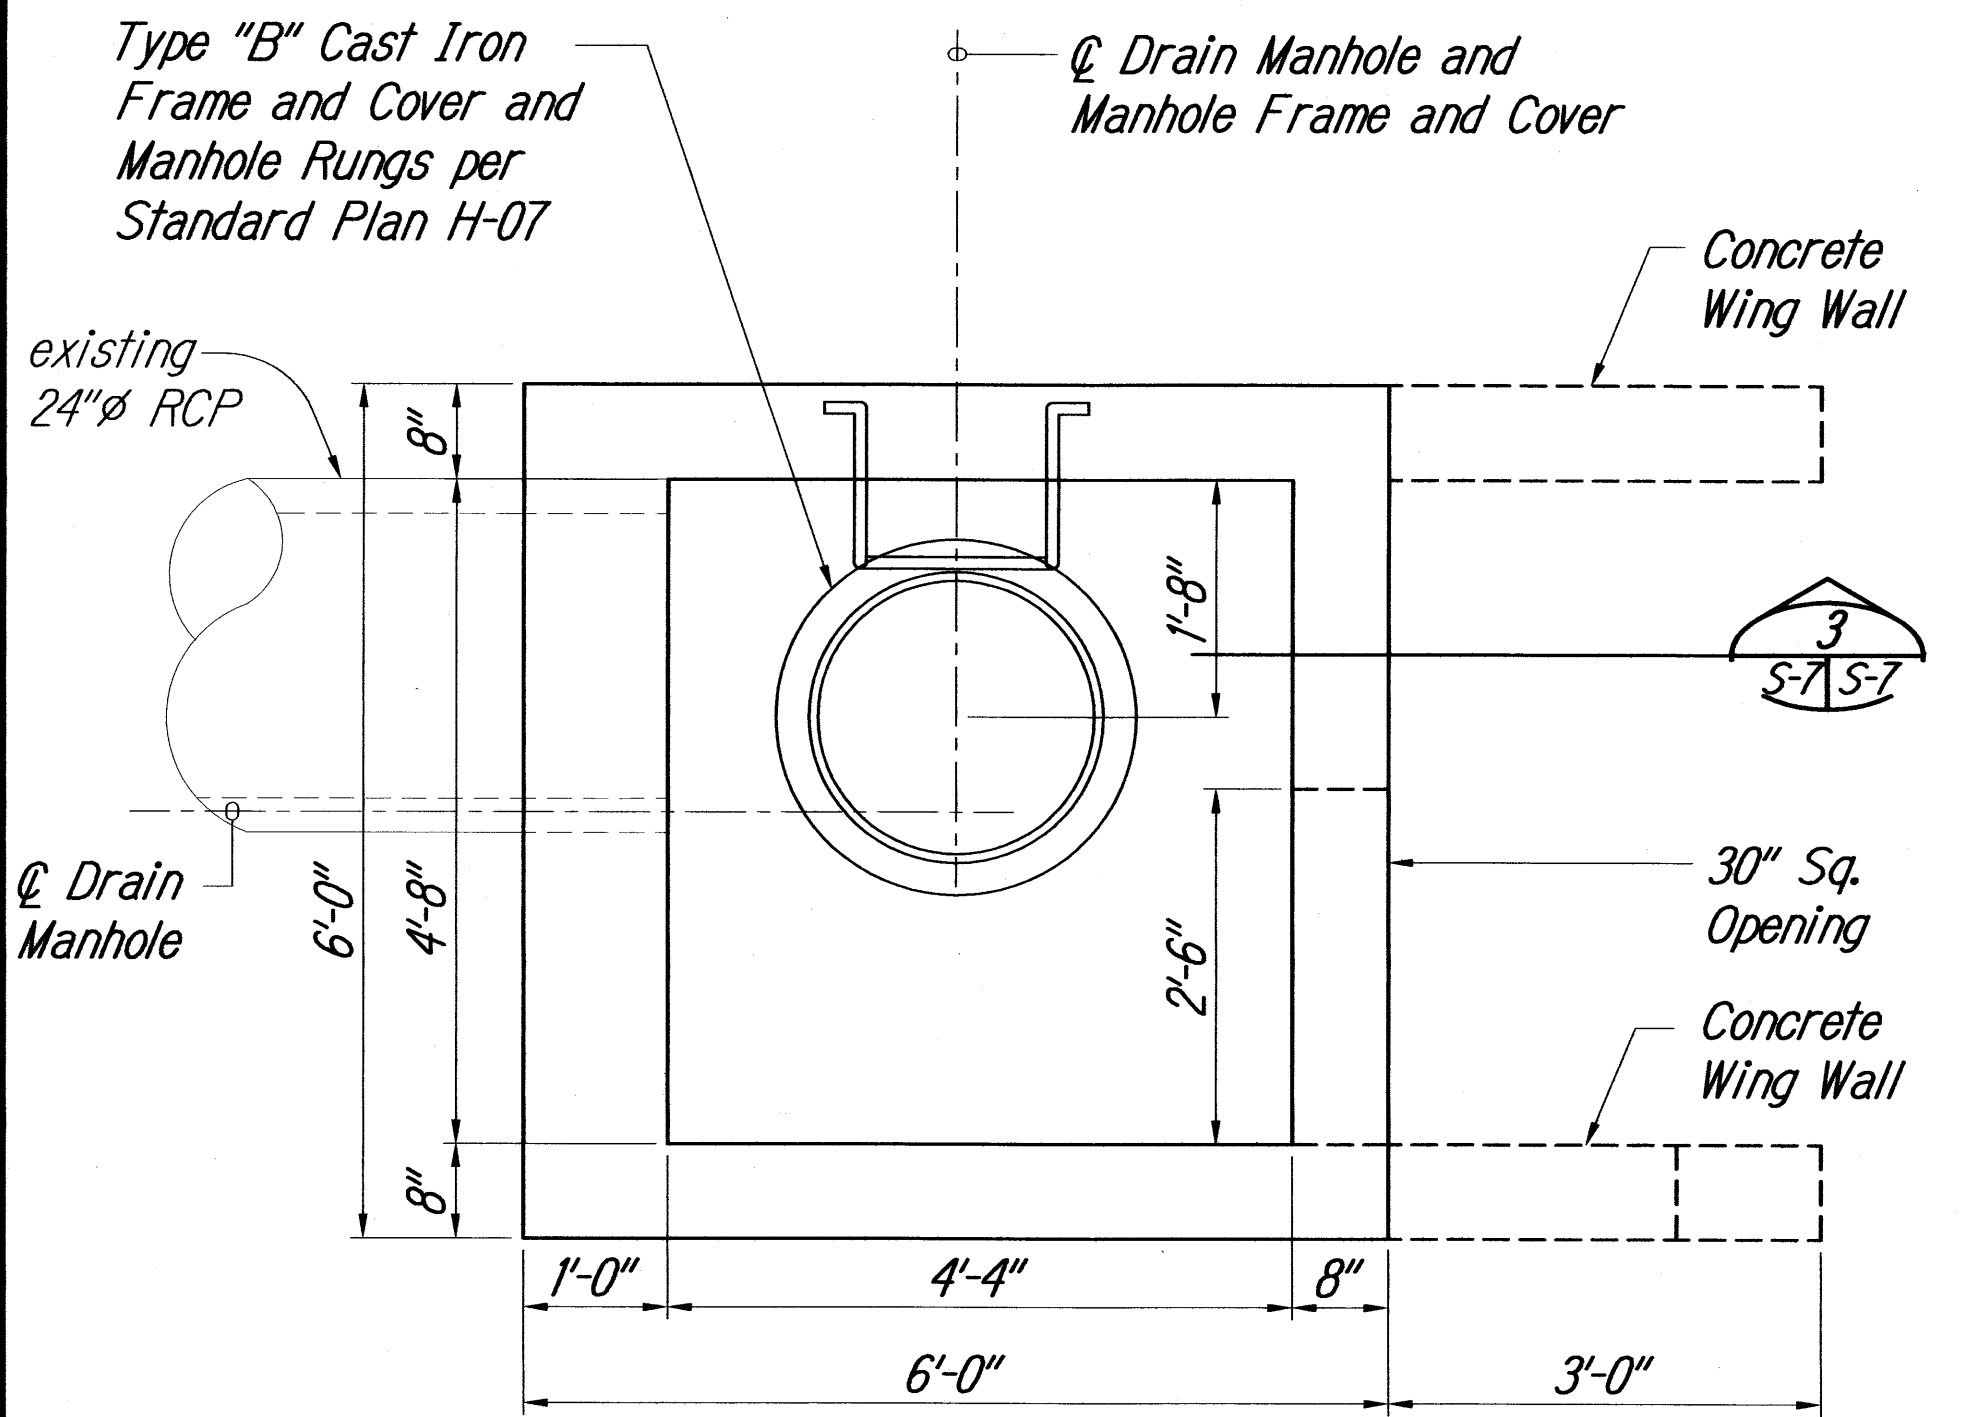

**DRAIN MANHOLE PLAN
AT CULVERT AT MP26.1**
Scale: 3/4" = 1'-0"


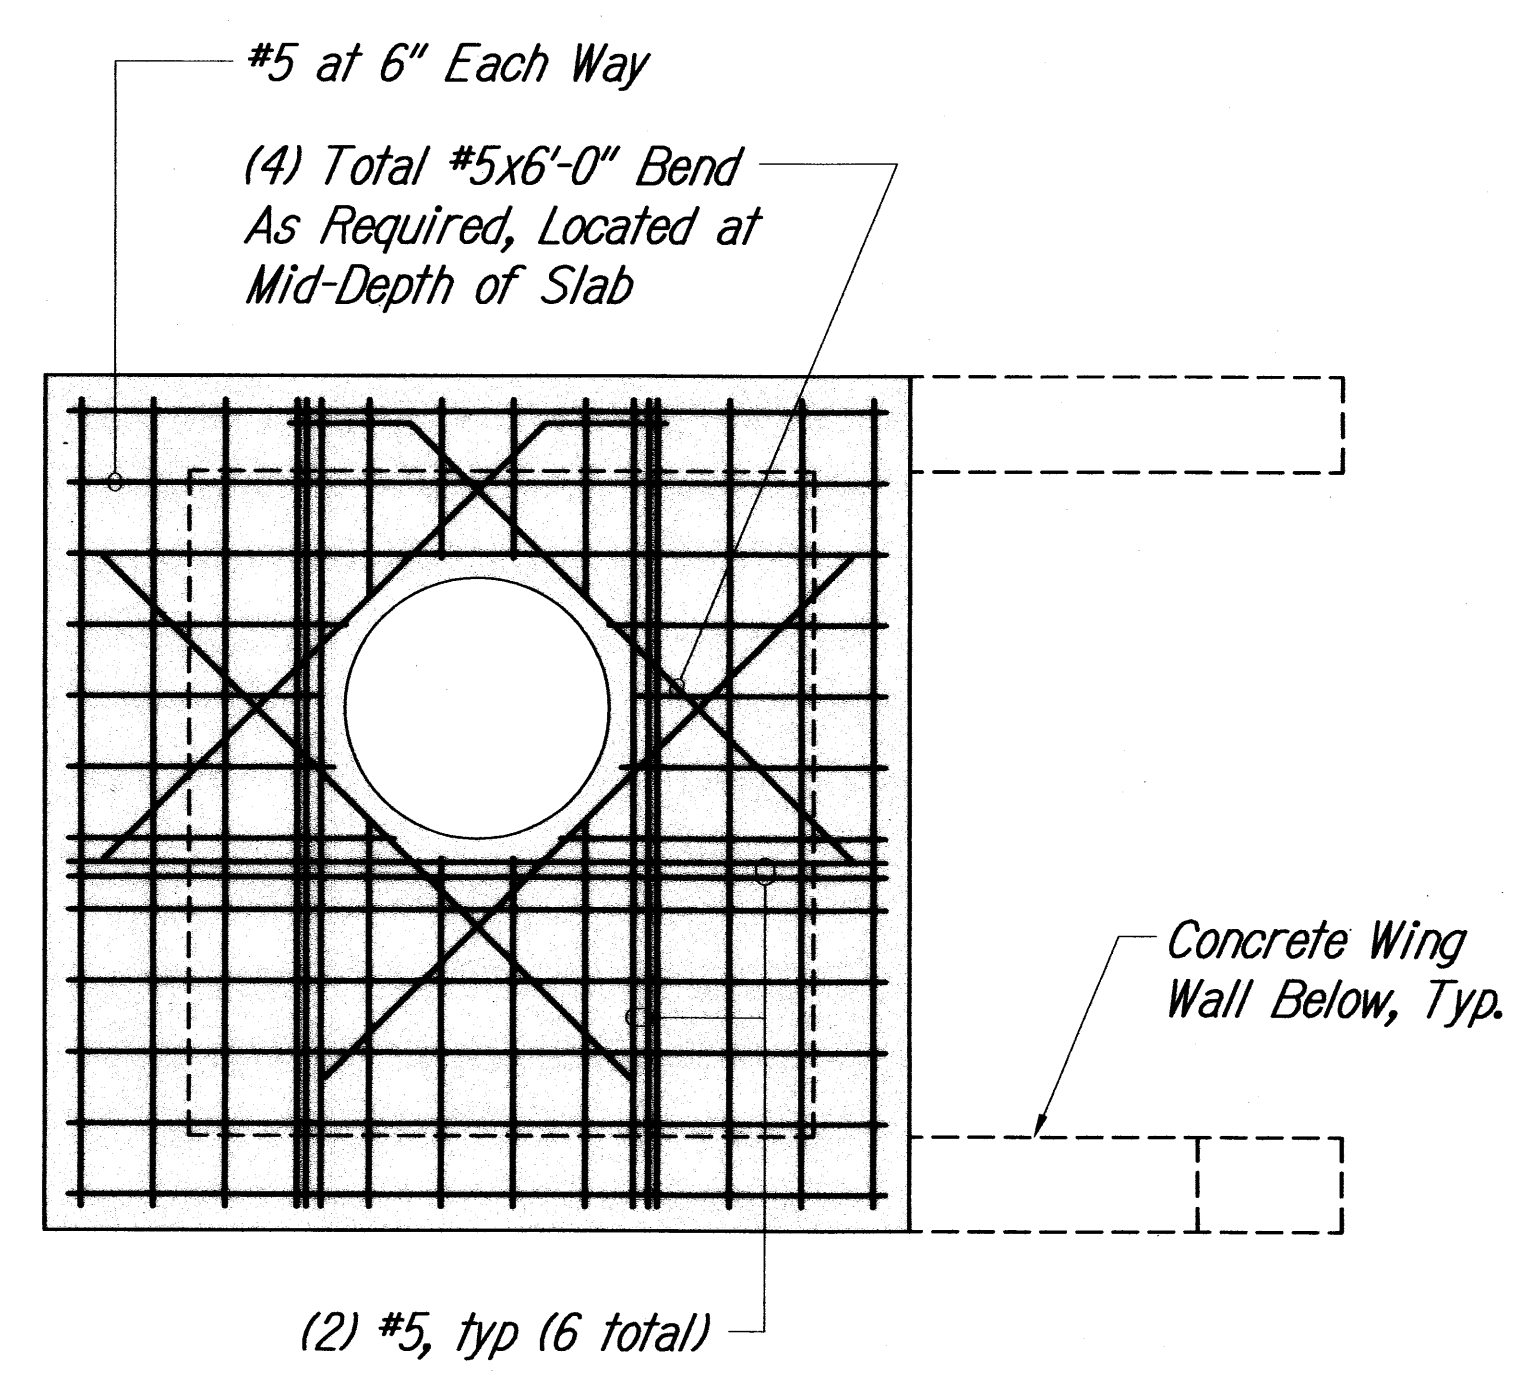


TOP SLAB PLAN
Scale: 3/4" = 1'-0"

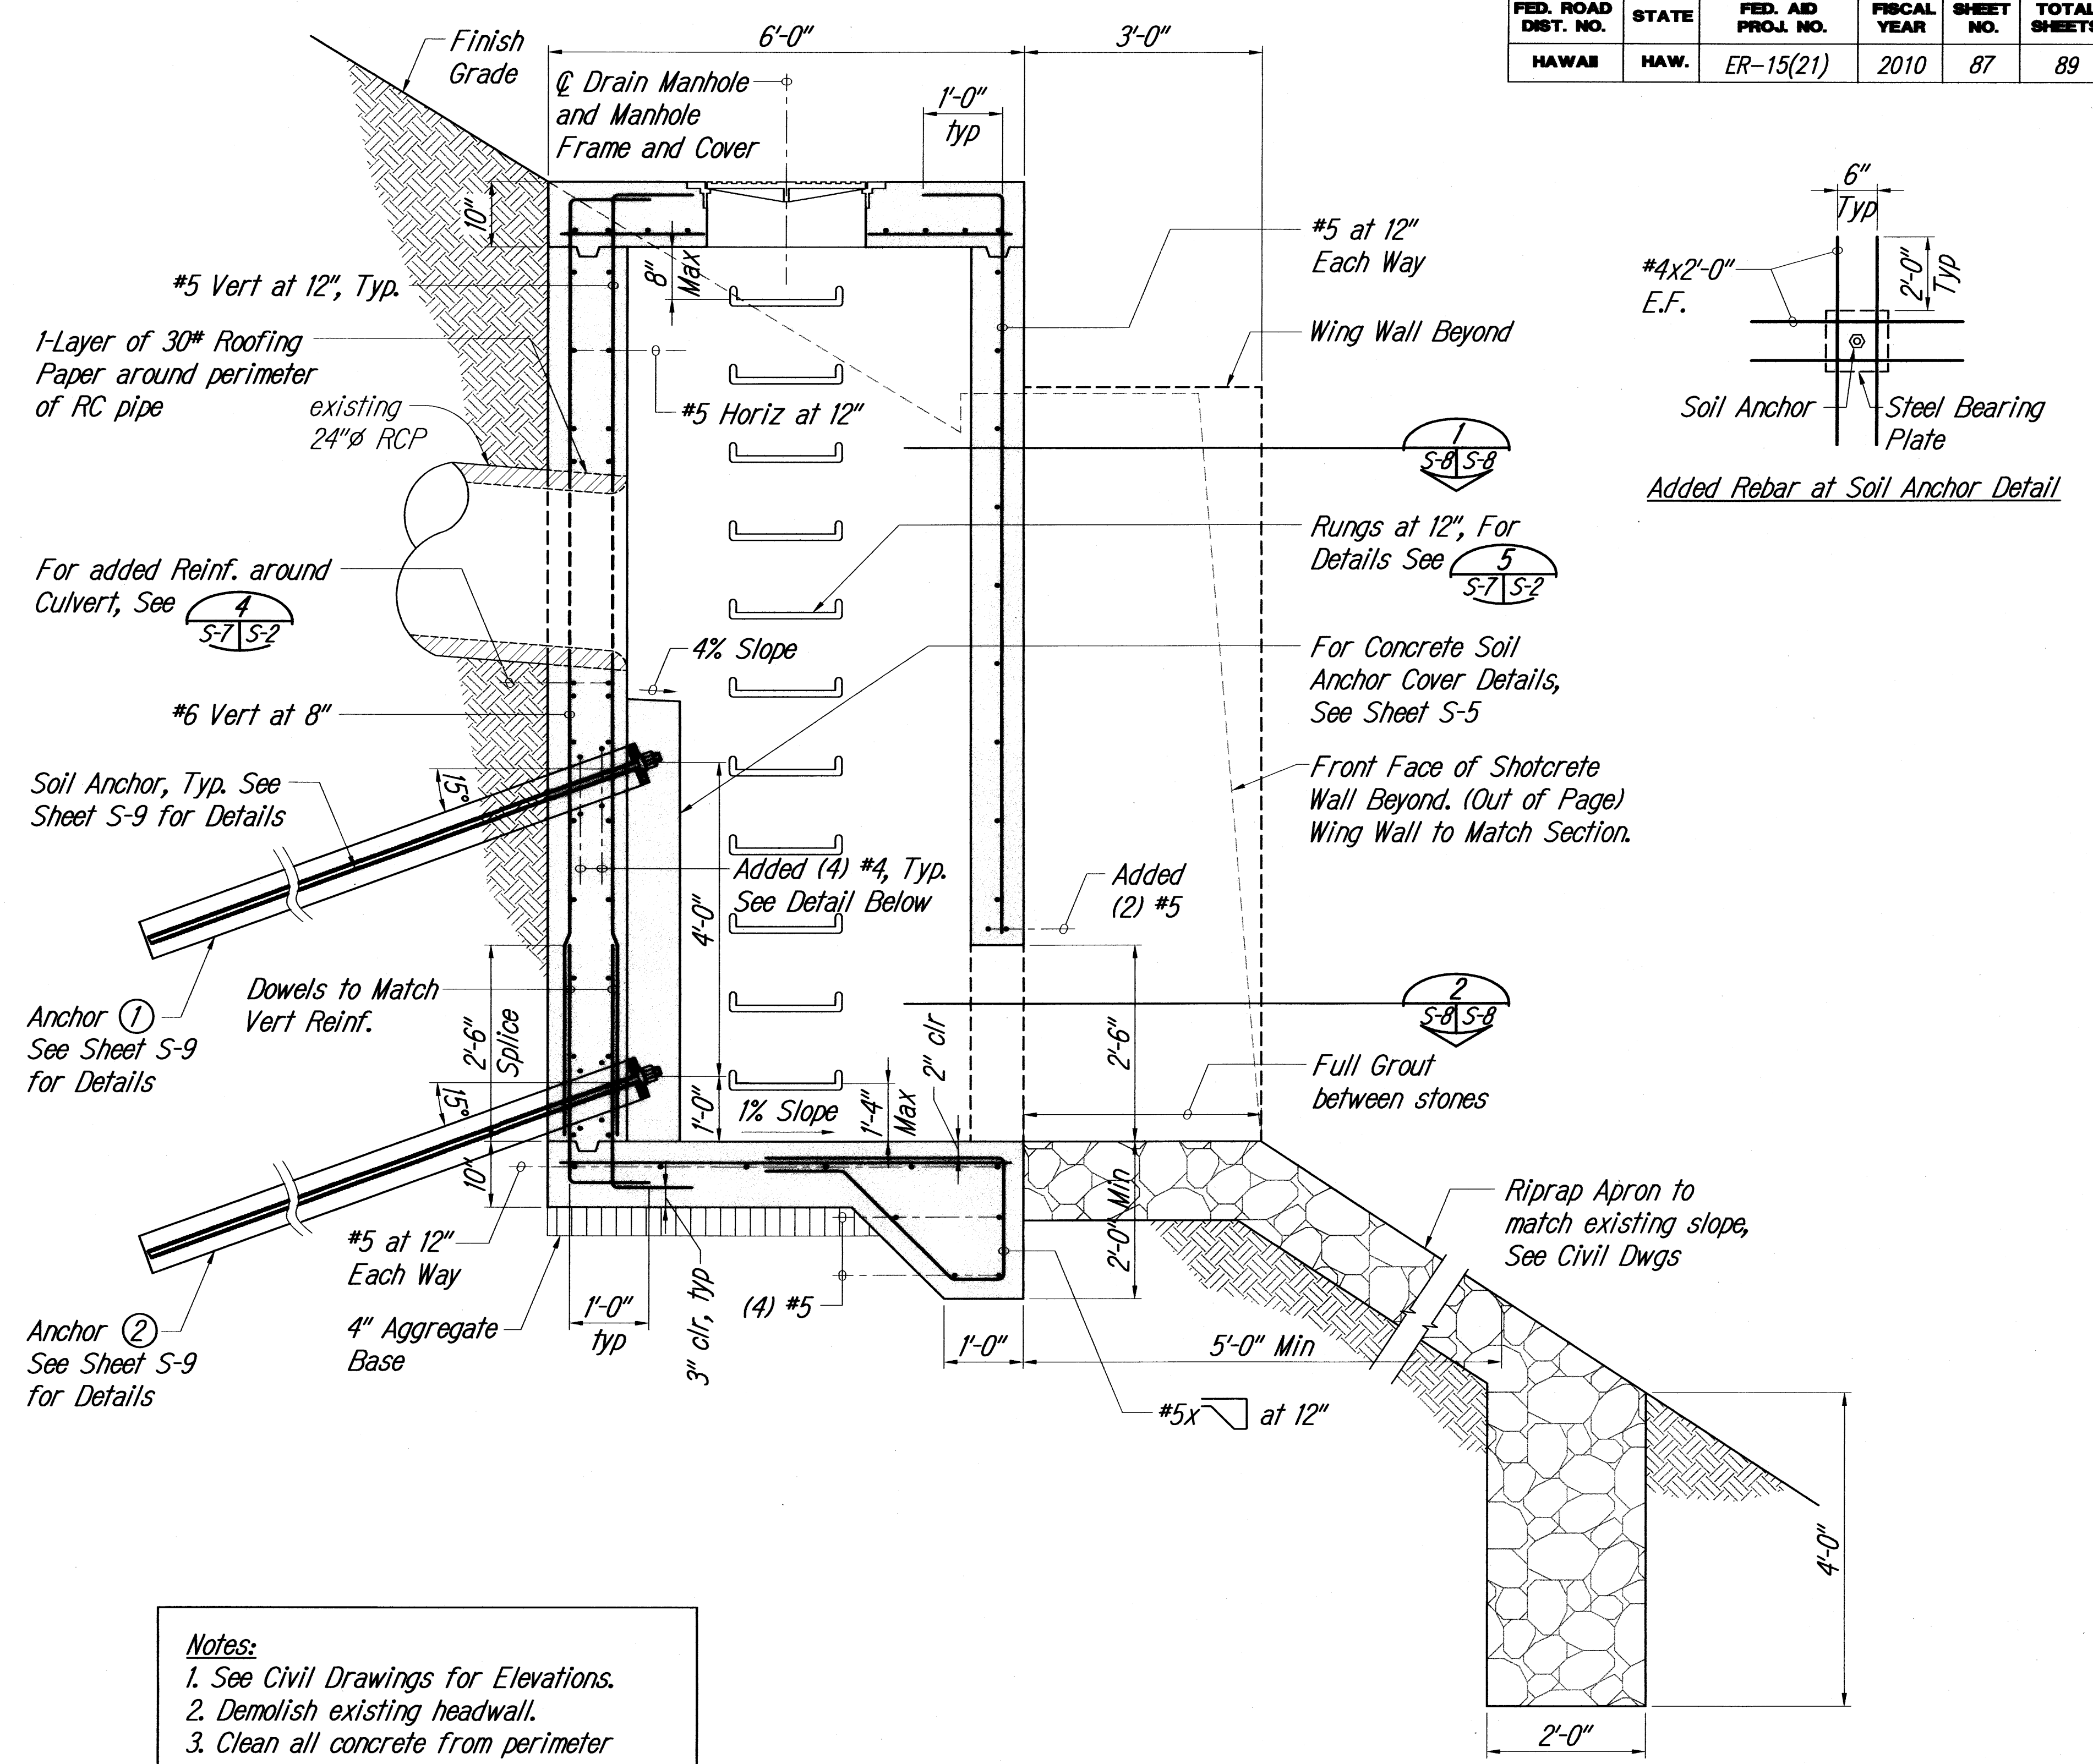

Notes:
1. See Civil Drawings for Elevations.
2. Demolish existing headwall.
3. Clean all concrete from perimeter surface of existing 24" RC Pipe after demolition of concrete headwall.

DRAIN MANHOLE SECTION
Scale: 3/4" = 1'-0"

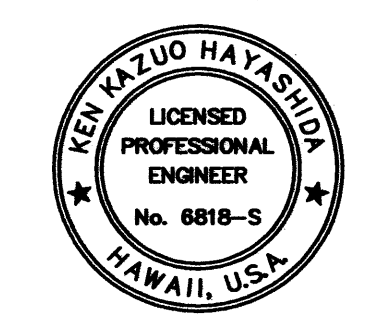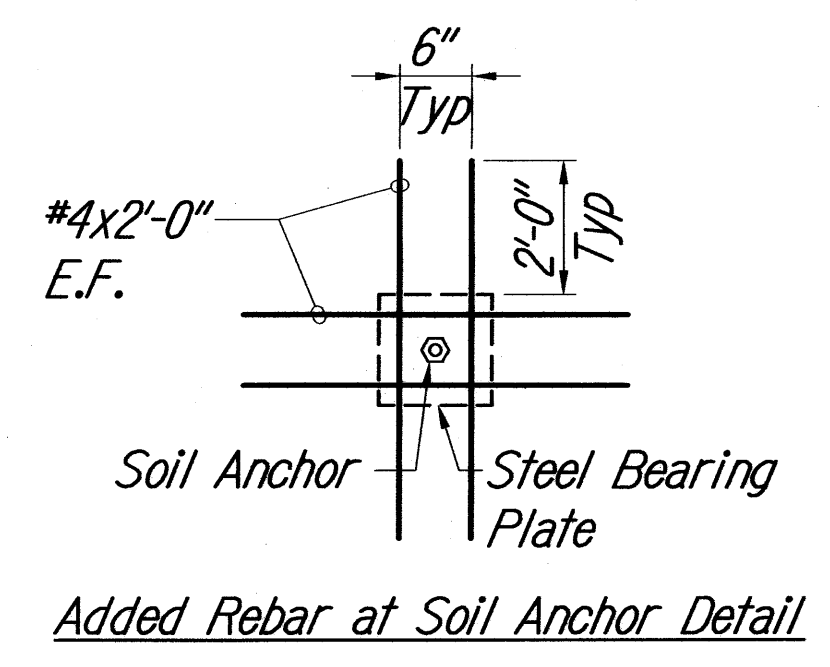

STATE OF HAWAII
DEPARTMENT OF TRANSPORTATION
HIGHWAYS DIVISION

**DRAIN MANHOLE
PLANS AND SECTIONS**

EMERGENCY EARTHQUAKE ROCKFALL REPAIRS
AT VARIOUS LOCATIONS

F.A. Project No. ER-15(21)


Scale: As Noted Date: December, 2009

SHEET No. S-7 OF 9 SHEETS

ORIGINAL PLAN	SURVEY PLOTTED BY	DATE
NOTE BOOK	DESIGNED BY	8/30/26
QUANTITIES BY	CHECKED BY	
No.		

LAST UPDATE: 21-09-2010 10:21 am PLOT DATE: 22-09-2010 10:22 am


FED. ROAD DIST. NO.	STATE	FED. AID PROJ. NO.	FISCAL YEAR	SHEET NO.	TOTAL SHEETS
HAWAII	HAW.	ER-15(21)	2010	88	89

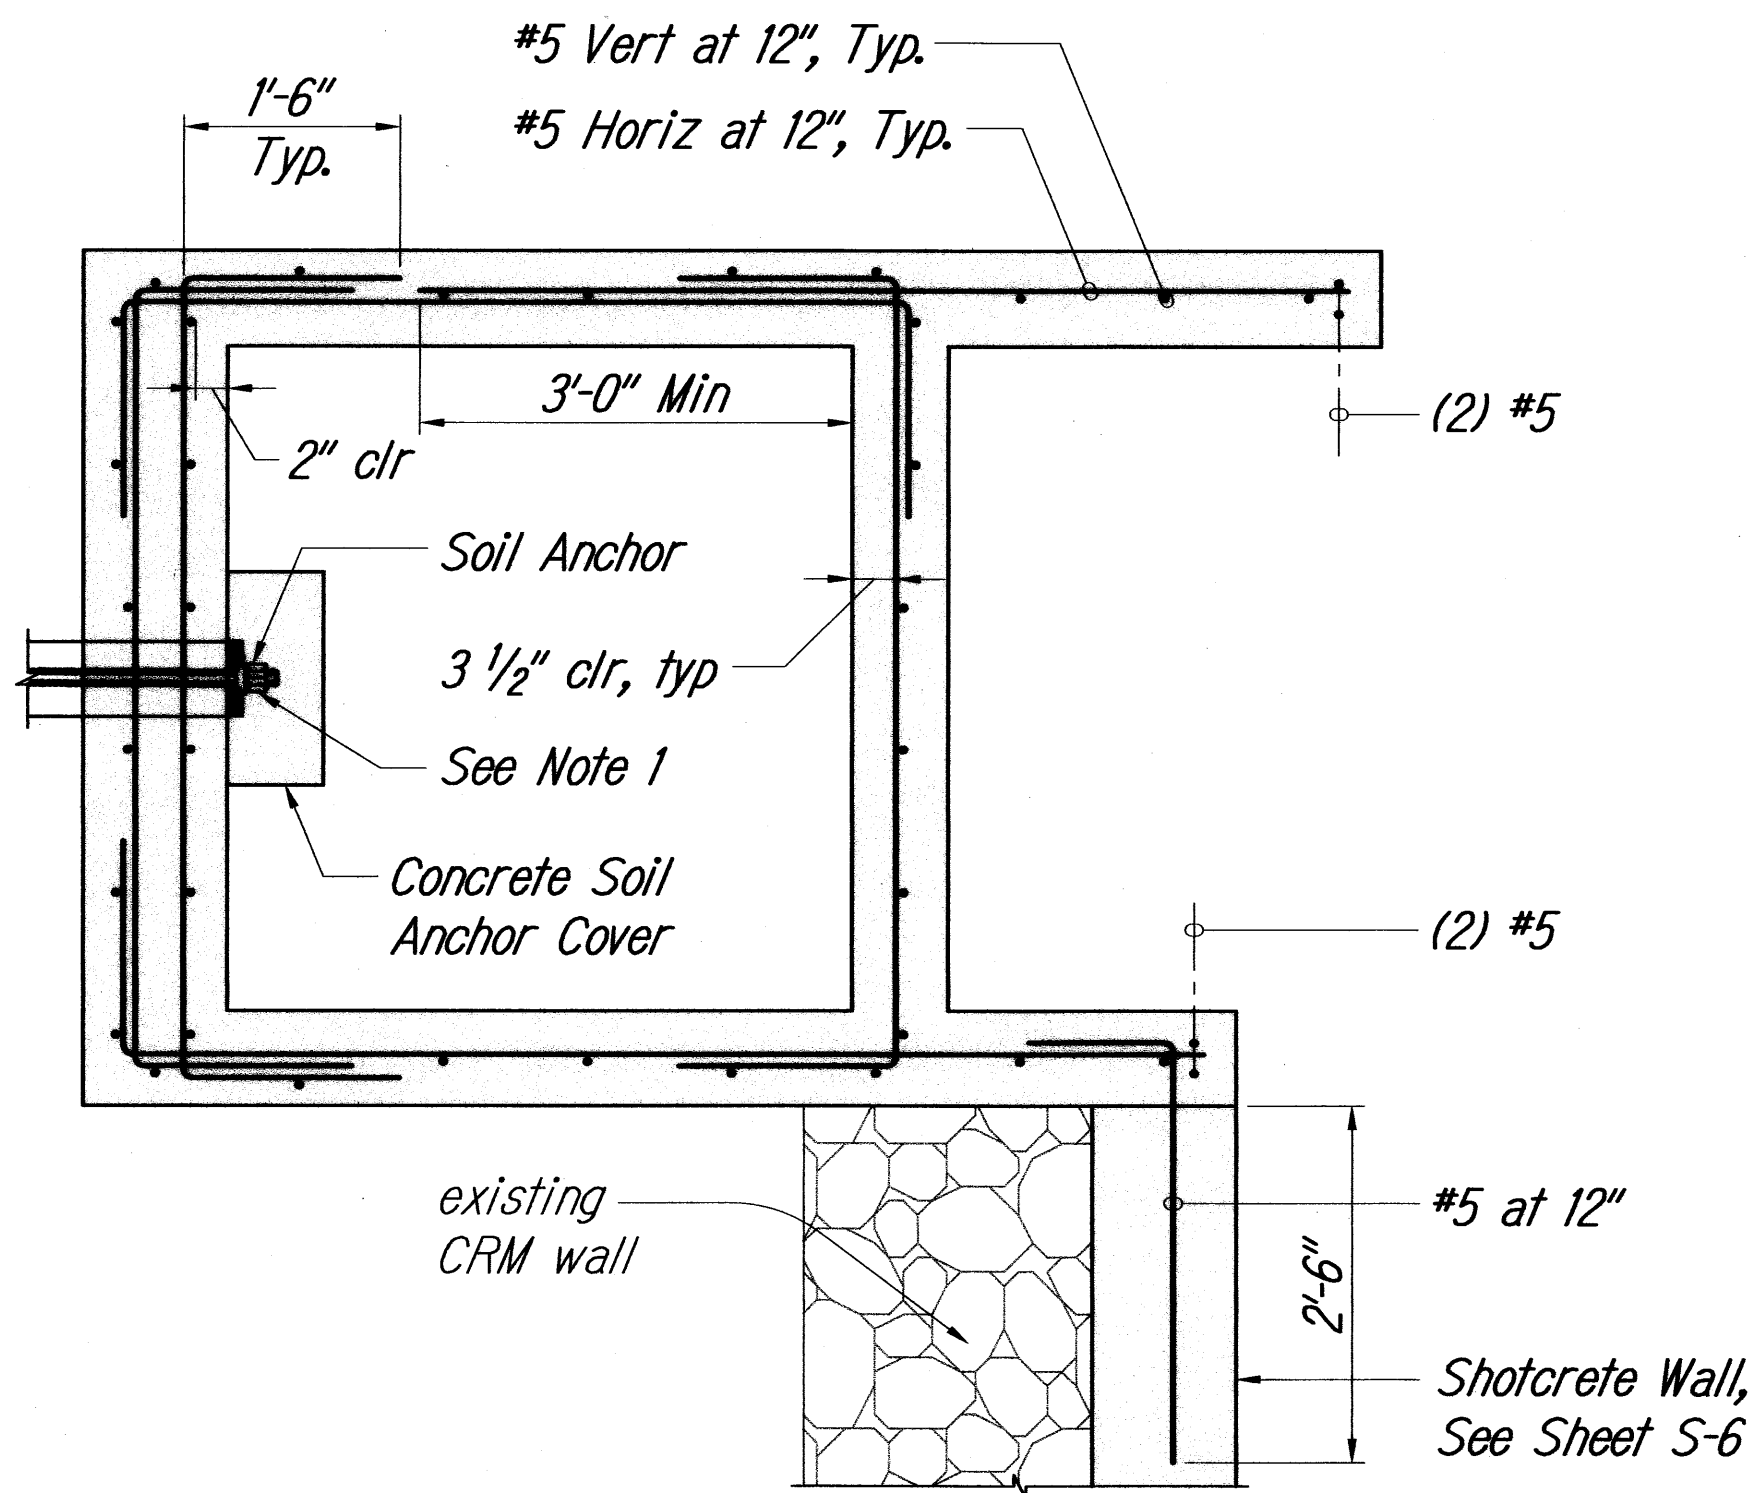

SECTION 1

Scale: 3/4" = 1'-0"

1
S-8 | S-8

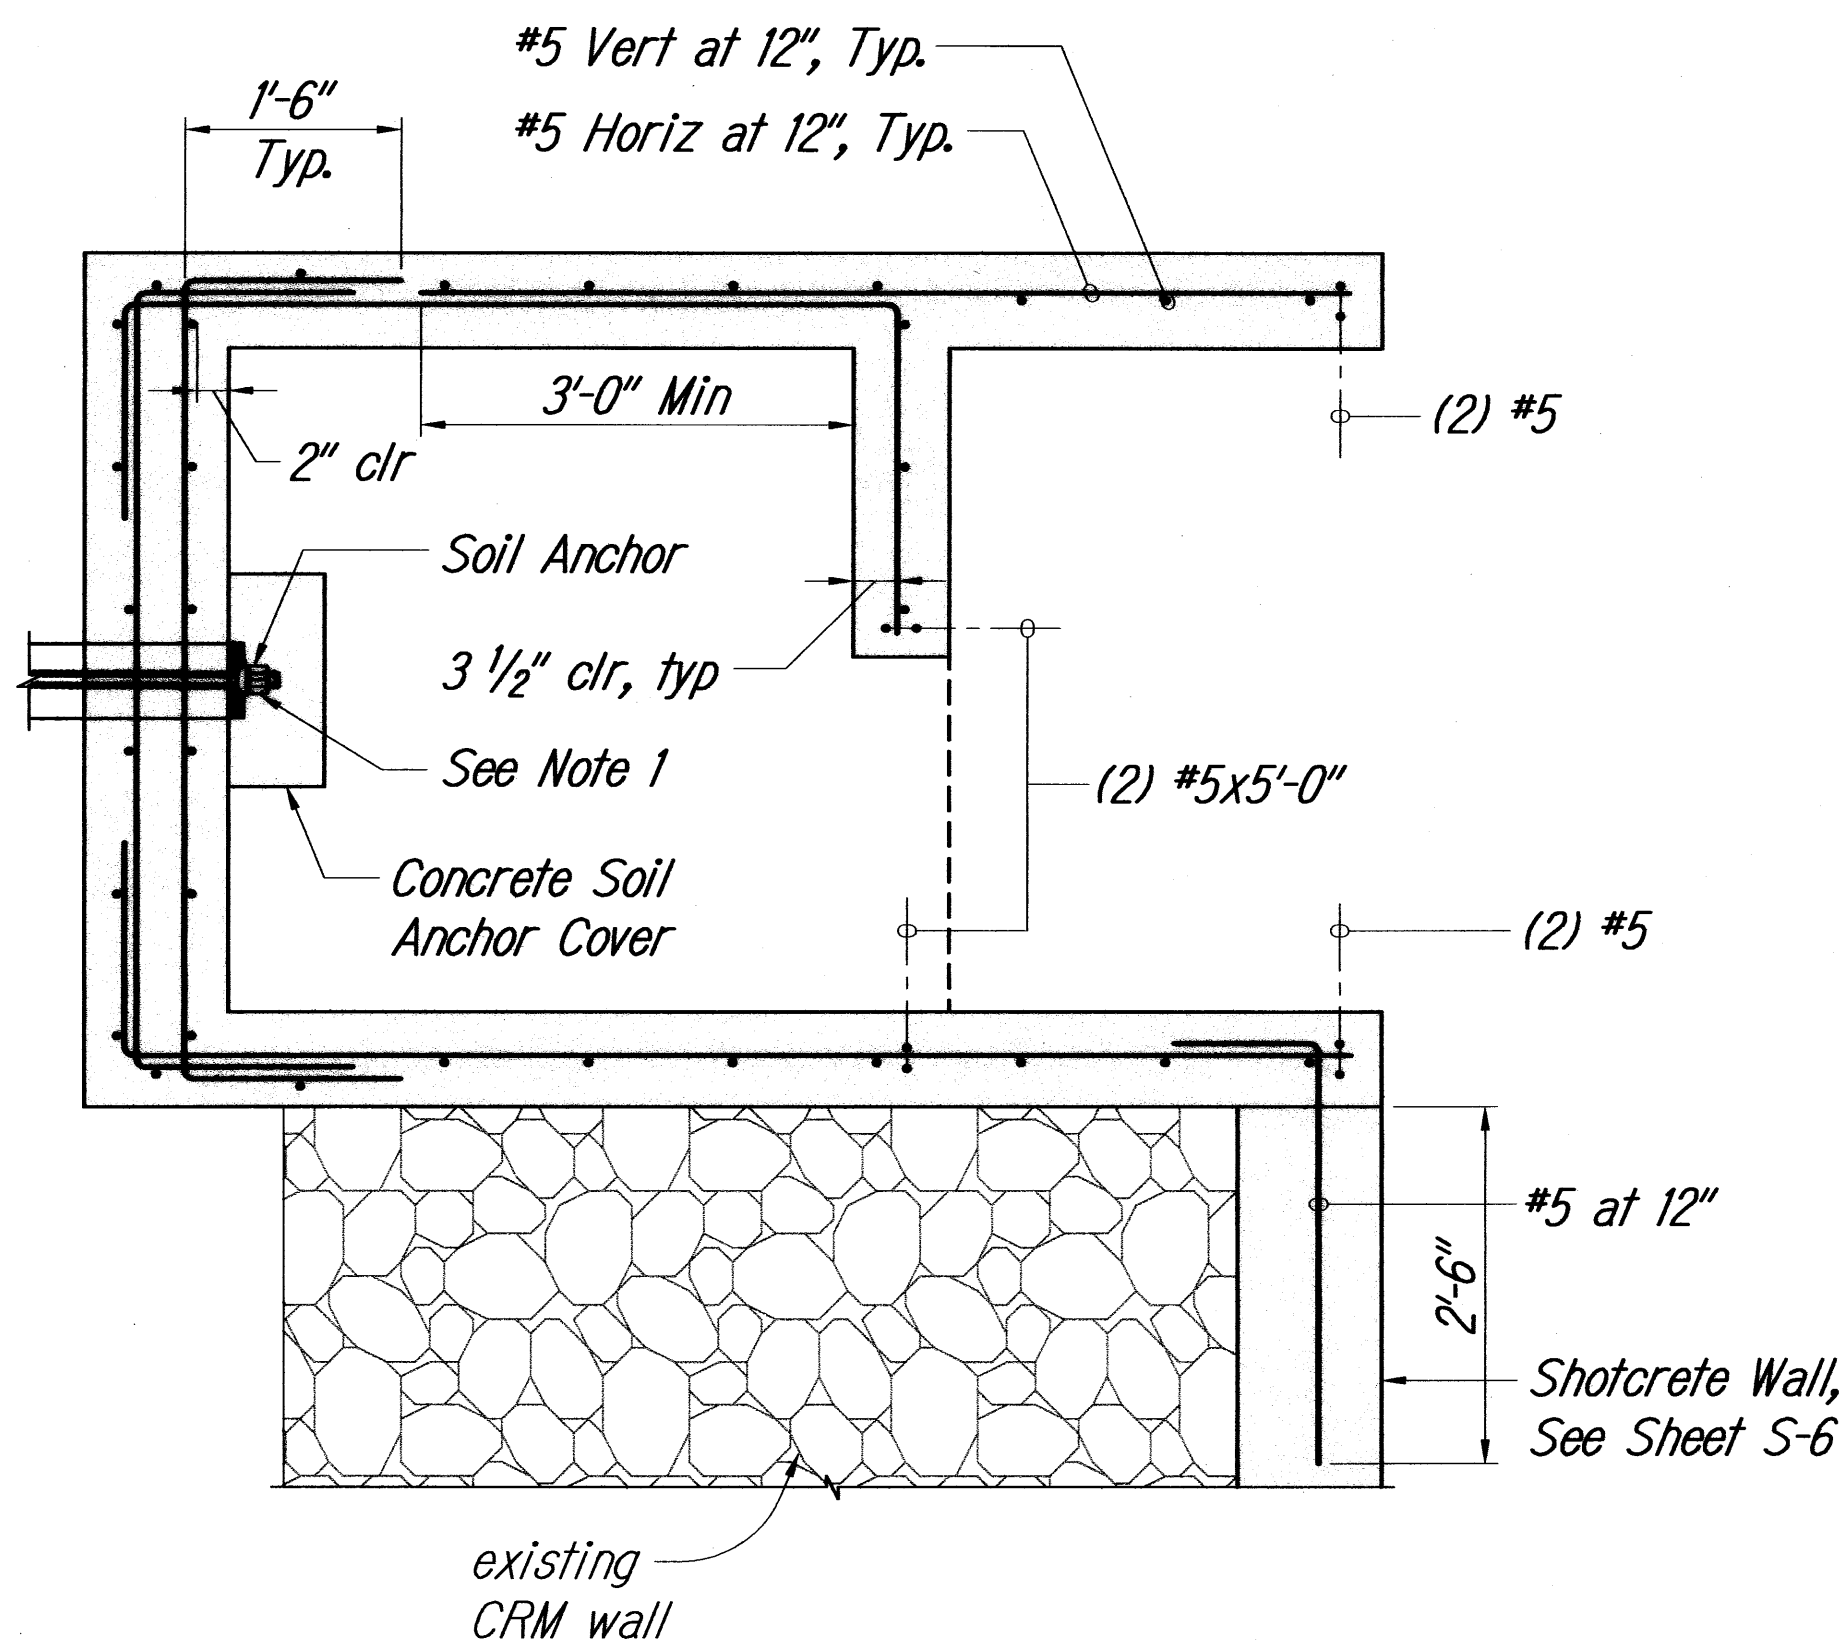

SECTION 2


Scale: 3/4" = 1'-0"

2
S-8 | S-8

Note:
See Detail 3 on Sheet S-7 for
added reinforcing at soil anchors.


ORIGINAL PLAN	SURVEY PLOTTED BY	DATE
PLAN	DESIGNED BY	6/20/06
NOTE BOOK	DESIGNED BY	L. Cho
QUANTITIES BY	QUANTITIES BY	L. Cho
CHECKED BY	CHECKED BY	L. Cho

LAST UPDATE: 21-06-2010 • 10:21 am PLOT DATE: 21-06-2010 • 10:22 am

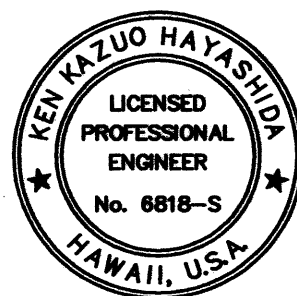


EXPIRATION DATE OF THE LICENSE: 4/30/2010
THIS WORK WAS PREPARED BY
ME OR UNDER MY SUPERVISION.


STATE OF HAWAII
DEPARTMENT OF TRANSPORTATION
HIGHWAYS DIVISION
DRAIN MANHOLE SECTIONS
EMERGENCY EARTHQUAKE ROCKFALL REPAIRS
AT VARIOUS LOCATIONS
F.A. Project No. ER-15(21)
Scale: As Noted Date: December, 2009
SHEET No. S-8 OF 9 SHEETS

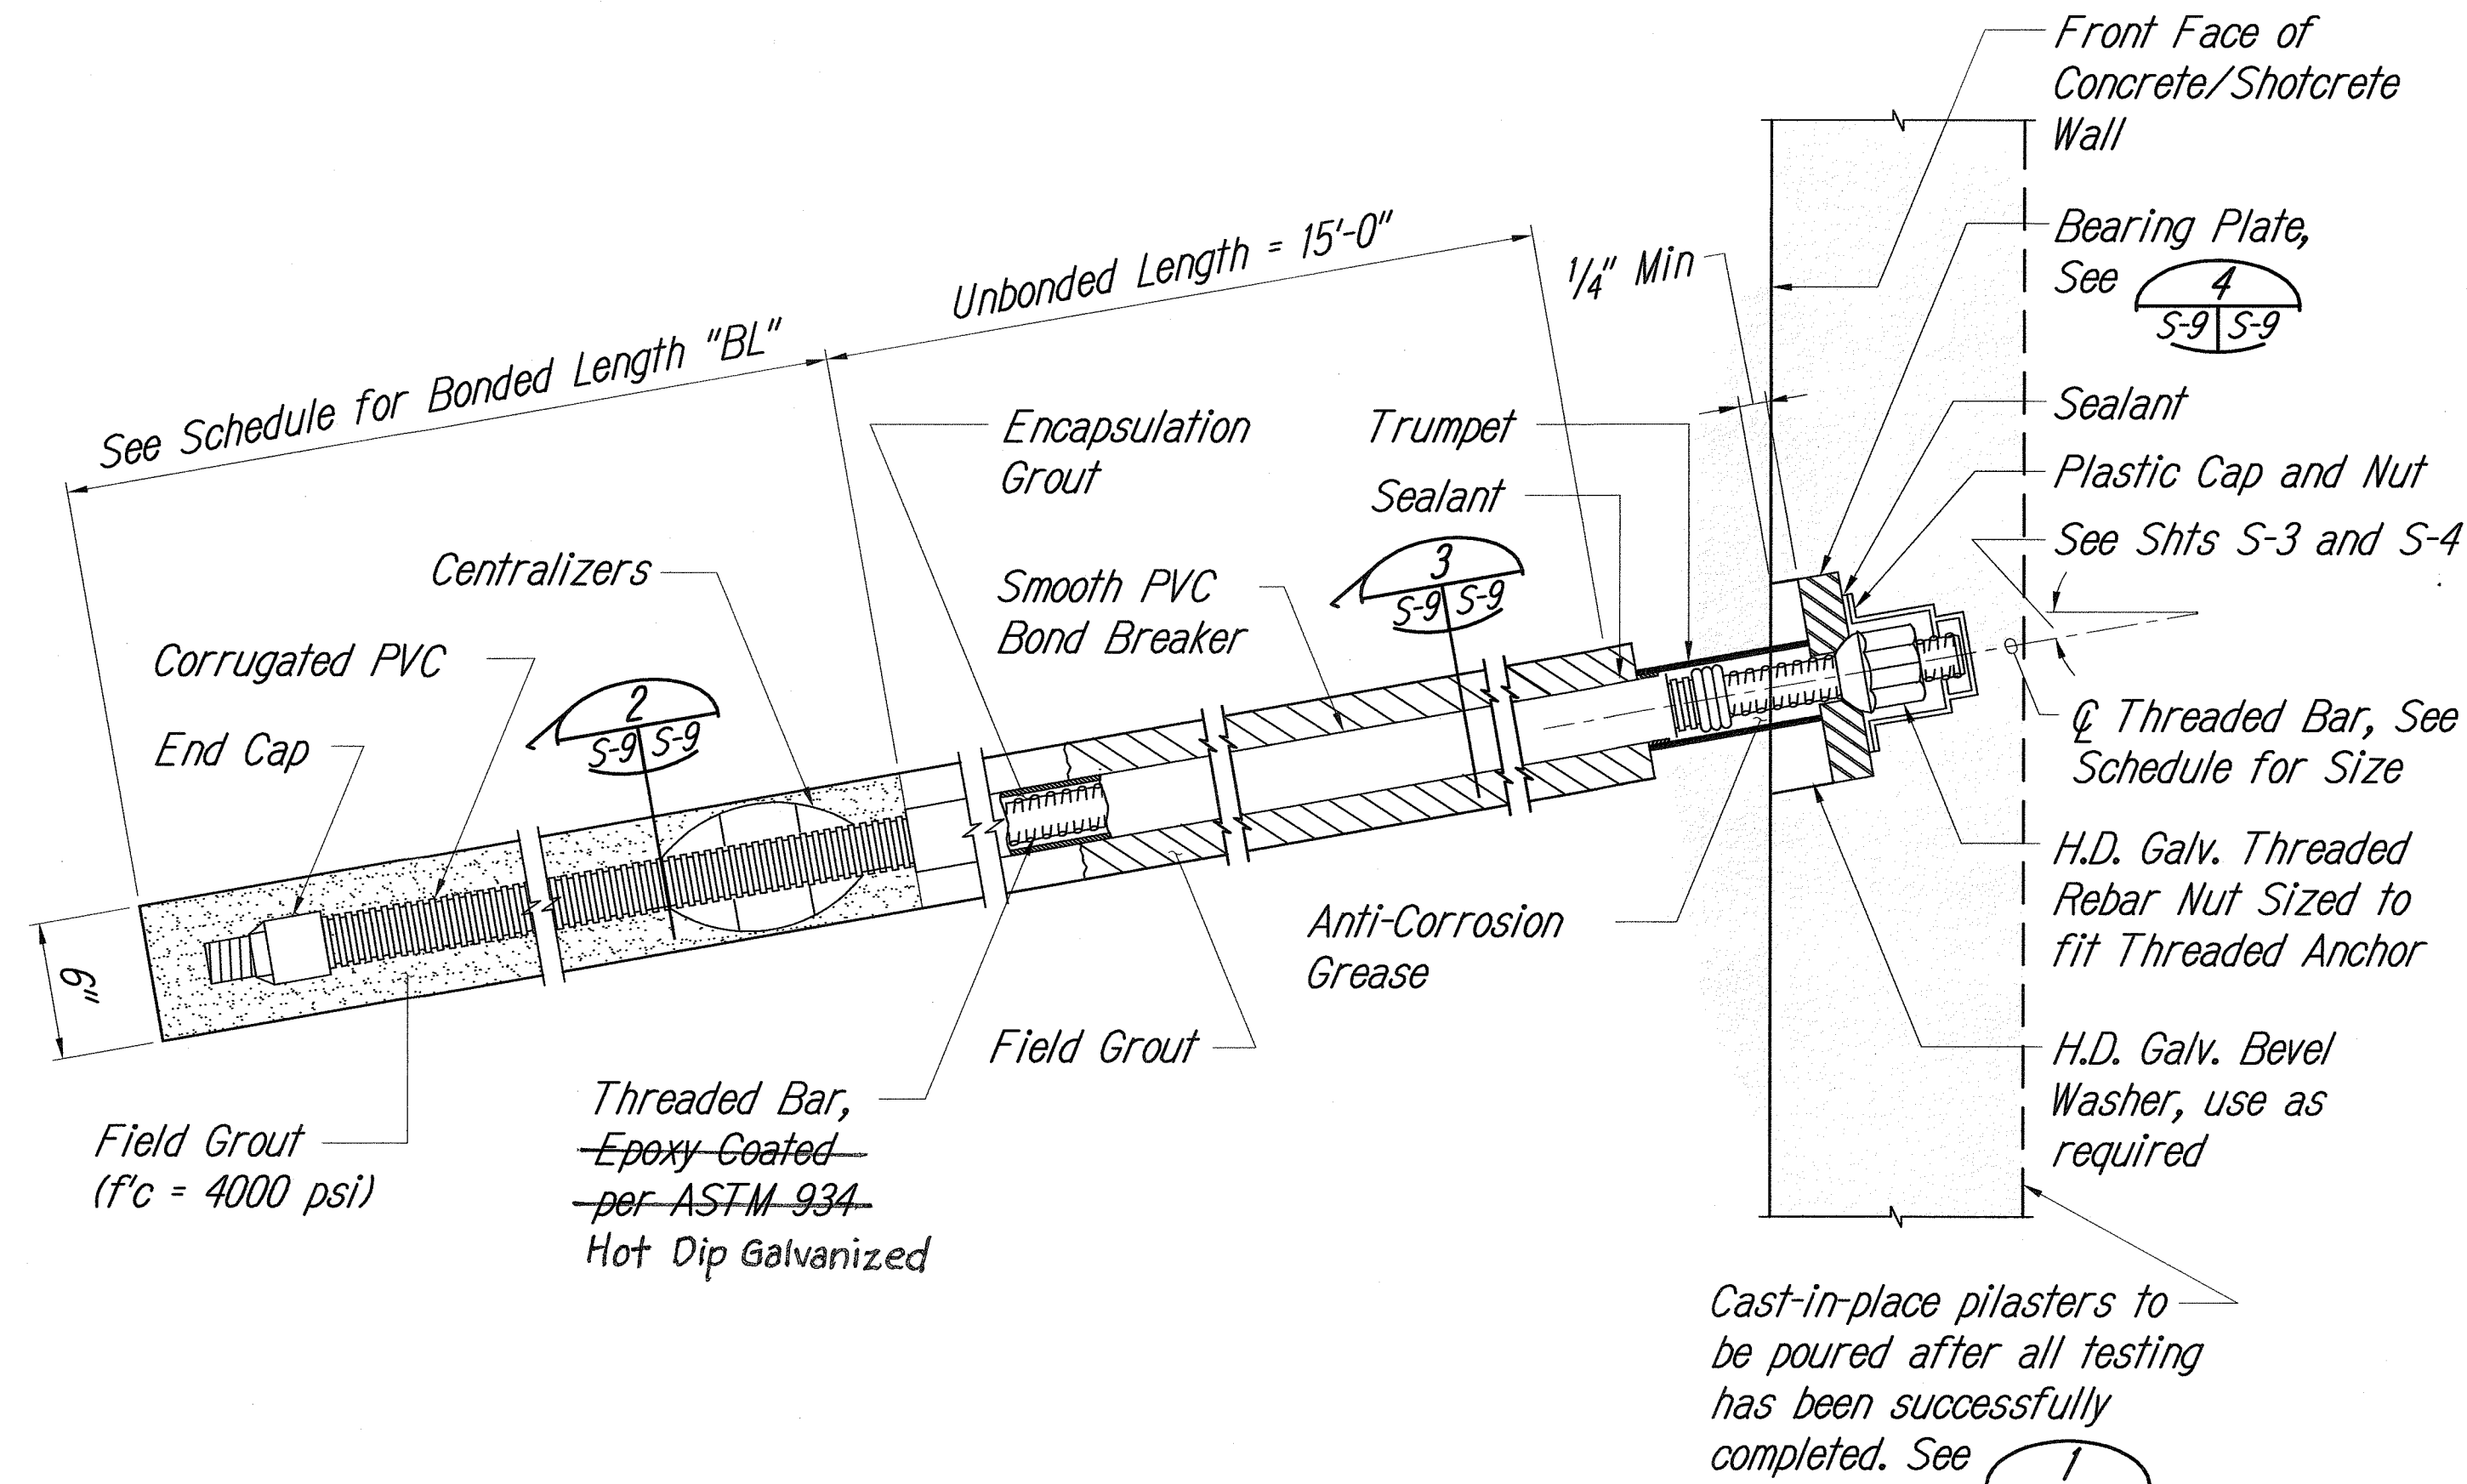


SOIL ANCHOR DETAIL
Not to Scale

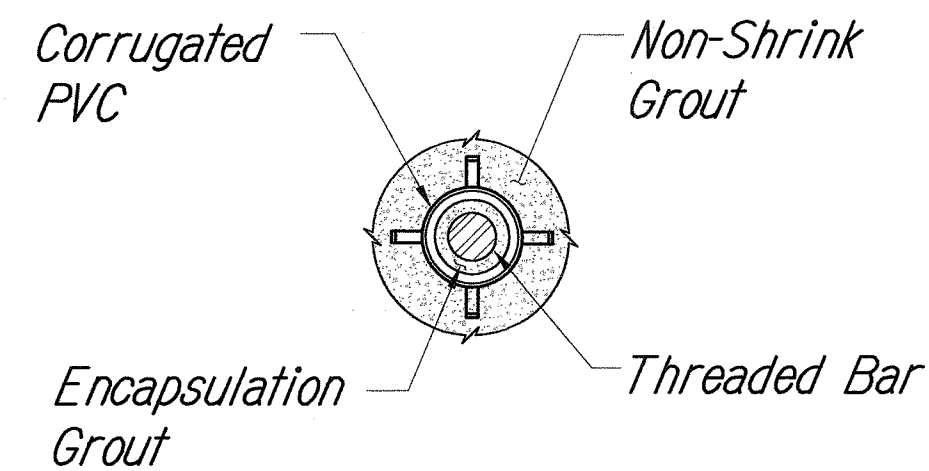

SECTION 2
Not to Scale

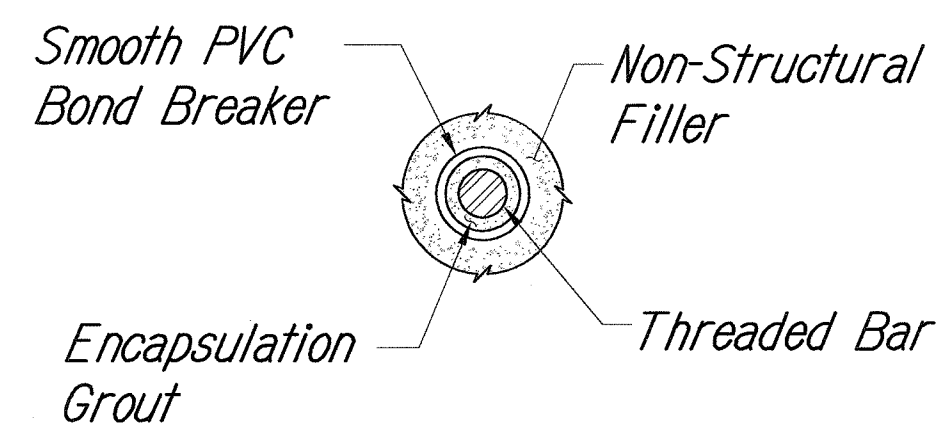

SECTION 3
Not to Scale

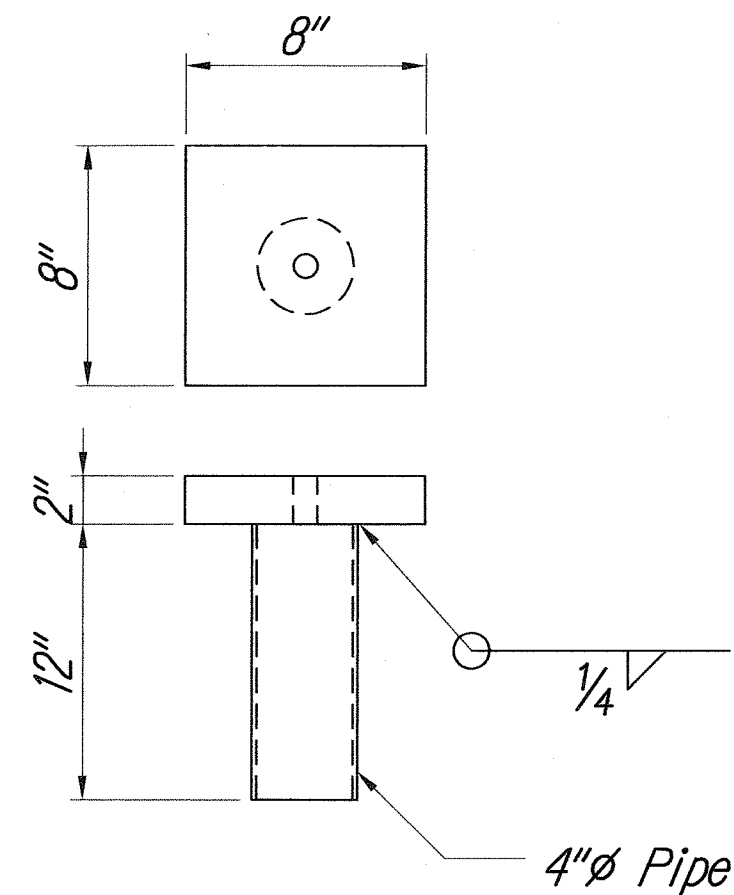

BEARING PLATE DETAIL
Not to Scale

Soil Anchor Notes:

1. Soil Anchor threaded bar shall be ASTM A722, type II, Grade 150 and galvanized per ASTM A153. See Schedule for Bar diameter. Yield strength shall not be reduced by more than 5% after galvanizing. In addition, angle compensating nuts or bevel washer set shall be galvanizing per ASTM 123.
2. See Schedule for required soil anchor design load, DL, test load, TL, and lock off load, LL.
3. Grout tubes shall be placed thru the 2" x 8" x 8" steel bearing plate. Size and locations shall ensure full grouting of hole. The contractor shall submit grouting details for approval by the engineer.
4. Centralizers shall be placed at 10-foot intervals in the bonded length, with the bottom centralizer located 5 feet from the bottom of the bonded length.
5. Drilling of the soil anchor holes may encounter loose/soft fill extremely weathered basalt rock and hard unweathered basalt rock. Special drilling tools for drilling into the basalt rock formation will be required. Temporary casing of the drilled holes for the soil anchors may be required when cave-in conditions occur during the drilling of the soil anchor holes, especially in the loose/soft fill and the extremely weathered basalt rock at the site.
6. Grouts shall attain a minimum compressive strength of 4000 psi prior to stressing. Testing for compressive strength shall conform to ASTM C-109 mortar and sand.
7. Smooth and corrugated sheaths/sleeves shall be High-Density Polyethylene (HDPE) conforming to ASTM D 3350 and having a minimum strength of 7,000 psi and 0.06 in wall thickness.
8. When lifting the soil anchors for installation into the holes, multiple pick points shall be used to avoid bending or damaging the threaded bar and/or encapsulation grout.
9. Soil anchor threaded bar shall be new and free of any surface damages, kinks, and sharp bend.
10. A Geotechnical Engineer, licensed in the State of Hawaii, shall be present to monitor the installation and testing of soil anchors. Contractor shall coordinate the installation and testing schedule with the State's Project Engineer.
11. A performance test on the first installed soil anchor shall be performed. See specifications for details.
12. All other soil anchors shall be proof tested. See specifications for details.

SOIL ANCHOR BONDED LENGTH AND LOADING SCHEDULE

HEIGHT "H"	AT MP 12.9						AT MP 26.1					
	"A"	"S"	"BL"	"DL"	"TL"	"LL"	"A"	"S"	"BL"	"DL"	"TL"	"LL"
≤ 22'-0"	-	-	-	-	-	-	1 1/4"	5'-0"	50'-0"	28	37	22
≤ 20'-0"	-	-	-	-	-	-	1 1/4"	5'-0"	45'-0"	22	29	18
≤ 18'-0"	-	-	-	-	-	-	1 1/4"	5'-0"	40'-0"	15	20	12
≤ 16'-0"	-	-	-	-	-	-	1"	5'-0"	35'-0"	15	20	12
≤ 14'-0"	1"	5'-0"	45'-0"	25	33	20	1"	6'-0"	35'-0"	12	16	10
≤ 12'-0"	1"	5'-0"	40'-0"	28	37	22	1"	7'-0"	35'-0"	10	13	8
≤ 10'-0"	1"	5'-0"	35'-0"	19	26	16	1"	10'-0"	35'-0"	8	11	7

TRUMPET OPENING SIZE SCHEDULE


ANCHOR DIAMETER	TRUMPET OPENING SIZE
1"	3 1/2"
1 1/4"	3 3/4"

SOIL ANCHOR SCHEDULE AT MP 26.1 AT DRAIN MANHOLE

ANCHOR	"A"	"BL"	"DL"	"TL"	"LL"
Anchor ①	1"	35'-0"	12	15	9
Anchor ②	1"	35'-0"	9	12	7

Legend:

- A = Anchor Threaded Bar Diameter (in)
S = Max Horizontal Anchor Spacing (ft)
BL = Bonded Length (ft)
DL = Design Load (kips)
TL = Test Load (kips)
LL = Lock Off Load (kips)

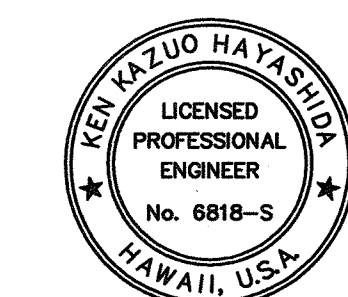

6-30-10	Revised Soil Anchor Detail per Addendum 2.
DATE	REVISION
STATE OF HAWAII DEPARTMENT OF TRANSPORTATION HIGHWAYS DIVISION	
SECTIONS AND DETAILS	
EMERGENCY EARTHQUAKE ROCKFALL REPAIRS AT VARIOUS LOCATIONS	
F.A. Project No. ER-15(21)	
Scale: As Noted	Date: December, 2009
SHEET No. 5-9 OF 9 SHEETS	