



FED. ROAD DIST. NO.	STATE	FED. AID PROJ. NO.	FISCAL YEAR	SHEET NO.	TOTAL SHEETS
HAWAII	HAW.	HSIP-019-1(41)	2018	ADD.7	43

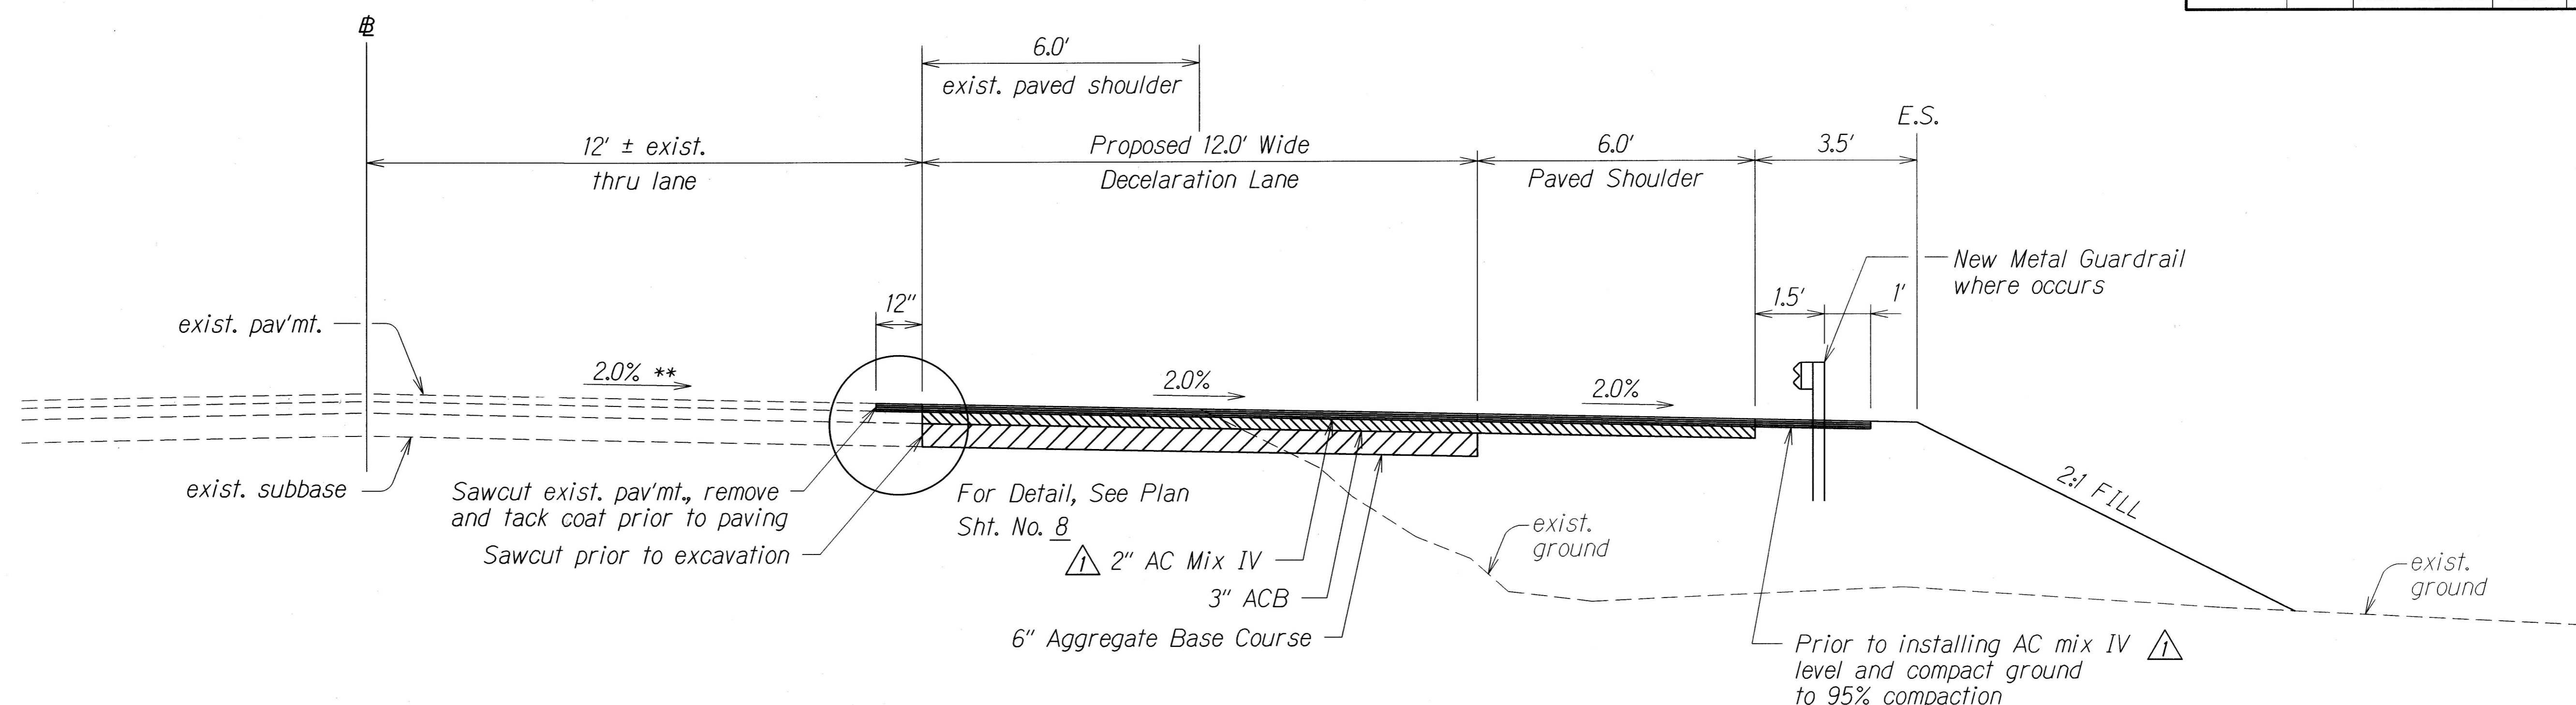

KAWAIHAE ROAD # STA. 85+63 TO # STA. 89+50 (Looking Towards Waimea)

Scale: 1/2" = 1'

** Match existing lane cross slope at super elevated curves

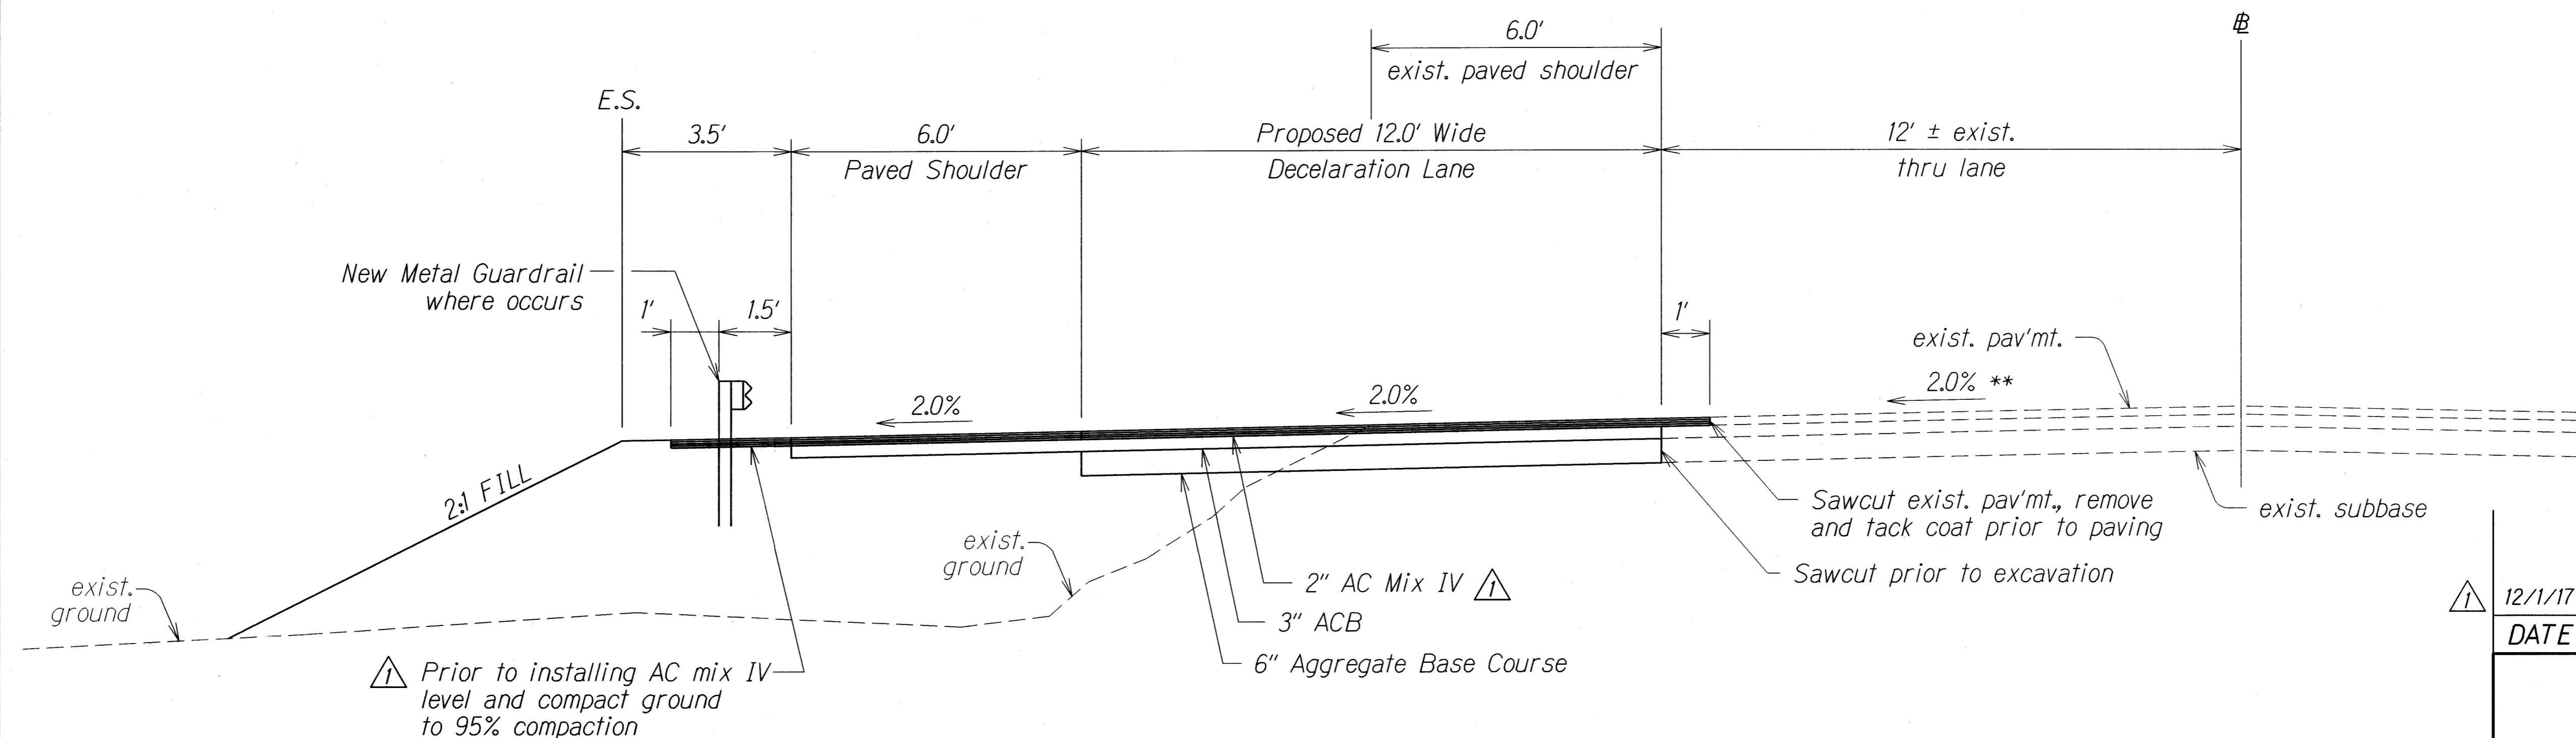

QUEEN KA'AHUMANU HIGHWAY # STA. 6+00 TO # STA. 9+74 (Looking Towards Kailua)

Scale: 1/2" = 1'

** Match existing lane cross slope at super elevated curves

DATE	REVISION
12/1/17	Revised Mix V to Mix IV.

STATE OF HAWAII
DEPARTMENT OF TRANSPORTATION
HIGHWAYS DIVISION

TYPICAL SECTIONS
QUEEN KA'AHUMANU HIGHWAY
INTERSECTION IMPROVEMENTS
AT KAWAIHAE ROAD

Federal-Aid Project No. HSIP-019-1(41)


Scale: 1/2" = 1'-0" Date: Sept., 2017

SHEET No. 1 OF 2 SHEETS


ADD.7

ORIGINAL PLAN	SURVEY PLOTTED BY	DATE
NOTED	DRAWN BY	
DESIGNED BY	CHECKED BY	
CHECKED BY		


FED. ROAD DIST. NO.	STATE	FED. AID PROJ. NO.	FISCAL YEAR	SHEET NO.	TOTAL SHEETS
HAWAII	HAW.	HSIP-019-1(41)	2018	ADD.8	43

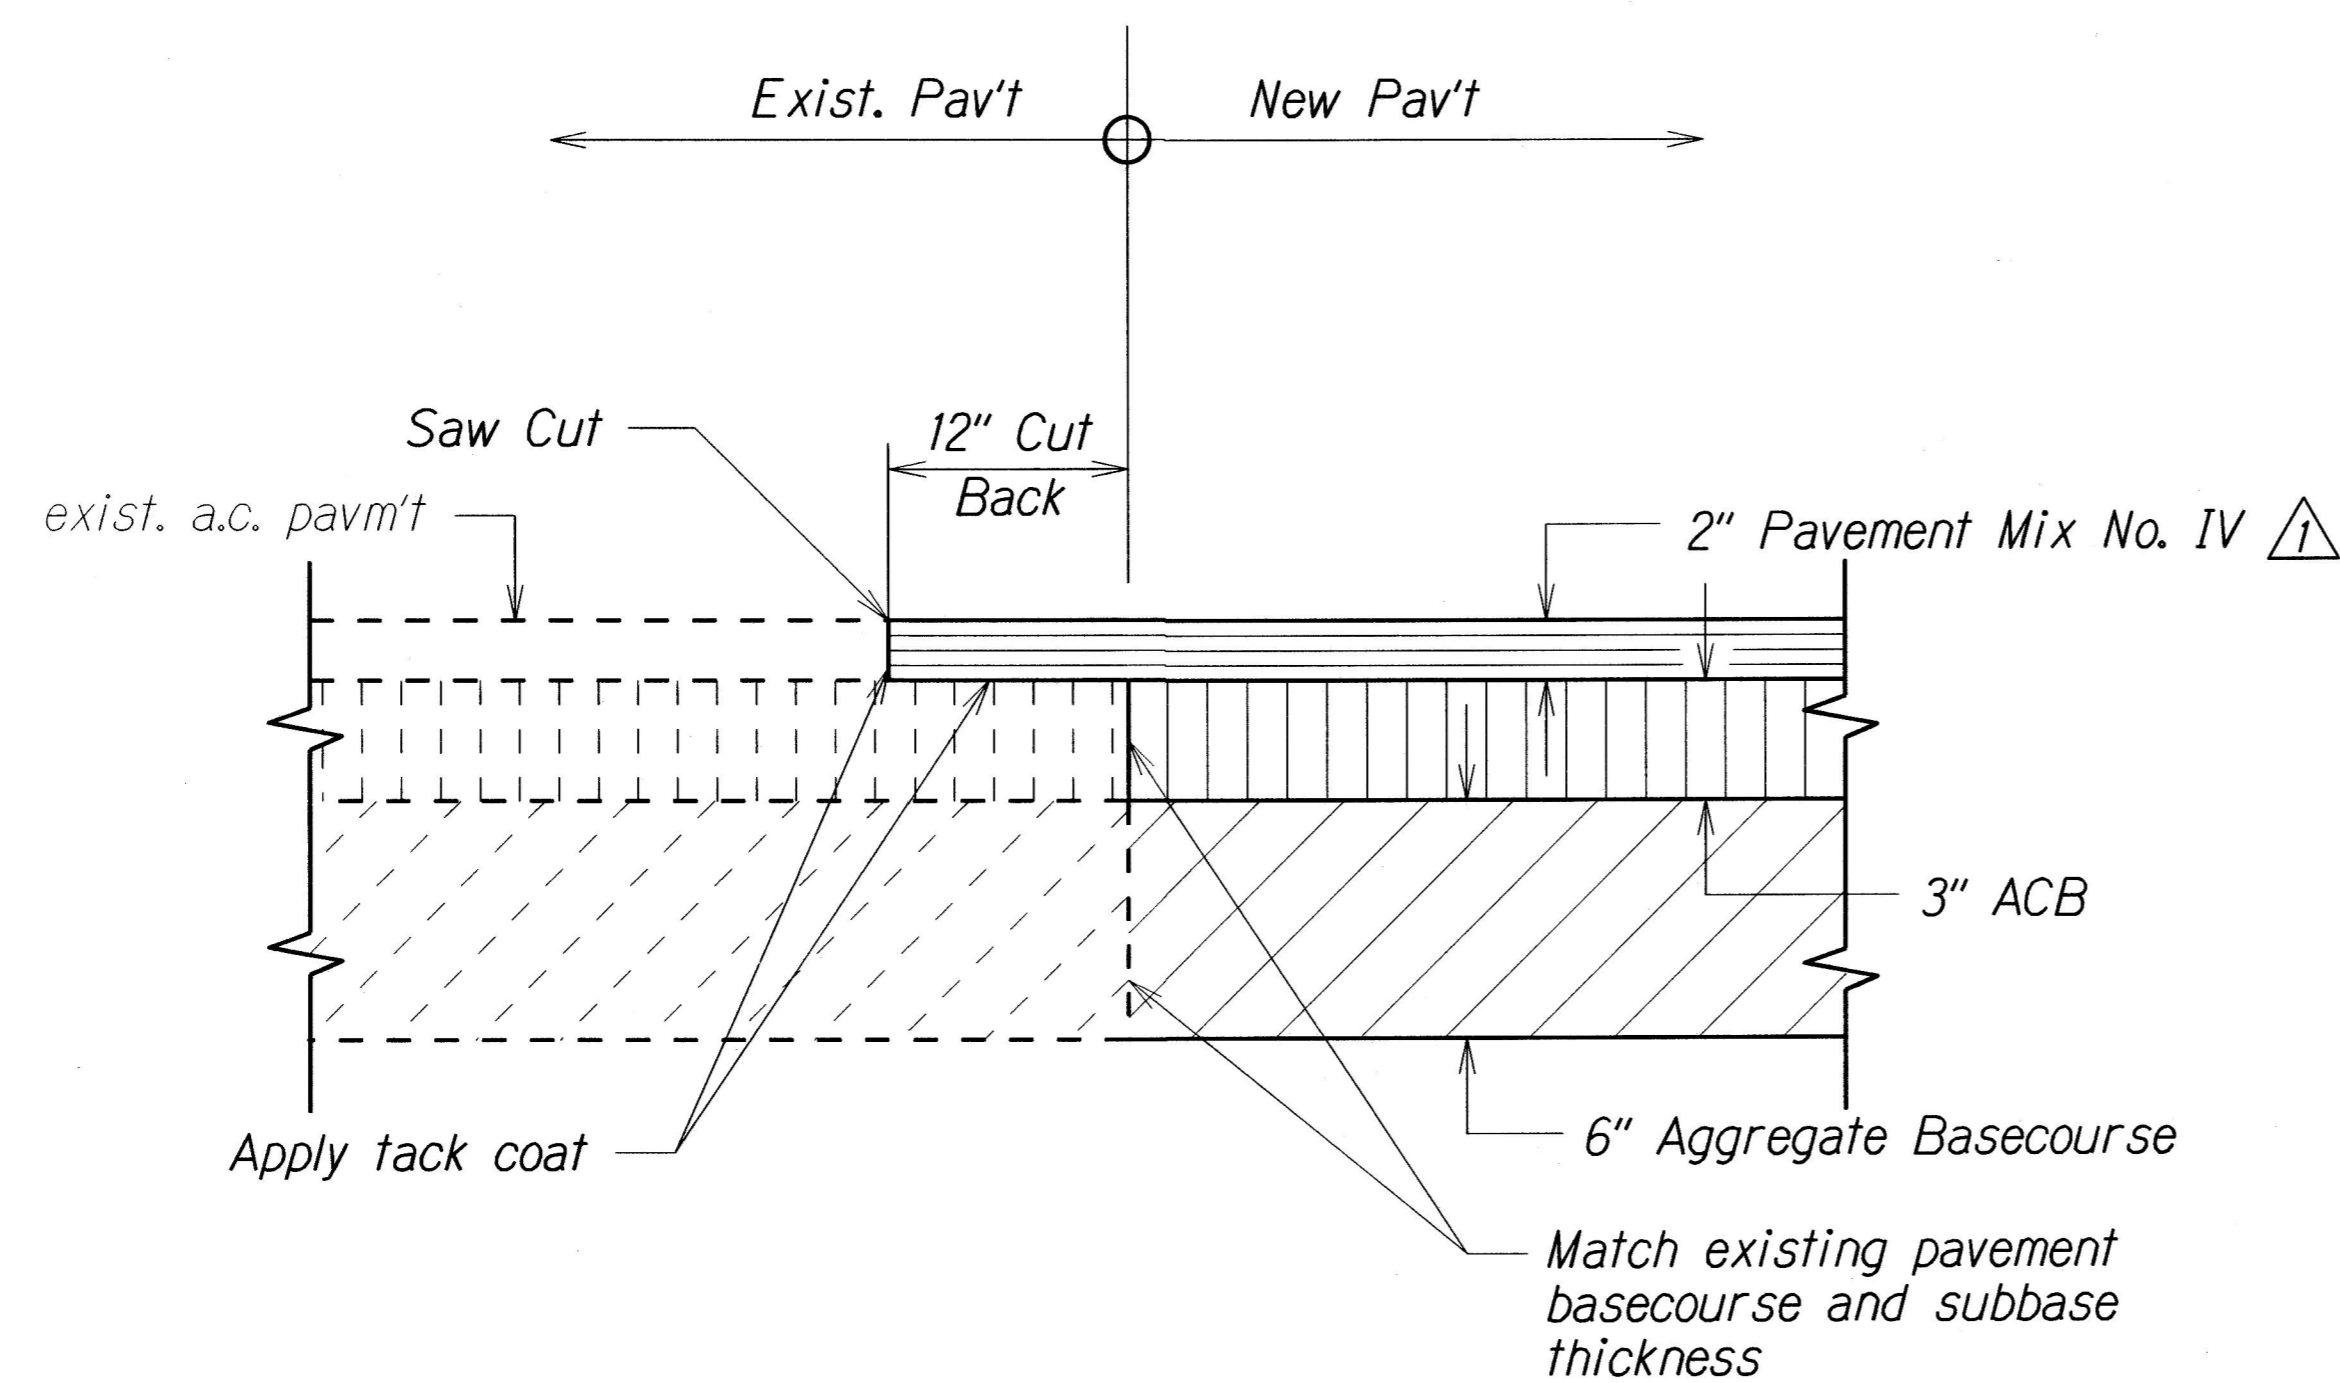

DETAIL
Not To Scale

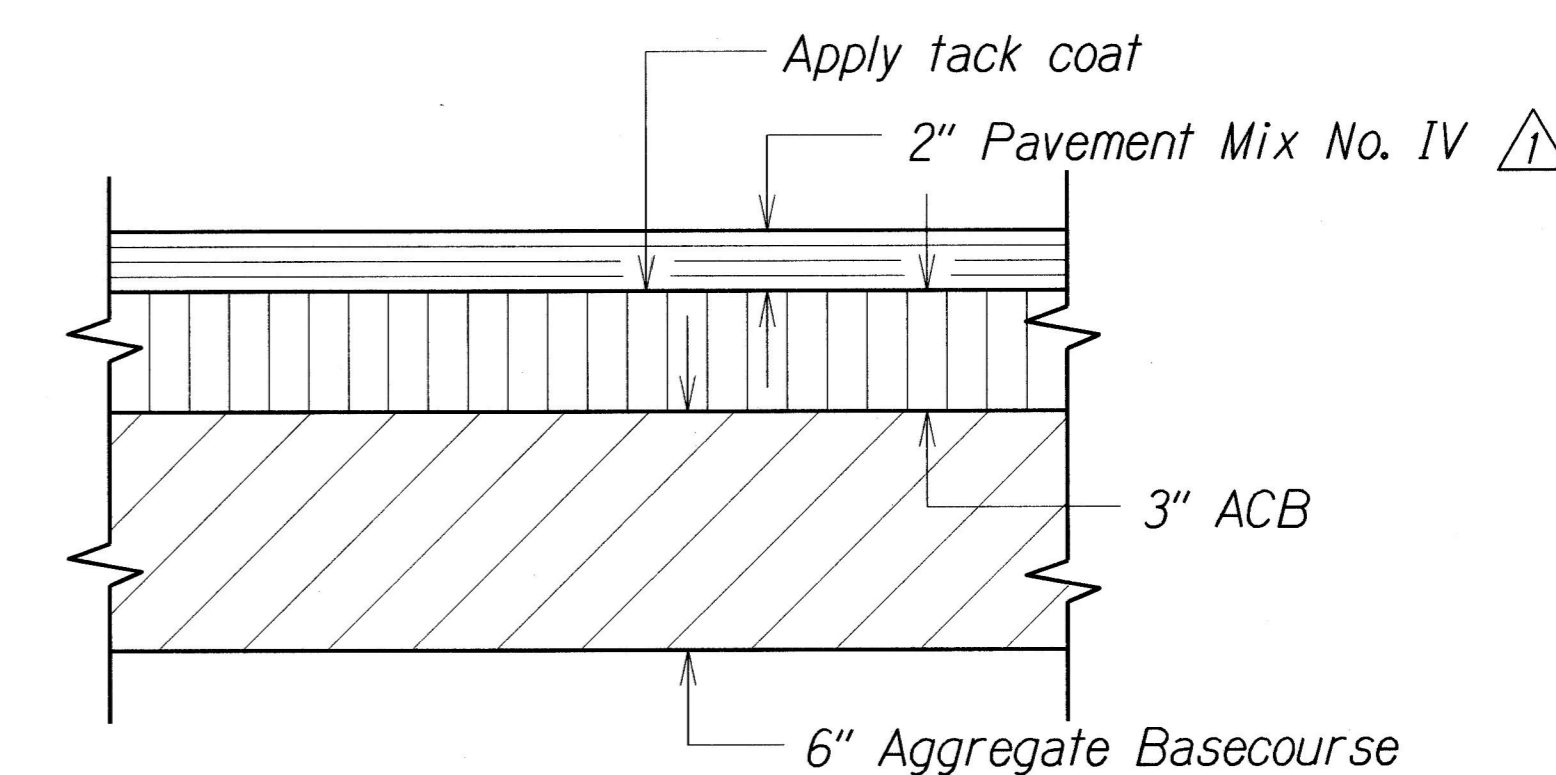

NEW A.C. PAVEMENT SECTION
Not To Scale

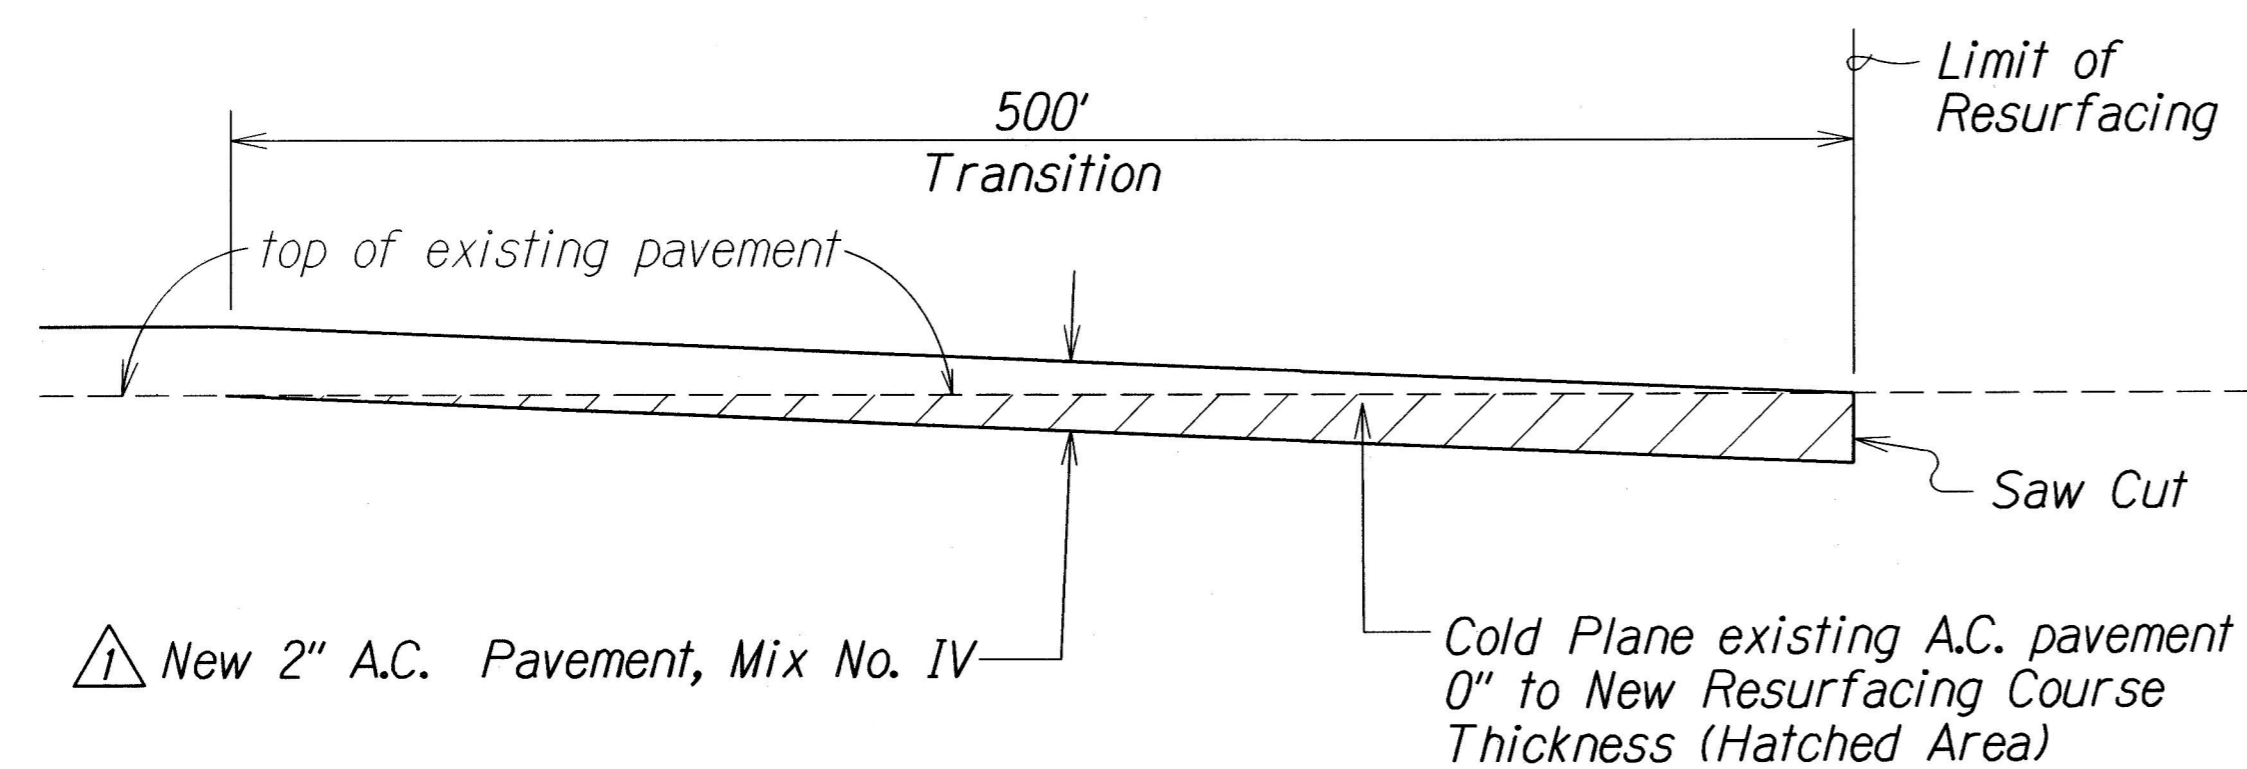

COLD PLANED TRANSITION
TO EXISTING A.C. PAVEMENT
Not To Scale

ORIGINAL PLAN	SURVEY PLOTTED BY	DATE
NOTED BY	DRAWN BY	
CHECKED BY	QUANTITIES BY	

12/1/17	Revised Mix V to Mix IV.
DATE	REVISION
STATE OF HAWAII DEPARTMENT OF TRANSPORTATION HIGHWAYS DIVISION <u>TYPICAL SECTIONS</u> <u>QUEEN KA'AHUMANU HIGHWAY</u> <u>INTERSECTION IMPROVEMENTS</u> <u>AT KAWAIHAE ROAD</u> <u>Federal-Aid Project No. HSIP-019-1(41)</u> Scale: 1/2" = 1'-0" Date: Sept., 2017	
SHEET No. 2 OF 2 SHEETS	