


FED. ROAD DIST. NO.	STATE	FED. AID PROJ. NO.	FISCAL YEAR	SHEET NO.	TOTAL SHEETS
HAWAII	HAW.	HSIP-019-1(41)	2018	ADD.16	43

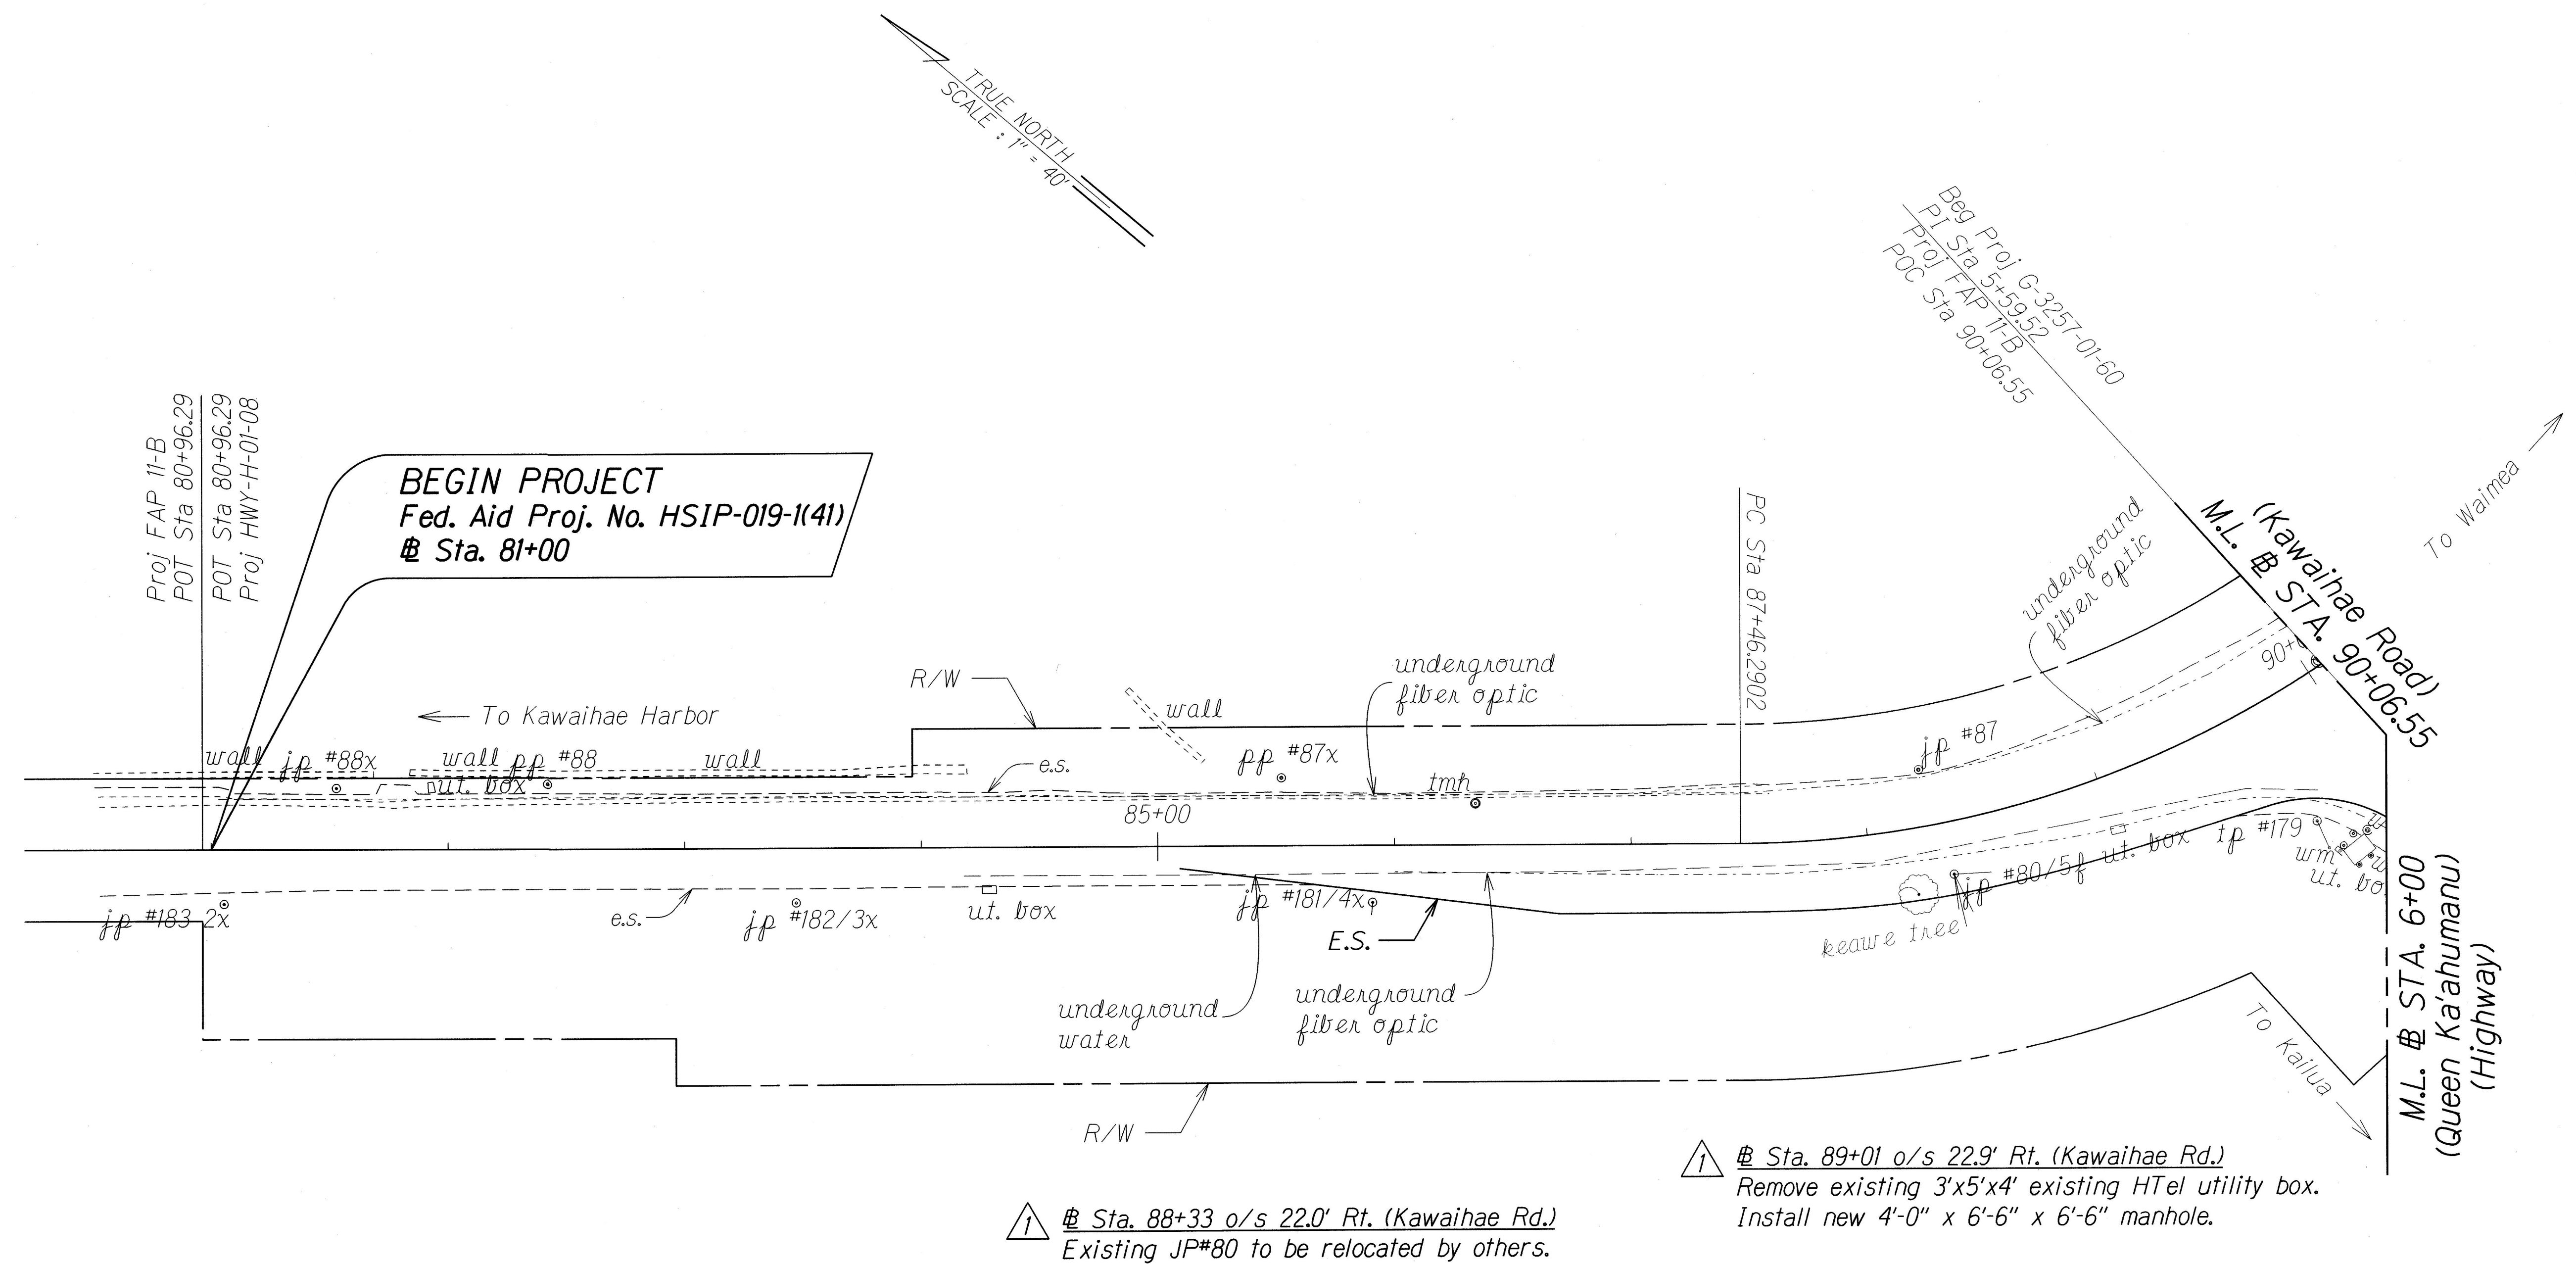

KAWAIHAE ROAD

1 *Note: Unless otherwise noted on the plans, existing utility lines and appurtenances shall remain in place.*

1	12/1/17	Notes added.
	DATE	REVISION

STATE OF HAWAII
DEPARTMENT OF TRANSPORTATION
HIGHWAYS DIVISION

UTILITY PLAN

QUEEN KA'AHUMANU HIGHWAY
INTERSECTION IMPROVEMENTS
AT KAWAIHAE ROAD


Federal-Aid Project No. HSIP-019-1(41)

Scale: 1" = 40' Date: Sept., 2017

SHEET No. 1 OF 3 SHEETS

ADD.16

FED. ROAD DIST. NO.	STATE	FED. AID PROJ. NO.	FISCAL YEAR	SHEET NO.	TOTAL SHEETS
HAWAII	HAW.	HSIP-019-1(41)	2018	18	43

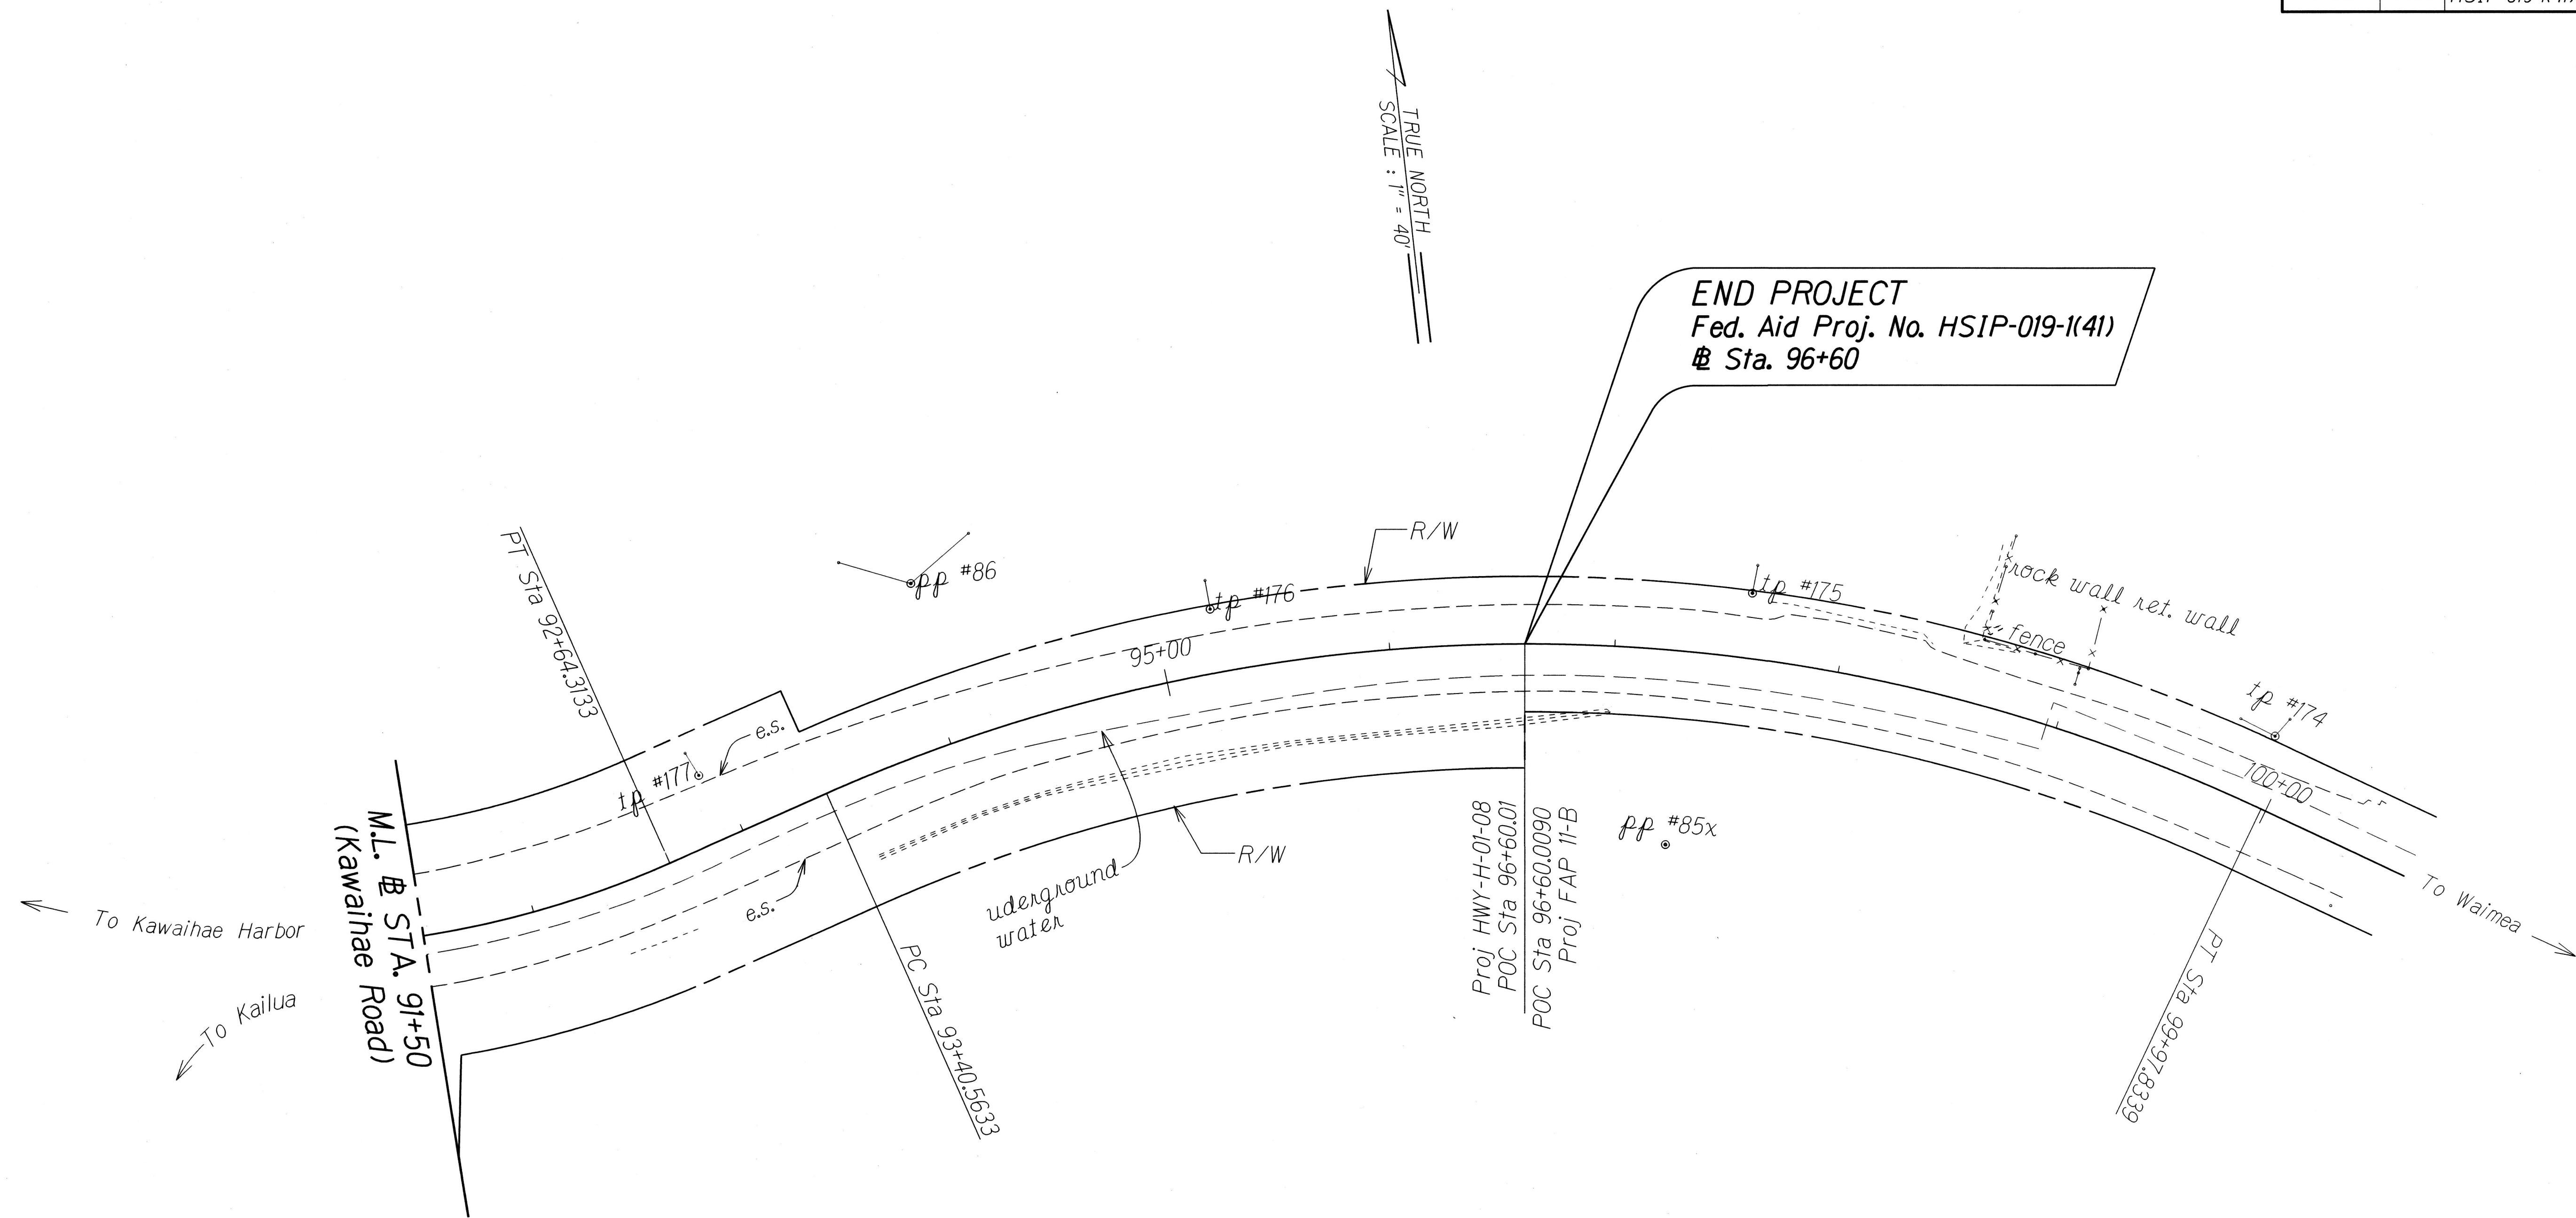

UPPER KAWAIHAE ROAD

ORIGINAL PLAN	DATE
NOTED BY	
DESIGNED BY	
CHECKED BY	

STATE OF HAWAII
DEPARTMENT OF TRANSPORTATION
HIGHWAYS DIVISION

UTILITY PLAN

**QUEEN KA'AHUMANU HIGHWAY
INTERSECTION IMPROVEMENTS
AT KAWAIHAE ROAD**

Federal-Aid Project No. HSIP-019-1(41)
Scale: 1" = 40' Date: Sept., 2017

SHEET No. 3 OF 3 SHEETS