
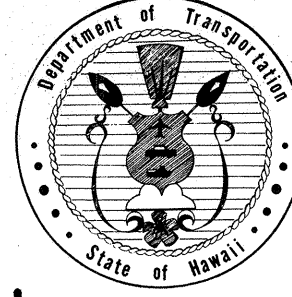


INDEX TO DRAWINGS	
SHEET NO.	DESCRIPTION
1	TITLE SHEET
2	PLAN AND PROFILE
3	CROSS SECTION
4-5	BARRICADE DETAILS
6-11	STANDARD DETAILS

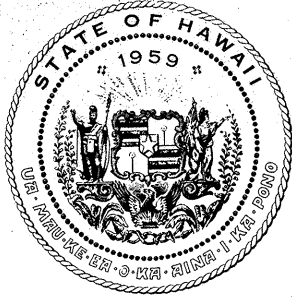

STATE OF HAWAII
DEPARTMENT OF TRANSPORTATION
LAND TRANSPORTATION FACILITIES DIVISION

"AS-BUILT" PLANS FOR


HAWAII BELT ROAD

SIGHT DISTANCE IMPROVEMENT AT
KEALAKAHA BRIDGE

PROJECT NO. 19G-01-75


SCALES

PLAN	-----	INCH = 50 FT.
PROFILE	-----	HOR. INCH = 50 FT.
	-----	VER. INCH = 5 FT.
CROSS SECTION	-----	HOR. INCH = 10 FT.
	-----	VER. INCH = 10 FT.

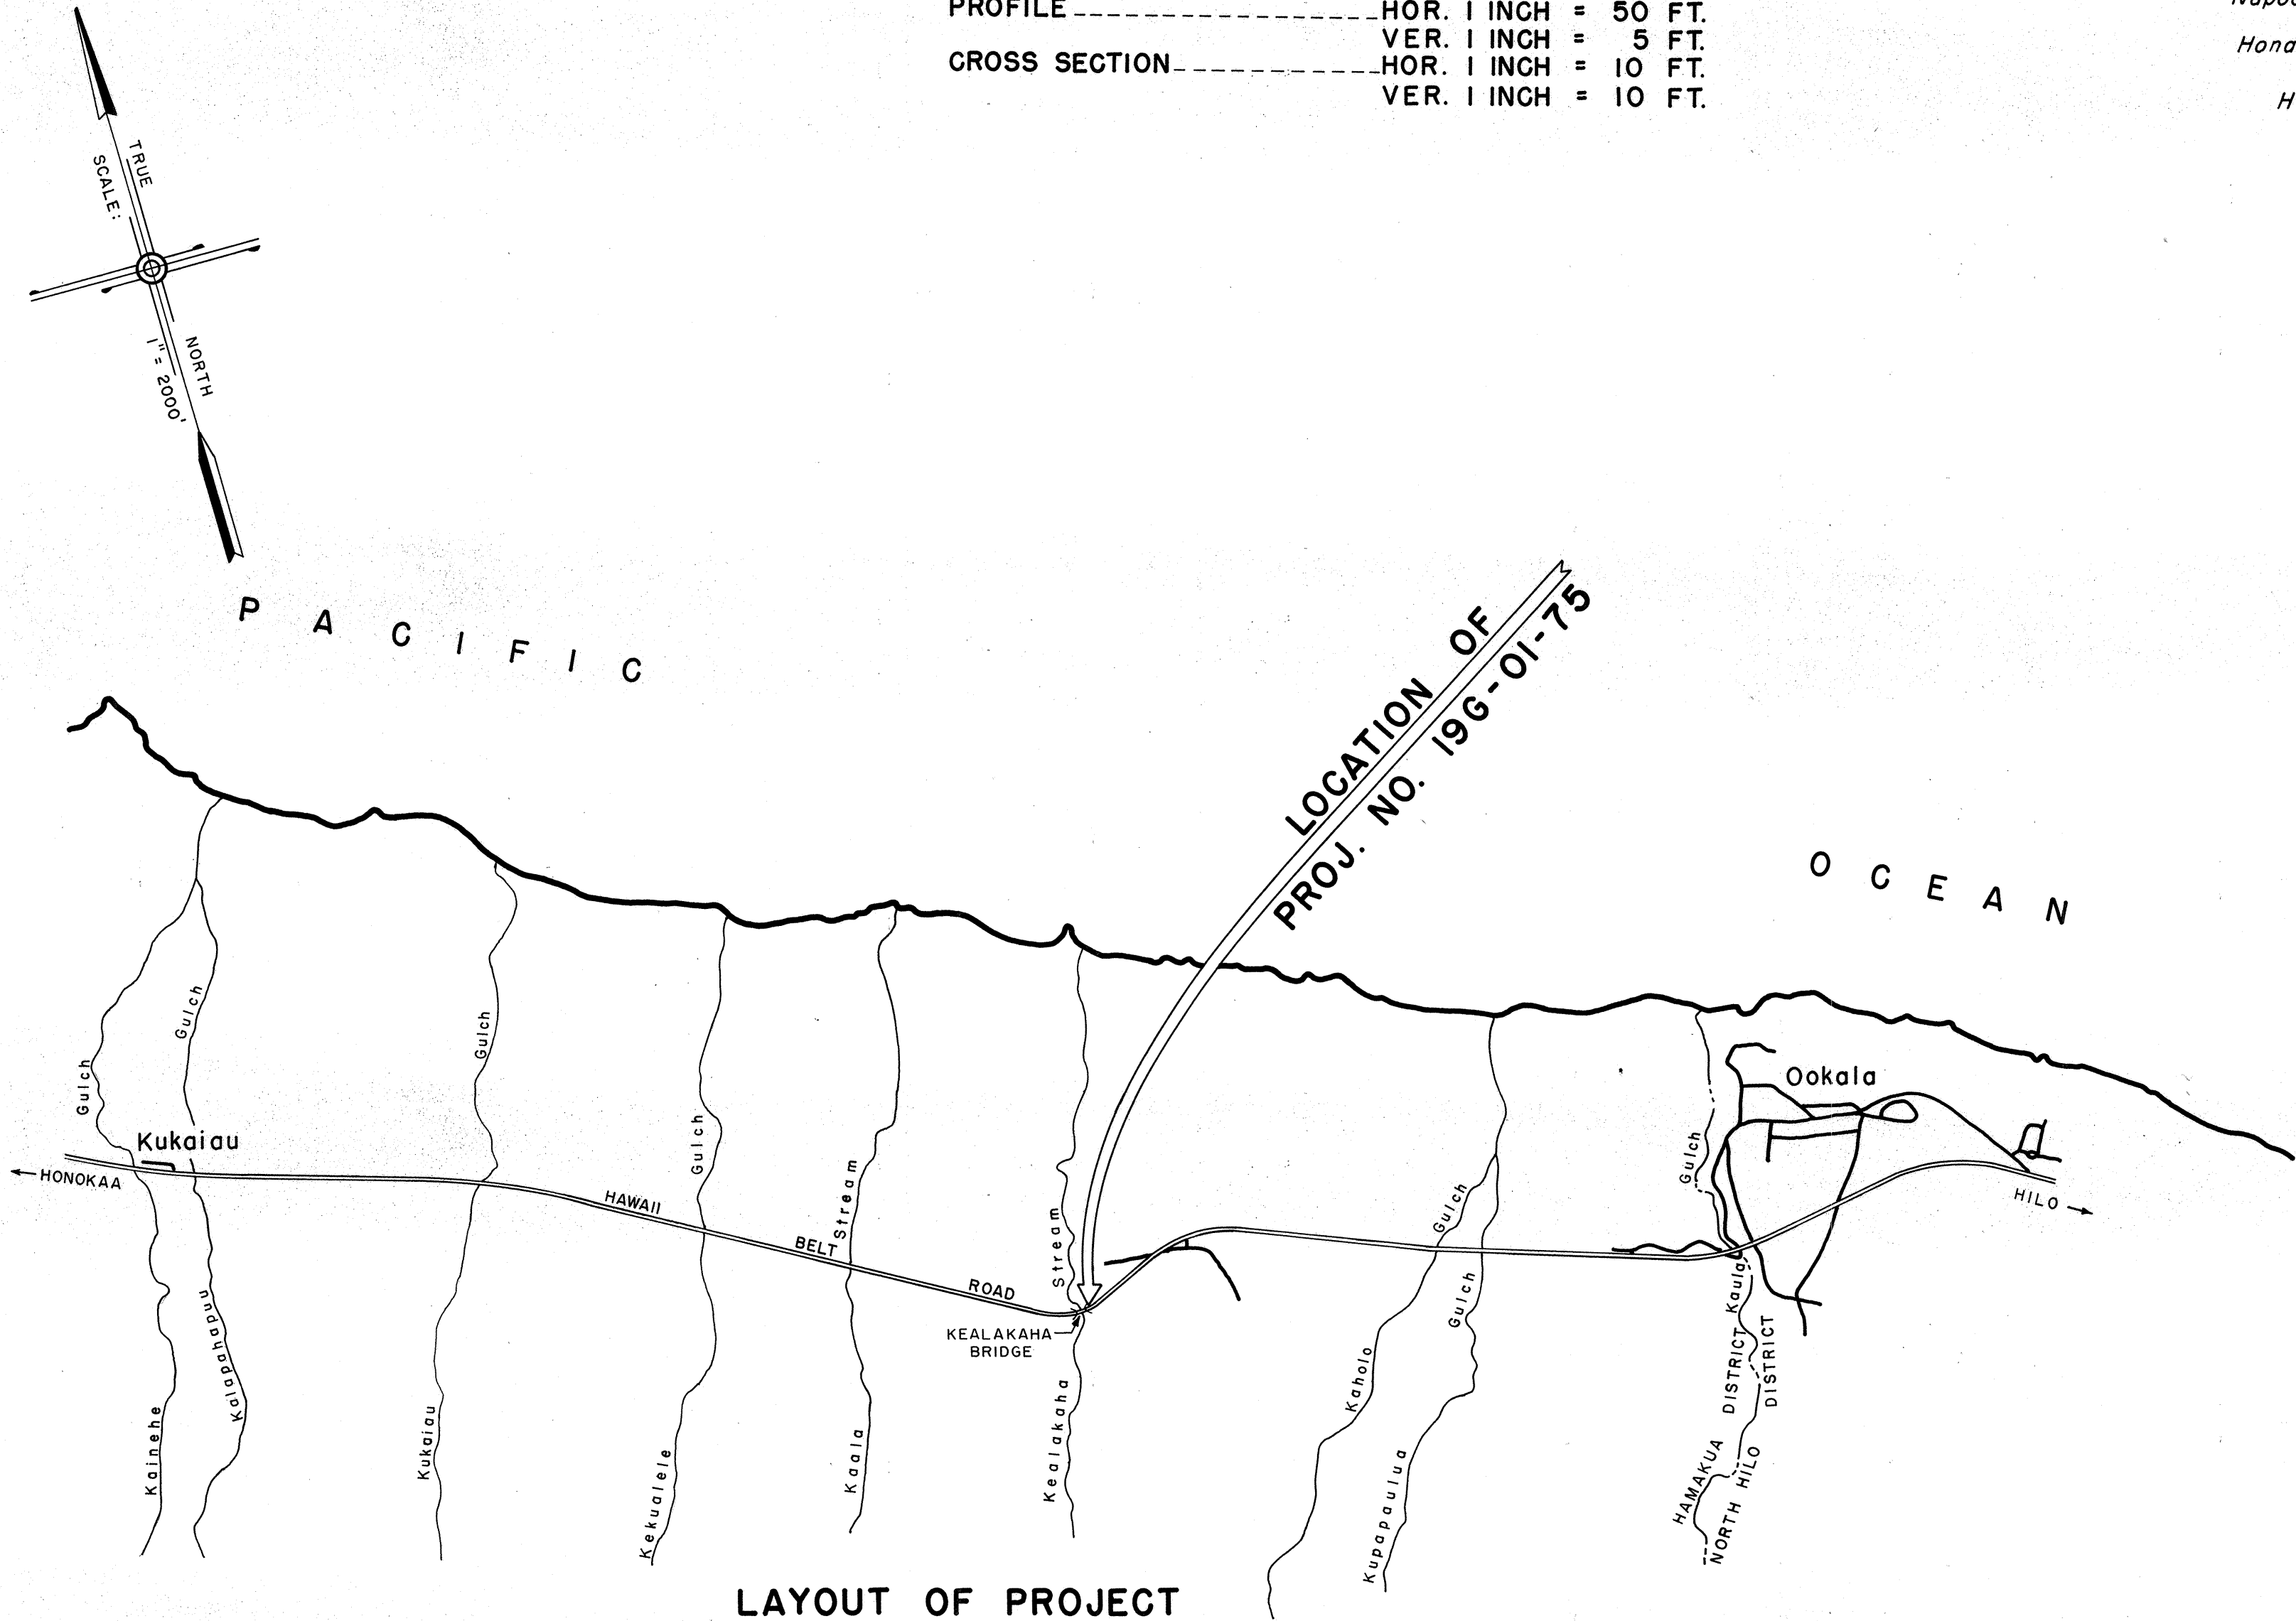

LAYOUT OF PROJECT

Scale: 1" = 2000'

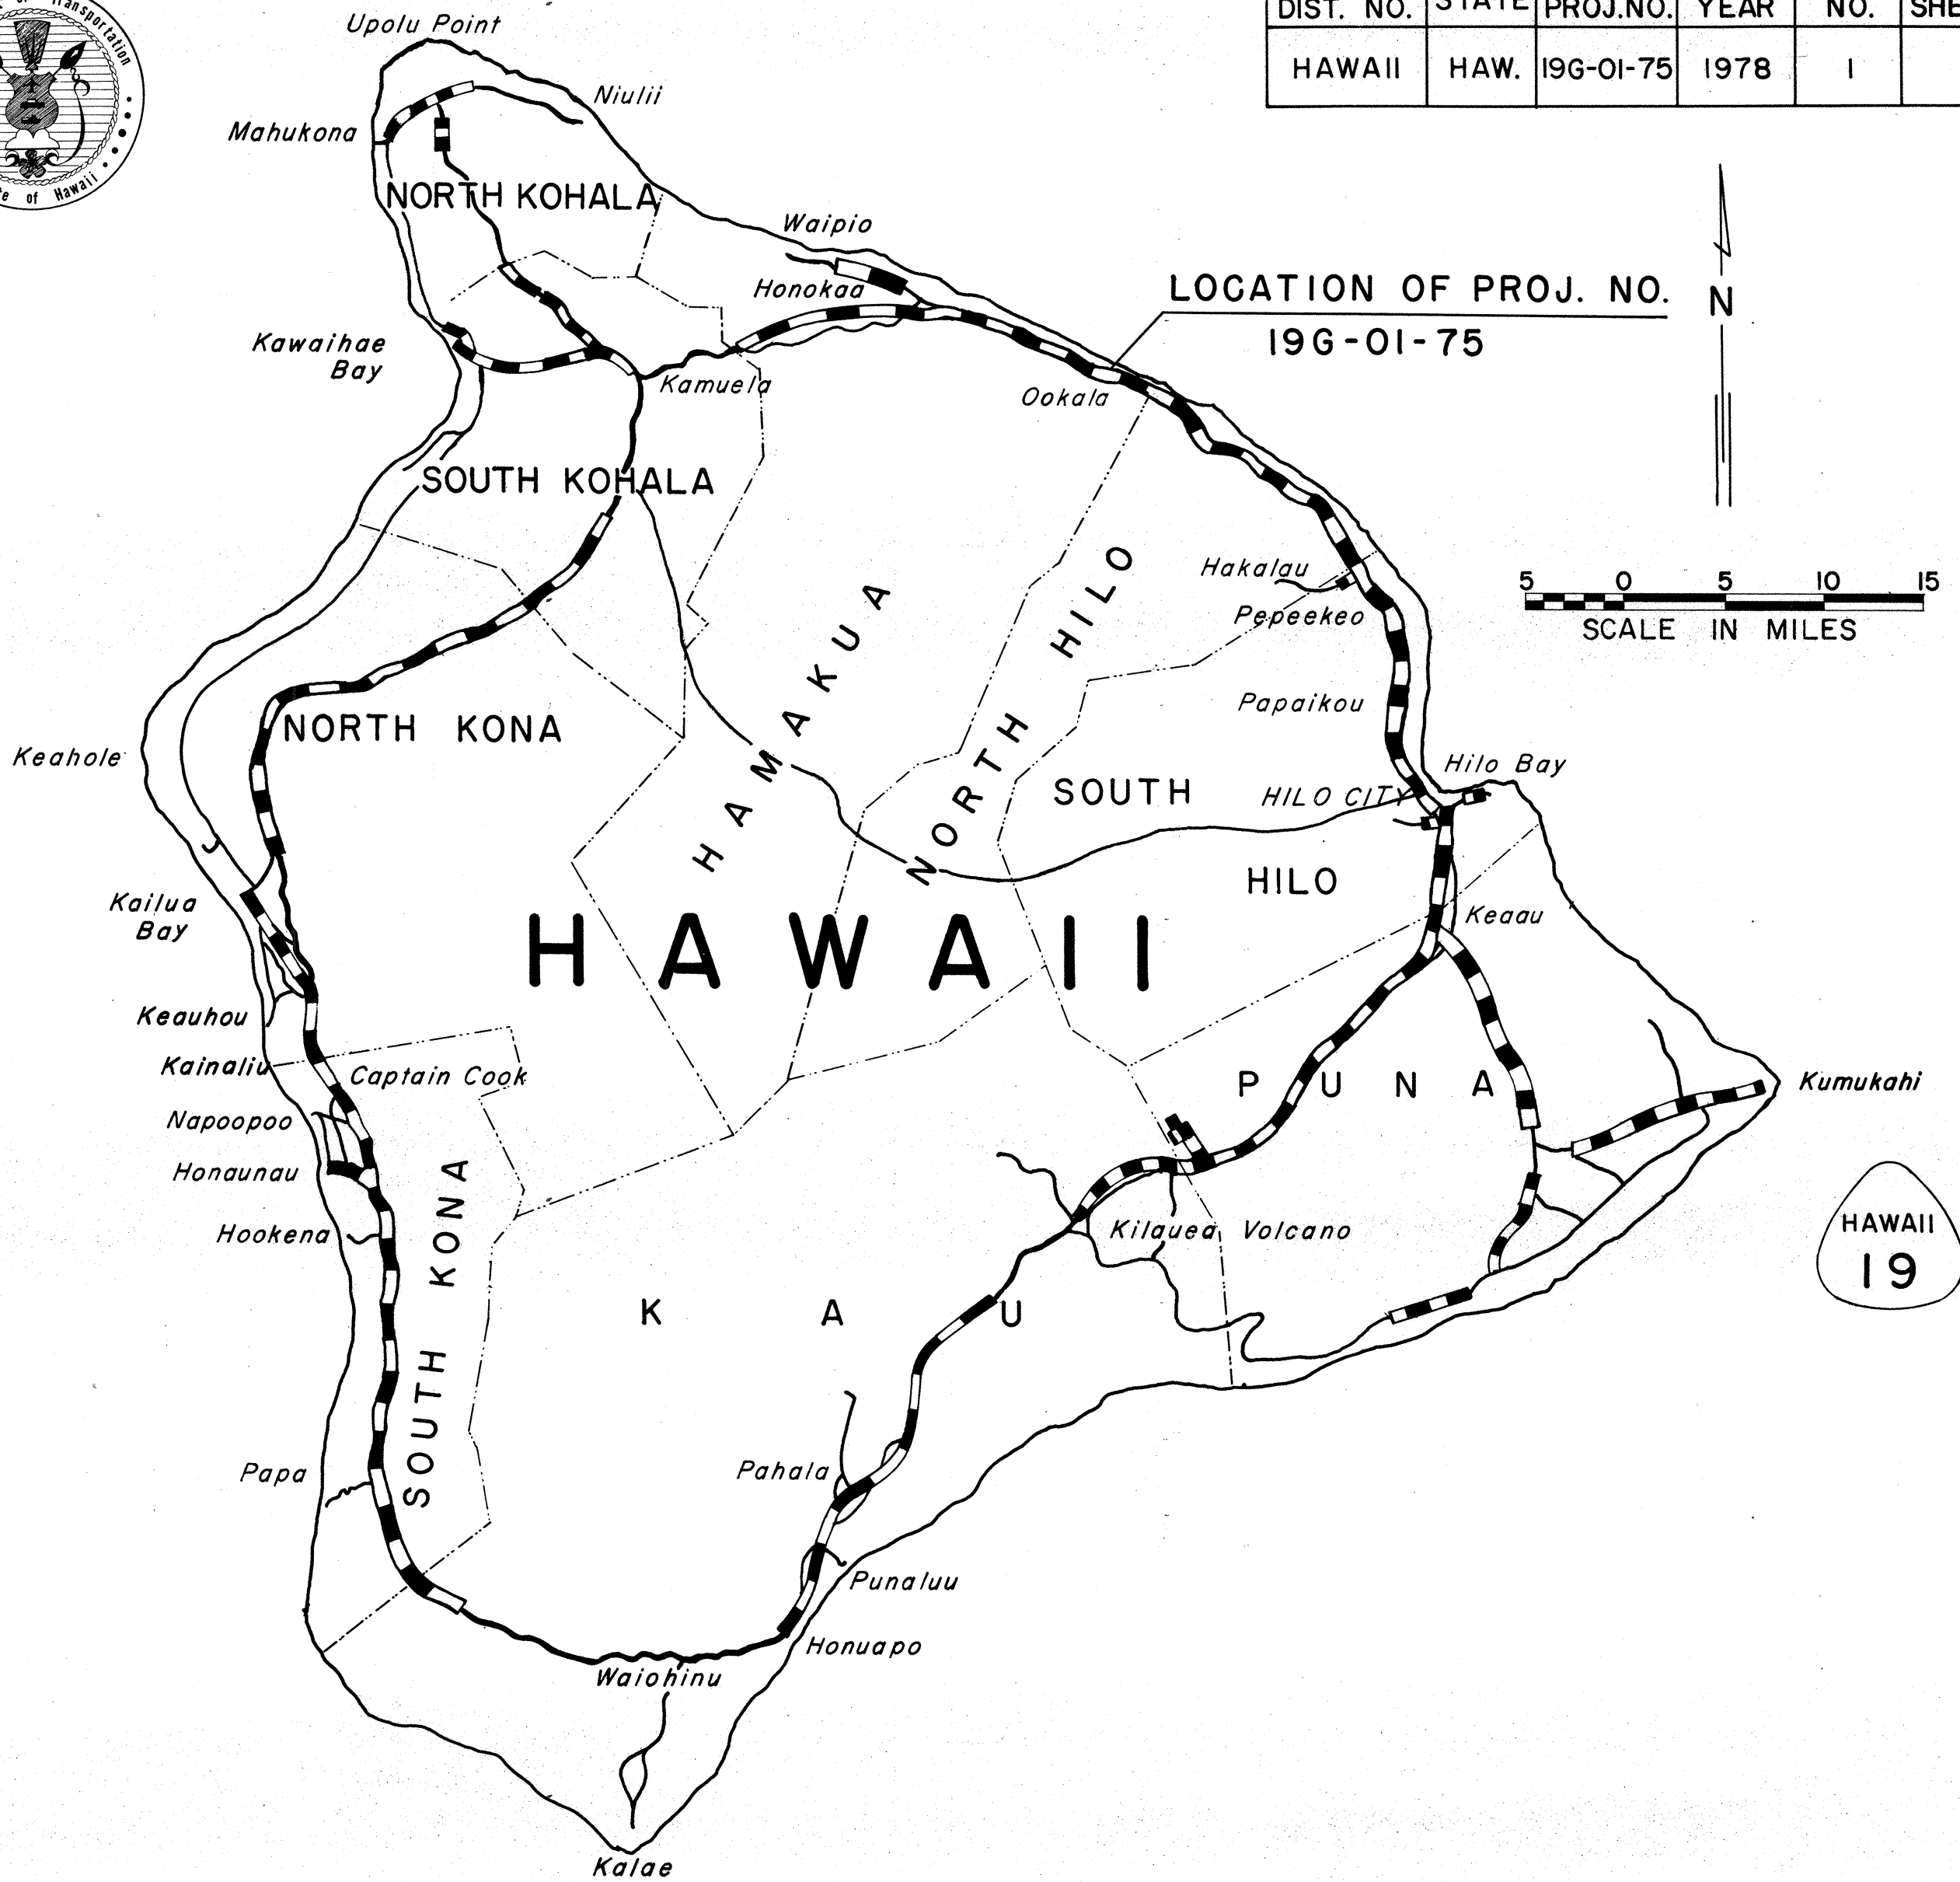

Federal Aid Projects Previously Constructed Or Under Construction

ALL CHANGES MADE DURING CONSTRUCTION HAVE BEEN INCORPORATED ON THESE PLANS IN RED EXCEPT CHANGES IN THE ORIGINAL THEORETICAL QUANTITIES. FOR ACTUAL QUANTITIES, REFER TO PROJECT LEDGER AND/OR COMPUTATION BOOK.

Conrad V. ...
PROJECT INSPECTOR

7-10-78
DATE

DEPARTMENT OF TRANSPORTATION STATE OF HAWAII	
APPROVED:	
<i>R. Higashionna</i>	11/16/77
for DIR. OF TRANSPORTATION	DATE

HAWAII DISTRICT DESIGNED BY Mike Miura P.S. & E. BY 548-7490 Oct. 1977 DATE

PHONE