
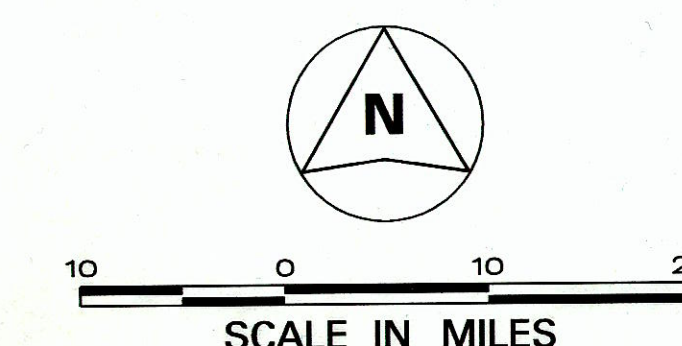
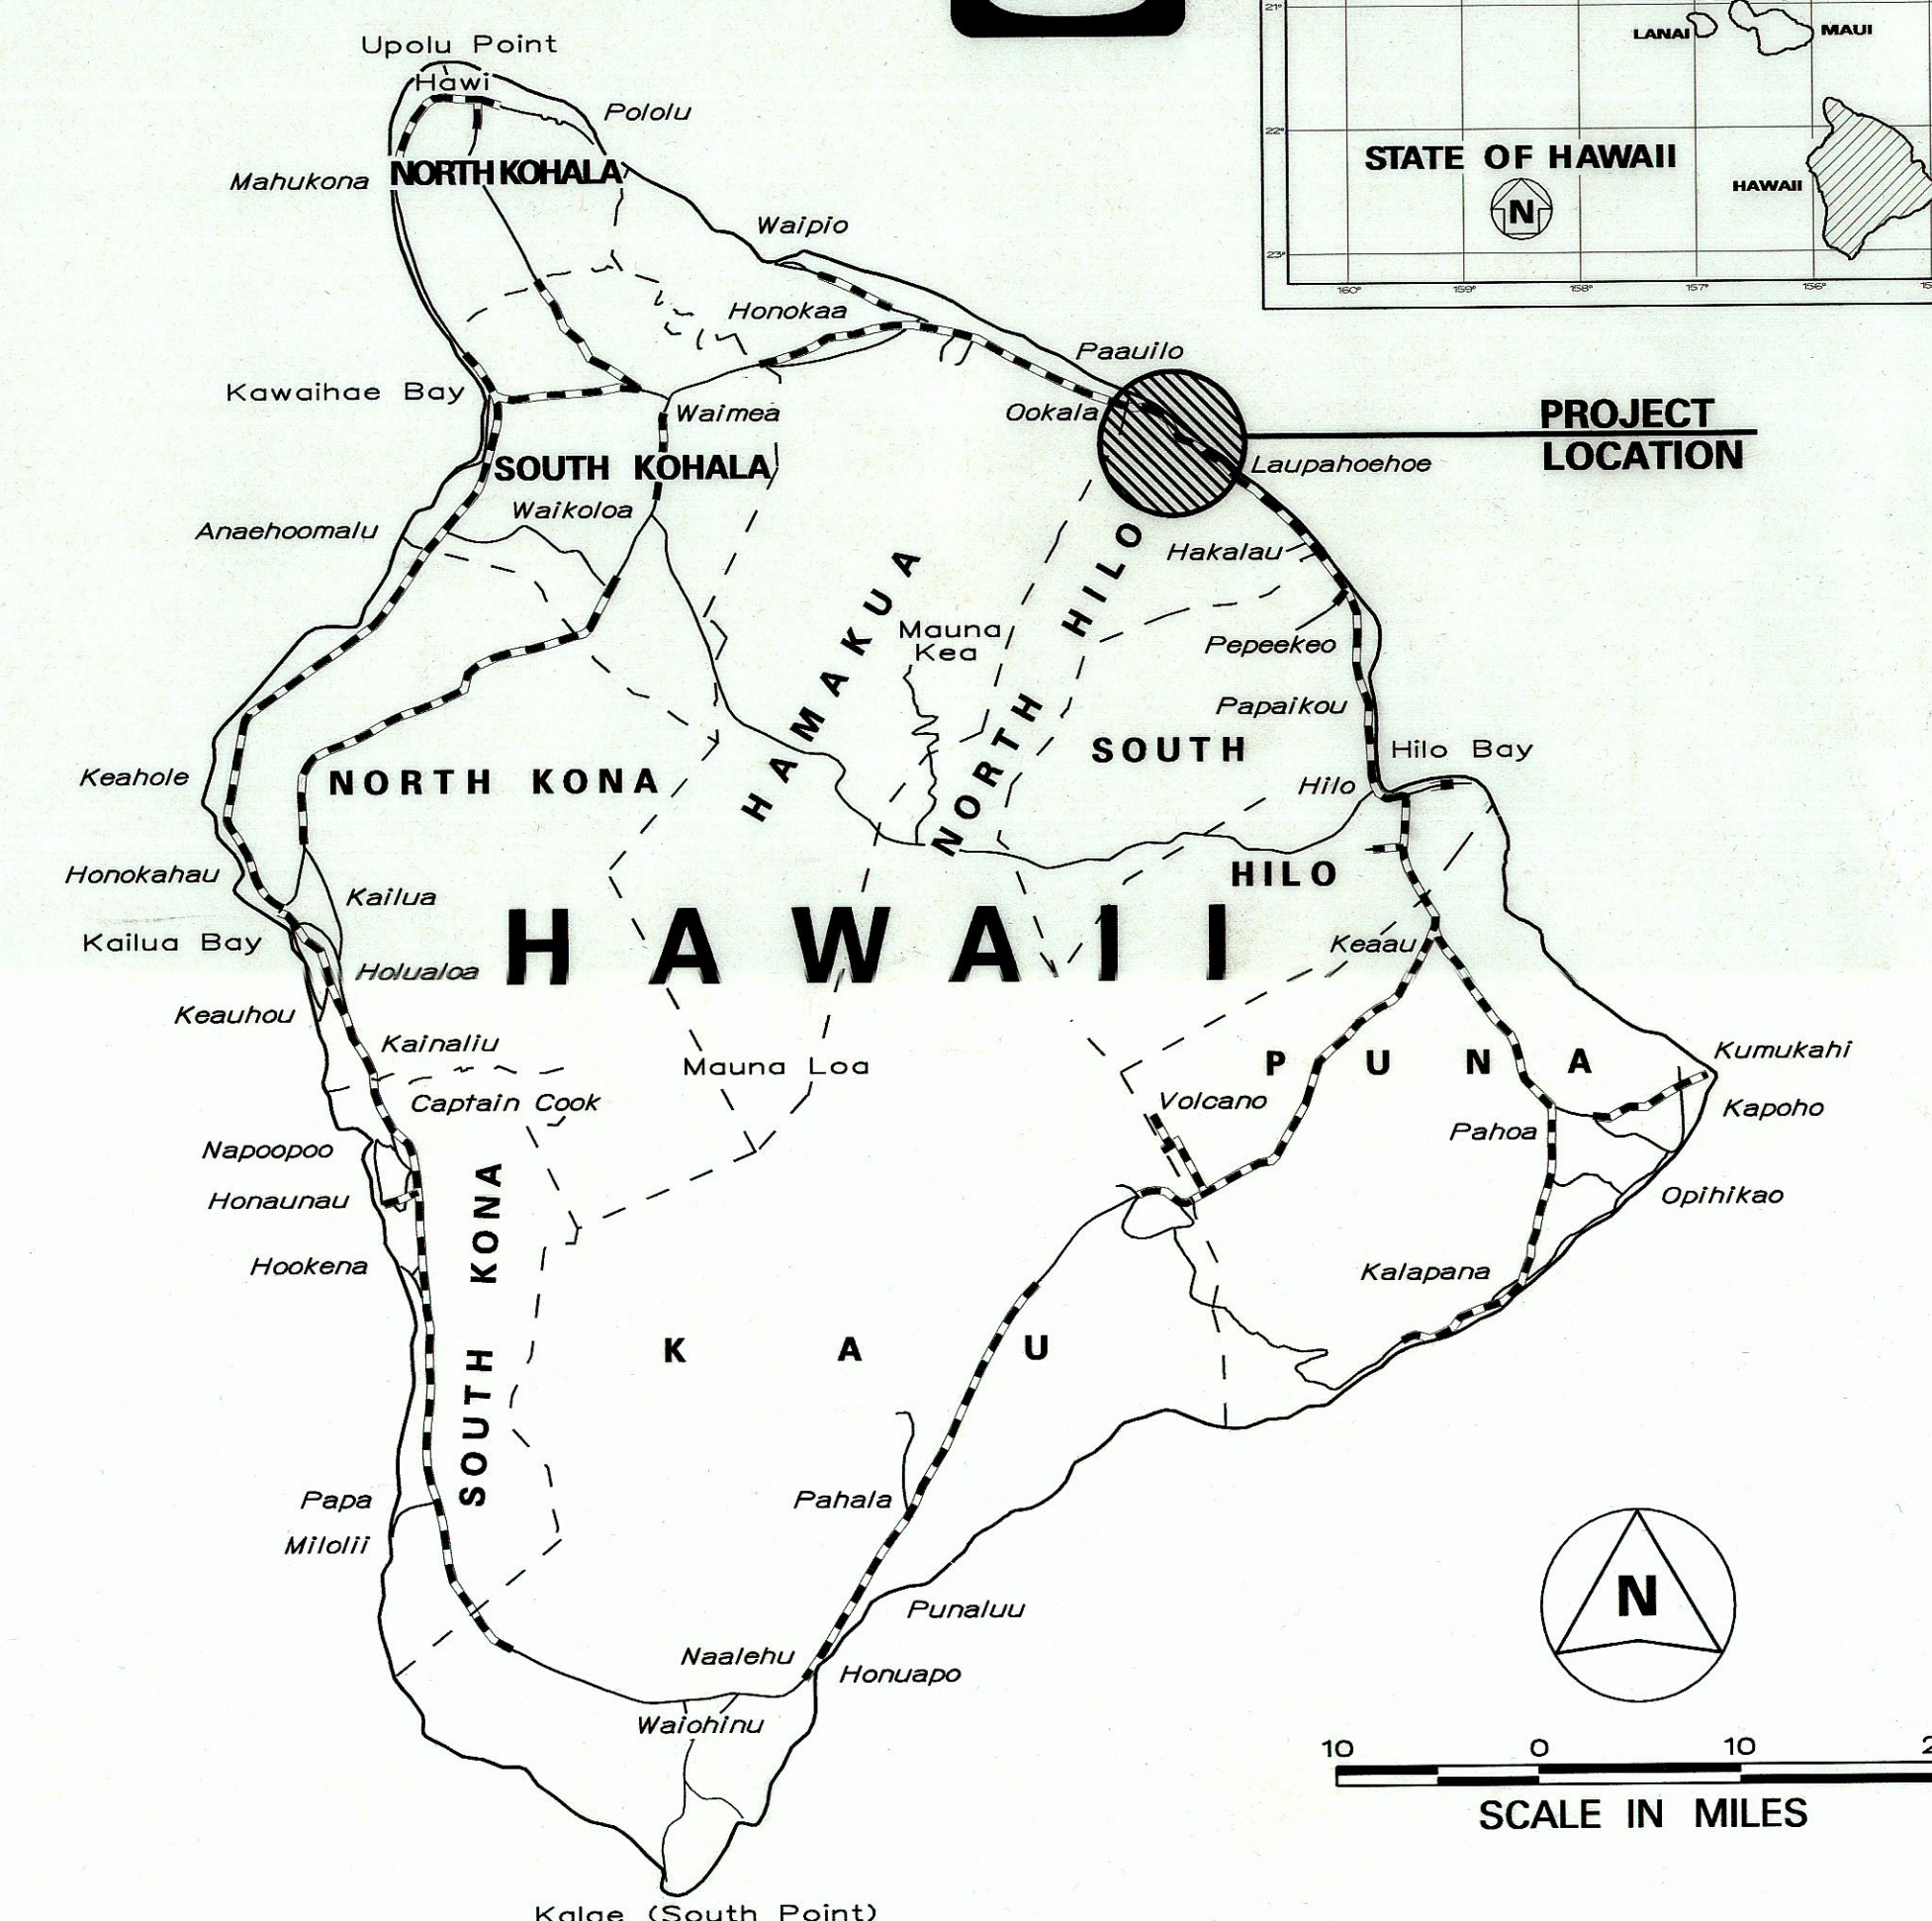


INDEX TO DRAWINGS	
SHEET NO.	DESCRIPTION
1	TITLE SHEET
2	STANDARD PLANS SUMMARY
3	GENERAL NOTES AND LEGEND
4-5	WATER POLLUTION AND EROSION CONTROL NOTES
6-7	TYPICAL SECTION AND DETAILS
8-17	GRADING PLANS
18-27	ROADWAY AND STRIPING PLANS
28	PAVEMENT MARKING LEGEND AND NOTES
29	MISCELLANEOUS SCHEDULES
30	GUARDRAIL SCHEDULE
31-40	GUARDRAIL DETAILS
41	DRAINAGE GRATE DETAIL
42	HIGH SPEED UNDIVIDED HIGHWAY WORK ZONE SIGNING PLAN, NOTES AND DETAILS

STATE OF HAWAII
DEPARTMENT OF TRANSPORTATION
HIGHWAYS DIVISION
HONOLULU, HAWAII
"AS-BUILT"
PLANS FOR
**HAWAII BELT ROAD
SAFETY IMPROVEMENTS
LAUPAHOEHOE GULCH AND KA'AWALI'I GULCH
FEDERAL AID PROJECT NO. HSIP-019-2(62)**

DISTRICT OF NORTH HILO
ISLAND OF HAWAII

DIST. NO.	STATE	FED. AID PROJ. NO.	FISCAL YEAR	SHEET NO.	TOTAL SHEETS
HAWAII	HAW.	HSIP-019-2(62)	2012	1	42

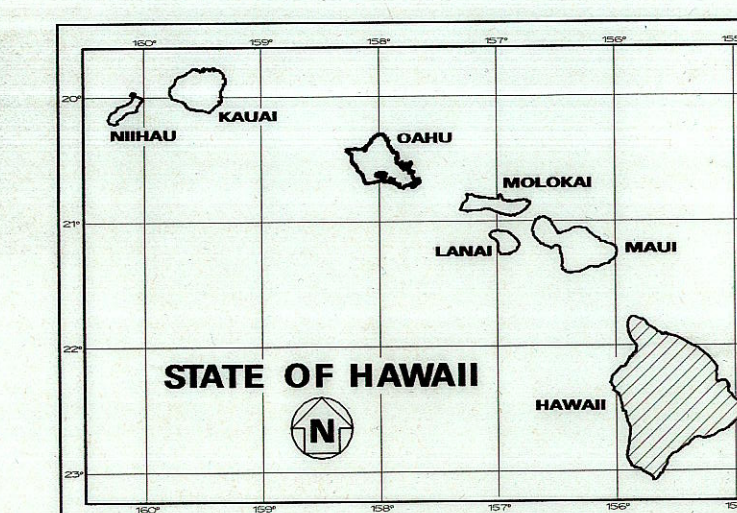


----- FEDERAL AID PROJECTS PREVIOUSLY CONSTRUCTED OR UNDER CONSTRUCTION

MILE POST 26.01 TO MILE POST 29.00


DESIGN DESIGNATION

ADT (2011) 6,900
ADT (2021) 7,800
DHV 660
D 55/45
T 5.0 %
V 45 M.P.H.

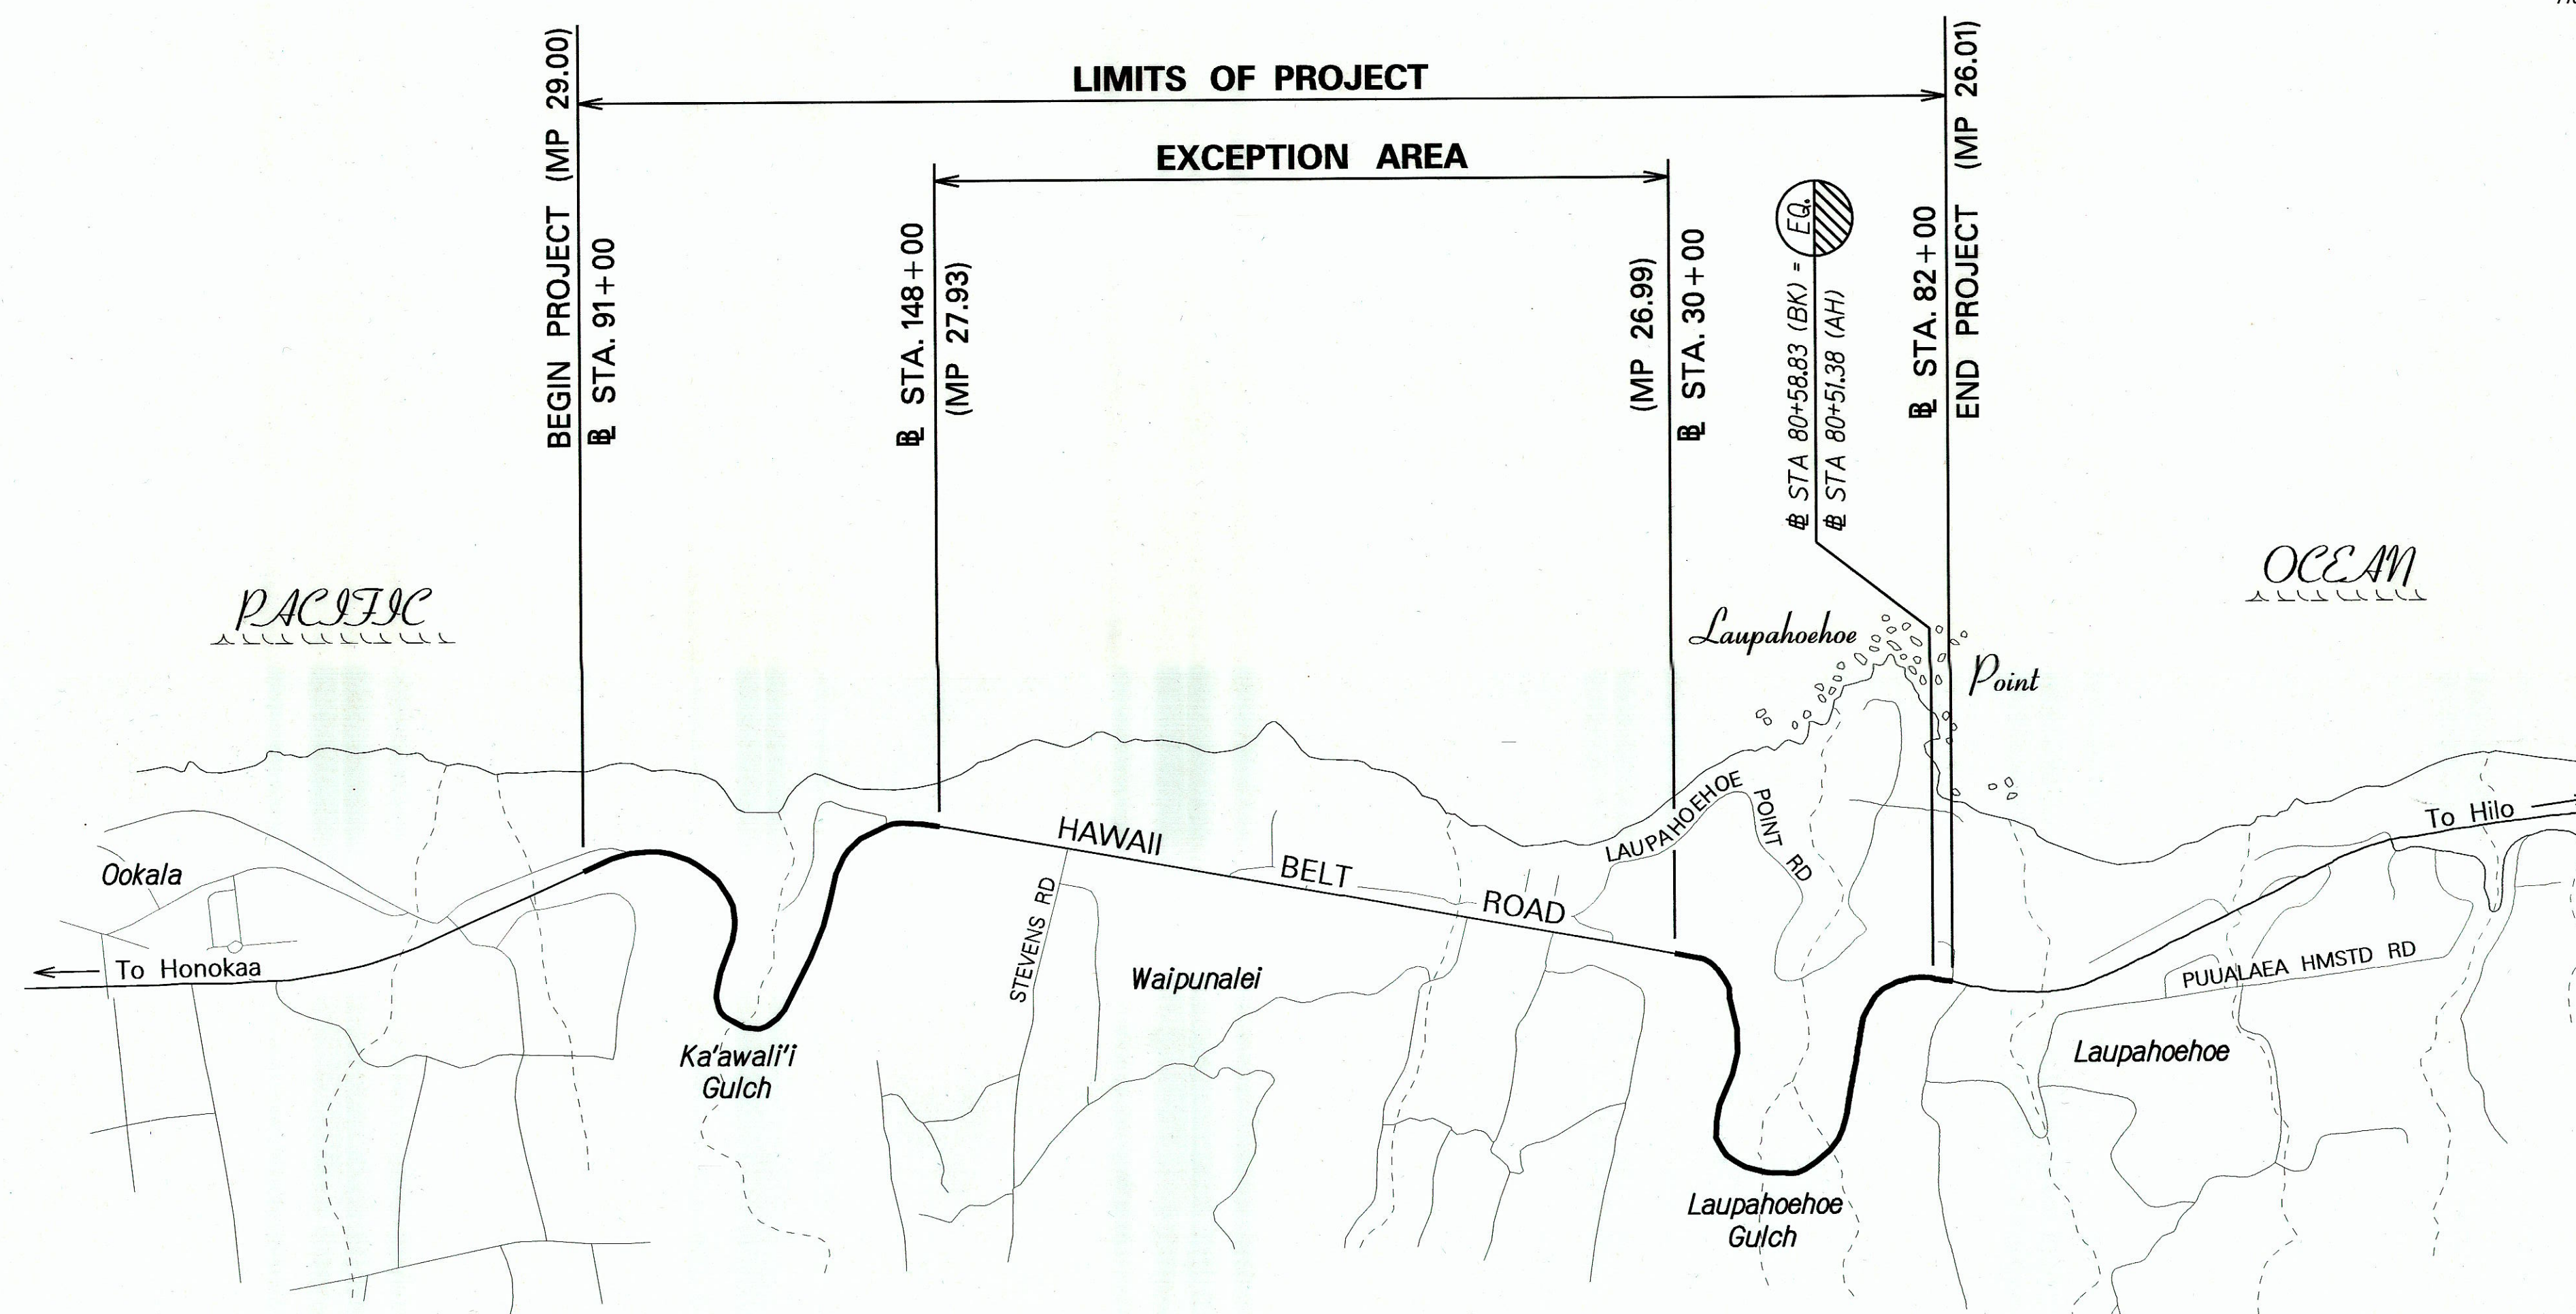


LAYOUT PLAN

GROSS LENGTH OF PROJECT 2.99 MILES
NET LENGTH OF PROJECT 2.05 MILES

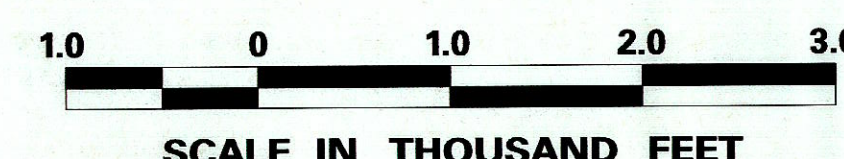

HAWAII DISTRICT DESIGNED BY _____
HAWY-HI MANAGED BY _____
933-8866 PHONE _____
JUNE, 2012 DATE _____

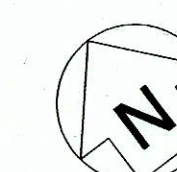

CHANGES MADE DURING CONSTRUCTION HAVE BEEN INCORPORATED ON THESE PLANS EXCEPT CHANGES IN THE ORIGINAL THEORETICAL QUANTITIES. FOR ACTUAL QUANTITIES, REFER TO PROJECT LEDGER AND/OR COMPUTATION BOOK.

DEPARTMENT OF TRANSPORTATION
STATE OF HAWAII
APPROVED: *[Signature]* 7/30/12
for DIR. OF TRANSPORTATION DATE