



DIST. NO.	STATE	FED. AID PROJ. NO.	FISCAL YEAR	SHEET NO.	TOTAL SHEETS
HAWAII	HAW.	HSIP-019-2(62)	2012	6	42

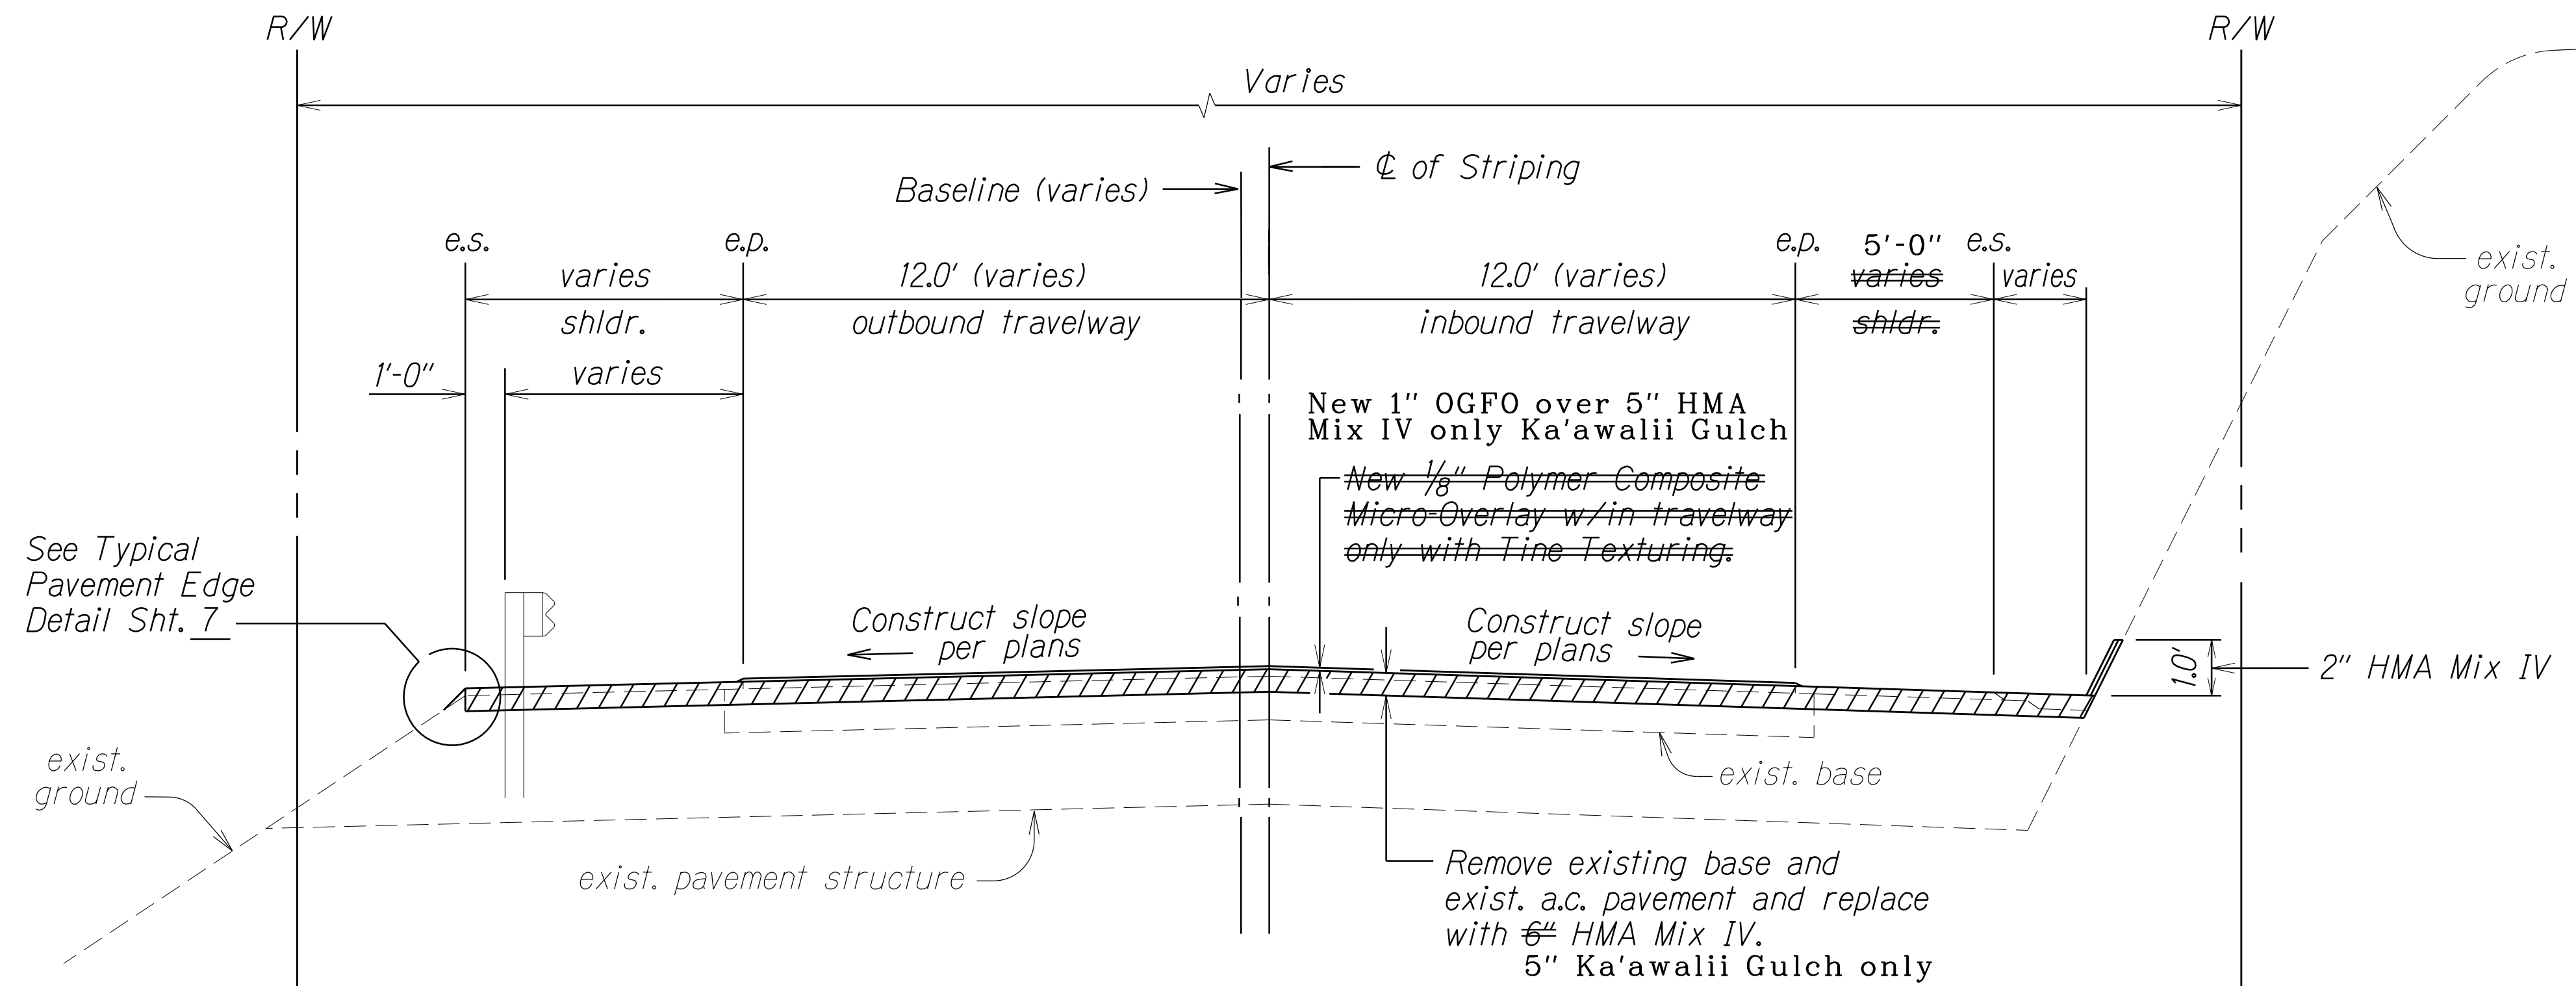

TYPICAL SECTION ON TANGENT

Not To Scale

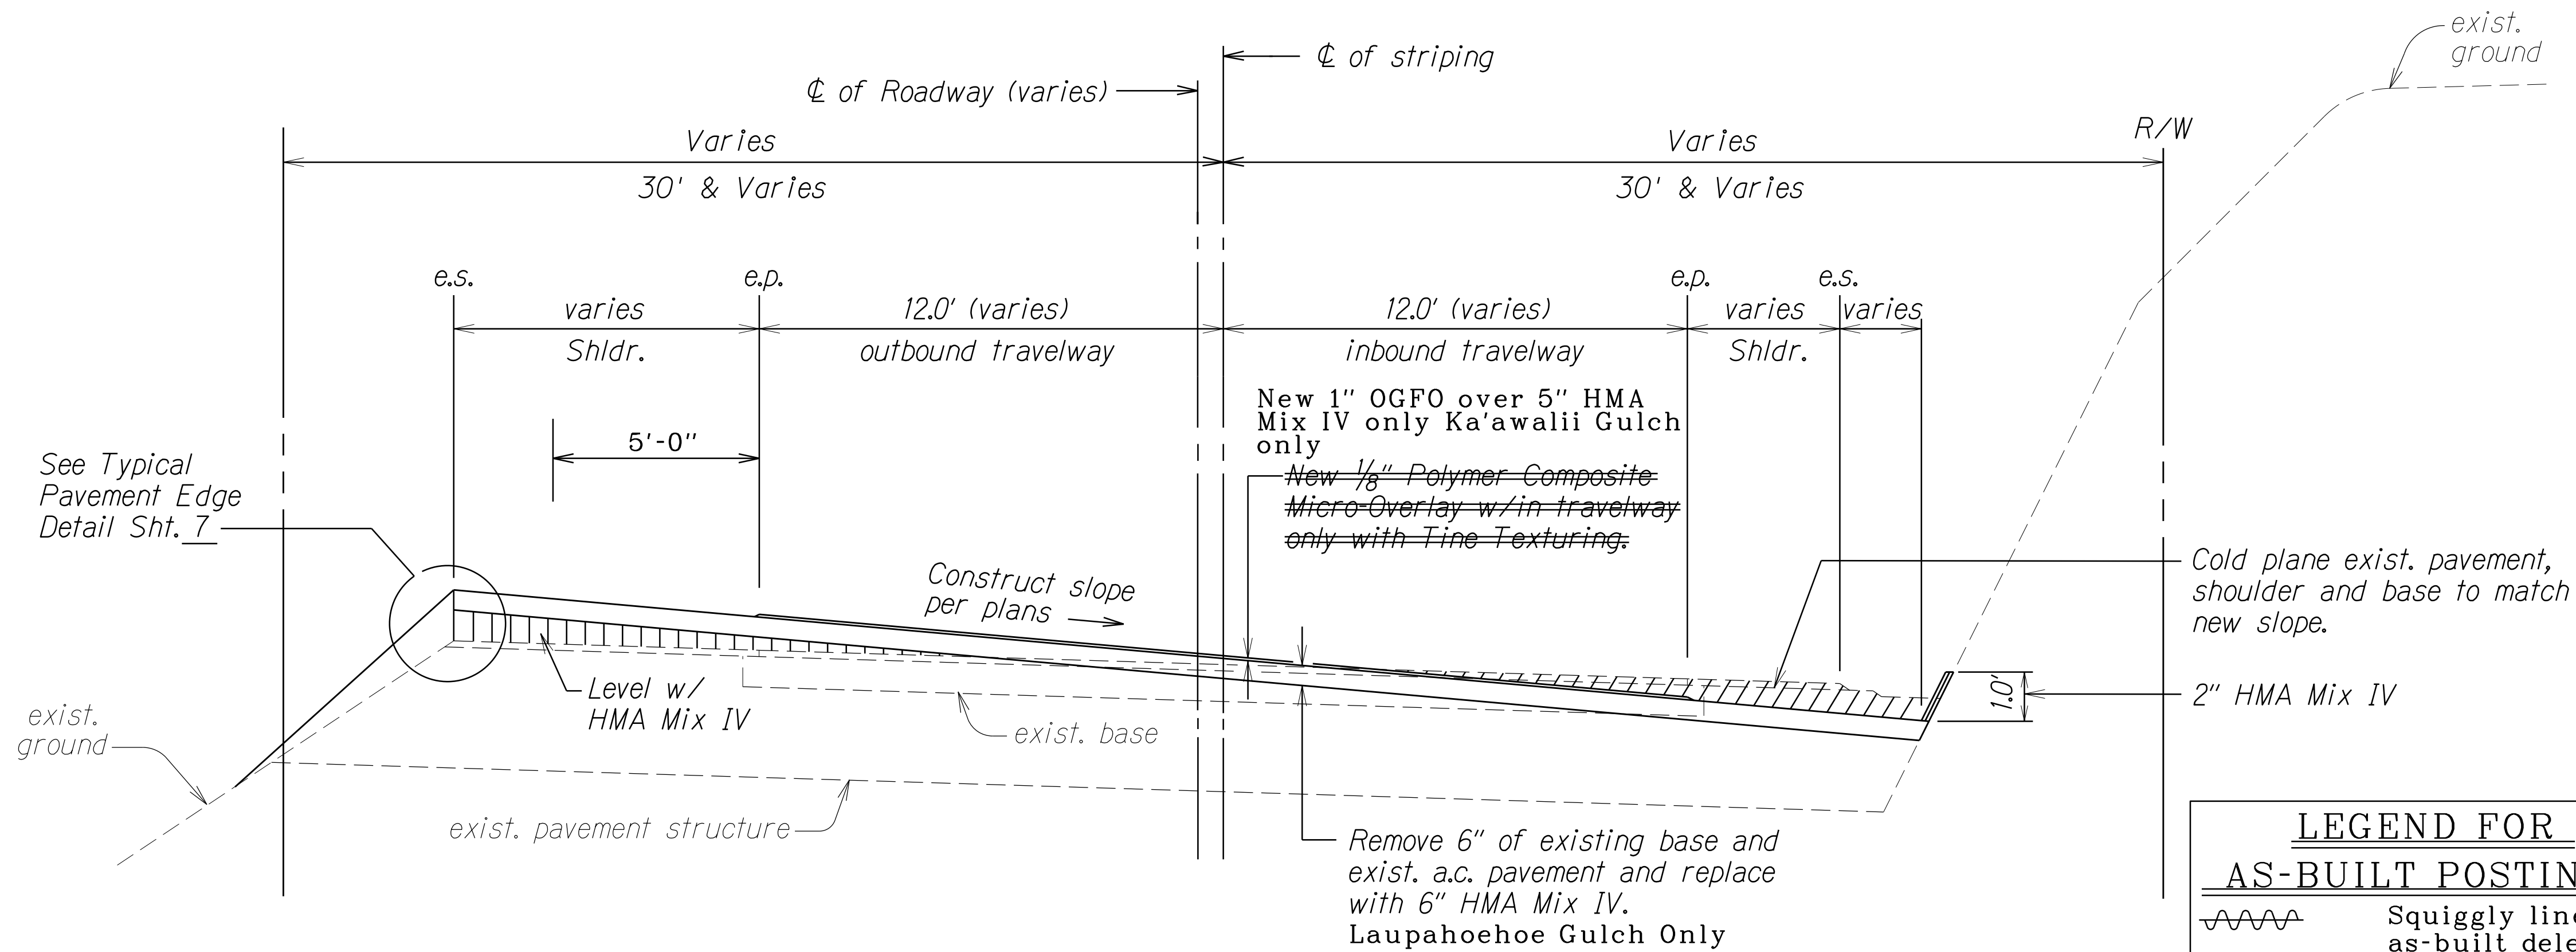

TYPICAL SECTION ON CURVE

Not To Scale

LEGEND FOR AS-BUILT POSTINGS	
	Squiggly line for as-built deletion
	Double line for as-built deletion
Roadway	Text for as-built posting

STATE OF HAWAII
DEPARTMENT OF TRANSPORTATION
HIGHWAYS DIVISION

TYPICAL SECTIONS

HAWAII BELT ROAD
Safety Improvements
Laupahoehoe Gulch and Ka'awali'i Gulch
Federal Aid Project No. HSIP-019-2(62)

Scale: N.T.S. Date: June, 2012

SHEET No. 1 OF 2 SHEETS

"AS-BUILT"

