


CENTERLINE AND REFERENCE SURVEY MONUMENT SCHEDULE						
MONUMENT TYPE	STATION	EXISTING DEPTH (FT.)	ADJUST CENTERLINE AND REFERENCE MON. (ITEM NO. 613.0200)	RECONSTRUCT CENTERLINE AND REFERENCE MON. (ITEM NO. 613.0300)	CONSTRUCT NEW CENTERLINE AND REFERENCE MON. (ITEM NO. 613.0100)	REMARKS
P.O.T.	155+01.35	0	1			
P.O.T.	184+87.55	0	1			
EQ. P.O.T.	197+94.69 (BK) 0+00 (AH)	0	1			
GRD. MON.	11+51.19	0	1			
P.C.	11+51.88					No Monument
EQ. P.T.	18+36.71 (BK) 18+37.71 (AH)	0	1			
GRD. MON.	46+67.24	0	1			
P.C.	46+71.28					No Monument
P.T.	60+25.72	0	1			
P.C.	73+42.22					No Monument
GRD. MON.	73+42.59	0	1			
EQ. P.T.	92+47.91 (BK) 92+50.32 (AH)	0.25		1		
GRD. MON.	103+48.50	0.25		1		
T.S.	103+48.87					No Monument
GRD. MON.	105+48.52	0	1			
S.C.	105+48.87					No Monument
C.S.	108+63.13	0	1			
S.T.	110+63.13	0.32		1		
T.S.	115+43.16					No Monument
GRD. MON.	115+43.79	0.27		1		
S.C.	117+43.16					No Monument
GRD. MON.	117+43.84	0.3		1		
C.S.	124+18.47	0.35		1		
S.T.	126+18.47	0.32		1		
GRD. MON.	143+70.95	0.38		1		
P.C.	143+71.38					No Monument
P.T.	150+44.93	0.35		1		
P.O.T.	158+58.69	0	1			

Continued


CENTERLINE AND REFERENCE SURVEY MONUMENT SCHEDULE						
MONUMENT TYPE	STATION	EXISTING DEPTH (FT.)	ADJUST CENTERLINE AND REFERENCE MON. (ITEM NO. 613.0200)	RECONSTRUCT CENTERLINE AND REFERENCE MON. (ITEM NO. 613.0300)	CONSTRUCT NEW CENTERLINE AND REFERENCE MON. (ITEM NO. 613.0100)	REMARKS
P.O.T.	65+00.03	0.15		1		
P.T.	64+17.70					No Monument
GRD. MON.	64+17.95	0	1			
P.C.	57+15.88	0	1			
P.T.	42+63.60	0	1			
P.C.	27+41.73			1	≠	
P.O.T.	17+01.40	0	1			
EQ. P.T.	12+24.03 (AH) 12+21.89 (BK)					No Monument
GRD. MON.	12+26.01 (AH) 12+23.87 (BK)	0	1			
P.C.	3+71.53	0	1			
TOTALS		--	17	≠ 11	≠ 0	

ORIGINAL PLAN	SURVEY PLOTTED BY	DATE
NOTE BOOK	DRAWN BY	
	DESIGNED BY	
	CHECKED BY	

LEGEND FOR AS-BUILT POSTINGS

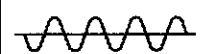

Squiggly line for as-built deletion

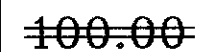

Double line for as-built deletion



Text for as-built posting

4/30/14

Revised Survey Monument Schedule and create New Sheet for Route Marker and Milepost Schedule.

DATE	REVISION
------	----------

STATE OF HAWAII
DEPARTMENT OF TRANSPORTATION
HIGHWAYS DIVISION

MISCELLANEOUS SCHEDULE

HAWAII BELT ROAD RESURFACING
Pepeekeo to Hakalau
Federal Aid Project No. NH-019-2(067)

Scale: None

Date: March, 2014

SHEET No. 1 OF 1 SHEETS

DIST. NO.	STATE	FED. AID PROJ. NO.	FISCAL YEAR	SHEET NO.	TOTAL SHEETS
HAWAII	HAW.	NH-019-2(067)	2014	40	41

ROUTE MARKER SCHEDULE						
PROJECT	STATION	INBOUND	OUTBOUND	ROUTE MARKER SIGN NO. (ROUTE NO.)	REMOVE	INSTALL TYPE A ASSEMBLY
FA-F 14B(1)	146+05	●		M1-6 (19)	1	1
	156+50		●	M1-6 (19)	1	1
	163+18	●		M1-6 (19)	1	1
SDR 3(2)	51+96	●		M1-6 (19)	1	1
	52+08		●	M1-6 (19)	1	1
	130+84		●	M1-6 (220)	1	1
	131+42	●		M1-6 (19)	1	1
	132+72		●	M1-6 (19)≠(220)	2	1
	135+44		●	M1-6 (19)	1	1
	136+00	●		M1-6 (19)≠(220)	2	1
	140+20		●	M1-6 (220)	1	1
				TOTALS	15	13
SDR 3(12)	20+58	●		M1-6 (19)	1	1
	17+00		●	M1-6 (19)	1	1
				TOTALS	15	13

MILEPOST SCHEDULE						
PROJECT	STATION	INBOUND	OUTBOUND	MILE POST D10-4 (12"X24") MILE POST NO. (RTE. NO.)	REMOVE	INSTALL WITH POST (BI-DIRECTIONAL)
FA-F 14B(1)	146+05		●	10.0 (19)	2	1
	171+40		●	10.5 (19)	2	1
SDR 3(2)	1+10		●	11.0 (19)	2	1
	27+40		●	11.5 (19)	2	1
	53+92		●	12.0 (19)	2	1
	80+20		●	12.5 (19)	2	1
	106+52		●	13.0 (19) (KM 21.0)	2	1
	133+00		●	13.5 (19)	2	1
	134+12	●		0.0 (220)	2	1
	159+65		●	14.0 (19)	2	1
				TOTALS	13	13
SDR 3(12)	54+20		●	14.5 (19)	2	1
	29+22		●	15.0 (19)	2	1
	4+56		●	15.0 (19)	2	1
				TOTALS	13	13

4/30/14 New Sheet for Route Marker and Milepost Schedule.

DATE REVISION

STATE OF HAWAII
DEPARTMENT OF TRANSPORTATION
HIGHWAYS DIVISION

MISCELLANEOUS SCHEDULE

HAWAII BELT ROAD RESURFACING

Pepeekeo to Hakalau

Federal Aid Project No. NH-019-2(067)

Scale: None Date: March, 2014

SHEET No. 1 OF 1 SHEETS

ORIGINAL PLAN	SURVEY PLOTTED BY	DATE
NOTE BOOK	DESIGNED BY	
QUANTITIES BY	CHECKED BY	
4/2/14/2014		