
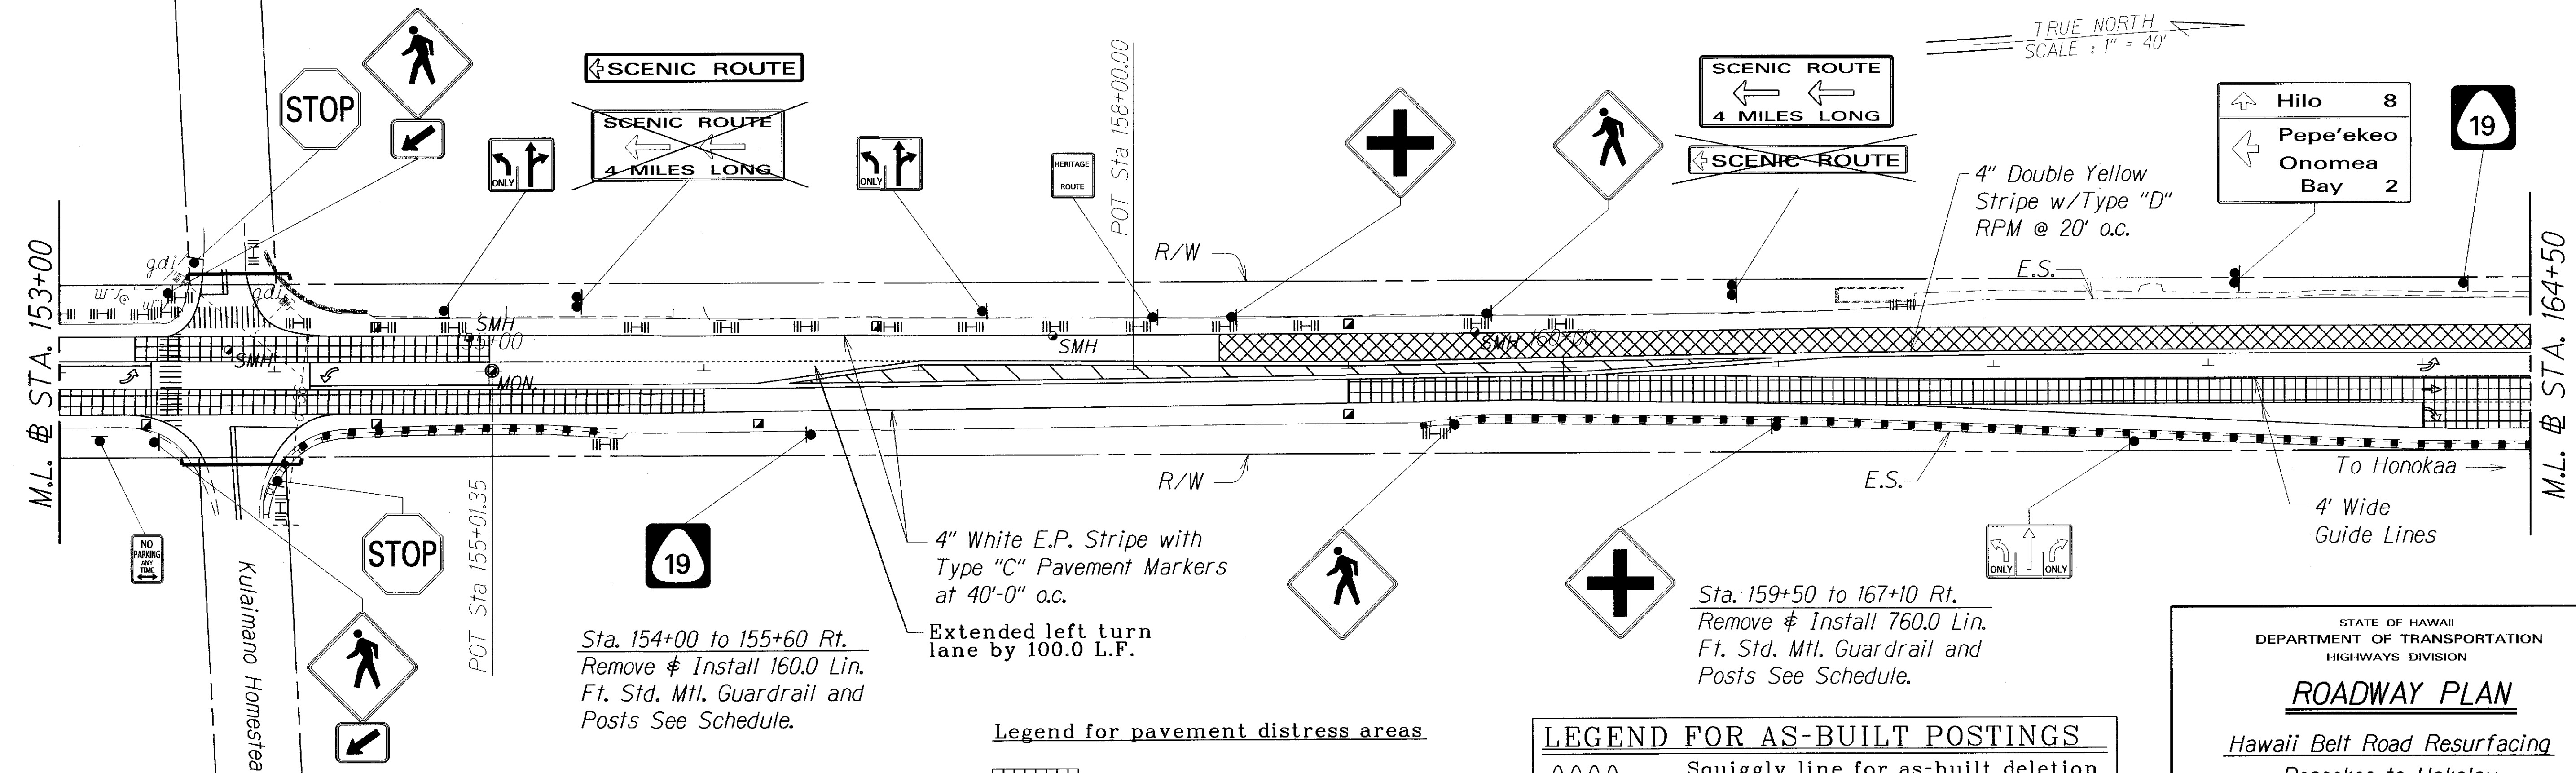


DIST. NO.	STATE	FED. AID PROJ. NO.	FISCAL YEAR	SHEET NO.	TOTAL SHEETS
HAWAII	HAW.	NH-019-2(067)	2014	10	41

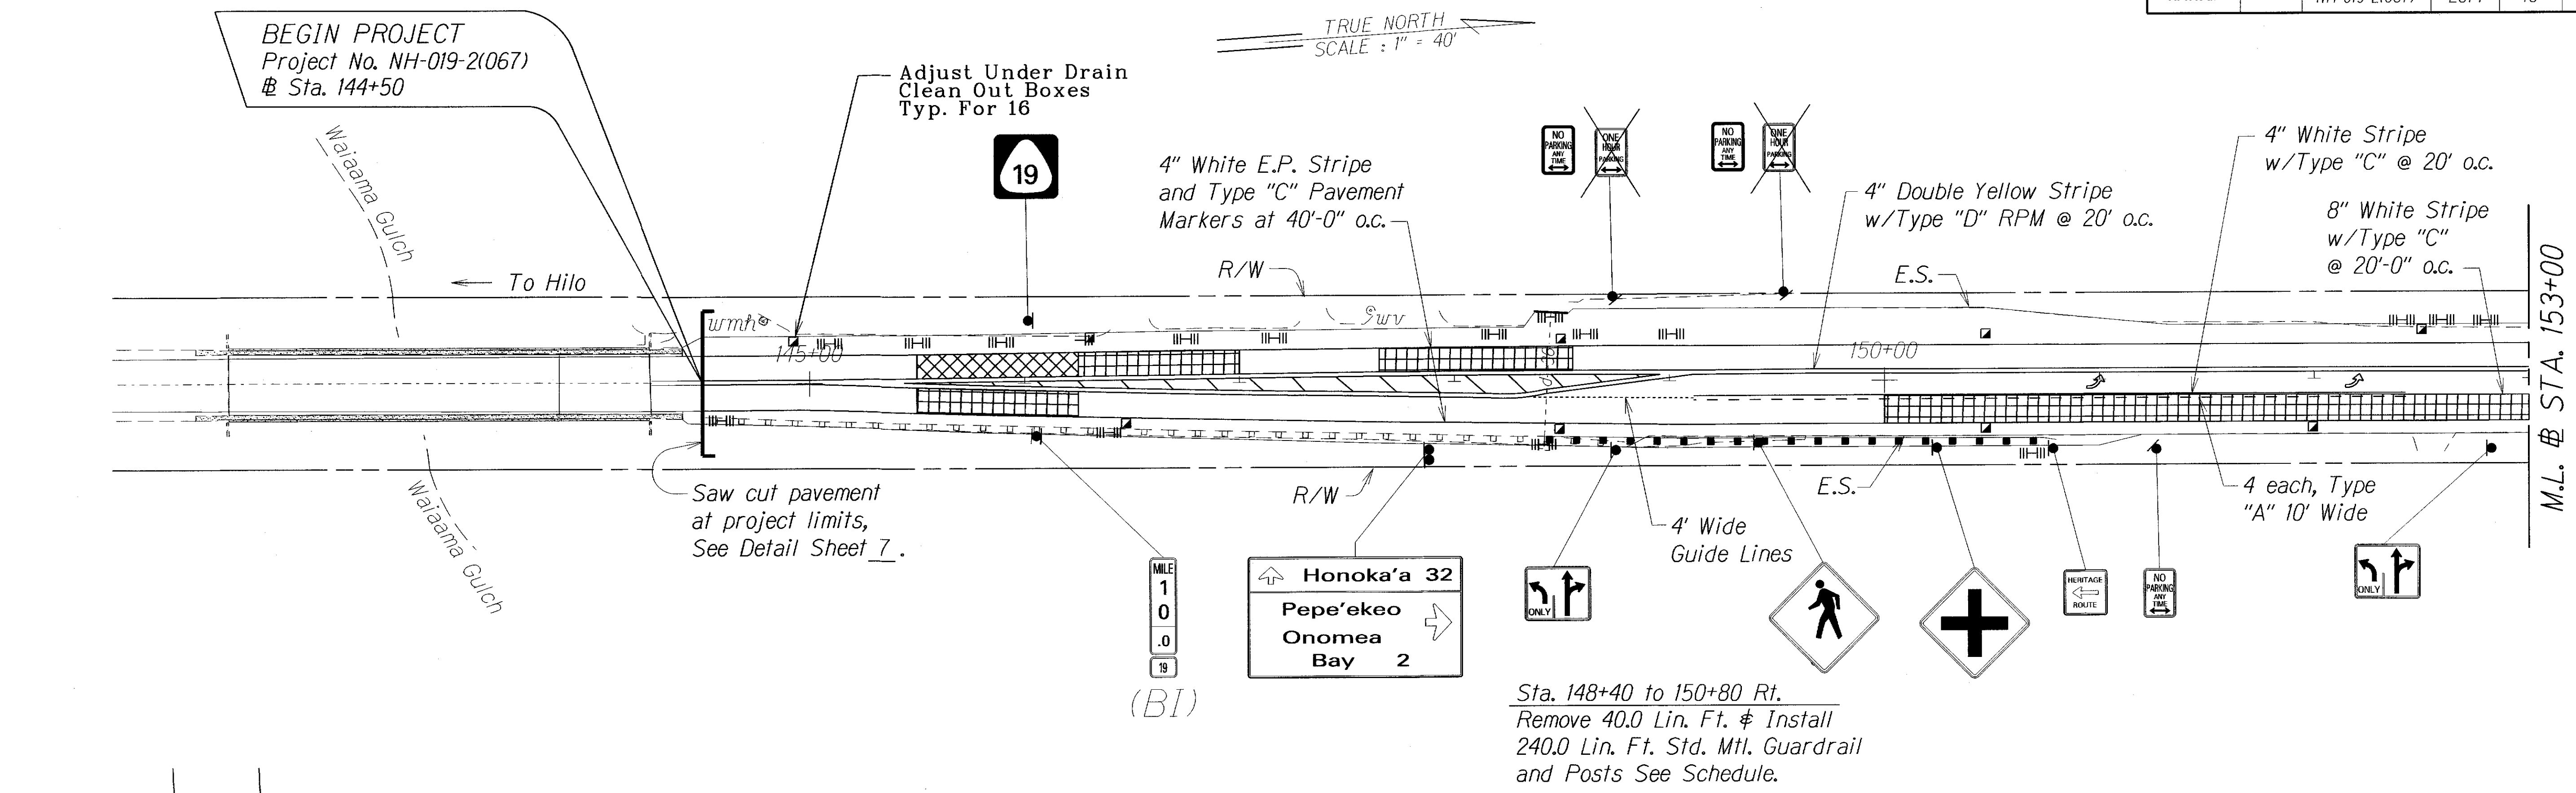

- Notes:
1. All existing signs (dashed) with post are to remain.
 2. All existing signs in conflict with construction signs are to be covered.
 3. This work shall be considered incidental to various contract items.

Legend for pavement distress areas

	Minor Distress
	Severe Distress

LEGEND FOR AS-BUILT POSTINGS

	Squiggly line for as-built deletion
	Double line for as-built deletion
Roadway	Text for as-built posting

STATE OF HAWAII
DEPARTMENT OF TRANSPORTATION
HIGHWAYS DIVISION

ROADWAY PLAN



*Hawaii Belt Road Resurfacing
Pepeekeo to Hakalau
Federal Aid Project No. NH-019-2(067)*

Scale: 1" = 40' Date: March, 2014

SHEET No. 1 OF 13 SHEETS

"AS-BUILT"

DIST. NO.	STATE	FED. AID PROJ. NO.	FISCAL YEAR	SHEET NO.	TOTAL SHEETS
HAWAII	HAW.	NH-019-2(067)	2014	11	41

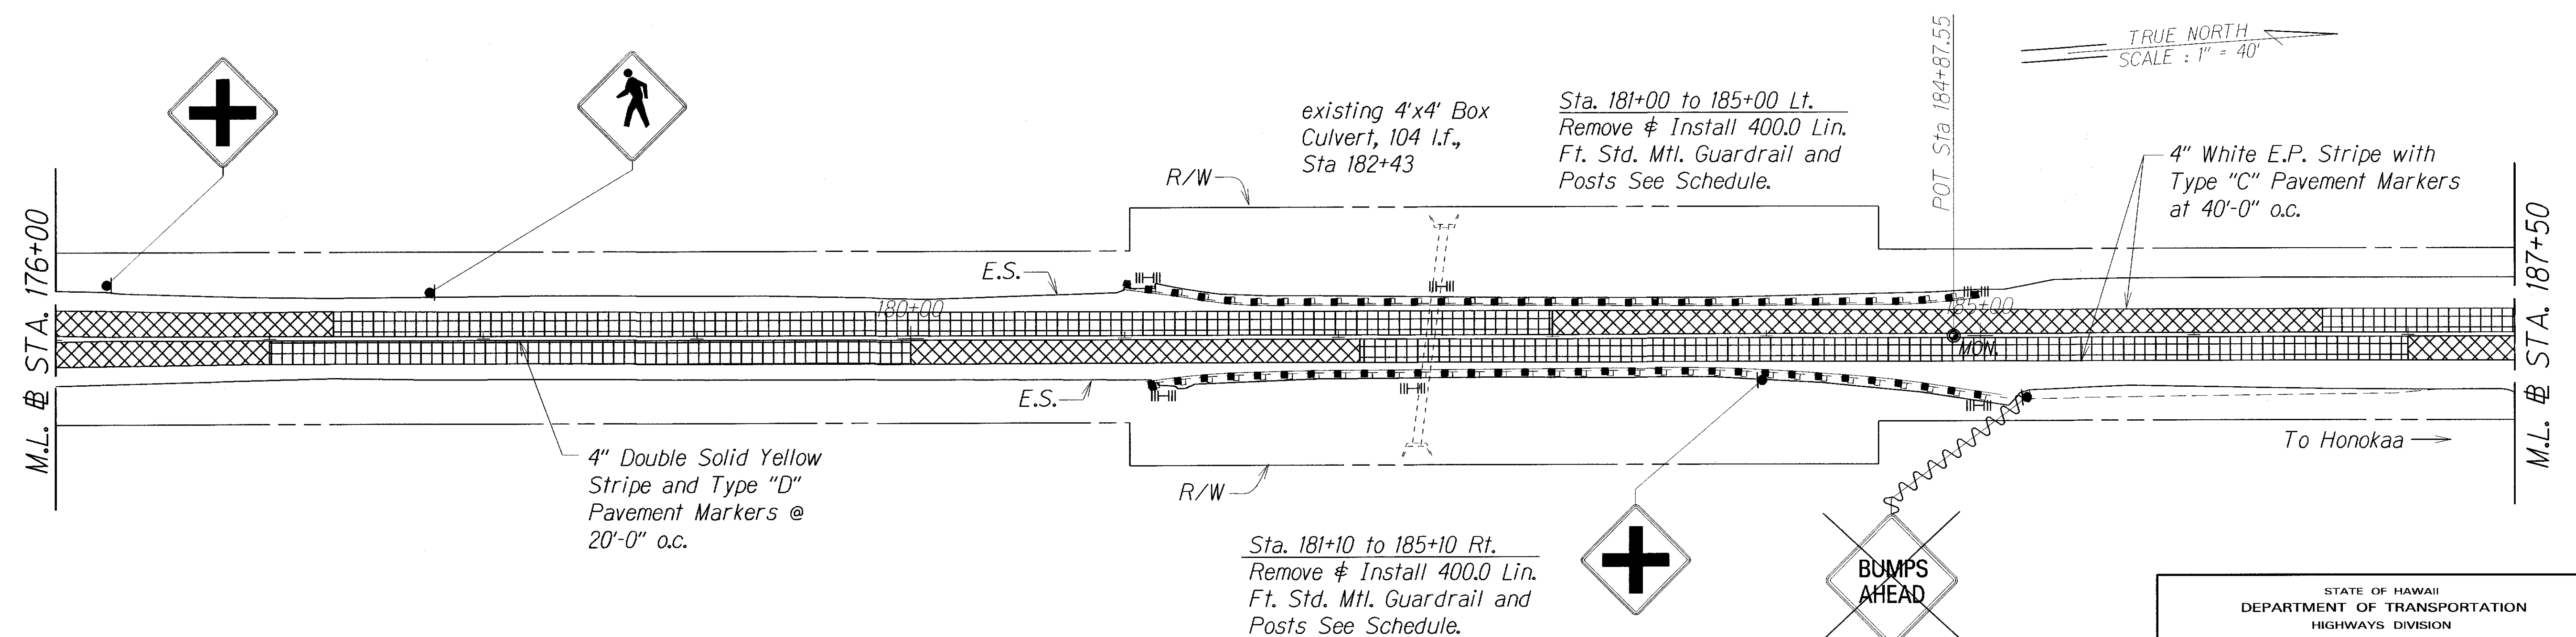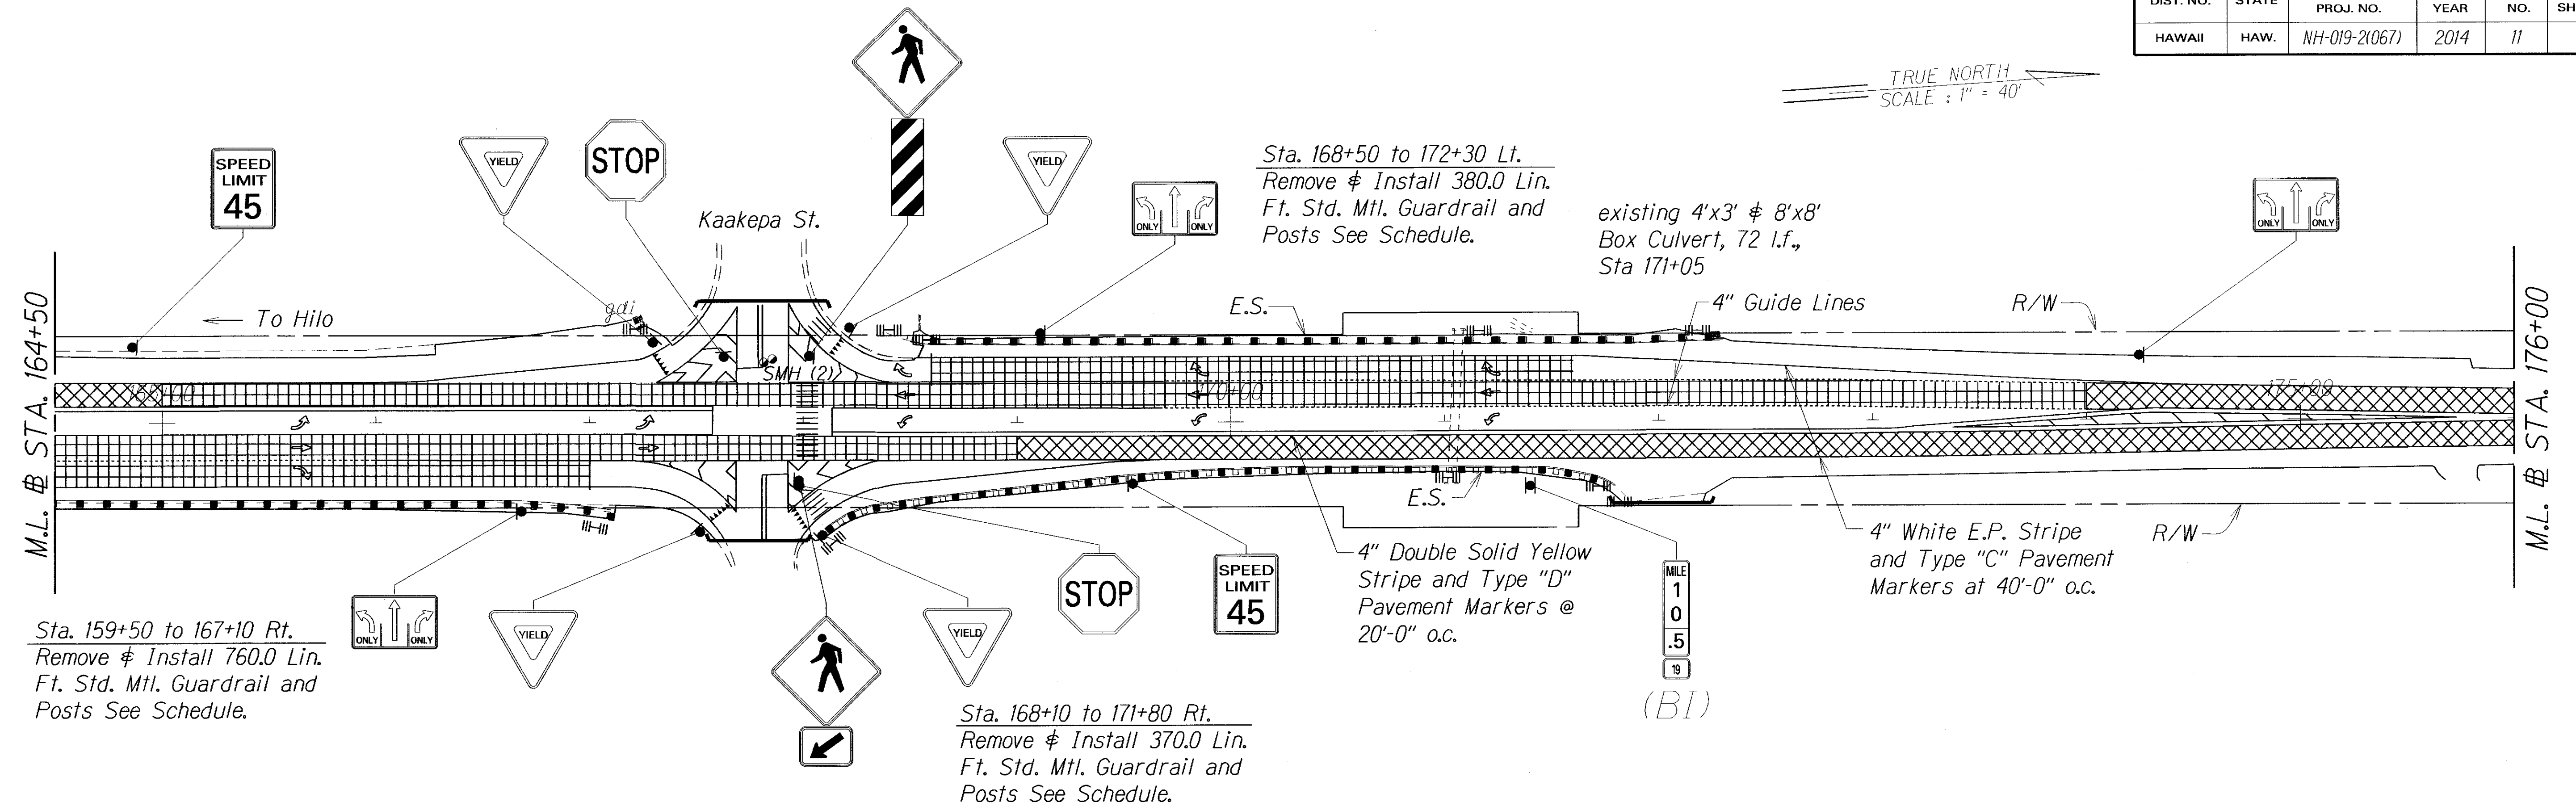

ORIGINAL PLAN	DATE
DRAWN BY	
DESIGNED BY	
CHECKED BY	
NOTED BY	
DATE	

STATE OF HAWAII
DEPARTMENT OF TRANSPORTATION
HIGHWAYS DIVISION

ROADWAY PLAN

*Hawaii Belt Road Resurfacing
Pepeekeo to Hakalau*


Federal Aid Project No. NH-019-2(067)

Scale: 1" = 40' Date: March, 2014

SHEET No. 2 OF 13 SHEETS


"AS-BUILT"

DIST. NO.	STATE	FED. AID PROJ. NO.	FISCAL YEAR	SHEET NO.	TOTAL SHEETS
HAWAII	HAW.	NH-019-2(067)	2014	12	41

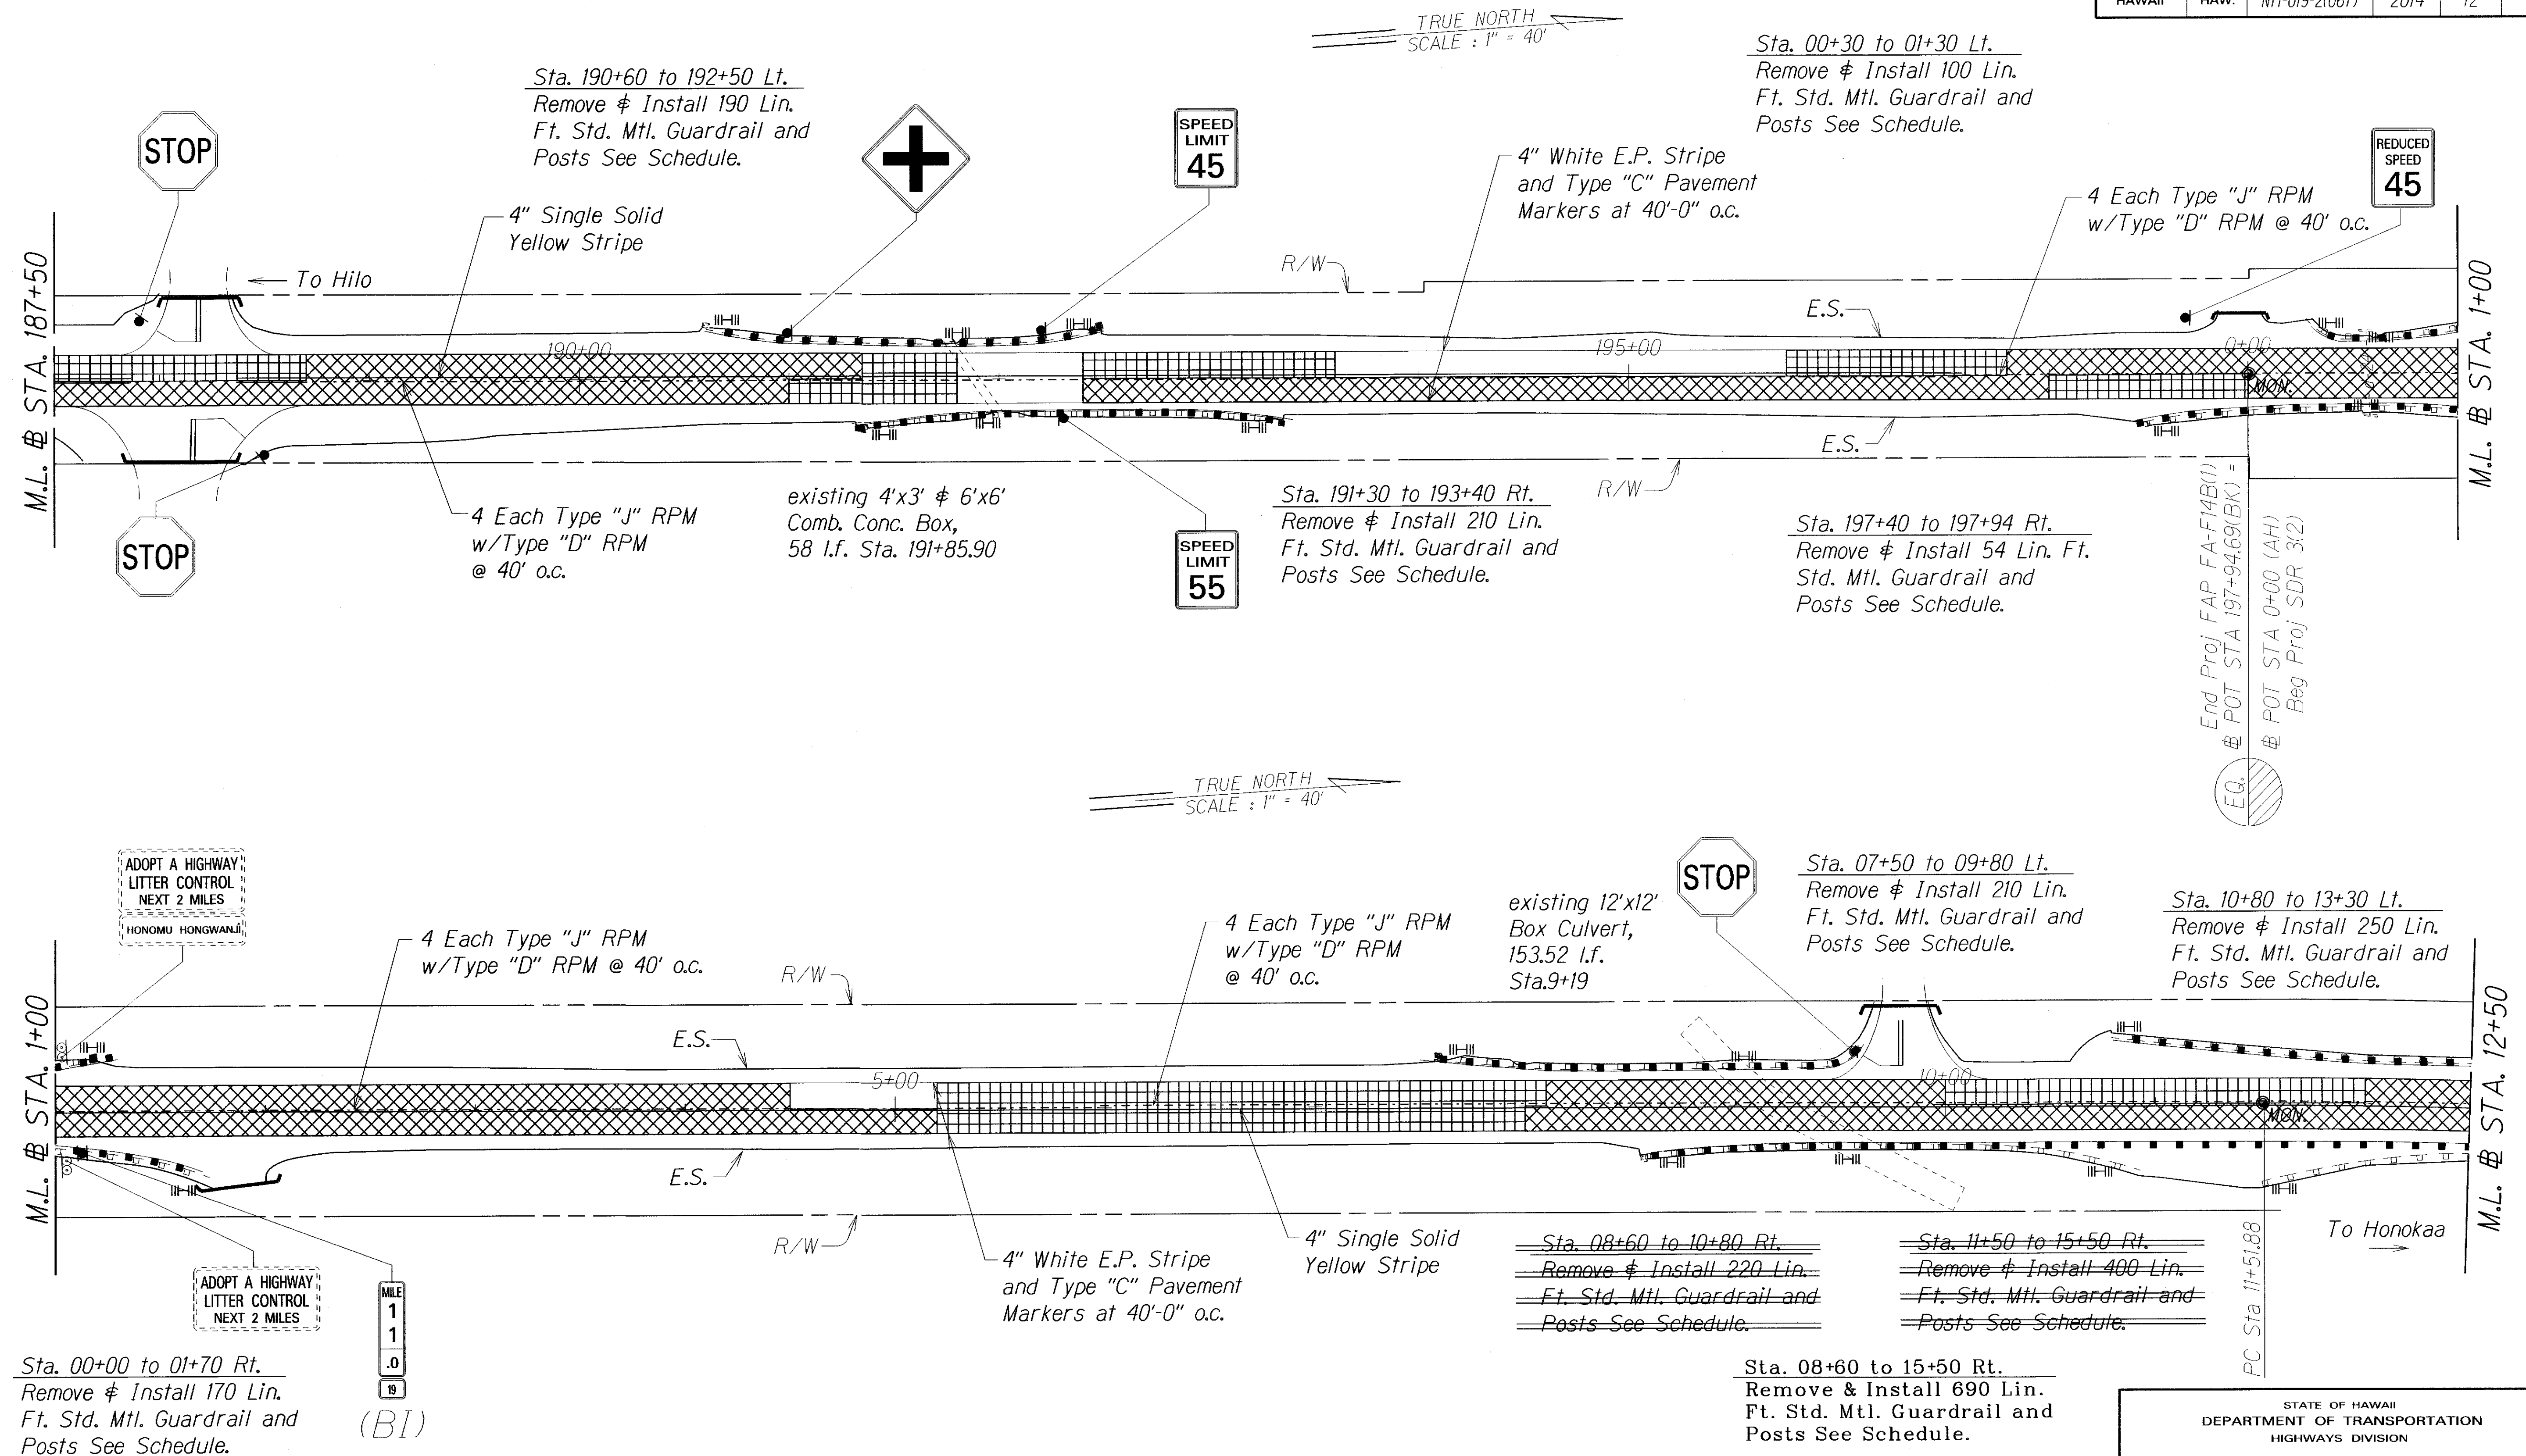

"AS-BUILT"

DIST. NO.	STATE	FED. AID PROJ. NO.	FISCAL YEAR	SHEET NO.	TOTAL SHEETS
HAWAII	HAW.	NH-019-2(067)	2014	13	41

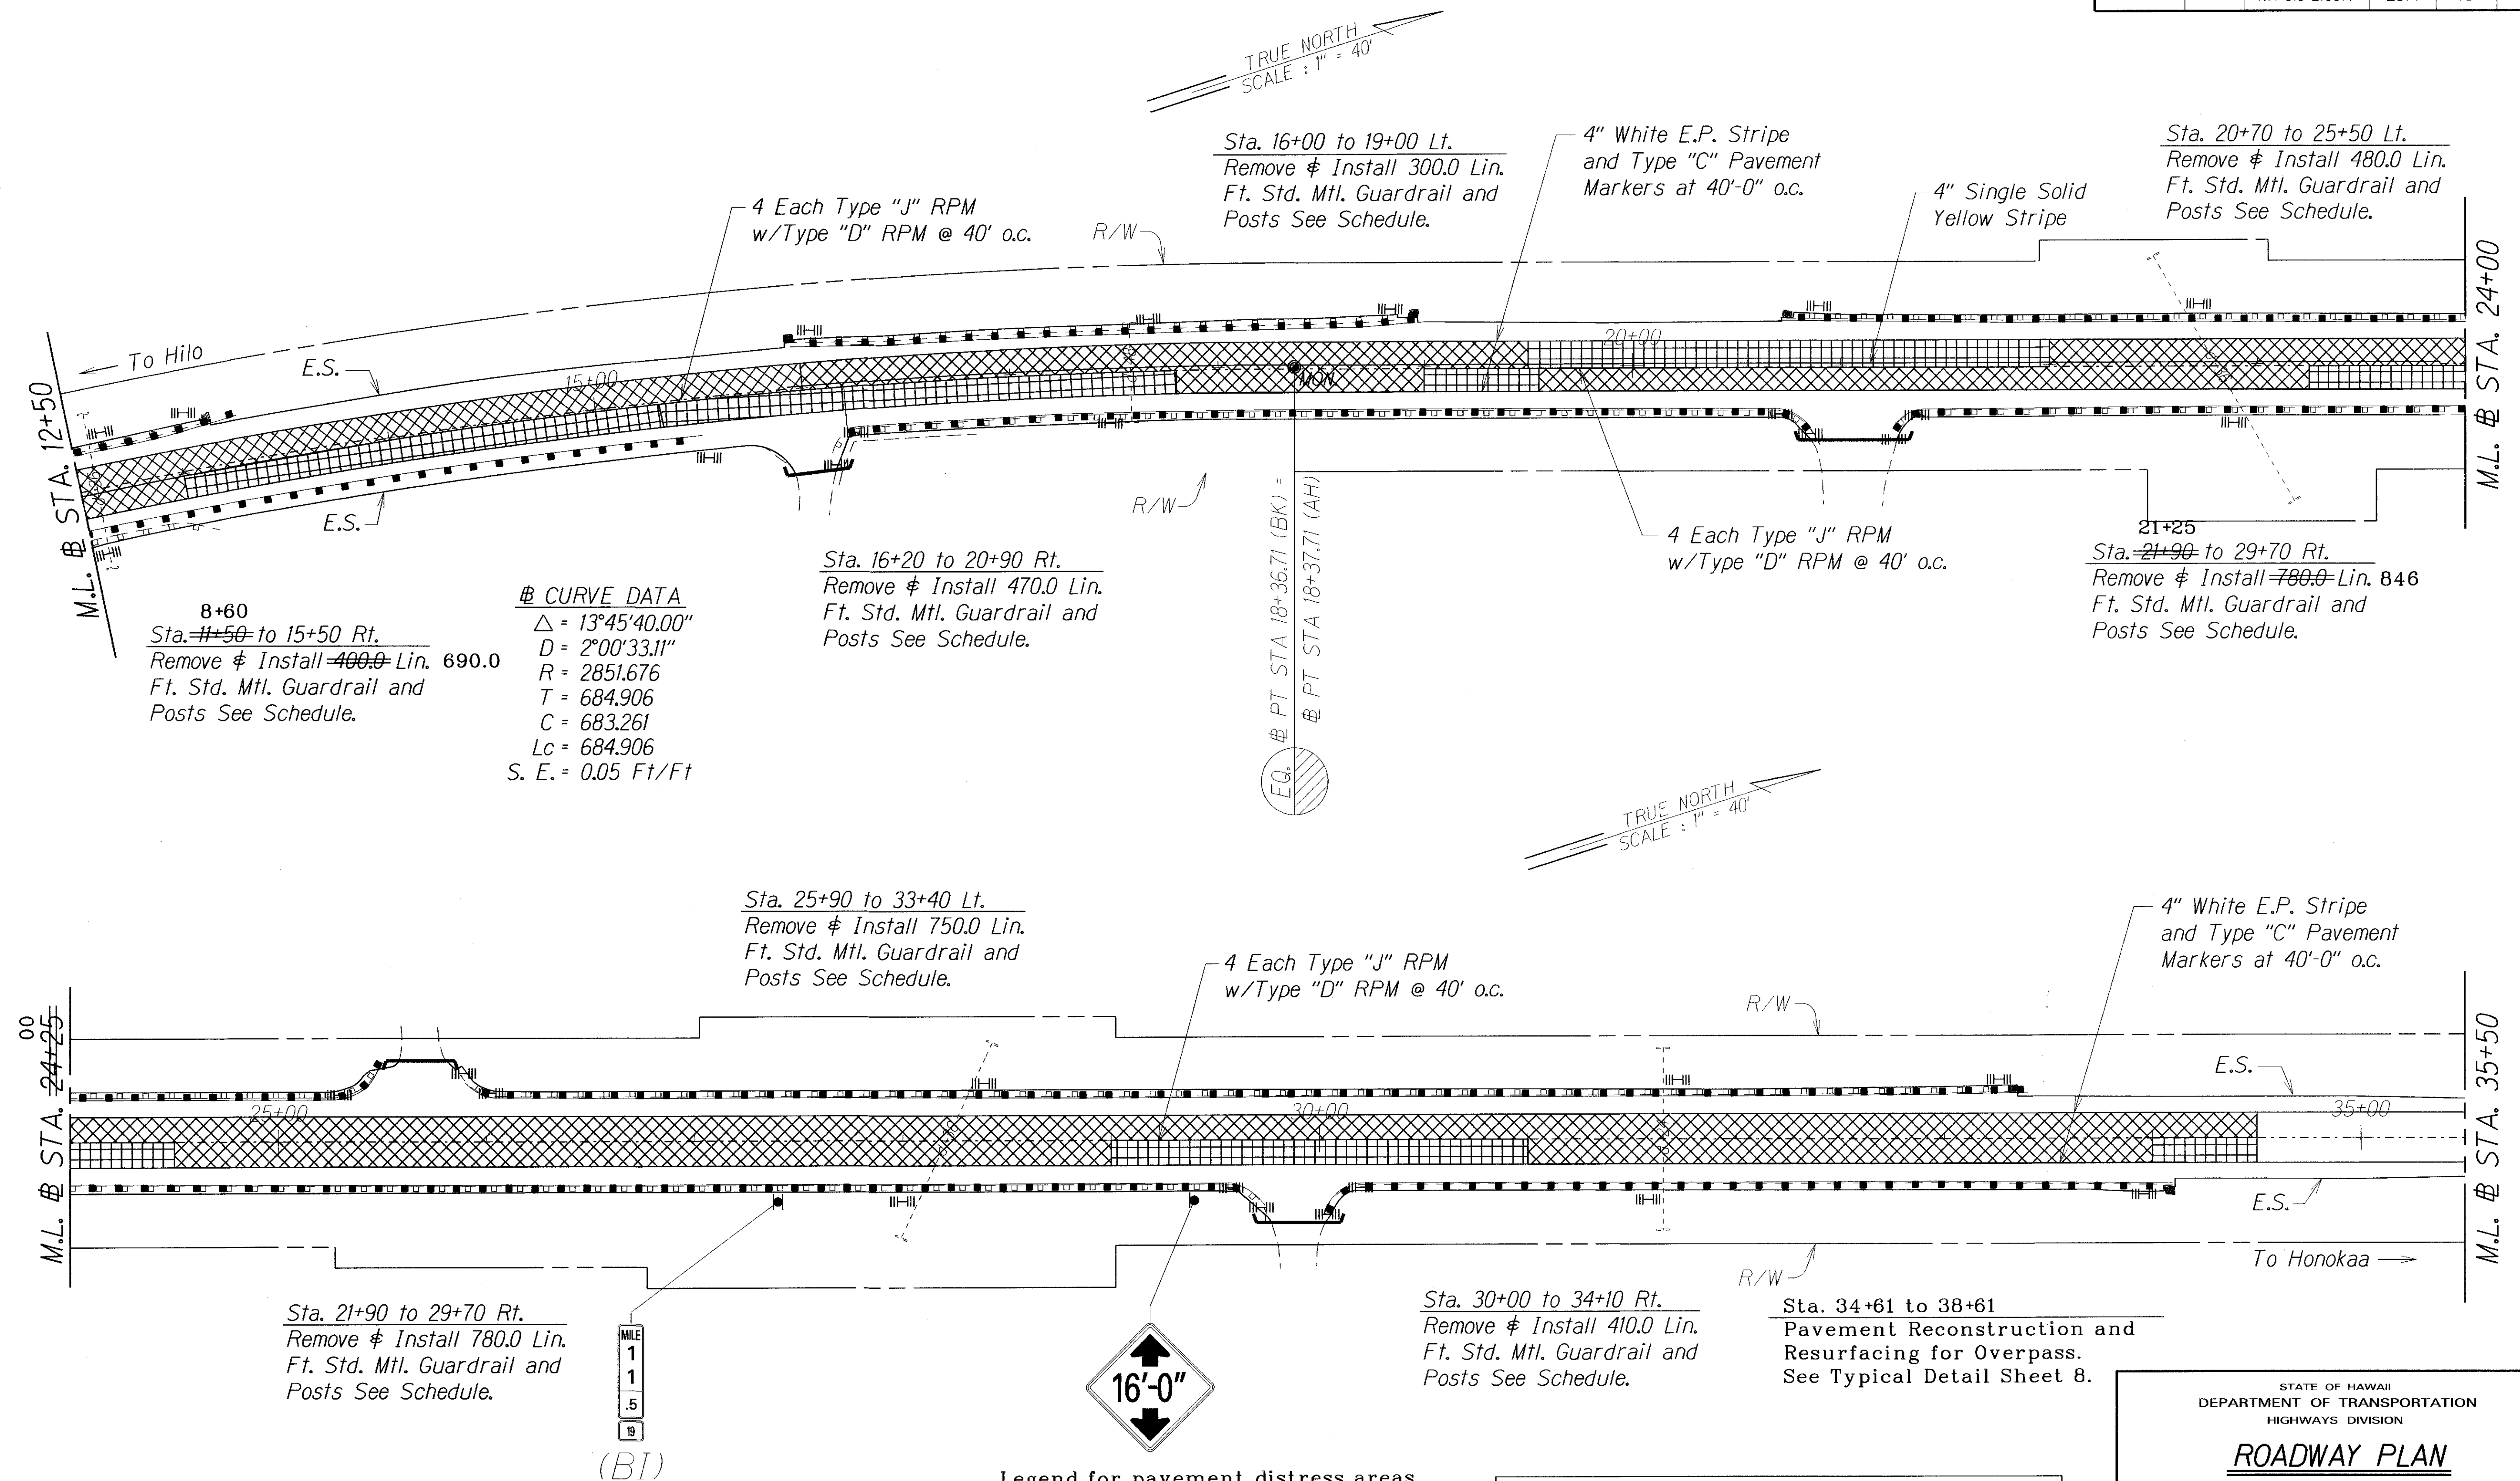

Notes:

1. All existing signs (dashed) with post are to remain.
2. All existing signs in conflict with construction signs are to be covered.
3. This work shall be considered incidental to various contract items.

Legend for pavement distress areas

	Minor Distress
	Severe Distress

LEGEND FOR AS-BUILT POSTINGS

	Squiggly line for as-built deletion
	Double line for as-built deletion
Roadway	Text for as-built posting

STATE OF HAWAII
DEPARTMENT OF TRANSPORTATION
HIGHWAYS DIVISION

ROADWAY PLAN

*Hawaii Belt Road Resurfacing
Pepeekeo to Hakalau*

Federal Aid Project No. NH-019-2(067)

Scale: 1" = 40' Date: March, 2014


SHEET No. 4 OF 13 SHEETS

"AS-BUILT"


13

DIST. NO.	STATE	FED. AID PROJ. NO.	FISCAL YEAR	SHEET NO.	TOTAL SHEETS
HAWAII	HAW.	NH-019-2(067)	2014	14	41

Sta. 34+61 to 38+61
Pavement Reconstruction and
Resurfacing at Overpass.
See Typical Detail Sheet B.

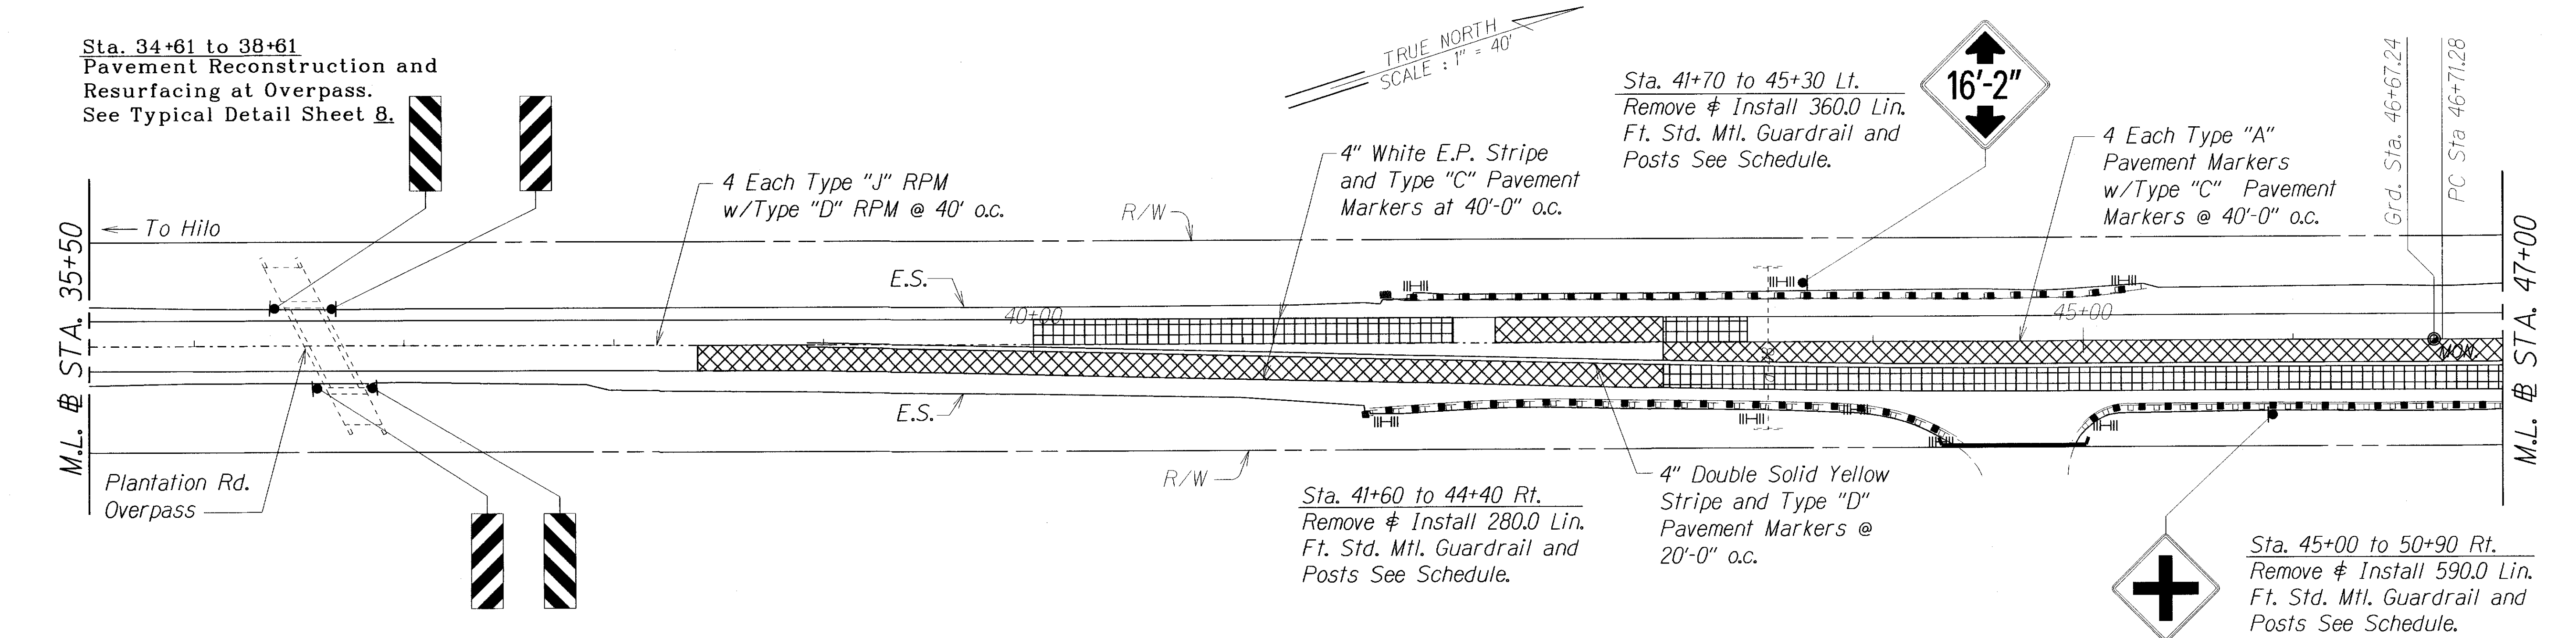

CURVE DATA
 $\Delta = 27^{\circ}14'35''$
 $D = 2^{\circ}00'41''$
 $R = 2848.57$
 $T = 690.2747$
 $C = 1341.718$
 $Lc = 1354.441$
 $S. E. = NO$

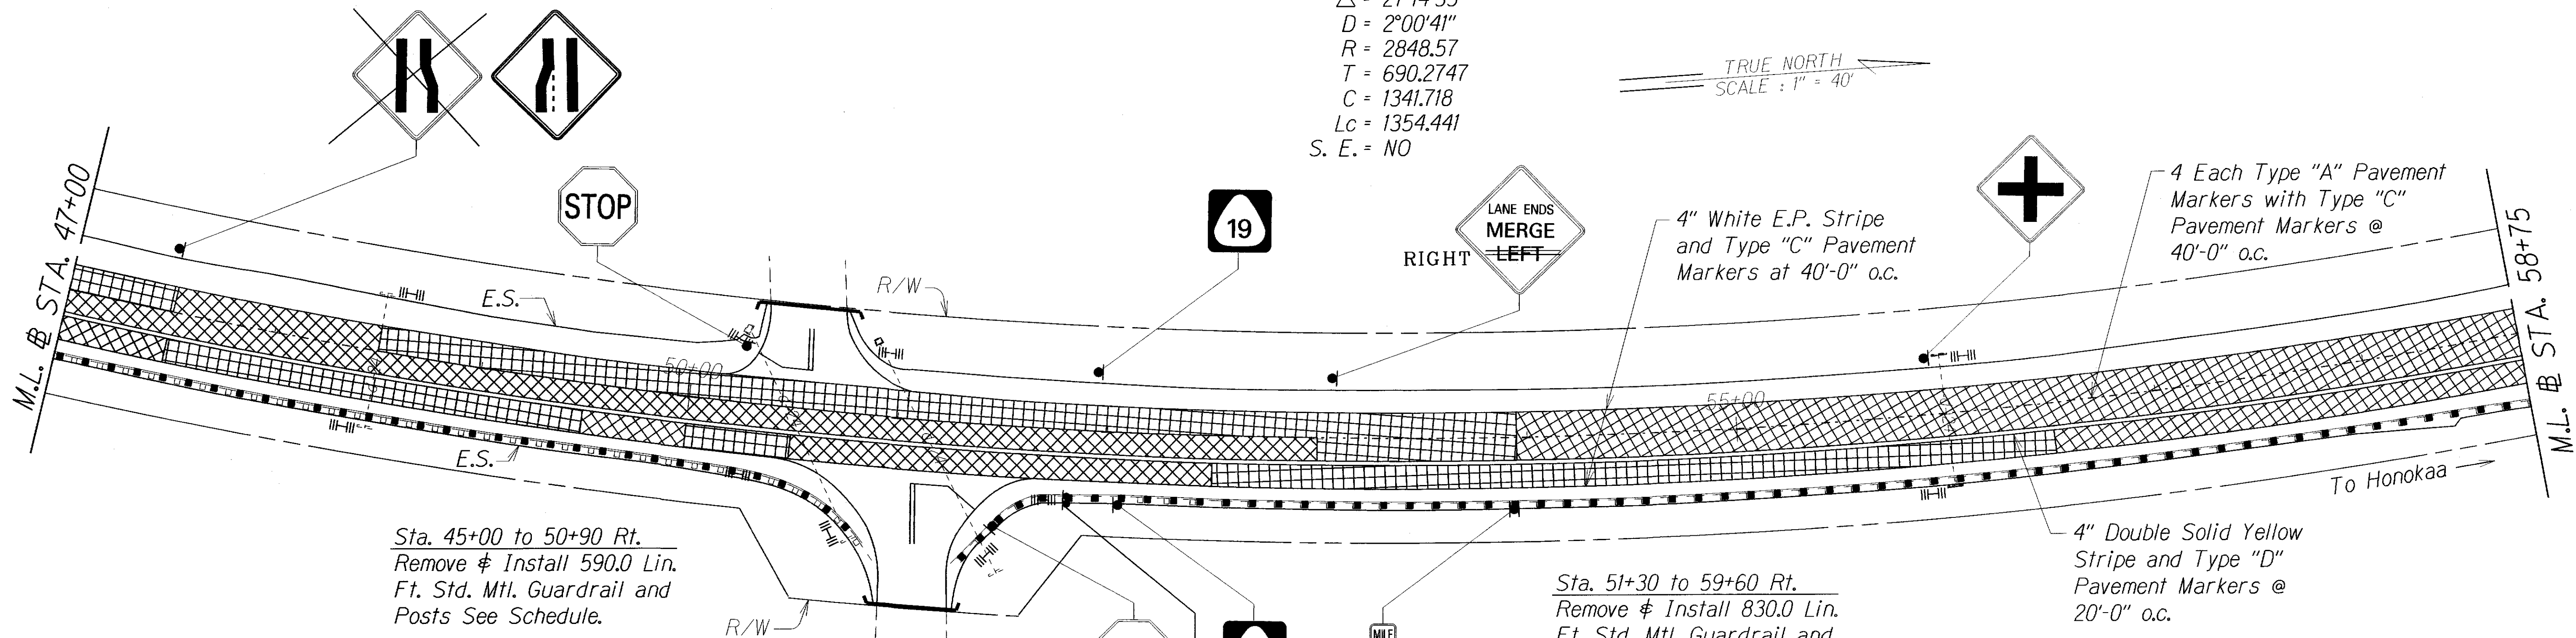

Legend for pavement distress areas

- Minor Distress
- Severe Distress

Notes:

- All existing signs (dashed) with post are to remain.
- All existing signs in conflict with construction signs are to be covered.
- This work shall be considered incidental to various contract items.

LEGEND FOR AS-BUILT POSTINGS

- Squiggly line for as-built deletion
- Double line for as-built deletion
- Roadway Text for as-built posting

STATE OF HAWAII
DEPARTMENT OF TRANSPORTATION
HIGHWAYS DIVISION

ROADWAY PLAN



Hawaii Belt Road Resurfacing
Pepeekeo to Hakalau
Federal Aid Project No. NH-019-2(067)

Scale: 1" = 40' Date: March, 2014

SHEET No. 5 OF 13 SHEETS

"AS-BUILT"

DIST. NO.	STATE	FED. AID PROJ. NO.	FISCAL YEAR	SHEET NO.	TOTAL SHEETS
HAWAII	HAW.	NH-019-2(067)	2014	15	41

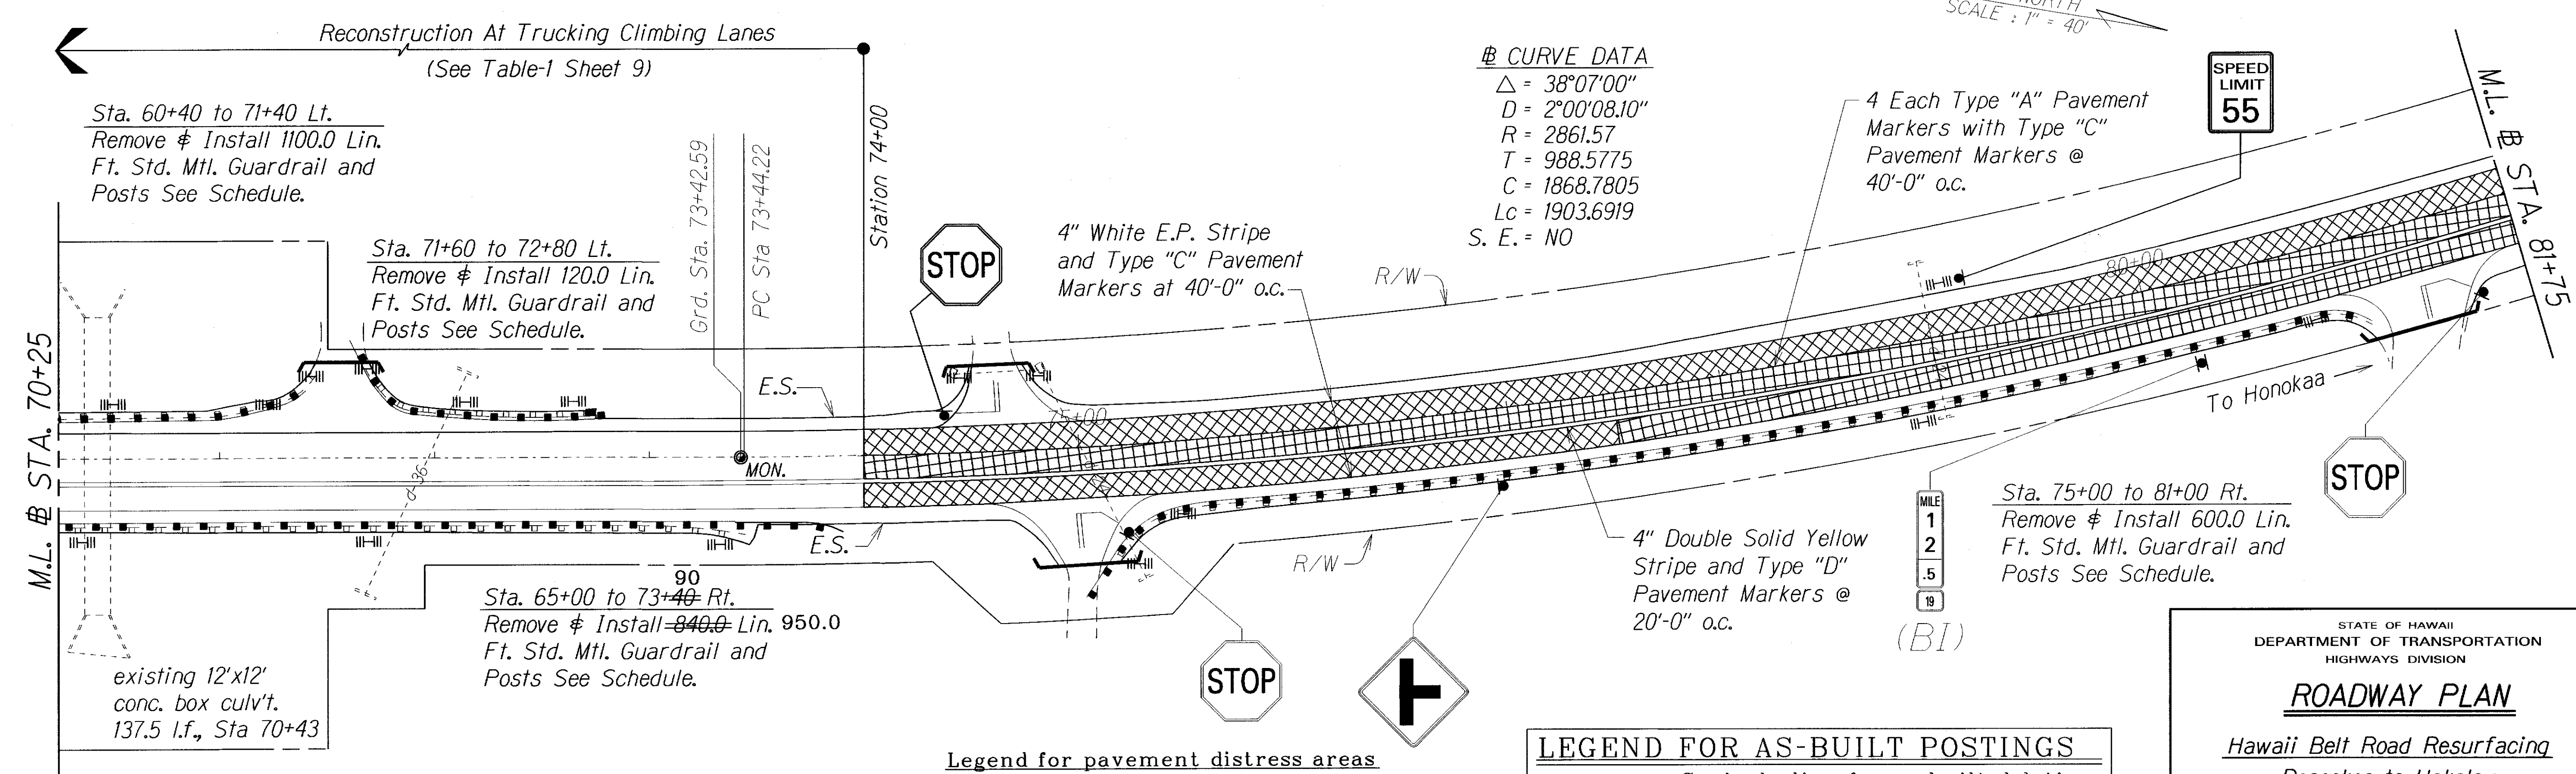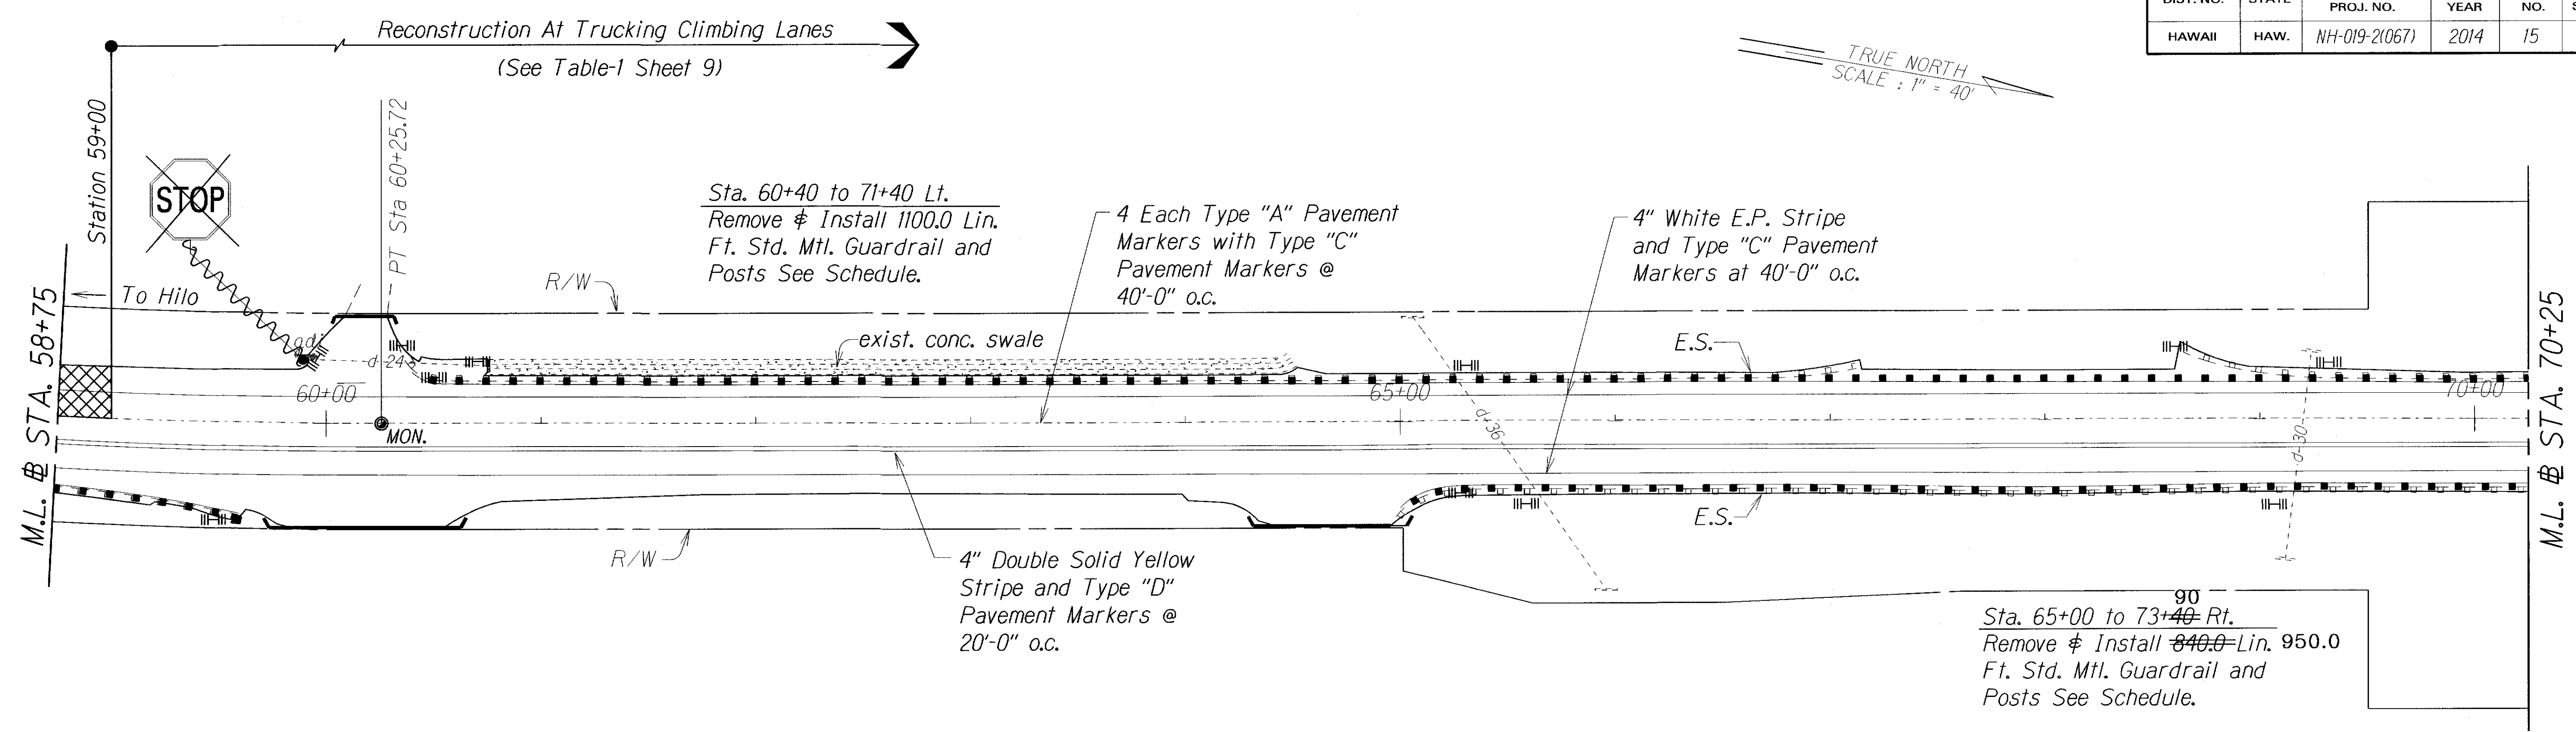

CURVE DATA
 $\Delta = 38^{\circ}07'00''$
 $D = 2^{\circ}00'08.10''$
 $R = 2861.57$
 $T = 988.5775$
 $C = 1868.7805$
 $Lc = 1903.6919$
 $S. E. = NO$

- Notes:
1. All existing signs (dashed) with post are to remain.
 2. All existing signs in conflict with construction signs are to be covered.
 3. This work shall be considered incidental to various contract items.

Legend for pavement distress areas

	Minor Distress
	Severe Distress

LEGEND FOR AS-BUILT POSTINGS

	Squiggly line for as-built deletion
	Double line for as-built deletion
Roadway	Text for as-built posting

STATE OF HAWAII
DEPARTMENT OF TRANSPORTATION
HIGHWAYS DIVISION

ROADWAY PLAN

*Hawaii Belt Road Resurfacing
Pepeekeo to Hakalau*


Federal Aid Project No. NH-019-2(067)

Scale: 1" = 40' Date: March, 2014

SHEET No. 6 OF 13 SHEETS

"AS-BUILT"

DIST. NO.	STATE	FED. AID PROJ. NO.	FISCAL YEAR	SHEET NO.	TOTAL SHEETS
HAWAII	HAW.	NH-019-2(067)	2014	16	41

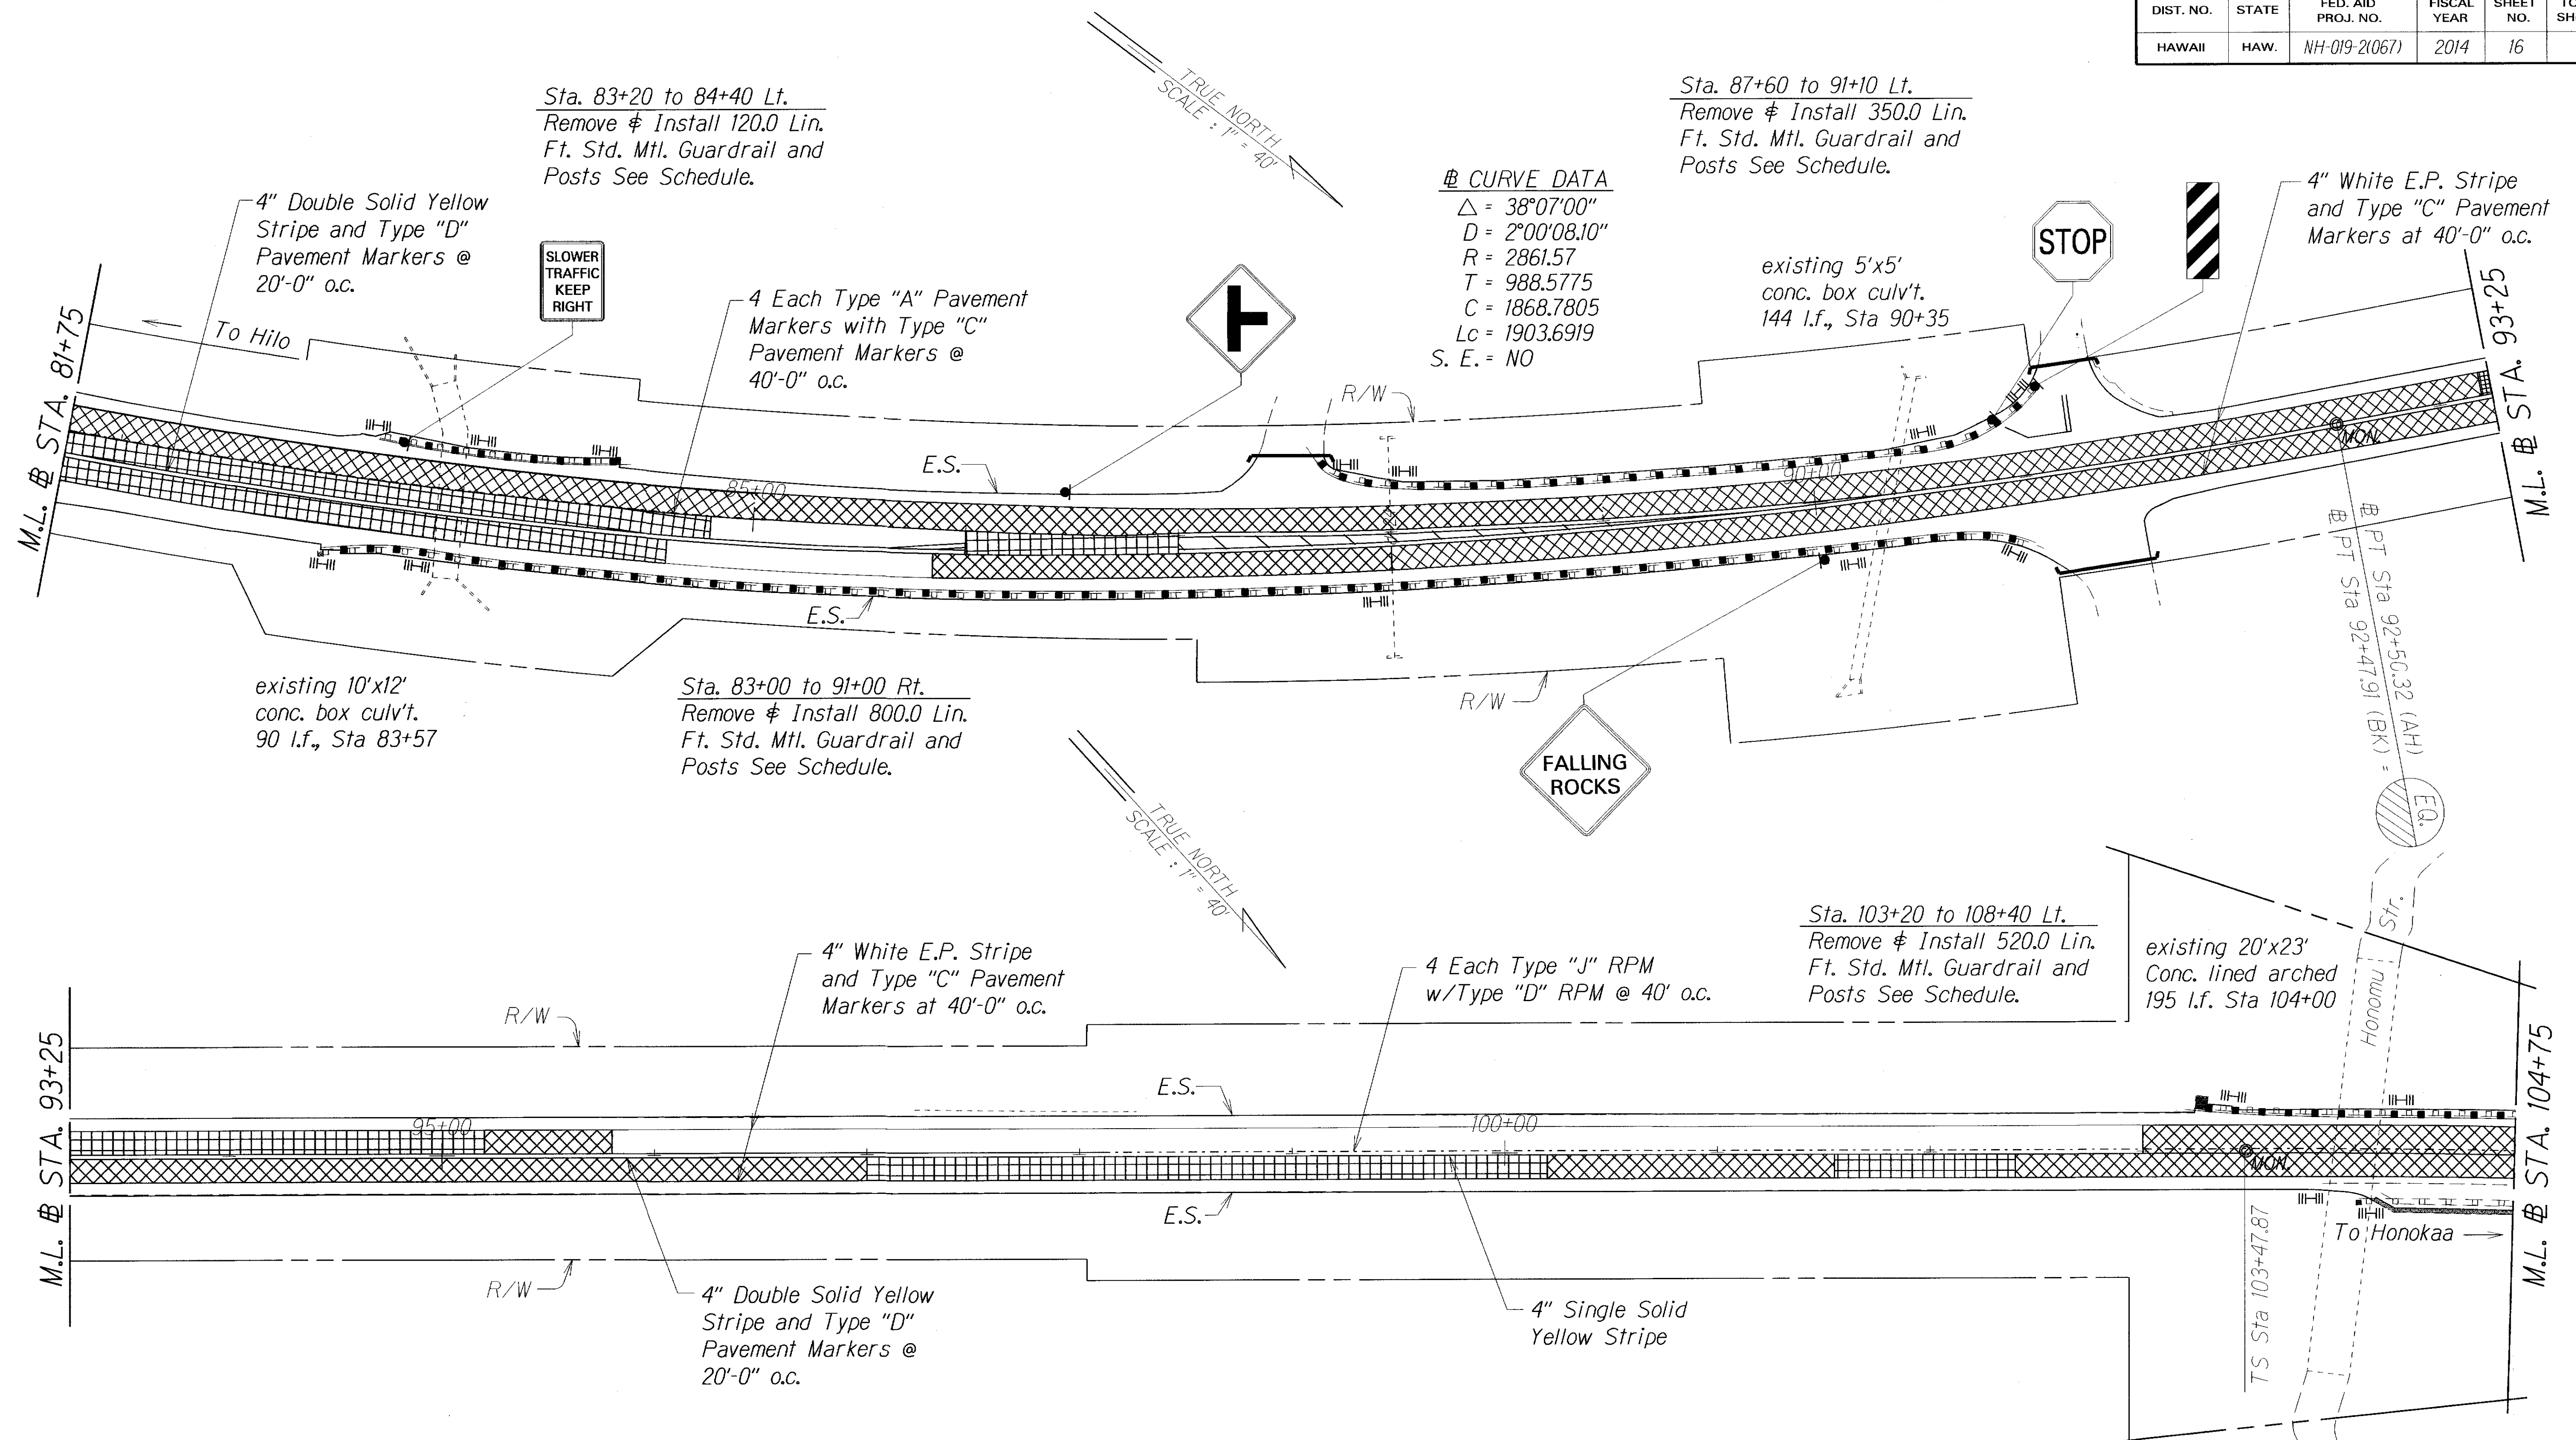

Notes:

1. All existing signs (dashed) with post are to remain.
2. All existing signs in conflict with construction signs are to be covered.
3. This work shall be considered incidental to various contract items.

Legend for pavement distress areas

	Minor Distress
	Severe Distress

LEGEND FOR AS-BUILT POSTINGS	
	Squiggly line for as-built deletion
	Double line for as-built deletion
Roadway	Text for as-built posting

STATE OF HAWAII
DEPARTMENT OF TRANSPORTATION
HIGHWAYS DIVISION

ROADWAY PLAN

Hawaii Belt Road Resurfacing
Pepeekeo to Hakalau
Federal Aid Project No. NH-019-2(067)

Scale: 1" = 40'


Date: March, 2014

SHEET No. 7 OF 13 SHEETS

"AS-BUILT"

16


DIST. NO.	STATE	FED. AID PROJ. NO.	FISCAL YEAR	SHEET NO.	TOTAL SHEETS
HAWAII	HAW.	NH-019-2(067)	2014	17	41

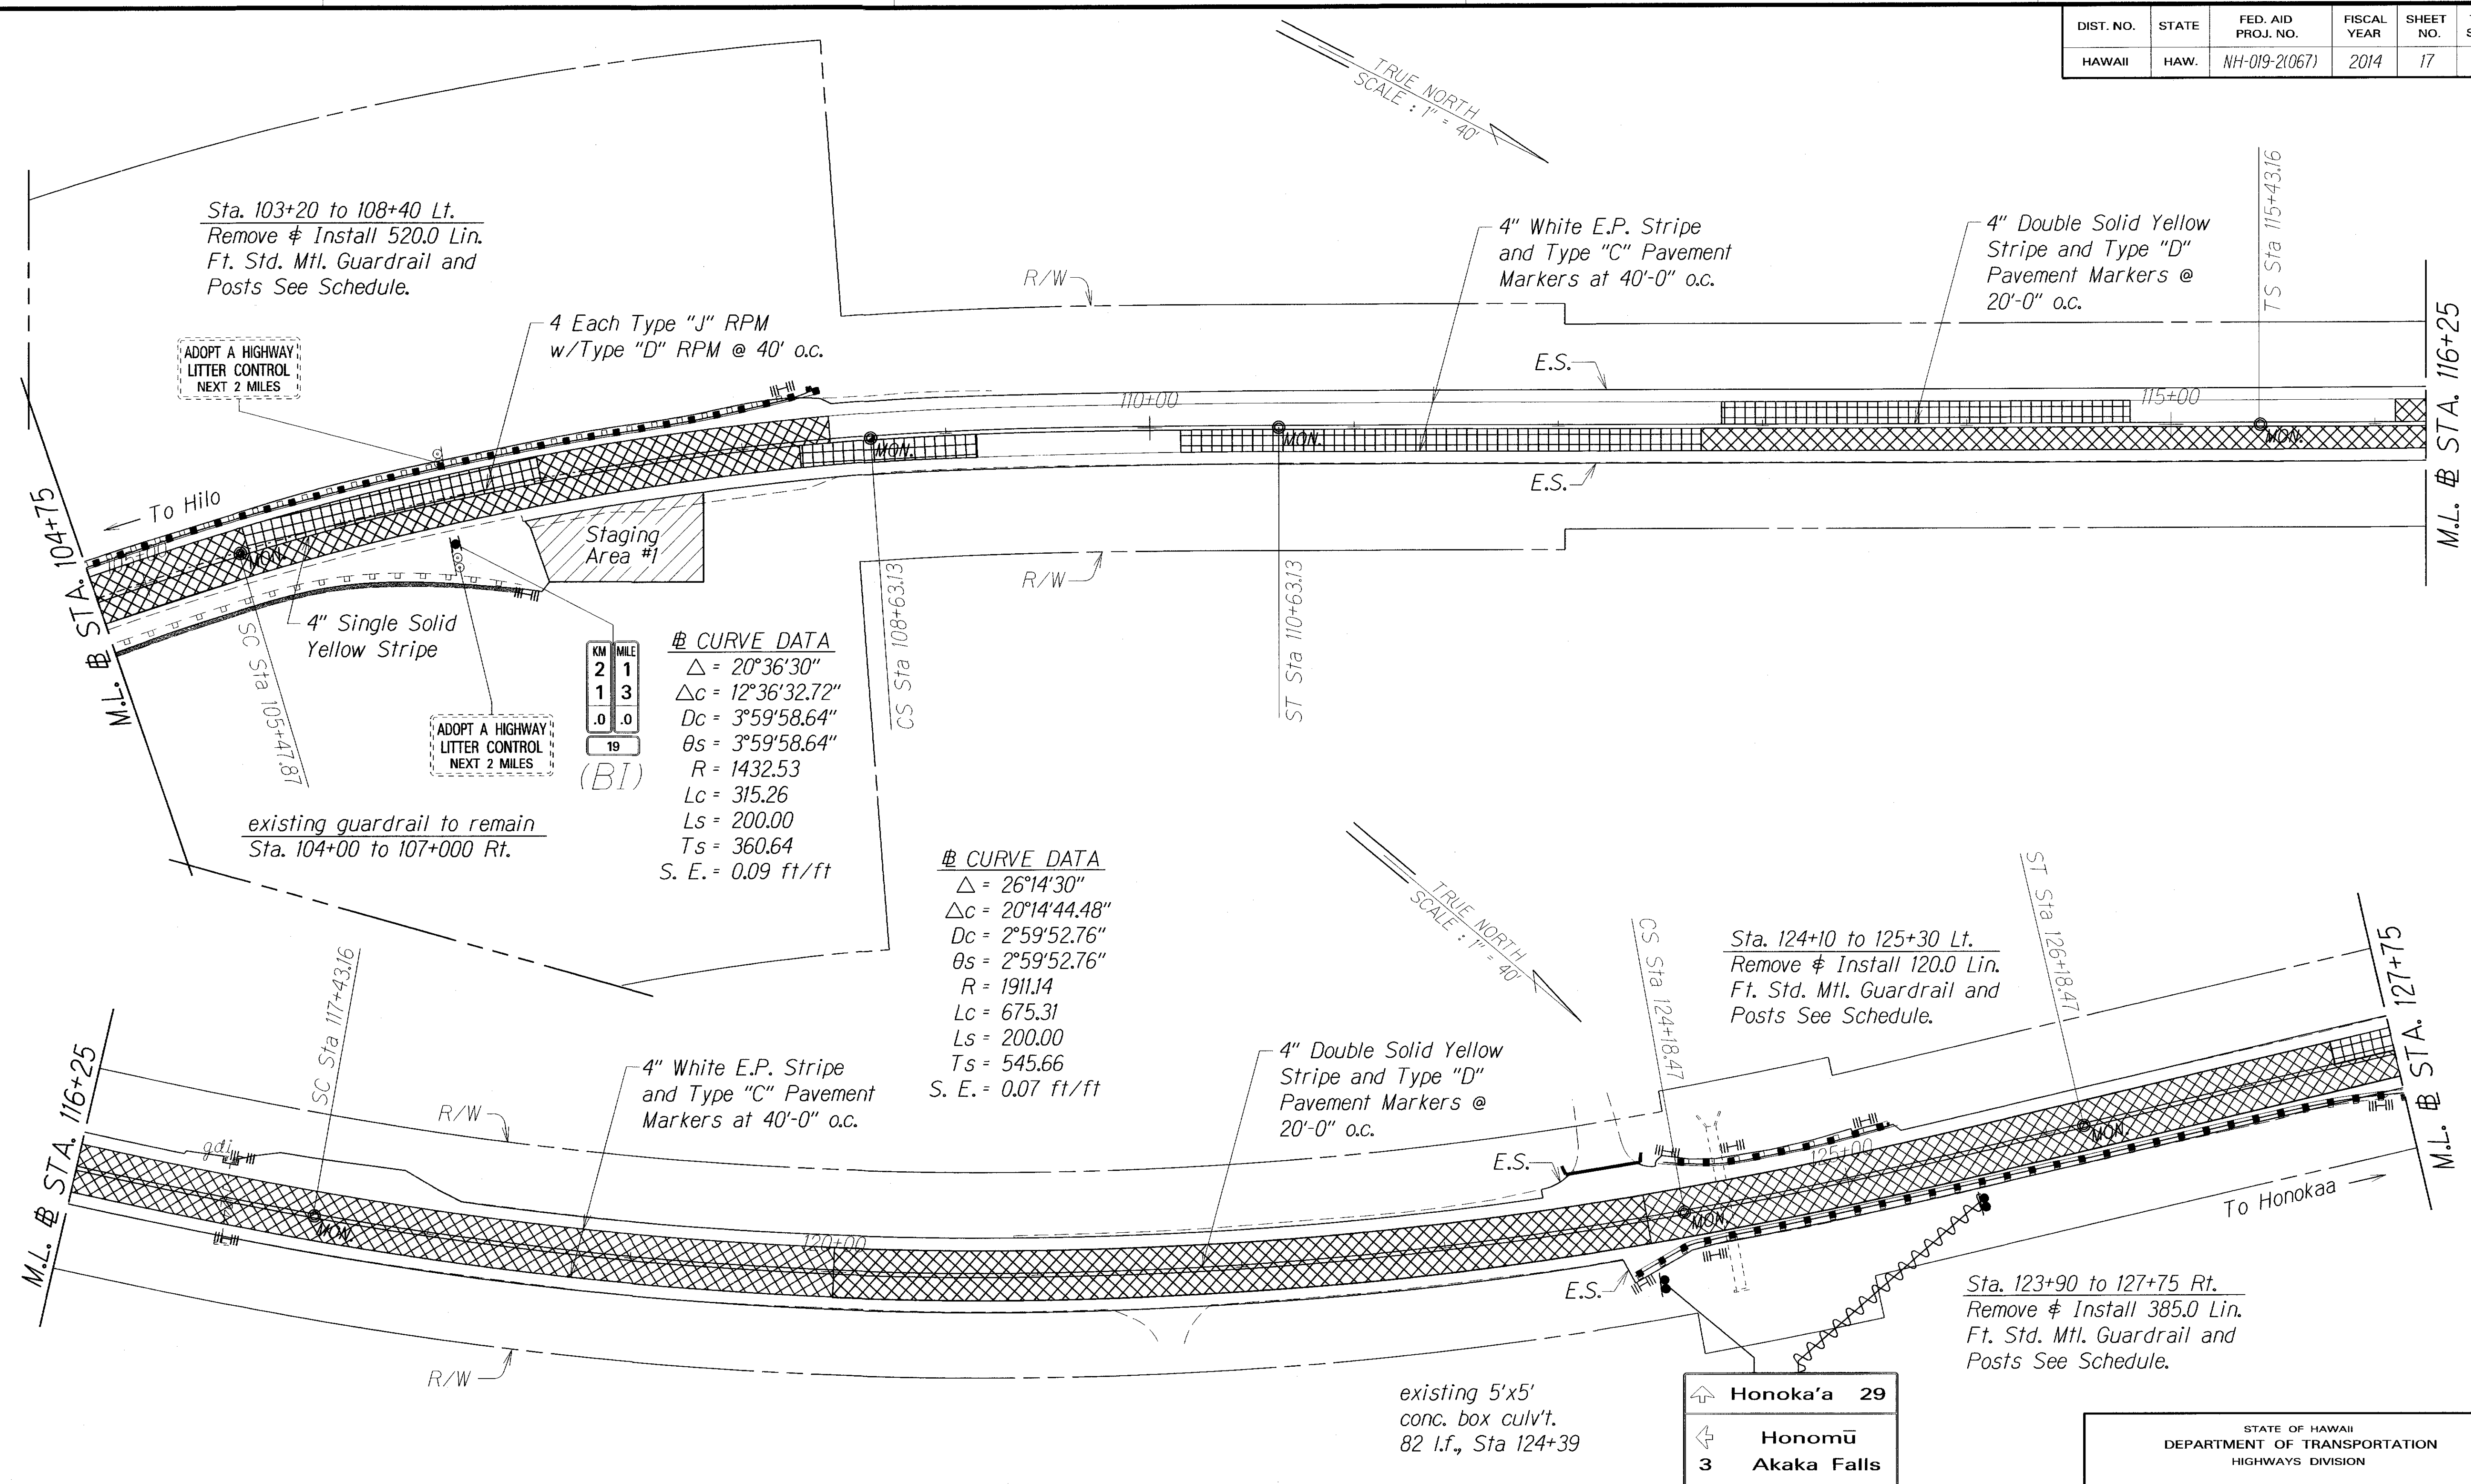

"AS-BUILT"

17

DIST. NO.	STATE	FED. AID PROJ. NO.	FISCAL YEAR	SHEET NO.	TOTAL SHEETS
HAWAII	HAW.	NH-019-2(067)	2014	18	41

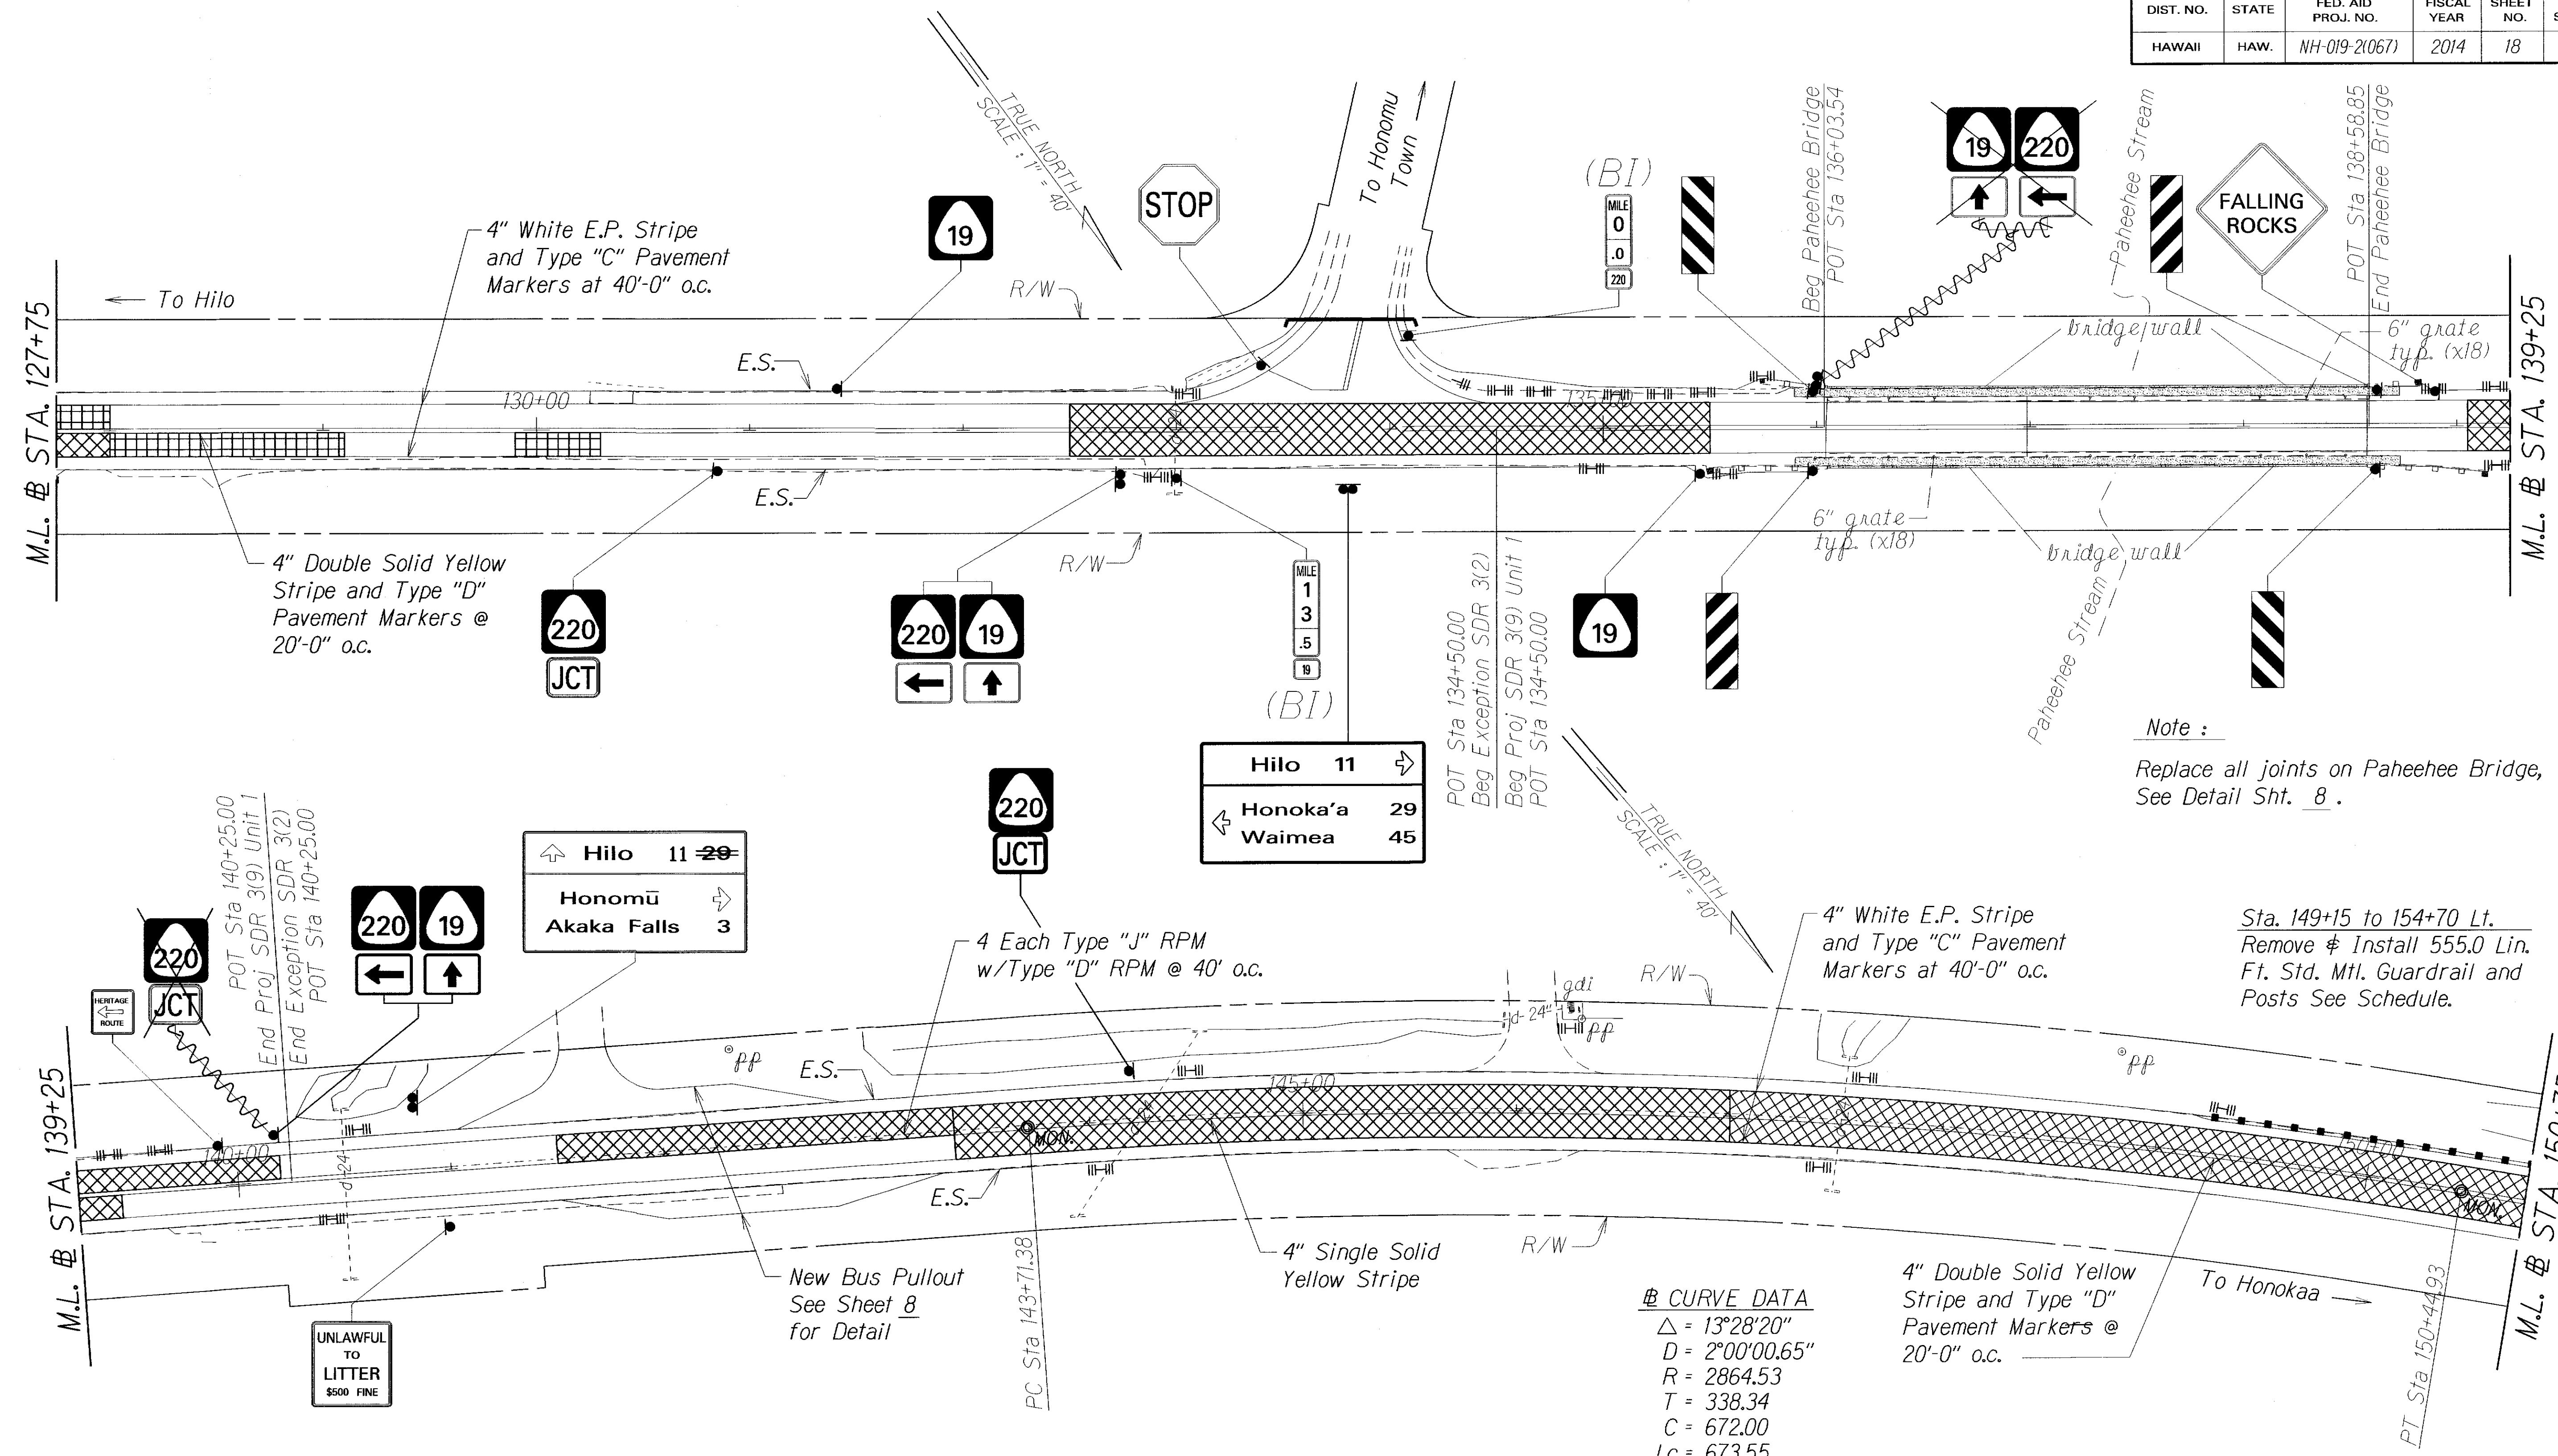

Note :
Replace all joints on Paheehoe Bridge,
See Detail Sht. 8 .

Sta. 149+15 to 154+70 Lt.
Remove & Install 555.0 Lin.
Ft. Std. Mt. Guardrail and
Posts See Schedule.

CURVE DATA
 $\Delta = 13^{\circ}28'20''$
 $D = 2^{\circ}00'00.65''$
 $R = 2864.53$
 $T = 338.34$
 $C = 672.00$
 $Lc = 673.55$
 $S. E. = NO$

- Notes:
1. All existing signs (dashed) with post are to remain.
 2. All existing signs in conflict with construction signs are to be covered.
 3. This work shall be considered incidental to various contract items.

Legend for pavement distress areas

- Minor Distress
- Severe Distress

LEGEND FOR AS-BUILT POSTINGS



- Squiggly line for as-built deletion
- Double line for as-built deletion
- Roadway Text for as-built posting

STATE OF HAWAII
DEPARTMENT OF TRANSPORTATION
HIGHWAYS DIVISION

ROADWAY PLAN
Hawaii Belt Road Resurfacing
Pepeekeo to Hakalau
Federal Aid Project No. NH-019-2(067)
Scale: 1" = 40' Date: March, 2014
SHEET No. 9 OF 13 SHEETS

"AS-BUILT"

DIST. NO.	STATE	FED. AID PROJ. NO.	FISCAL YEAR	SHEET NO.	TOTAL SHEETS
HAWAII	HAW.	NH-019-2(067)	2014	19	41

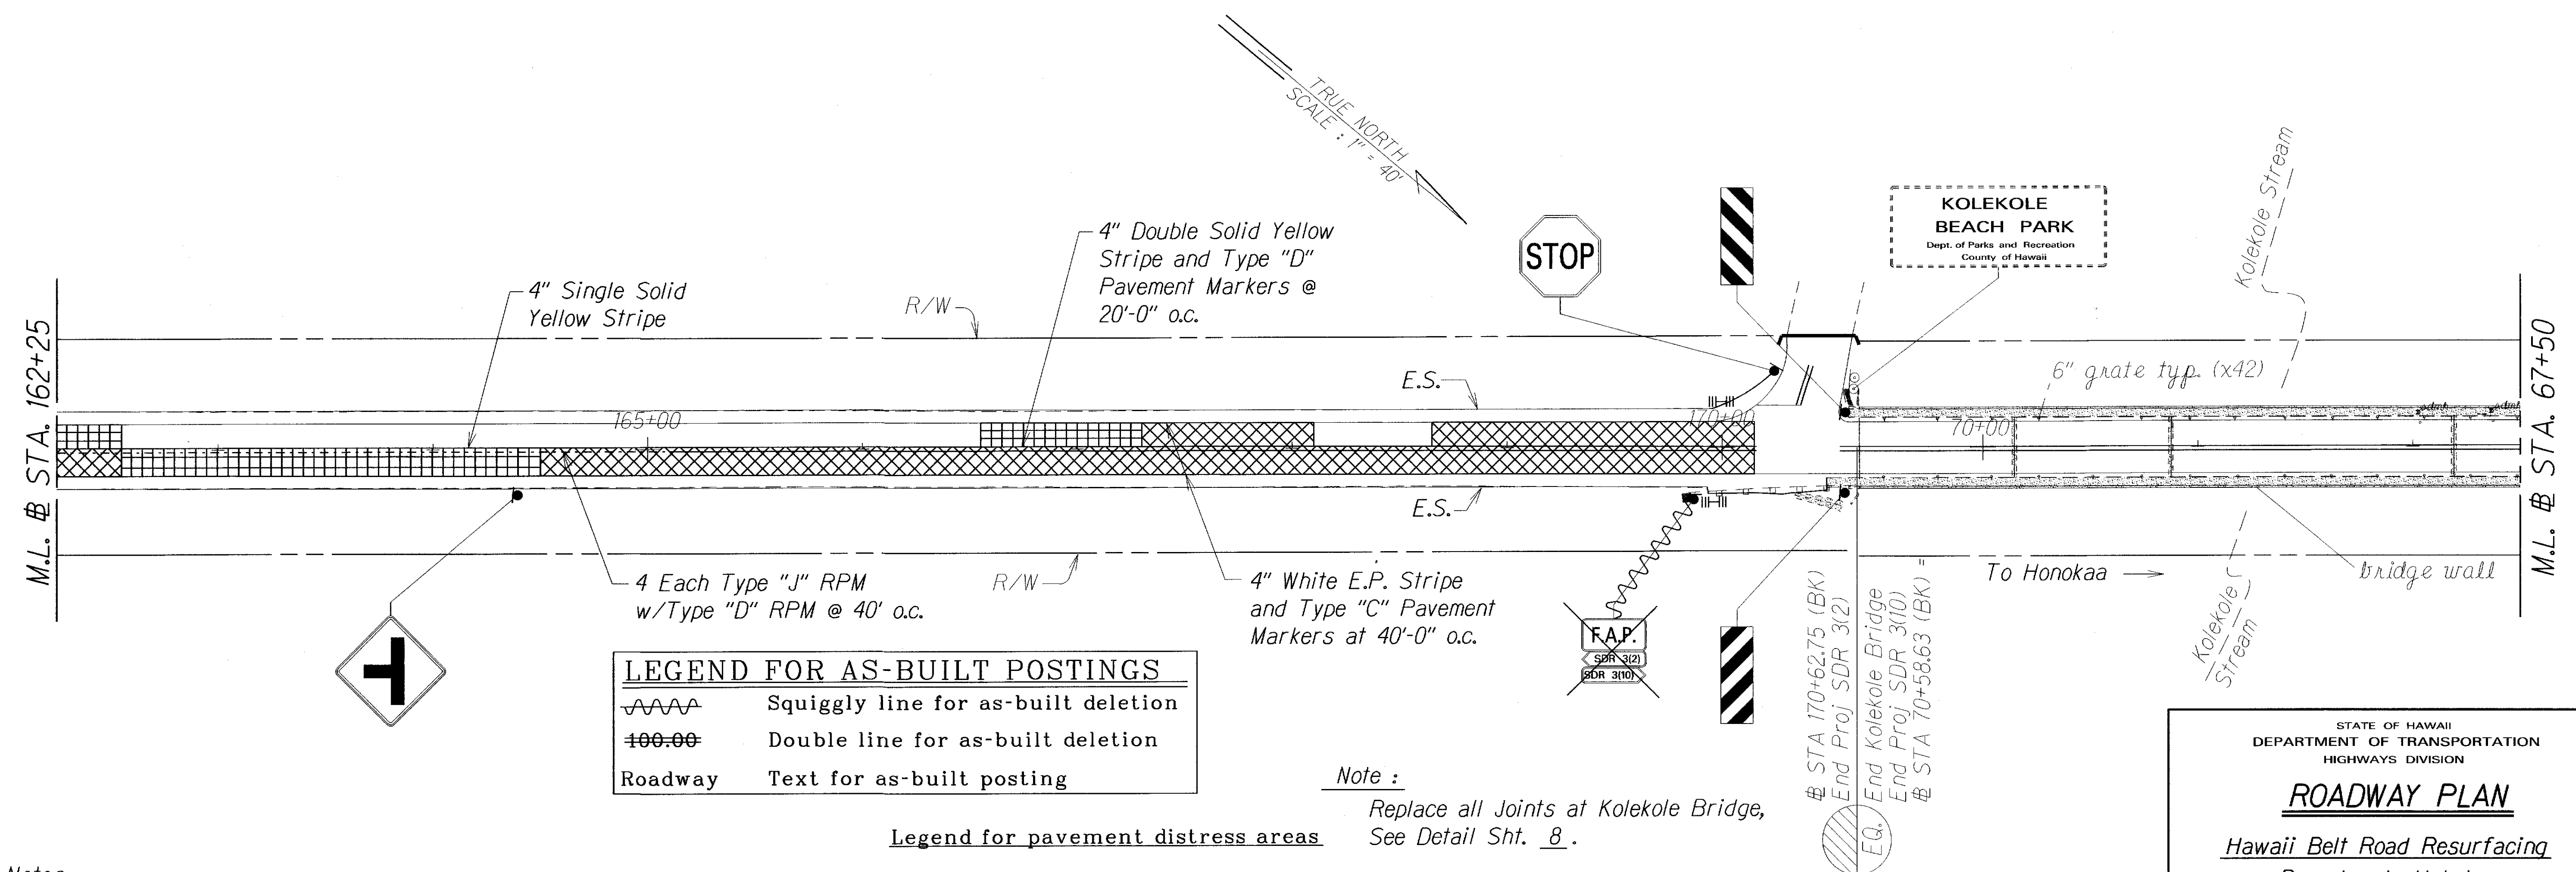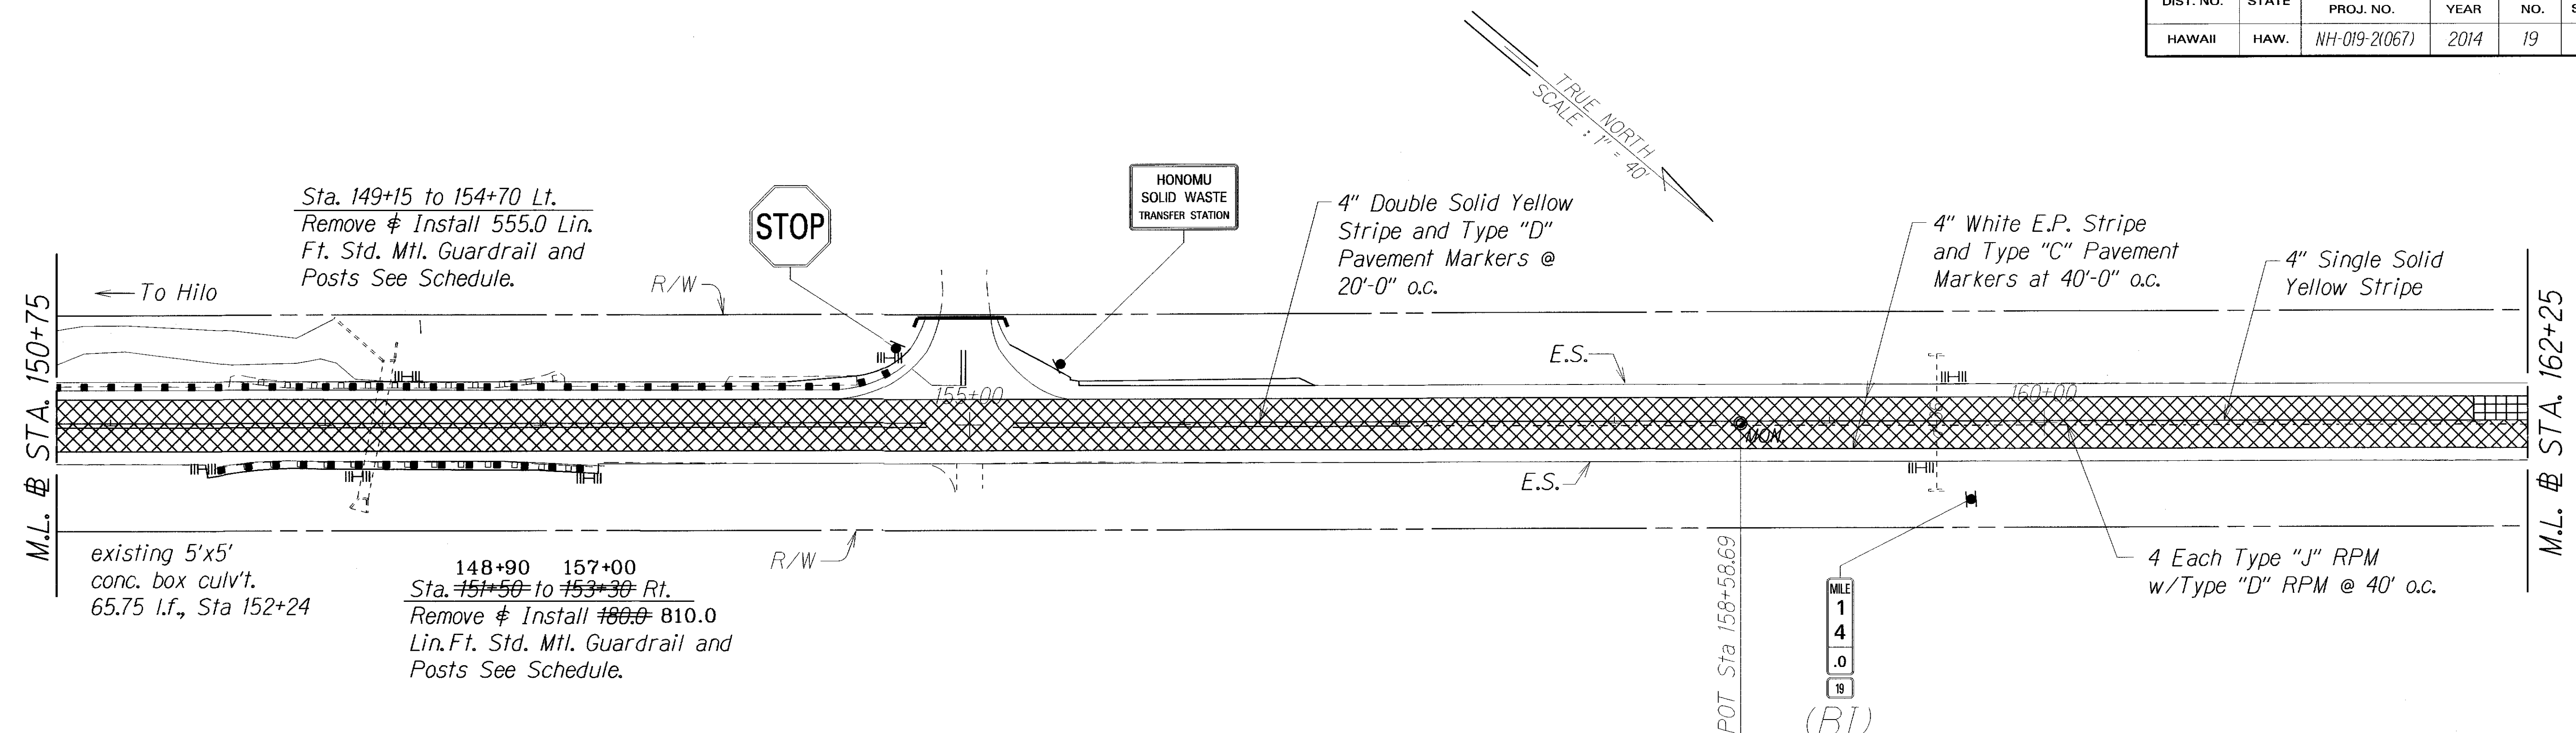

LEGEND FOR AS-BUILT POSTINGS	
	Squiggly line for as-built deletion
	Double line for as-built deletion
Roadway	Text for as-built posting

Legend for pavement distress areas

	Minor Distress
	Severe Distress

Notes:

1. All existing signs (dashed) with post are to remain.
2. All existing signs in conflict with construction signs are to be covered.
3. This work shall be considered incidental to various contract items.

Note :

Replace all Joints at Kolekole Bridge, See Detail Sht. 8.

ORIGINAL PLAN	DATE
DRAWN BY	
CHECKED BY	
NOTED BY	
QUANTITIES BY	
CHECKED BY	

STATE OF HAWAII
DEPARTMENT OF TRANSPORTATION
HIGHWAYS DIVISION

ROADWAY PLAN


Hawaii Belt Road Resurfacing
Pepeekeo to Hakalau
Federal Aid Project No. NH-019-2(067)

Scale: 1" = 40' Date: March, 2014

SHEET No. 10 OF 13 SHEETS

"AS-BUILT"

DIST. NO.	STATE	FED. AID PROJ. NO.	FISCAL YEAR	SHEET NO.	TOTAL SHEETS
HAWAII	HAW.	NH-019-2(067)	2014	20	41

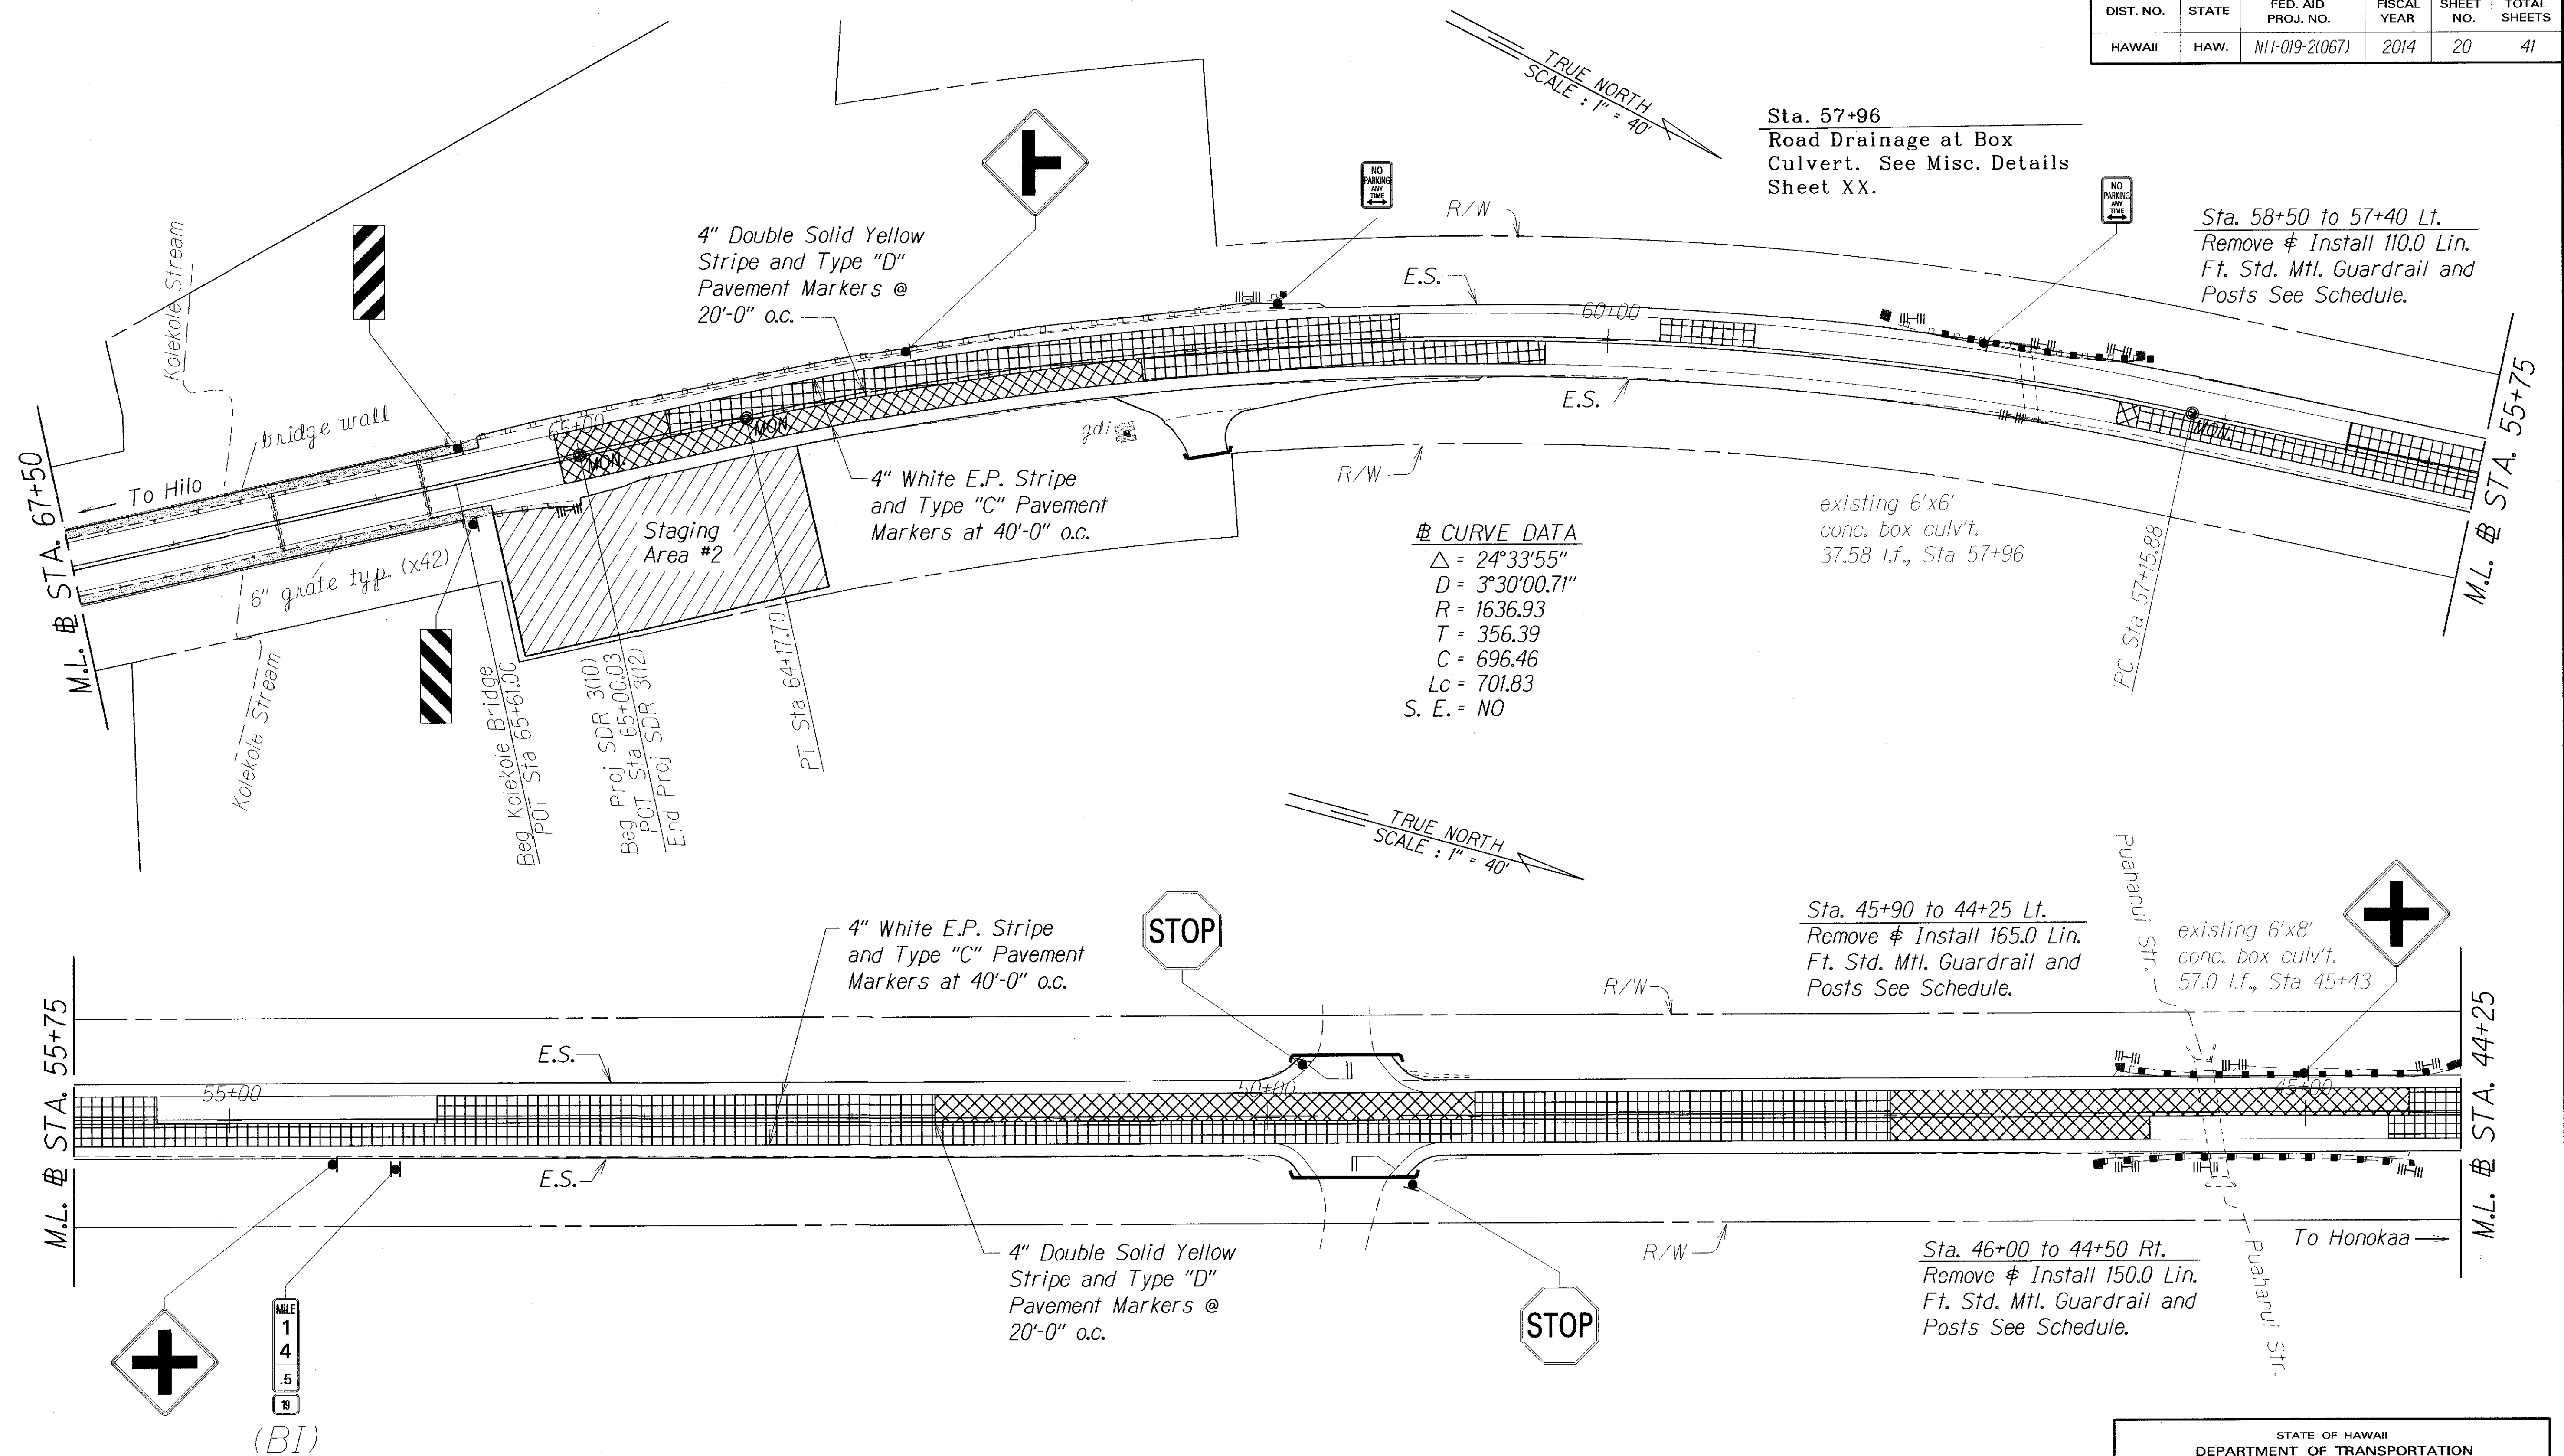

Notes:

- All existing signs (dashed) with post are to remain.
- All existing signs in conflict with construction signs are to be covered.
- This work shall be considered incidental to various contract items.

Legend for pavement distress areas

- Minor Distress
- Severe Distress

LEGEND FOR AS-BUILT POSTINGS

- Squiggly line for as-built deletion
- Double line for as-built deletion
- Roadway Text for as-built posting

STATE OF HAWAII
DEPARTMENT OF TRANSPORTATION
HIGHWAYS DIVISION

ROADWAY PLAN

Hawaii Belt Road Resurfacing
Pepeekeo to Hakalau
Federal Aid Project No. NH-019-2(067)


Scale: 1" = 40' Date: March, 2014

SHEET No. 11 OF 13 SHEETS

"AS-BUILT"

20

DIST. NO.	STATE	FED. AID PROJ. NO.	FISCAL YEAR	SHEET NO.	TOTAL SHEETS
HAWAII	HAW.	NH-019-2(067)	2014	22	41

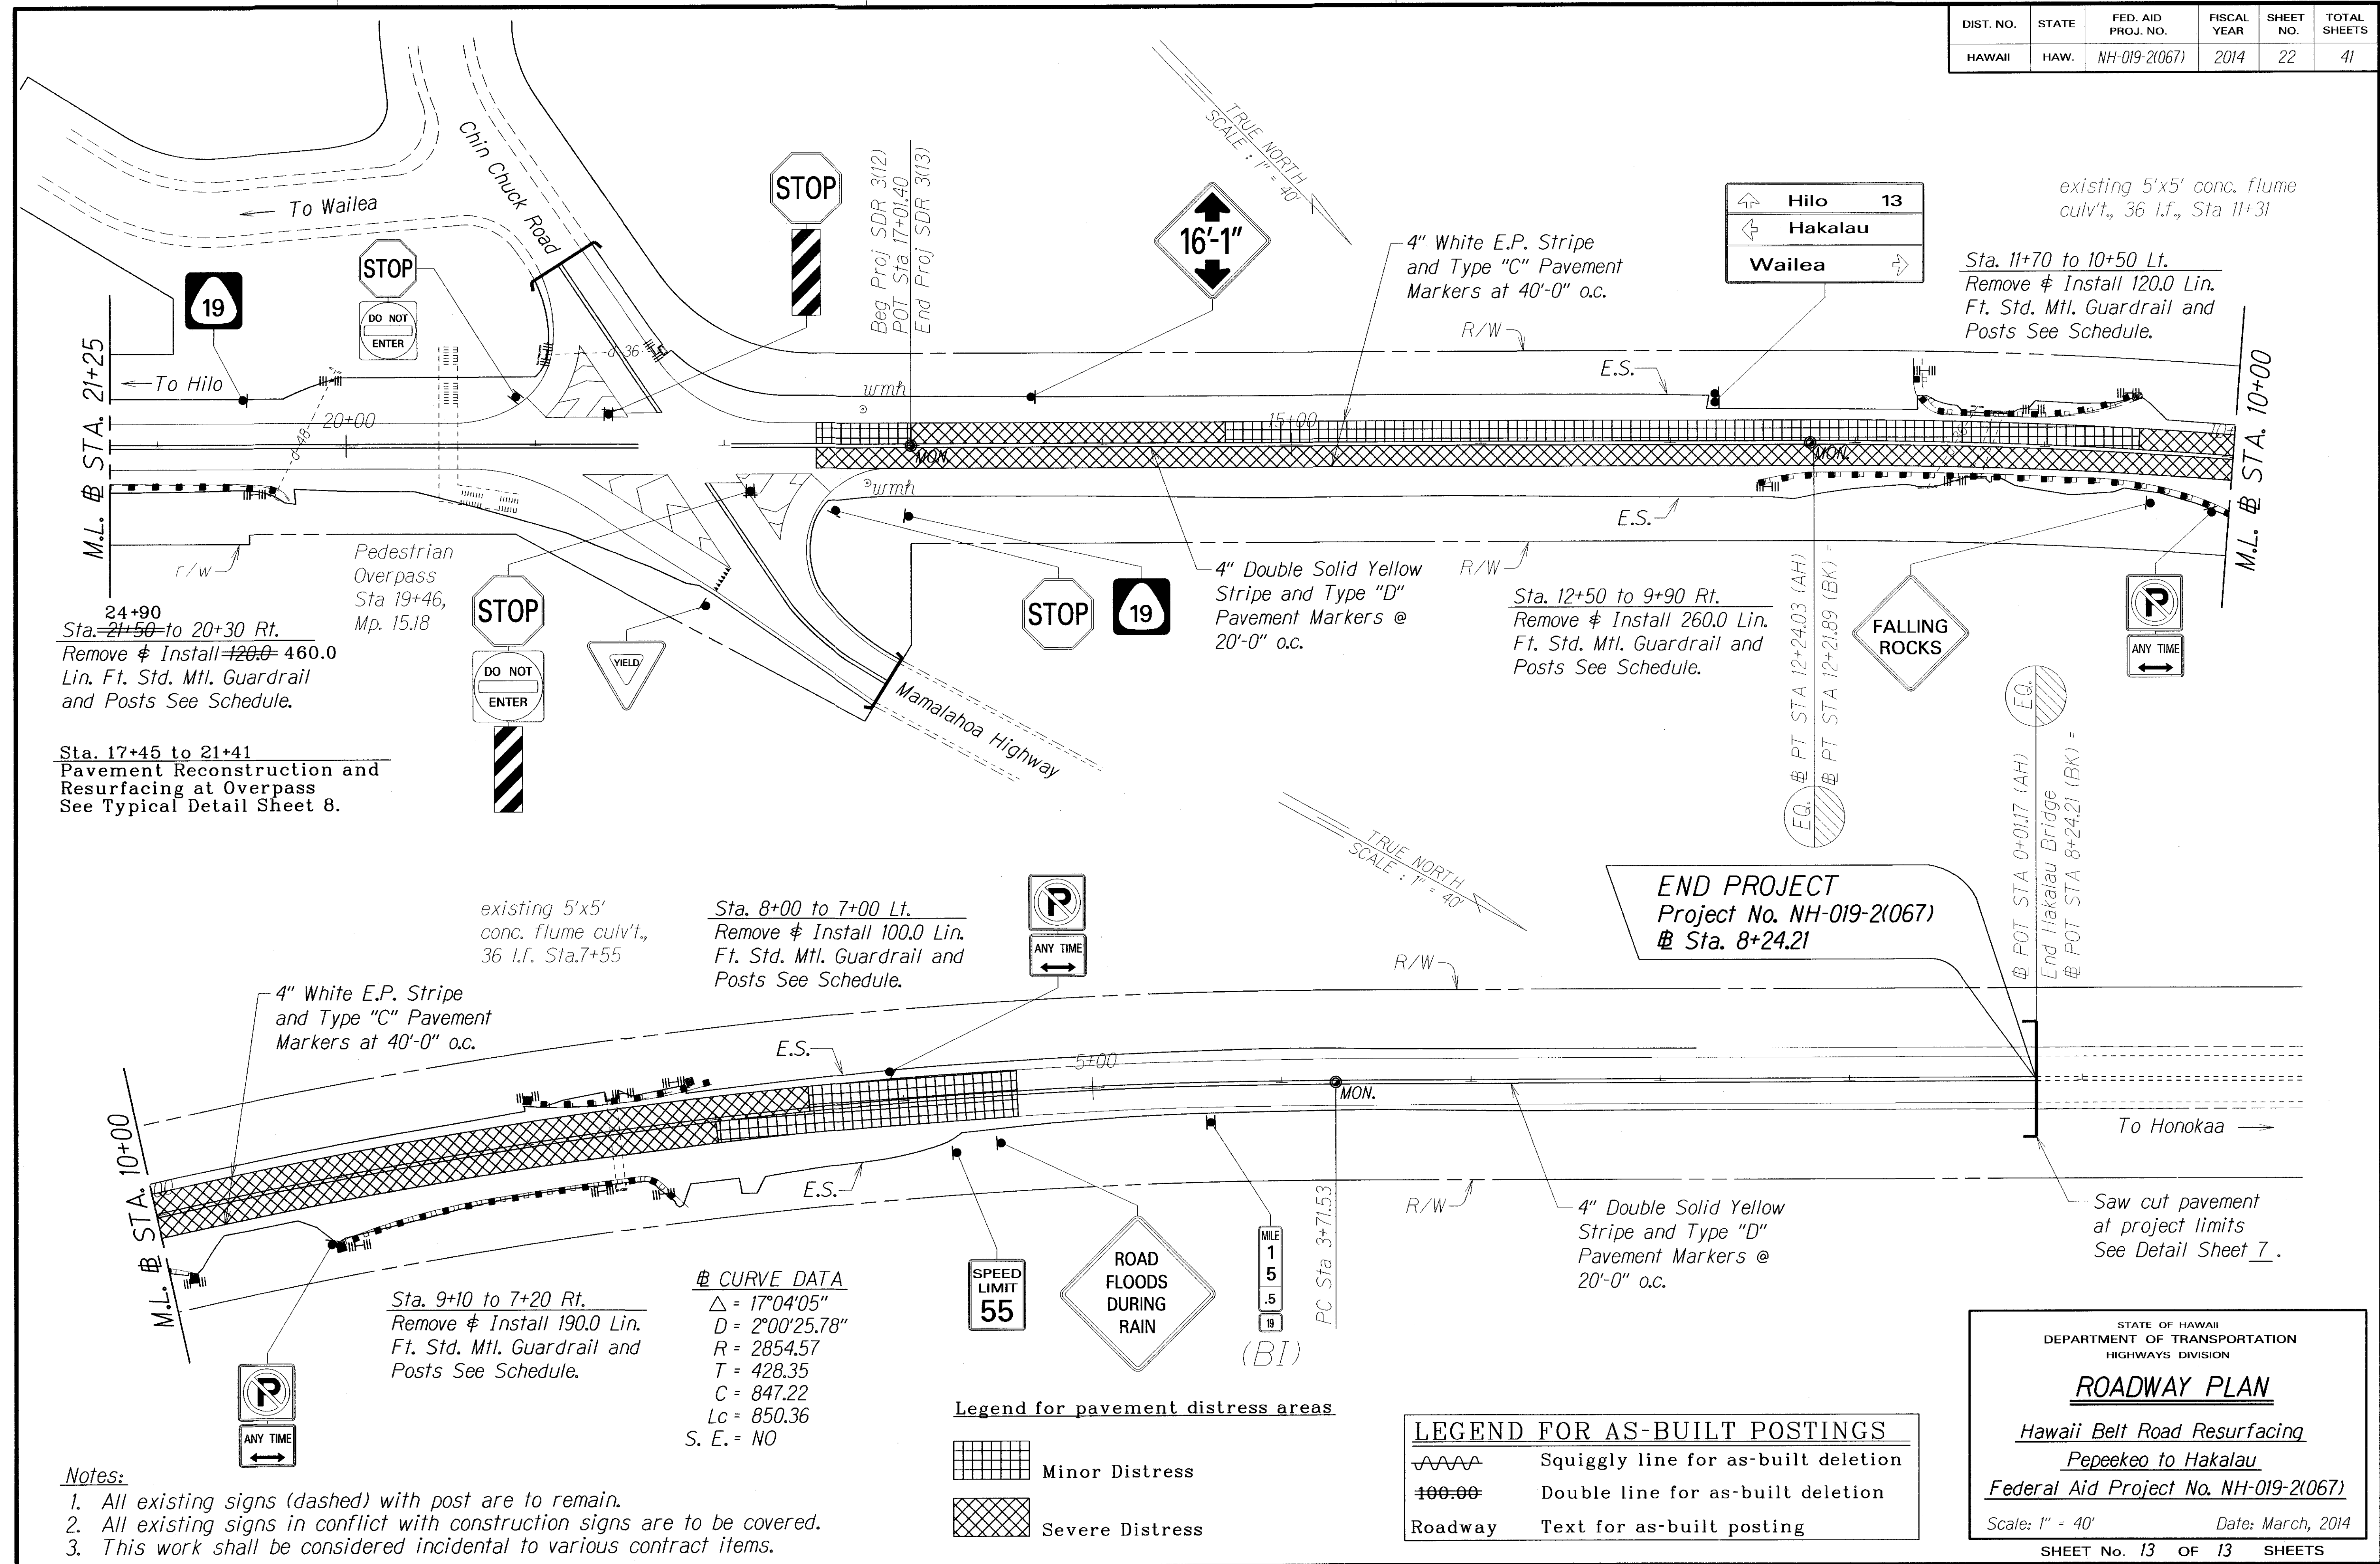

"AS-BUILT"