

ORIGINAL PLAN

SURVEY PLOTTED BY

DATE

DESIGNED BY

TRACED BY

NOTE BOOK

DESIGNED BY

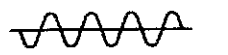
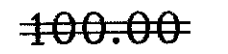
QUANTITIES BY

CHECKED BY

SIGN REPLACEMENT, REMOVAL, AND INSTALLATION SCHEDULE											
STATION	INBOUND	OUTBOUND	TYPE	SIGN TO REMAIN	REMOVE	INSTALL LESS THAN 10 SQ. FT.		INSTALL GREATER THAN 10 SQ. FT.		DESTINATION SIGN	
						W/POST	WO/POST	W/POST	WO/POST	SIZE (SQ. FT.)	POST INSTALL.
147+88		●	D-1 (10.0'x7.0') ↑ Honokaa 32 Pepeekeo → Onomea Bay 2		1					70	2
148+72		●	R3-8R		1	1					
148+72	●		R7-1		1	1					
149+38		●	W11-2		1	1					
149+54	●		R7-1		1	1					
150+24		●	W2-1		1	1					
151+28		●	R8-3		1	1					
152+80		●	R3-8R		1	1					
153+18		●	R8-3		1	1					
153+44		●	W11-2/W16-7P		1	1					
153+50	●		W11-2/W16-7P		1	1					
153+64	●		R1-1		1	1					
154+04		●	R1-1		1	1					
154+80	●		R3-8R		1	1					
155+40	●		D-3 (9.0'x1.5') ← SCENIC ROUTE		1					13.5	2
157+30	●		R3-8R		1	1					
158+46	●		W2-1		1	1					
159+48		●	W11-2		1	1					
159+62	●		W11-2		1	1					
160+80	●		D-2 (9.5'x3.5') SCENIC ROUTE ← 4 MILES LONG		1					33.35	2
161+62		●	R3-8b		1	1					
162+12	●		D-4 (9.0'x7.0') ↑ Hilo 8 Pepeekeo ← Onomea Bay 2		1					63	2
164+88	●		R2-1 (45) (36"x48")		1			1			
166+68		●	R3-8b		1	1					
167+30	●		R1-2		1	1					
167+52		●	R1-2		1	1					
167+62		●	R1-1		1	1					
167+96		●	W11-2/W16-7P		1	1					
167+96		●	R1-1		1	1					
168+04	●		W11-2/RM-4		1	1					

STATION	INBOUND	OUTBOUND	TYPE	SIGN TO REMAIN	REMOVE	INSTALL LESS THAN 10 SQ. FT.		INSTALL GREATER THAN 10 SQ. FT.		DESTINATION SIGN	
						W/POST	WO/POST	W/POST	WO/POST	SIZE (SQ. FT.)	POST INSTALL.
168+08		●	R1-2		1	1					
168+22	●		R1-2		1	1					
169+10	●		R3-8b		1	1					
169+52		●	R2-1 (45) (36"x48")		1				1		
174+26	●		R3-8b		1	1					
176+22	●		W2-1		1	1					
177+72	●		W11-2		1	1					
183+96		●	W2-1		1	1					
185+20		●	("BUMPS AHEAD") (48"x48")		1				2		
187+70	●		R1-1		1	1					
188+50		●	R1-1		1	1					
191+00	●		W2-1		1	1					
192+22	●		R2-1 (45) (36"x48")		1				1		
192+30		●	R2-1 (55) (36"x48")		1				1		
197+62	●		R2-5b (45) (36"x48")		1				1		
1+02	●		"Adopt-a-Highway"	1							
1+04		●	"Adopt-a-Highway"	1							
9+56		●	R1-1		1	1					
29+40		●	W12-2 (16'-0")		1				1		
36+40	●		RM-4		1	1					
36+60		●	RM-4		1	1					
36+66	●		RM-4		1	1					
36+82		●	RM-4		1	1					
43+68	●		W12-2 (16'-2")		1				1		
47+88	●		W4-2R W4-2L		1	1					
50+24	●		R1-1		1	1					
51+48		●	R1-1		1	1					
51+80		●	R2-1(55) (36"x48")						1		
53+06	●		W9-2L W9-2R		1	1					

(Continued)

LEGEND FOR AS-BUILT POSTINGS	
	Squiggly line for as-built deletion
	Double line for as-built deletion
Roadway	Text for as-built posting

FED. ROAD DIST. NO.

STATE

FED. AID PROJ. NO.

FISCAL YEAR

SHEET NO.

TOTAL SHEETS

HAWAII

HAW.

NH-019-2(067)

2014

26

41

STATE OF HAWAII

DEPARTMENT OF TRANSPORTATION

HIGHWAYS DIVISION

SIGN SCHEDULE

HAWAII BELT ROAD RESURFACING

Pepeekeo to Hakalau

Federal Aid Project No. NH-019-2(067)

Scale: None

Date: March, 2014

SHEET No. 1 OF 2 SHEETS

SIGN REPLACEMENT, REMOVAL, AND INSTALLATION SCHEDULE											
STATION	INBOUND	OUTBOUND	TYPE	SIGN TO REMAIN	REMOVE	INSTALL LESS THAN 10 SQ. FT.		INSTALL GREATER THAN 10 SQ. FT.		DESTINATION SIGN	
						W/POST	WO/POST	W/POST	WO/POST	SIZE (SQ. FT.)	POST INSTALL.
55+92	●		W2-1		1	1					
59+90	●		RI-1		1	1					
74+38	●		R1-1			1					
75+22		●	RI-1		1	1					
76+96		●	W2-2R		1	1					
79+00	●		R2-1(55) (36"x48")					1			
81+52		●	RI-1		1	1					
83+32	●		R4-3		1	1					
86+46	●		W2-2R		1	1					
90+00		●	("Falling Rocks") (36"x36")		1	1					
90+88	●		RI-1/RM-4		1	1					
106+52	●		"Adopt-a-Highway"	1							
106+52		●	"Adopt-a-Highway"	1							
124+00 125+62		●	D-5 (10.0'x7.0') ↑ Honokaa 29 ← Honomu 3 Akaka Falls		1					70	2
133+40	●		RI-1		1	1					
133+80		●	Hilo 11→ ← Honokaa 29 Waimea 45							70	2
136+00	●		RM-4		1	1					
136+00		●	RM-4		1	1					
138+62	●		RM-4		1	1					
138+62		●	RM-4		1	1					
138+90	●		("Falling Rocks") (36"x36")		1	1					
139+92	●		("Heritage Route") (18"x36")		1	1					
140+84	●		D-6 (10.0'x7.0') ↑ Hilo 29 Honomu → Akaka Falls 3		1					70	2
141+00		●	("Unlawful to Litter")		1	1					
154+68	●		RI-1		1	1					
155+44	●		("Honomu Solid Waste")		1	1					
164+38		●	W2-2L		1	1					
169+86		●	F.A.P. SDR 3(2), SDR 3(10)		1	1					
170+24	●		RI-1		1	1					
170+58	●		RM-4		1	1					
170+58		●	RM-4		1	1					
170+60	●		("Kolekole Beach Park")	1							

LEGEND FOR AS-BUILT POSTINGS	
	Squiggly line for as-built deletion
100-00	Double line for as-built deletion
Roadway	Text for as-built posting

STATE OF HAWAII
DEPARTMENT OF TRANSPORTATION
HIGHWAYS DIVISION

SIGN SCHEDULE

HAWAII BELT ROAD RESURFACING
Pepeekeo to Hakalau
Federal Aid Project No. NH-019-2(067)

Scale: None Date: March, 2014

SHEET No. 2 OF 2 SHEETS