
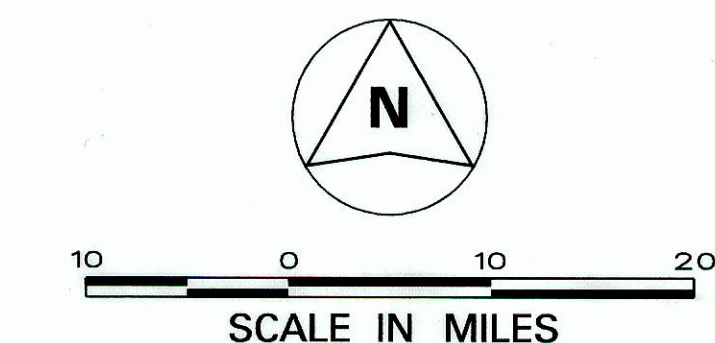
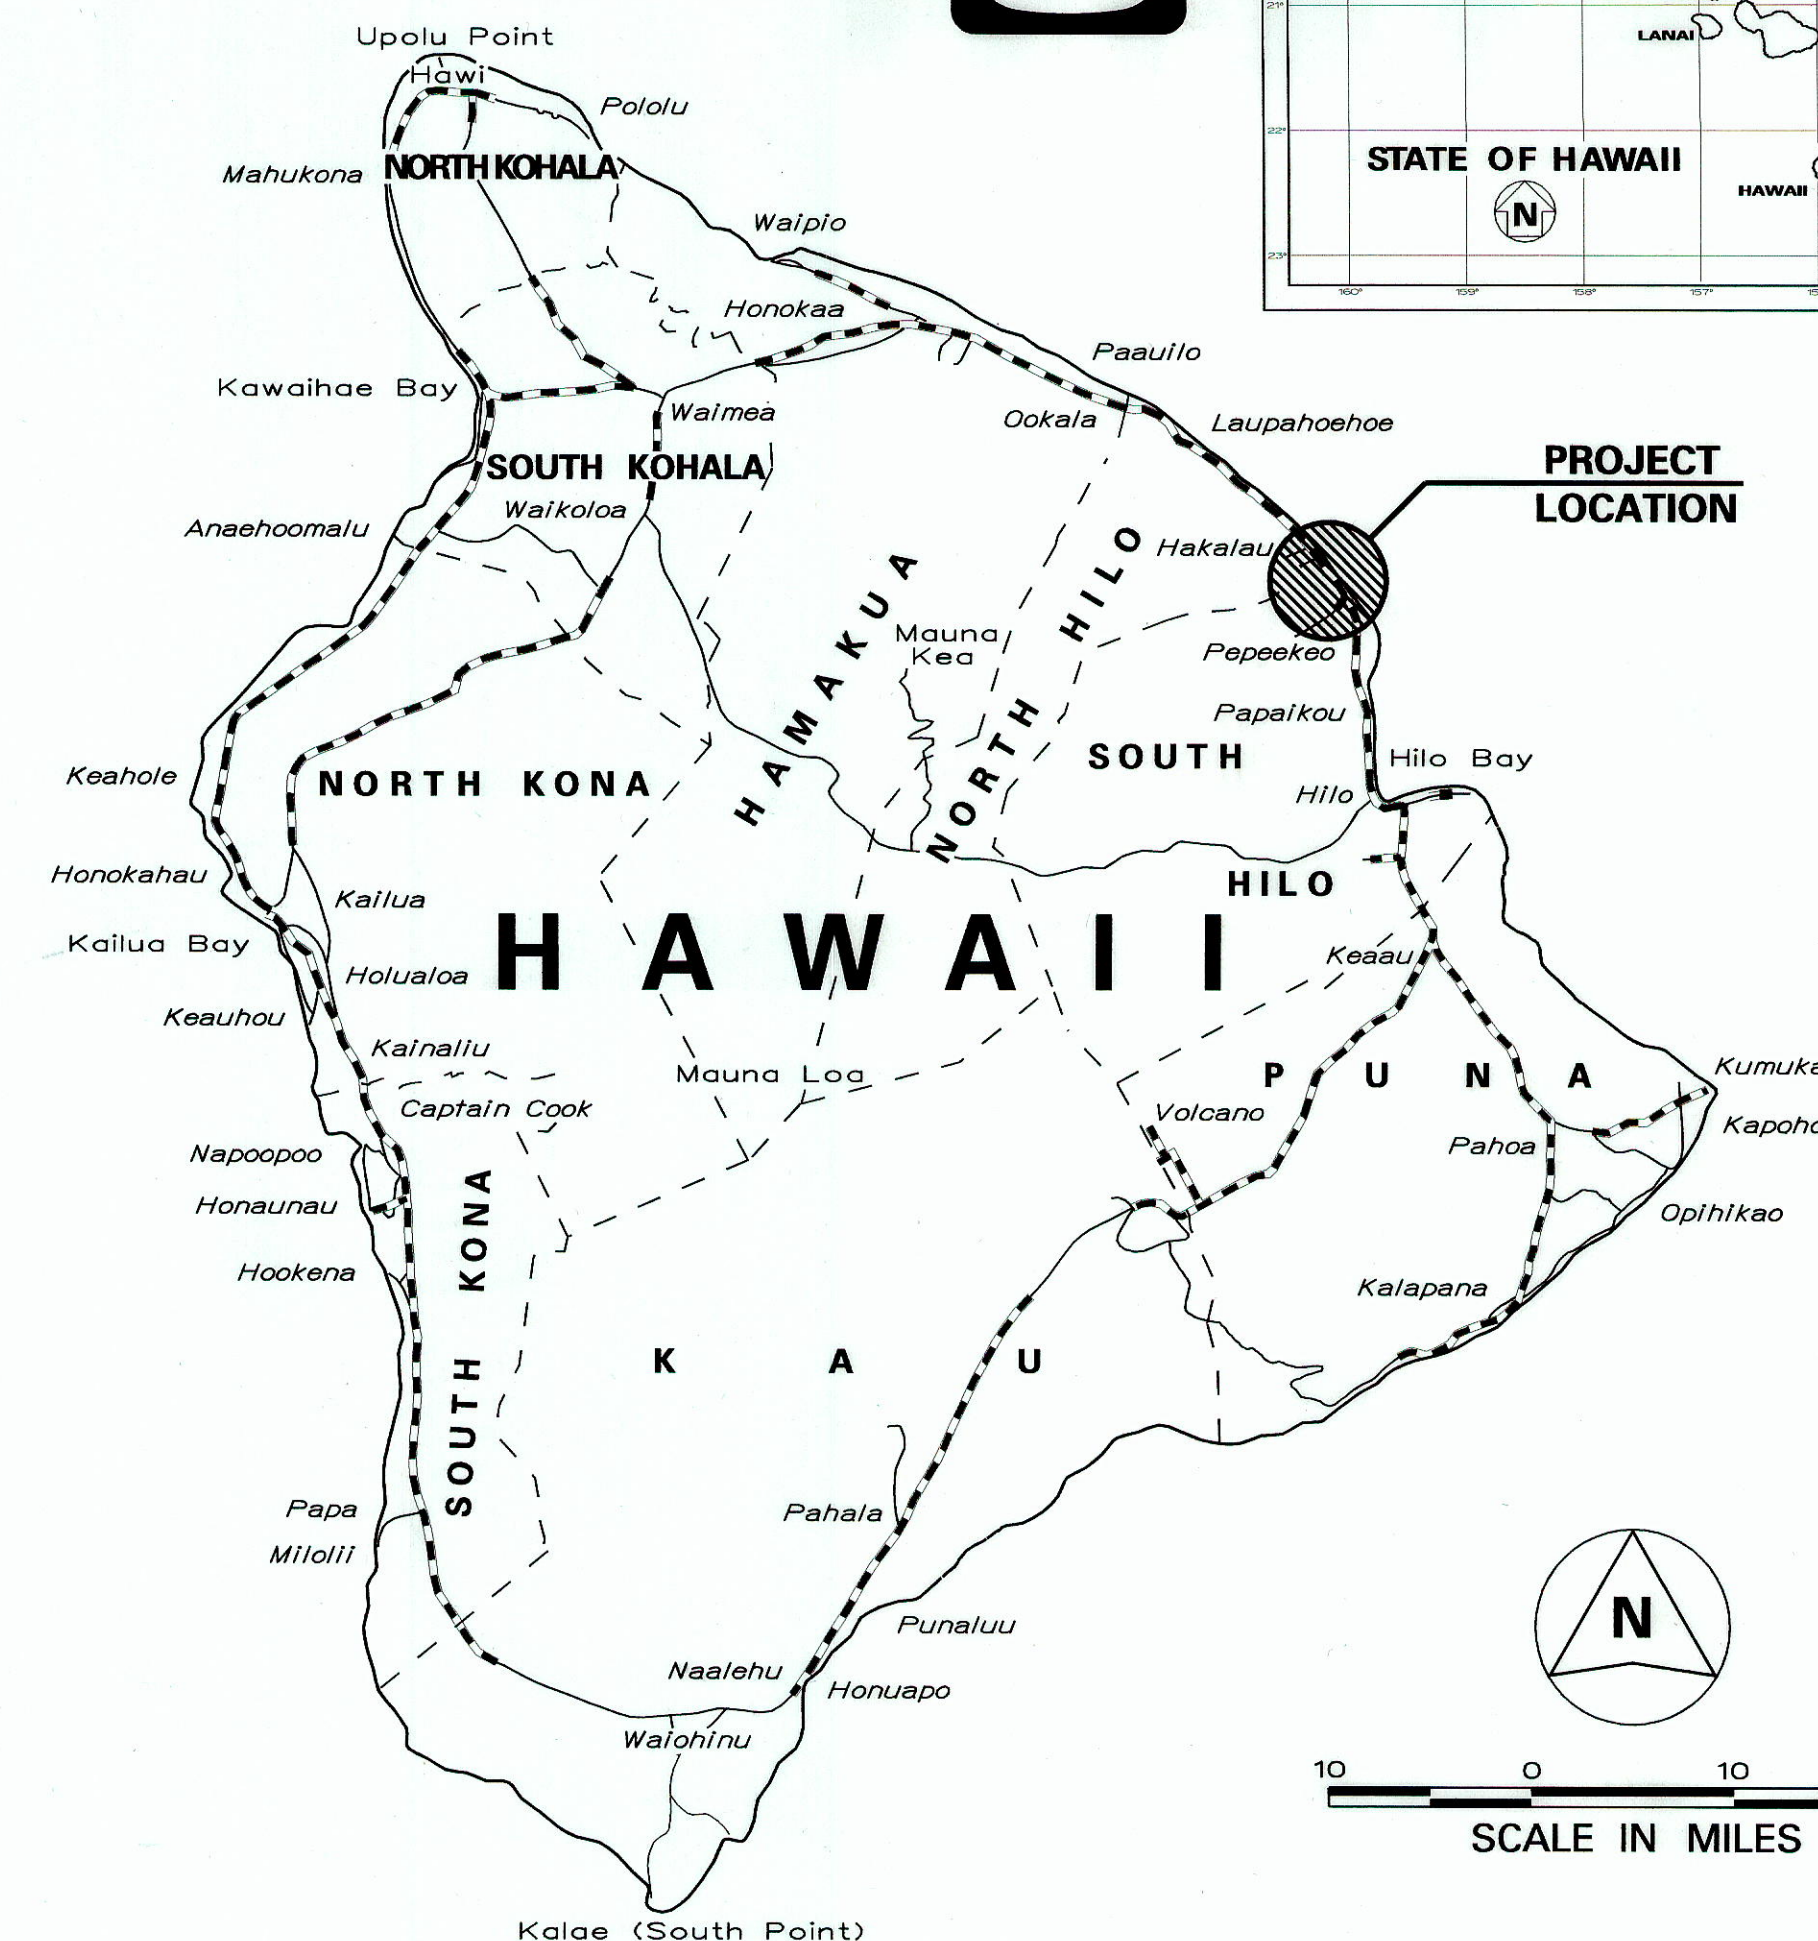


INDEX TO DRAWINGS	
SHEET NO.	DESCRIPTION
1	TITLE SHEET
2	STANDARD PLANS SUMMARY
3	GENERAL NOTES AND LEGEND
4-5	WATER POLLUTION AND EROSION CONTROL NOTES
6-8	TYPICAL SECTION AND DETAILS
9	PROBE AND GROUT DETAILS
10-22	ROADWAY PLANS
23	PAVEMENT MARKING LEGEND AND NOTES
24-25	STRIPING AND PAVEMENT MARKING SCHEDULE
26-27	SIGN SCHEDULE
28-29	GUARDRAIL SCHEDULE
30-39	GUARDRAIL DETAILS
40	MISCELLANEOUS SCHEDULE
41	HIGH SPEED UNDIVIDED HIGHWAYS WORK ZONE SIGNING PLAN, NOTES AND DETAILS

STATE OF HAWAII
DEPARTMENT OF TRANSPORTATION
HIGHWAYS DIVISION
HONOLULU, HAWAII
"AS-BUILT"
PLANS FOR
HAWAII BELT ROAD RESURFACING
PEPE'EKEO TO HAKALAU
FEDERAL AID PROJECT NO. NH-019-2(067)
DISTRICT OF SOUTH HILO
ISLAND OF HAWAII

FED. ROAD DIST. NO.	STATE	FED. AID PROJ. NO.	FISCAL YEAR	SHEET NO.	TOTAL SHEETS
HAWAII	HAW.	NH-019-2(067)	2014	1	41

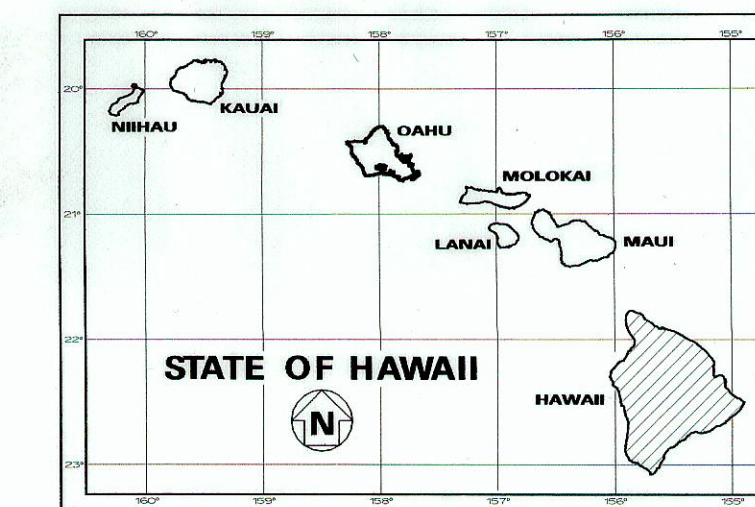


----- FEDERAL AID PROJECTS PREVIOUSLY CONSTRUCTED OR UNDER CONSTRUCTION

MILE POST 10.00 TO MILE POST 15.55

DESIGN DESIGNATION

ADT (2012).....10,200
ADT (2022).....12,000
DHV1,020
D55/45
T4.0 %
V60 M.P.H.

HAWAII DISTRICT DESIGNED BY
HWY-HE MANAGED BY
933-8866 PHONE
March, 2014 DATE

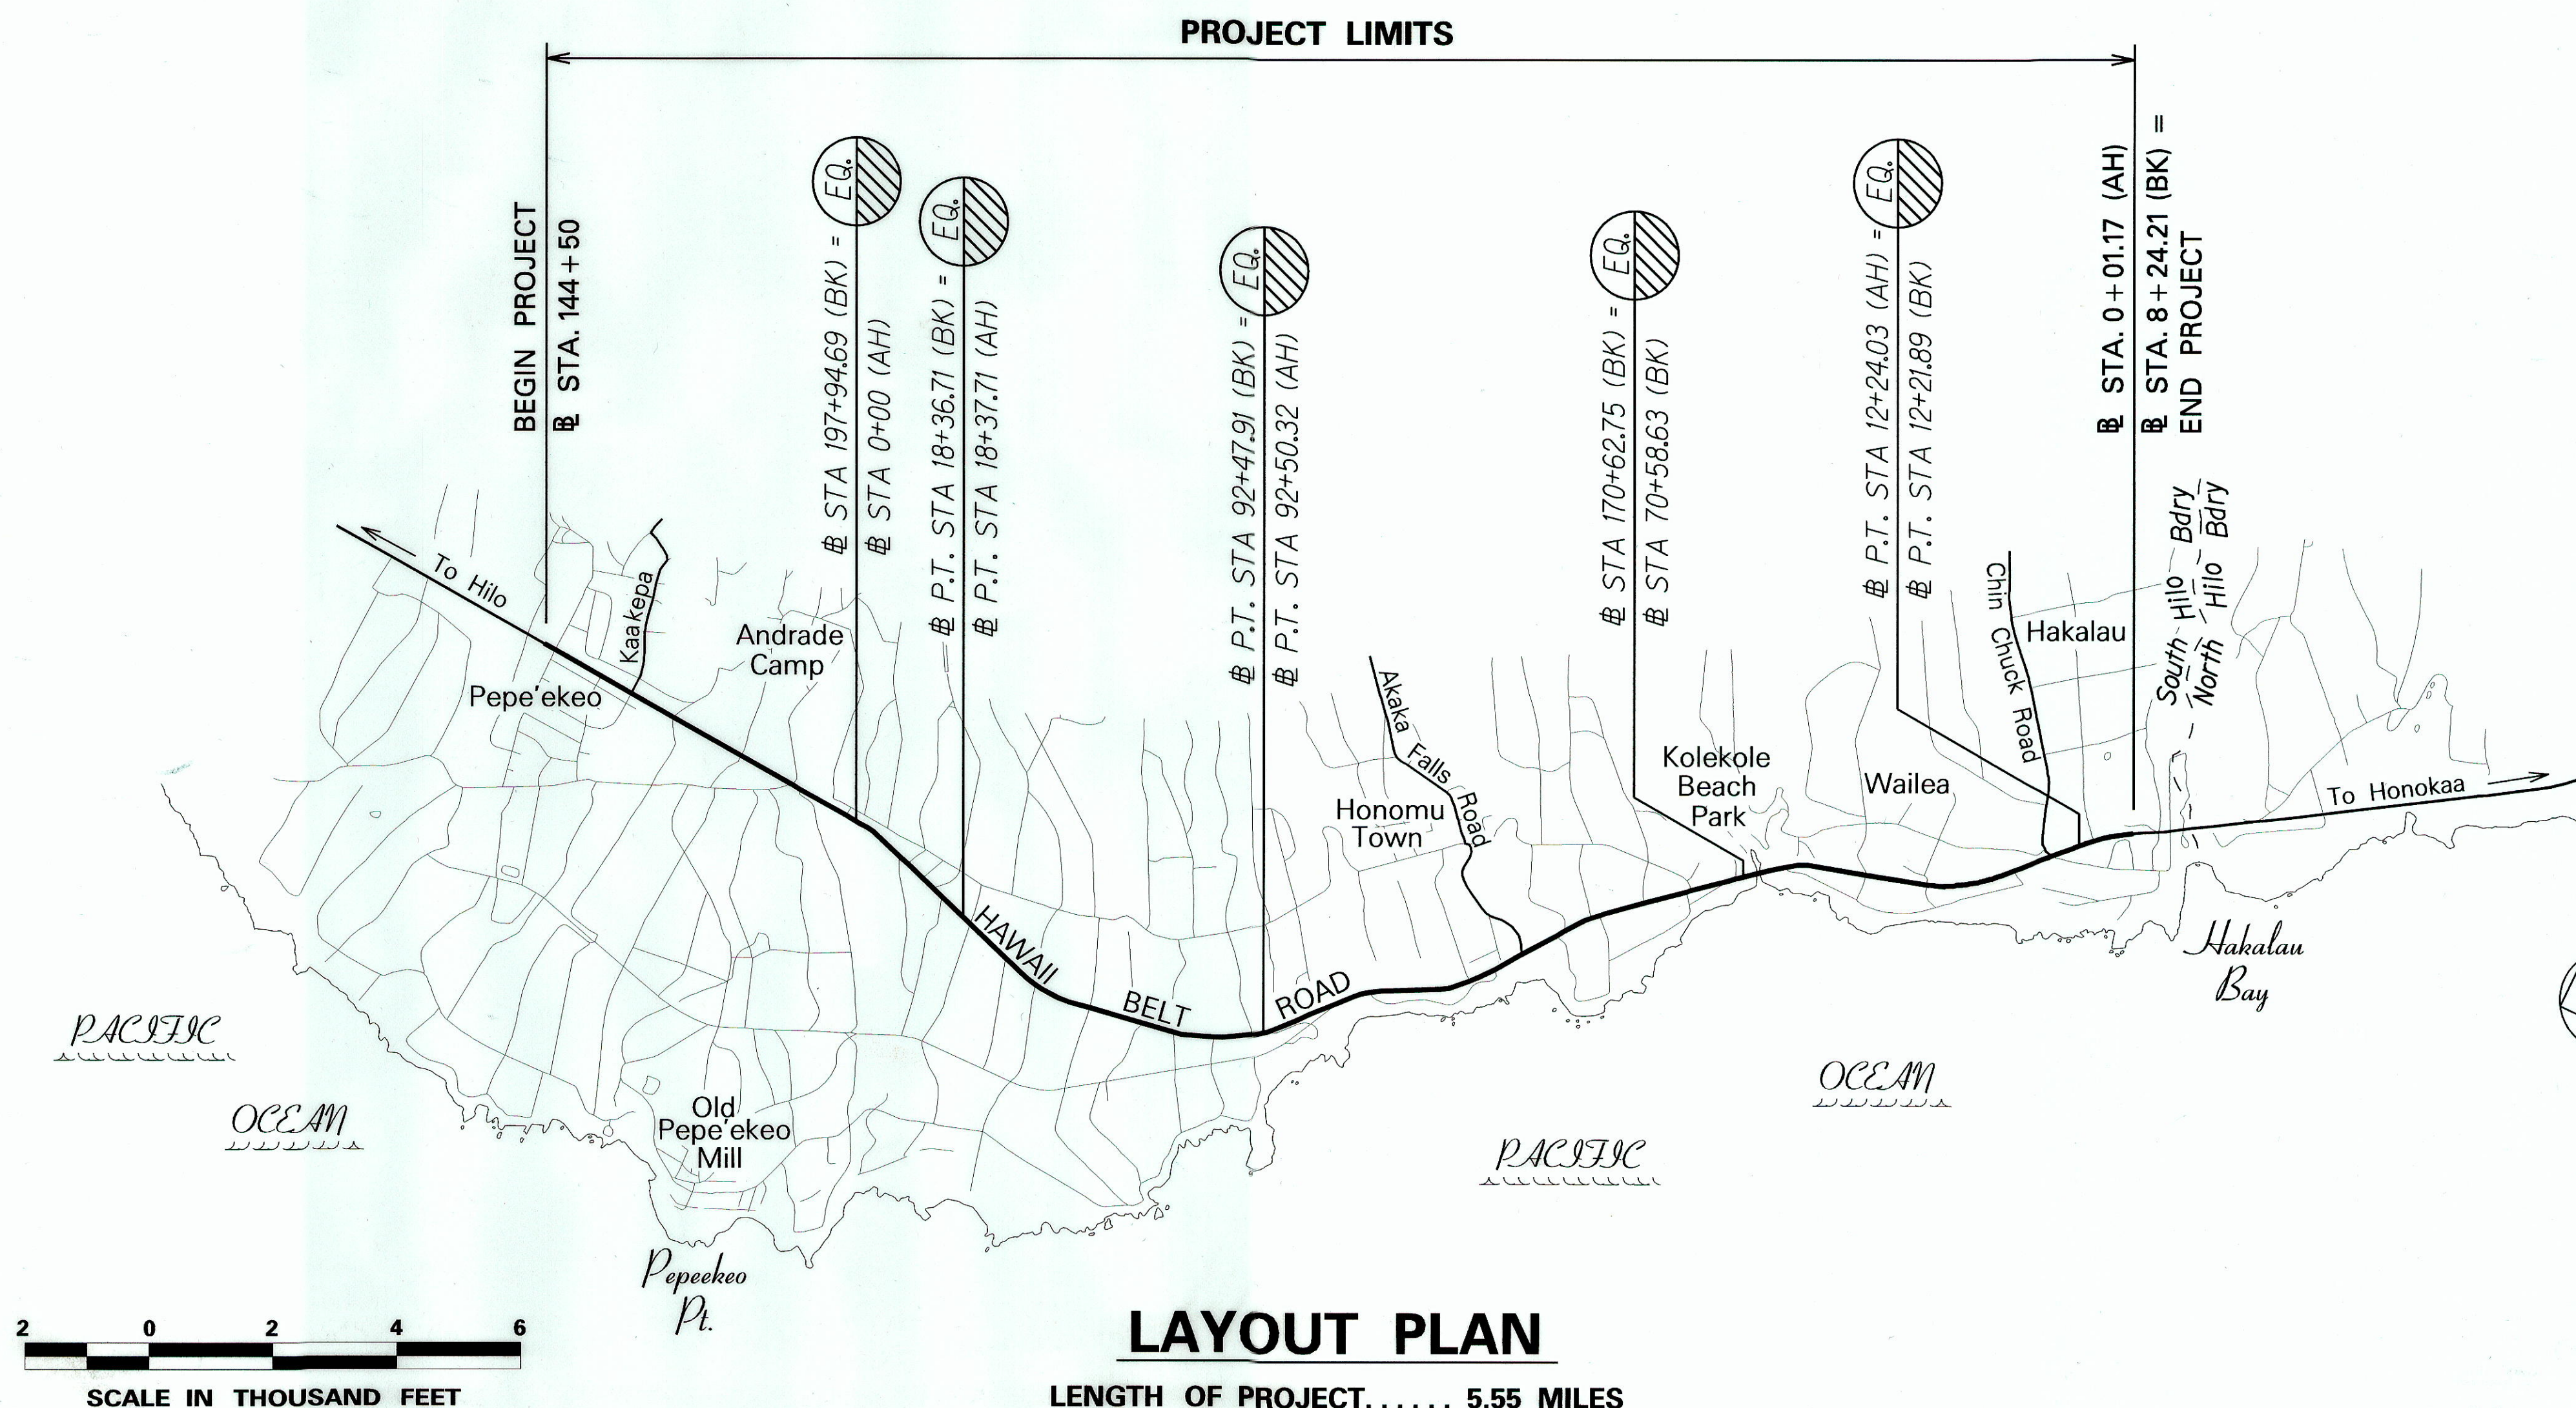

LAYOUT PLAN
LENGTH OF PROJECT..... 5.55 MILES

CHANGES MADE DURING CONSTRUCTION HAVE BEEN INCORPORATED ON THESE PLANS EXCEPT CHANGES IN THE ORIGINAL THEORETICAL QUANTITIES. FOR ACTUAL QUANTITIES, REFER TO PROJECT LEDGER AND/OR COMPUTATION BOOK.
RESIDENT ENGINEER
DATE 1/19/18

DEPARTMENT OF TRANSPORTATION
STATE OF HAWAII
APPROVED:
for DIR. OF TRANSPORTATION
DATE 4/09/14