




FED. ROAD DIST. NO.	STATE	PROJ. NO.	FISCAL YEAR	SHEET NO.	TOTAL SHEETS
HAWAII	HAW.	19L-01-78	1978	3	6

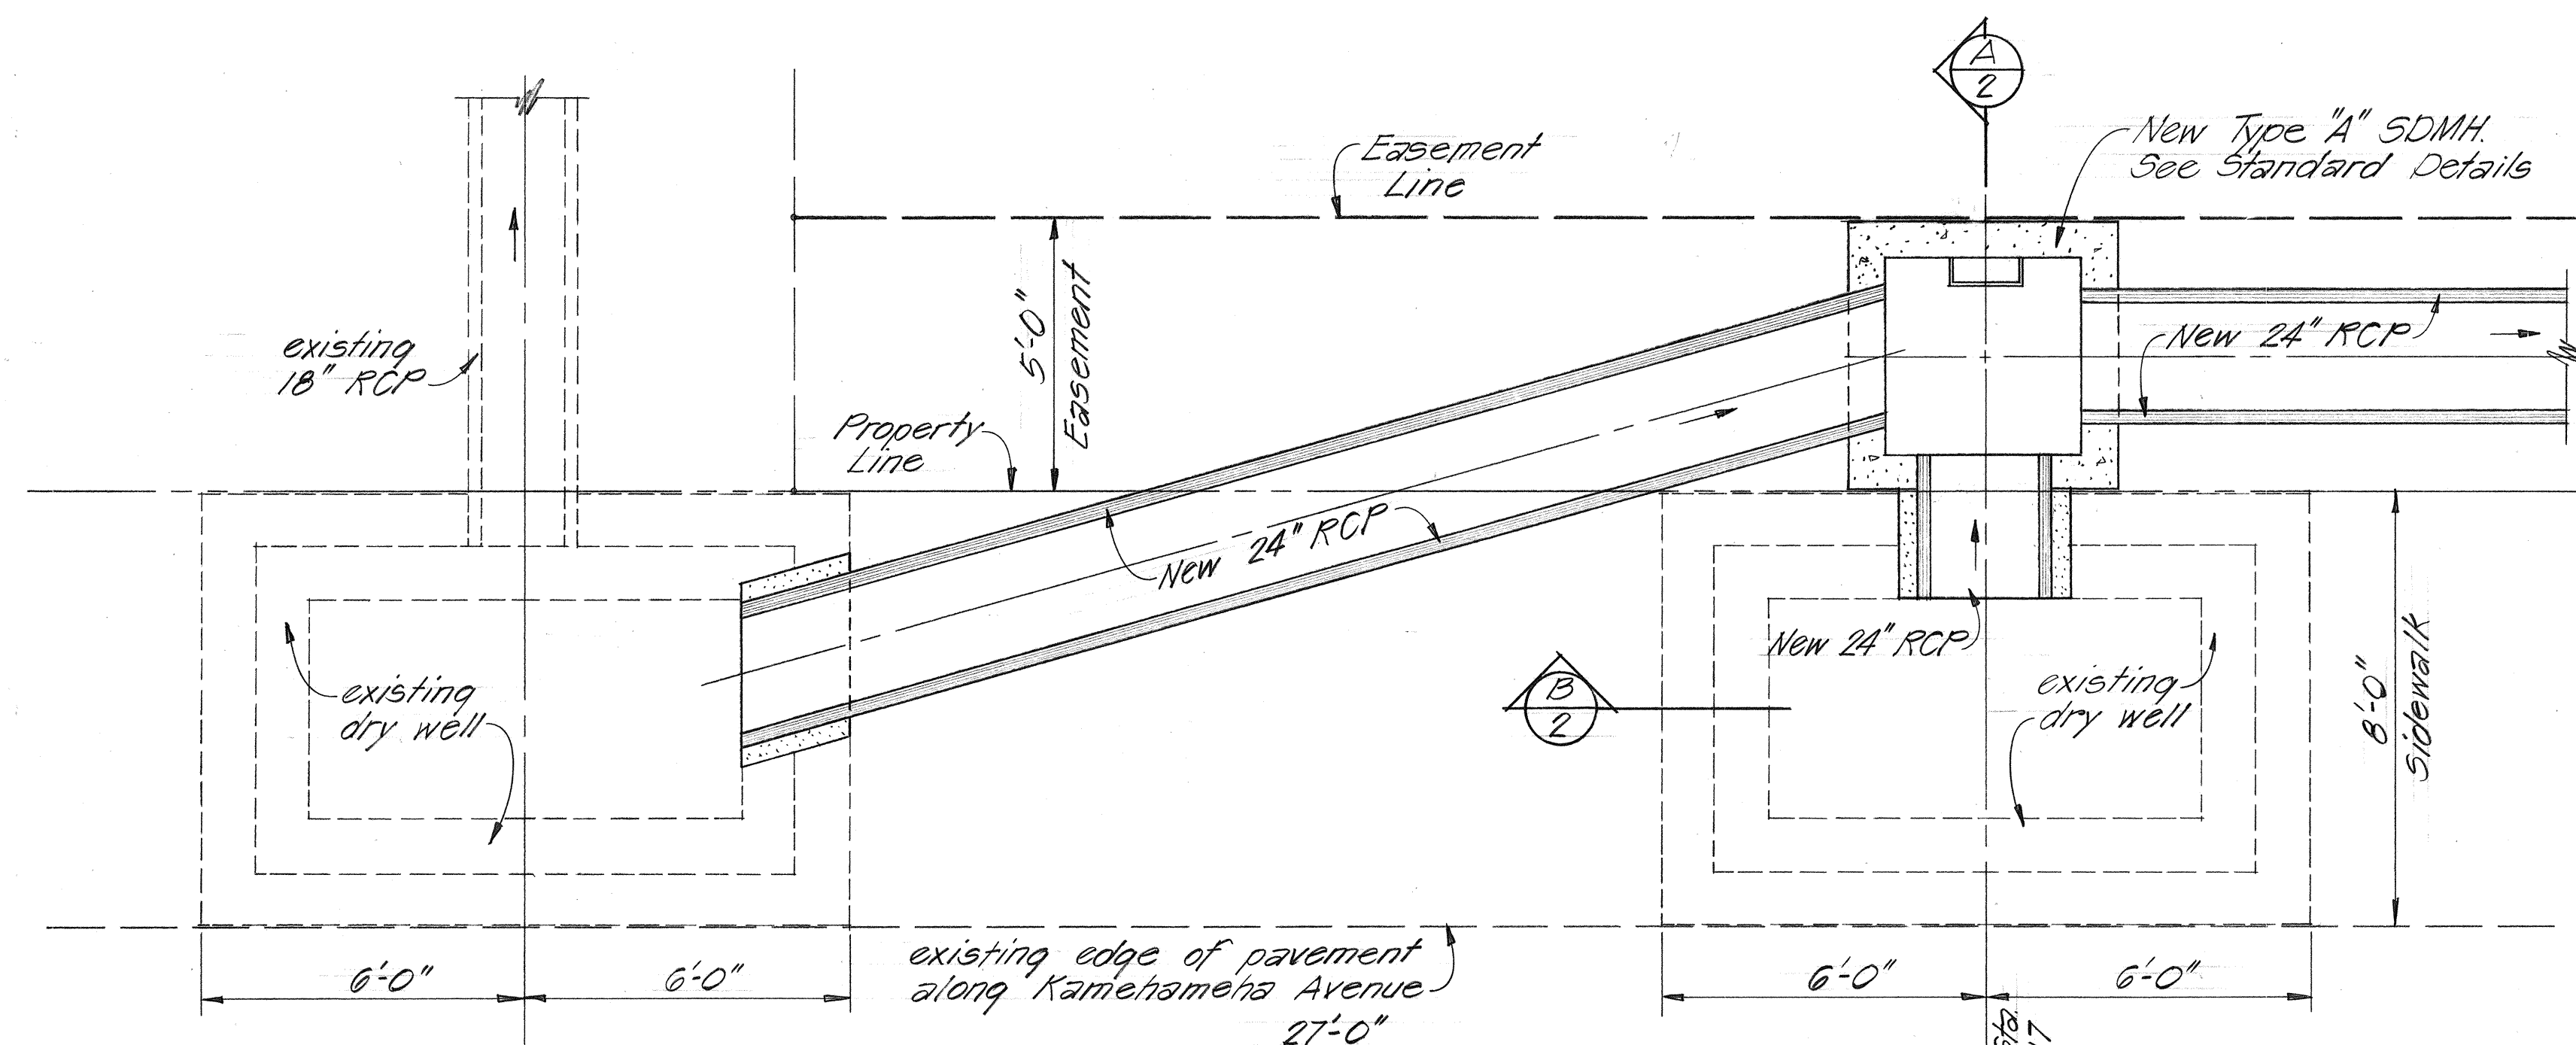

PLAN - SDMH AND RCP CONNECTIONS
Scale: $\frac{3}{8}$ " = 1'-0"

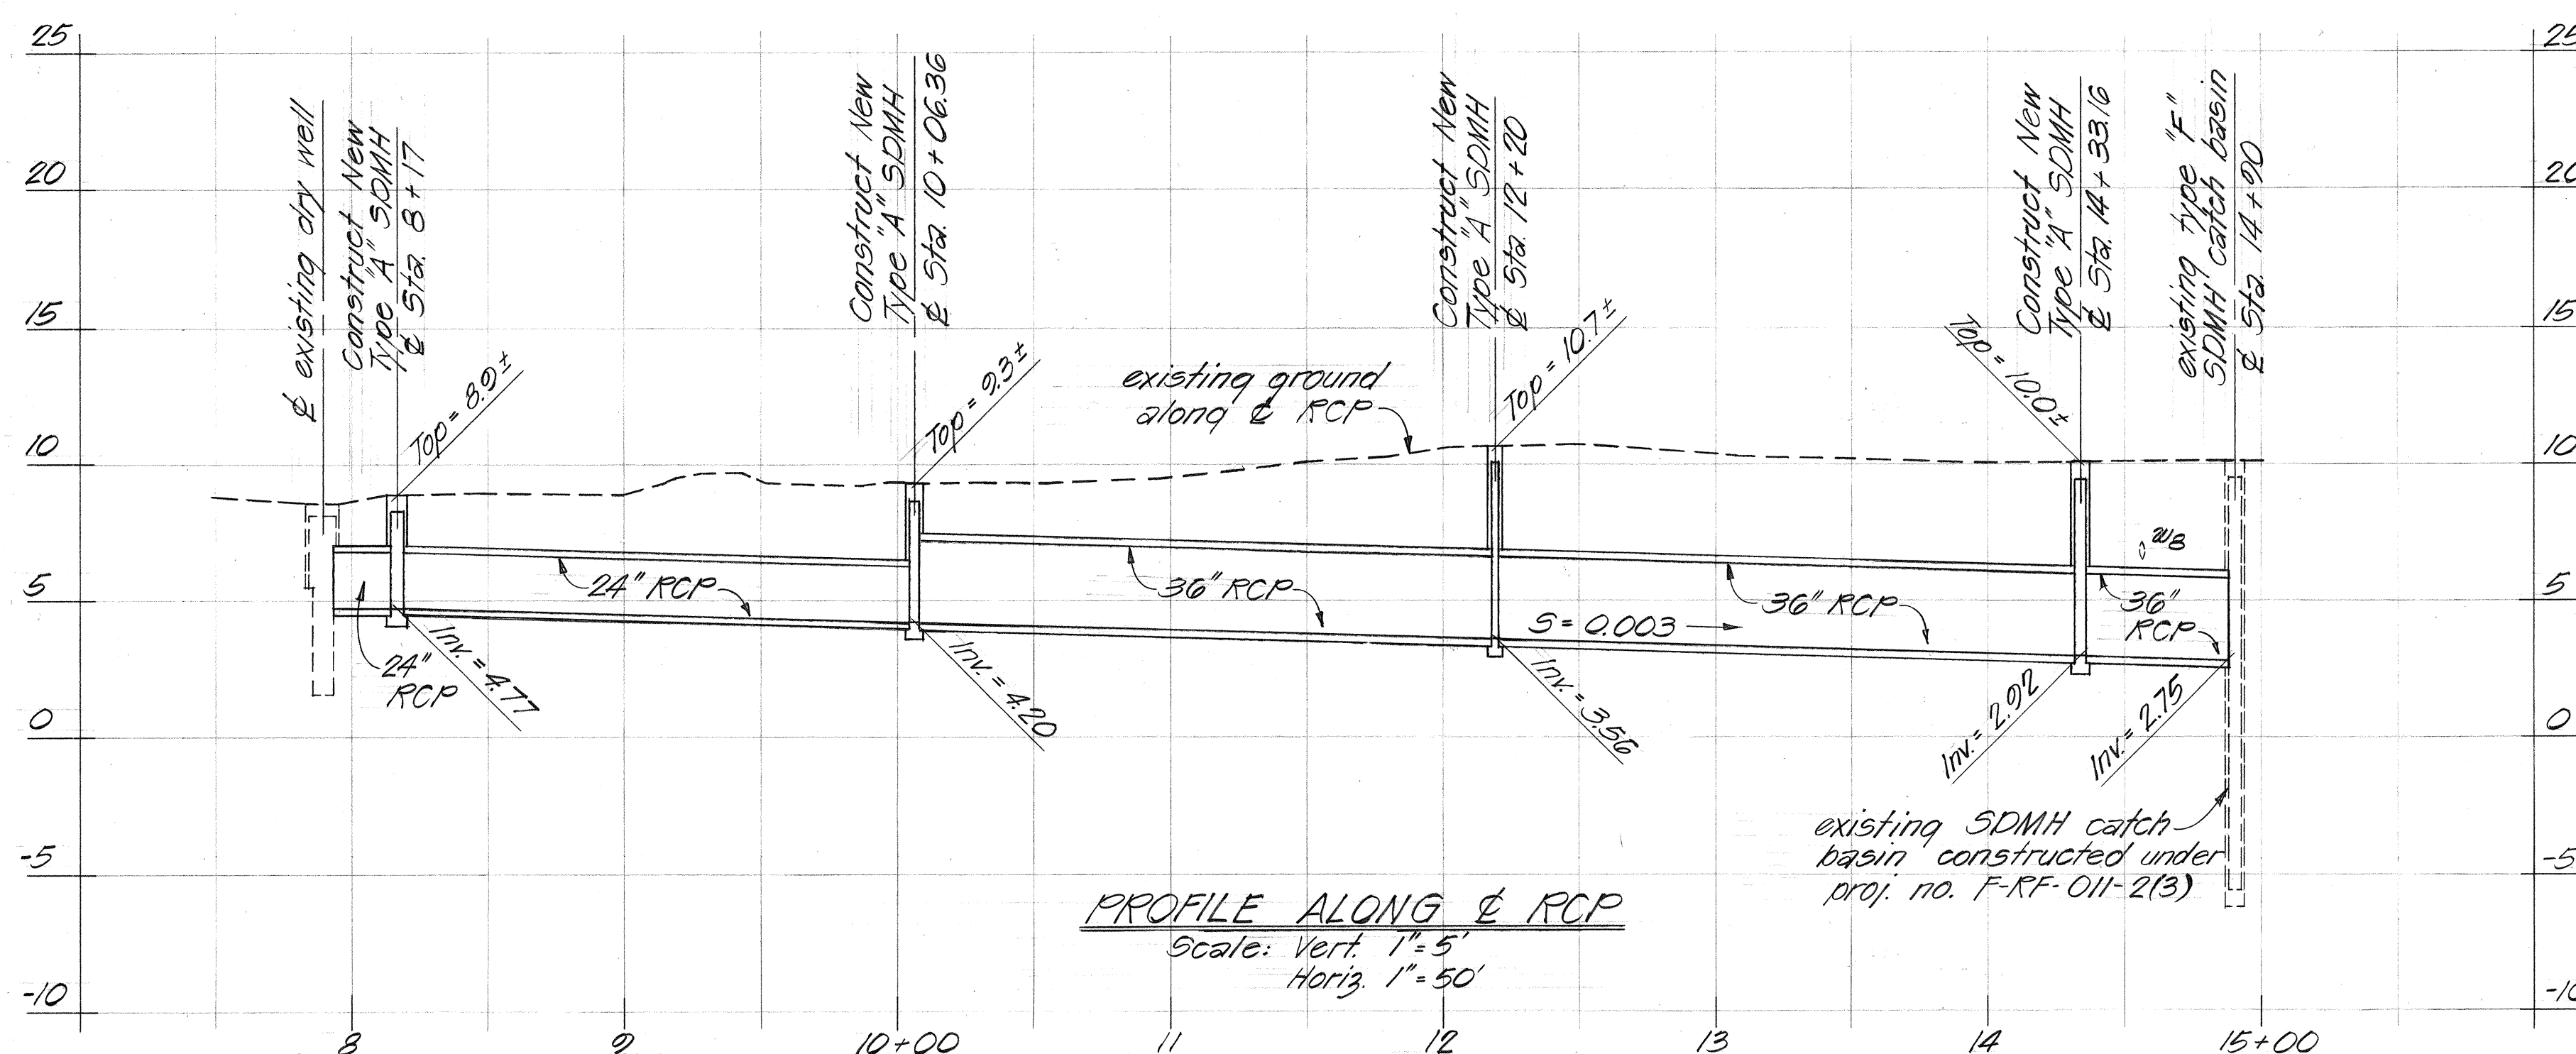


PROFILE ALONG E RCP
Scale: Vert. 1" = 5'
Horiz. 1" = 50'

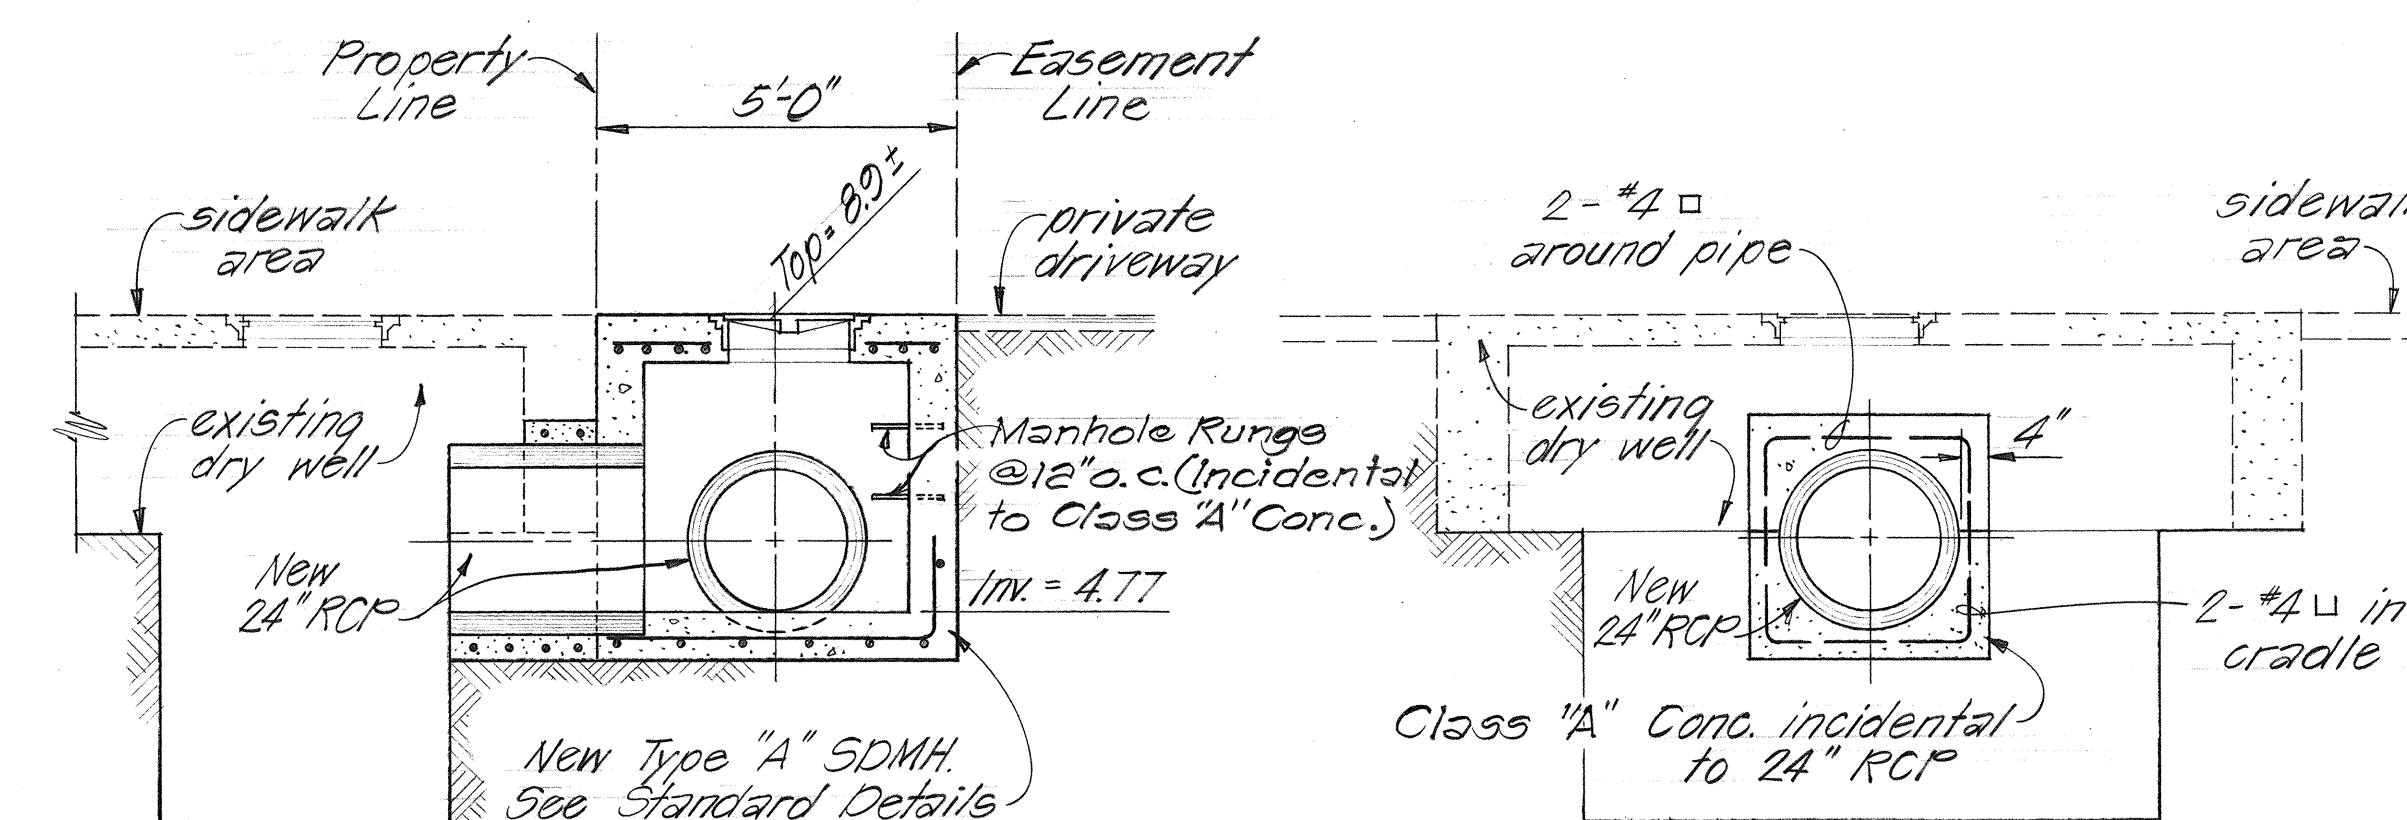


SECTION A-A
Scale: $\frac{3}{8}$ " = 1'-0"

SECTION B-B
Scale: $\frac{3}{8}$ " = 1'-0"

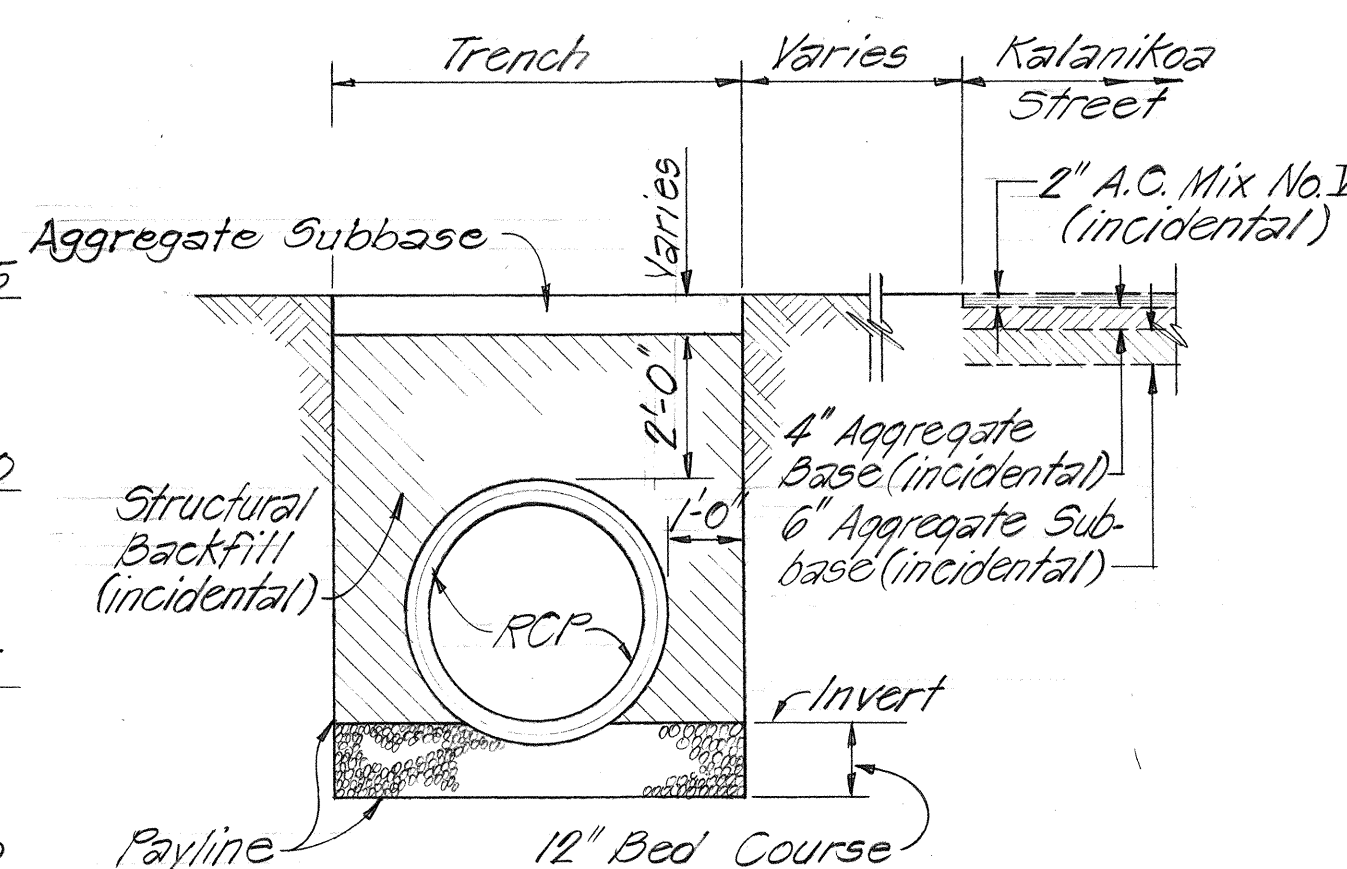

TYPICAL TRENCH SECTION C-C
Scale: $\frac{3}{8}$ " = 1'-0"

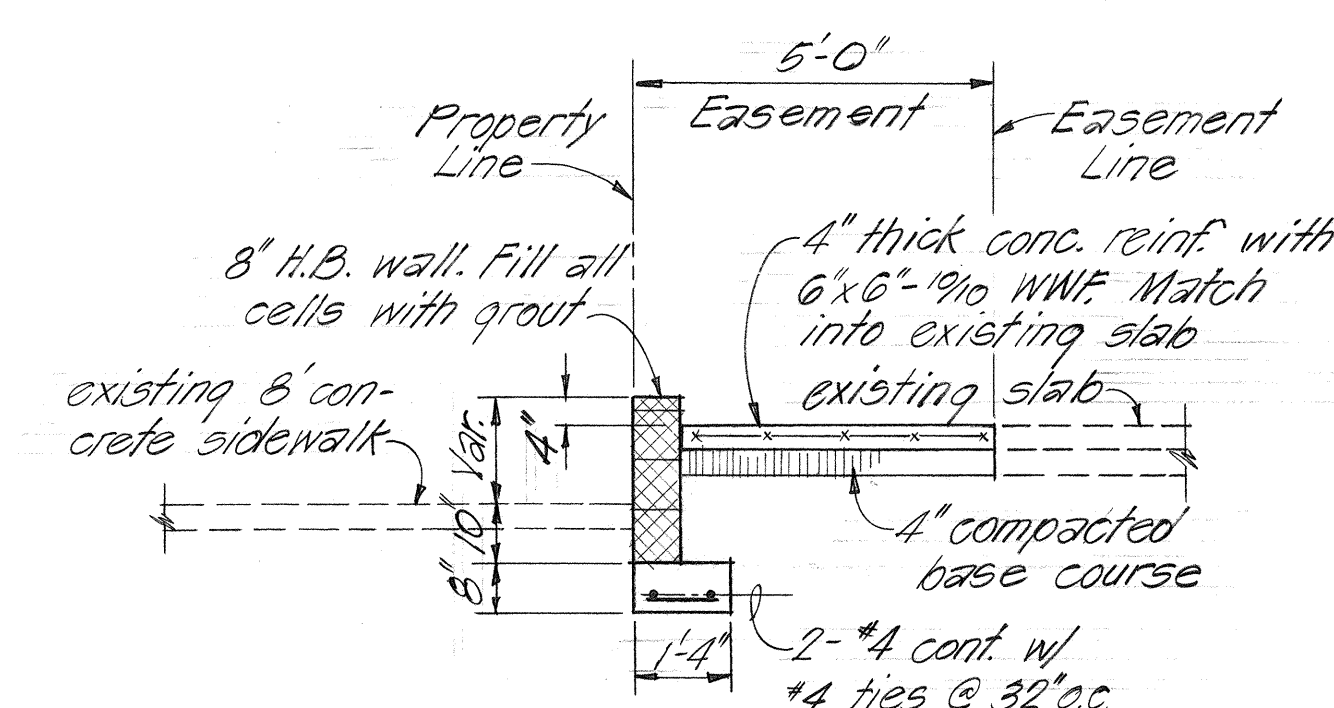

DETAIL D-D
Scale: $\frac{3}{8}$ " = 1'-0"

STATE OF HAWAII
DEPARTMENT OF TRANSPORTATION
HIGHWAYS DIVISION
PLAN, PROFILE, AND DETAILS OF
SDMH & 24" & 36" RCP
KAMEHAMEHA AVENUE
DRAINAGE IMPROVEMENTS
PROJECT NO. 19L-01-78
Scale: As Shown Date: Aug. 1978
SHEET NO. 2 OF 2 SHEETS