
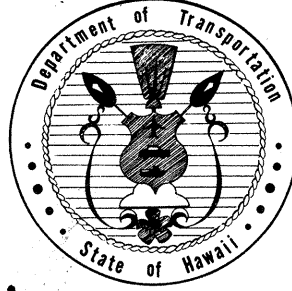


INDEX TO DRAWINGS	
SHEET NO.	DESCRIPTION
1	TITLE SHEET
2	ROADWAY PLAN & GENERAL NOTES
3	CULVERT PROFILE, SECTIONS, & DETAILS
4-6	STANDARD DETAILS

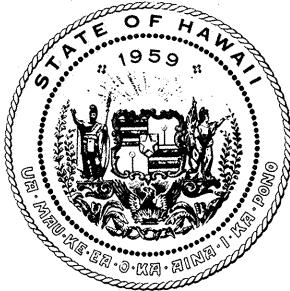



STATE OF HAWAII
DEPARTMENT OF TRANSPORTATION
LAND TRANSPORTATION FACILITIES DIVISION
HONOLULU, HAWAII

"AS BUILT"
PLANS FOR
KAMEHAMEHA AVENUE DRAINAGE IMPROVEMENTS

PROJECT NO. 19L-01-78

DISTRICT OF SOUTH HILO
ISLAND OF HAWAII

FED. ROAD DIST. NO.	STATE	PROJ. NO.	FISCAL YEAR	SHEET NO.	TOTAL SHEETS
HAWAII	HAW.	19L-01-78	1978	1	6

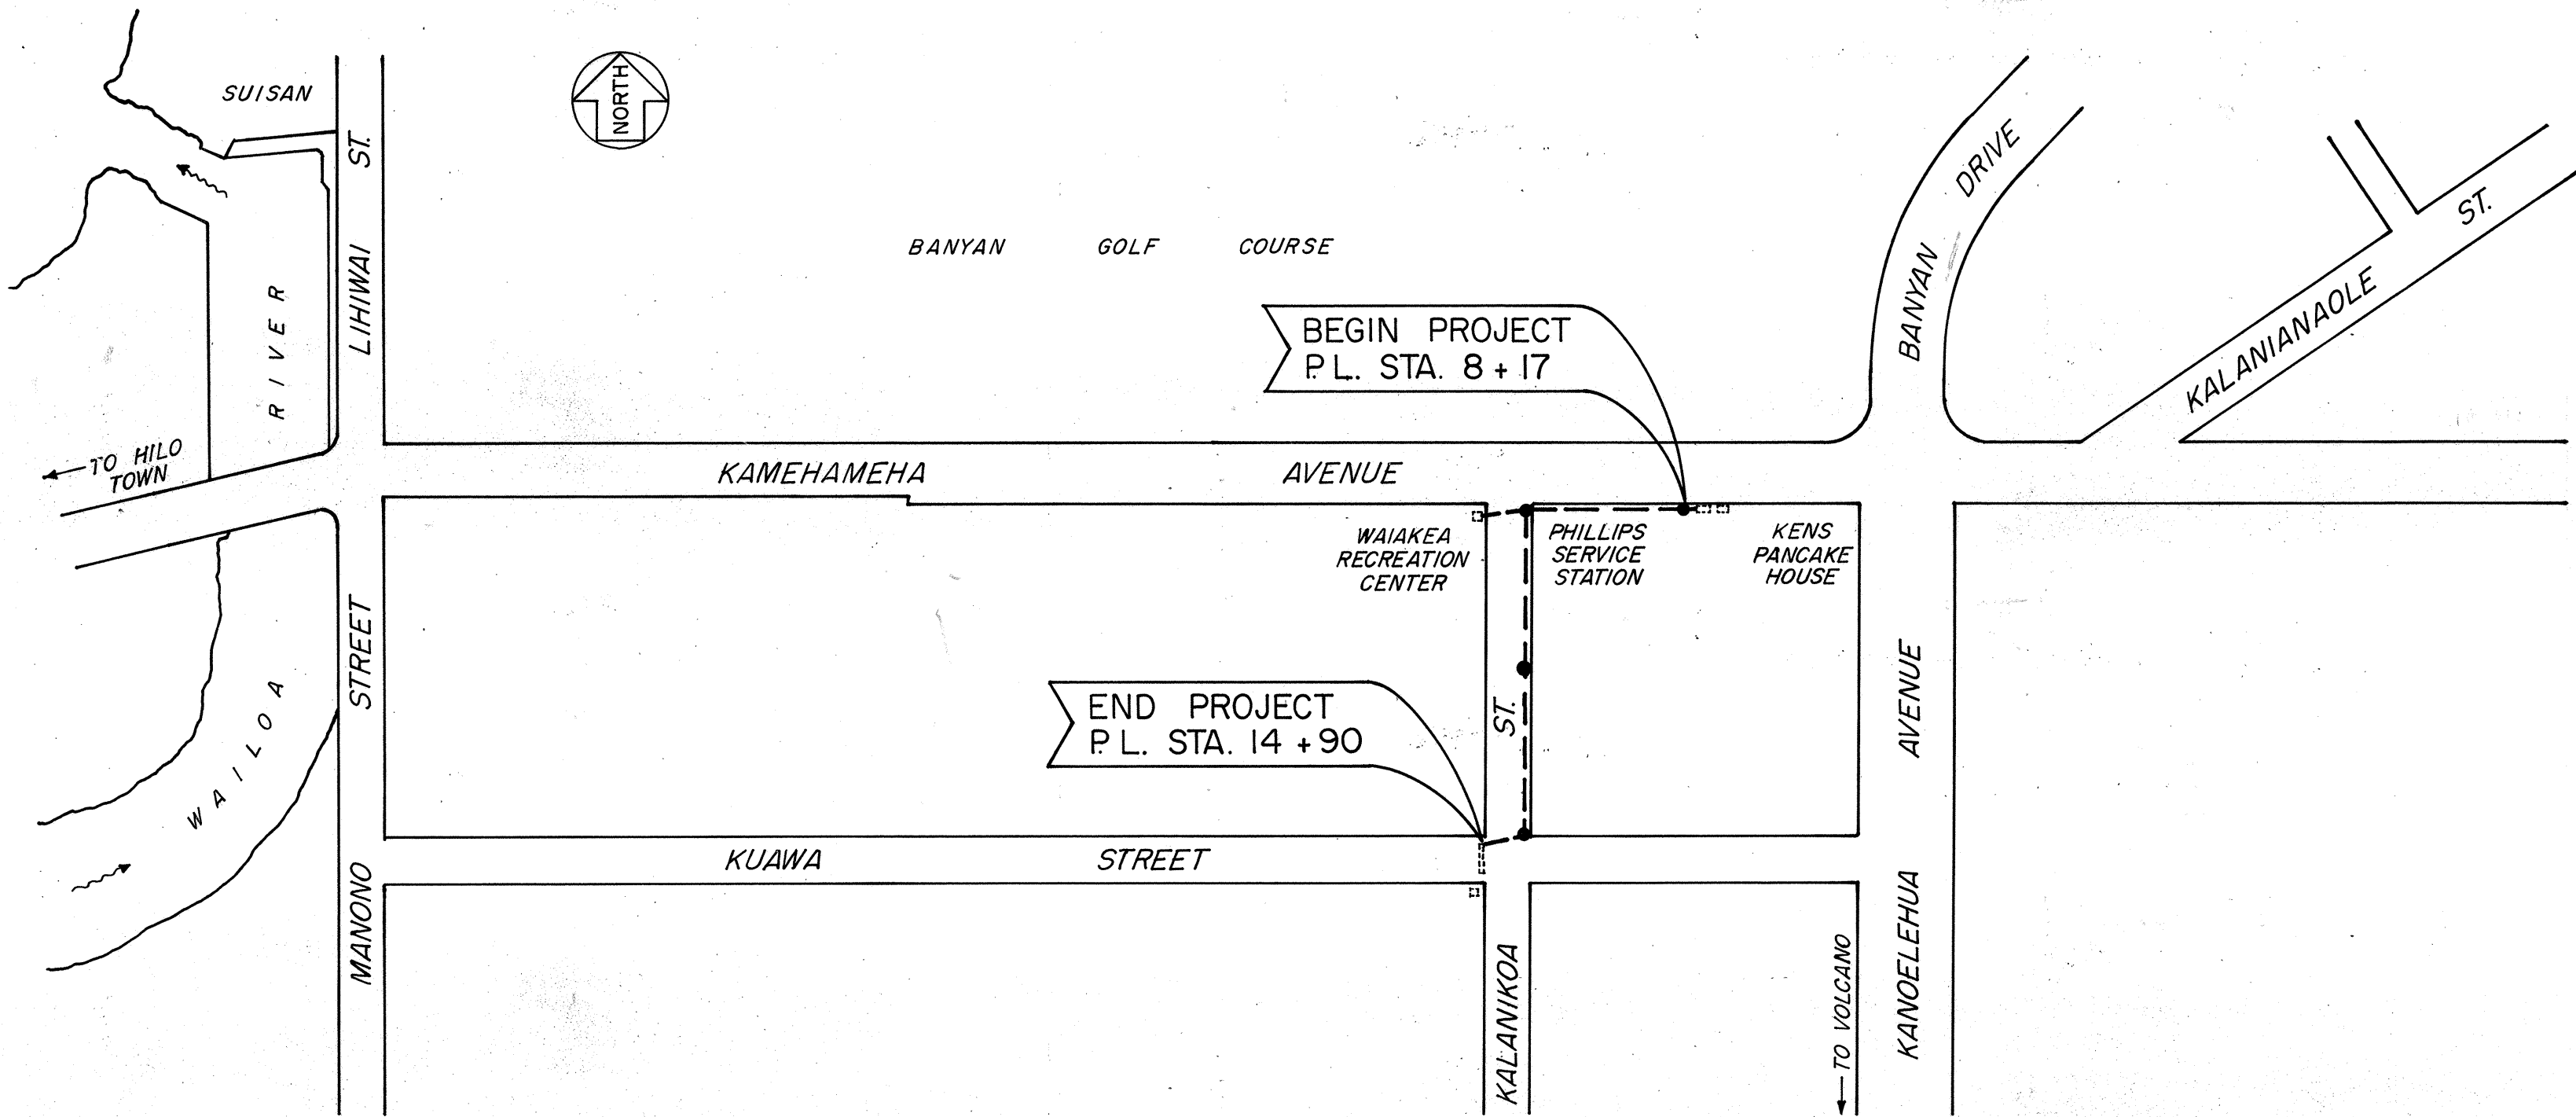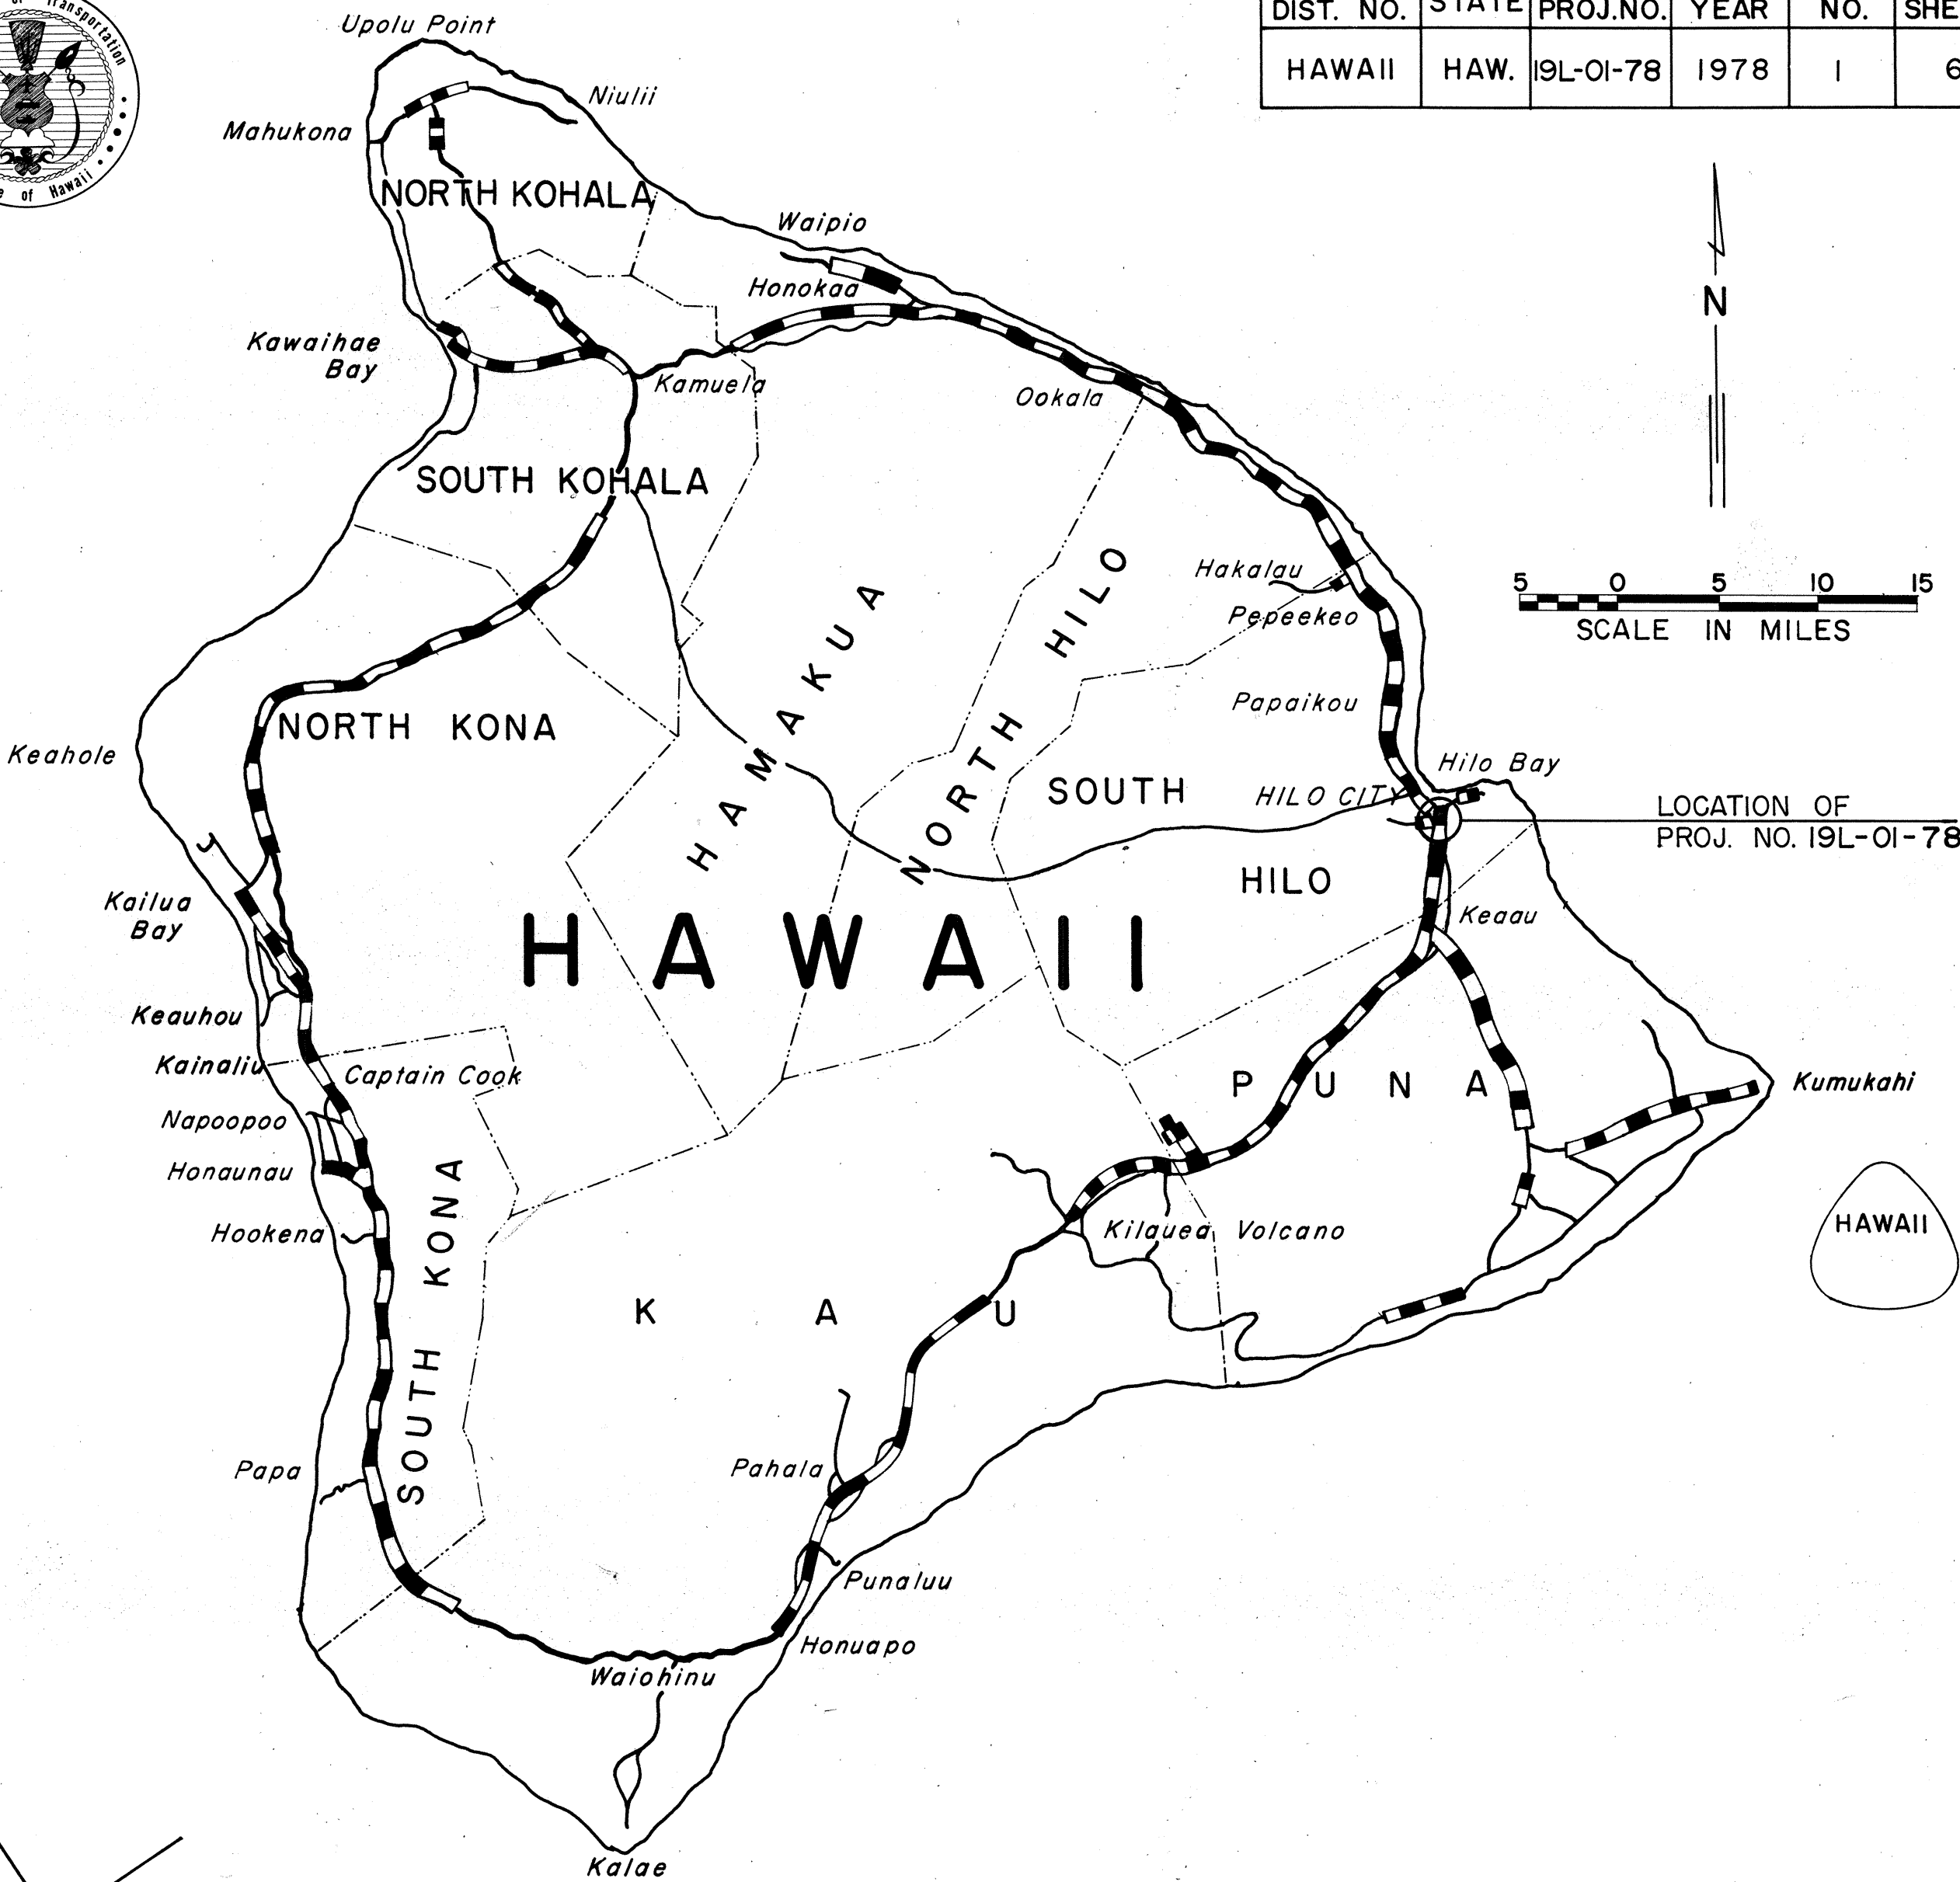

LAYOUT PLAN
SCALE IN HUNDRED FEET

Federal Aid Projects Previously Constructed Or Under Construction

NOTE:
ALL CHANGES MADE DURING CONSTRUCTION HAVE BEEN INCORPORATED ON THESE PLANS IN RED EXCEPT CHANGES IN THE ORIGINAL THEORETICAL QUANTITIES.

[Signature]
PROJECT ENGINEER
Inspector

7/17/78
DATE

DEPARTMENT OF TRANSPORTATION STATE OF HAWAII	
APPROVED:	
<i>R. Higashikawa</i>	12-22-78
for DIR. OF TRANSPORTATION	DATE

HAWAII DISTRICT DESIGNED BY D. BEVIER P.S. & E. BY 548-7537 DEC. 22, 1977 PHONE DATE