
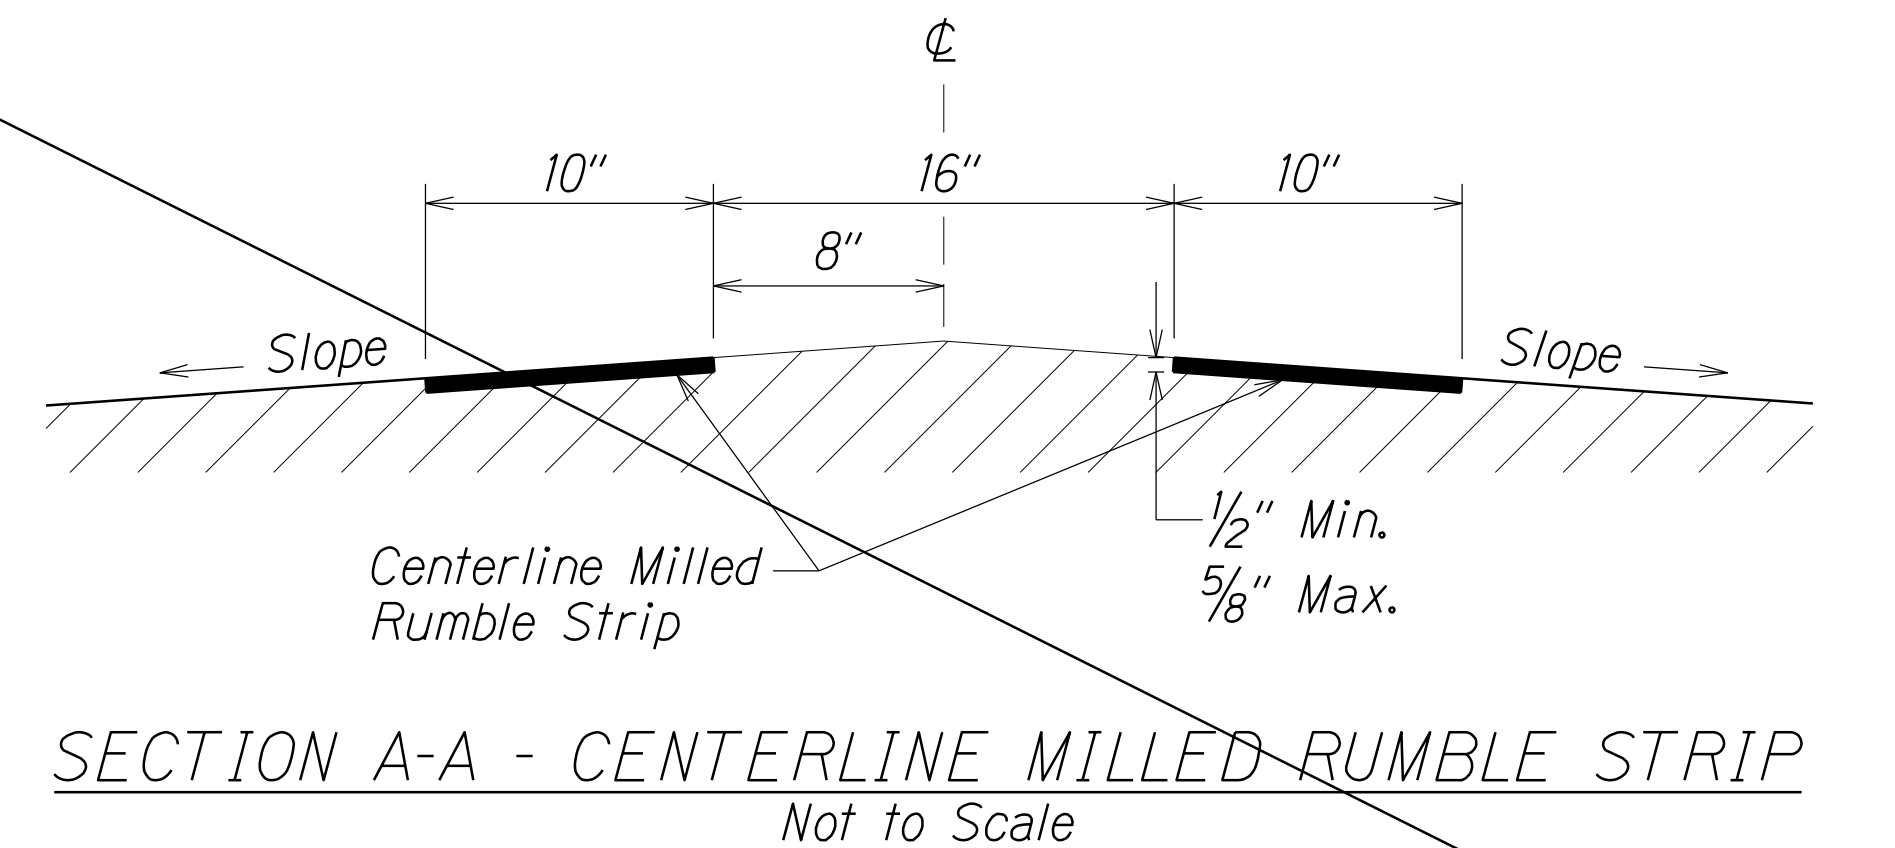
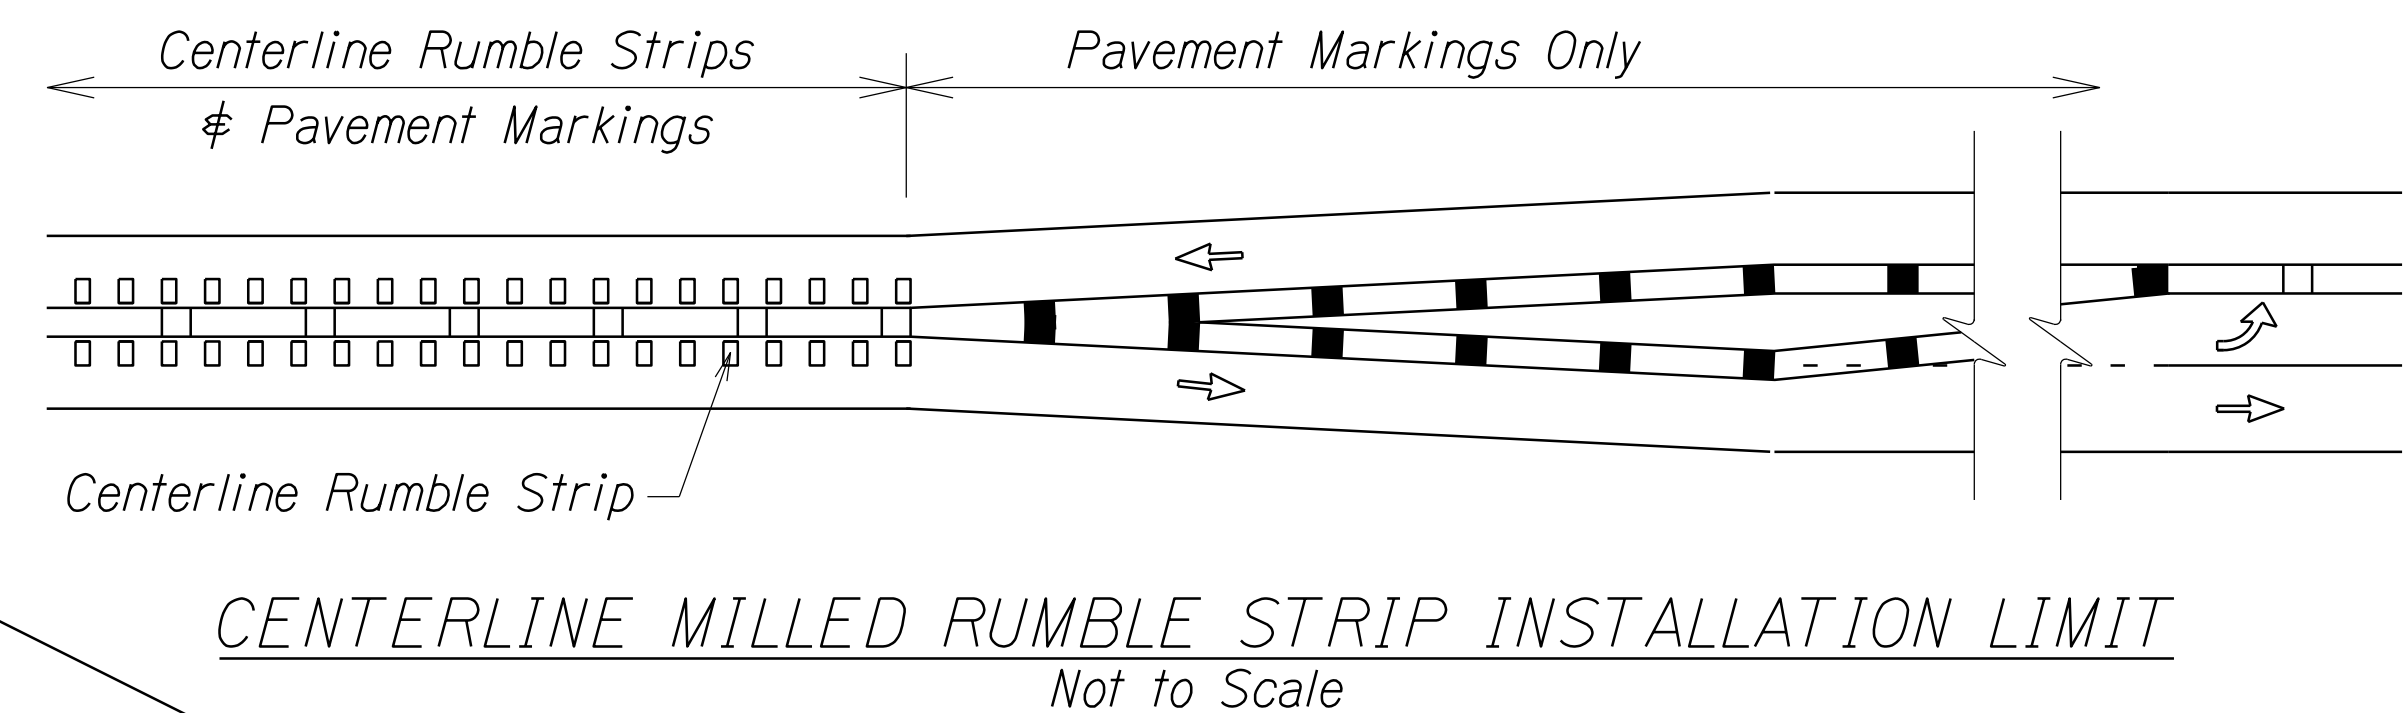
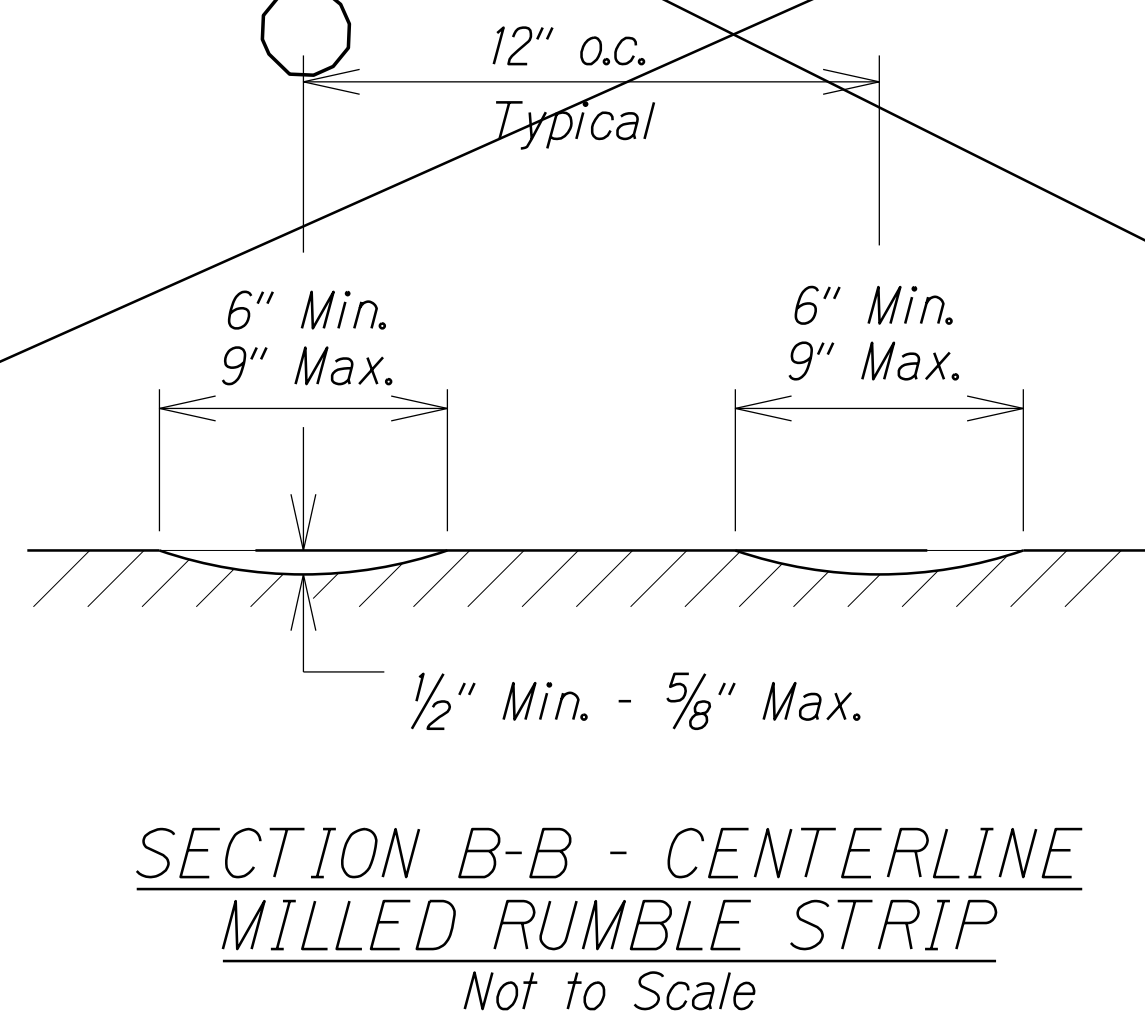
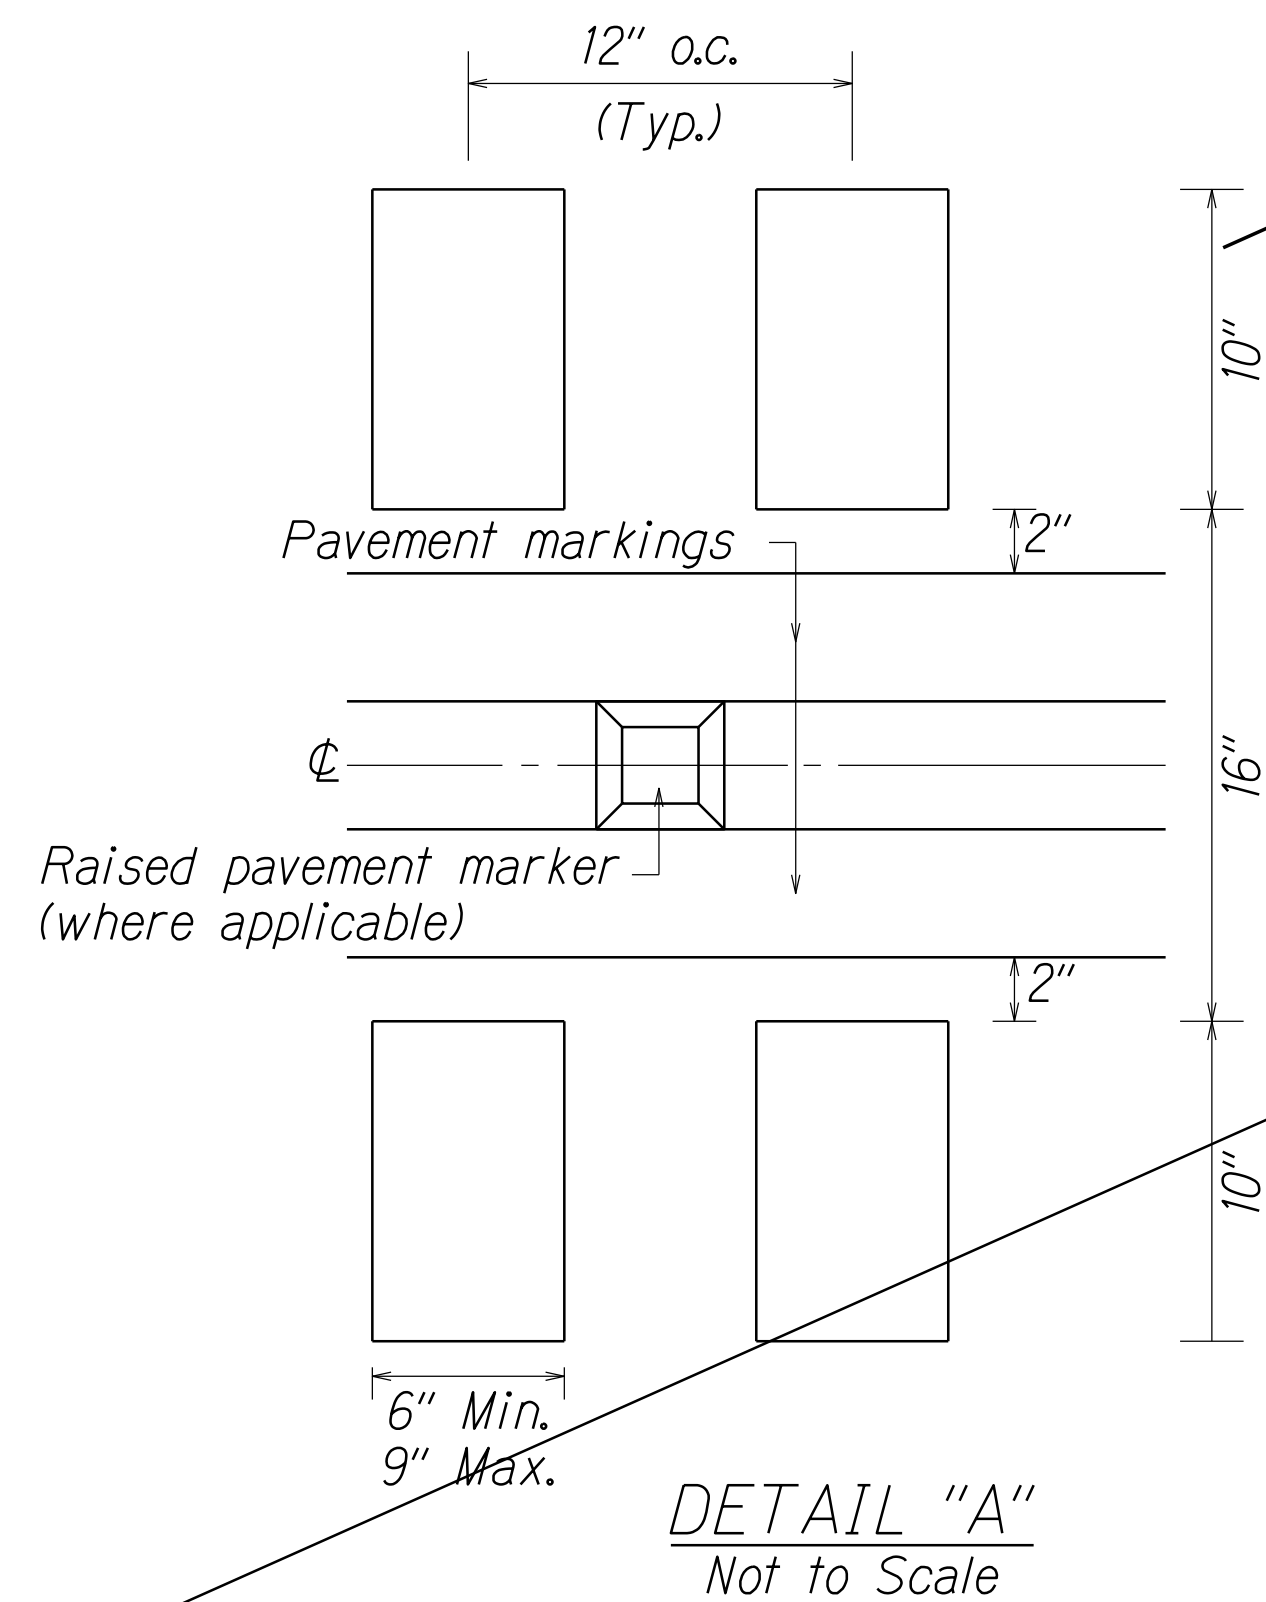


FED. ROAD DIST. NO.	STATE	PROJ. NO.	FISCAL YEAR	SHEET NO.	TOTAL SHEETS
HAWAII	HAW.	19BC-01-17	2017	29	30

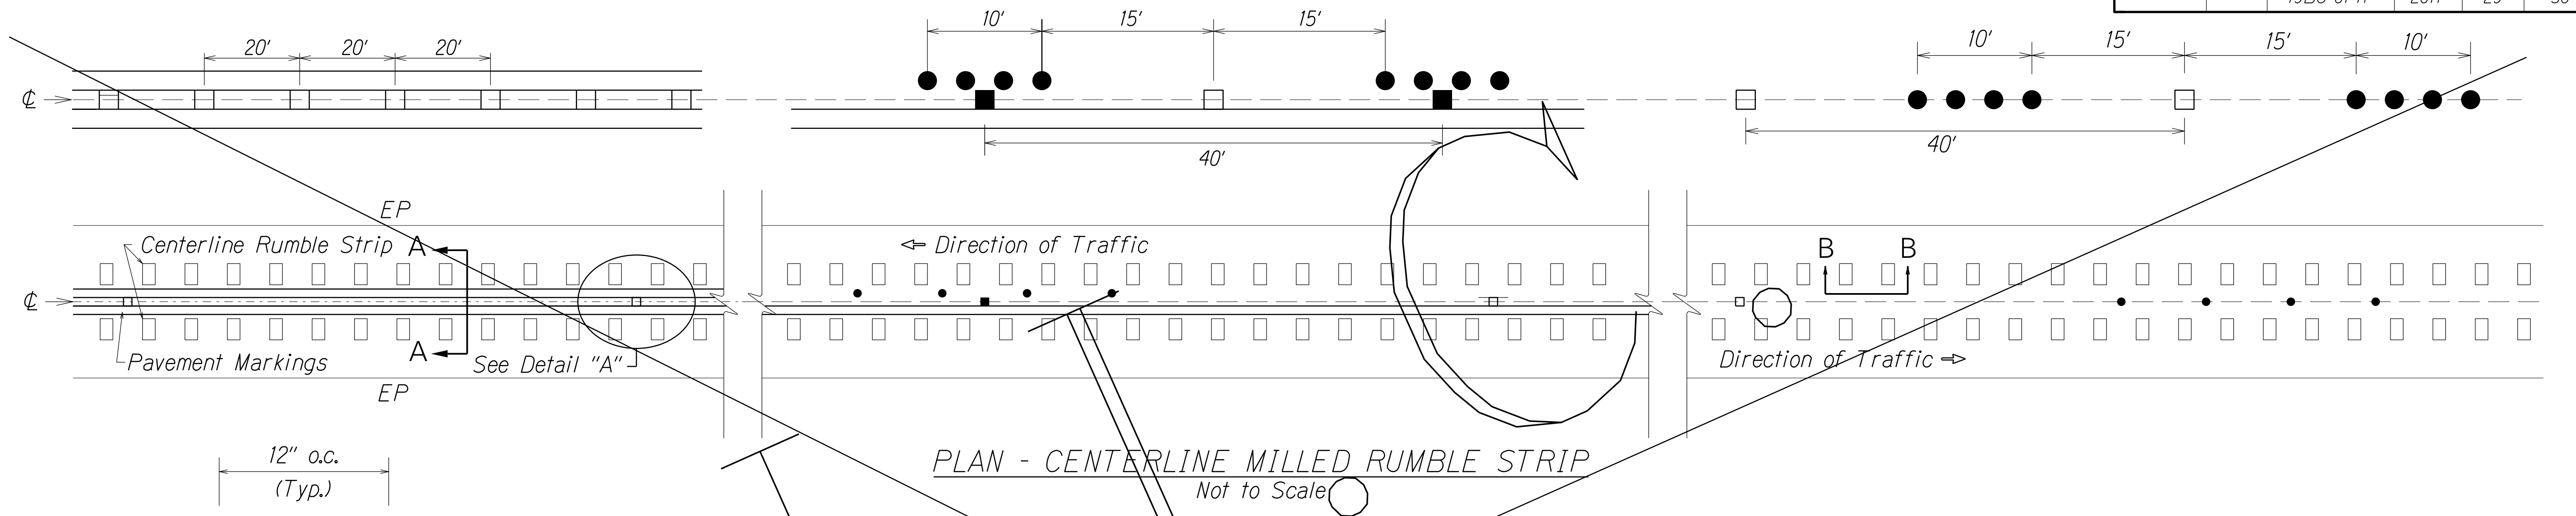

NOTES:

1. The method of constructing the centerline milled rumble strip shall be submitted to the Engineer for acceptance prior to the actual work.
2. Dimensions shown are approximate. Adjust rumble strip spacing to coordinate with pavement markings prior to installation.
3. Raised pavement markers shall be installed on level surface between the rumble strips. Do not install raised pavement markers inside the milled area.
4. The construction of the centerline milled rumble strip shall be paid for under Item No. 615.1000 - Milled Rumble Strip, Centerline.
5. The milling apparatus and removal of existing pavement markings will not be paid for separately and shall be considered incidental to Item 615.1000 - Milled Rumble Strip, Centerline.
6. Do not install centerline rumble strips on bridge decks.
7. Where at-grade bridges are present, rumble strips shall end/begin 20 L.F. beyond the existing bridge deck joints/concrete approach slab.

See:
Sheet ADD. 29S-1
Centerline Rumble Strips
Exhibit A

LEGEND FOR AS-BUILT POSTINGS	
	Squiggly line for as-built deletion
	Double line for as-built deletion
Roadway	Text for as-built posting







3/6/17	Revised note numbers 4 and 5.
DATE	REVISION

STATE OF HAWAII DEPARTMENT OF TRANSPORTATION HIGHWAYS DIVISION
DOUBLE 10-INCH CENTERLINE MILLED RUMBLE STRIP DETAIL
QUEEN KA'AHUMANU HIGHWAY RUMBLE STRIPS IMPROVEMENTS Mahai'ula to Kawaihae Project No. 19BC-01-17
Scale: Not To Scale Date: Dec., 2016
SHEET No. 1 OF 1 SHEETS

"AS-BUILT"

ADD. 29

FED. ROAD DIST. NO.	STATE	PROJ. NO.	FISCAL YEAR	SHEET NO.	TOTAL SHEETS
HAWAII	HAW.	19BC-01-17	2017	ADD.29 S-1	30

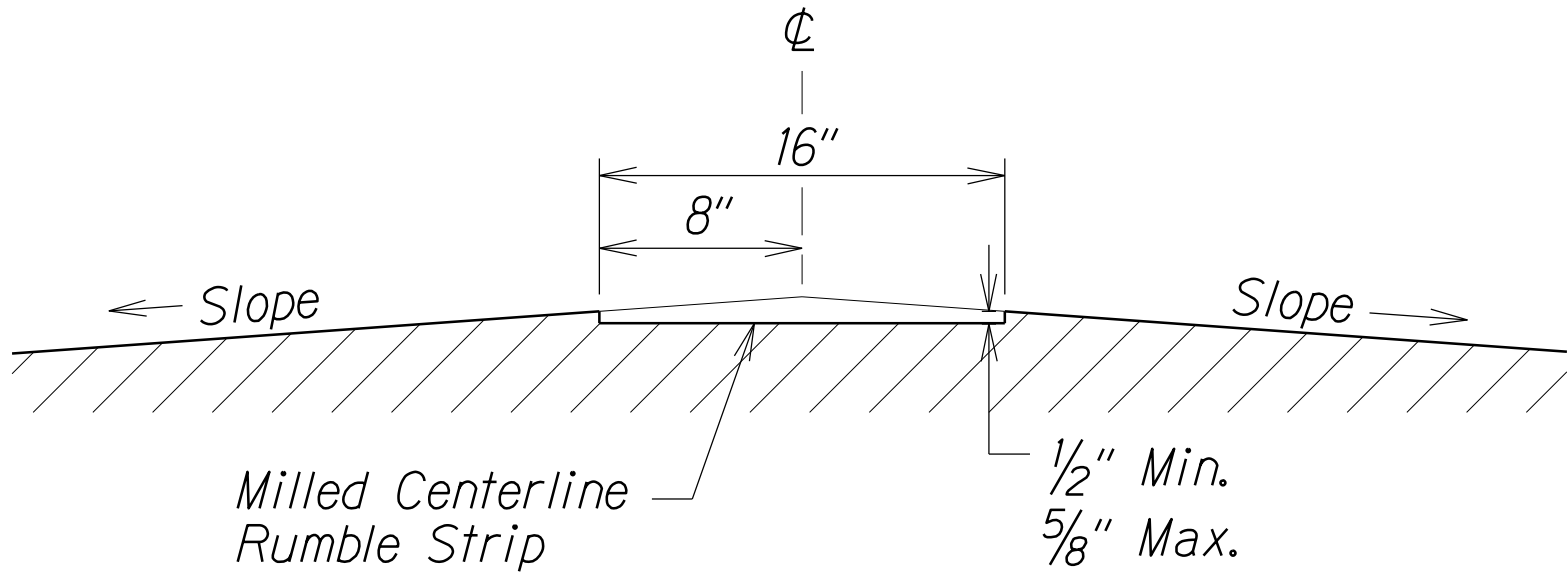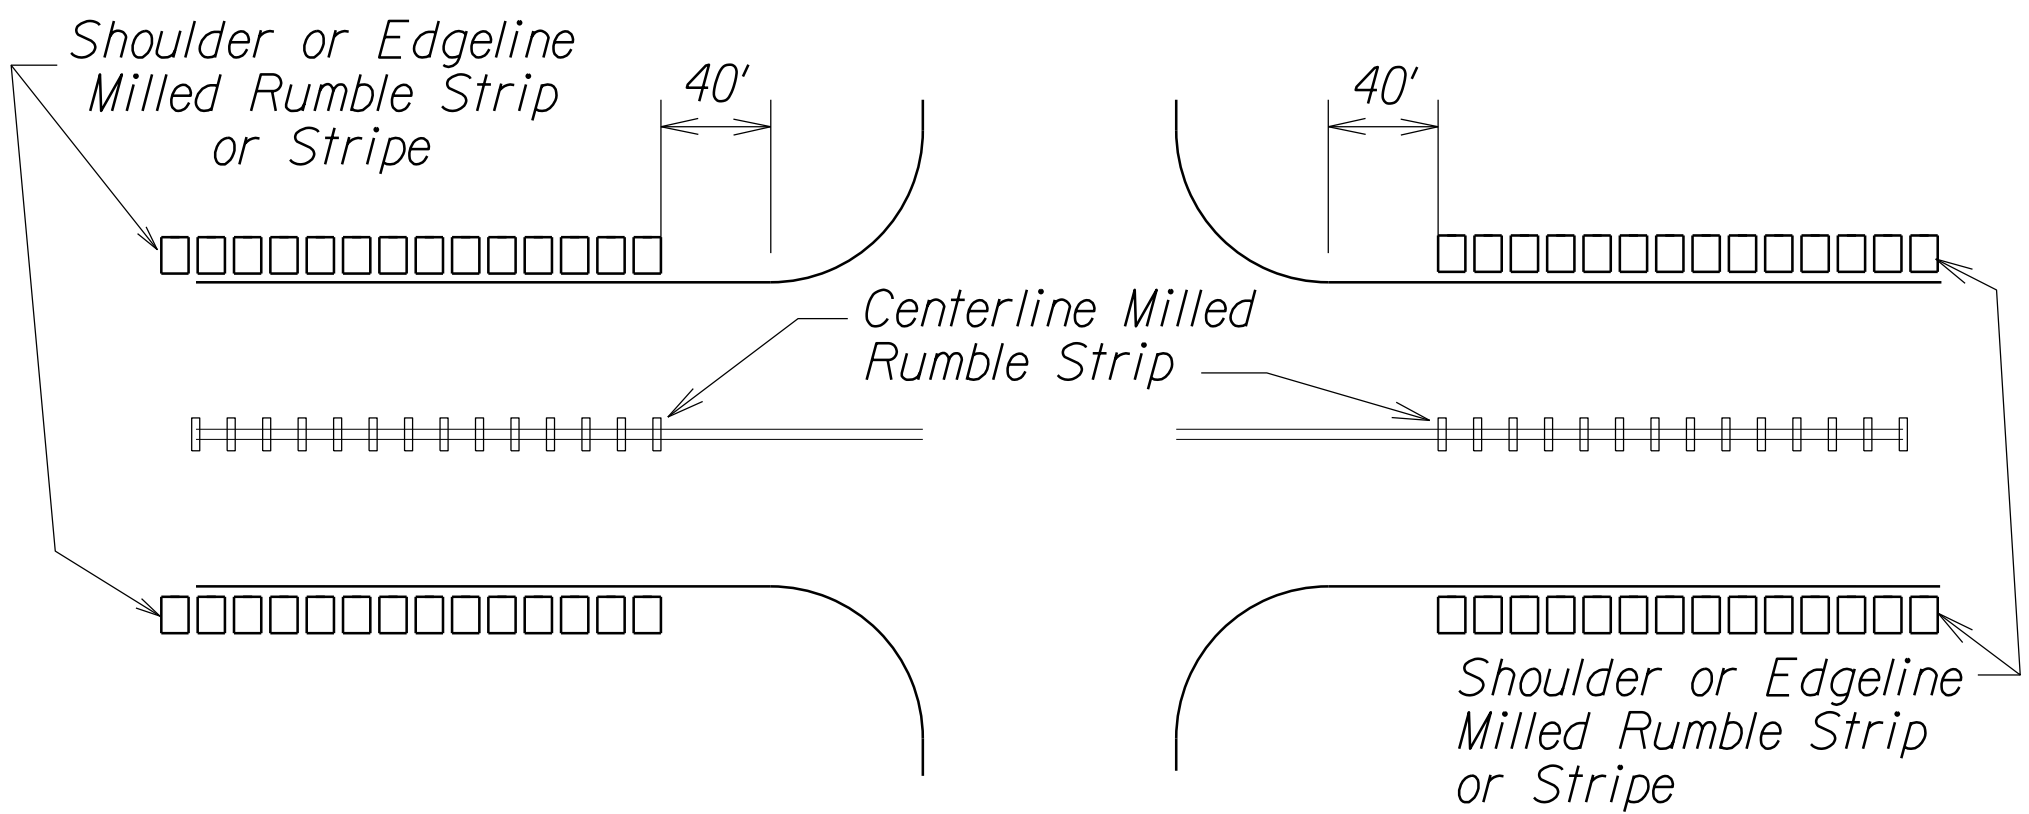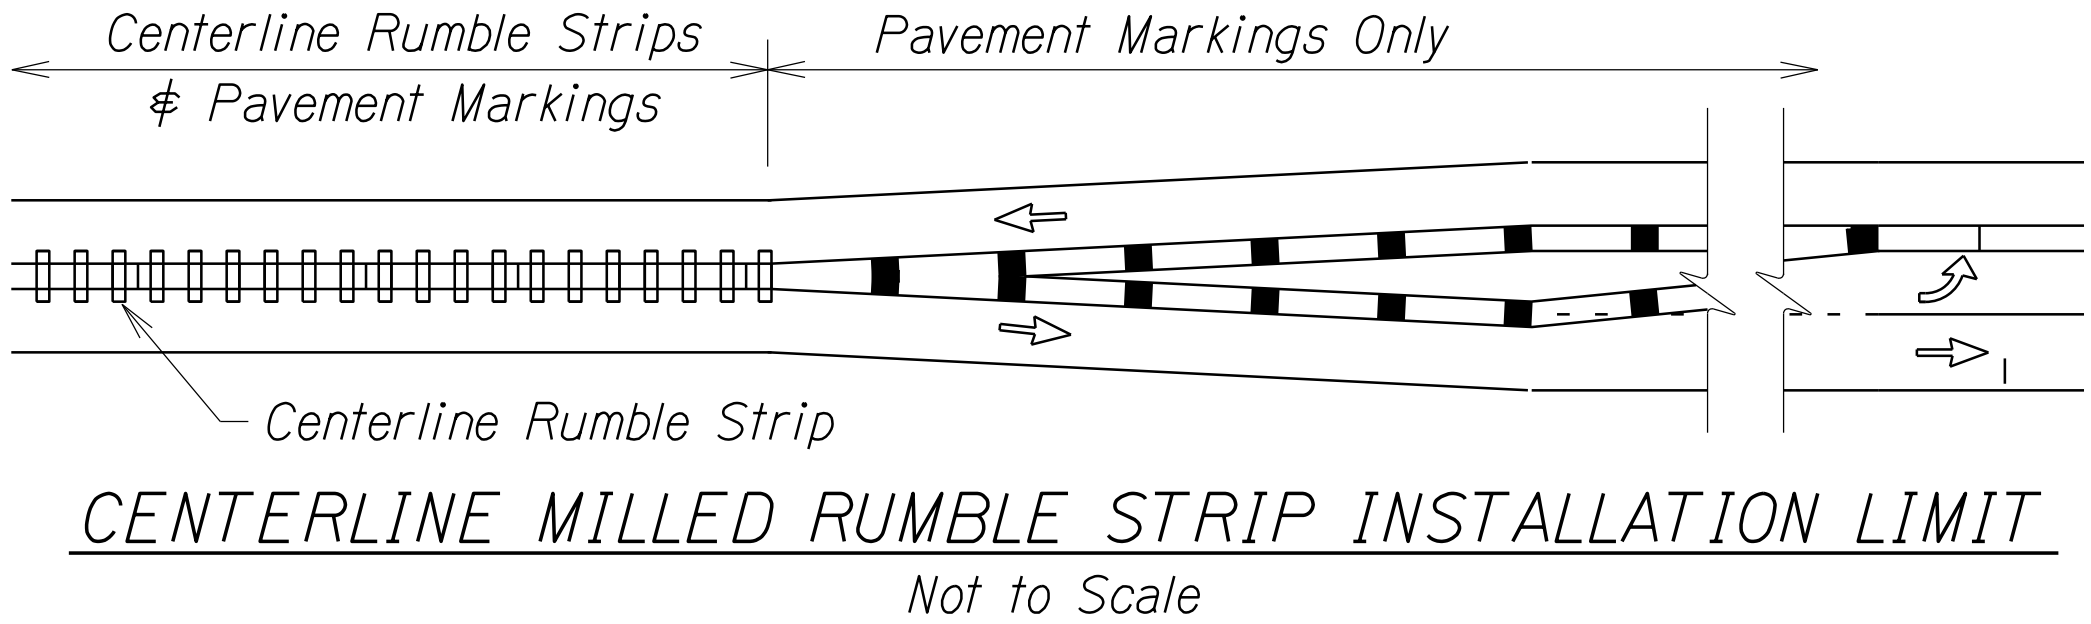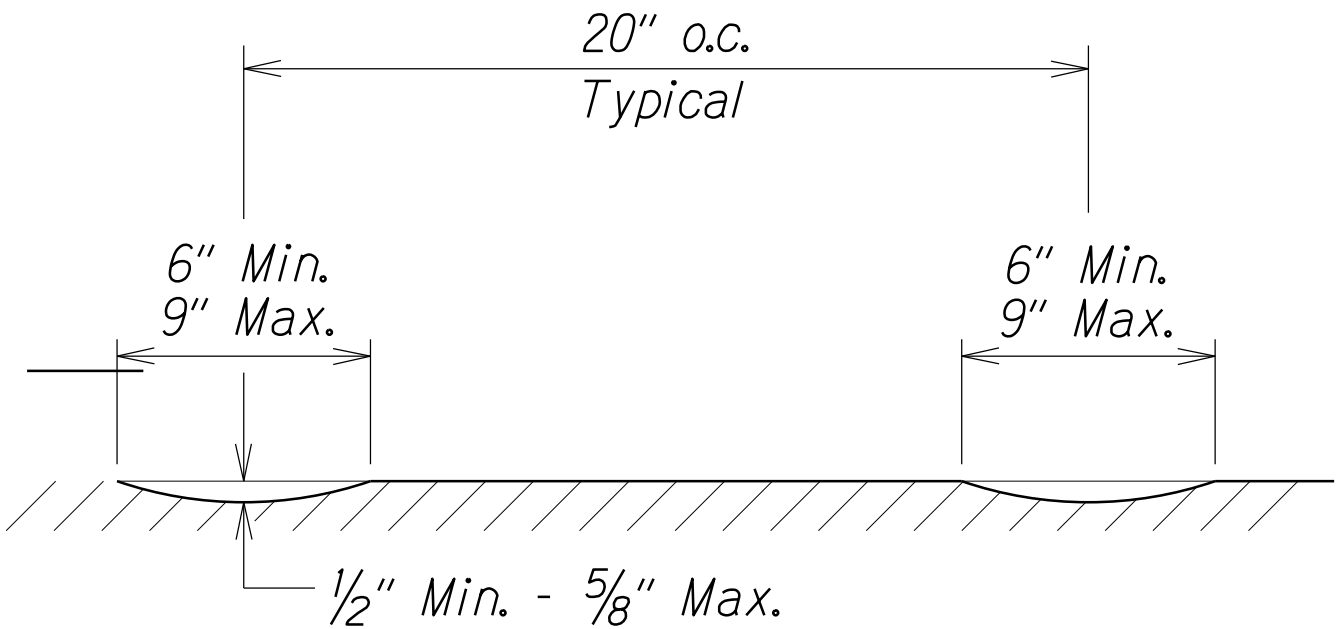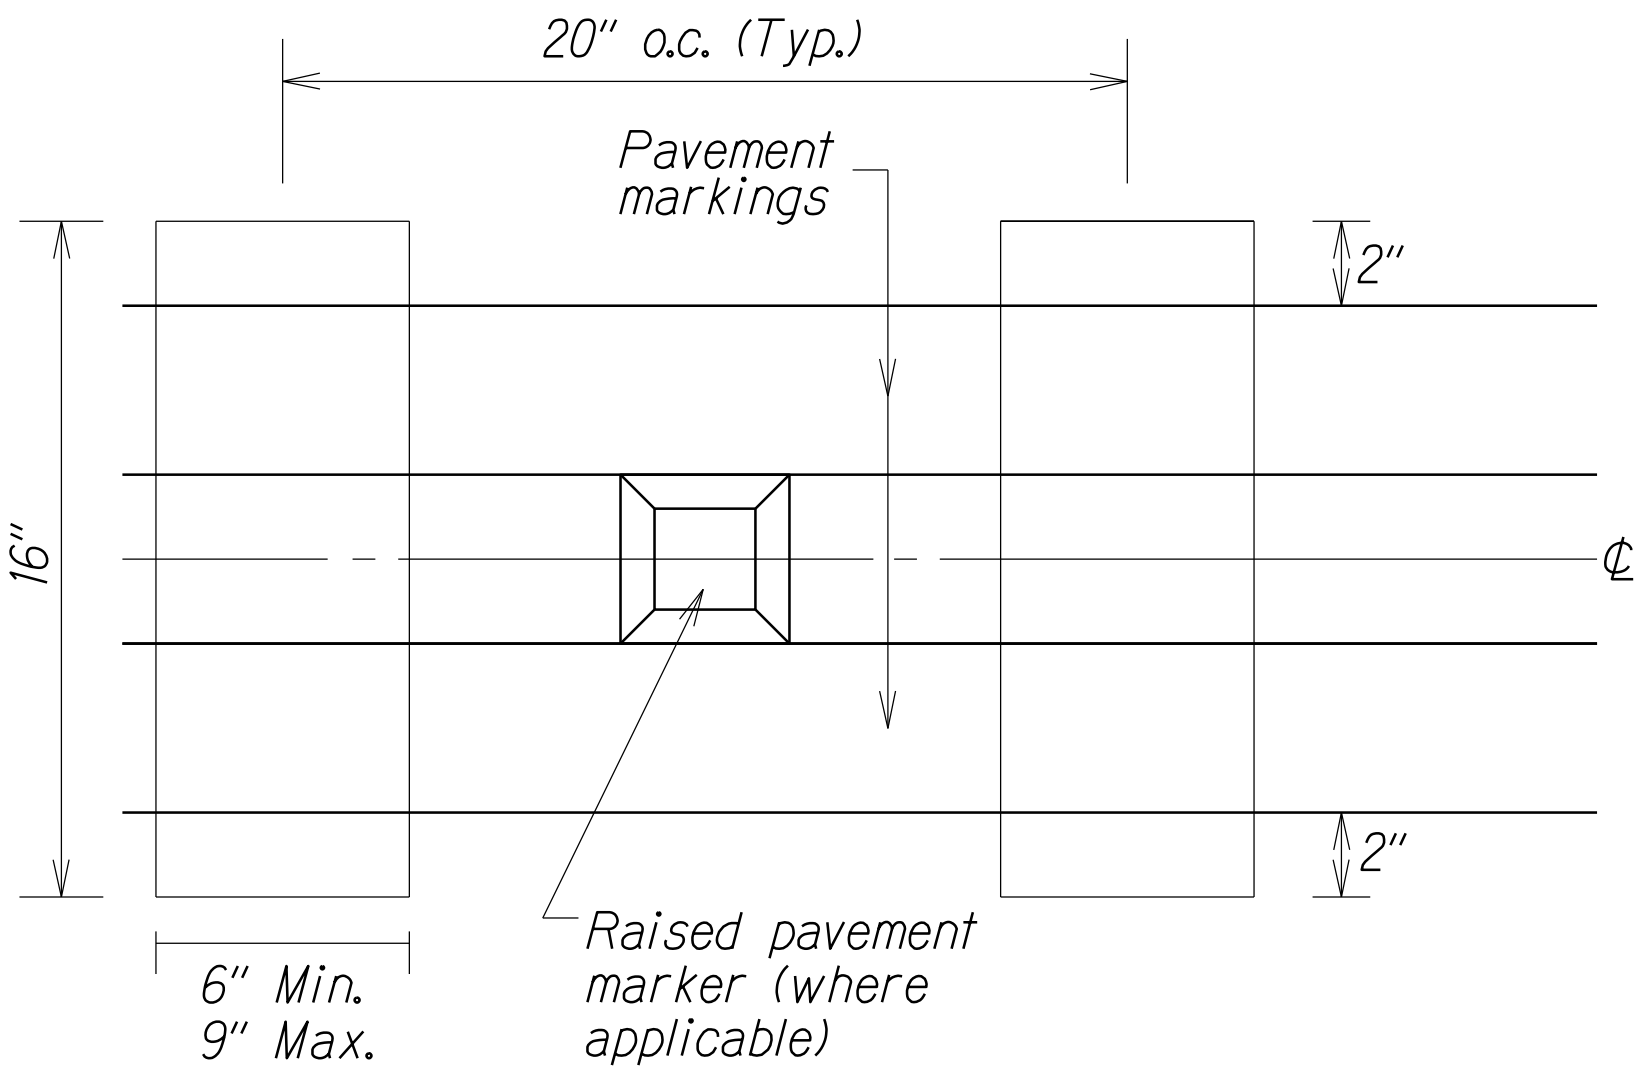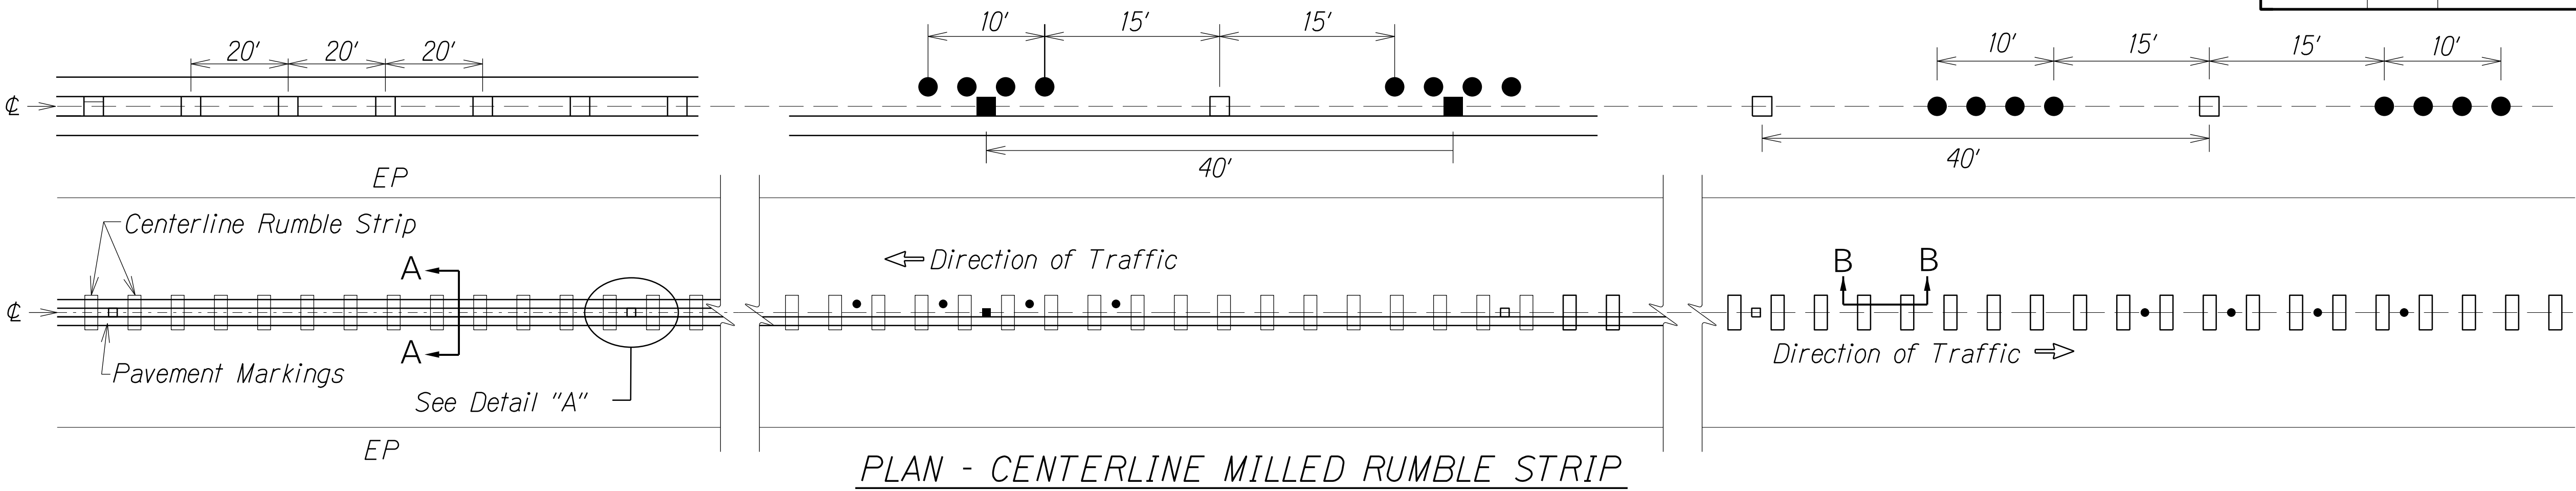

CENTERLINE RUMBLE STRIPS EXHIBIT "A"

LEGEND FOR AS-BUILT POSTINGS

	Squiggly line for as-built deletion
	Double line for as-built deletion
Roadway	Text for as-built posting

STATE OF HAWAII
DEPARTMENT OF TRANSPORTATION
HIGHWAYS DIVISION
**CENTERLINE MILLED
RUMBLE STRIP DETAIL**
QUEEN KA'AHUMANU HIGHWAY
RUMBLE STRIPS IMPROVEMENTS
Mahai'ula to Kawaihae
Project No. 19BC-01-17

Scale: Not To Scale Date: Dec., 2016

SHEET No. 1 OF 1 SHEETS

"AS-BUILT"

ADD. 29S-1