


FED. ROAD DIST. NO.	STATE	FEDERAL AID PROJ. NO.	FISCAL YEAR	SHEET NO.	TOTAL SHEETS
HAWAII	HAW.	BR-019-2(077)	2024	ADD. 30	280

INDEX TO STRUCTURAL DRAWINGS


<u>SHEET NO.</u>	<u>DESCRIPTION</u>
S0.1	INDEX TO STRUCTURAL DRAWINGS
S0.2	INDEX TO STRUCTURAL DRAWINGS
S0.3	INDEX TO STRUCTURAL DRAWINGS
S0.4	STRUCTURAL GENERAL NOTES
S0.5	STRUCTURAL GENERAL NOTES
S0.6	STRUCTURAL GENERAL NOTES
S0.7	STRUCTURAL GENERAL NOTES
S0.8	STRUCTURAL GENERAL NOTES
S0.9	SYMBOLS AND ABBREVIATIONS
SA1.1	LAYOUT PLAN
SA1.2	FOUNDATION PLAN
SA2.1	DOWNSTREAM ELEVATION
SA2.2	TYPICAL TRANSVERSE SECTION
SA2.3	TRANSVERSE SECTION AT FIXED BEARING BENTS
SA2.4	TRANSVERSE SECTION AT EXPANSION BEARING BENTS
SA2.5	SURVEY POINTS
SA3.1	ABUTMENT NOS. 1 AND 2 PLAN
SA3.2	ABUTMENT NOS. 1 AND 2 ELEVATIONS
SA3.3	ABUTMENT NO. 1 DEMO PLAN AND SECTIONS
SA3.4	ABUTMENT NO. 2 DEMO PLAN AND SECTIONS
SA3.5	ABUTMENT NO. 1 ABUTMENT SECTIONS
SA3.6	ABUTMENT NO. 2 ABUTMENT SECTIONS
SA3.7	BEARING REPLACEMENT CONSTRUCTION SEQUENCE
SA4.1	MEMBER ID LOCATION KEY, LEGEND, WP DETAILS & SCHEDULE AT BENTS
SA4.2	MEMBER ID LOCATION KEY AND LEGEND AT TRESTLES
SA4.3	BENT NO. 1 / TRESTLE NO. 1 MEMBER ELEVATIONS
SA4.4	BENT NO. 2 / TRESTLE NO. 2 MEMBER ELEVATIONS
SA4.5	BENT NO. 3 / TRESTLE NO. 2 MEMBER ELEVATIONS
SA4.6	BENT NO. 4 / TRESTLE NO. 3 MEMBER ELEVATIONS
SA4.7	BENT NO. 5 / TRESTLE NO. 3 MEMBER ELEVATIONS
SA4.8	BENT NO. 6 / TRESTLE NO. 4 MEMBER ELEVATIONS
SA4.9	BENT NO. 7 / TRESTLE NO. 4 MEMBER ELEVATIONS
SA4.10	BENT NOS. 8 AND 9 / TRESTLE NO. 5 MEMBER ELEVATIONS

<u>SHEET NO.</u>	<u>DESCRIPTION</u>
SA4.11	CONNECTION ID LOCATION KEY AND LEGEND AT BENTS
SA4.12	CONNECTION ID LOCATION KEY AND LEGEND AT TRESTLES
SA4.13	BENT NO. 1 / TRESTLE NO. 1 CONNECTION ELEVATIONS
SA4.14	BENT NO. 2 / TRESTLE NO. 2 CONNECTION ELEVATIONS
SA4.15	BENT NO. 3 / TRESTLE NO. 2 CONNECTION ELEVATIONS
SA4.16	BENT NO. 4 / TRESTLE NO. 3 CONNECTION ELEVATIONS
SA4.17	BENT NO. 5 / TRESTLE NO. 3 CONNECTION ELEVATIONS
SA4.18	BENT NO. 6 / TRESTLE NO. 4 CONNECTION ELEVATIONS
SA4.19	BENT NO. 7 / TRESTLE NO. 4 CONNECTION ELEVATIONS
SA4.20	BENT NOS. 8 AND 9 / TRESTLE NO. 5 CONNECTION ELEVATIONS
SA5.1	UPPER COLUMN ELEVATIONS
SA5.2	UPPER COLUMN ELEVATIONS
SA5.3	INTERMEDIATE COLUMN ELEVATIONS
SA5.4	INTERMEDIATE COLUMN ELEVATIONS
SA5.5	LOWER COLUMN ELEVATIONS
SA5.6	LOWER COLUMN ELEVATIONS
SA5.7	BENT NO. 1 COLUMN ELEVATIONS
SA5.8	BENT NO. 1 COLUMN ELEVATIONS
SA5.9	BENT NO. 9 COLUMN ELEVATIONS
SA5.10	BENT NO. 9 COLUMN ELEVATIONS
SA5.11	COLUMN SECTIONS AND DETAILS
SA5.12	DIAGONAL BRACE PLAN, ELEVATION AND SECTION
SA5.13	DIAGONAL BRACE SCHEDULE
SA5.14	DIAGONAL BRACE SCHEDULE
SA5.15	DIAGONAL BRACE PLAN, ELEVATION AND SECTION
SA5.16	DIAGONAL BRACE SCHEDULE
SA5.17	DIAGONAL BRACE PLAN, ELEVATION AND SECTION
SA5.18	DIAGONAL BRACE SCHEDULE
SA5.19	HORIZONTAL BRACE PLAN, ELEVATION AND SECTION
SA5.20	HORIZONTAL BRACE SCHEDULE
SA5.21	HORIZONTAL BRACE PLAN, ELEVATION AND SECTION
SA5.22	HORIZONTAL BRACE SCHEDULE
SA5.23	DIAGONAL BRACE PLAN, ELEVATION AND SECTION
SA5.24	DIAGONAL BRACE SCHEDULE
SA5.25	DIAGONAL BRACE SCHEDULE
SA5.26	DIAGONAL BRACE PLAN, ELEVATION AND SECTION


<u>SHEET NO.</u>	<u>DESCRIPTION</u>
SA5.27	DIAGONAL BRACE SCHEDULE
SA5.28	HORIZONTAL BRACE PLAN, ELEVATION AND SECTION
SA5.29	HORIZONTAL BRACE PLAN, ELEVATION AND SECTION
SA5.30	HORIZONTAL BRACE SCHEDULE
SA5.31	VERTICAL BRACE PLAN, ELEVATION AND SECTION
SA5.32	VERTICAL BRACE SCHEDULE
SA5.33	VERTICAL BRACE PLAN, ELEVATION AND SECTION
SA5.34	VERTICAL BRACE SCHEDULE
SA6.1	COLUMN SPLICE CONNECTION DETAILS
SA6.2	COLUMN TO BRACE CONNECTION DETAILS
SA6.3	COLUMN TO BRACE CONNECTION DETAILS
SA6.4	COLUMN TO BRACE CONNECTION DETAILS
SA6.5	COLUMN TO BRACE CONNECTION DETAILS
SA6.6	COLUMN TO BRACE CONNECTION DETAILS
SA6.7	COLUMN TO BRACE CONNECTION DETAILS
SA6.8	COLUMN TO BRACE CONNECTION DETAILS
SA6.9	COLUMN TO BRACE CONNECTION DETAILS
SA6.10	BASE COLUMN TO BRACE CONNECTION DETAILS
SA6.11	BASE COLUMN TO BRACE CONNECTION DETAILS
SA6.12	BASE COLUMN TO BRACE CONNECTION DETAILS
SA6.13	BASE COLUMN TO BRACE CONNECTION DETAILS
SA6.14	TOP COLUMN TO BRACE CONNECTION DETAILS
SA6.15	BRACE TO BRACE CONNECTION DETAILS
SA6.16	BRACE TO BRACE CONNECTION DETAILS
SA6.17	BRACE TO BRACE CONNECTION DETAILS
SA6.17A 	PAINT BLOCKING DETAILS AT BOLTED CONNECTIONS
SA6.18	CONNECTION REFERENCE SCHEDULE


ORIGINAL PLAN	SURVEY PLOTTED BY	DATE
	DRAWN BY	
	DESIGNED BY	
	NOTED BY	
NOTE BOOK	QUANTITIES BY	
	CHECKED BY	
No.		

DRAWING NAME: Z:\00_OBNOBNO\23-022-9-NANUE STR BR PF2-DOT\A1 CAD\12-06-24 ADD\NSR-S0001 INDEX ADD2.DWG PLOT TIME: 12-03-24 9:48 PM

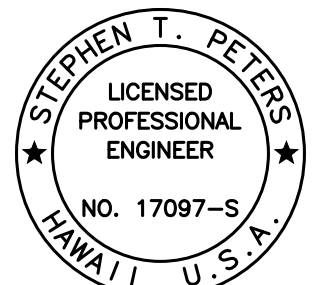

THIS WORK WAS PREPARED BY
ME OR UNDER MY SUPERVISION.

 4-30-26
SIGNATURE EXPIRATION DATE OF THE LICENSE

12/6/24	 Revised Index
DATE	REVISION

STATE OF HAWAII
DEPARTMENT OF TRANSPORTATION
HIGHWAYS DIVISION

INDEX TO STRUCTURAL DRAWINGS

HAWAII BELT ROAD
Nanue Stream Bridge Rehabilitation
Federal Aid Project No. BR-019-2(077)


Scale: None Date: Oct. 2024

SHEET No. S0.1 OF 9 SHEETS

DRAWING NAME: Z:\00 ONGOING\23-022-9-NANUE STR BR PF2-DOT\A.01 CAD\12-06-24 ADD\NSR-S0004 GENNOTES.DWG PLOT TIME: 12-05-24, 12:29 PM

ORIGINAL PLAN	SURVEY PLOTTED BY:	DATE:
	DRAWN BY:	
	TRACED BY:	
	DESIGNED BY:	
NOTE BOOK	QUANTITIES BY:	
	CHECKED BY:	
No.		

5. Structural Steel (Cont.)

- B. All new steel structures shall be ASTM A123 hot-dip zinc galvanized after all fabrication is complete. Protect elements against hydrogen embrittlement in conformance with ASTM A143. Post-galvanizing quenching/passivation shall not be utilized for steel going to paint. Coordinate with coating Contractor.
- C. The steel detailer of the trestle structures shall hold a current National Institute of Steel Detailing (NISD) Senior Detailer - Class I Bridge Certification and shall be submitted to the Engineer for review and approval.
-  D. The steel fabricator of the trestle structures shall hold a current AISC Intermediate (IBR) Bridge Fabricator Certification and shall be submitted to the Engineer for review and approval.
- E. Prior to hot-dip galvanizing, all welding flux and slag shall be completely removed using mechanical methods to ensure proper zinc adhesion.
- F. Vent holes may be provided in members for hot-dip zinc galvanized operation. Size and location of holes shall be determined by galvanizing contractor, unless otherwise shown on the drawings. Vent hole sizes and locations shall be included on the structural steel shop drawings. All holes, other than base plates, and where noted shall be filled with zinc plugs following galvanizing operation.
- G. All damage done to galvanized steel surfaces shall be repaired in accordance with ASTM A780 using the zinc solder method. Zinc rich paint shall not be an acceptable repair procedure
- H. Structural parts designated for CVN Testing shall meet the longitudinal Charpy V-Notch requirements for a non-fracture critical member in Zone 1.
- I. Steel plates for columns shall be cut and fabricated so that the primary direction of rolling is parallel to the column length. For column splice plates, the direction shall be parallel to the direction of the splice. For base plates, the direction shall be parallel to the centerline of the bent.
- J. All holes in steel members shall be be sub-punched and reamed or full size drilled.
- K. All holes for bolted connections shall be standard size unless otherwise shown on the contract drawings.
- L. Bolt assemblies which connect steel to steel shall utilize 7/8" dia. high-strength bolts conforming to ASTM F3125, Grade A325, Type 1, unless otherwise noted. Bolts shall be ordered such that threads are excluded from the shear plane. Bolts shall be snug tightened unless otherwise shown on plans. All pretensioned/ slip-critical bolts shall utilize Direct Tension Indicating (DTI) washers to ensure proper bolt tension. Bolts shall be inspected.
- M. Steel-to-steel bolted joints designated as slip-critical shall be pretensioned bolt assemblies with additional paint masking requirements between the faying surfaces. Provide paint masking details as shown in the contract documents.

5. Structural Steel (Cont.)

- N. All nuts shall be ASTM A563 DH heavy-hex and all hardened washers shall be ASTM F436. All hardened washers shall have a hardness of Rc 38-45. DTI Washer shall be ASTM F959 and shall be installed under the bolt head or nut as shown on the Contract drawings.
- O. Matched Bolt Assemblies shall contain bolt, nut, and washer provided by the same supplier.
- P. Installation of all bolted assemblies shall be in accordance with the latest Research Council of Structural Connections (RCSC) Specifications for Structural Joints Using High-Strength Bolts.
- Q. Anchor bolts which connect steel to concrete shall be high-strength threaded rods conforming to ASTM F1554, Grade 105 and shall be straight rod with anchor plate details at the embedded end as shown in the contract drawings. Anchor bolts shall have CVN Testing performed. Anchor bolts shall be pretensioned by the turn of the nut method. See anchor bolt pretensioning schedule.
- R. All hardware, including bolts, anchor bolts, nuts and hardened washers shall be ASTM F2329 hot-dip zinc galvanized. Hardware shall be centrifugally cleaned post galvanizing. Nut threads shall be tapped oversized prior to galvanizing in accordance with ASTM A563 and are prohibited from being chased following the galvanizing process. DTI washers shall be mechanically zinc galvanized in accordance with ASTM B695, Class 55.
- S. All welding shall conform to the latest ANSI/AASHTO/AWS D1.5 Bridge Welding Code. Welding shall be performed in accordance with a Welding Procedure Specification (WPS) and Procedure Qualification Record (PQR) as required in AWS D1.5. The WPS variables shall be within the parameters established by the filler-metal manufacturer.
- T. All welding, whether shop or field, shall be done by certified welders in conformance with the Bridge Welding Code AWS D1.5 of the American Welding Society.
- U. All Welder Certifications, WPS's and supporting PQR's shall be submitted to the Engineer for review and approval prior to any welding being performed.
- V. Welding shall be performed in such a manner so as to minimize warping and distortion of steel pieces being joined. Excessive concentrated heat being applied to steel pieces shall be avoided.
- W. All welded connections shall receive full seal welding along all edges of faying surfaces to prevent moisture intrusion.
- X. All weld sizes are shown in inches. No fillet weld (including seal welds) or PJP weld shall be less than 1/4" and 3/16", respectively.

6. Structural Steel (Cont.)


- Y. All welds shall utilize E70XX Electrodes where Shielded Metal Arc Welding (SMAW) is utilized. Where other welding processes are used, filler metal shall have matching strength to base metal.
- Z. Field welding shall not be permitted unless explicitly shown on the contract drawings.
- AA. All welding arc strikes, whether shop or field performed, shall be ground flush to the base metal. Any arc strikes made to the bottom flange of the plate girder shall additionally have magnetic particle inspection and hardness testing performed in accordance with AWS D1.5.
- AB. All existing deformed girder stiffeners shall be cold straightened to bring them back in original alignment over their full height. Cost for this work shall be incidental to the various pay items.
- AC. See Standard Specifications and Special Provisions Section 501 - STEEL STRUCTURES for additional requirements.


6. Concrete:

- A. All concrete strengths shall be as noted below:

Item No.	Structural Parts	Compressive Strength, f'c (28 Days)	Maximum Water/ Cementitious (W/C)	Maximum Cementitious Material Content (lbs./cy)	Included Admixtures (See Notes Below in This Section)
(1)	Foundation Pedestals, Grade Beams, and Cheek Walls	6,000 psi	0.40	720	C, D, E
(2)	Underwater Concrete	(See Special Provisions Section 615)			
(3)	VESLMC	(See Special Provisions Section 679)			

- B. The use of calcium chloride in any concrete is prohibited.
- C. A migrating amine carboxylate water-based corrosion inhibiting admixture such as Cortec MCI 2005 NS or approved equal shall be added to the concrete mix. The dosage requirements shall be 24 fluid ounces per cubic yard of concrete.

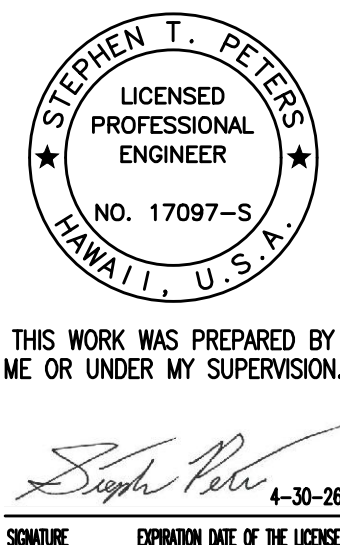


12/6/24	 Revised Note
DATE	REVISION

STATE OF HAWAII
DEPARTMENT OF TRANSPORTATION
HIGHWAYS DIVISION


STRUCTURAL GENERAL NOTES
HAWAII BELT ROAD
Nanue Stream Bridge Rehabilitation
Federal Aid Project No. BR-019-2(077)
Scale: None Date: Oct. 2024

SHEET No. 50.5 OF 9 SHEETS


FED. ROAD DIST. NO.	STATE	FEDERAL AID PROJ. NO.	FISCAL YEAR	SHEET NO.	TOTAL SHEETS
HAWAII	HAW.	BR-019-2(077)	2024	ADD. 51	280

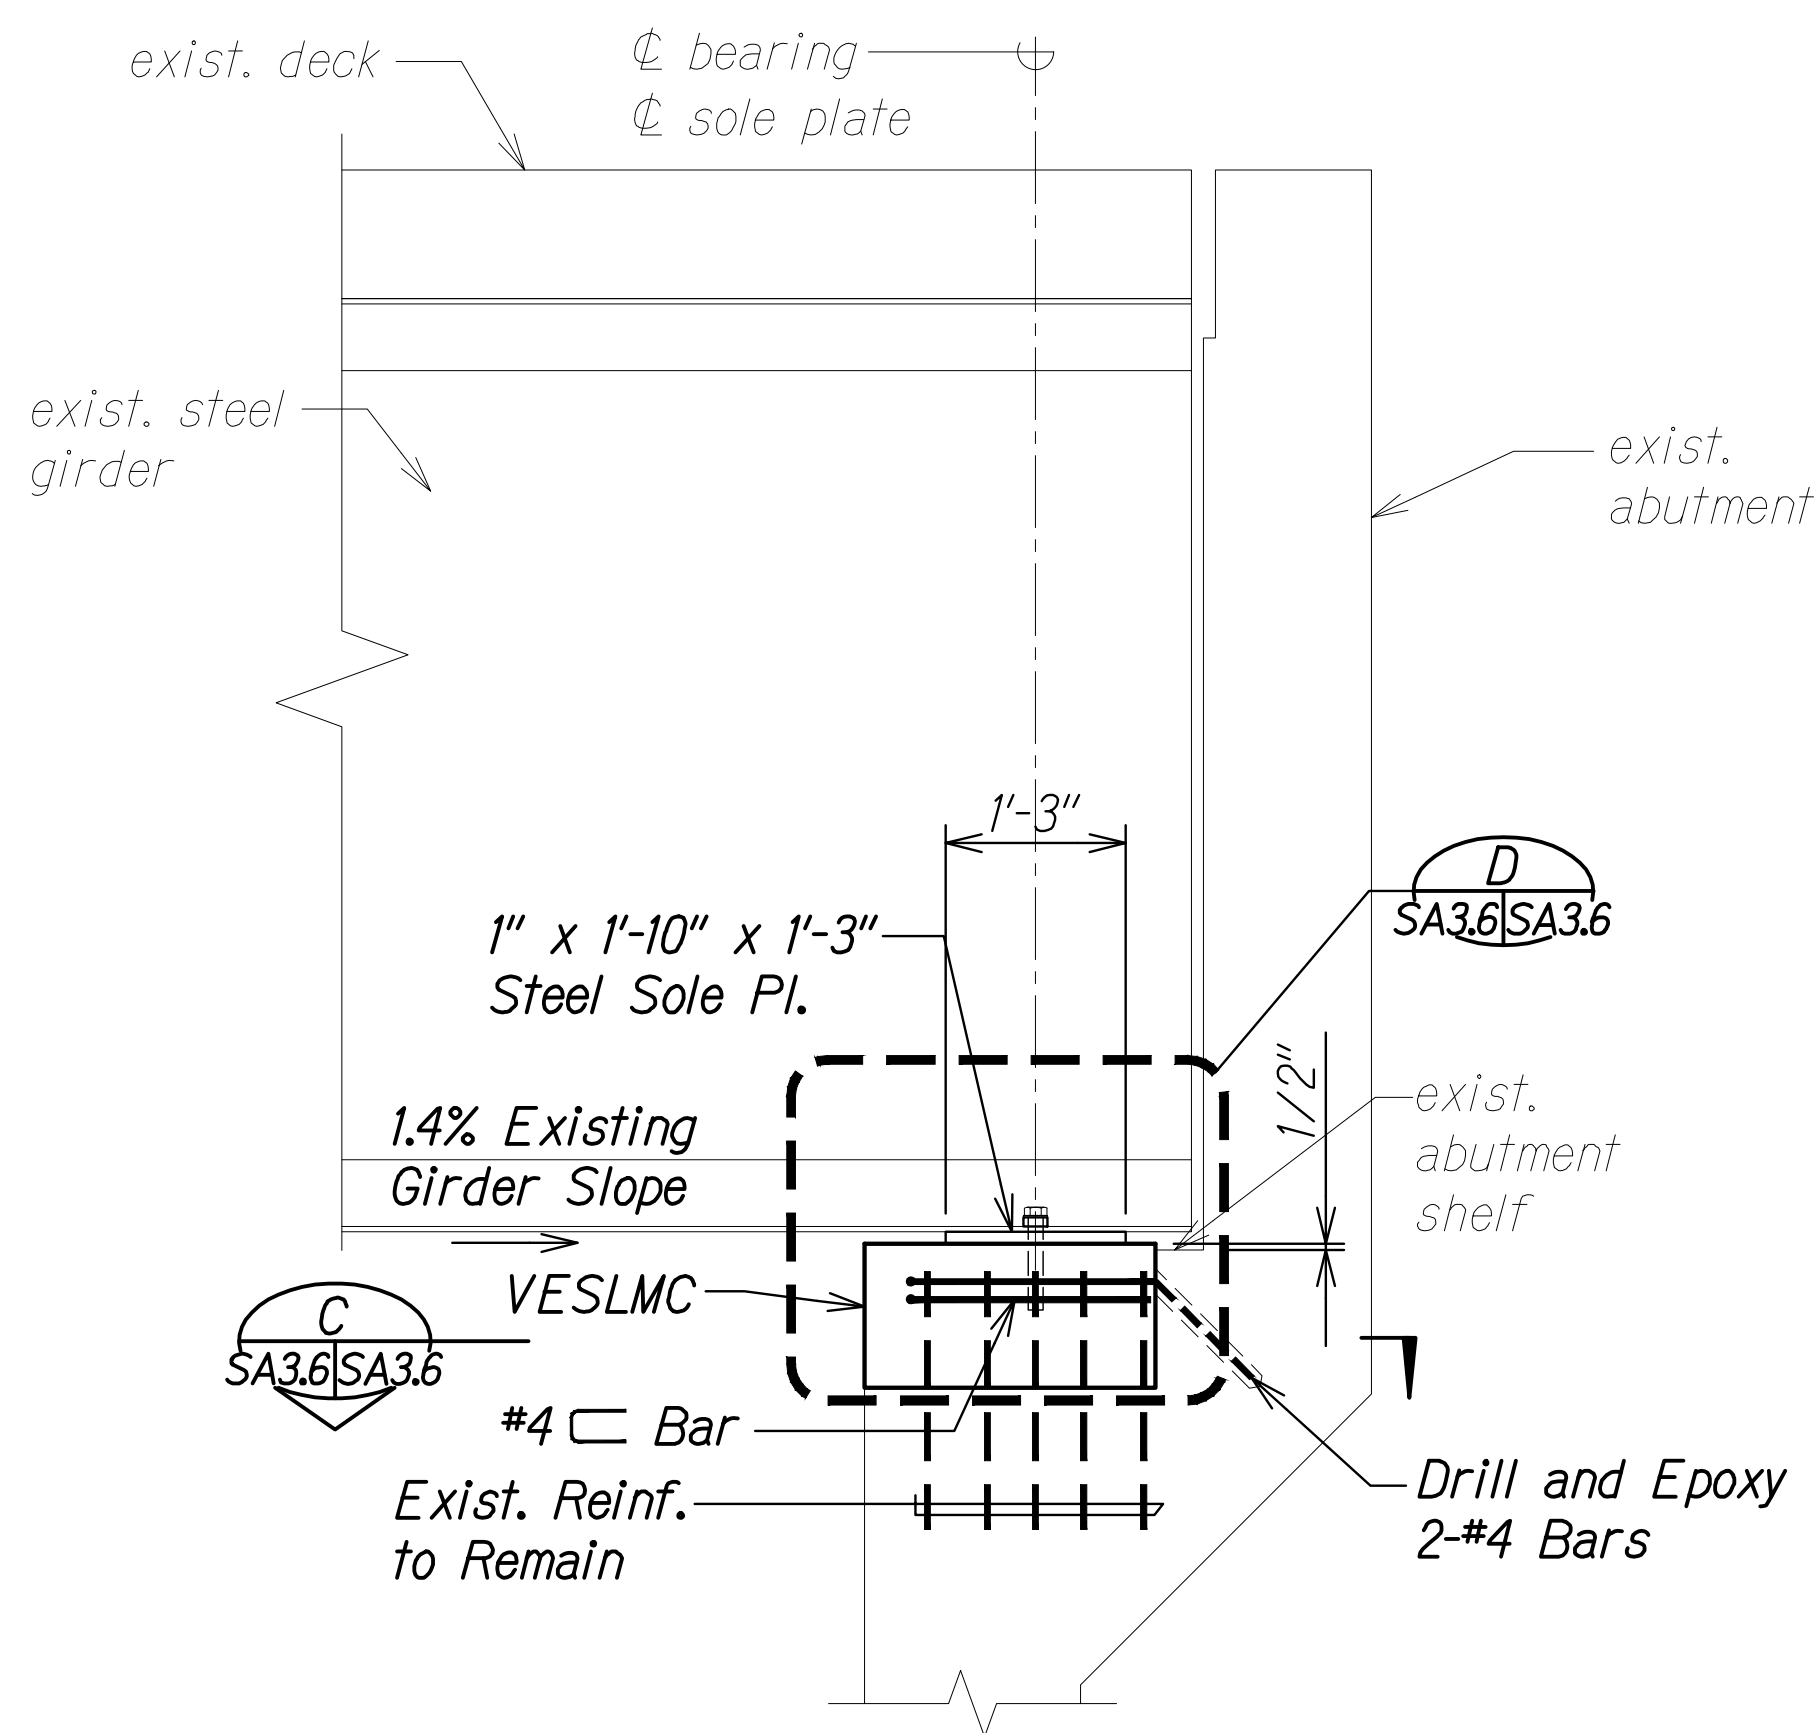


SECTION A
Scale: 3/4" = 1'-0" SA3.1 SA3.6

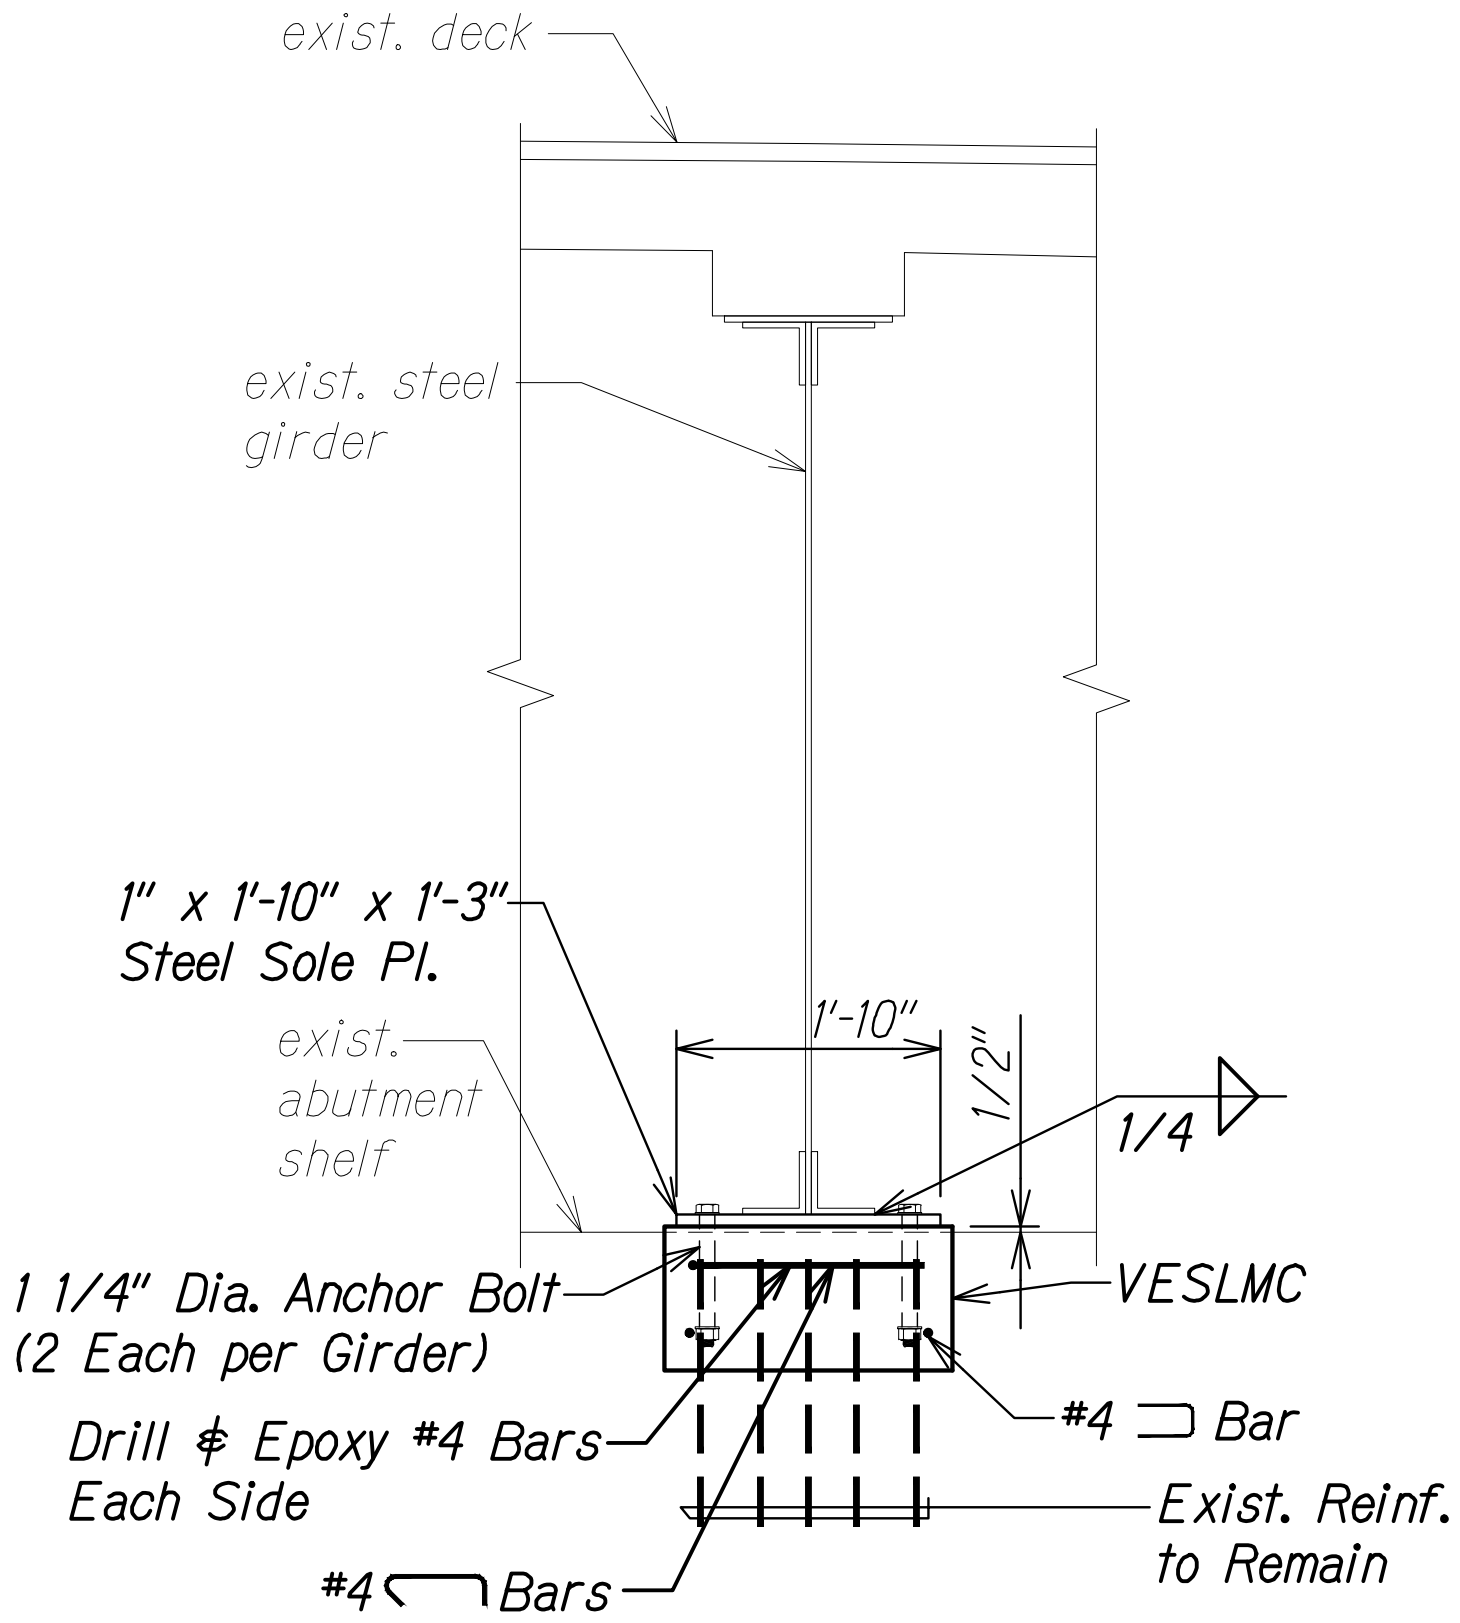

SECTION B
Scale: 3/4" = 1'-0" SA3.1 SA3.6

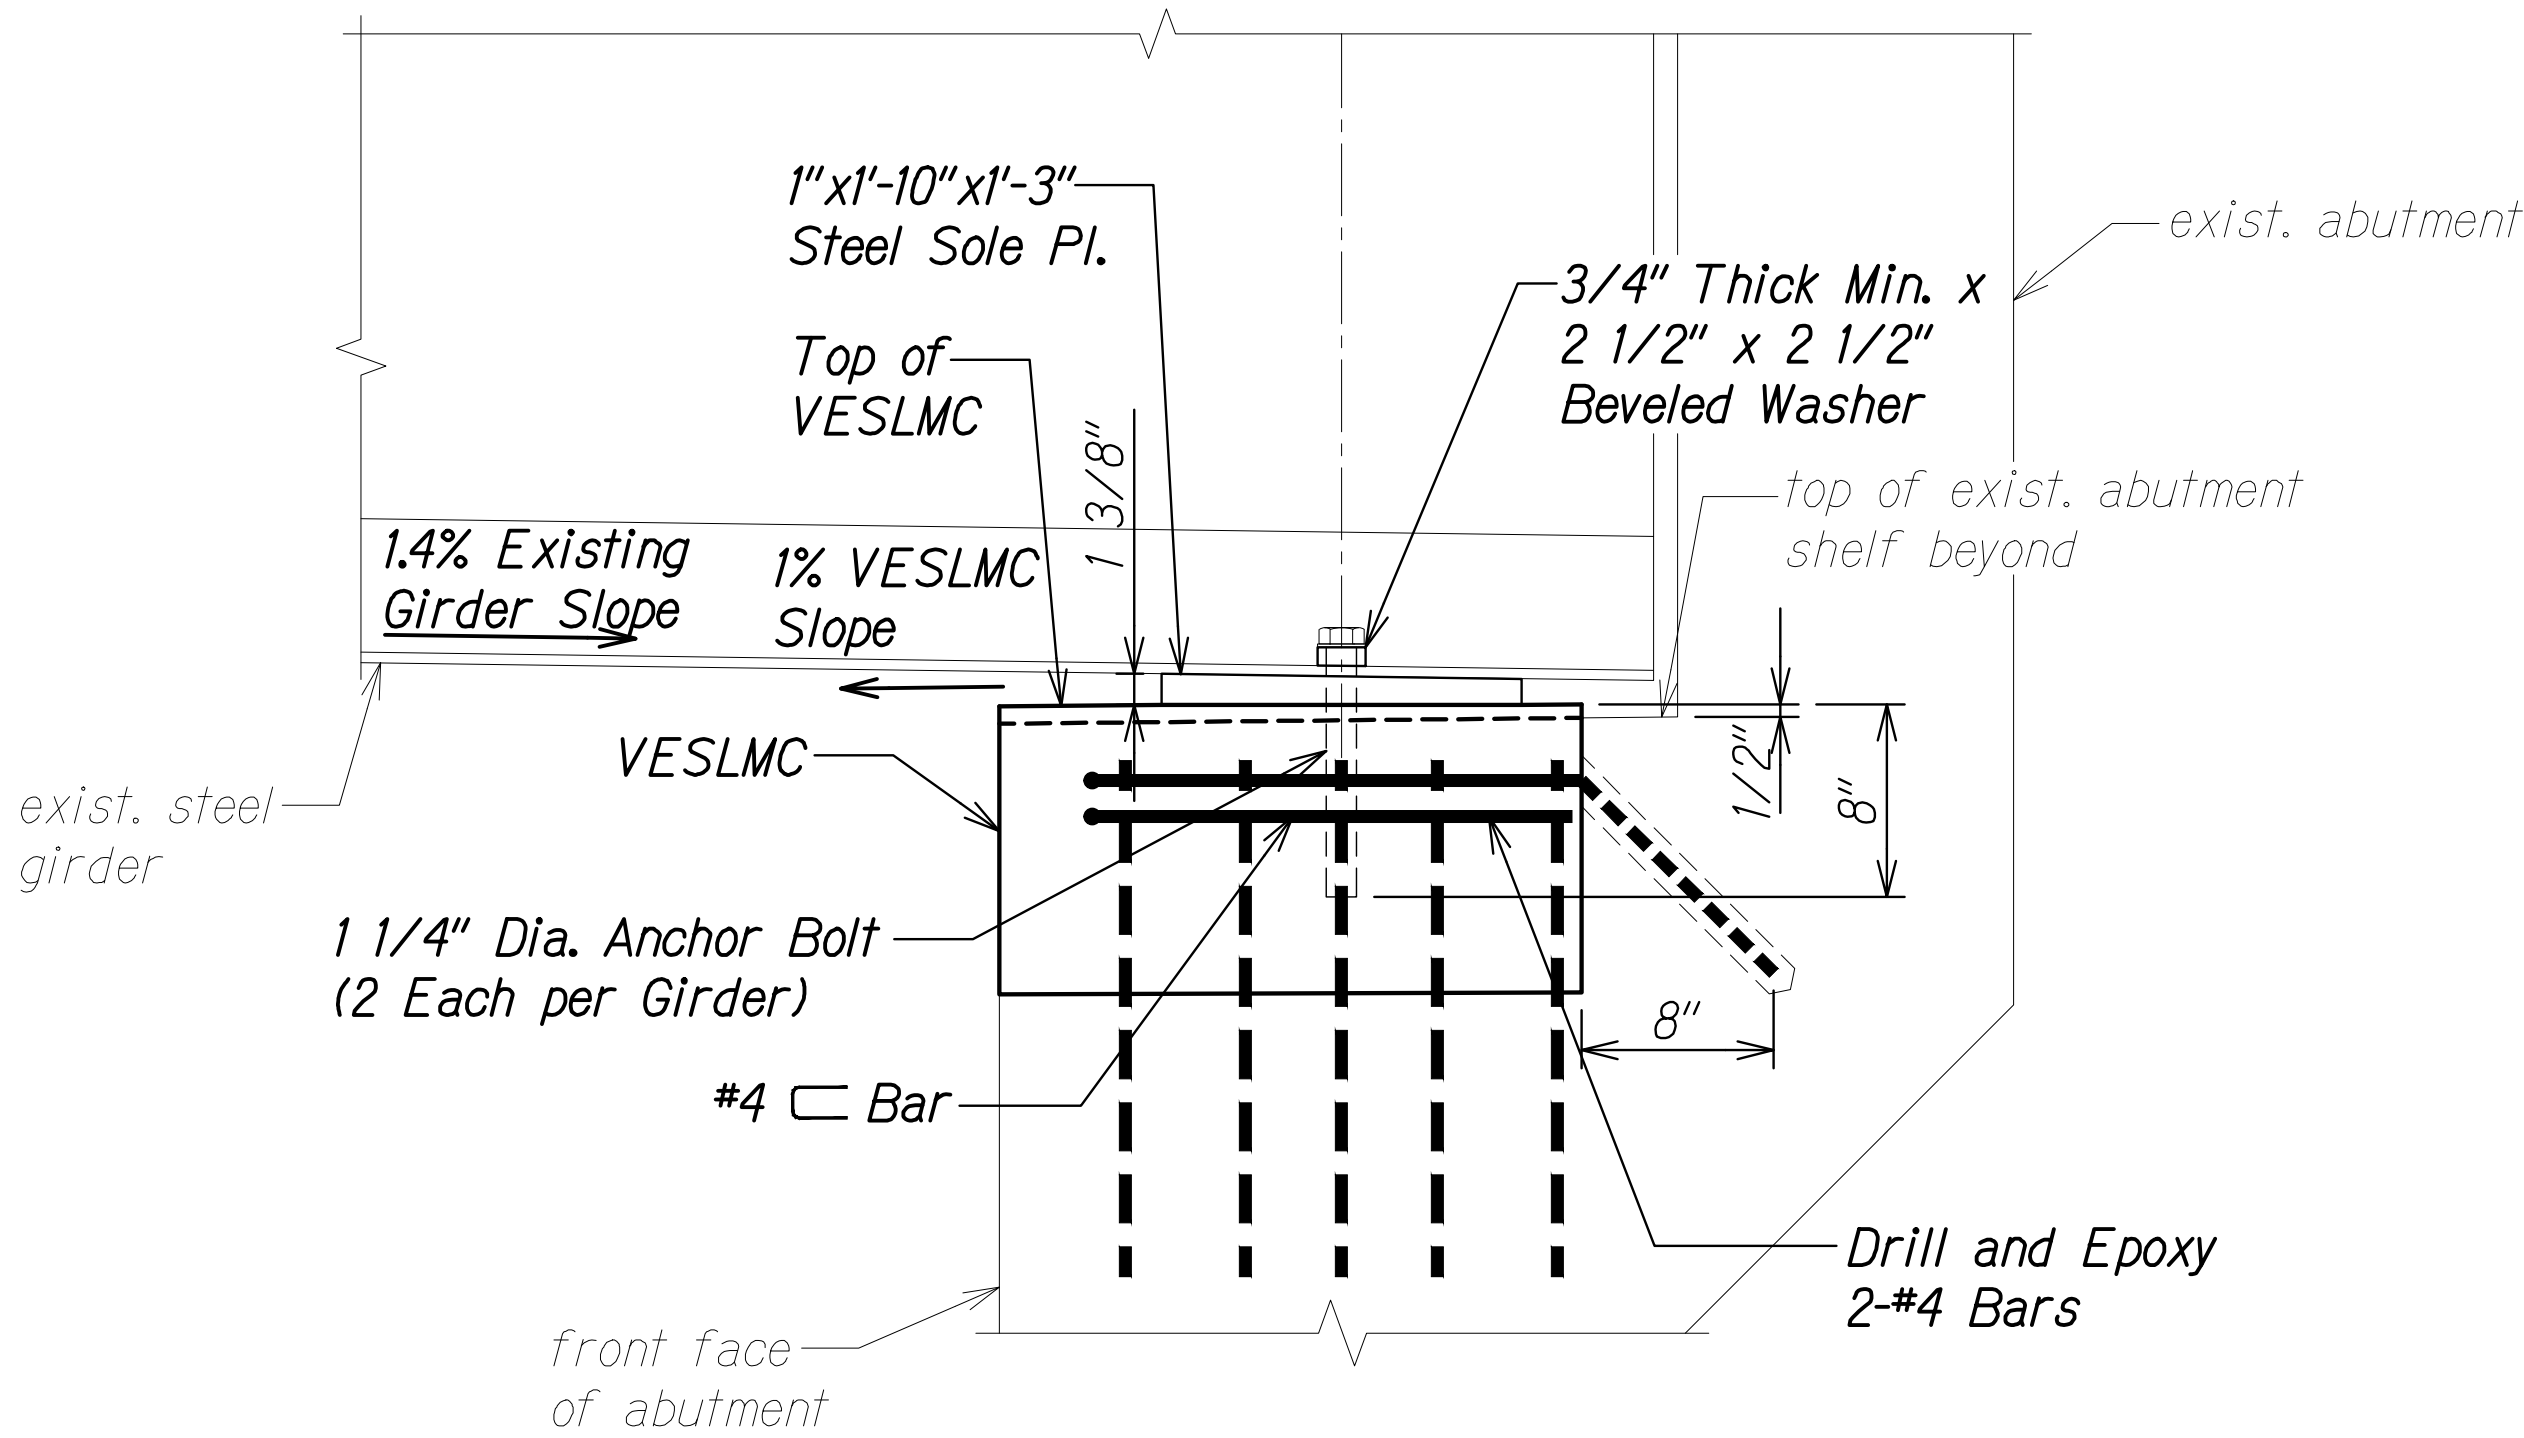


SECTION D
Scale: 1 1/2" = 1'-0" SA3.6 SA3.6

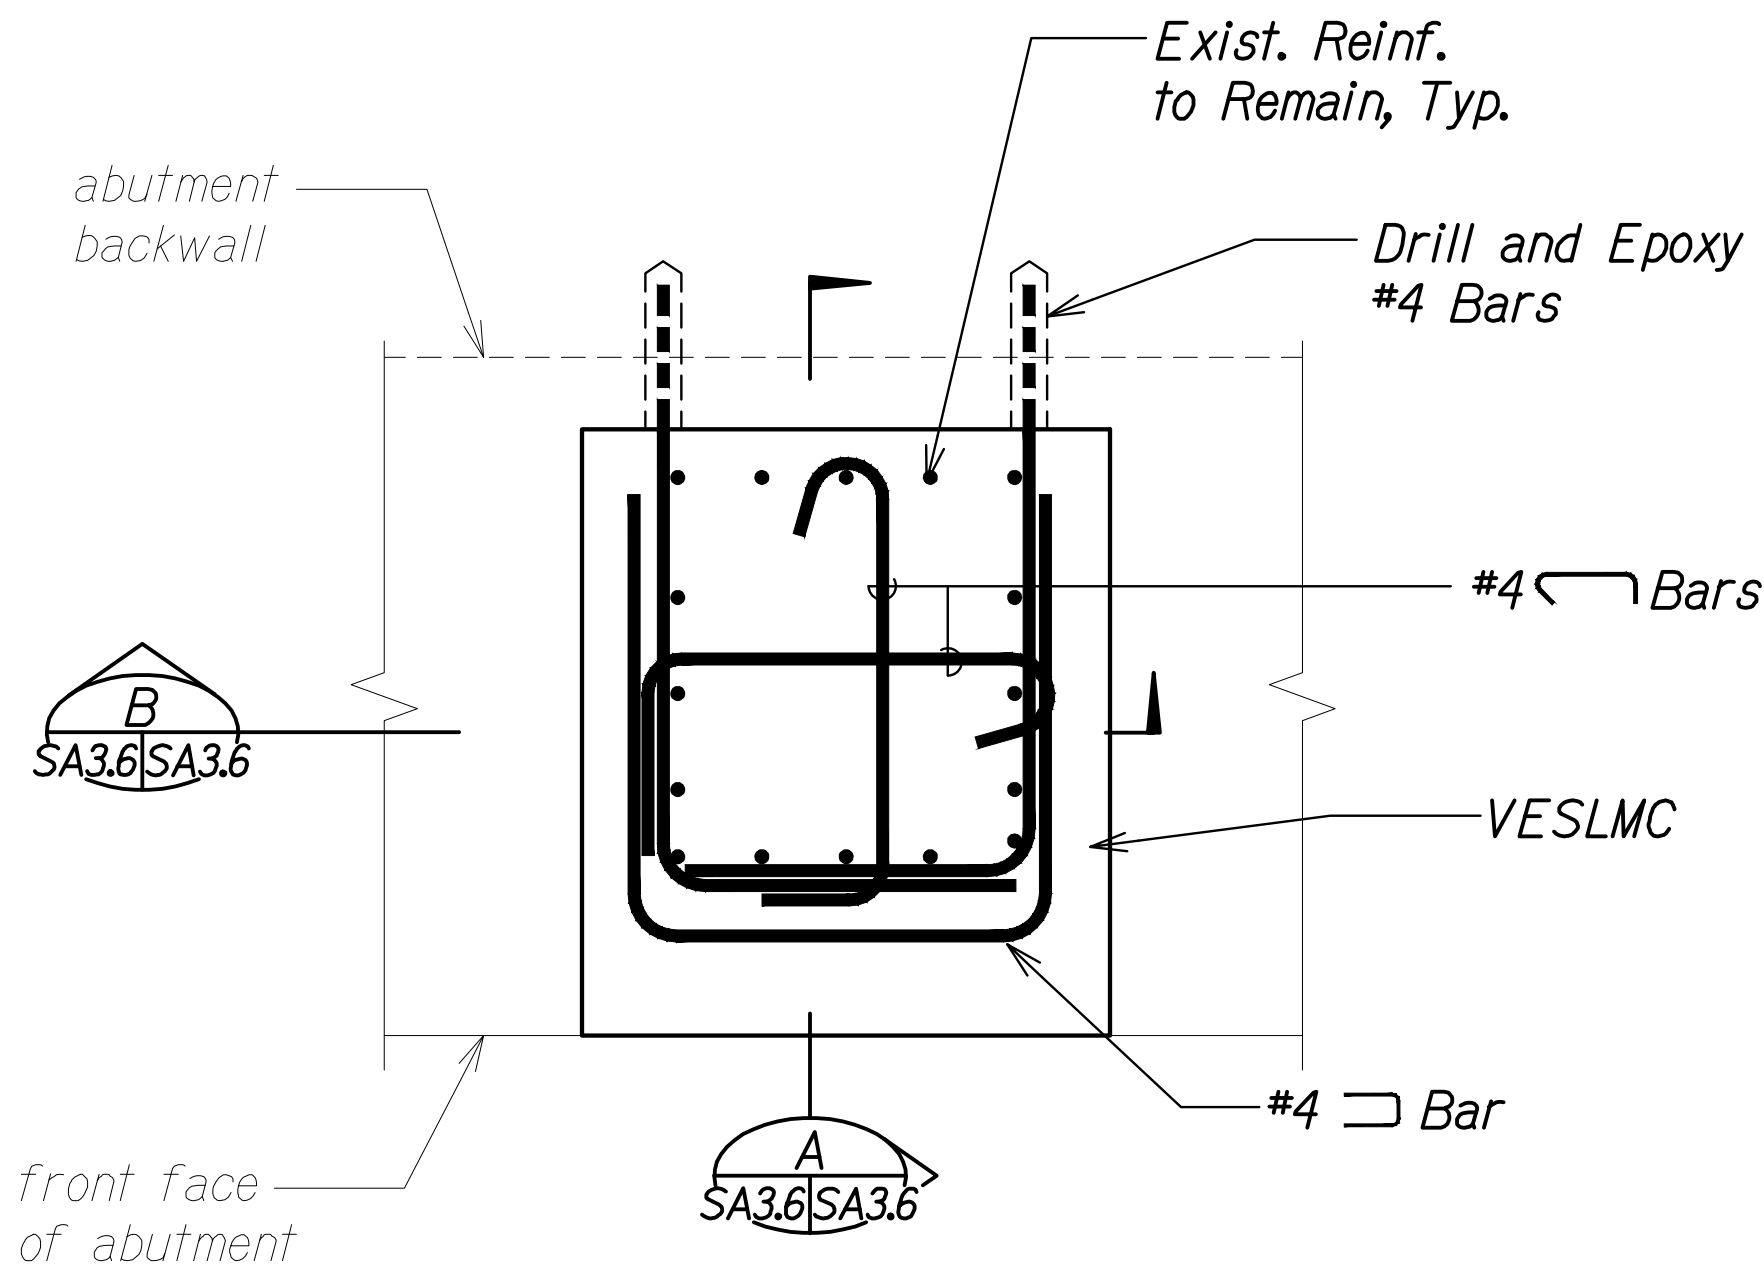

PLAN
Scale: 1 1/2" = 1'-0" SA3.6 SA3.6

NOTES:

1. Verify all dimensions and slopes in field before fabricating any members.
2. Repair all welds to bearing plates with zinc solder in accordance with ASTM A780, Painting of all bearings shall be incidental to Pay Item 666.1000.

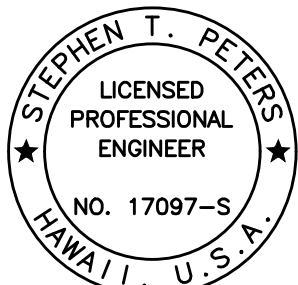

THIS WORK WAS PREPARED BY ME OR UNDER MY SUPERVISION.

SIGNATURE: *Stephen T. Peters* EXPIRATION DATE OF THE LICENSE: 4-30-26

STATE OF HAWAII
DEPARTMENT OF TRANSPORTATION
HIGHWAYS DIVISION


ABUTMENT NO. 2
ABUTMENT SECTIONS
HAWAII BELT ROAD
Nanue Stream Bridge Rehabilitation
Federal Aid Project No. BR-019-2(077)

Scale: As Noted Date: Oct. 2024


SHEET No. SA3.6 OF 7 SHEETS

12/6/24	1	Revised Scale and Added Note
DATE	REVISION	


FED. ROAD DIST. NO.	STATE	FEDERAL AID PROJ. NO.	FISCAL YEAR	SHEET NO.	TOTAL SHEETS
HAWAII	HAW.	BR-019-2(077)	2024	ADD. 55	280

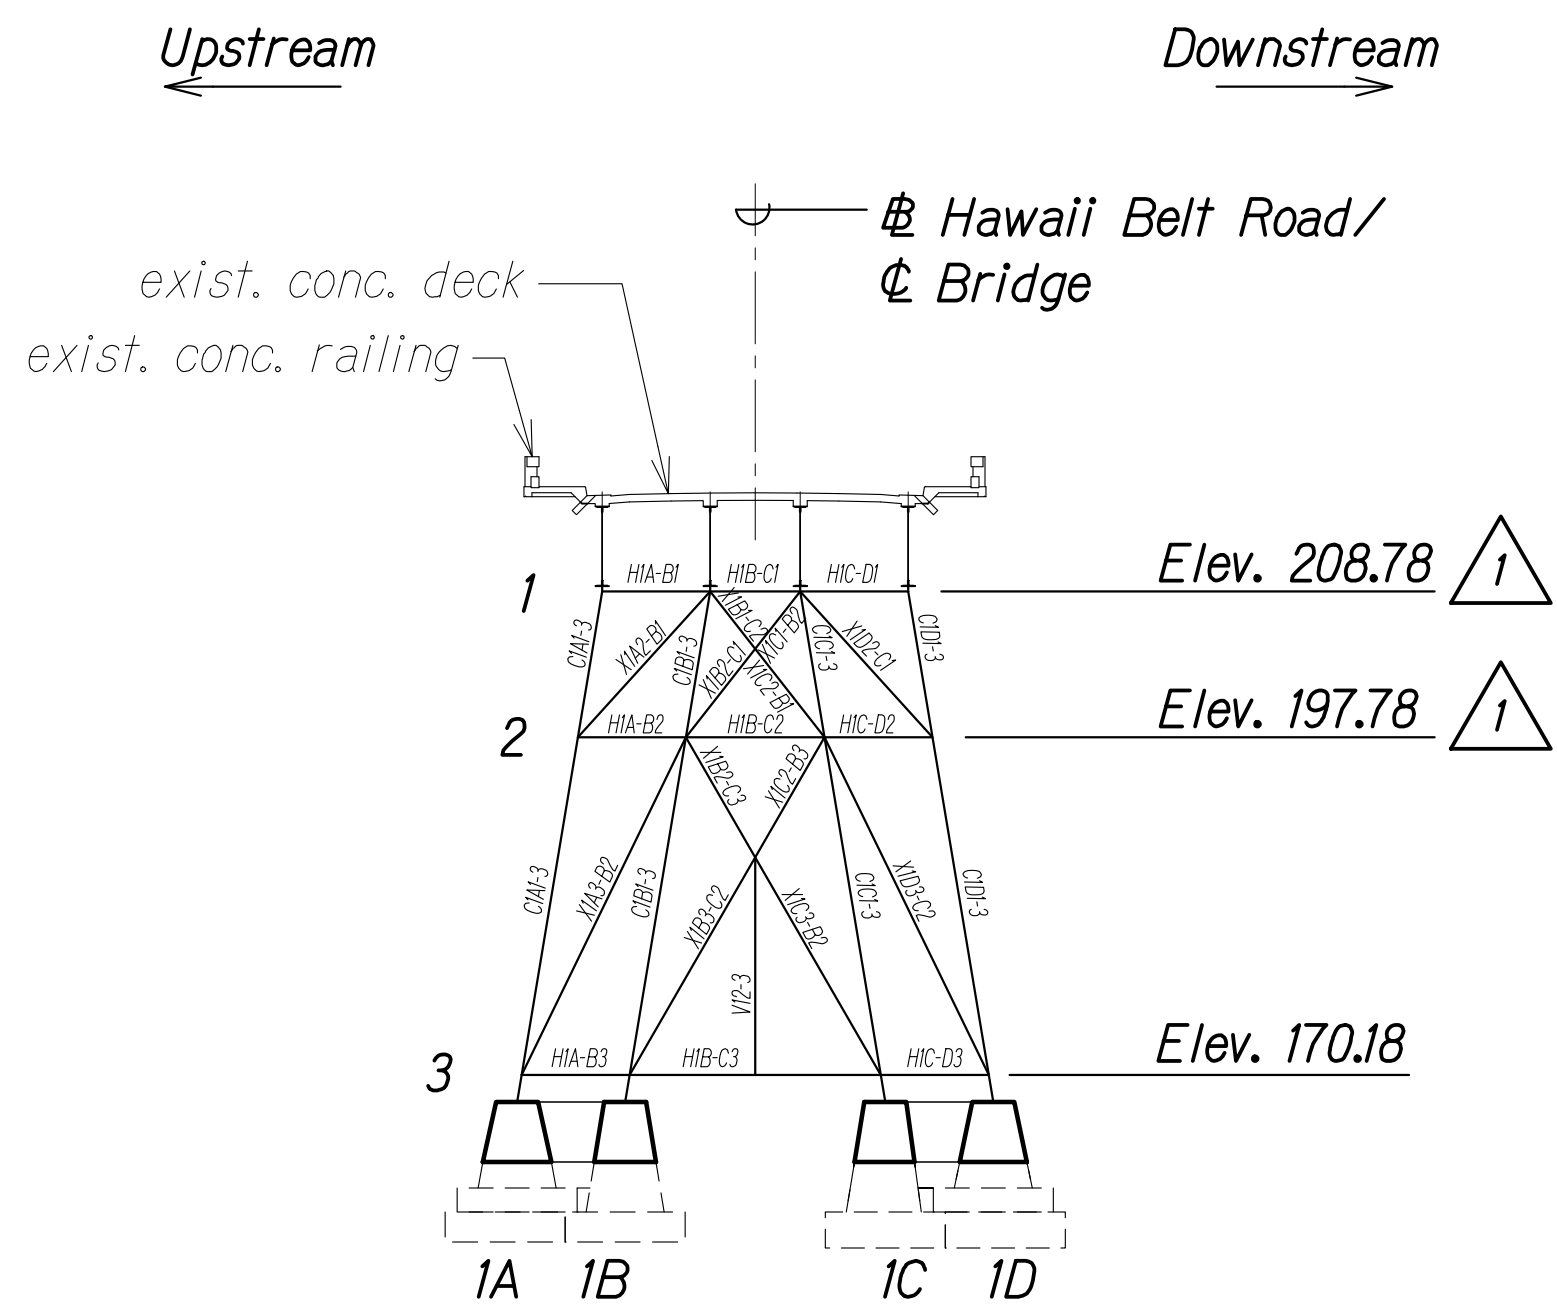


BENT NO. 1 ELEVATION
Scale: 1/16" = 1'-0"

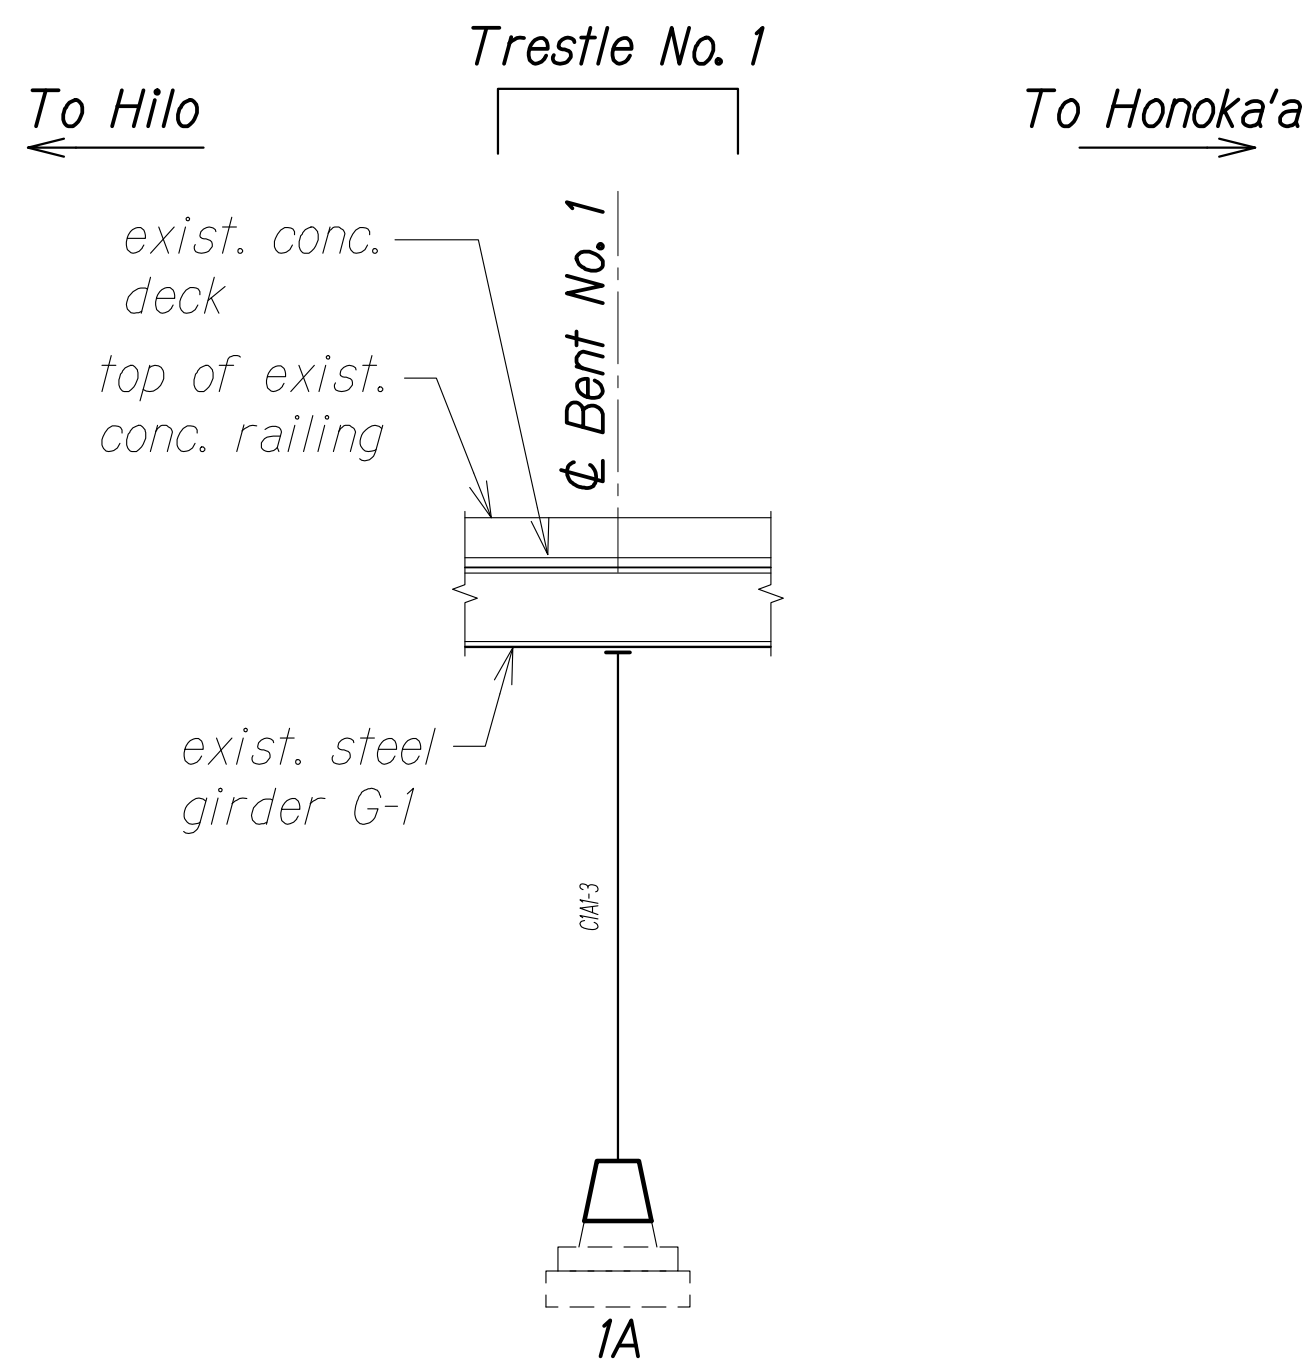


TRESTLE NO. 1 ELEVATION - COLUMN LINE "A"
Scale: 1/16" = 1'-0"

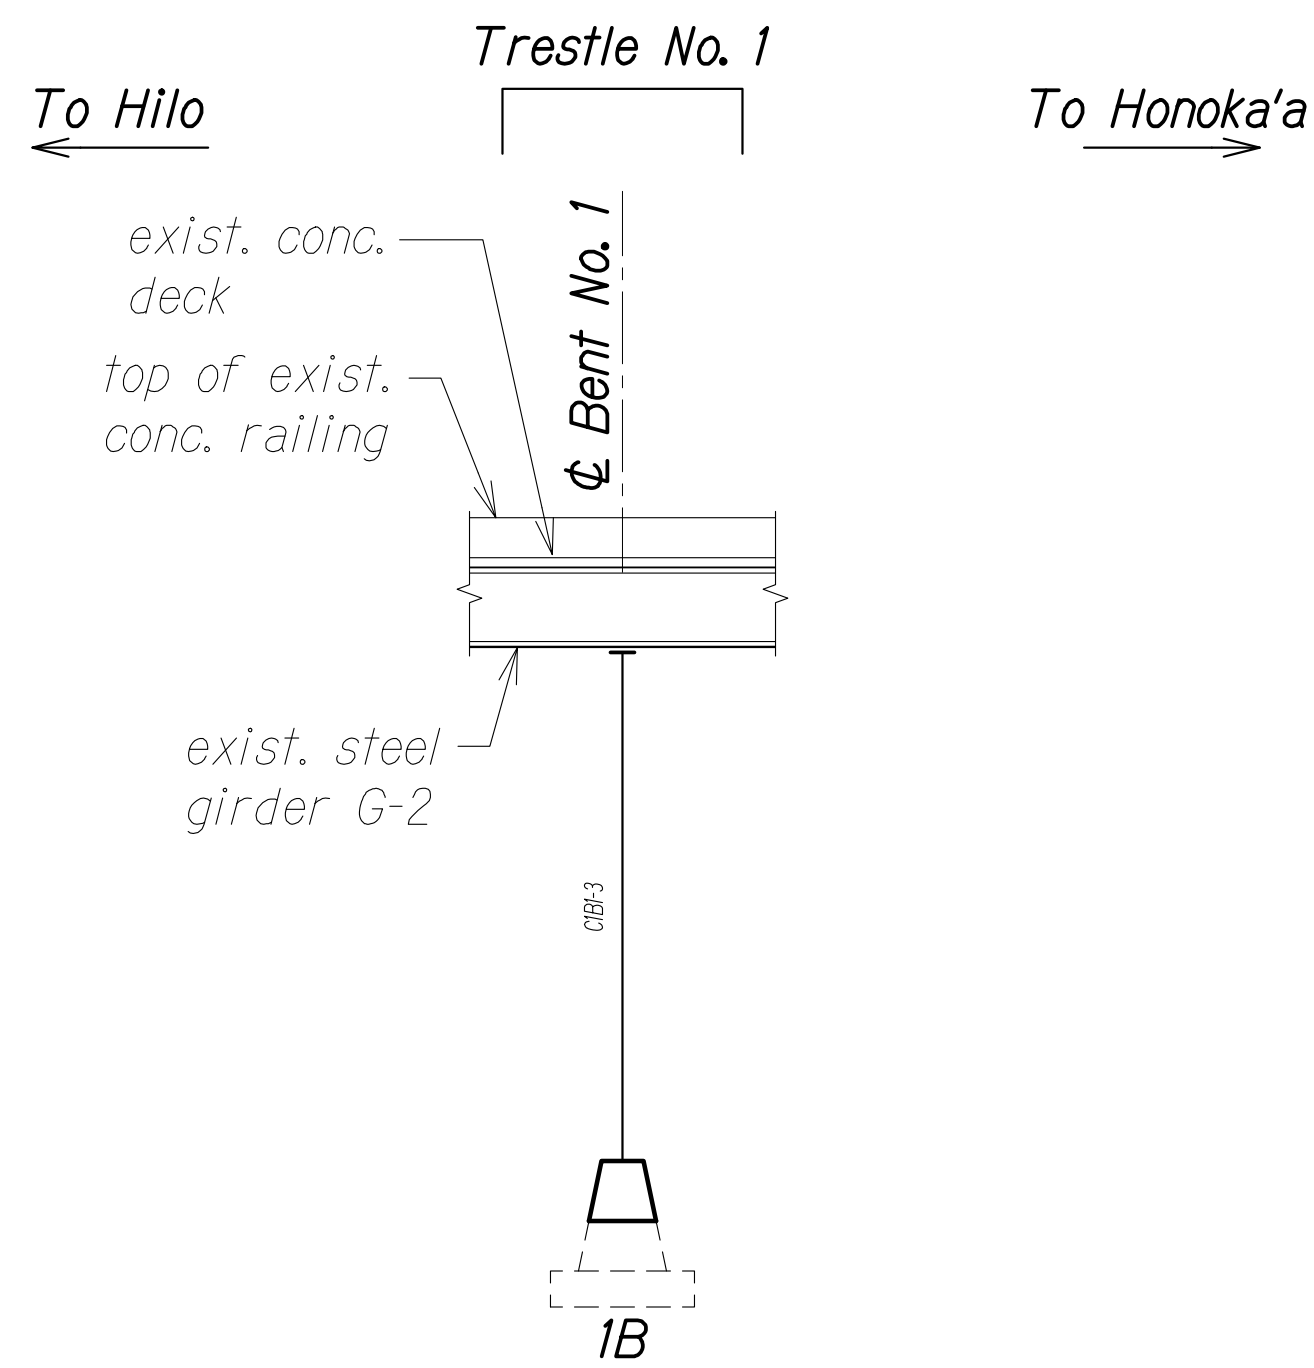


TRESTLE NO. 1 ELEVATION - COLUMN LINE "B"
Scale: 1/16" = 1'-0"

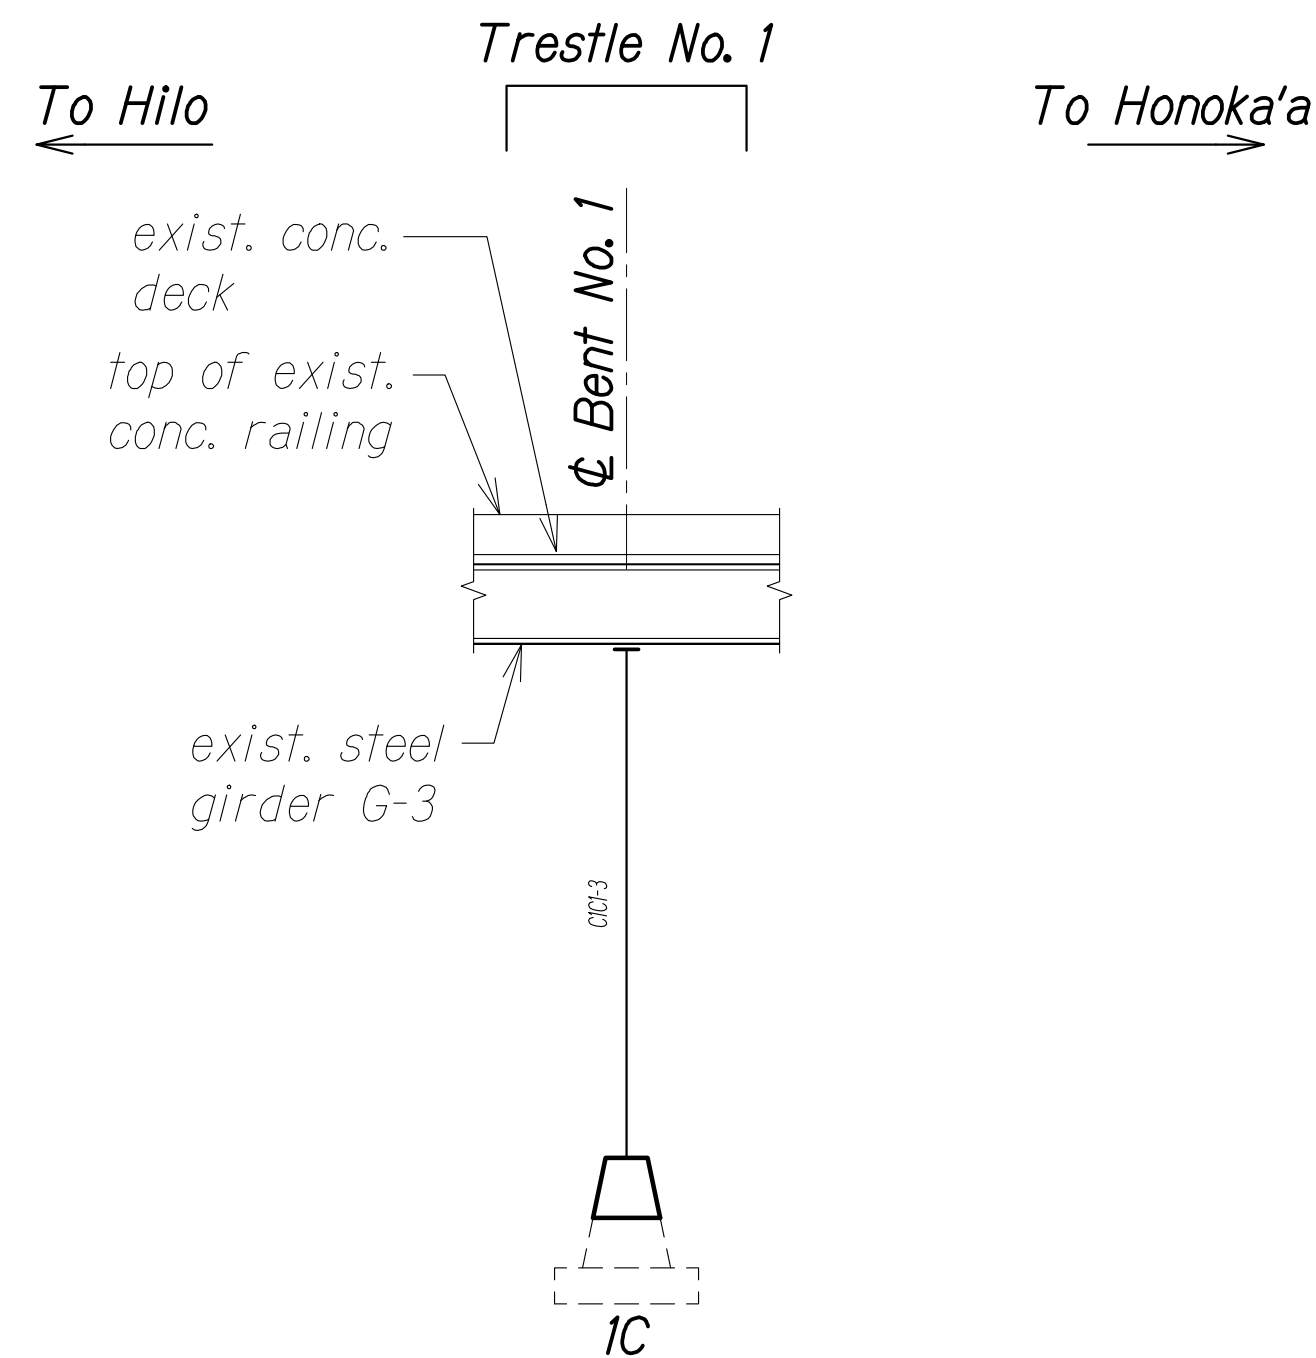

TRESTLE NO. 1 ELEVATION - COLUMN LINE "C"
Scale: 1/16" = 1'-0"

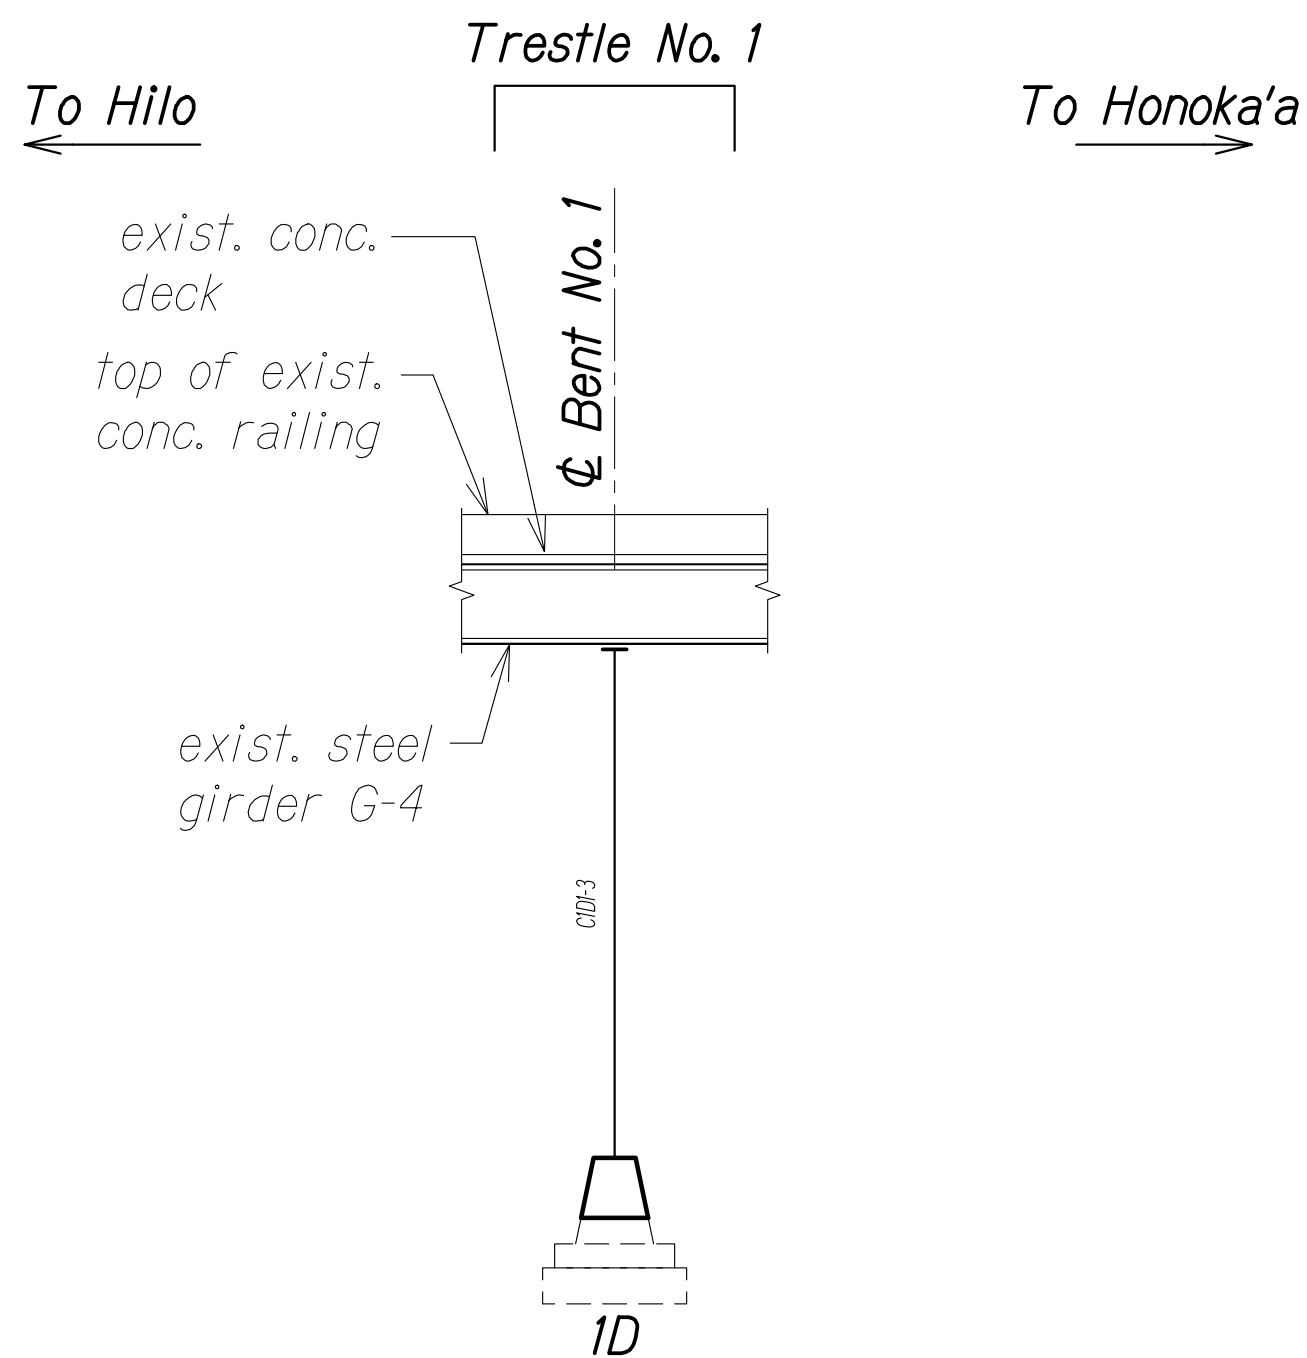


TRESTLE NO. 1 ELEVATION - COLUMN LINE "D"
Scale: 1/16" = 1'-0"

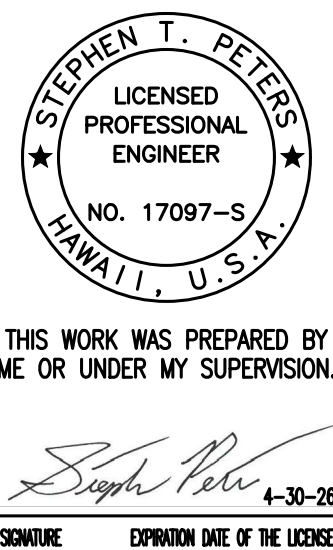

12/6/24	1	Revised Elevations
DATE		REVISION
STATE OF HAWAII DEPARTMENT OF TRANSPORTATION HIGHWAYS DIVISION		
BENT NO. 1/TRESTLE NO. 1 MEMBER ELEVATIONS		
HAWAII BELT ROAD Nanue Stream Bridge Rehabilitation Federal Aid Project No. BR-019-2(077)		
Scale: As Noted		Date: Oct. 2024
SHEET No. SA4.3 OF 20 SHEETS		

FED. ROAD DIST. NO.	STATE	FEDERAL AID PROJ. NO.	FISCAL YEAR	SHEET NO.	TOTAL SHEETS
HAWAII	HAW.	BR-019-2(077)	2024	ADD. 56	280

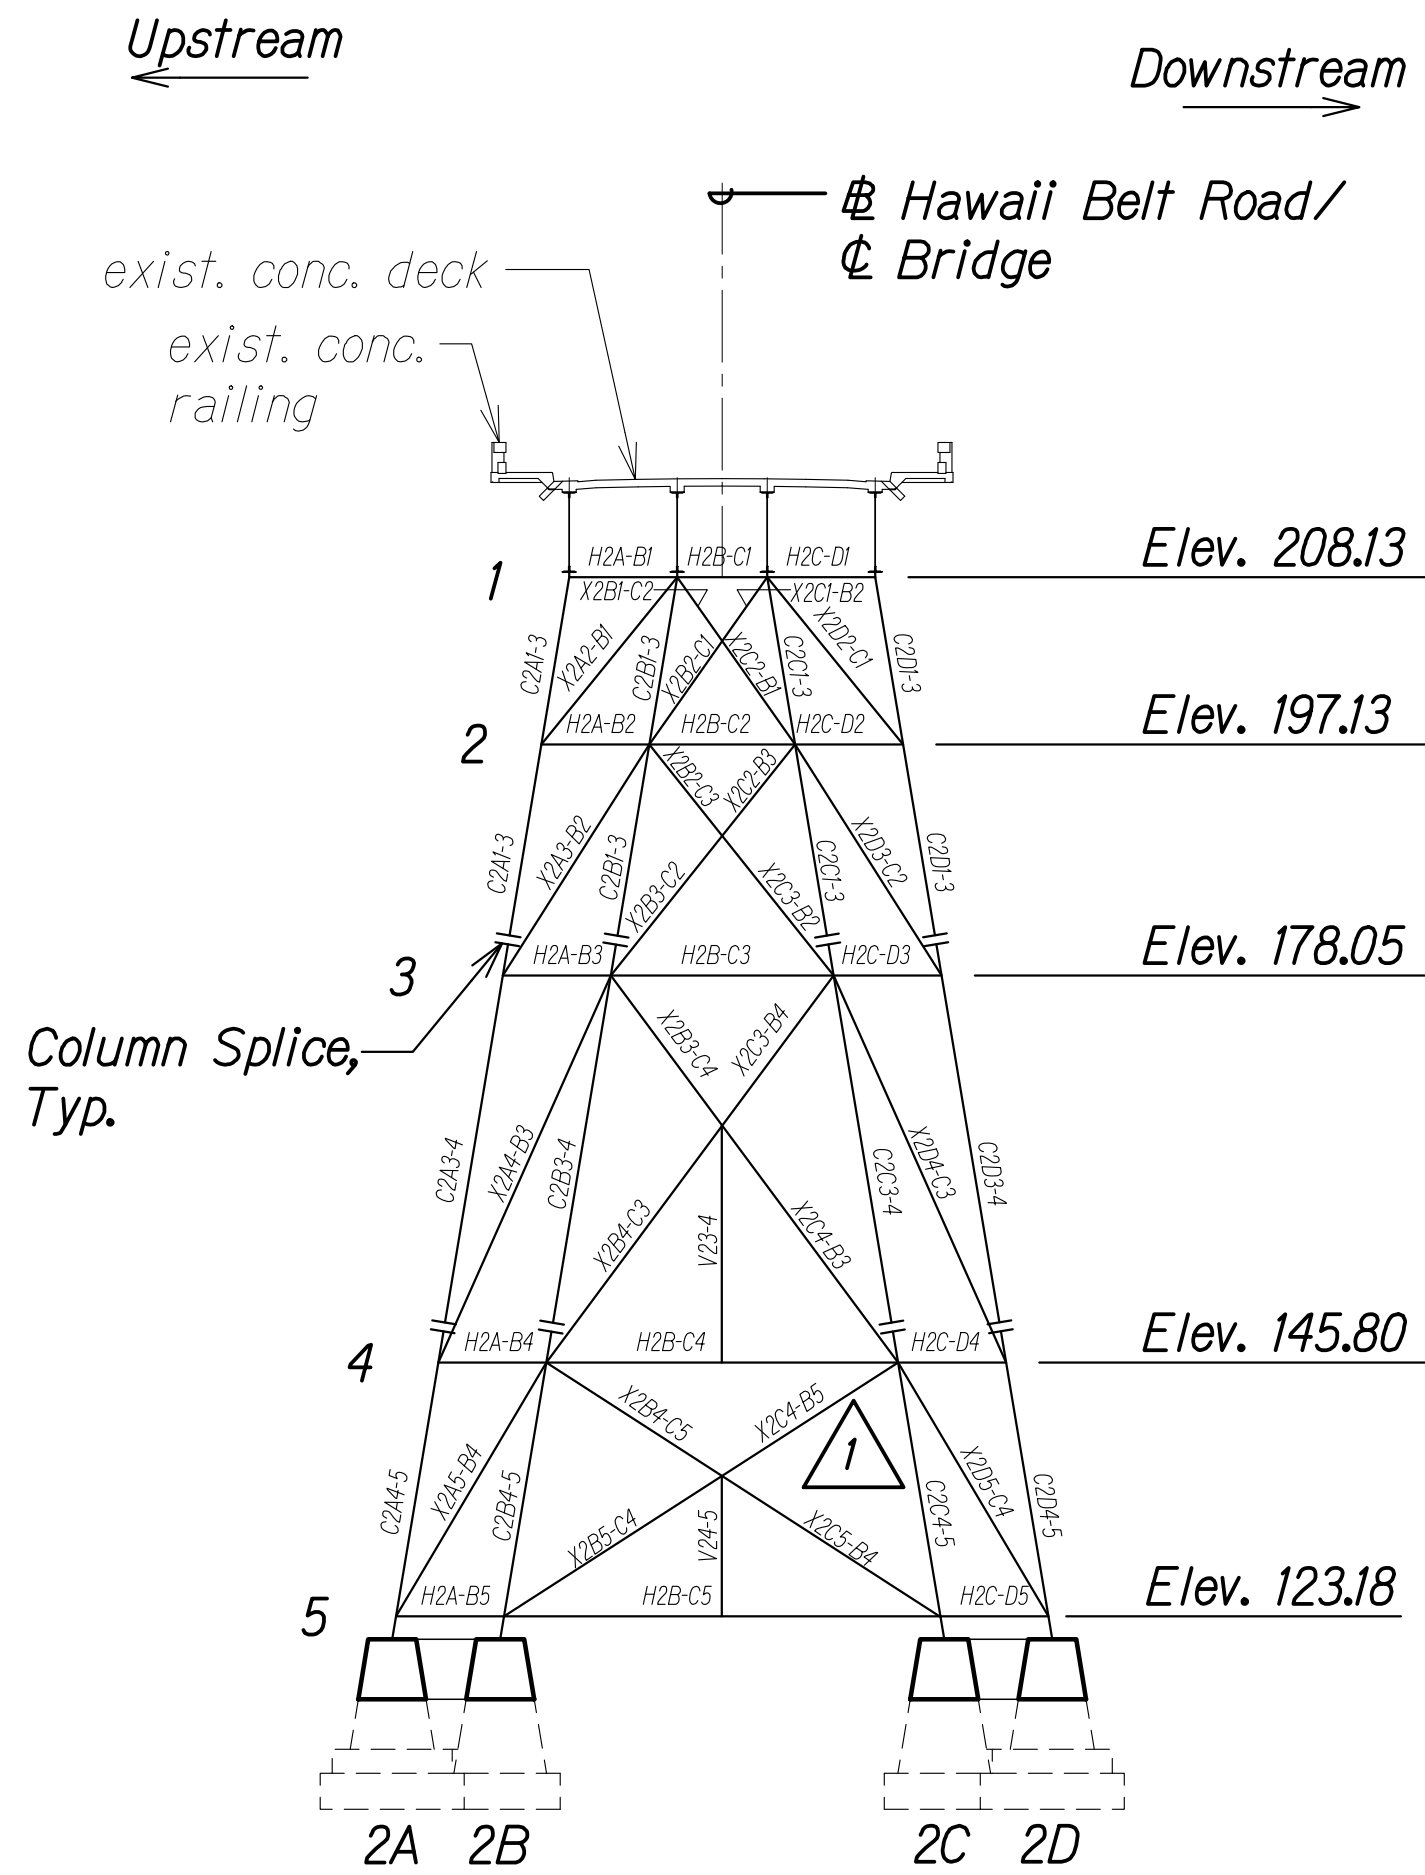


BENT NO. 2 ELEVATION

Scale: 1/16" = 1'-0"

A

SA4.4 SA4.4

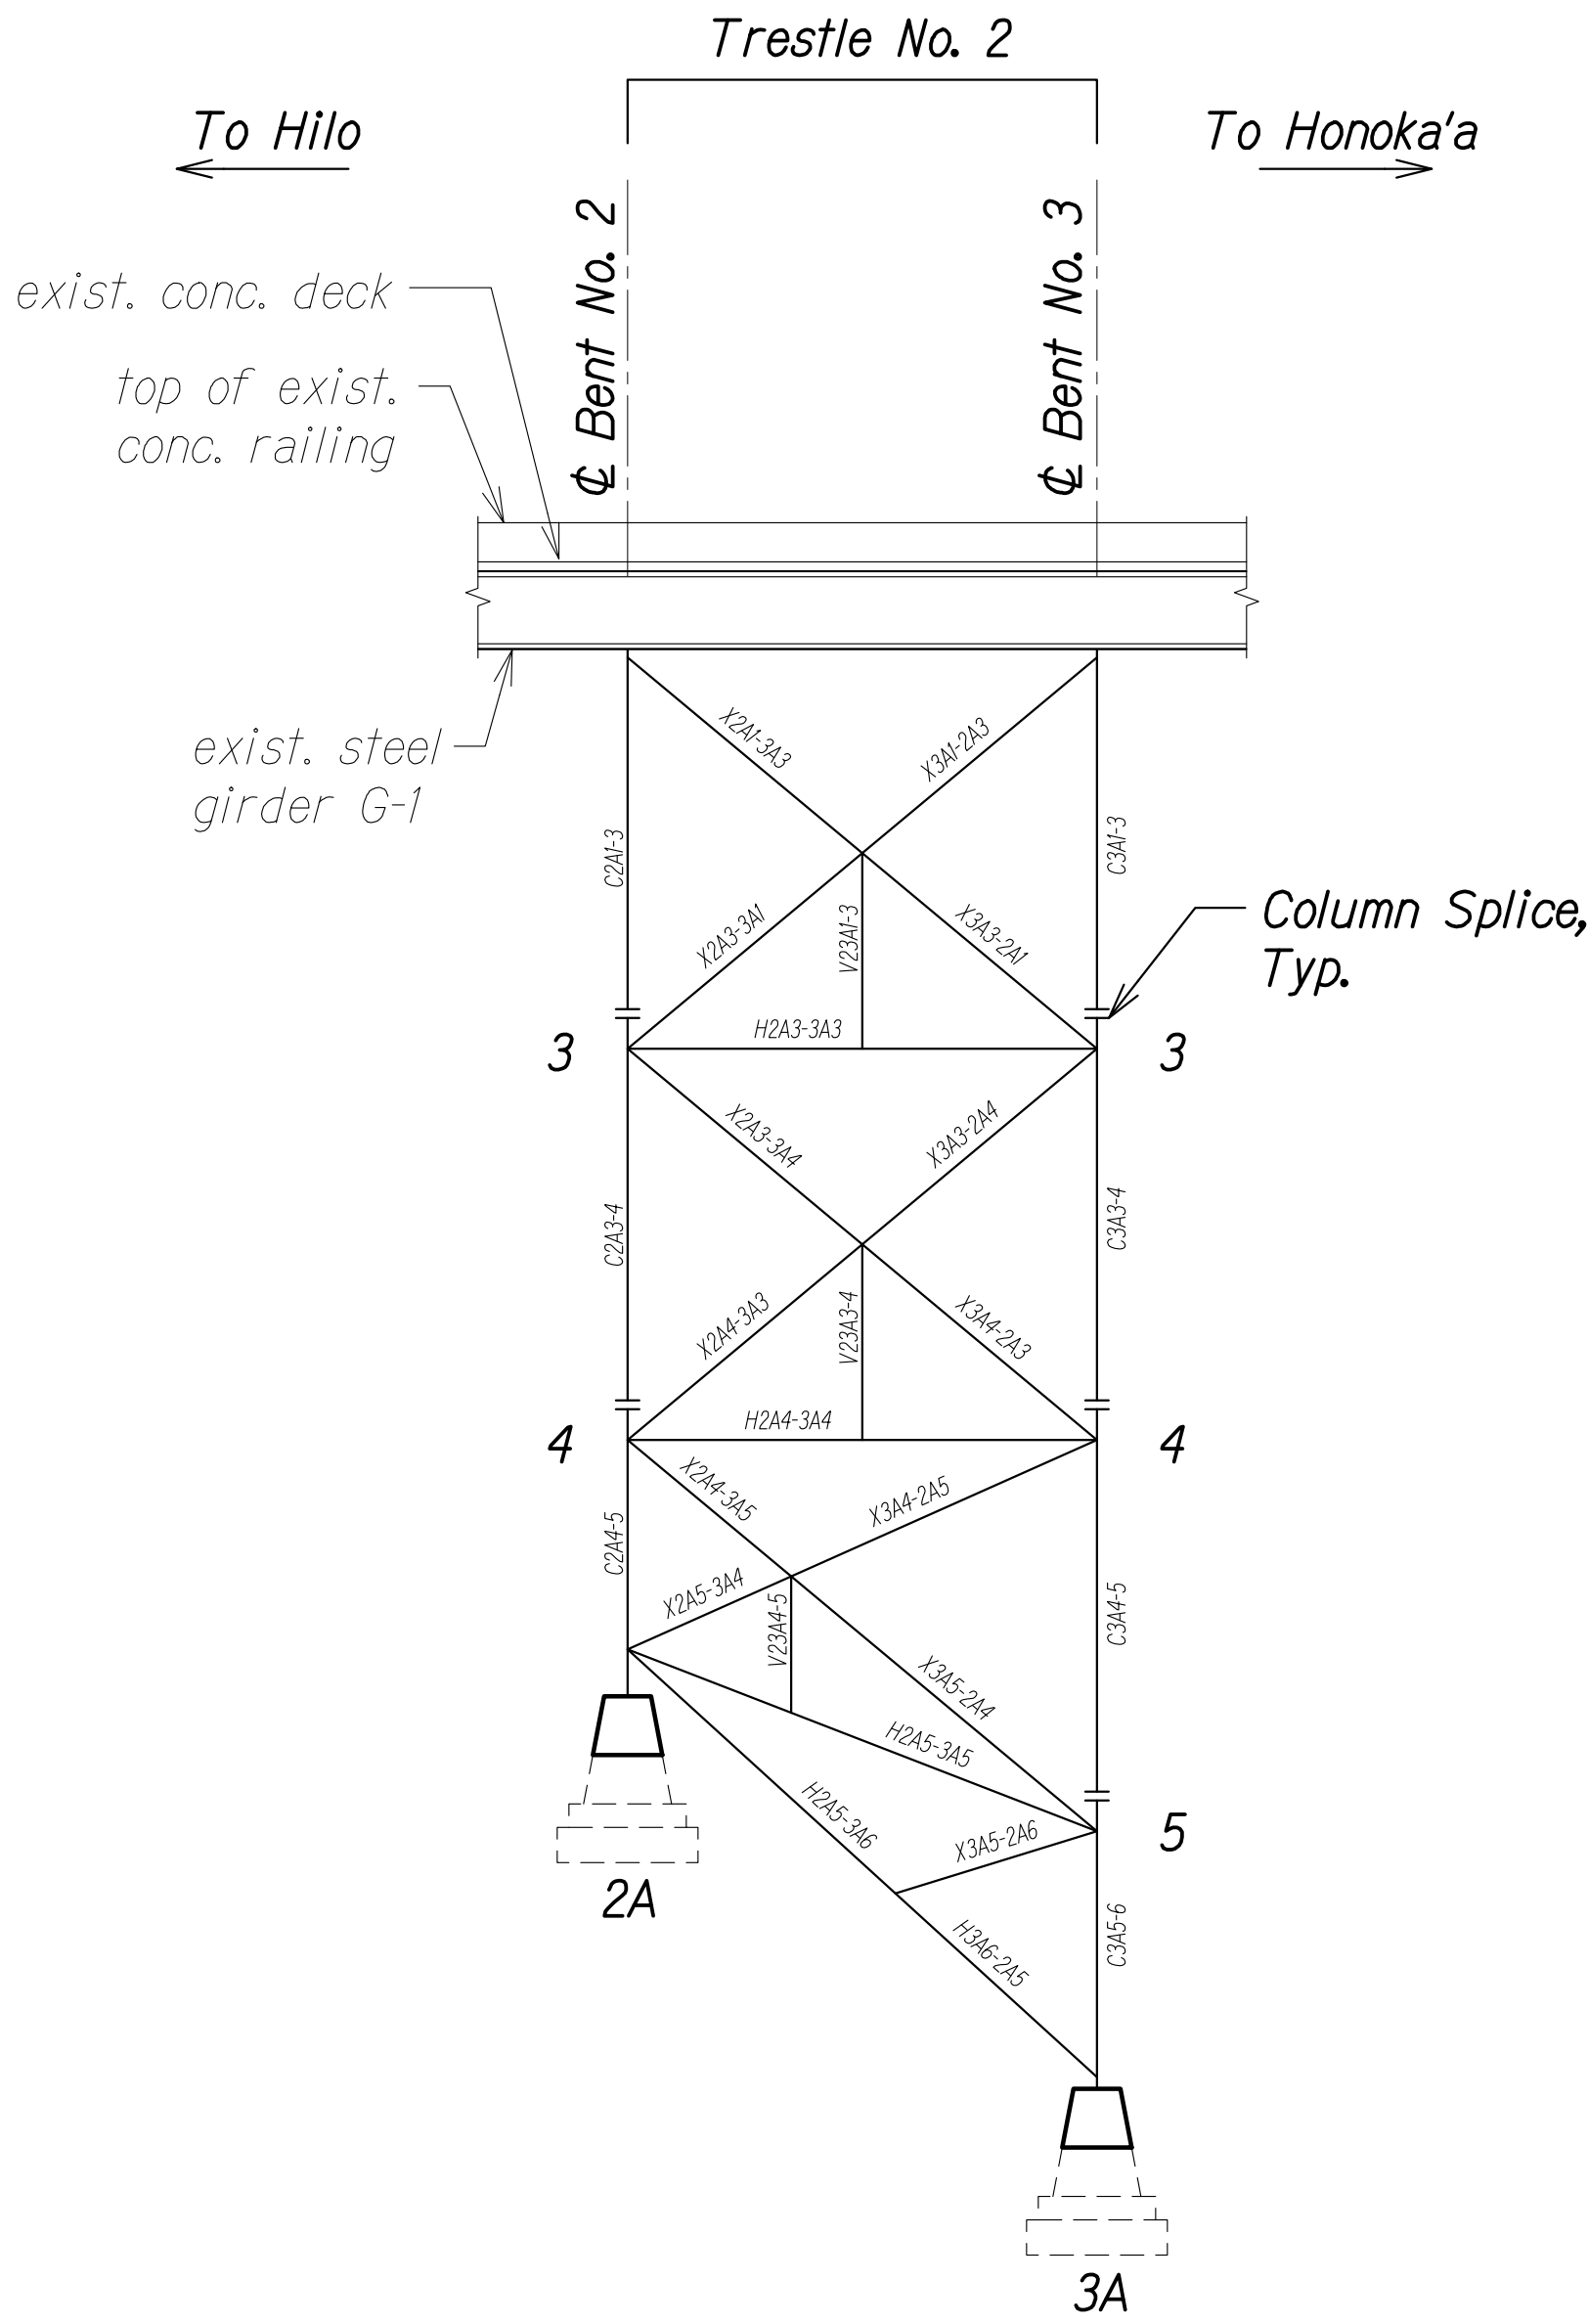


TRESTLE NO. 2 ELEVATION - COLUMN LINE "A"

Scale: 1/16" = 1'-0"

B

SA4.4 SA4.4

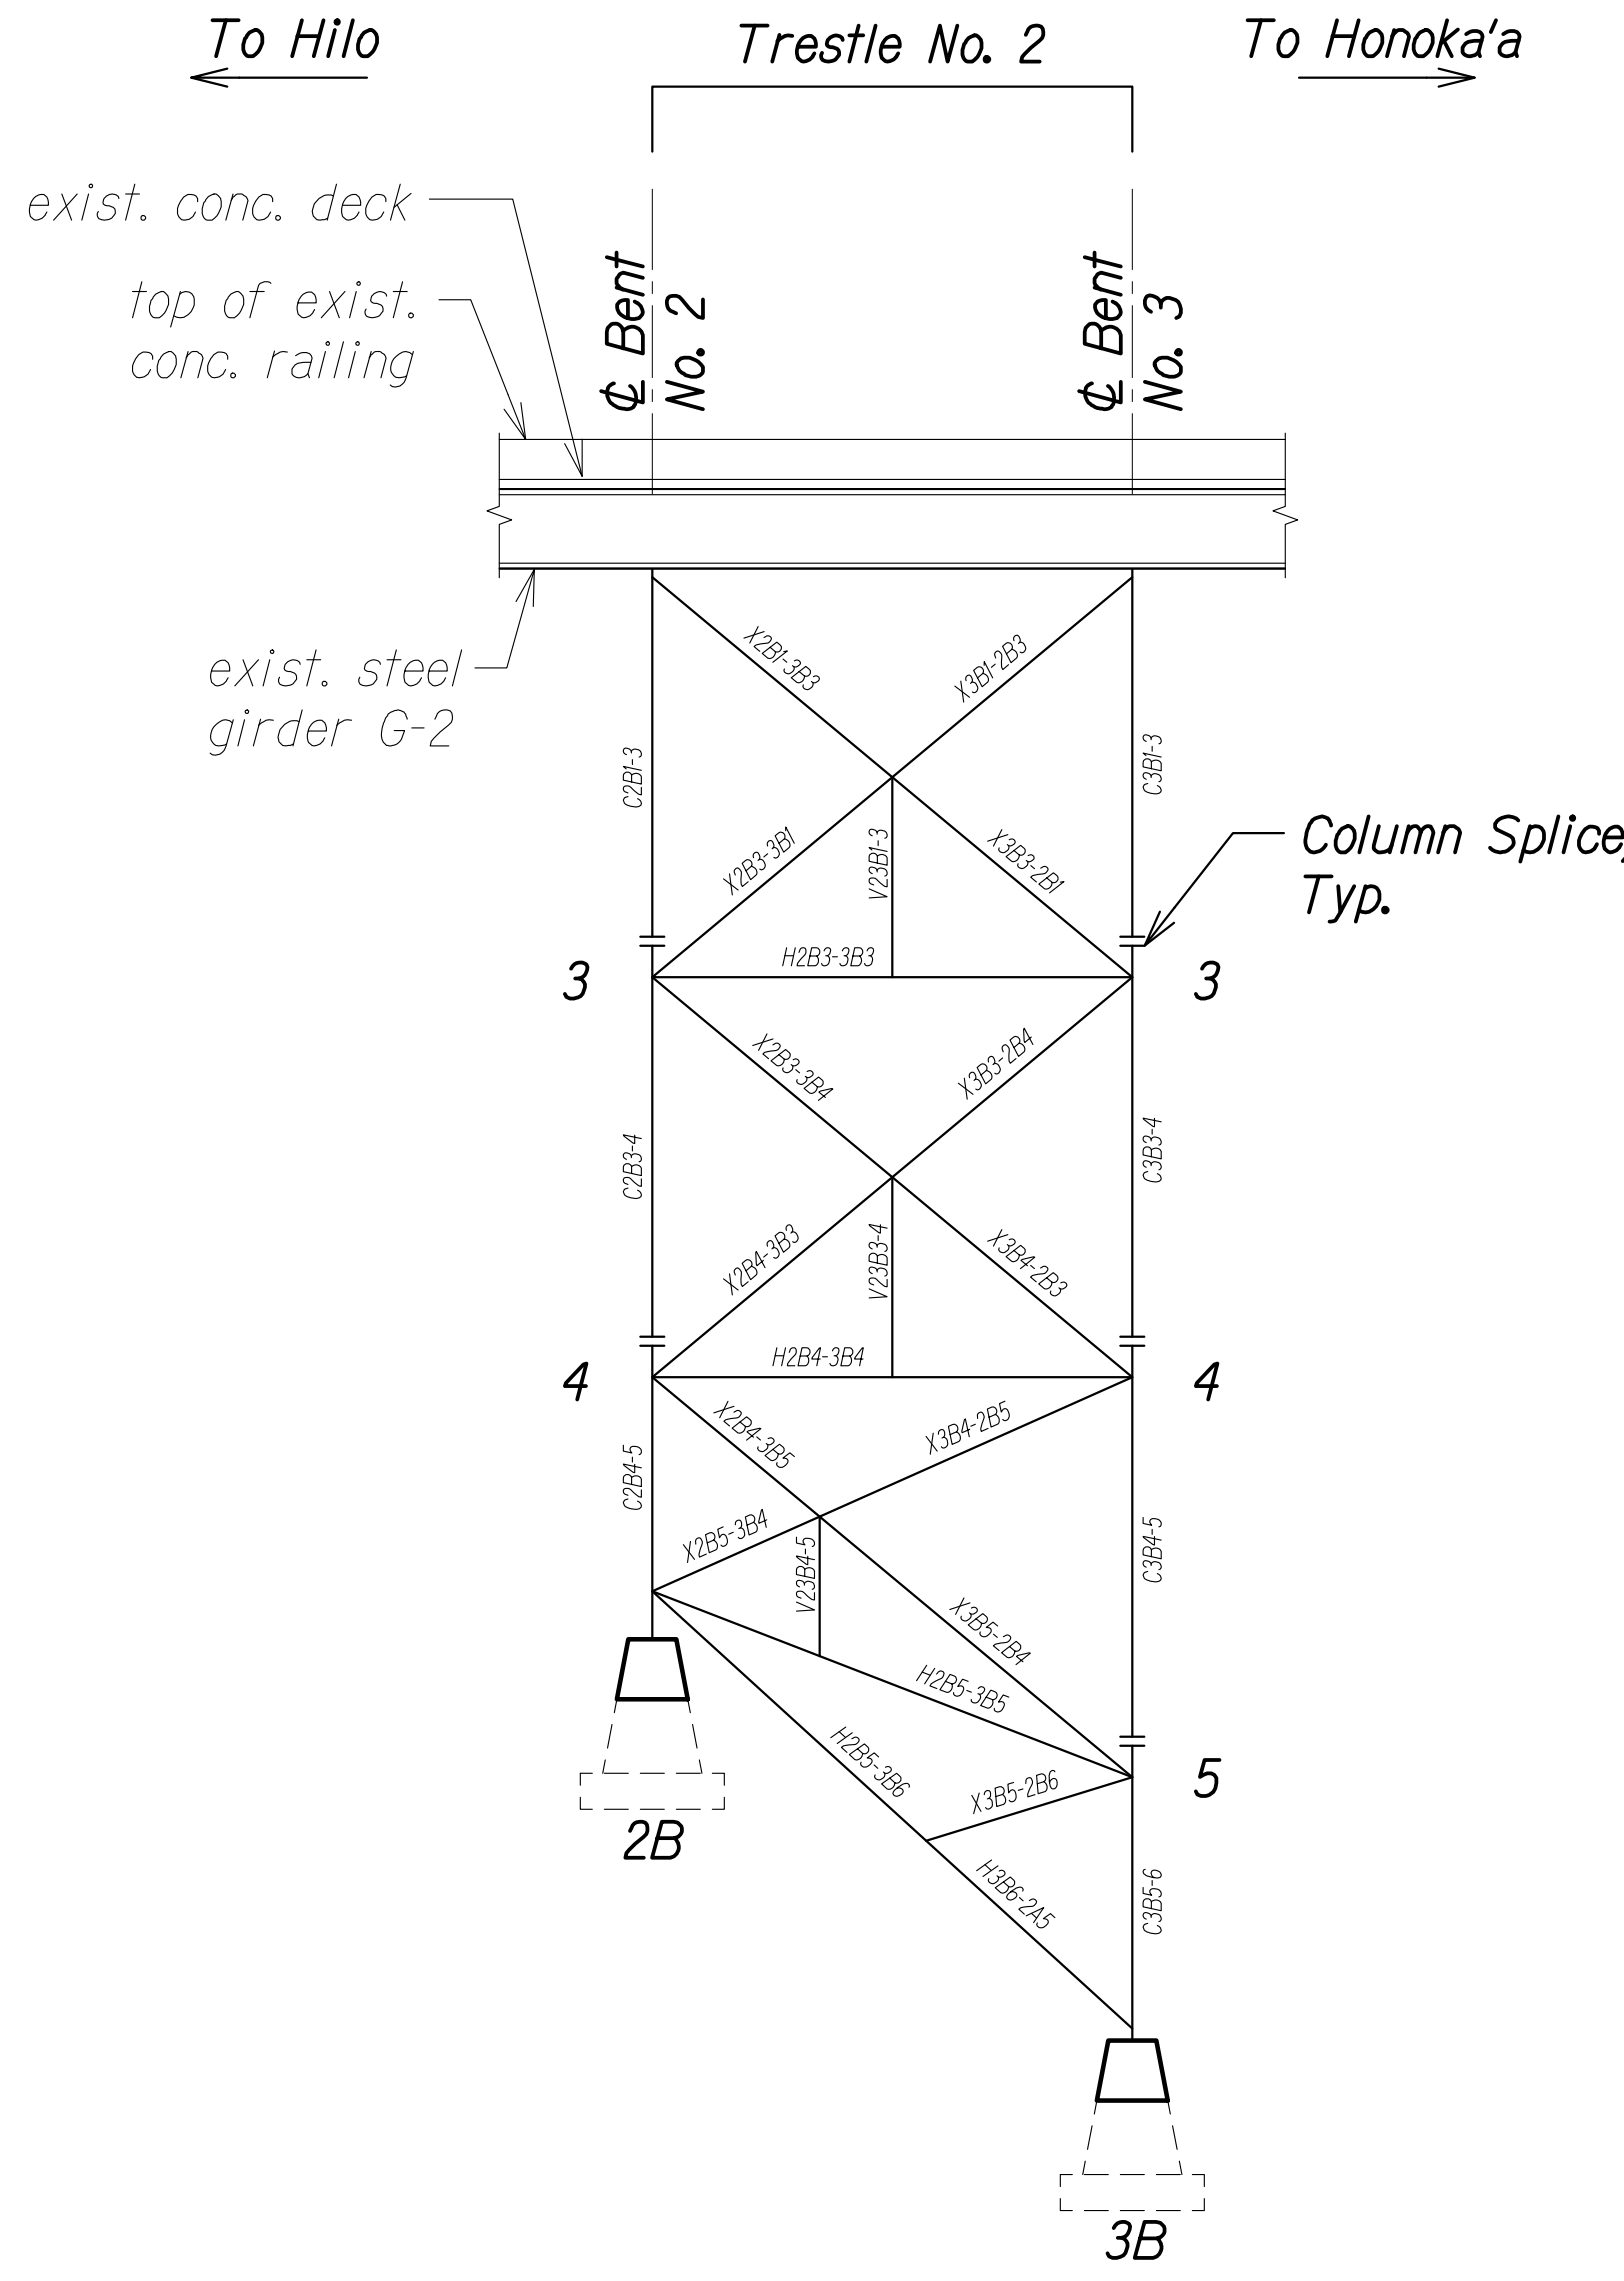

TRESTLE NO. 2 ELEVATION - COLUMN LINE "B"


Scale: 1/16" = 1'-0"

C

SA4.4 SA4.4

ORIGINAL PLAN	SURVEY PLOTTED BY	DATE
NOTE BOOK	DRAWN BY	
No.	DESIGNED BY	
	QUANTITIES BY	
	CHECKED BY	

DRAWING NAME: Z:\00 ONGOING\23-022.9-NANUE STR BR PF2-DOT\A.01 CAD\12-06-24 ADD\NSR-SA0401-SA410 BENT-TRESTLES ADD2.DWG PLOT TIME: 12-03-24 9:52 PM

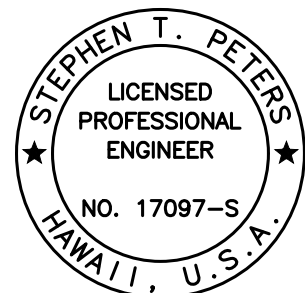

THIS WORK WAS PREPARED BY ME OR UNDER MY SUPERVISION.

SIGNATURE EXPIRATION DATE OF THE LICENSE

12/6/24	<div>1</div>	Revised Label
DATE	REVISION	
STATE OF HAWAII DEPARTMENT OF TRANSPORTATION HIGHWAYS DIVISION		
<u>BENT NO. 2/TRESTLE NO. 2</u>		
<u>MEMBER ELEVATIONS</u>		
<u>HAWAII BELT ROAD</u>		
<u>Nanue Stream Bridge Rehabilitation</u>		
<u>Federal Aid Project No. BR-019-2(077)</u>		
Scale: As Noted		Date: Oct. 2024

SHEET No. SA4.4 OF 20 SHEETS

FED. ROAD DIST. NO.	STATE	FEDERAL AID PROJ. NO.	FISCAL YEAR	SHEET NO.	TOTAL SHEETS
HAWAII	HAW.	BR-019-2(077)	2024	ADD. 85	280

BENT UPPER INTERIOR DIAGONAL BRACE SCHEDULE

BENT NO. 1	MEMBER ID	"A"	BATTEN PLATE SPACES	
	X1B1-C2	1'-6"	1 Eq. Spaces	1
	X1C1-B2	1'-6"	1 Eq. Spaces	1
	X1B2-C1	1'-6"	2 Eq. Spaces	1
	X1C2-B1	1'-6"	2 Eq. Spaces	1
	X1B2-C3	1'-6"	4 Eq. Spaces	
	X1C2-B3	1'-6"	4 Eq. Spaces	
	X1B3-C2	1'-6"	9 Eq. Spaces	
	X1C3-B2	1'-6"	9 Eq. Spaces	
BENT NO. 2	X2B1-C2	1'-6"	1 Eq. Spaces	1
	X2C1-B2	1'-6"	1 Eq. Spaces	1
	X2B2-C1	1'-6"	2 Eq. Spaces	1
	X2C2-B1	1'-6"	2 Eq. Spaces	1
	X2B2-C3	1'-6"	3 Eq. Spaces	
	X2C2-B3	1'-6"	3 Eq. Spaces	
	X2B3-C2	1'-6"	6 Eq. Spaces	
	X2C3-B2	1'-6"	6 Eq. Spaces	
	X2B3-C4	1'-6"	6 Eq. Spaces	
	X2C3-B4	1'-6"	6 Eq. Spaces	
	X2B4-C3	1'-6"	11 Eq. Spaces	
	X2C4-B3	1'-6"	11 Eq. Spaces	
	X2B4-C5	1'-6"	7 Eq. Spaces	
	X2C4-B5	1'-6"	7 Eq. Spaces	1
	X2B5-C4	1'-6"	10 Eq. Spaces	
	X2C5-B4	1'-6"	10 Eq. Spaces	
BENT NO. 3	X3B1-C2	1'-6"	1 Eq. Spaces	1
	X3C1-B2	1'-6"	1 Eq. Spaces	1
	X3B2-C1	1'-6"	2 Eq. Spaces	1
	X3C2-B1	1'-6"	2 Eq. Spaces	1
	X3B2-C3	1'-6"	3 Eq. Spaces	
	X3C2-B3	1'-6"	3 Eq. Spaces	
	X3B3-C2	1'-6"	6 Eq. Spaces	
	X3C3-B2	1'-6"	6 Eq. Spaces	
	X3B3-C4	1'-6"	6 Eq. Spaces	
	X3C3-B4	1'-6"	6 Eq. Spaces	
	X3B4-C3	1'-6"	11 Eq. Spaces	
	X3C4-B3	1'-6"	11 Eq. Spaces	
	X3B4-C5	1'-6"	9 Eq. Spaces	
	X3C4-B5	1'-6"	9 Eq. Spaces	
	X3B5-C4	1'-6"	12 Eq. Spaces	
	X3C5-B4	1'-6"	12 Eq. Spaces	
	X3B4-C6	1'-6"	10 Eq. Spaces	
	X3C5-B6	1'-6"	10 Eq. Spaces	
	X3B6-C5	1'-6"	12 Eq. Spaces	
	X3C6-B5	1'-6"	12 Eq. Spaces	

BENT UPPER INTERIOR DIAGONAL BRACE SCHEDULE

BENT NO. 4	MEMBER ID	"A"	BATTEN PLATE SPACES	
	X4B1-C2	1'-6"	1 Eq. Spaces	1
	X4C1-B2	1'-6"	1 Eq. Spaces	1
	X4B2-C1	1'-6"	2 Eq. Spaces	1
	X4C2-B1	1'-6"	2 Eq. Spaces	1
	X4B2-C3	1'-6"	3 Eq. Spaces	
	X4C2-B3	1'-6"	3 Eq. Spaces	
	X4B3-C2	1'-6"	6 Eq. Spaces	
	X4C3-B2	1'-6"	6 Eq. Spaces	
	X4B3-C4	1'-6"	6 Eq. Spaces	
	X4C3-B4	1'-6"	6 Eq. Spaces	
	X4B4-C3	1'-6"	11 Eq. Spaces	
	X4C4-B3	1'-6"	11 Eq. Spaces	
	X4B4-C5	1'-6"	9 Eq. Spaces	
	X4C4-B5	1'-6"	9 Eq. Spaces	
	X4B5-C4	1'-6"	12 Eq. Spaces	
BENT NO. 5	X5B1-C2	1'-6"	1 Eq. Spaces	1
	X5C1-B2	1'-6"	1 Eq. Spaces	1
	X5B2-C1	1'-6"	2 Eq. Spaces	1
	X5C2-B1	1'-6"	2 Eq. Spaces	1
	X5B2-C3	1'-6"	3 Eq. Spaces	
	X5C2-B3	1'-6"	3 Eq. Spaces	
	X5B3-C2	1'-6"	6 Eq. Spaces	
	X5C3-B2	1'-6"	6 Eq. Spaces	
	X5B3-C4	1'-6"	6 Eq. Spaces	
	X5C3-B4	1'-6"	6 Eq. Spaces	
	X5B4-C3	1'-6"	11 Eq. Spaces	
	X4C4-B3	1'-6"	11 Eq. Spaces	
	X5B4-C5	1'-6"	9 Eq. Spaces	
	X5C4-B5	1'-6"	9 Eq. Spaces	
	X5B5-C4	1'-6"	12 Eq. Spaces	
	X5C5-B4	1'-6"	12 Eq. Spaces	
	X5B5-C6	1'-6"	11 Eq. Spaces	
	X5C5-B6	1'-6"	11 Eq. Spaces	
	X5B6-C5	1'-6"	14 Eq. Spaces	
	X5C6-B5	1'-6"	14 Eq. Spaces	

ORIGINAL PLAN	SURVEY PLOTTED BY	DATE
NOTE BOOK	DRAWN BY	
No.	DESIGNED BY	
	QUANTITIES BY	
	CHECKED BY	

DRAWING NAME: Z:\00 ONGOING\23-022-9-NANUE STR BR PF2-DOT\A\01 CAD\12-06-24 ADD\NSR-SAG512 DIAG BRACE DTLS ADD2.DWG PLOT TIME: 12-03-24, 10:03 PM

STEPHEN T. PETERS

LICENSED PROFESSIONAL ENGINEER

NO. 17097-S

HAWAII, U.S.A.

THIS WORK WAS PREPARED BY ME OR UNDER MY SUPERVISION.

Signature

4-30-26

SIGNATURE EXPIRATION DATE OF THE LICENSE

12/6/24	1	Revised Table Value
DATE	REVISION	

STATE OF HAWAII

DEPARTMENT OF TRANSPORTATION

HIGHWAYS DIVISION

DIAGONAL BRACE SCHEDULE

HAWAII BELT ROAD

Nanue Stream Bridge Rehabilitation

Federal Aid Project No. BR-019-2(077)

Scale: As Noted

Date: Oct. 2024

FED. ROAD DIST. NO.	STATE	FEDERAL AID PROJ. NO.	FISCAL YEAR	SHEET NO.	TOTAL SHEETS
HAWAII	HAW.	BR-019-2(077)	2024	ADD. 86	280

BENT UPPER INTERIOR DIAGONAL BRACE SCHEDULE

BENT NO. 6	MEMBER ID	"A"	BATTEN PLATE SPACES	
	X6B1-C2	1'-6"	1 Eq. Spaces	1
	X6C1-B2	1'-6"	1 Eq. Spaces	1
	X6B2-C1	1'-6"	2 Eq. Spaces	1
	X6C2-B1	1'-6"	2 Eq. Spaces	1
	X6B2-C3	1'-6"	3 Eq. Spaces	
	X6C2-B3	1'-6"	3 Eq. Spaces	
	X6B3-C2	1'-6"	6 Eq. Spaces	
	X6C3-B2	1'-6"	6 Eq. Spaces	
	X6B3-C4	1'-6"	6 Eq. Spaces	
	X6C3-B4	1'-6"	6 Eq. Spaces	
	X6B4-C3	1'-6"	11 Eq. Spaces	
	X6C4-B3	1'-6"	11 Eq. Spaces	
	X6B4-C5	1'-6"	9 Eq. Spaces	
	X6C4-B5	1'-6"	9 Eq. Spaces	
	X6B5-C4	1'-6"	12 Eq. Spaces	
	X6C5-B4	1'-6"	12 Eq. Spaces	
	X6B5-C6	1'-6"	11 Eq. Spaces	
	X6C5-B6	1'-6"	11 Eq. Spaces	
	X6B6-C5	1'-6"	14 Eq. Spaces	
	X6C6-B5	1'-6"	14 Eq. Spaces	
BENT NO. 7	X7B1-C2	1'-6"	1 Eq. Spaces	1
	X7C1-B2	1'-6"	1 Eq. Spaces	1
	X7B2-C1	1'-6"	2 Eq. Spaces	1
	X7C2-B1	1'-6"	2 Eq. Spaces	1
	X7B2-C3	1'-6"	3 Eq. Spaces	
	X7C2-B3	1'-6"	3 Eq. Spaces	
	X7B3-C2	1'-6"	6 Eq. Spaces	
	X7C3-B2	1'-6"	6 Eq. Spaces	
	X7B3-C4	1'-6"	6 Eq. Spaces	
	X7C3-B4	1'-6"	6 Eq. Spaces	
	X7B4-C3	1'-6"	11 Eq. Spaces	
	X7C4-B3	1'-6"	11 Eq. Spaces	
	X7B4-C5	1'-6"	9 Eq. Spaces	
	X7C4-B5	1'-6"	9 Eq. Spaces	
	X7B5-C4	1'-6"	12 Eq. Spaces	
	X7C5-B4	1'-6"	12 Eq. Spaces	
	X7B5-C6	1'-6"	11 Eq. Spaces	
	X7C5-B6	1'-6"	11 Eq. Spaces	
	X7B6-C5	1'-6"	14 Eq. Spaces	
	X7C6-B5	1'-6"	14 Eq. Spaces	

BENT UPPER INTERIOR DIAGONAL BRACE SCHEDULE

BENT NO. 8	MEMBER ID	"A"	BATTEN PLATE SPACES	
	X8B1-C2	1'-6"	1 Eq. Spaces	1
	X8C1-B2	1'-6"	1 Eq. Spaces	1
	X8B2-C1	1'-6"	2 Eq. Spaces	1
	X8C2-B1	1'-6"	2 Eq. Spaces	1
	X8B2-C3	1'-6"	3 Eq. Spaces	
	X8C2-B3	1'-6"	3 Eq. Spaces	
	X8B3-C2	1'-6"	6 Eq. Spaces	
	X8C3-B2	1'-6"	6 Eq. Spaces	
	X8B3-C4	1'-6"	6 Eq. Spaces	
	X8C3-B4	1'-6"	6 Eq. Spaces	
	X8B4-C3	1'-6"	11 Eq. Spaces	
	C8C4-B3	1'-6"	11 Eq. Spaces	
BENT NO. 9	X9B1-C2	1'-6"	1 Eq. Spaces	1
	X9C1-B2	1'-6"	1 Eq. Spaces	1
	X9B2-C1	1'-6"	2 Eq. Spaces	1
	X9C2-B1	1'-6"	2 Eq. Spaces	1
	X9B2-C3	1'-6"	4 Eq. Spaces	
	X9C2-B3	1'-6"	4 Eq. Spaces	
	X9B3-C2	1'-6"	7 Eq. Spaces	
	X9C3-B2	1'-6"	7 Eq. Spaces	

ORIGINAL PLAN	SURVEY PLOTTED BY	DATE
NOTE BOOK	DRAWN BY	
No.	DESIGNED BY	
	QUANTITIES BY	
	CHECKED BY	

DRAWING NAME: Z:\00 ONGOING\23-022.9-NANUE STR BR PF2-DOT\A\01 CAD\12-06-24 ADD\NSR-SAG512 DIAG BRACE DTLS ADD2.DWG PLOT TIME: 12-03-24, 10:05 PM

STEPHEN T. PETERS

LICENSED PROFESSIONAL ENGINEER

NO. 17097-S

HAWAII, U.S.A.

THIS WORK WAS PREPARED BY ME OR UNDER MY SUPERVISION.

Signature

4-30-26

SIGNATURE EXPIRATION DATE OF THE LICENSE

12/6/24	<div><div></div><div>1</div></div>	Revised Table Value
DATE	REVISION	
STATE OF HAWAII DEPARTMENT OF TRANSPORTATION HIGHWAYS DIVISION		
<u>DIAGONAL BRACE SCHEDULE</u>		
HAWAII BELT ROAD Nanue Stream Bridge Rehabilitation Federal Aid Project No. BR-019-2(077) Scale: As Noted Date: Oct. 2024		
SHEET No.SA5.14 OF 34 SHEETS		

FED. ROAD DIST. NO.	STATE	FEDERAL AID PROJ. NO.	FISCAL YEAR	SHEET NO.	TOTAL SHEETS
HAWAII	HAW.	BR-019-2(077)	2024	ADD. 88	280

BENT LOWER INTERIOR DIAGONAL BRACE SCHEDULE			
BENT NO. 4	MEMBER ID	"A"	BATTEN PLATE SPACES
	X4B6-C7	1'-6"	14 Eq. Spaces
	X4C6-B7	1'-6"	14 Eq. Spaces
	X4B7-C6	1'-6"	18 Eq. Spaces
	X4C7-B6	1'-6"	18 Eq. Spaces
BENT NO. 5	X5B6-C7	1'-6"	20 Eq. Spaces
	X5C6-B7	1'-6"	20 Eq. Spaces
	X5B8-C7	1'-6"	18 Eq. Spaces
	X5C8-B7	1'-6"	18 Eq. Spaces
BENT NO. 6	X6B6-C7	1'-6"	20 Eq. Spaces
	X6C6-B7	1'-6"	20 Eq. Spaces
	X6B8-C7	1'-6"	18 Eq. Spaces
	X6C8-B7	1'-6"	18 Eq. Spaces

ORIGINAL PLAN	SURVEY PLOTTED BY	DATE
	DRAWN BY	
	DESIGNED BY	
	QUANTITIES BY	
NOTE BOOK	CHECKED BY	
	No.	

DRAWING NAME: Z:\00 ONGOING\23-022.9-NANUE STR BR PF2-DOT\01 CAD\12-06-24 ADD\NSR-SAG512 DIAG BRACE DTLS ADD2.DWG PLOT TIME: 12-03-24, 10:04 PM)

STEPHEN T. PETERS

LICENSED PROFESSIONAL ENGINEER

NO. 17097-S

HAWAII, U.S.A.

THIS WORK WAS PREPARED BY ME OR UNDER MY SUPERVISION.

Signature

4-30-26

SIGNATURE

EXPIRATION DATE OF THE LICENSE

12/6/24	1	Revised Table Value
DATE	REVISION	

STATE OF HAWAII

DEPARTMENT OF TRANSPORTATION

HIGHWAYS DIVISION

DIAGONAL BRACE SCHEDULE

HAWAII BELT ROAD


Nanue Stream Bridge Rehabilitation

Federal Aid Project No. BR-019-2(077)

Scale: As Noted






Date: Oct. 2024

FED. ROAD DIST. NO.	STATE	FEDERAL AID PROJ. NO.	FISCAL YEAR	SHEET NO.	TOTAL SHEETS
HAWAII	HAW.	BR-019-2(077)	2024	ADD. 91	280

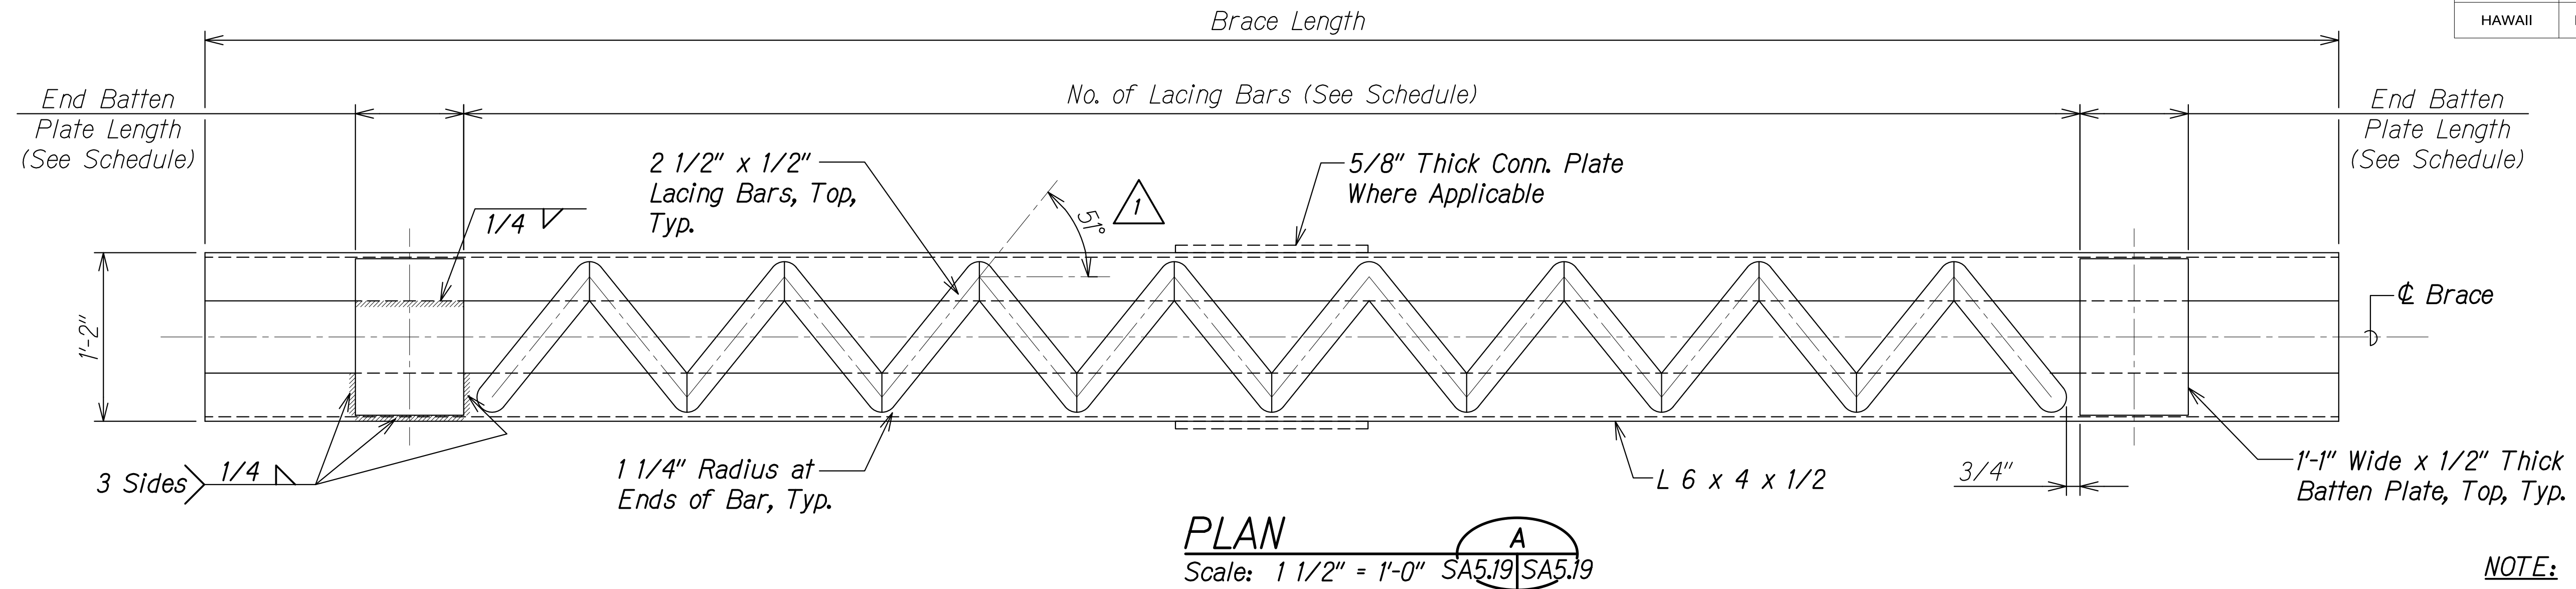

NOTE:


Steel detailer to determine all lengths not shown on brace plans and schedule.

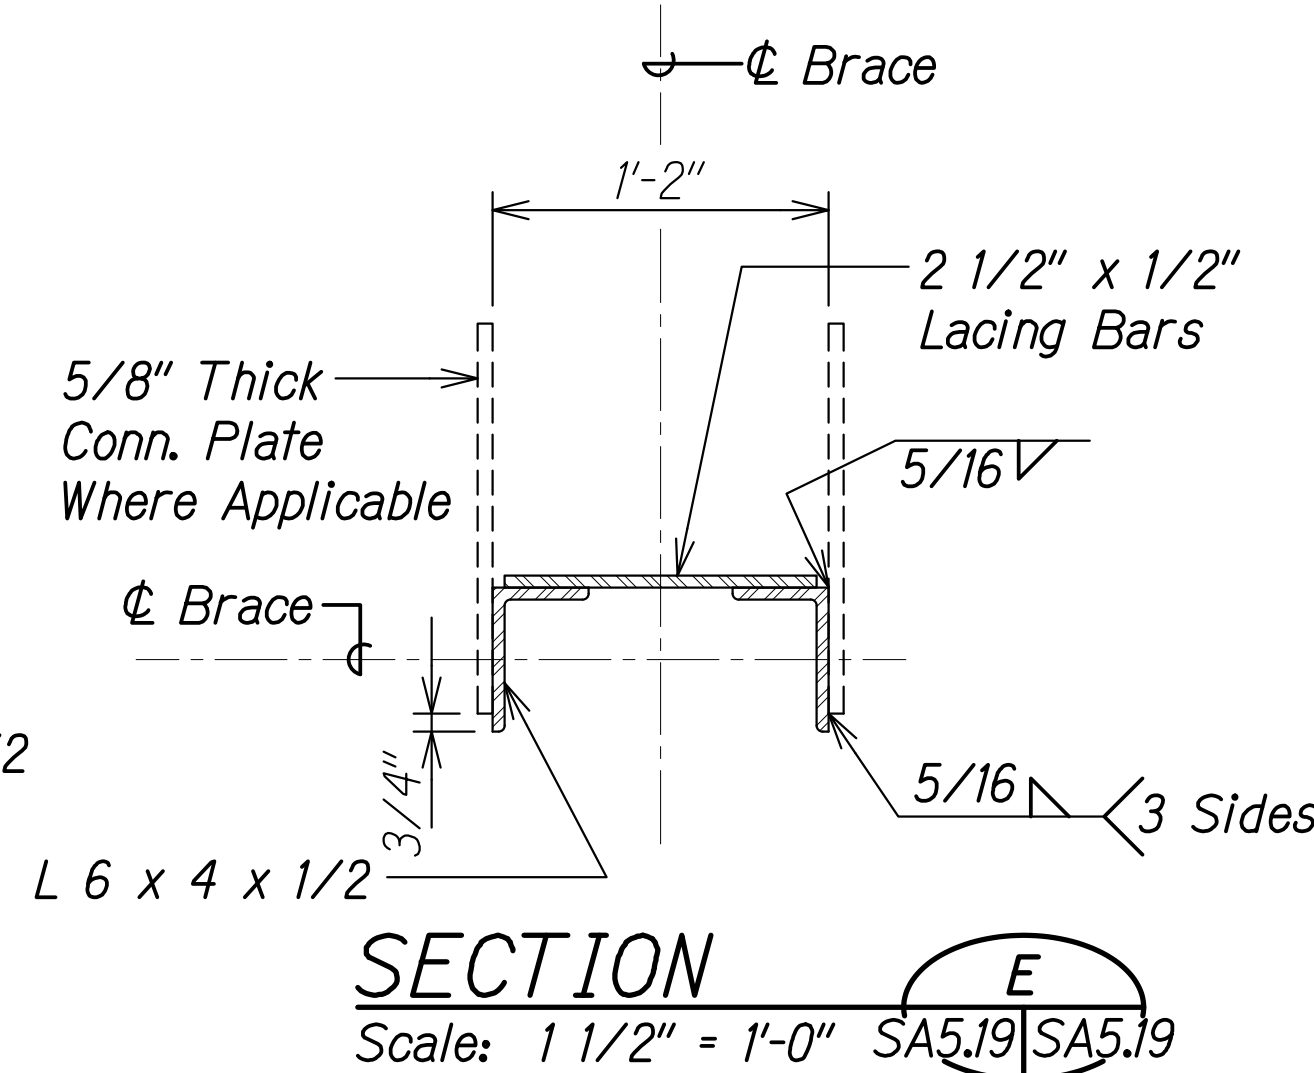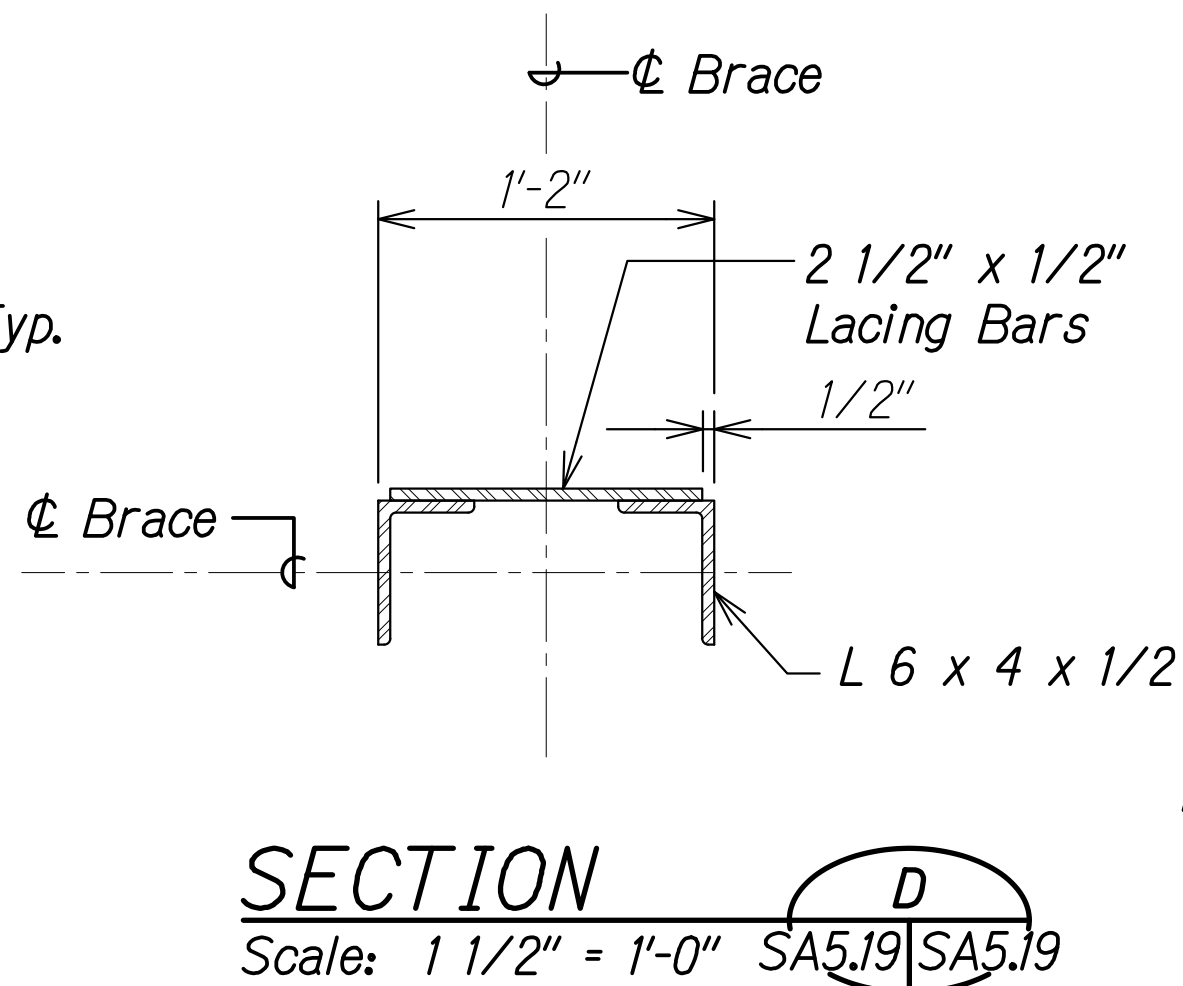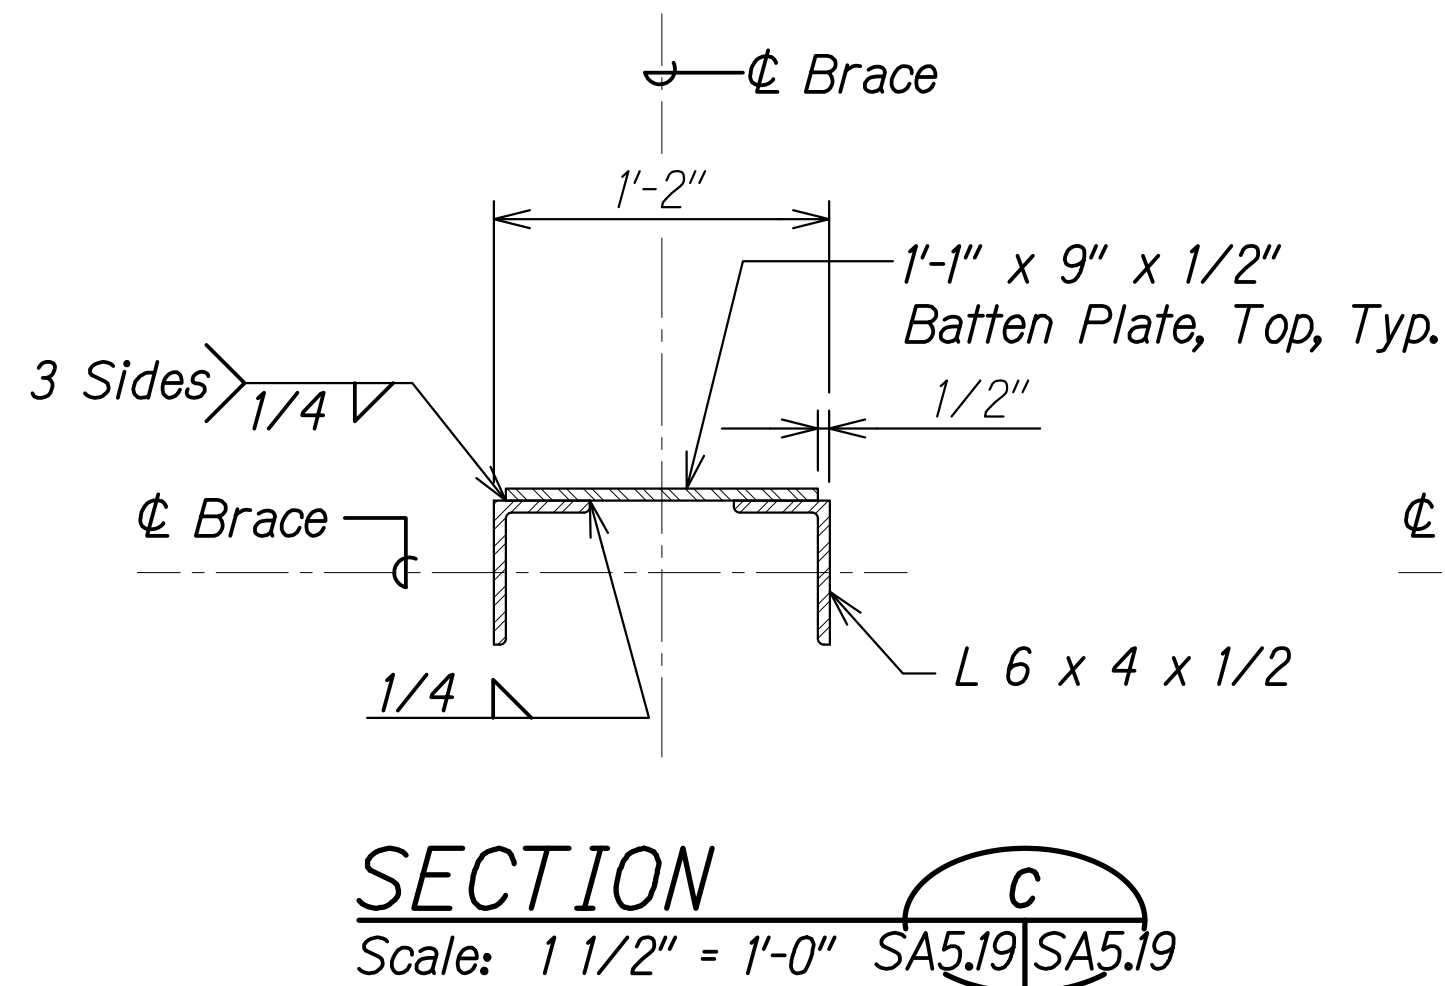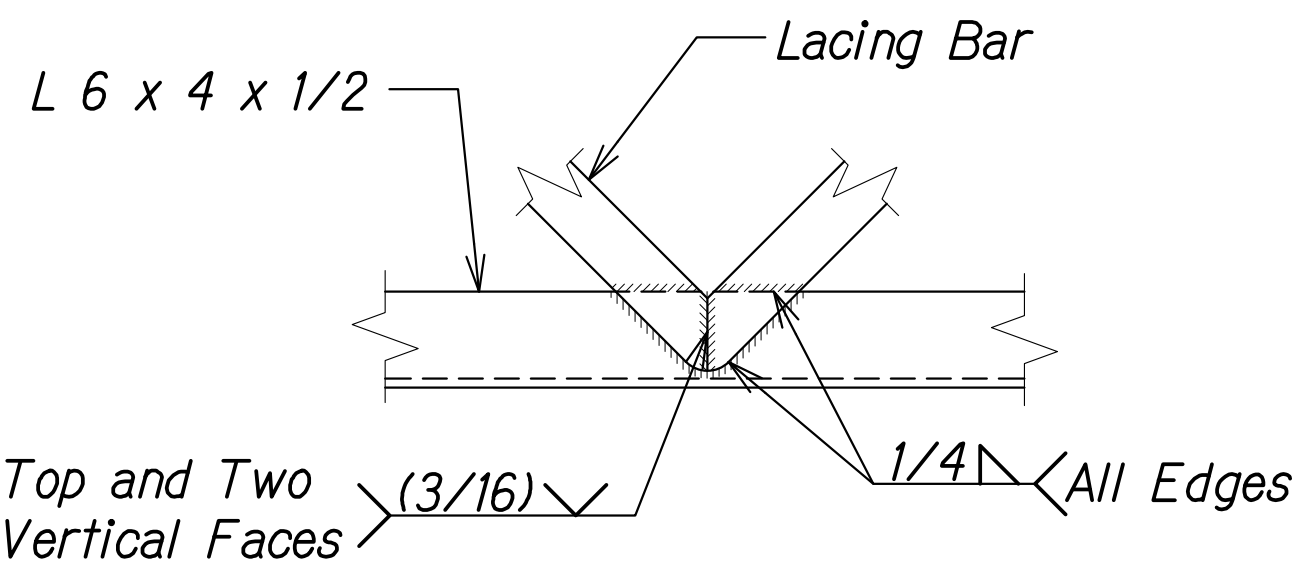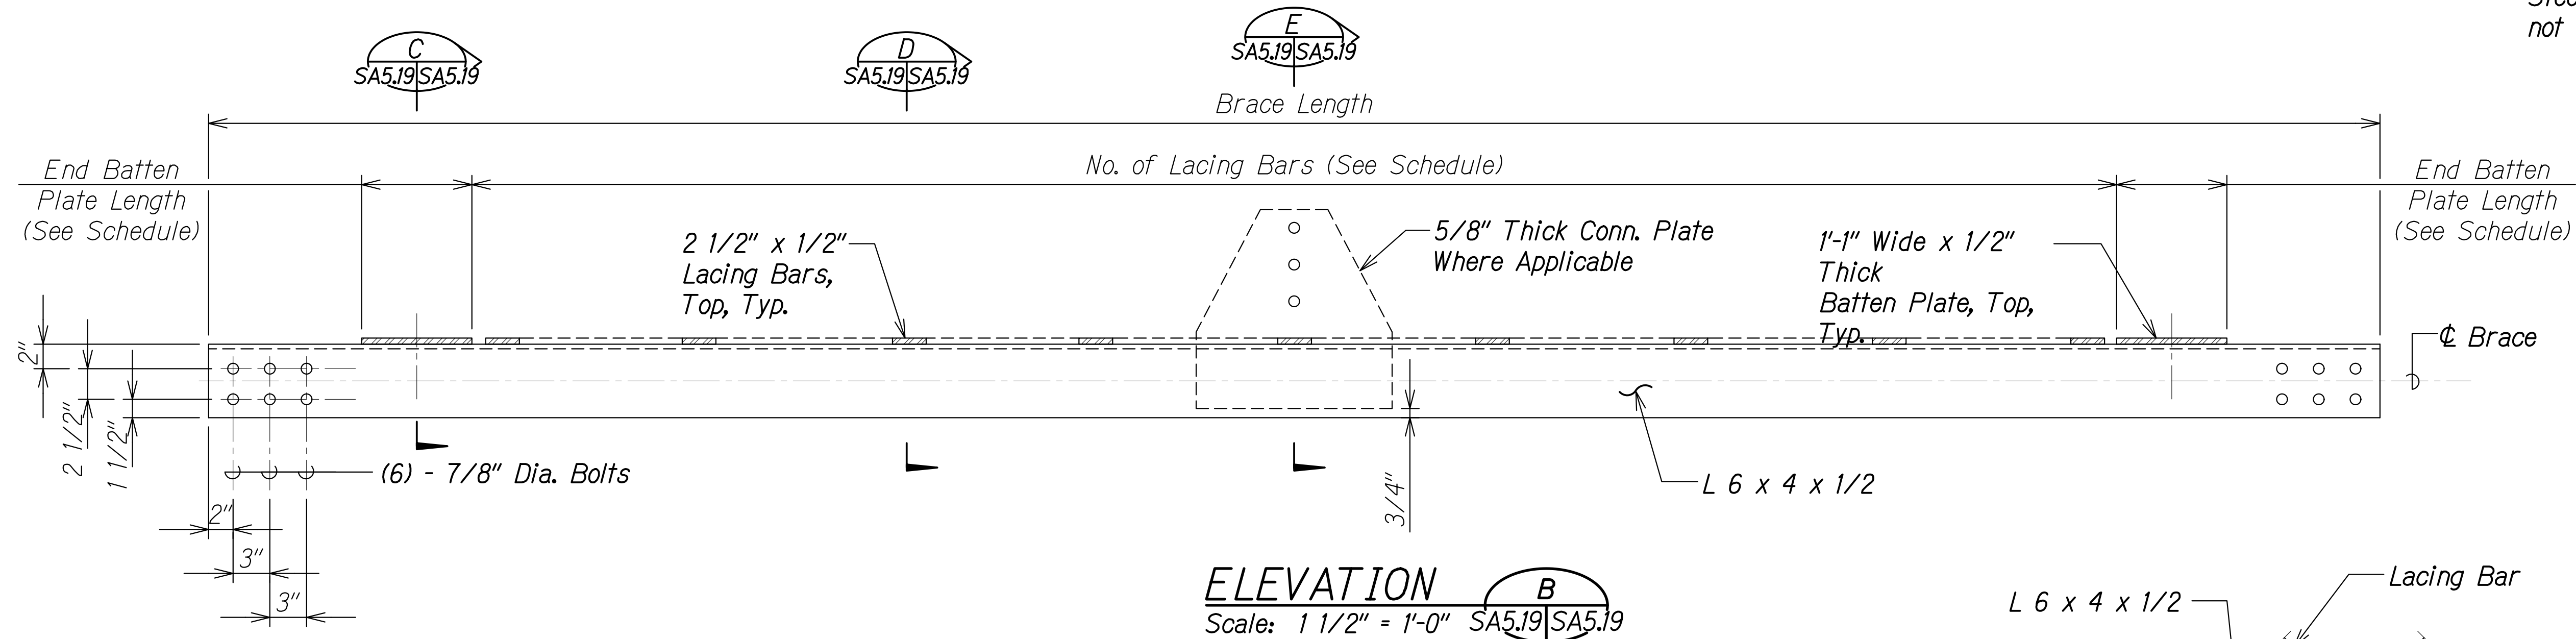

DETAIL

Scale: 1 1/2" = 1'-0" SA5.19 SA5.19


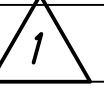
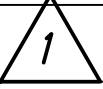
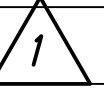
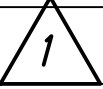
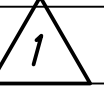
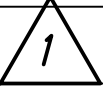
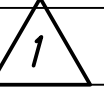
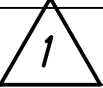


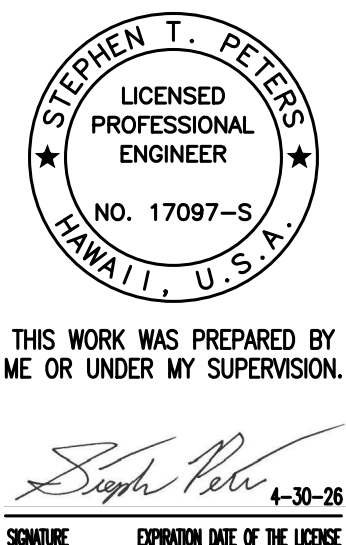
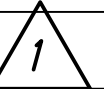
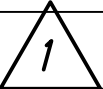
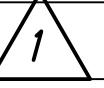
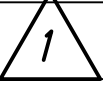

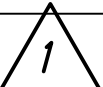





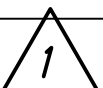


1








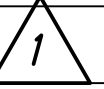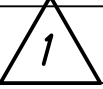






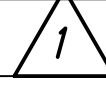
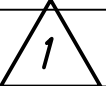
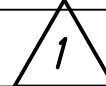
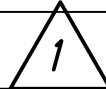
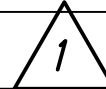
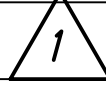
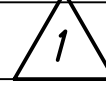

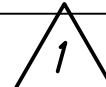







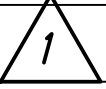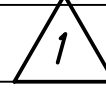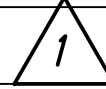

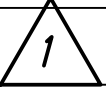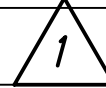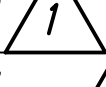
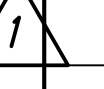







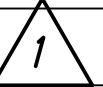
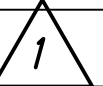


12/6/24	<div><div>1</div></div>	Revised Dimension
DATE	REVISION	
STATE OF HAWAII DEPARTMENT OF TRANSPORTATION HIGHWAYS DIVISION		
<u>HORIZONTAL BRACE PLAN,</u> <u>ELEVATION AND SECTION</u>		
<u>HAWAII BELT ROAD</u> <u>Nanue Stream Bridge Rehabilitation</u> <u>Federal Aid Project No. BR-019-2(077)</u>		
Scale: As Noted		Date: Oct. 2024
SHEET No. SA5.19 OF 34 SHEETS		

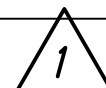FED. ROAD DIST. NO.	STATE	FEDERAL AID PROJ. NO.	FISCAL YEAR	SHEET NO.	TOTAL SHEETS
HAWAII	HAW.	BR-019-2(077)	2024	ADD. 92	280

BENT UPPER HORIZONTAL BRACE SCHEDULE

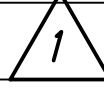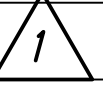
BENT NO. 1	MEMBER ID	End Batten Plate Length	No. of Lacing Bars
	H1A-B1	0'-10"	4
	H1B-C1	0'-9"	2 
	H1C-D1	0'-10"	4
	H1A-B2	0'-10"	4
	H1B-C2	1'-5" 	4 
	H1C-D2	0'-10"	4
BENT NO. 2	H2A-B1	0'-10"	4
	H2B-C1	0'-8" 	2 
	H2C-D1	0'-10"	4
	H2A-B2	0'-9" 	6 
	H2B-C2	0'-10"	8
	H2C-D2	0'-10"	4
	H2A-B3	0'-10"	4
	H2B-C3	0'-8" 	14 
	H2C-D3	0'-10"	4
	H2A-B4	0'-10"	4
	H2B-C4	0'-9" 	26 
	H2C-D4	0'-10"	4
BENT NO. 3	H3A-B1	0'-10"	4
	H3B-C1	0'-9"	2 
	H3C-D1	0'-10"	4
	H3A-B2	0'-10"	4
	H3B-C2	1'-5" 	4 
	H3C-D2	0'-10"	4
	H3A-B3	0'-10"	4
	H3B-C3	1'-3" 	12 
	H3C-D3	0'-10"	4
	H3A-B4	0'-10"	4
	H3B-C4	0'-10" 	26 
	H3C-D4	0'-10"	4
	H3A-B5	0'-10"	4
	H3B-C5	1'-2" 	38 
	H3C-D5	0'-10"	4
BENT NO. 4	H4A-B1	0'-10"	4
	H4B-C1	0'-8" 	2 
	H4C-D1	0'-10"	4
	H4A-B2	0'-10"	4
	H4B-C2	0'-9" 	6 
	H4C-D2	0'-10"	4
	H4A-B3	0'-10"	4
	H4B-C3	0'-8" 	14 
	H4C-D3	0'-10"	4

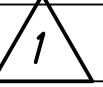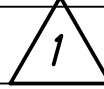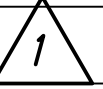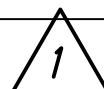BENT NO. 4	MEMBER ID	End Batten Plate Length	No. of Lacing Bars
	H4A-B4	0'-10"	4
	H4B-C4	0'-9" 	26 
	H4C-D4	0'-10"	4
	H4A-B5	0'-10"	4
	H4B-C5	1'-3" 	38 
	H4C-D5	0'-10"	4
BENT NO. 5	H5A-B1	0'-10"	4
	H5B-C1	0'-9"	2 
	H5C-D1	0'-10"	4
	H5A-B2	0'-10"	4
	H5B-C2	1'-5" 	4 
	H5C-D2	0'-10"	4
	H5A-B3 	0'-10"	4
	H5B-C3 	1'-3" 	12 
	H5C-D3 	0'-10"	4
	H5A-B4 	0'-10"	4
	H5B-C4	0'-10" 	26 
	H5C-D4	0'-10"	4
	H5A-B5	0'-10"	4
	H5B-C5	1'-5" 	38 
	H5C-D5	0'-10"	4
BENT NO. 6	H6A-B1	0'-10"	4
	H6B-C1	0'-8" 	2 
	H6C-D1	0'-10"	4
	H6A-B2	0'-10"	4
	H6B-C2	0'-9" 	6 
	H6C-D2	0'-10"	4
	H6A-B3	0'-10"	4
	H6B-C3	0'-8" 	14 
	H6C-D3	0'-10"	4
	H6A-B4	0'-10"	4
	H6B-C4	0'-9" 	26 
	H6C-D4	0'-10"	4
	H6A-B5	0'-10"	4
	H6B-C5	1'-3" 	38 
	H6C-D5	0'-10"	4
BENT NO. 7	H7A-B1	0'-10"	4
	H7B-C1	0'-9"	2 
	H7C-D1	0'-10"	4
	H7A-B2	0'-10"	4
	H7B-C2	1'-5" 	4 
	H7C-D2	0'-10"	4
	H7A-B3	0'-10"	4

BENT NO. 7	MEMBER ID	End Batten Plate Length	No. of Lacing Bars
	H7B-C3	1'-3" 	12 
	H7C-D3	0'-10"	4
	H7A-B4	0'-10"	4
	H7B-C4	0'-10" 	26 
	H7C-D4	0'-10"	4
	H7A-B5	0'-10"	4
BENT NO. 8	H7B-C5	0'-9"	40 
	H7C-D5	0'-10"	4
BENT NO. 9	H8A-B1	0'-10"	4
	H8B-C1	0'-8" 	2 
	H8C-D1	0'-10"	4
	H8A-B2	0'-10"	4
	H8B-C2	0'-9" 	6 
	H8C-D2	0'-10"	4
	H8A-B3	0'-10"	4
	H8B-C3	1'-2"	12 
BENT NO. 9	H8C-D3	0'-10"	4
	H9A-B1	0'-10"	4
	H9B-C1	0'-9"	2 
	H9C-D1	0'-10"	4
	H9A-B2	0'-10"	4
BENT NO. 9	H9B-C2	1'-5" 	4 
	H9C-D2	0'-10"	4


ORIGINAL PLAN	SURVEY PLOTTED BY	DATE
NOTE BOOK	DRAWN BY	
	DESIGNED BY	
	QUANTITIES BY	
	CHECKED BY	
No.		

DRAWING NAME: Z:\00 ONGOING\23-022-9-NANUE STR BR PF2-DOTHA\01 CAD\12-06-24 ADD\NSR-SAG512 DIAG BRACE DTLS ADD2.DWG PLOT TIME: 12-03-24, 10:07 PM

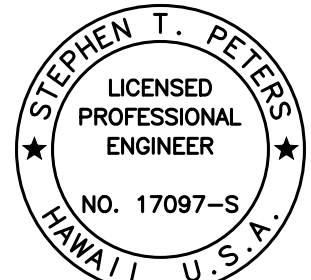

THIS WORK WAS PREPARED BY
ME OR UNDER MY SUPERVISION.

Stephen Peters
SIGNATURE EXPIRATION DATE OF THE LICENSE 4-30-26

12/6/24	 Revised Table Value
DATE	REVISION






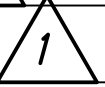














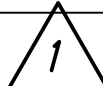
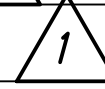
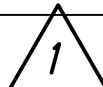
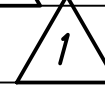
STATE OF HAWAII
DEPARTMENT OF TRANSPORTATION
HIGHWAYS DIVISION

HORIZONTAL BRACE SCHEDULE

HAWAII BELT ROAD
Nanue Stream Bridge Rehabilitation
Federal Aid Project No. BR-019-2(077)

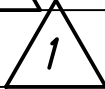
Scale: As Noted Date: Oct. 2024


FED. ROAD DIST. NO.	STATE	FEDERAL AID PROJ. NO.	FISCAL YEAR	SHEET NO.	TOTAL SHEETS
HAWAII	HAW.	BR-019-2(077)	2024	ADD. 94	280

BENT LOWER HORIZONTAL BRACE SCHEDULE							
BENT NO. 1	MEMBER ID	End Batten Plate Length	No. of Lacing Bars	BENT NO. 6	MEMBER ID	End Batten Plate Length	No. of Lacing Bars
	H1A-B3	0'-8"	4		H6A-B6	0'-8"	4
	H1B-C3	1'-4" 	16		H6B-C6	1'-1" 	22
	H1C-D3	0'-8"	4		H6C-B6	1'-1" 	22
					H6C-D6	0'-8"	4
					H6A-B7	0'-8"	4
BENT NO. 2	H2A-B5	0'-8"	4		H6B-C7	1'-5" 	28
	H2B-C5	1'-6" 	34		H6C-B7	1'-5" 	28
	H2C-D5	0'-8"	4		H6C-D7	0'-8"	4
					H6A-B8	0'-8"	4
					H6B-C8	0'-11" 	34
					H6C-B8	0'-11" 	34
BENT NO. 3	H3A-B6	0'-8"	4		H6C-D8	0'-8"	4
	H3B-C6	0'-9" 	22	BENT NO. 7	H7A-B6	0'-8"	4
	H3C-B6	0'-9" 	22		H7B-C6	1'-2" 	22
	H3C-D6	0'-8"	4		H7C-B6	1'-2" 	22
					H7C-D6	0'-8"	4
BENT NO. 4	H4A-B6	0'-8"	4		BENT NO. 8	H8A-B4	0'-8"
	H4B-C6	1'-3" 	22	H8B-C4		1'-2" 	26
	H4C-B6	1'-3" 	22	H8C-D4		0'-8"	4
	H4C-D6	0'-8"	4				
	H4A-B7	0'-8"	4				
	H4B-C7	1'-5" 	30				
	H4C-B7	1'-5" 	30	BENT NO. 9	H9A-B3	0'-8"	4
	H4C-D7	0'-8"	4		H9B-C3	1'-4" 	14
BENT NO. 5	H5A-B6	0'-8"	4		H9C-D3	0'-8"	4
	H5B-C6	1'-2" 	22				
	H5C-B6	1'-2" 	22				
	H5C-D6	0'-8"	4				
	H5A-B7	0'-8"	4				
	H5B-C7	1'-3" 	28				
	H5C-B7	1'-3" 	28				
	H5C-D7	0'-8"	4				
	H5A-B8	0'-8"	4				
	H5B-C8	1'-5" 	32				
	H5C-B8	1'-5" 	32				
	H5C-D8	0'-8"	4				





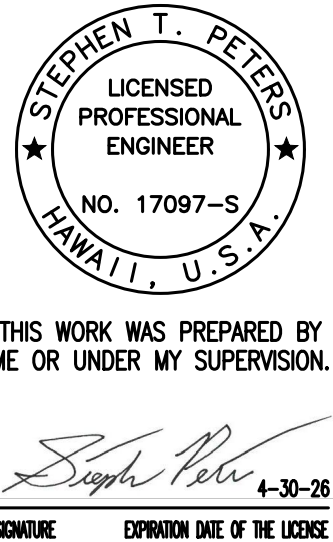



ORIGINAL PLAN	SURVEY PLOTTED BY	DATE
NOTE BOOK	DRAWN BY	
No.	DESIGNED BY	
	QUANTITIES BY	
	CHECKED BY	

DRAWING NAME: Z:\00 ONGOING\23-022.9-NANUE STR BR PF2-DOT\A.01 CAD\12-06-24 ADD\NSR-SAG612 DIAG BRACE DTLS ADD2.DWG PLOT TIME: 12-03-24, 10:08 PM



12/6/24	 Revised Table Value
DATE	REVISION
STATE OF HAWAII DEPARTMENT OF TRANSPORTATION HIGHWAYS DIVISION	
HORIZONTAL BRACE SCHEDULE	
HAWAII BELT ROAD Nanue Stream Bridge Rehabilitation Federal Aid Project No. BR-019-2(077)	
Scale: As Noted	Date: Oct. 2024
SHEET NoSA5.22 OF 34 SHEETS	

FED. ROAD DIST. NO.	STATE	FEDERAL AID PROJ. NO.	FISCAL YEAR	SHEET NO.	TOTAL SHEETS
HAWAII	HAW.	BR-019-2(077)	2024	ADD. 99	280

TRESTLE NO. 5 DIAGONAL BRACE SCHEDULE			
TRESTLE NO. 5	MEMBER ID	"A"	BATTEN PLATE SPACES
	X8A1-9A3	1'-6"	12 Eq. Spaces 
	X8B1-9B3	1'-6"	12 Eq. Spaces 
	X8C1-9C3	1'-6"	12 Eq. Spaces 
	X8D1-9D3	1'-6"	12 Eq. Spaces 
	X9A1-8A3	1'-6"	12 Eq. Spaces
	X9B1-8B3	1'-6"	12 Eq. Spaces
	X9C1-8C3	1'-6"	12 Eq. Spaces
	X9D1-8D3	1'-6"	12 Eq. Spaces
	X8A3-9A1	1'-6"	10 Eq. Spaces
	X8B3-9B1	1'-6"	10 Eq. Spaces
	X8C3-9C1	1'-6"	10 Eq. Spaces
	X8D3-9D1	1'-6"	10 Eq. Spaces
	X9A3-8A1	1'-6"	12 Eq. Spaces
	X9B3-8B1	1'-6"	12 Eq. Spaces
	X9C3-8C1	1'-6"	12 Eq. Spaces
	X9D3-8D1	1'-6"	12 Eq. Spaces
	X8A4-9A3	1'-6"	12 Eq. Spaces 
	X8B4-9B3	1'-6"	12 Eq. Spaces 
	X8C4-9C3	1'-6"	12 Eq. Spaces 
	X8D4-9D3	1'-6"	12 Eq. Spaces 
	X9A3-8A4	1'-6"	12 Eq. Spaces
	X9B3-8B4	1'-6"	12 Eq. Spaces
	X9C3-8C4	1'-6"	12 Eq. Spaces
	X9D3-8D4	1'-6"	12 Eq. Spaces

ORIGINAL PLAN	SURVEY PLOTTED BY	DATE
NOTE BOOK	DRAWN BY	
No.	DESIGNED BY	
	QUANTITIES BY	
	CHECKED BY	

DRAWING NAME: Z:\00_OINGONG\23-022.9-NANUE STR BR PF2-DOT\A\01 CAD\12-06-24 ADD\NSR-SAG512 DIAG BRACE DTLS ADD2.DWG PLOT TIME: 12-03-24, 10:09 PM


STEPHEN T. PETERS

LICENSED PROFESSIONAL ENGINEER

NO. 17097-S


HAWAII, U.S.A.

THIS WORK WAS PREPARED BY ME OR UNDER MY SUPERVISION.




4-30-26


SIGNATURE EXPIRATION DATE OF THE LICENSE

12/6/24	 Revised Table Value
DATE	REVISION
<div>STATE OF HAWAII DEPARTMENT OF TRANSPORTATION HIGHWAYS DIVISION</div> <div>DIAGONAL BRACE SCHEDULE</div> <div>HAWAII BELT ROAD Nanue Stream Bridge Rehabilitation Federal Aid Project No. BR-019-2(077) Scale: As Noted Date: Oct. 2024</div>	
SHEET NoSA5.27 OF 34 SHEETS	


FED. ROAD DIST. NO.	STATE	FEDERAL AID PROJ. NO.	FISCAL YEAR	SHEET NO.	TOTAL SHEETS
HAWAII	HAW.	BR-019-2(077)	2024	ADD. 108	280

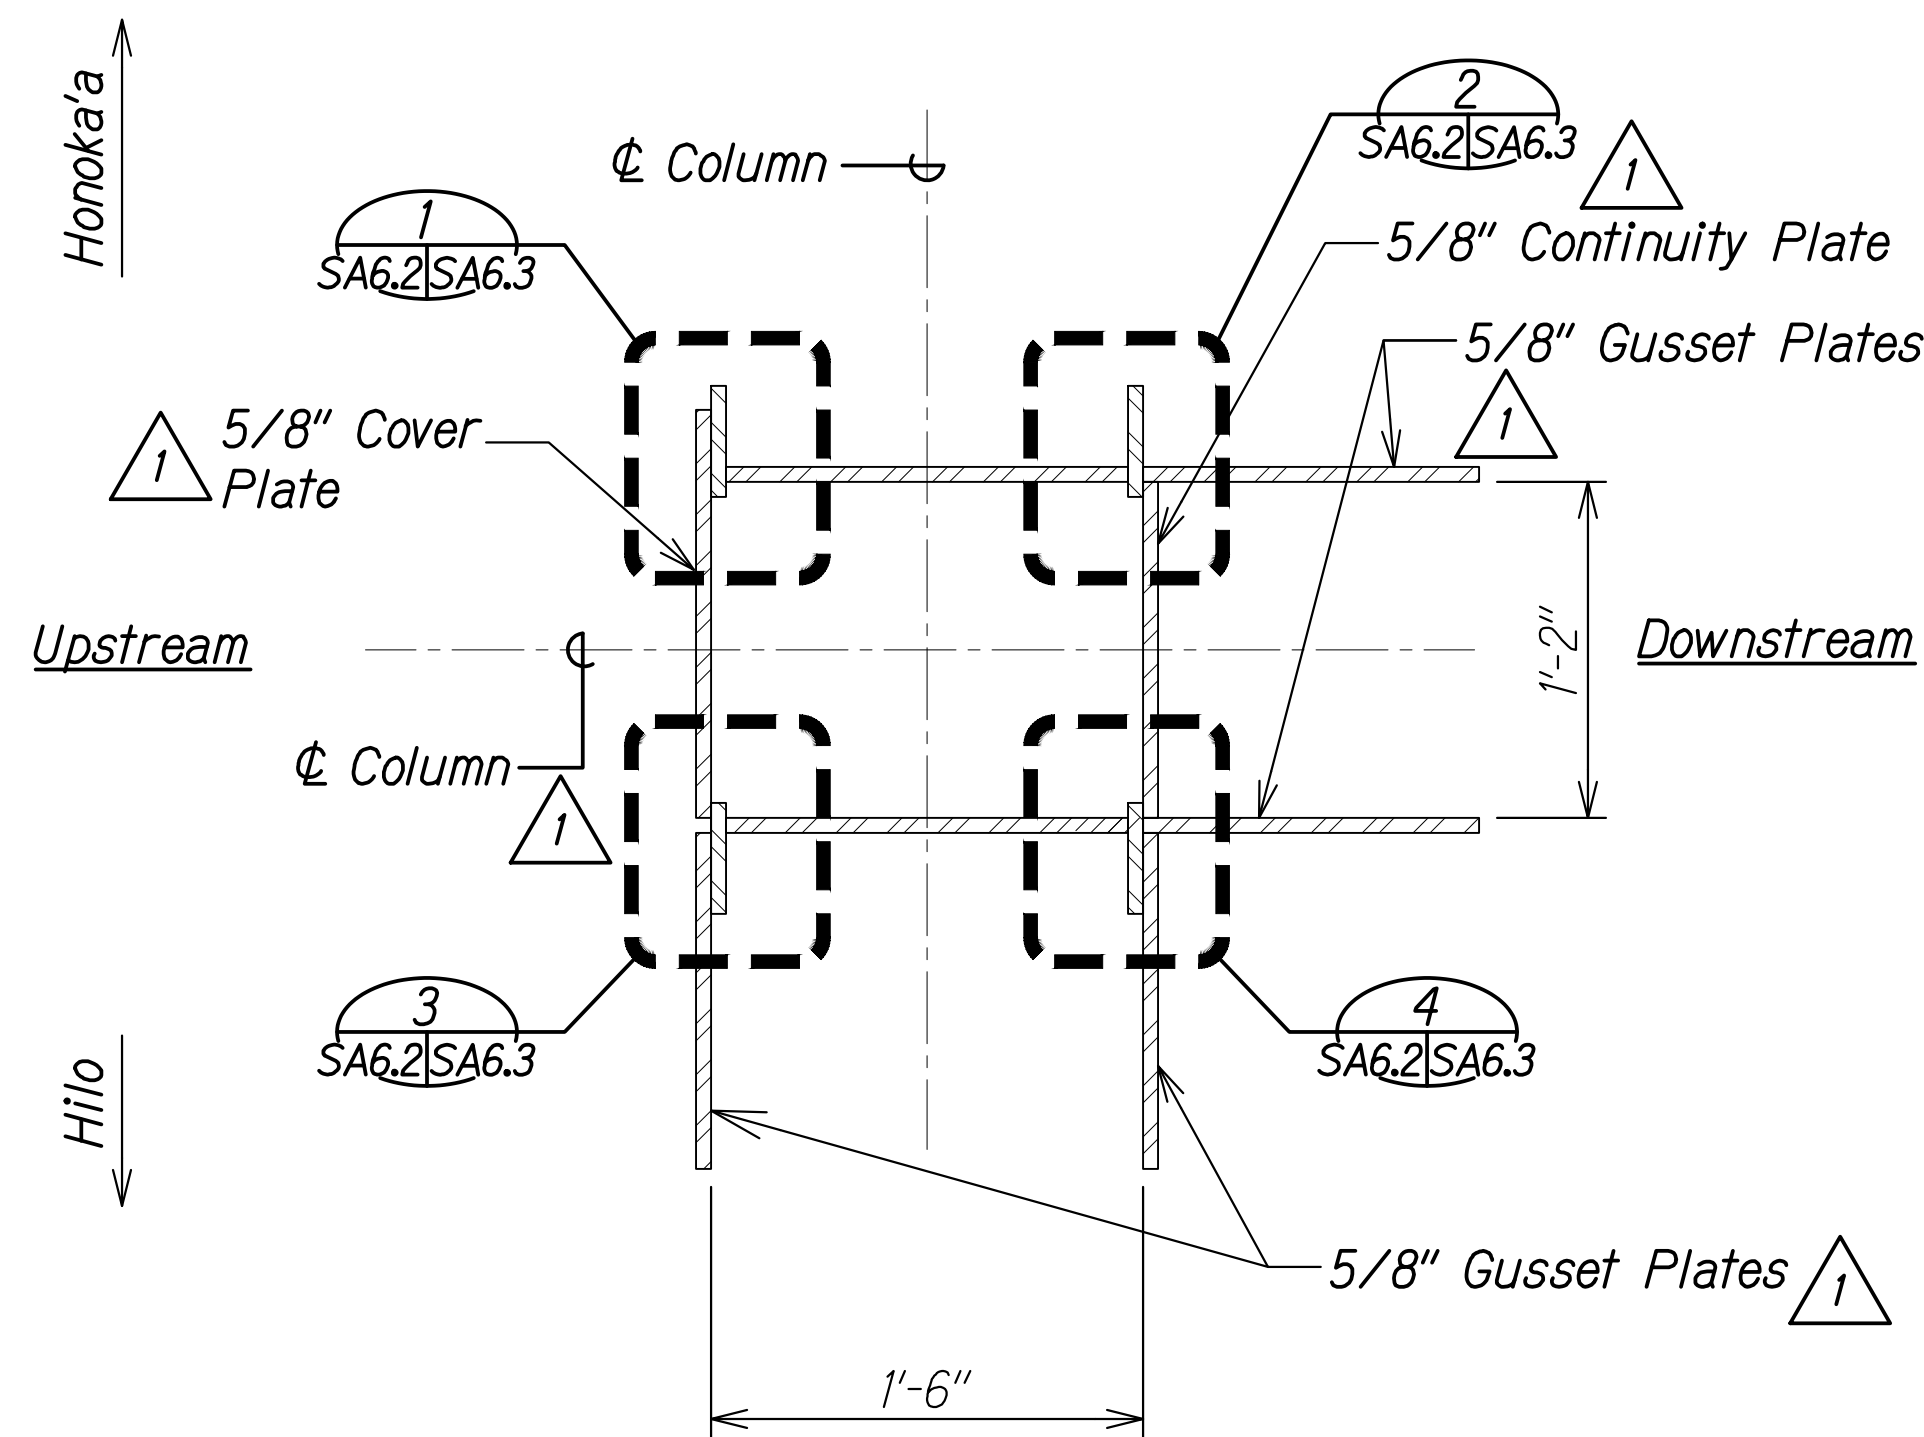


PLAN DETAIL A
Scale: 1 1/2" = 1'-0" SA6.2|SA6.2

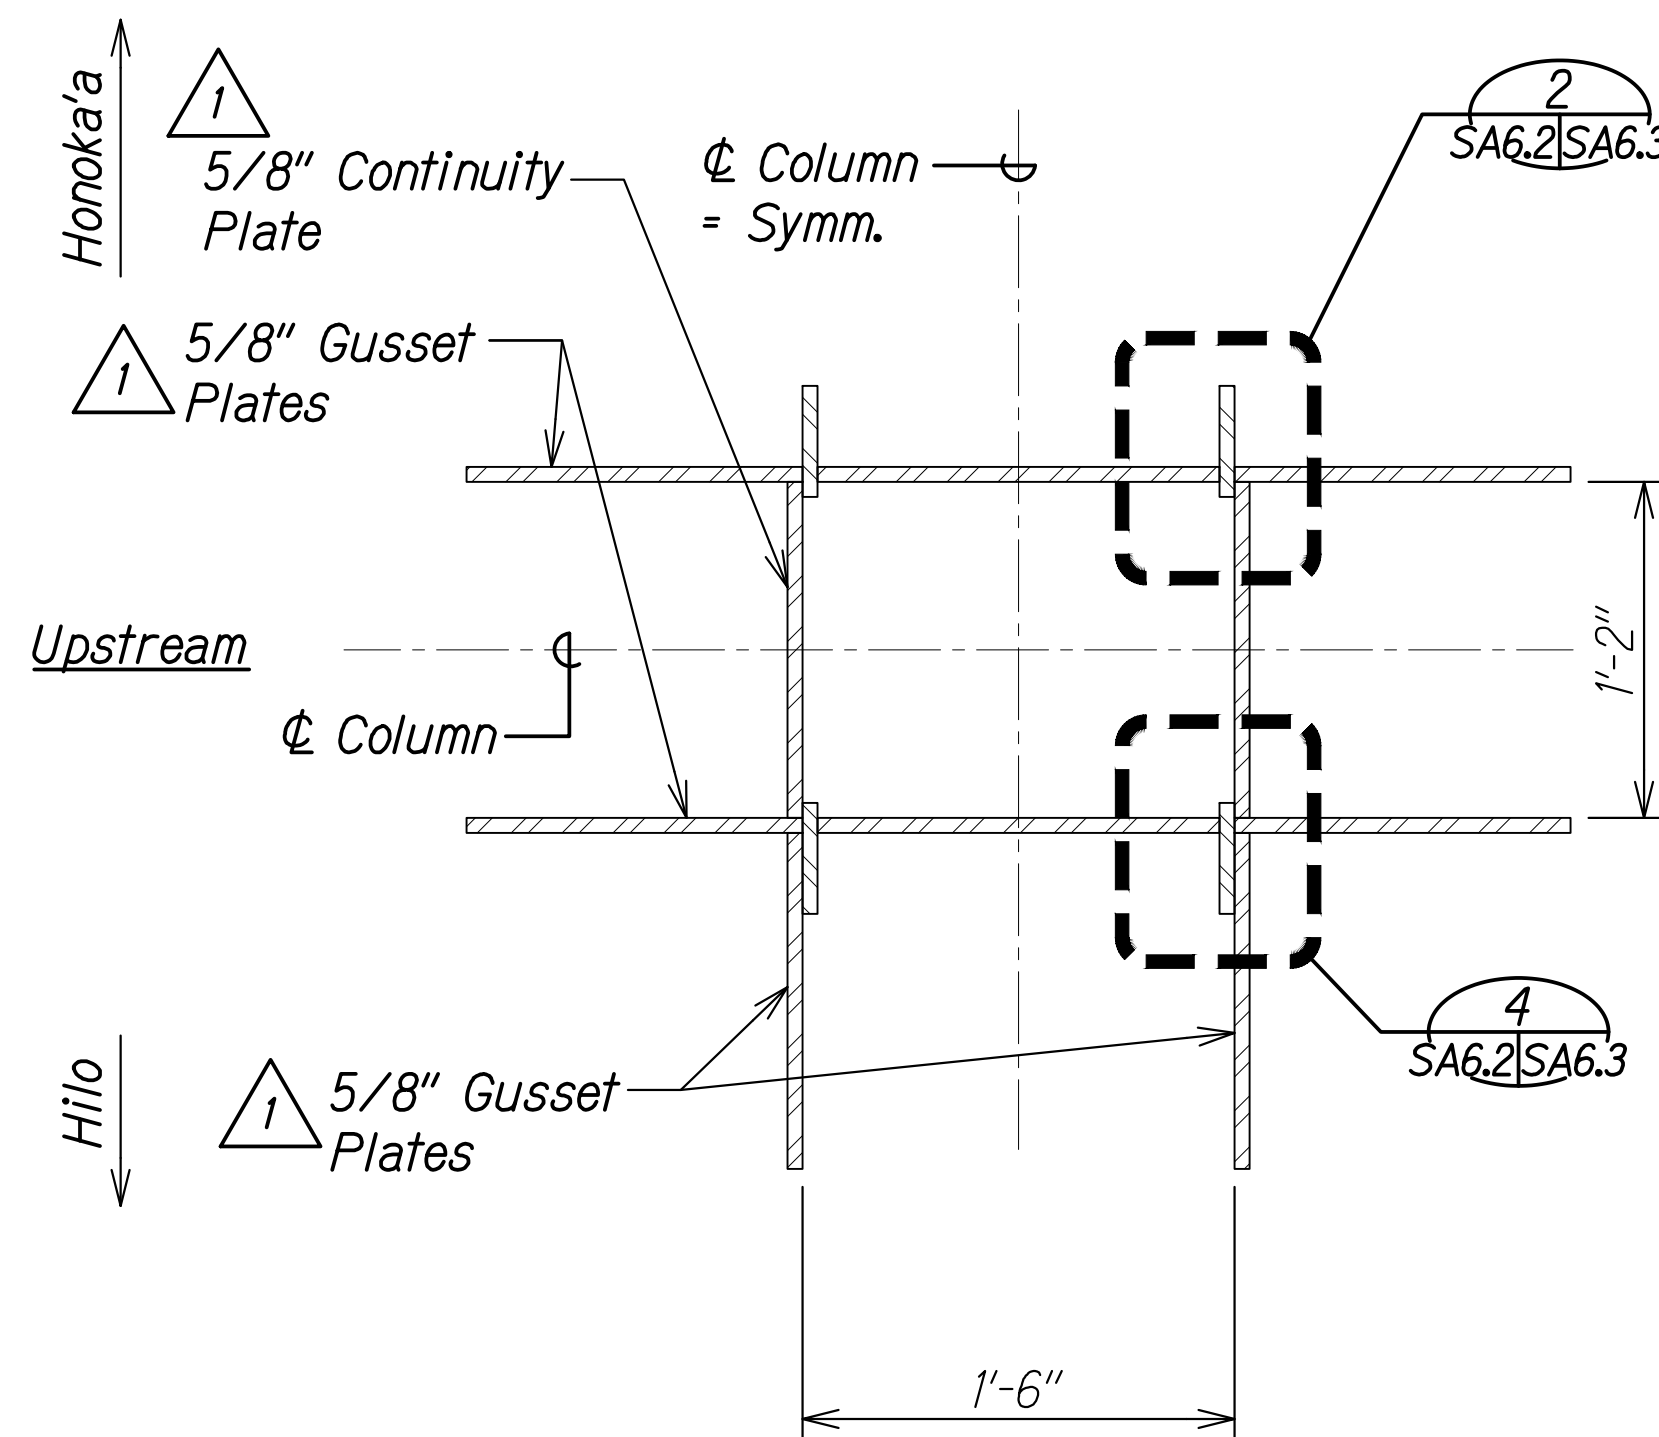


PLAN DETAIL B
Scale: 1 1/2" = 1'-0" SA6.2|SA6.2

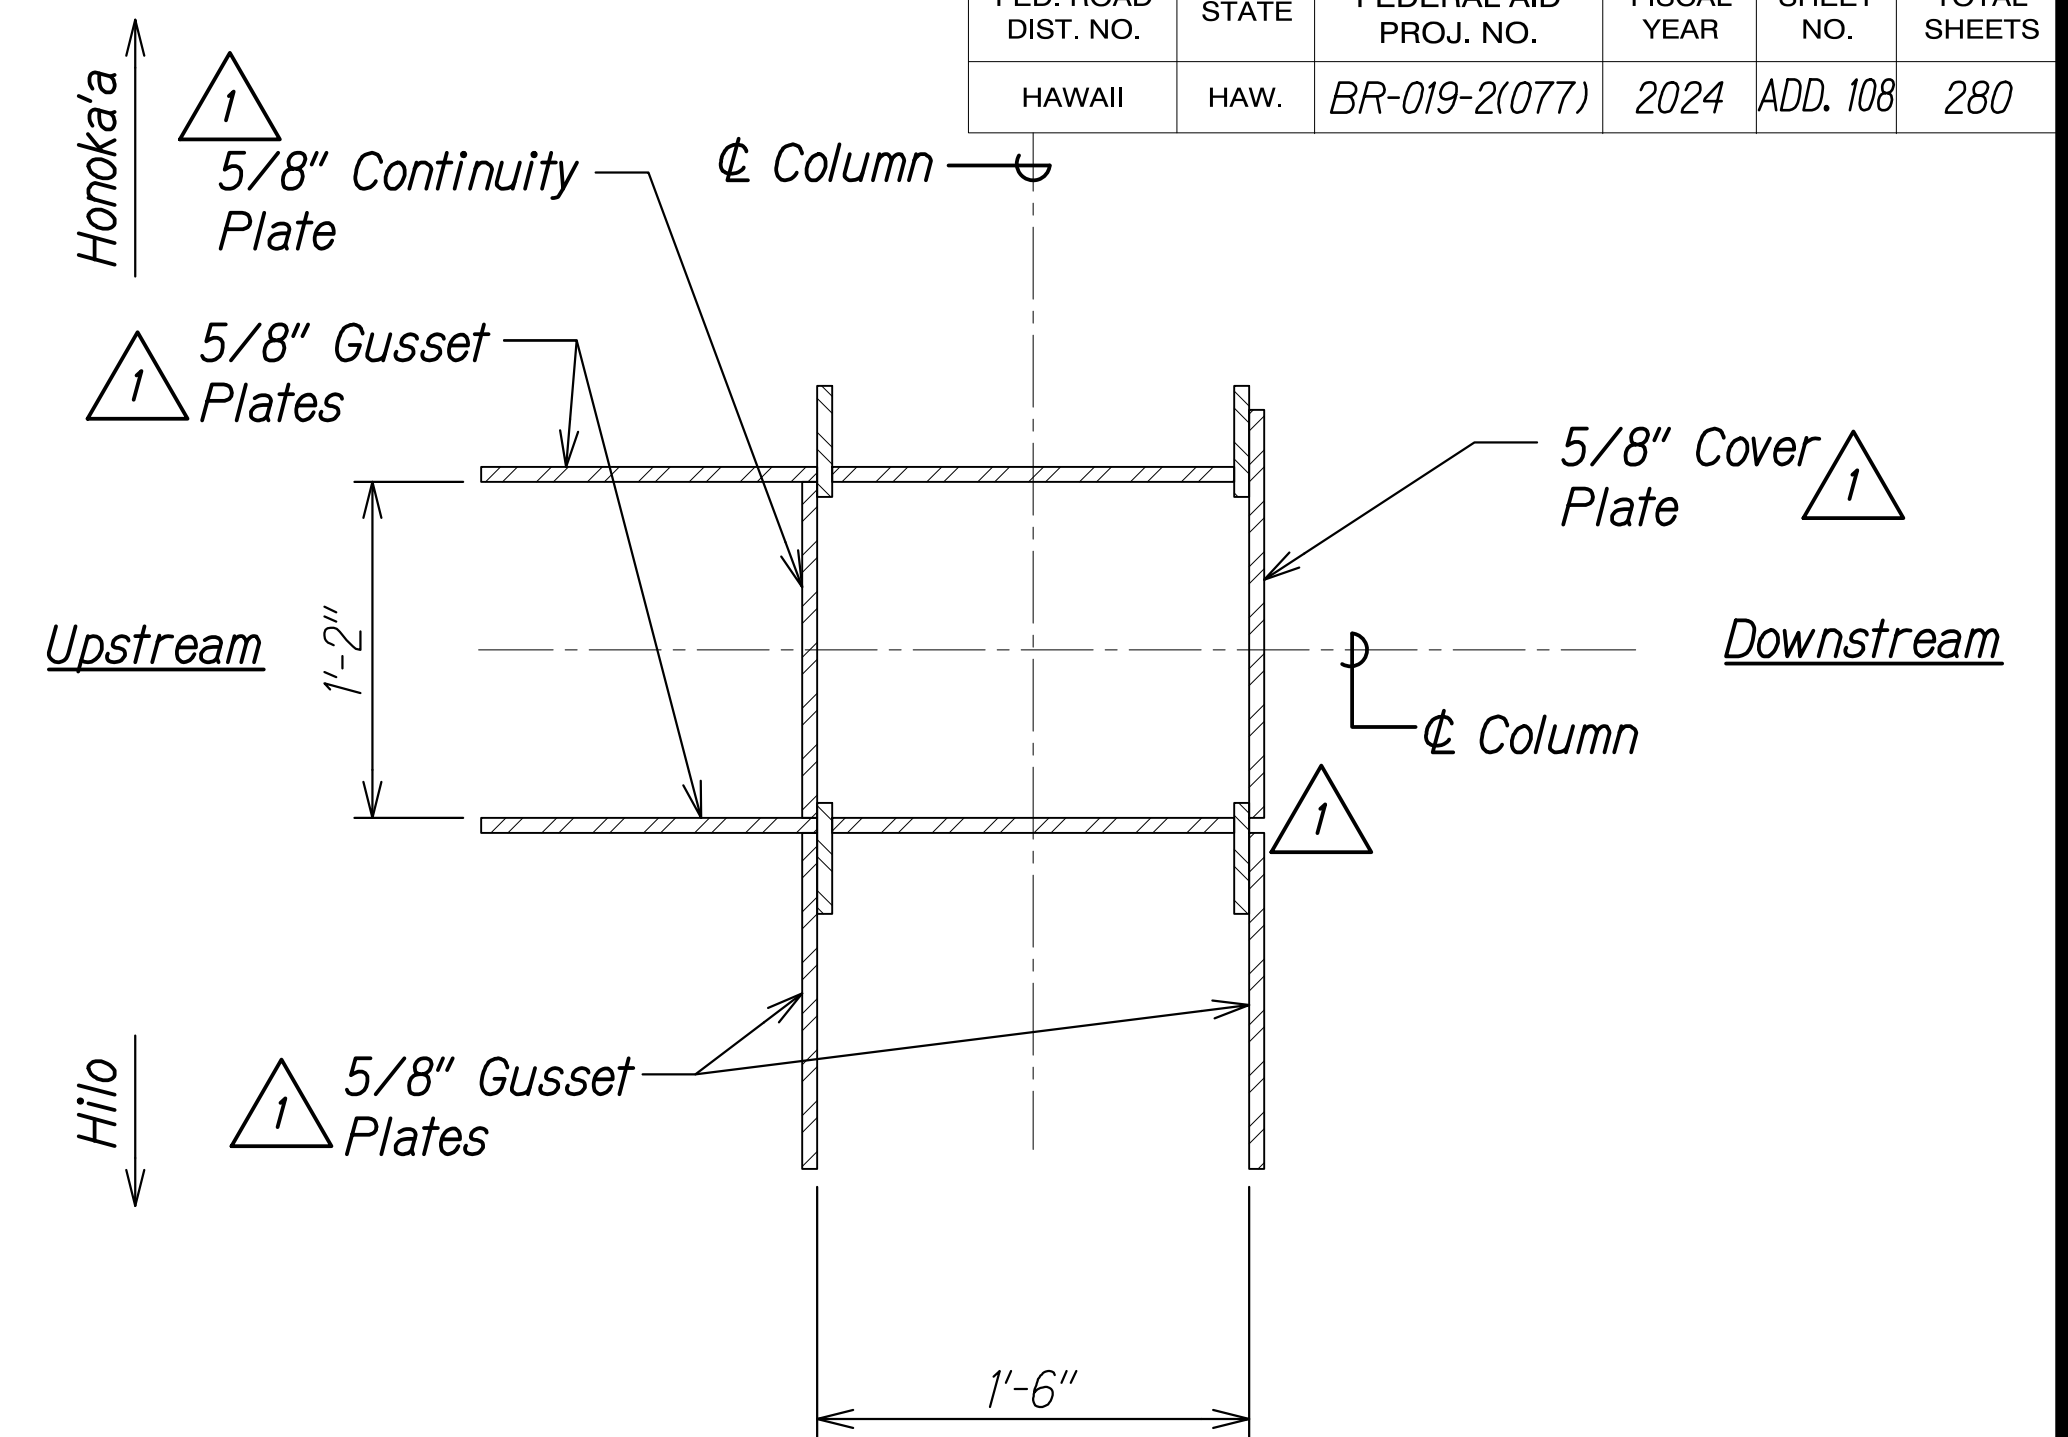


PLAN DETAIL C
Scale: 1 1/2" = 1'-0" SA6.2|SA6.2

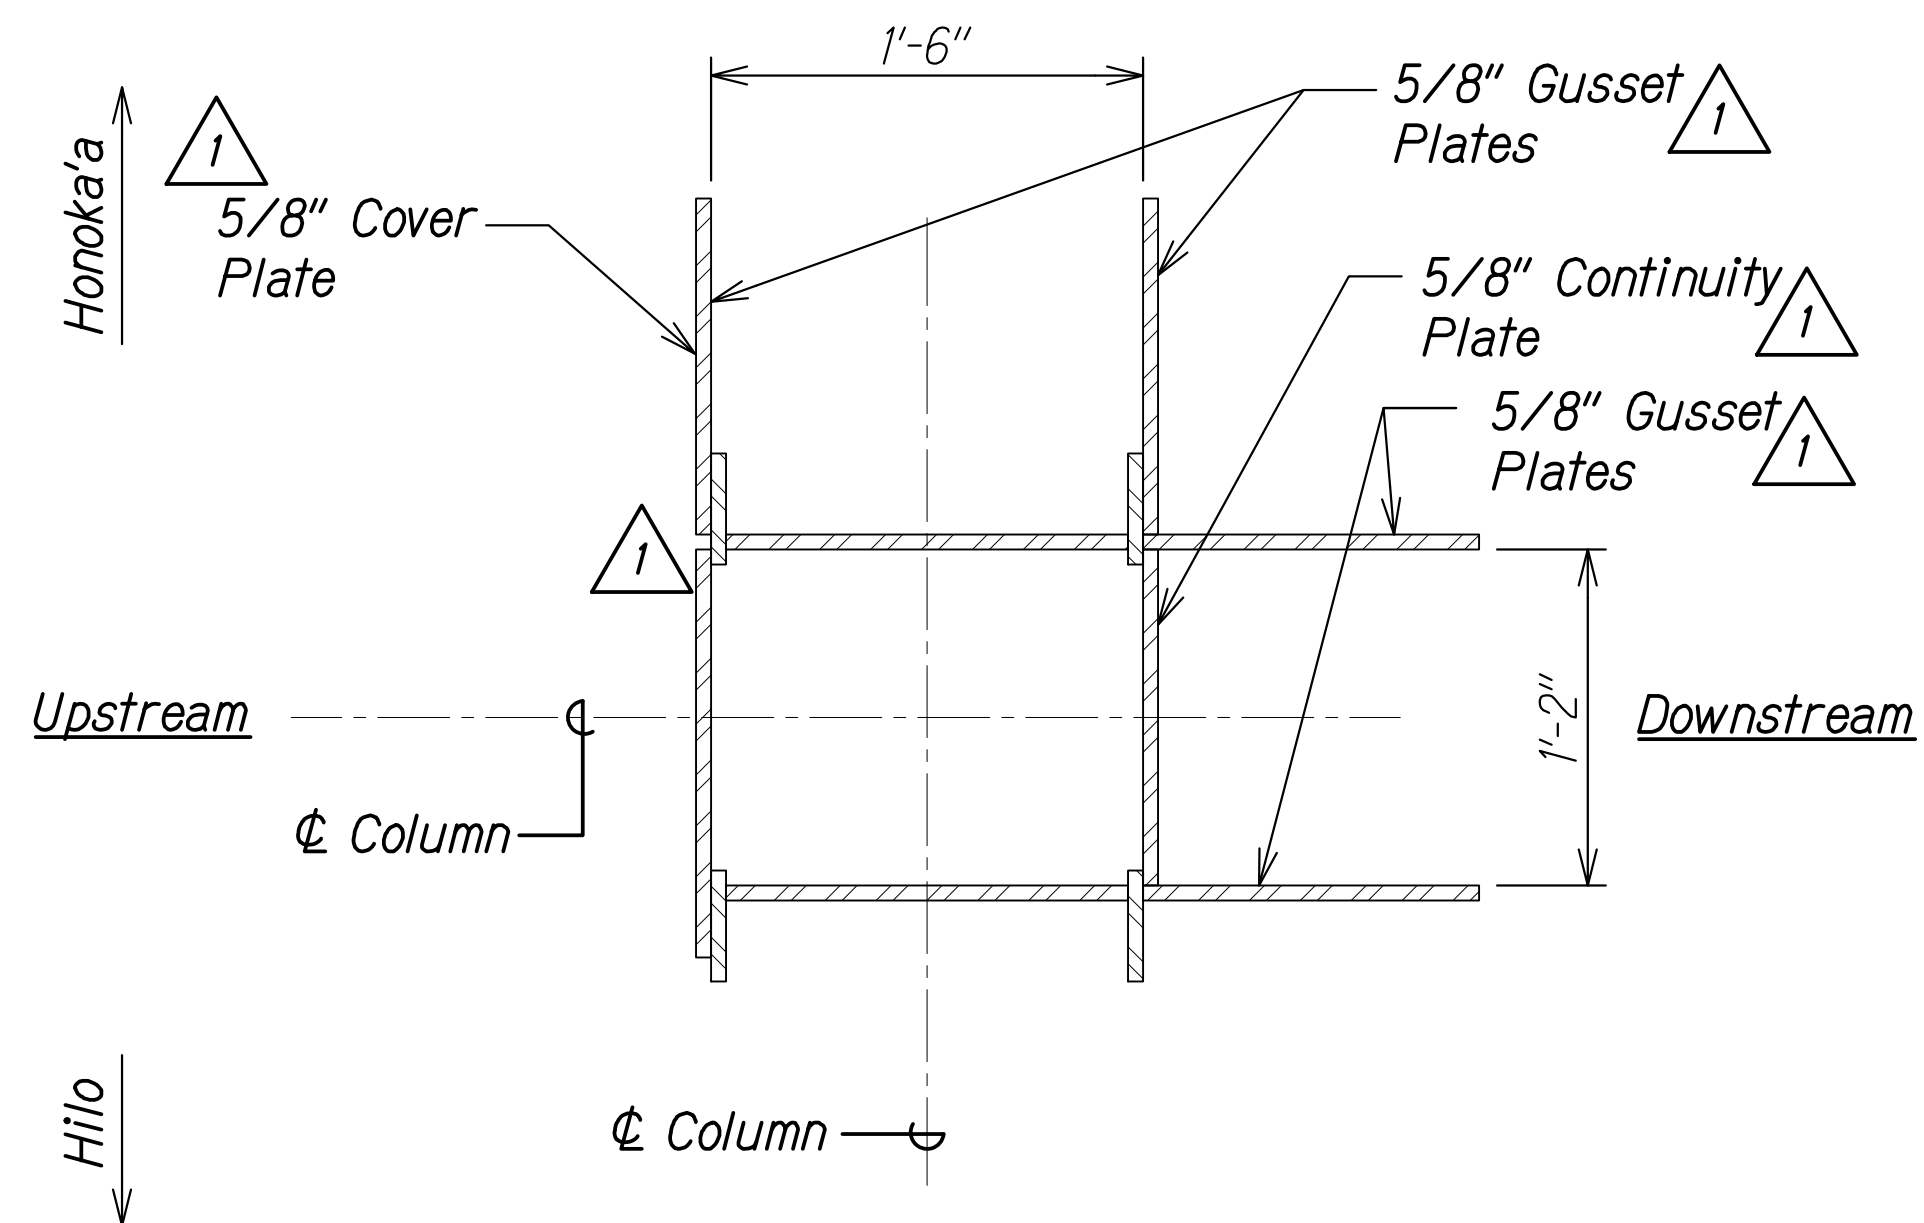

PLAN DETAIL D
Scale: 1 1/2" = 1'-0" SA6.2|SA6.2

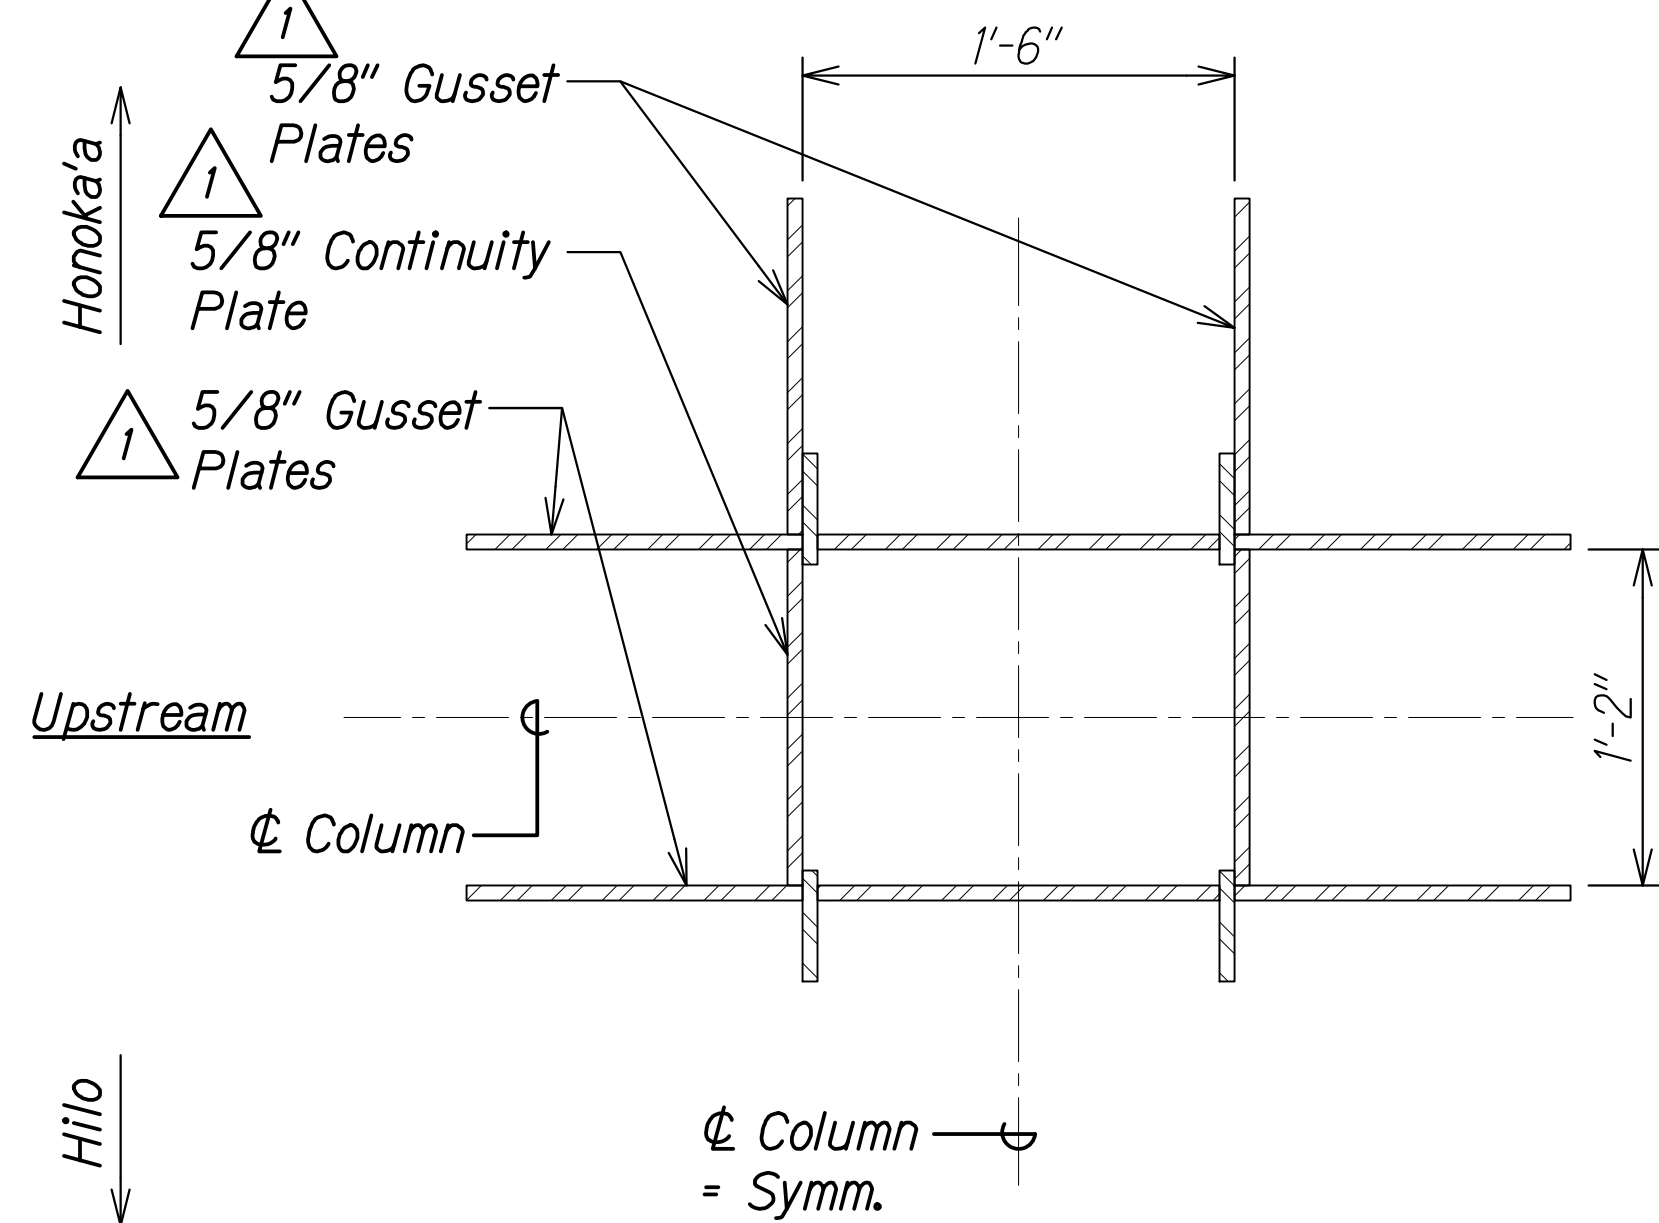

PLAN DETAIL E
Scale: 1 1/2" = 1'-0" SA6.2|SA6.2

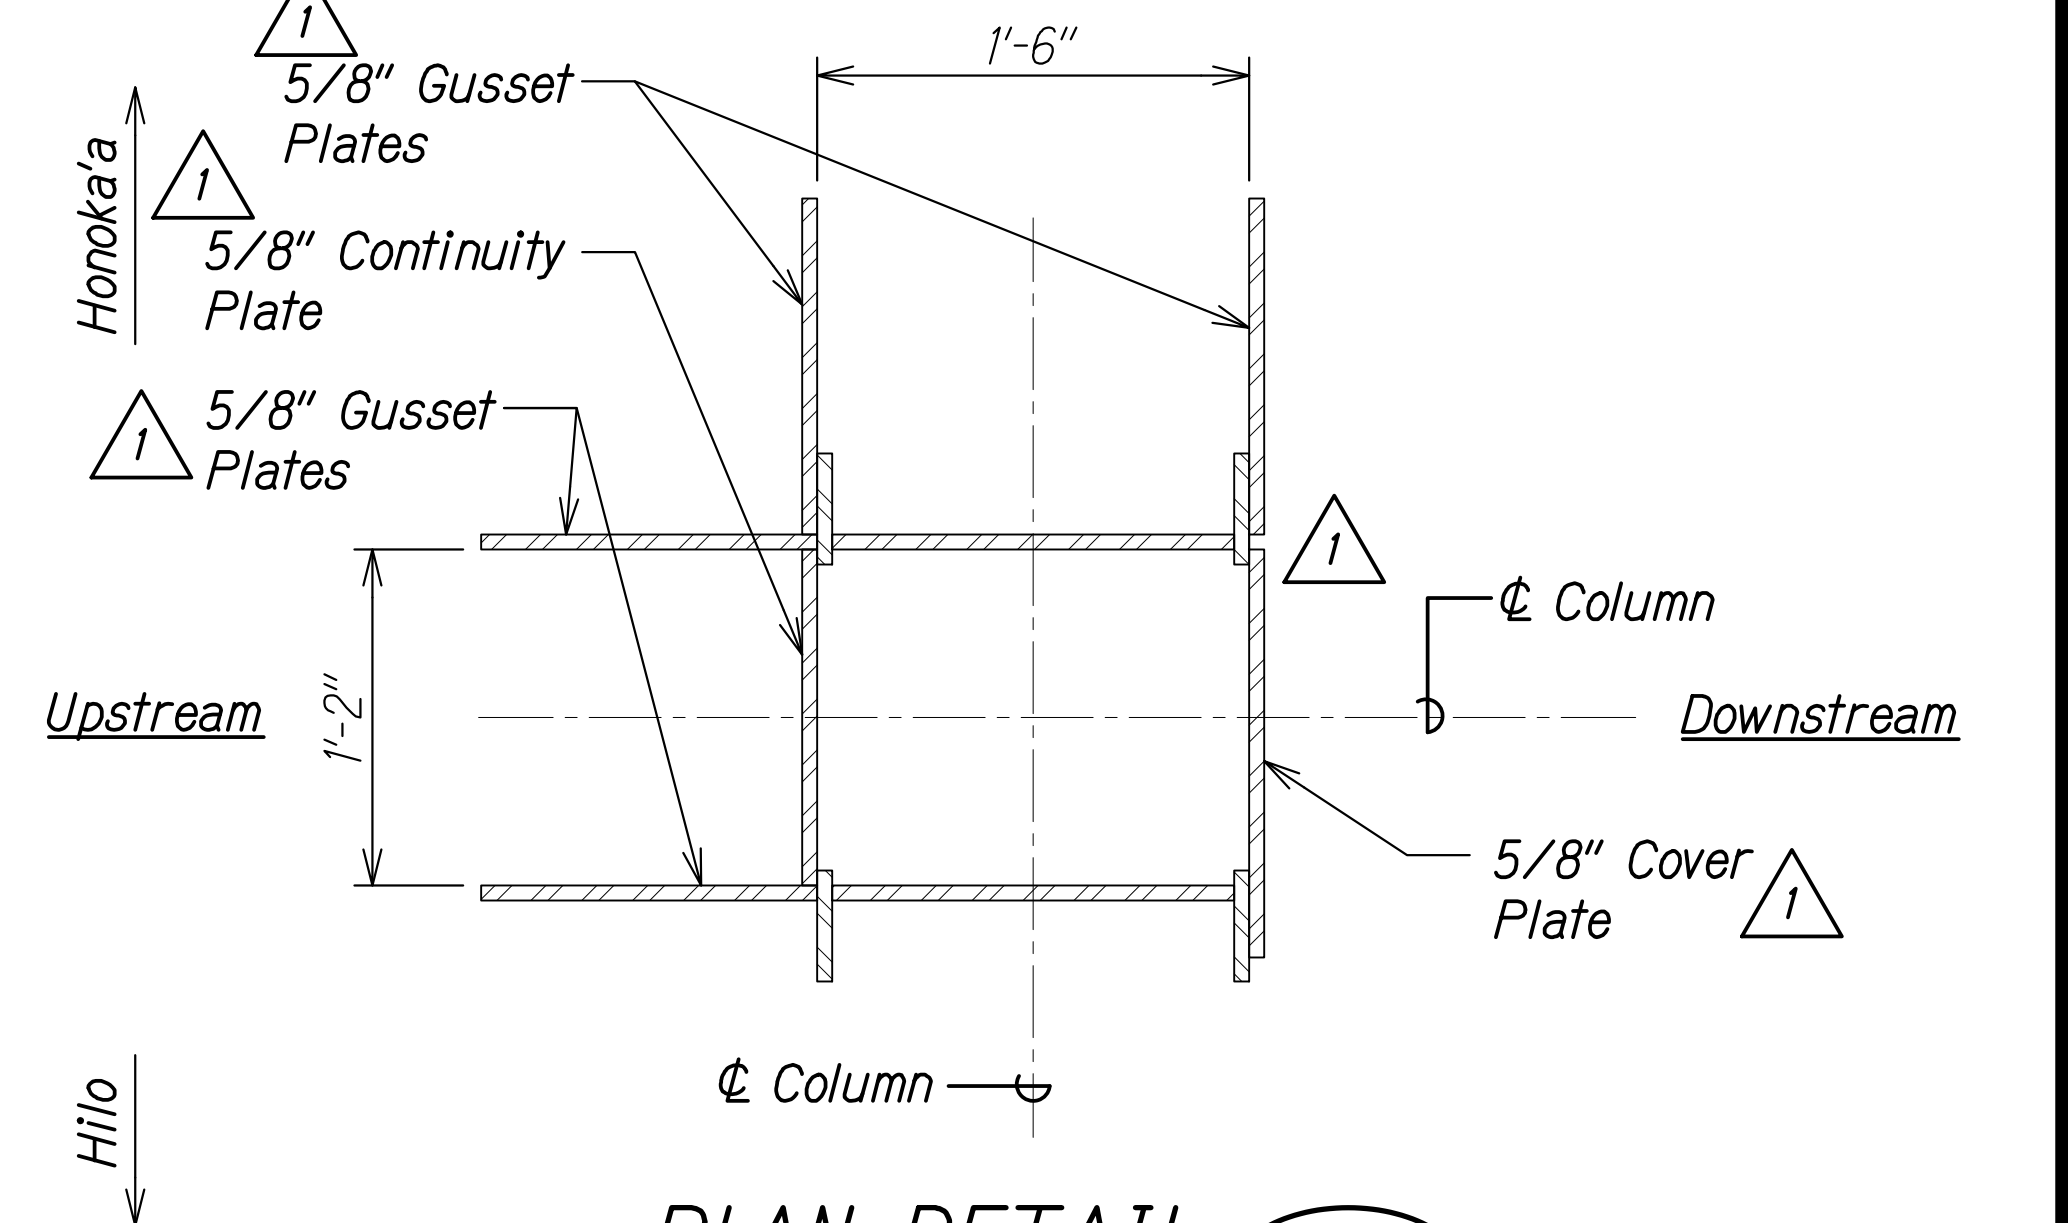


PLAN DETAIL F
Scale: 1 1/2" = 1'-0" SA6.2|SA6.2

NOTE:

Brace not shown for clarity.

12/6/24	1 Revised Callouts
DATE	REVISION

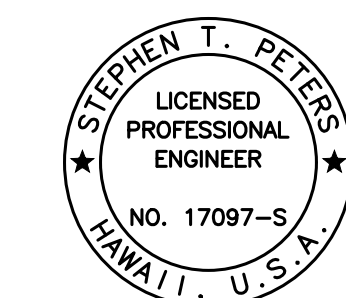

THIS WORK WAS PREPARED BY ME OR UNDER MY SUPERVISION.

SIGNATURE EXPIRATION DATE OF THE LICENSE

STATE OF HAWAII
DEPARTMENT OF TRANSPORTATION
HIGHWAYS DIVISION


**COLUMN TO BRACE
CONNECTION DETAILS**

HAWAII BELT ROAD
Nanue Stream Bridge Rehabilitation
Federal Aid Project No. BR-019-2(077)


Scale: As Noted Date: Oct. 2024

SHEET No. SA6.2 OF 22 SHEETS

FED. ROAD DIST. NO.	STATE	FEDERAL AID PROJ. NO.	FISCAL YEAR	SHEET NO.	TOTAL SHEETS
HAWAII	HAW.	BR-019-2(077)	2024	ADD. 109	280

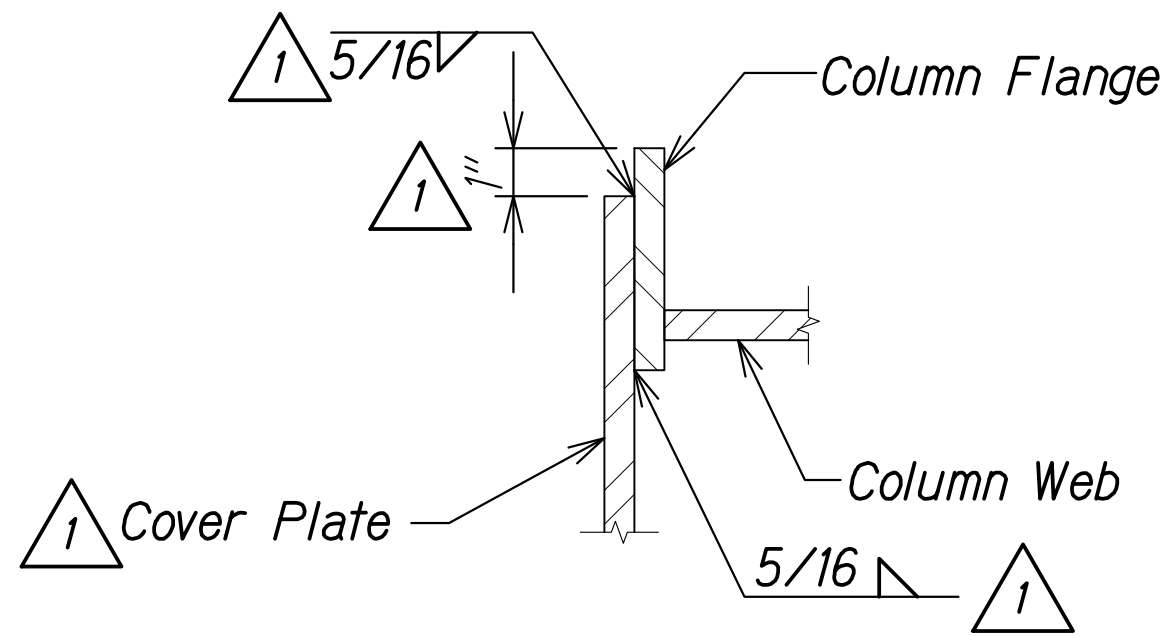


DETAIL 1
Scale: 3" = 1'-0" SA6.2|SA6.3

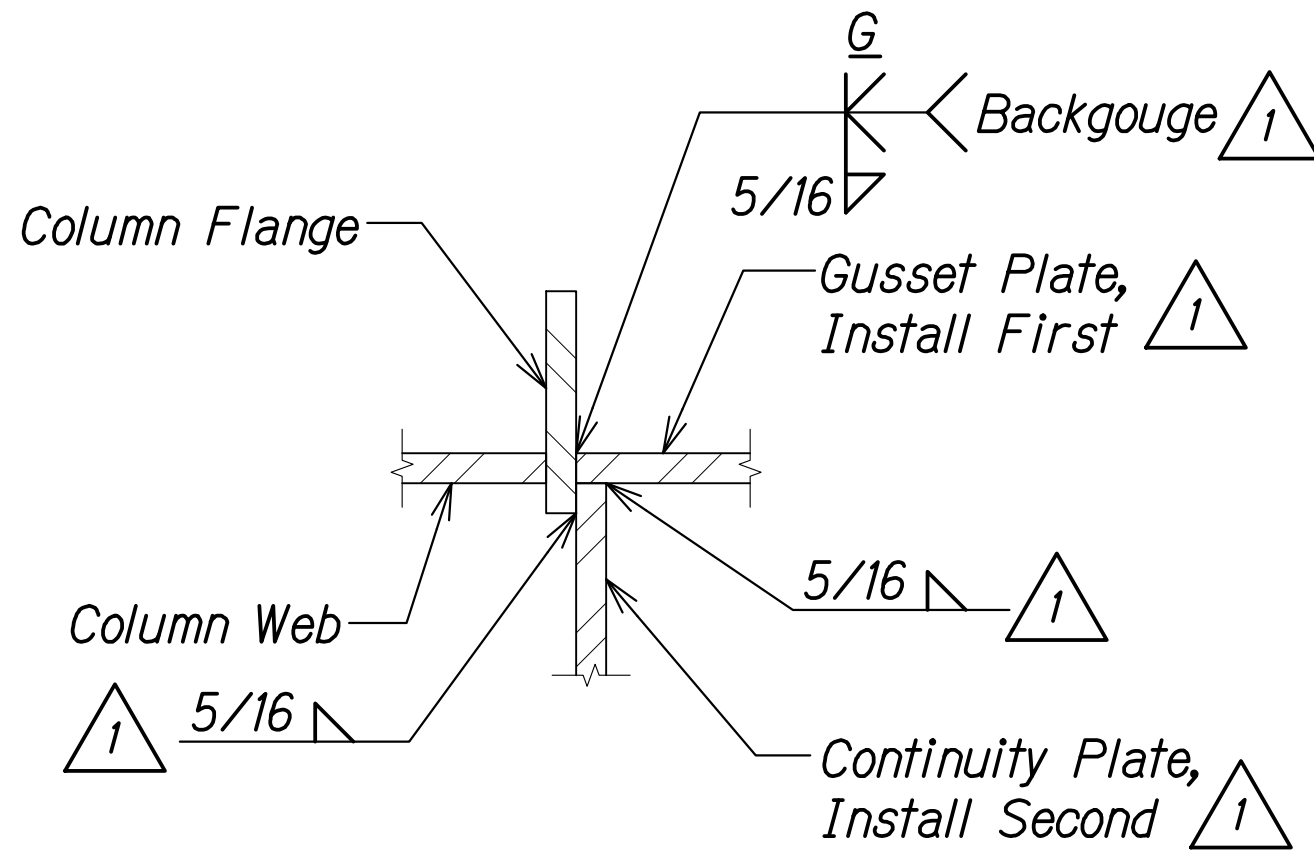


DETAIL 2
Scale: 3" = 1'-0" SA6.2|SA6.3

NOTE:
All gusset/cover/continuity/stiffener plates shall receive return fillet welds across the top and bottom connection at faying edge with column flange and column seat to provide a full seal weld to prevent moisture intrusion.

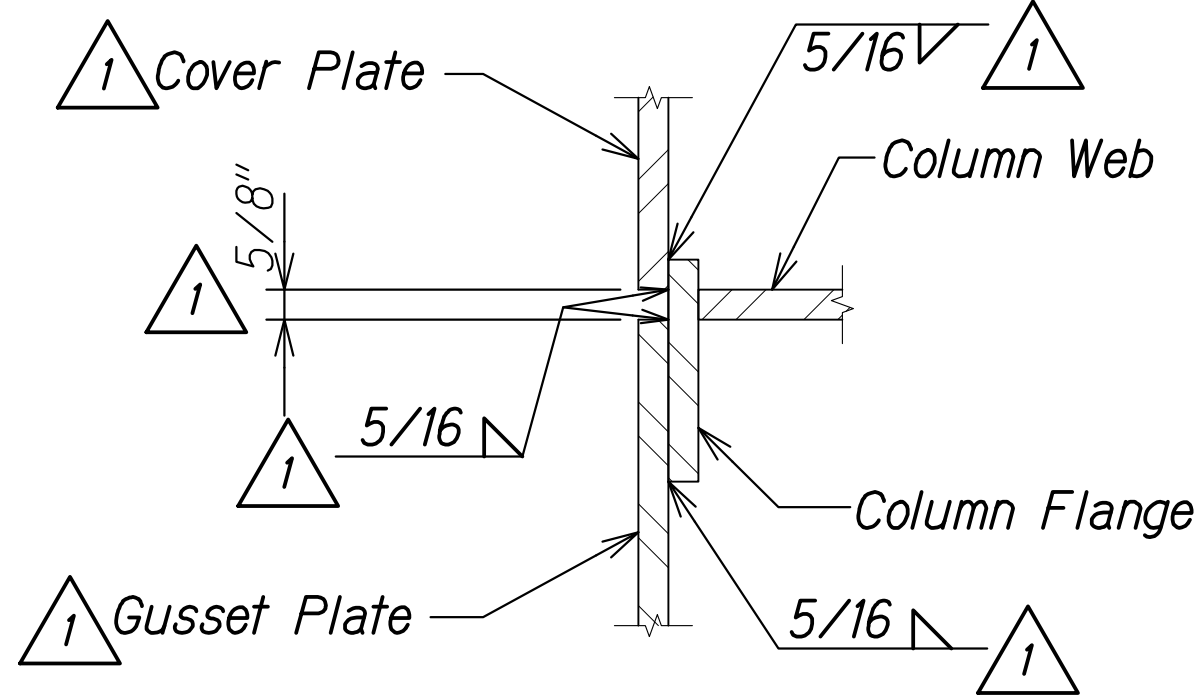


DETAIL 3
Scale: 3" = 1'-0" SA6.2|SA6.3

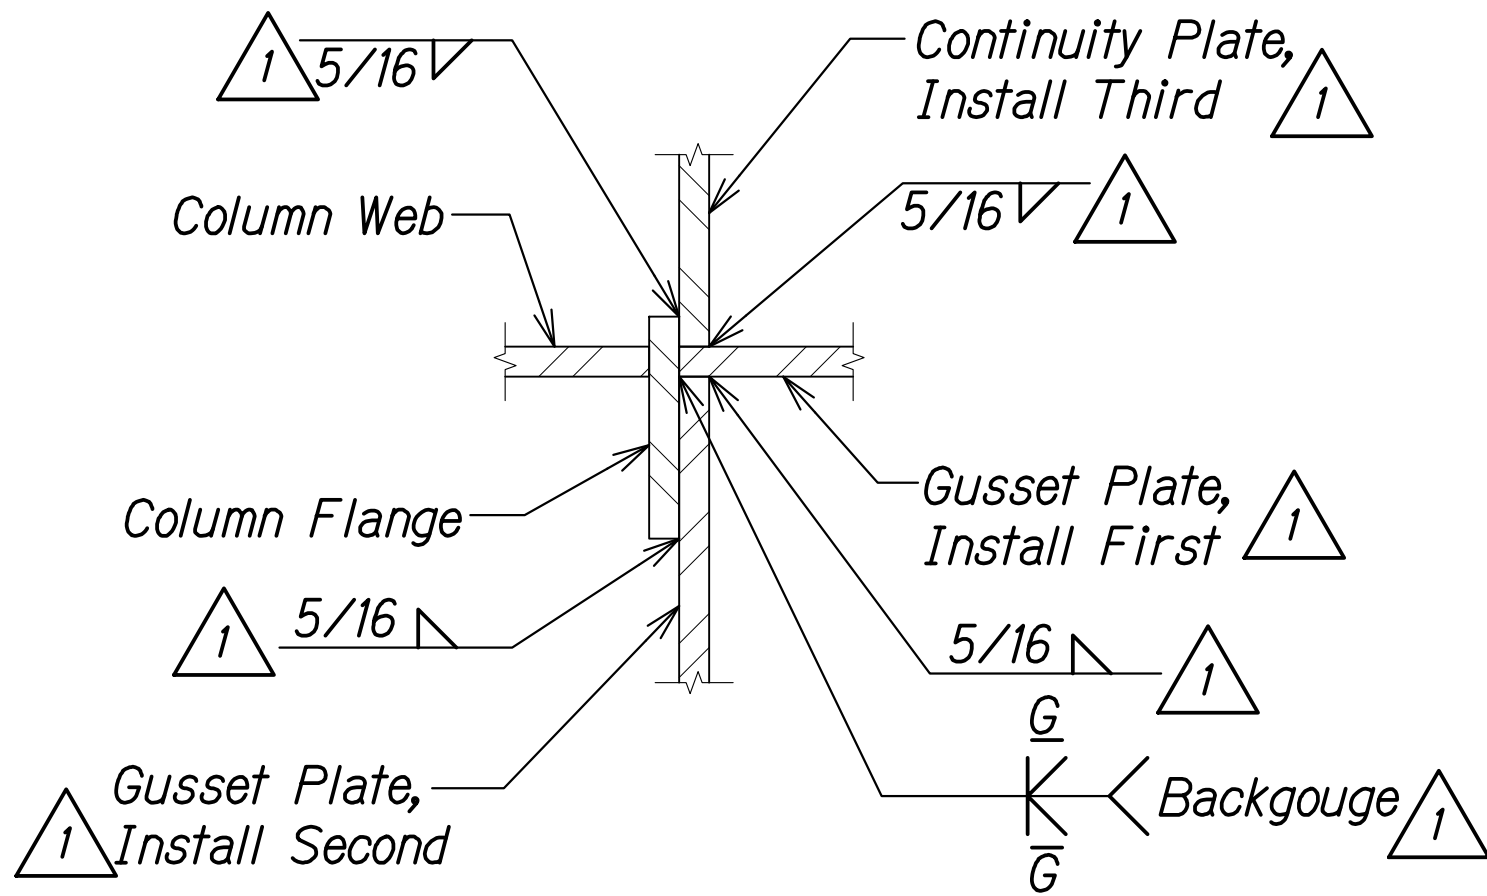

DETAIL 4
Scale: 3" = 1'-0" SA6.2|SA6.3


ORIGINAL PLAN	SURVEY PLOTTED BY	DATE
NOTE BOOK	DRAWN BY	
No.	DESIGNED BY	
	QUANTITIES BY	
	CHECKED BY	

DRAWING NAME: Z:\00 ONGOING\23-022.9-NANUE STR BR PF2-DOT\01 CAD\12-06-24 ADD\NSR-SAG602-SAG617 CONN DTL'S ADD2.DWG PLOT TIME: 12-05-24 1:11 PM

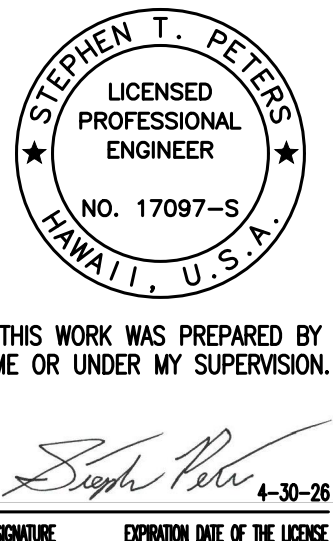


12/6/24	1	Revised Callouts and Added Note
DATE	REVISION	
STATE OF HAWAII DEPARTMENT OF TRANSPORTATION HIGHWAYS DIVISION COLUMN TO BRACE CONNECTION DETAILS HAWAII BELT ROAD Nanue Stream Bridge Rehabilitation Federal Aid Project No. BR-019-2(077) Scale: As Noted Date: Oct. 2024		
SHEET No. SA6.3 OF 22 SHEETS		


FED. ROAD DIST. NO.	STATE	FEDERAL AID PROJ. NO.	FISCAL YEAR	SHEET NO.	TOTAL SHEETS
HAWAII	HAW.	BR-019-2(077)	2024	ADD. 110	280

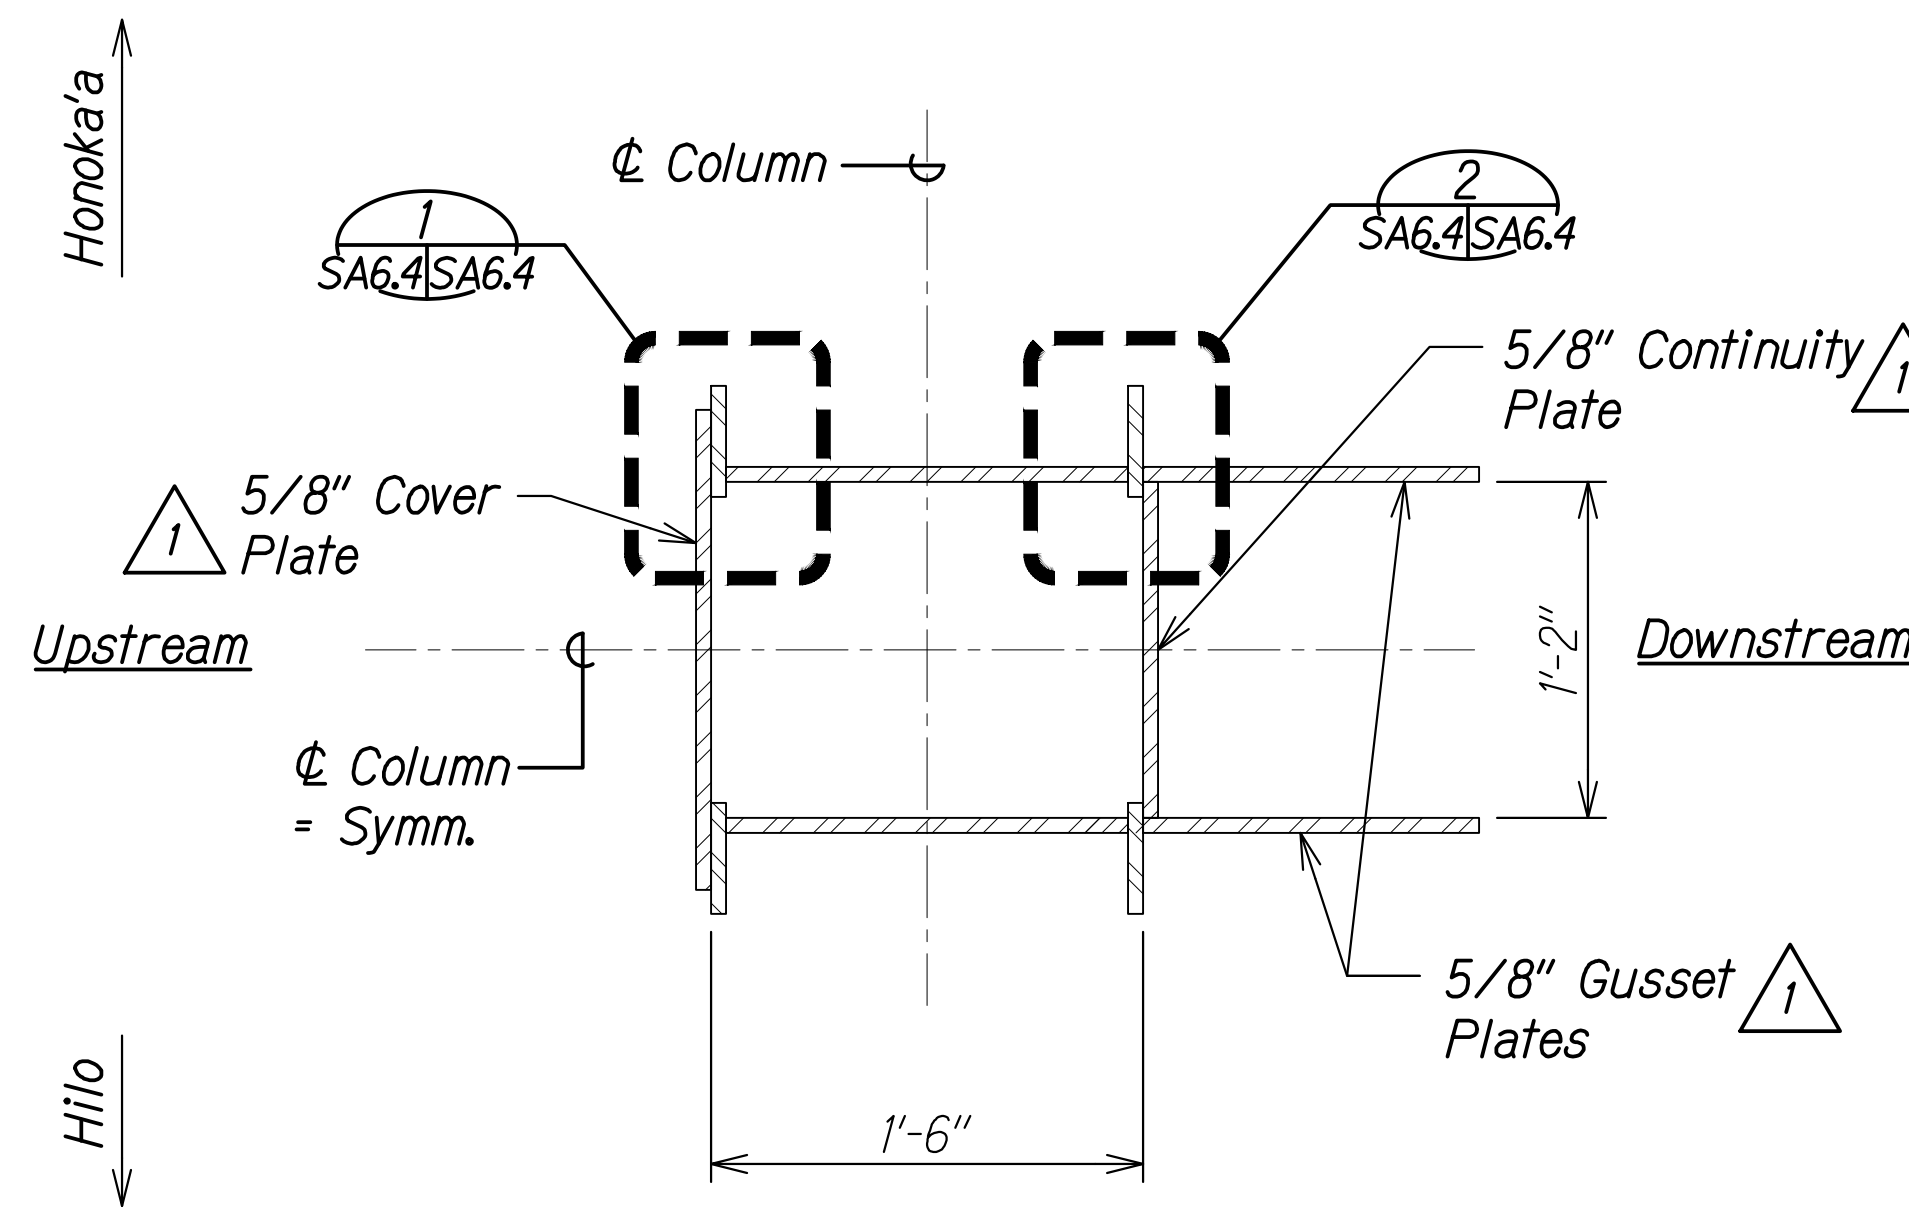


PLAN DETAIL A
Scale: 1 1/2" = 1'-0" SA6.4 SA6.4

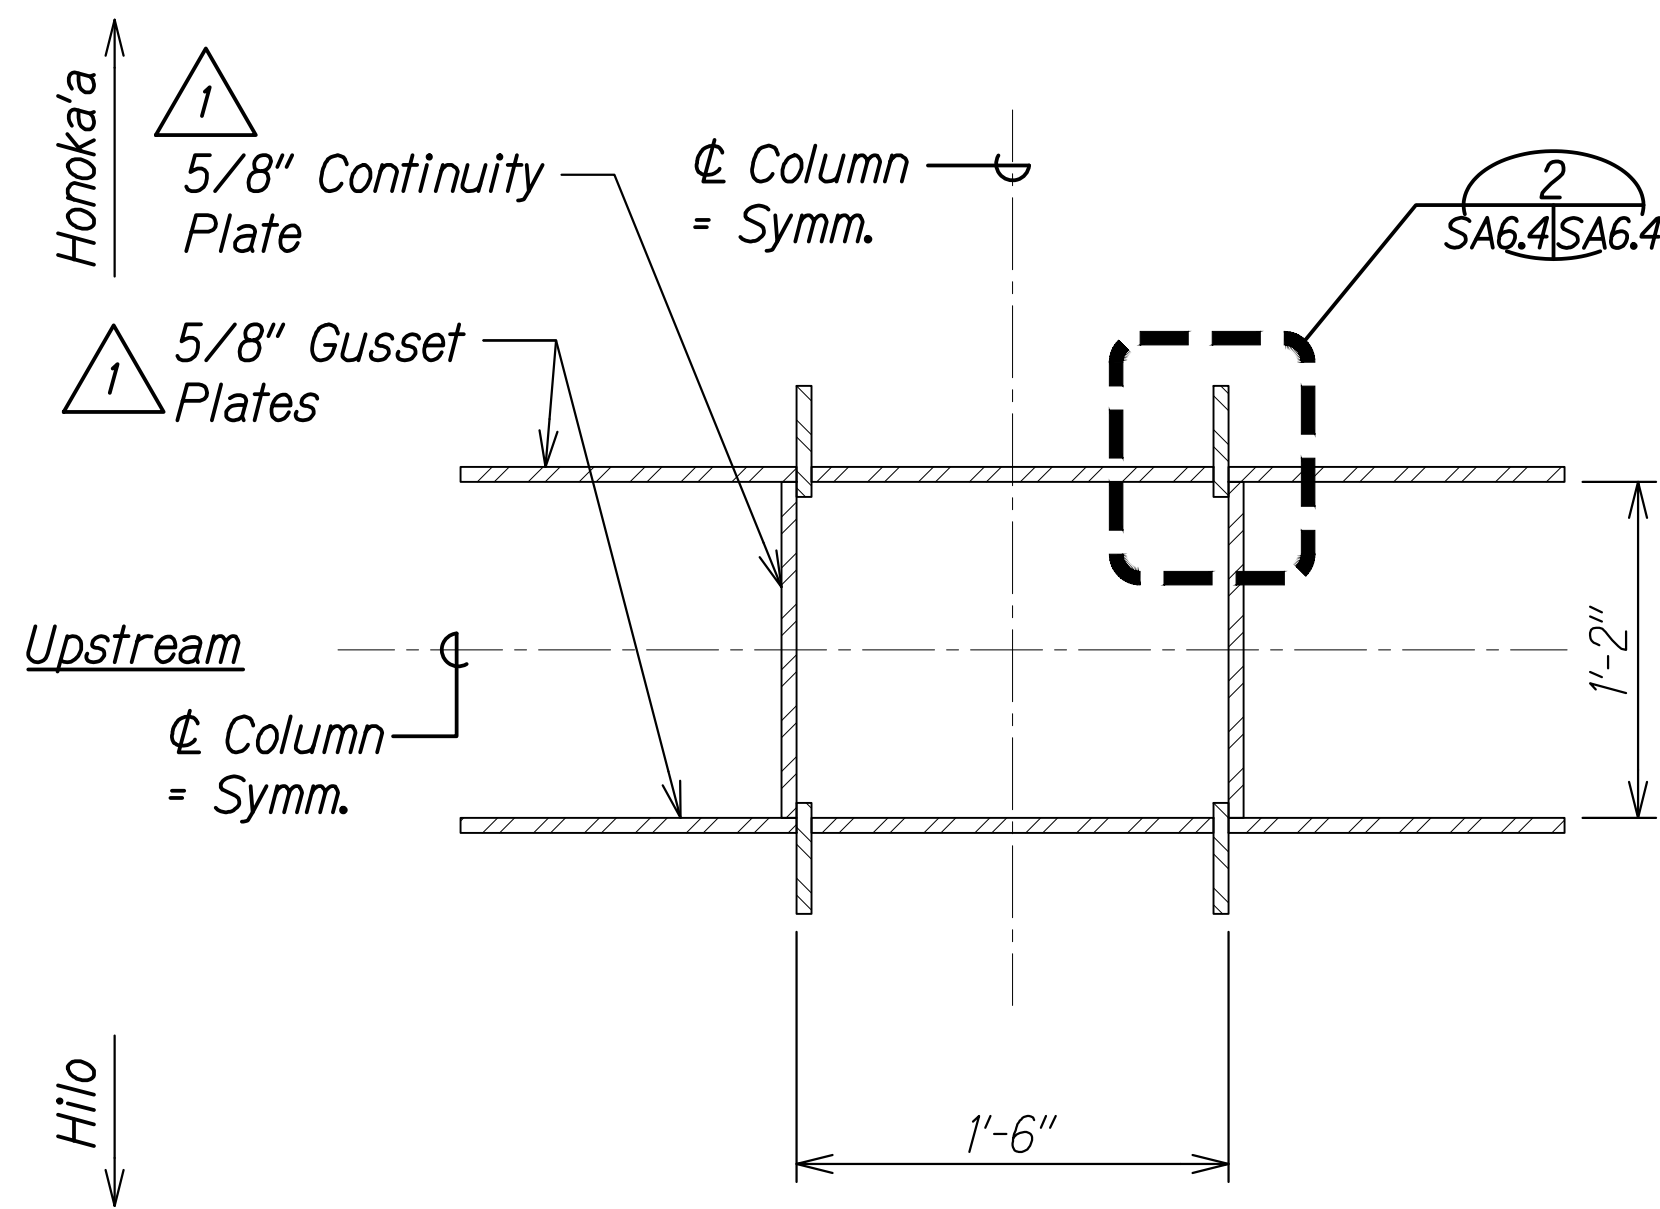


PLAN DETAIL B
Scale: 1 1/2" = 1'-0" SA6.4 SA6.4

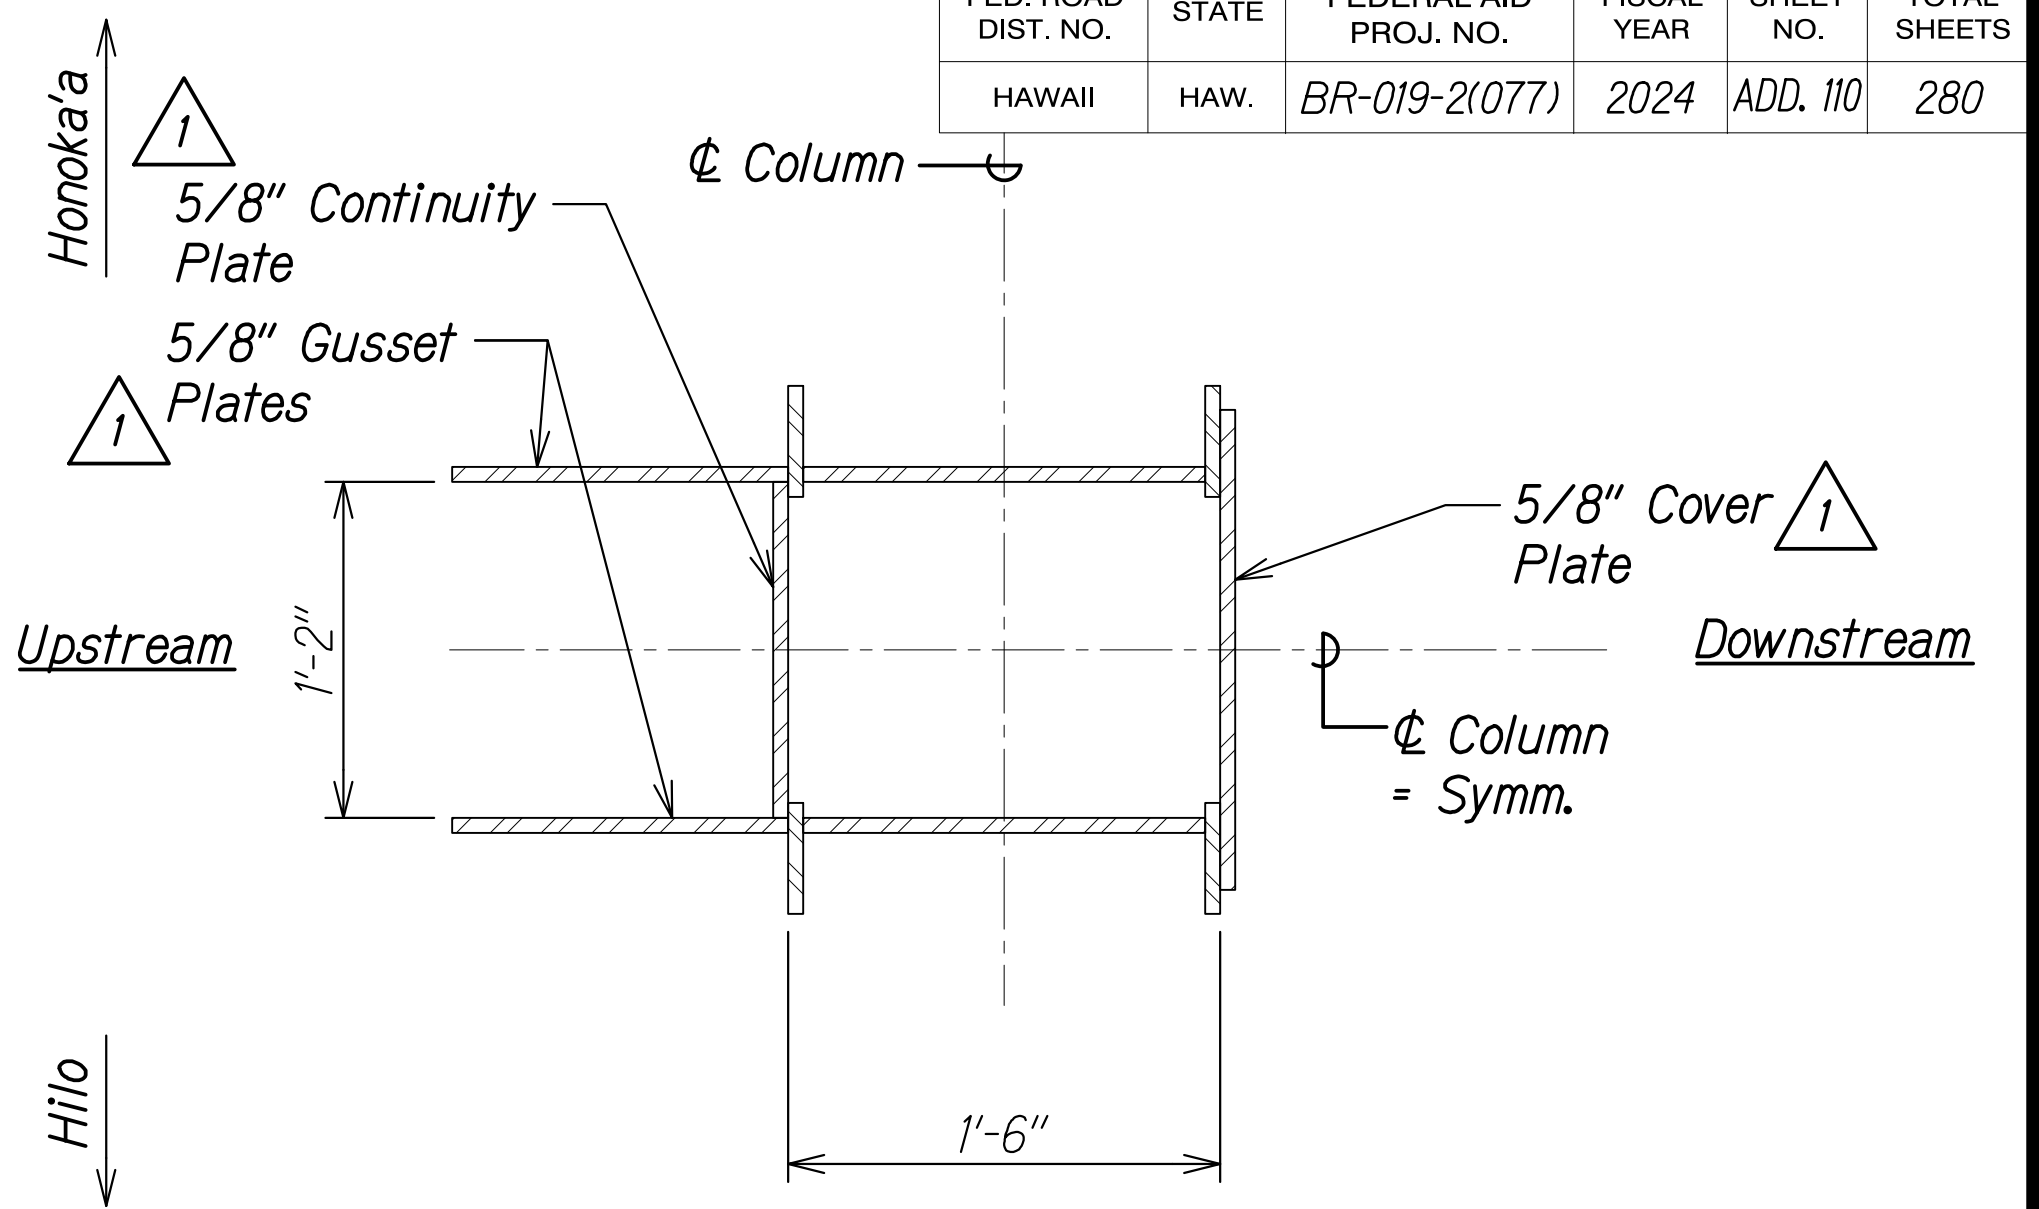

PLAN DETAIL C
Scale: 1 1/2" = 1'-0" SA6.4 SA6.4

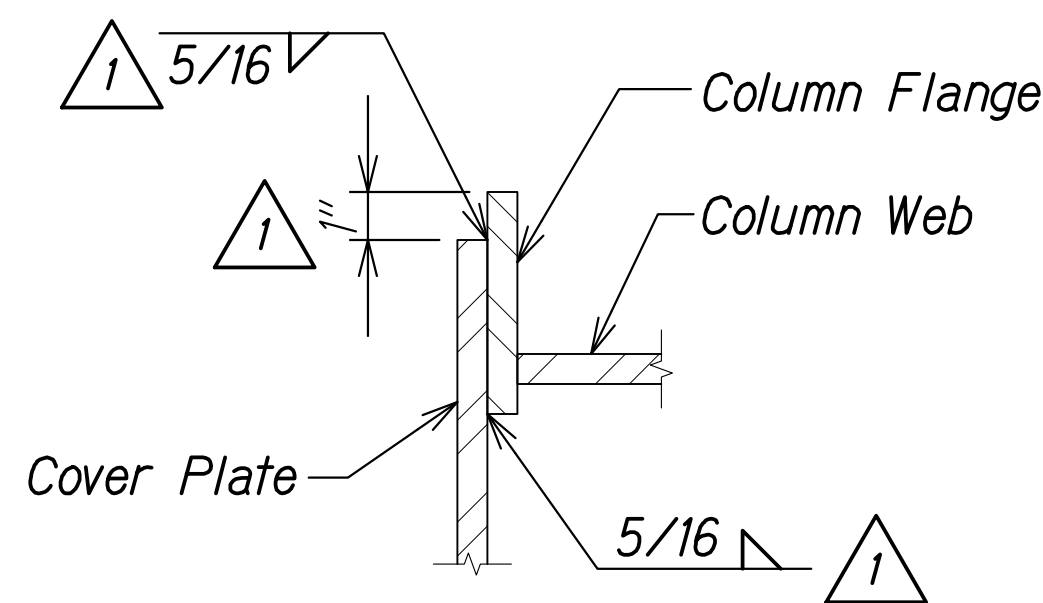


DETAIL 1
Scale: 3" = 1'-0" SA6.4 SA6.4

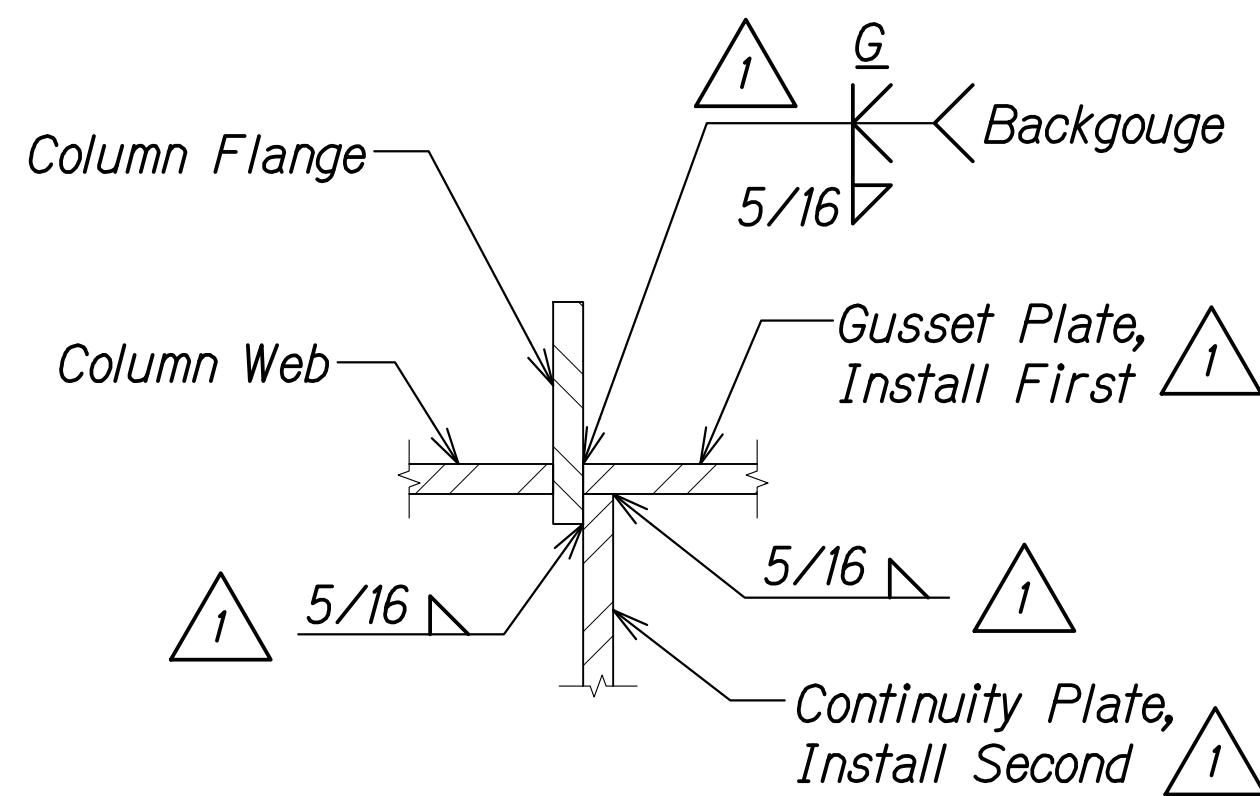

DETAIL 2
Scale: 3" = 1'-0" SA6.4 SA6.4


NOTE:

All gusset/cover/continuity/stiffener plates shall receive return fillet welds across the top and bottom connection at faying edge with column flange and column seat to provide a full seal weld to prevent moisture intrusion.

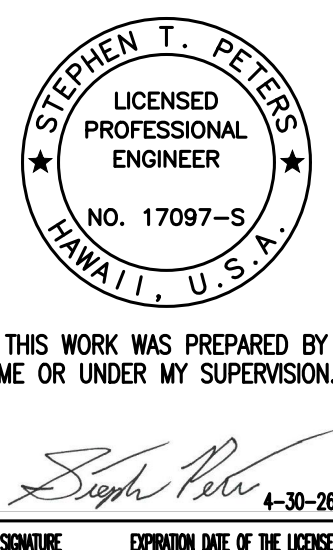

12/6/24	1	Revised Callouts and Added Dimensions & Notes
DATE	REVISION	
STATE OF HAWAII DEPARTMENT OF TRANSPORTATION HIGHWAYS DIVISION COLUMN TO BRACE CONNECTION DETAILS HAWAII BELT ROAD Nanue Stream Bridge Rehabilitation Federal Aid Project No. BR-019-2(077) Scale: As Noted Date: Oct. 2024		
SHEET No. SA6.4 OF 22 SHEETS		


FED. ROAD DIST. NO.	STATE	FEDERAL AID PROJ. NO.	FISCAL YEAR	SHEET NO.	TOTAL SHEETS
HAWAII	HAW.	BR-019-2(077)	2024	ADD. 111	280

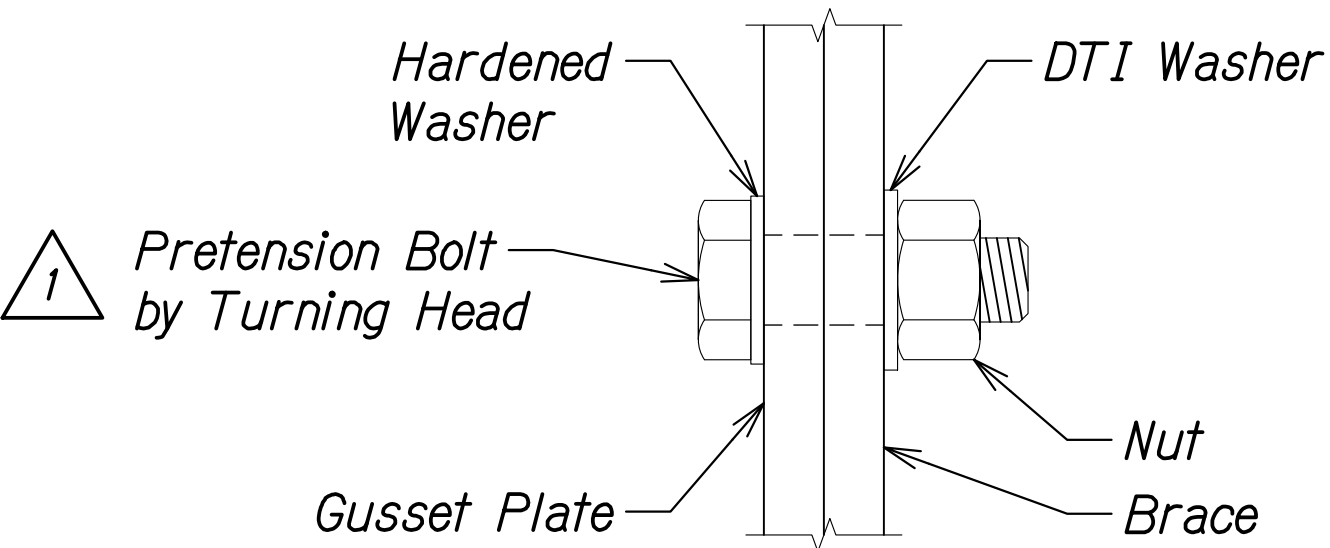


TYPICAL BRACE
BOLT CONNECTION DETAIL 5
Scale: 6" = 1'-0" SA6.5 SA6.5

NOTES:


- The Contractor's Steel Detailer is responsible for determining the actual size of each gusset/continuity/cover plate based on the information provided in the Contract Drawings.
- All bolted connections for horizontal and diagonal braces, as detailed on this sheet, shall be pretensioned.
- After erection, touch-up paint the ends of all bolts/nuts/washers.
- Batten plates and lacing not shown for clarity.
- See Schedule on sheet SA6.6 for WP offsets.

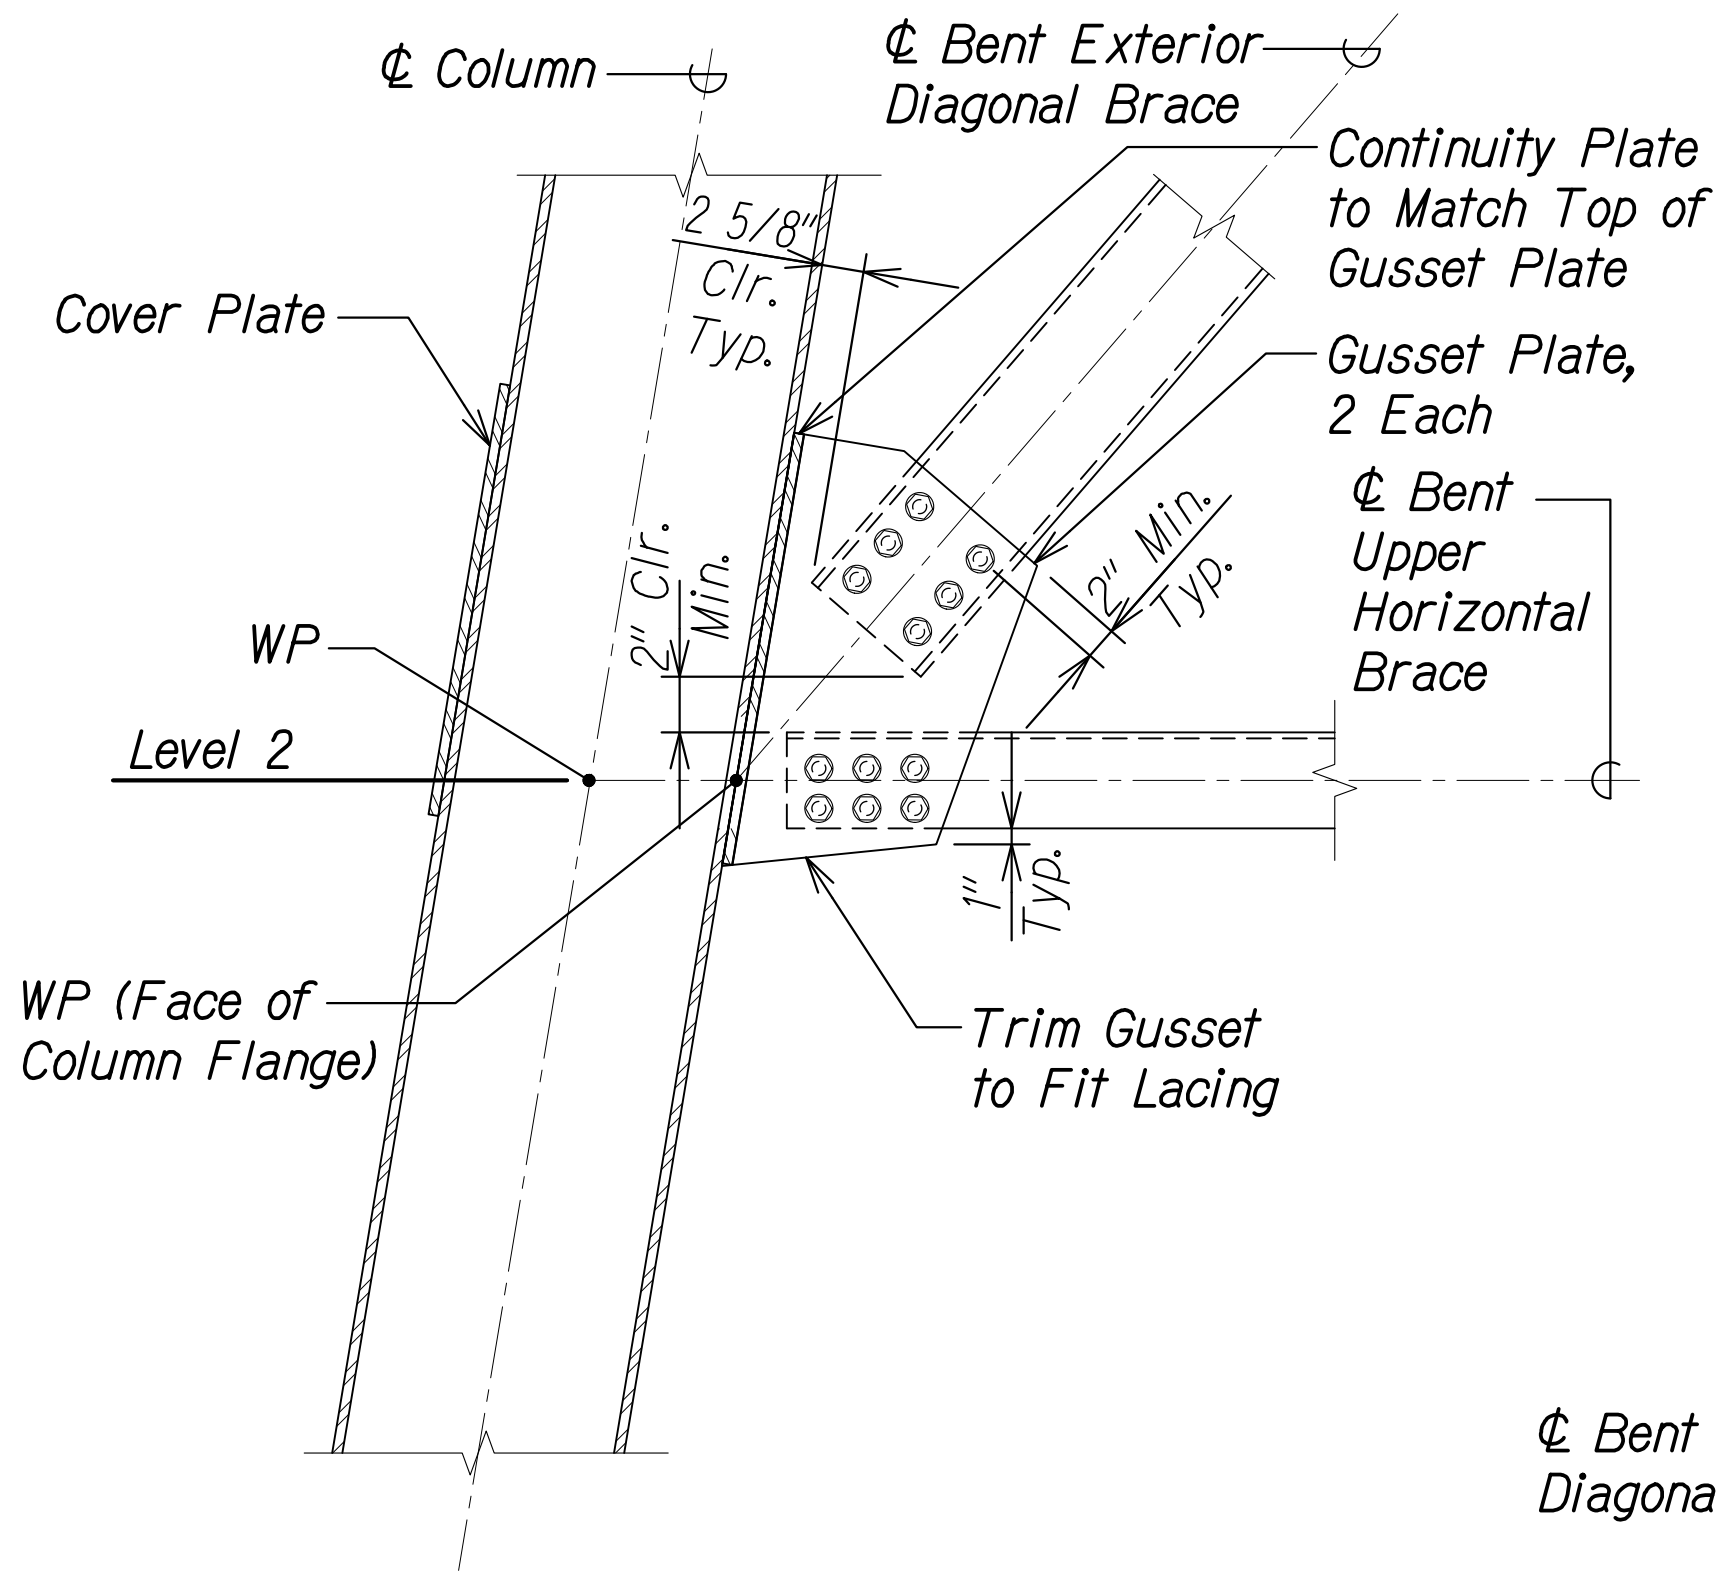


EXTERIOR COLUMN TO BRACE
CONNECTION DETAIL 1
Scale: 1" = 1'-0" SA6.5 SA6.5

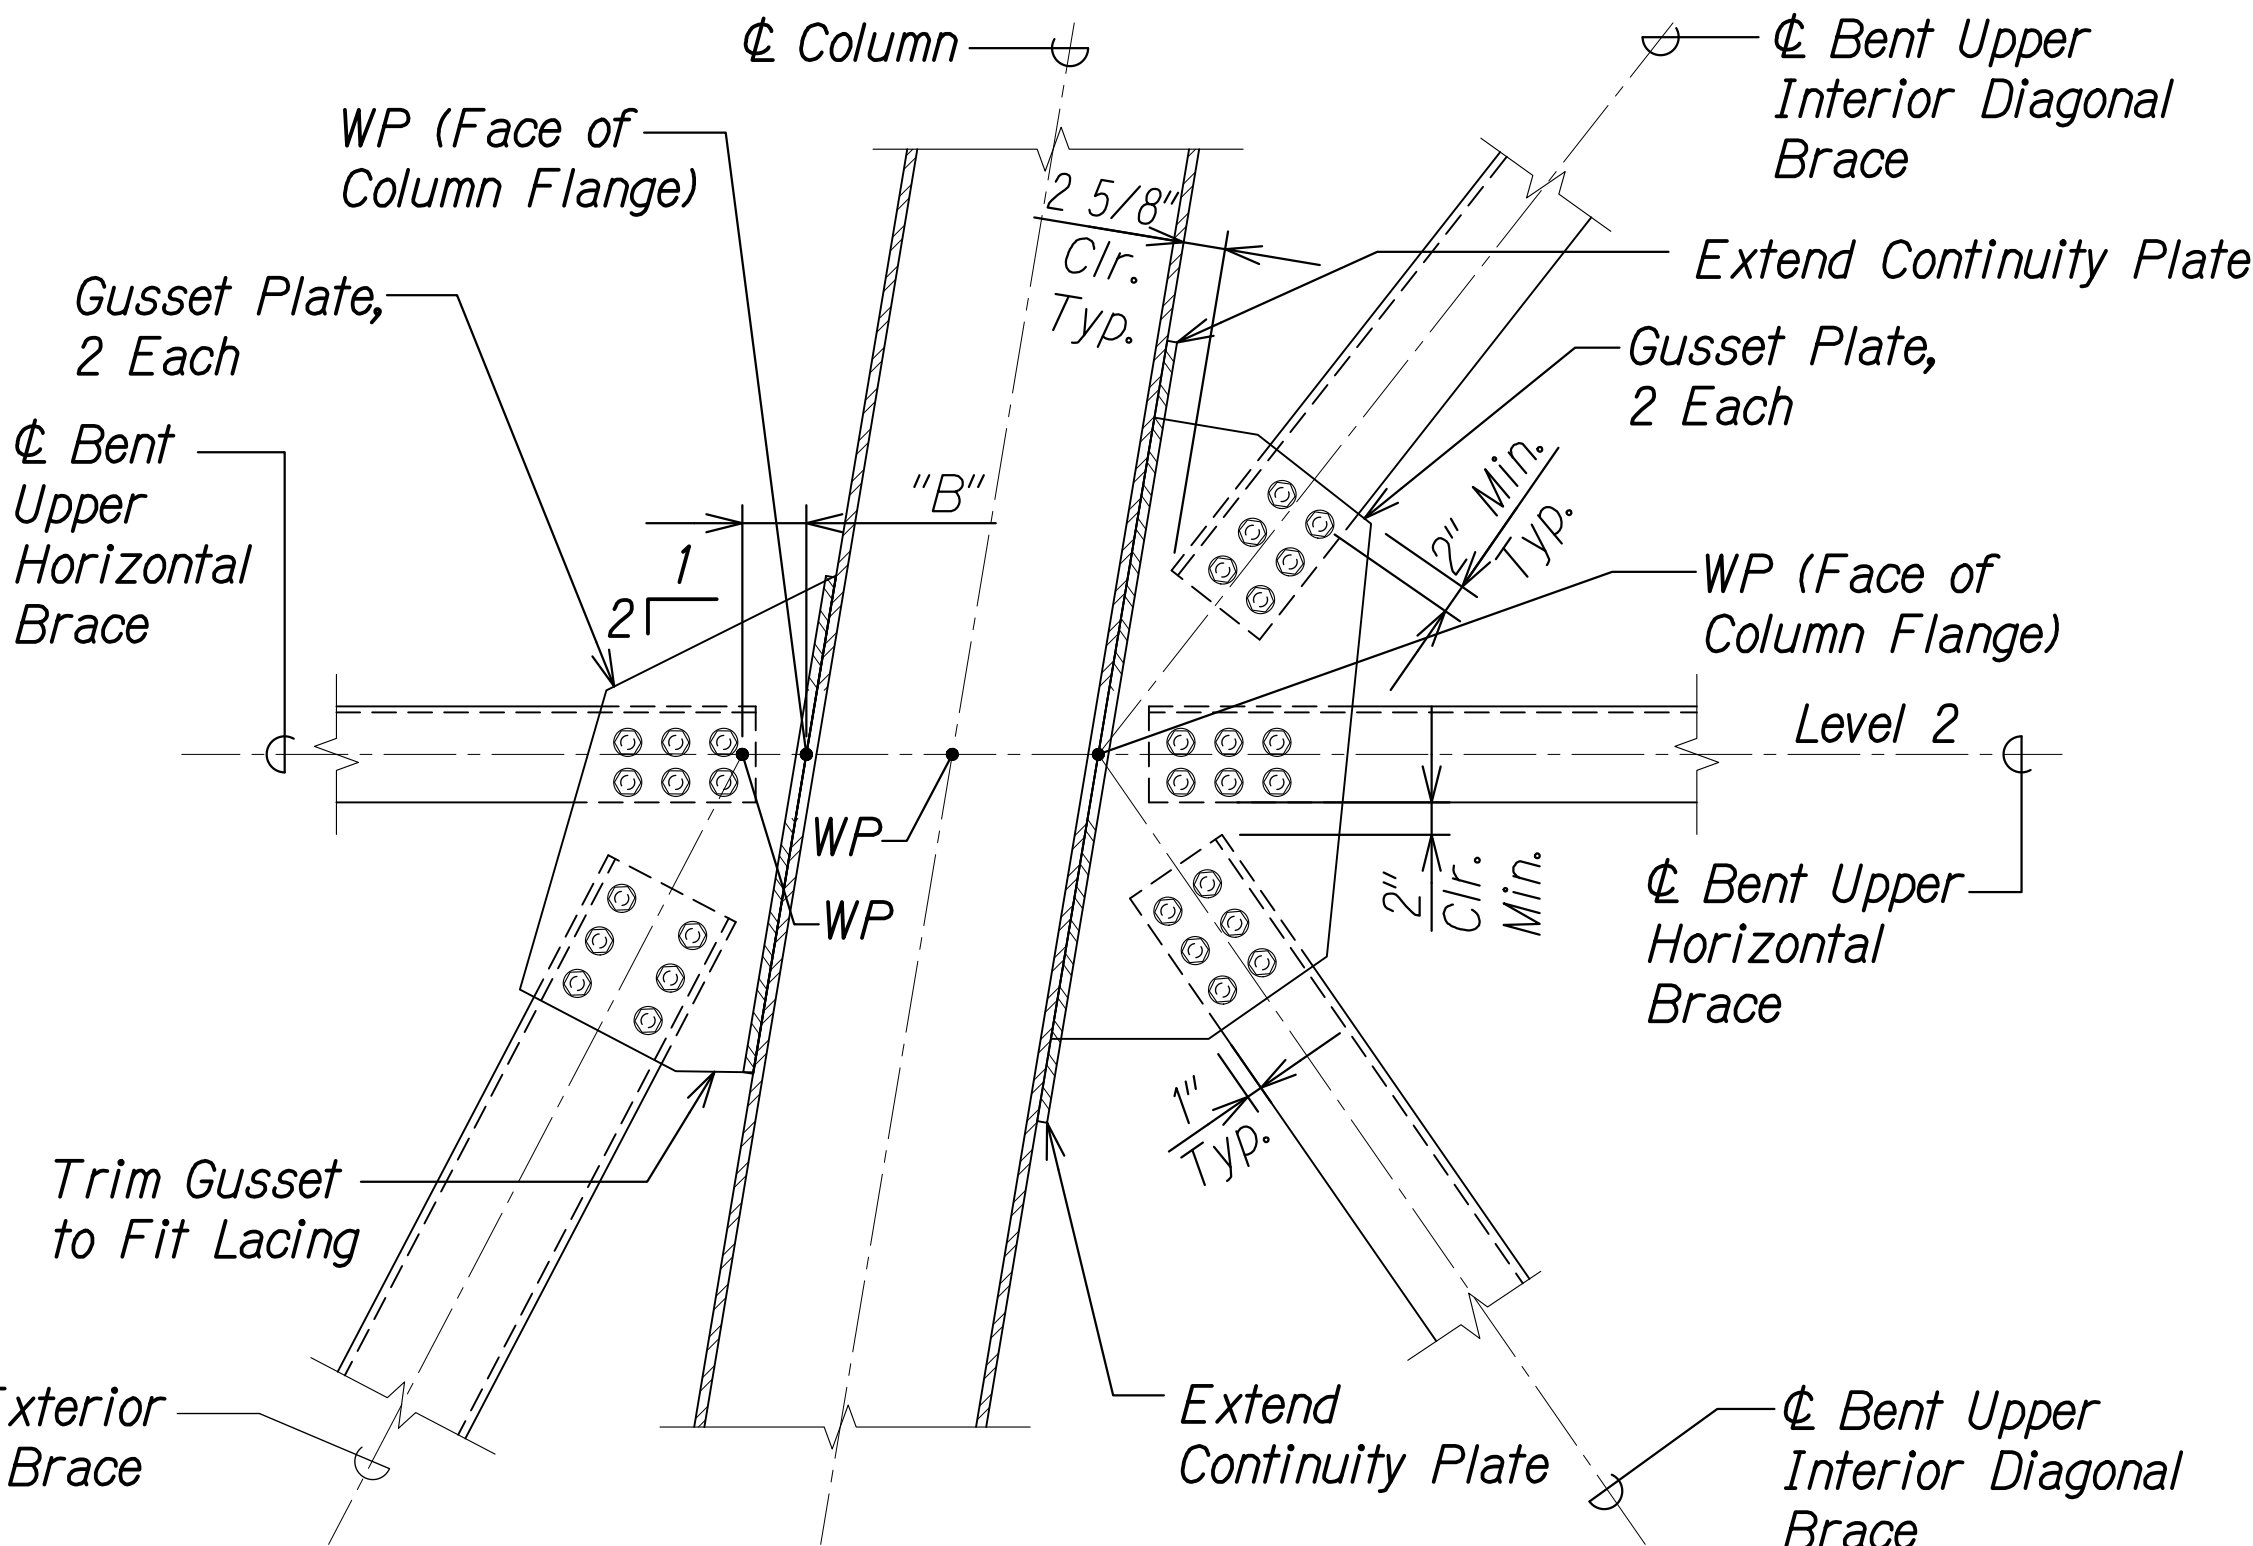

INTERIOR COLUMN TO BRACE
CONNECTION DETAIL 2
Scale: 1" = 1'-0" SA6.5 SA6.5

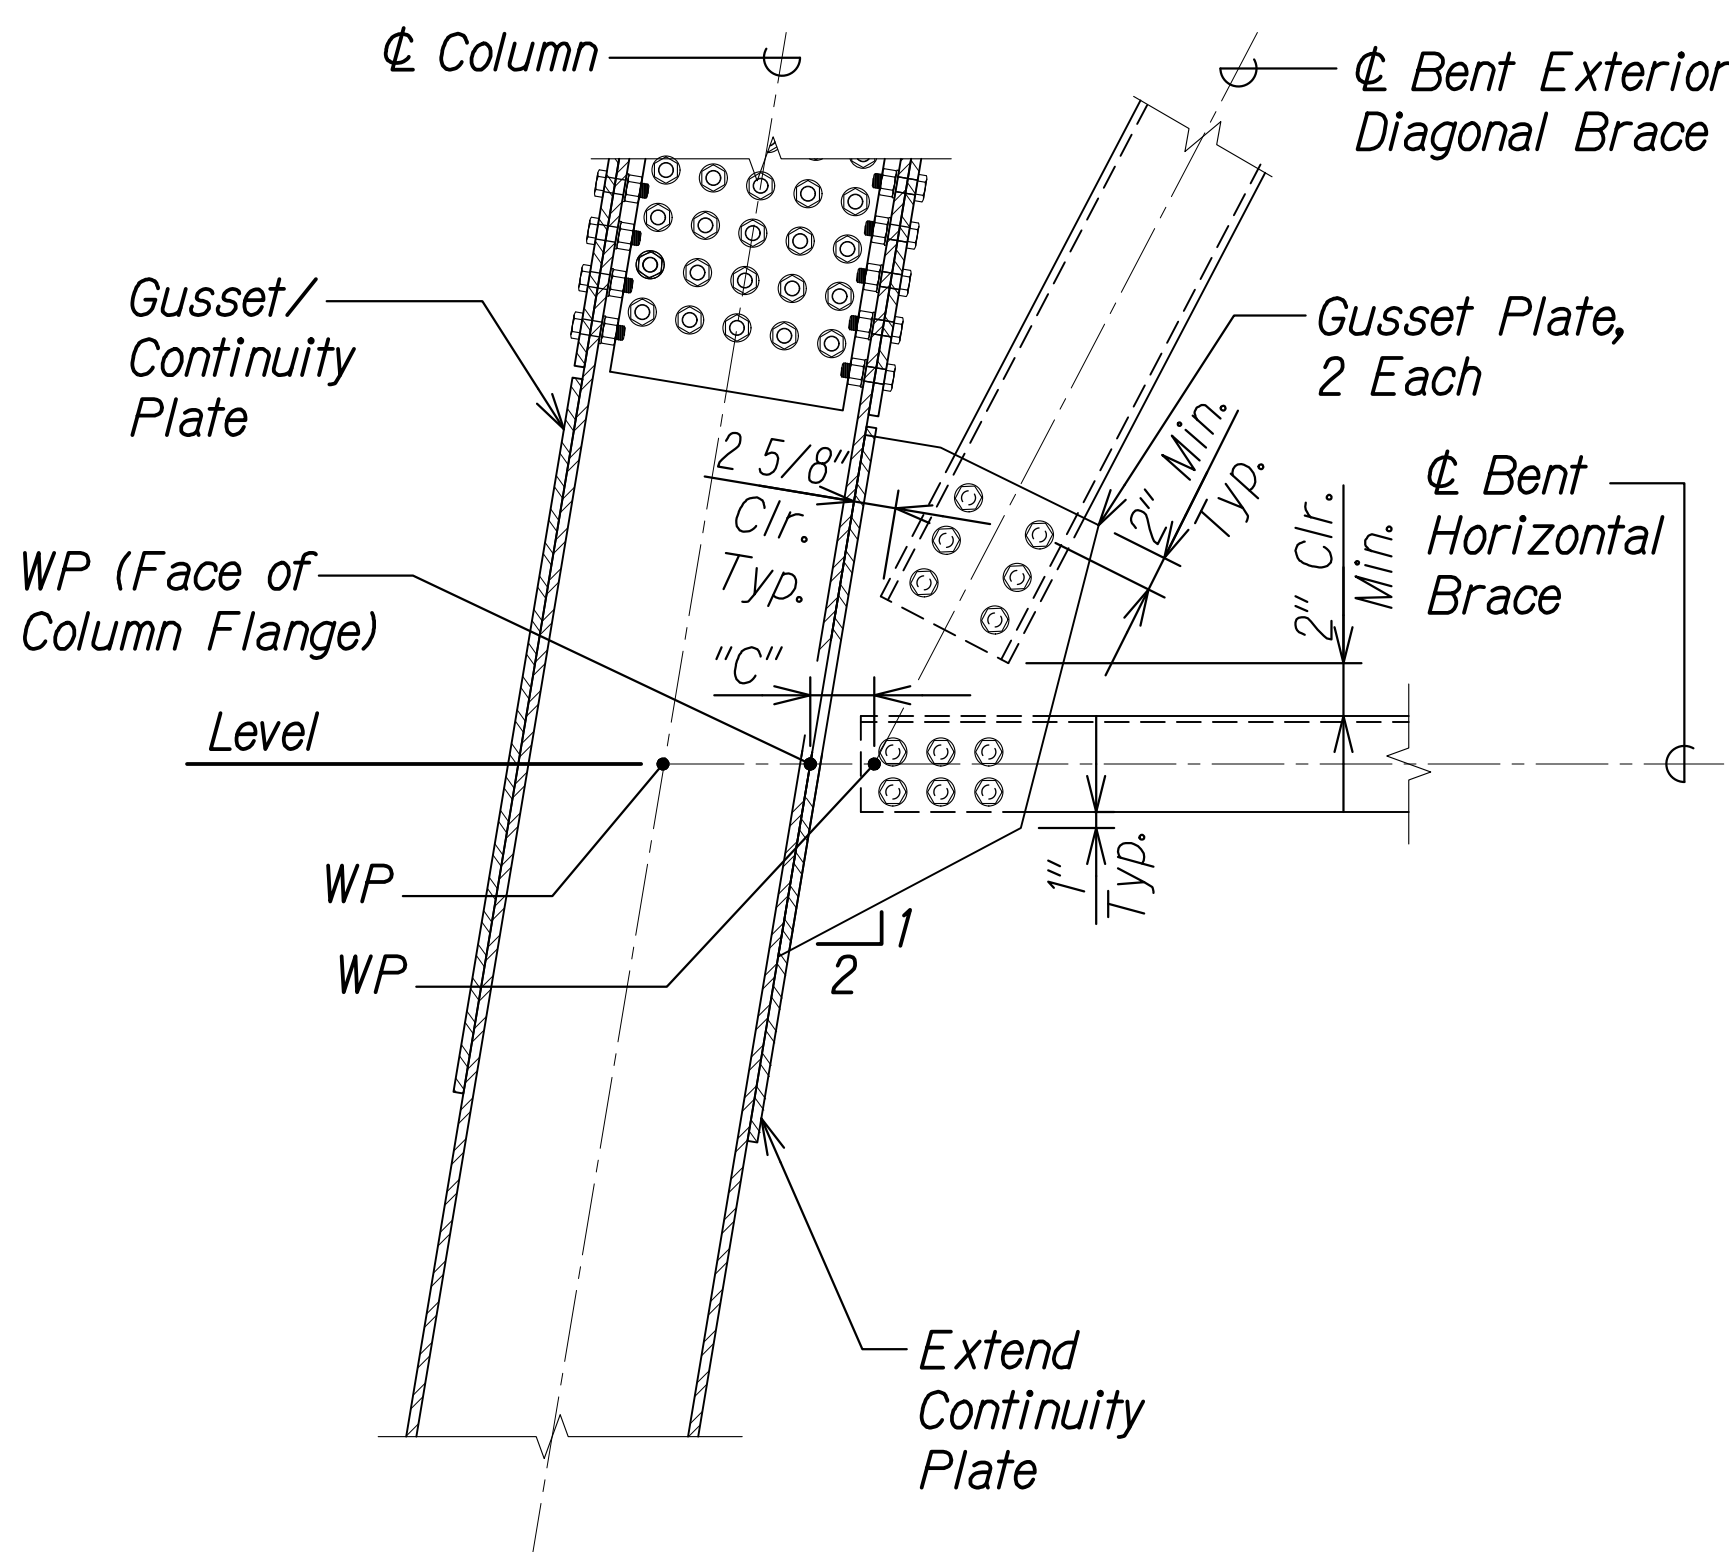


EXTERIOR COLUMN TO BRACE
CONNECTION DETAIL 3
Scale: 1" = 1'-0" SA6.5 SA6.5

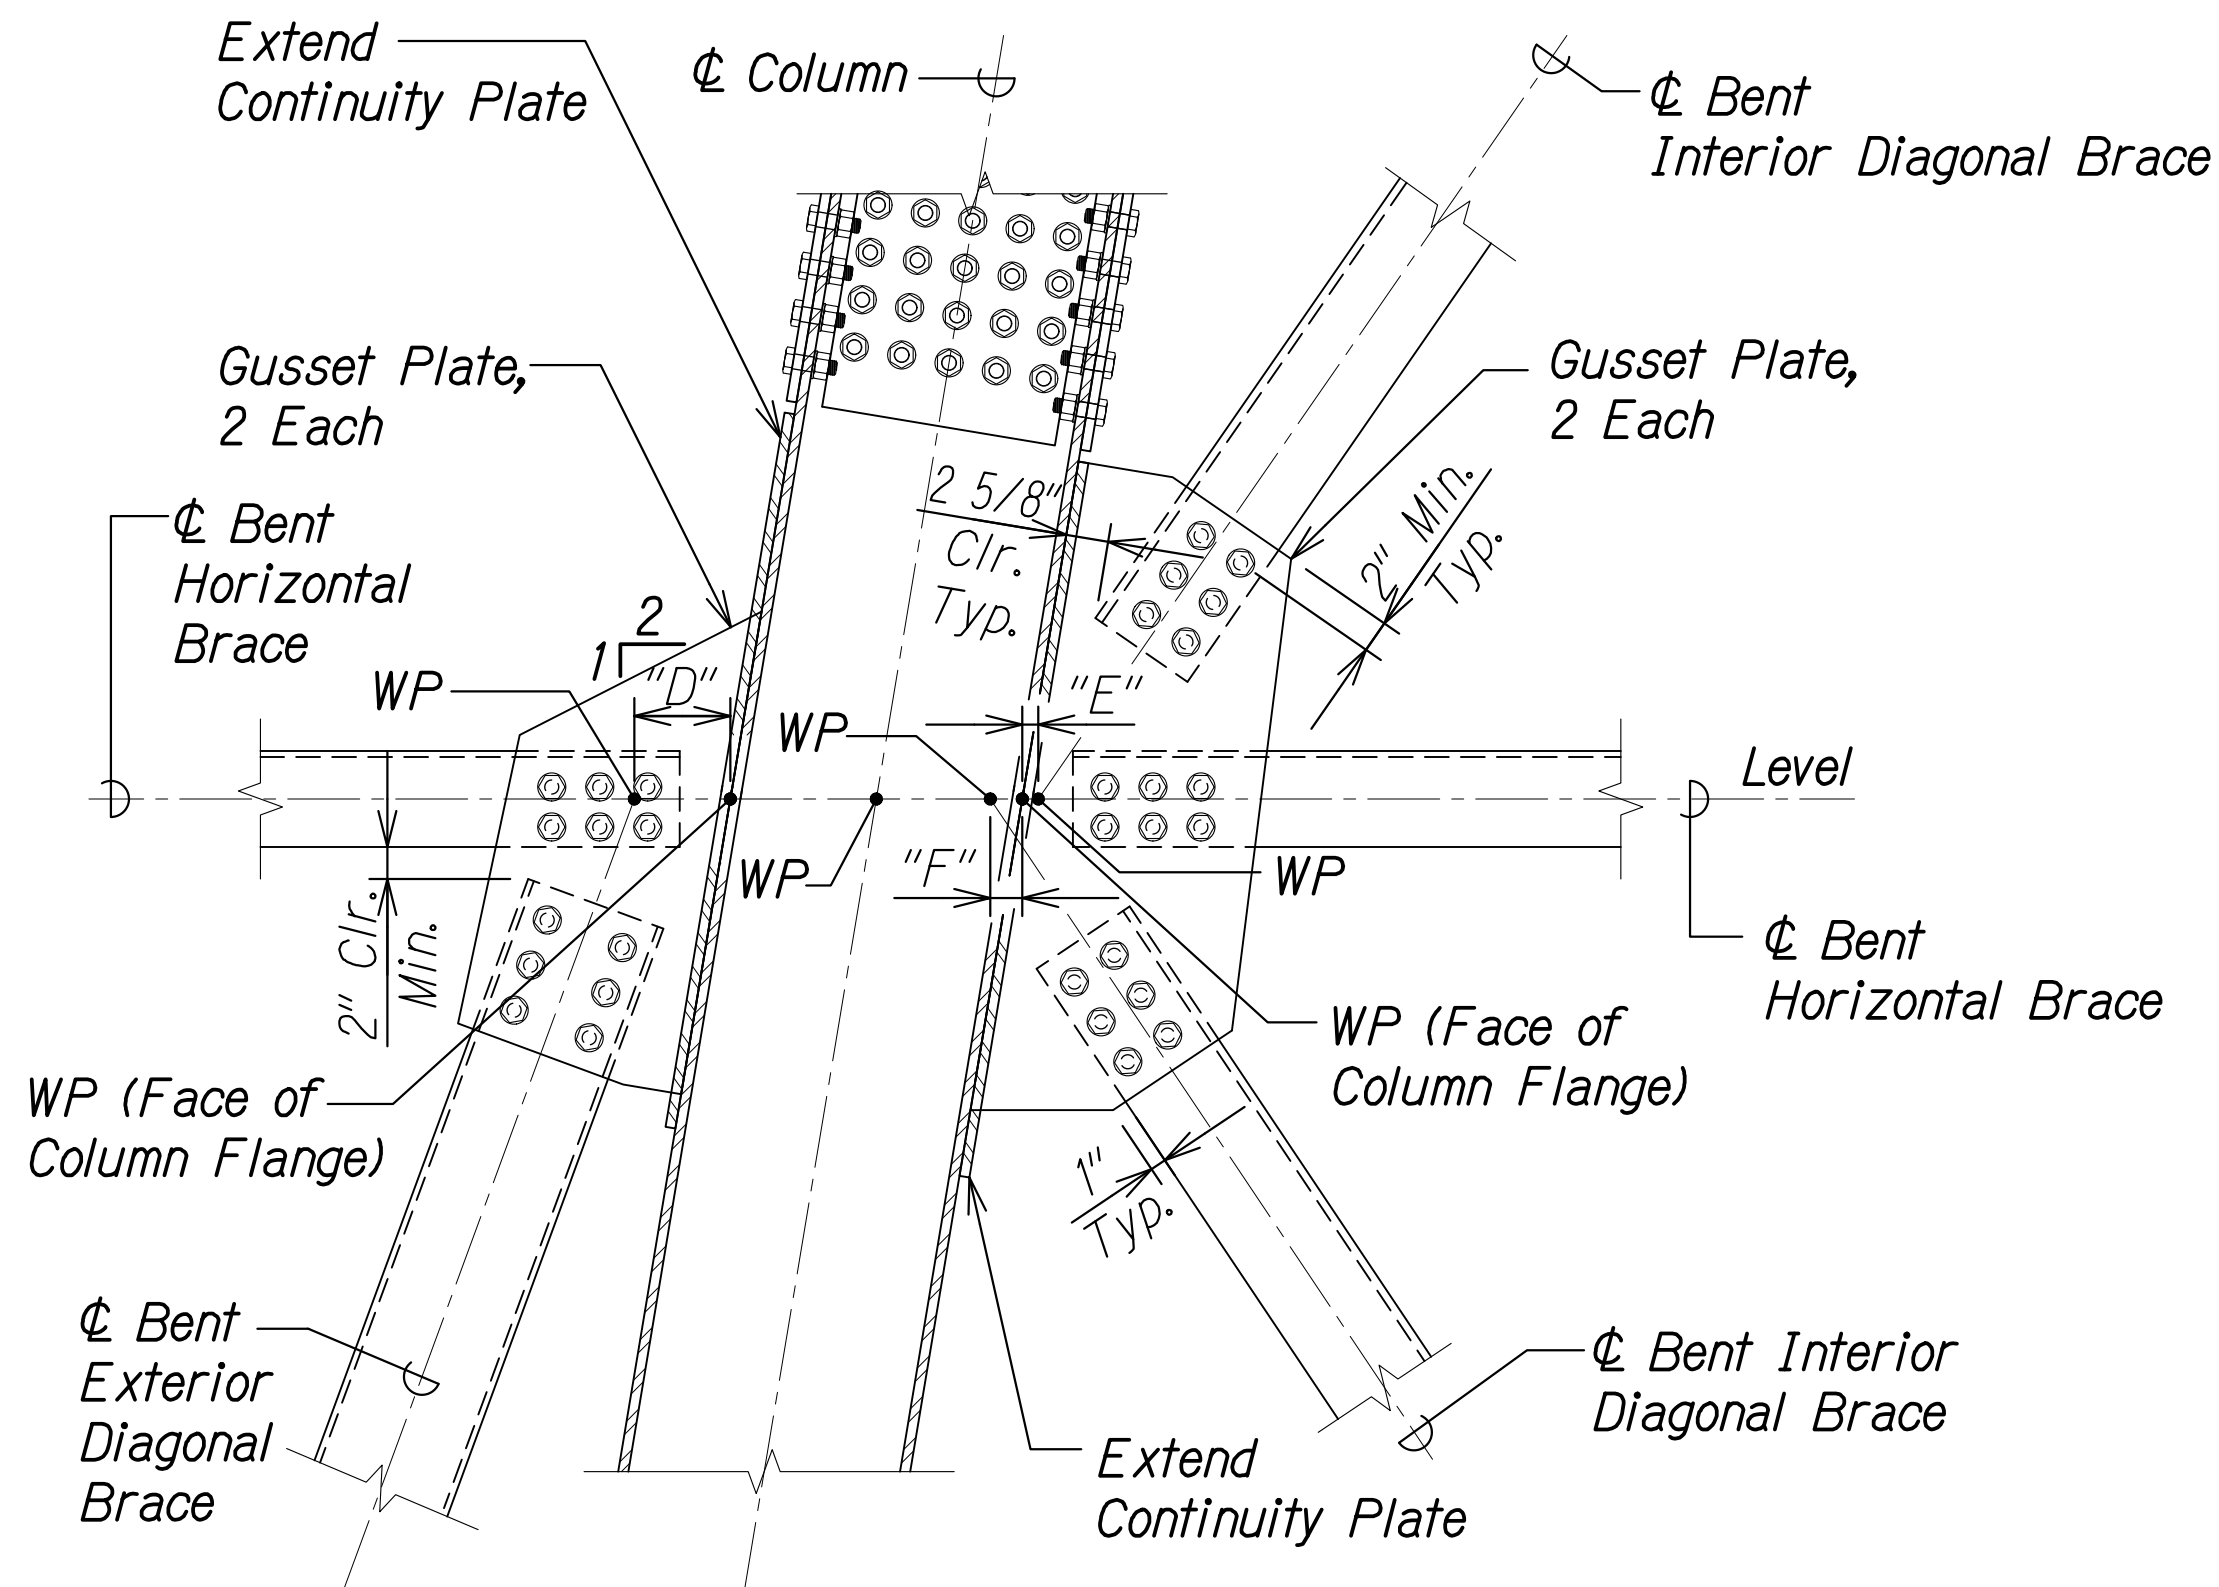

INTERIOR COLUMN TO BRACE
CONNECTION DETAIL 4
Scale: 1" = 1'-0" SA6.5 SA6.5


12/6/24	1	Revised Details & Added Notes
DATE		REVISION

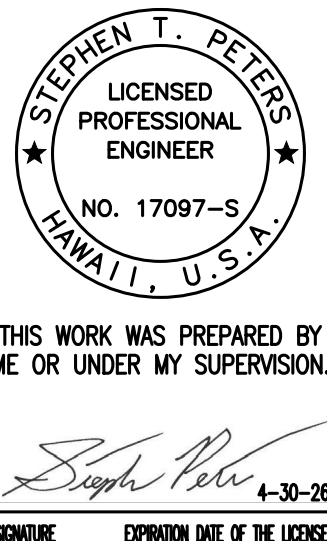

12/6/24	1	Revised Details & Added Notes
DATE		REVISION

SHEET No. SA6.5 OF 22 SHEETS

FED. ROAD DIST. NO.	STATE	FEDERAL AID PROJ. NO.	FISCAL YEAR	SHEET NO.	TOTAL SHEETS
HAWAII	HAW.	BR-019-2(077)	2024	ADD. 112	280

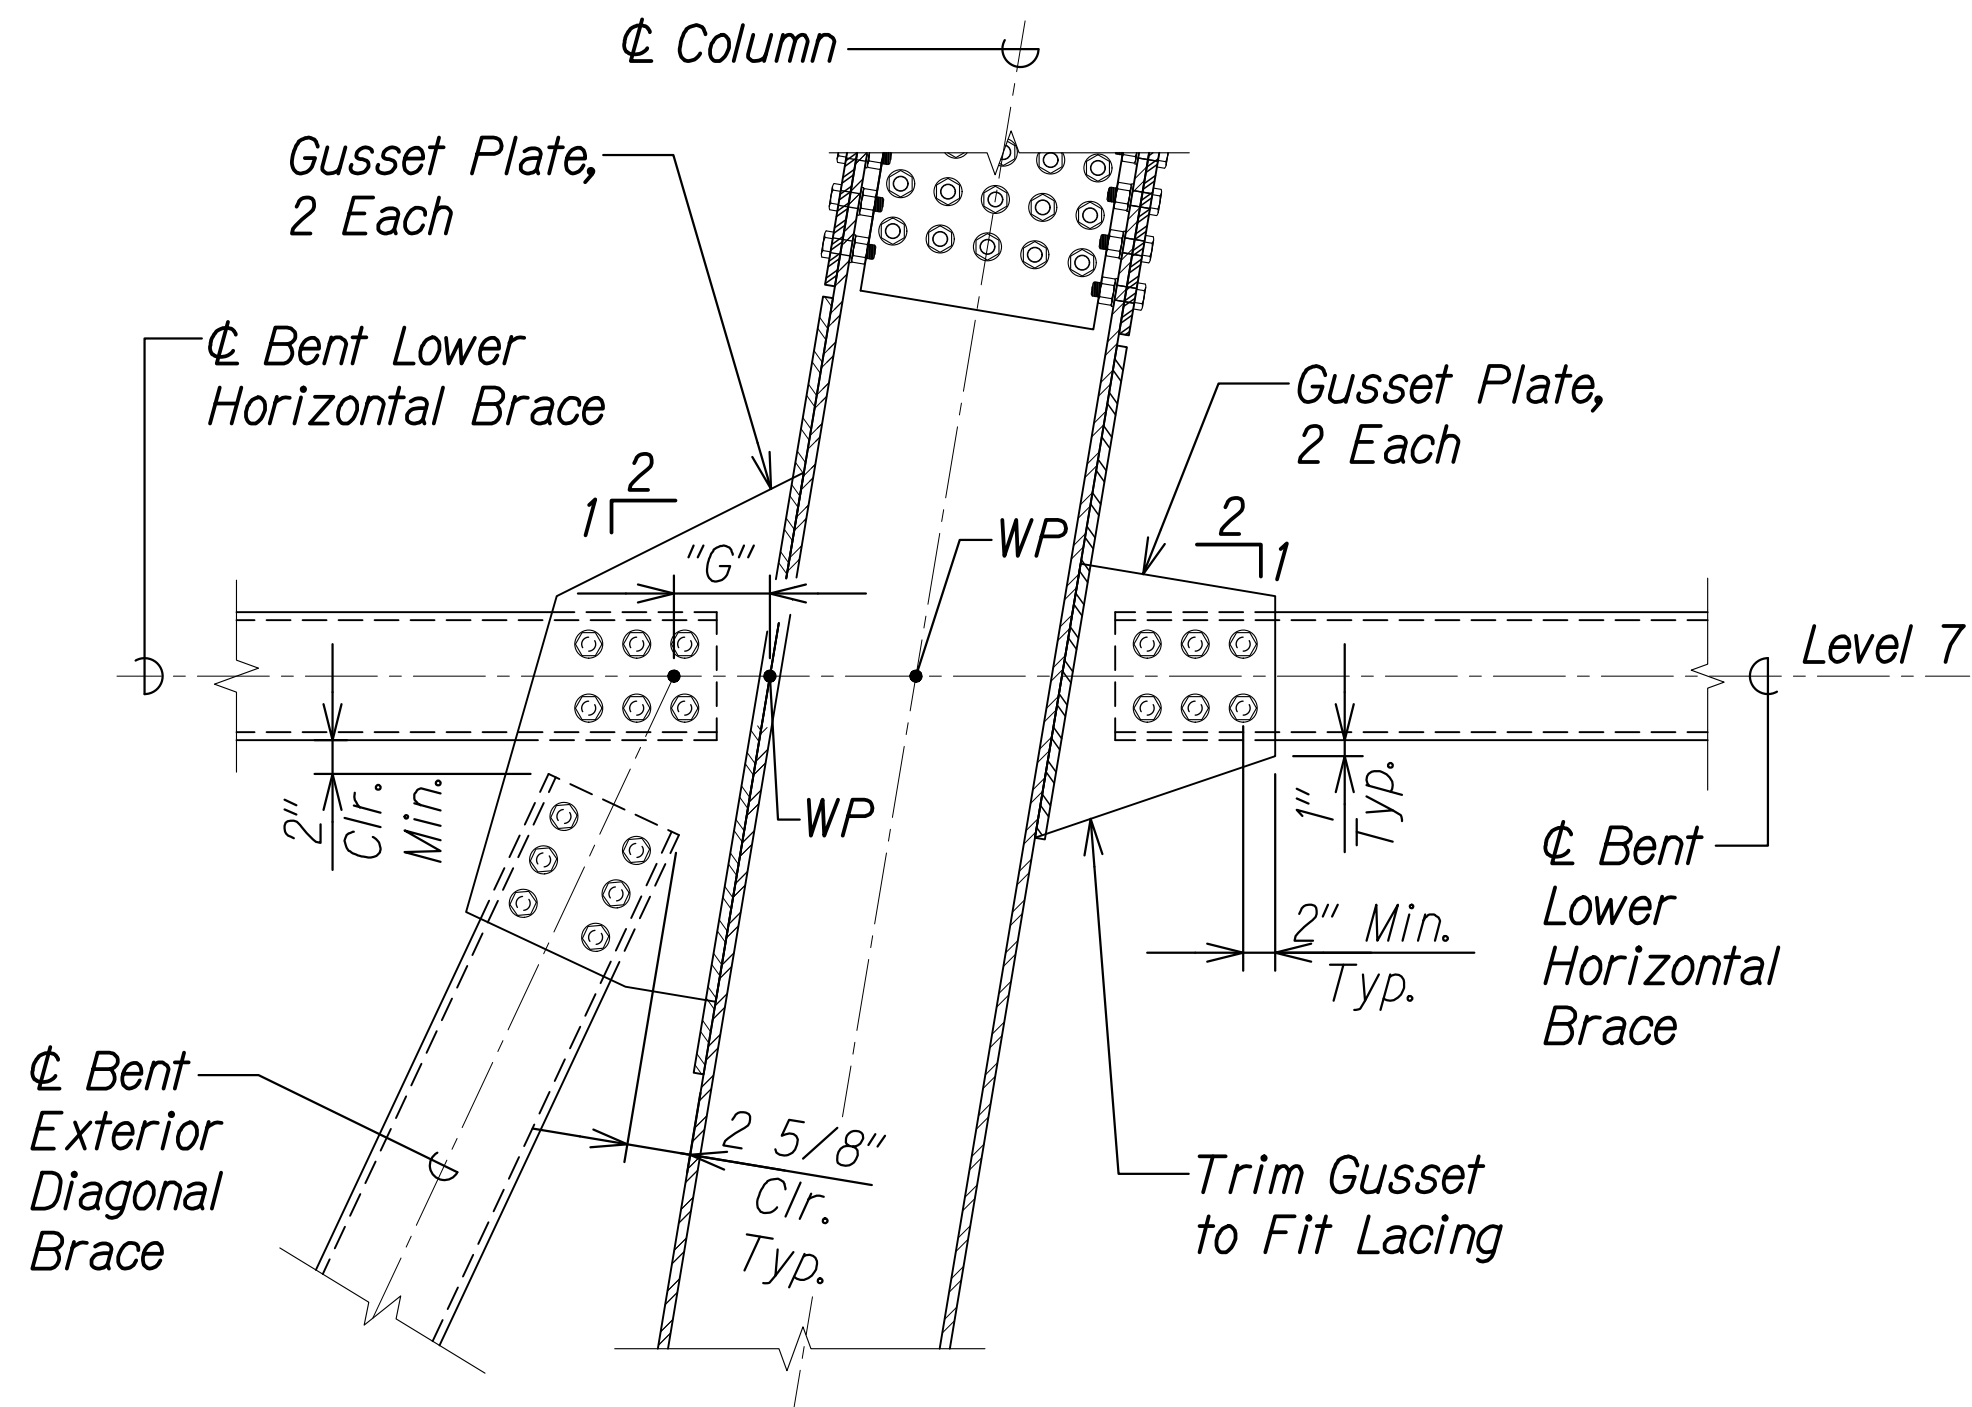

INTERIOR COLUMN TO BRACE
CONNECTION DETAIL

Scale: 1" = 1'-0"



NOTES:

- The Contractor's Steel Detailer is responsible for determining the actual size of each gusset/continuity/cover plate based on the information provided in the Contract Drawings.
- All bolted connections for horizontal and diagonal braces, as detailed on this sheet, shall be pretensioned.
- After erection, touch-up paint the ends of all bolts/nuts/washers.
- Batten plates and lacing not shown for clarity.

WP OFFSET SCHEDULE

LOCATION		"B"	"C"	"D"	"E"	"F"	"G"
Level 2	Bent Nos. 1 ϕ 9	6"	-	-	-	-	-
	Bent Nos. 2, 3, 4, 5, 6, 7, ϕ 8	4"	-	-	-	-	-
Level 3	Bent Nos. 2, 3, 4, 5, 6, 7, ϕ 8	-	4"	6"	1"	0"	-
Level 4	Bent Nos. 2, 3, 4, 5, 6, ϕ 7	-	6"	6"	3"	0"	-
Level 5	Bent Nos. 3, 4, 5, 6, ϕ 7	-	6"	6"	0"	8"	-
Level 6	Bent No. 4	-	6"	6"	-5"	8"	-
	Bent Nos. 5 ϕ 6	-	6"	6"	-5"	2"	-
Level 7	Bent Nos. 5, ϕ 6	-	6"	-	-	-	6"


12/6/24

DATE

1

Revised Detail & Schedule, and Added Notes

REVISION

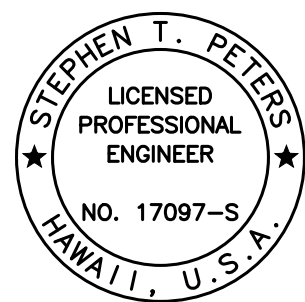

THIS WORK WAS PREPARED BY
ME OR UNDER MY SUPERVISION.

Signature: Stephen T. Peters
4-30-26
SIGNATURE EXPIRATION DATE OF THE LICENSE

STATE OF HAWAII
DEPARTMENT OF TRANSPORTATION
HIGHWAYS DIVISION

COLUMN TO BRACE
CONNECTION DETAILS

HAWAII BELT ROAD

Nanue Stream Bridge Rehabilitation

Federal Aid Project No. BR-019-2(077)

Scale: As Noted

Date: Oct. 2024


SHEET No. SA6.6 OF 22 SHEETS

ADD. 112


FED. ROAD DIST. NO.	STATE	FEDERAL AID PROJ. NO.	FISCAL YEAR	SHEET NO.	TOTAL SHEETS
HAWAII	HAW.	BR-019-2(077)	2024	ADD. 113	280

NOTES:


1. The Contractor's Steel Detailer is responsible for determining the actual size of each gusset/continuity/cover plate based on the information provided in the Contract Drawings.
2. All bolted connections for horizontal and diagonal braces, as detailed on this sheet, shall be pretensioned.
3. After erection, touch-up paint the ends of all bolts/nuts/washers.
4. Batten plates and lacing on braces not shown for clarity.

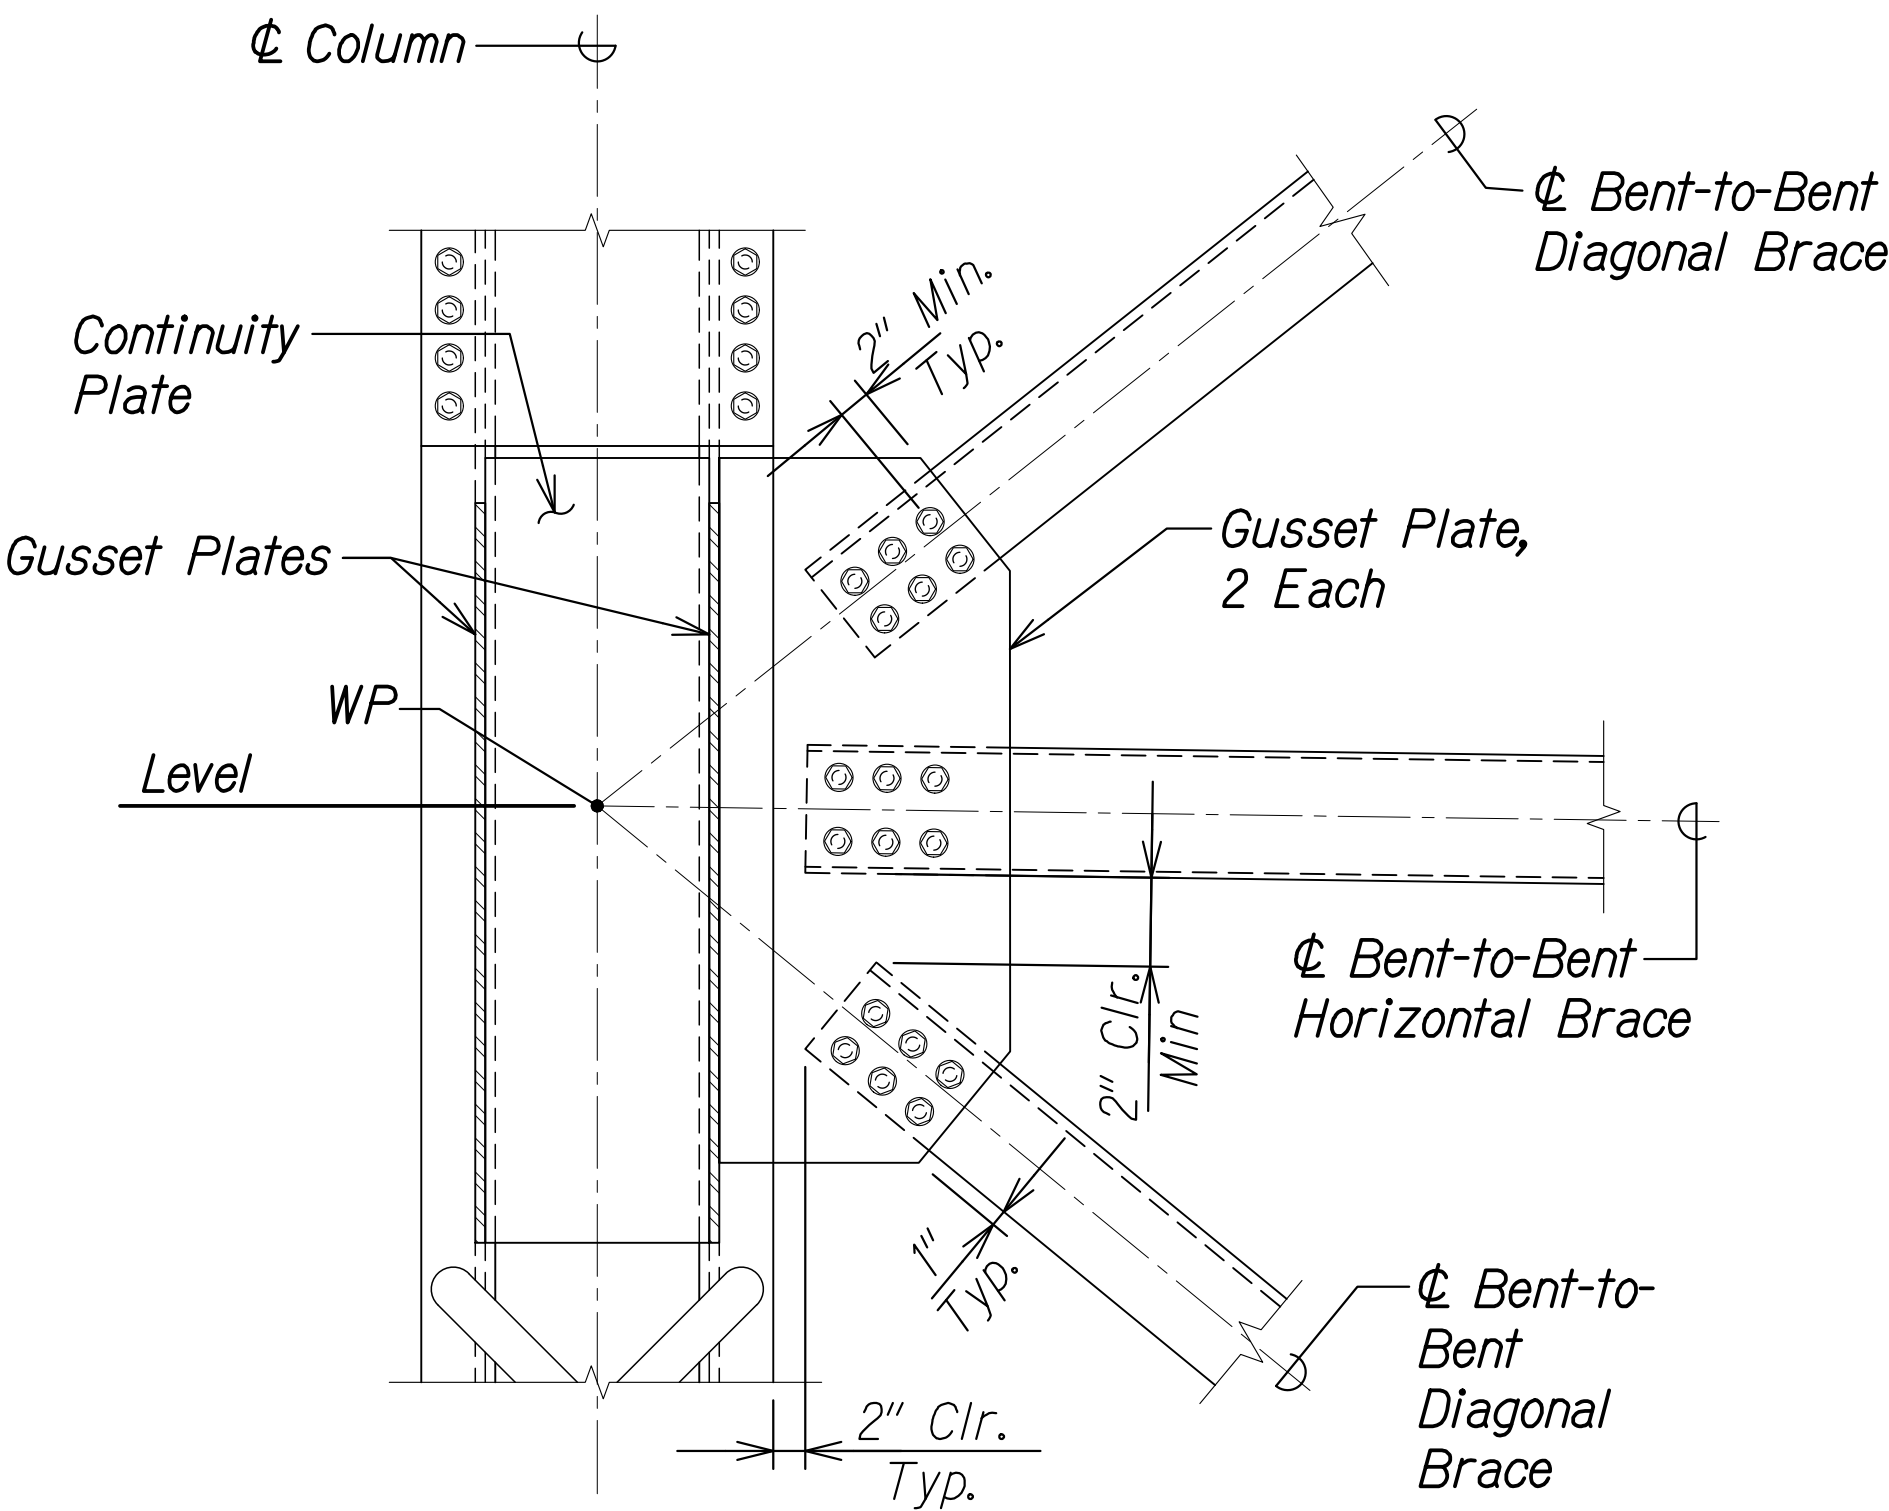


**COLUMN TO BRACE
CONNECTION DETAIL**
Scale: 1" = 1'-0"
SA6.7 SA6.7 1

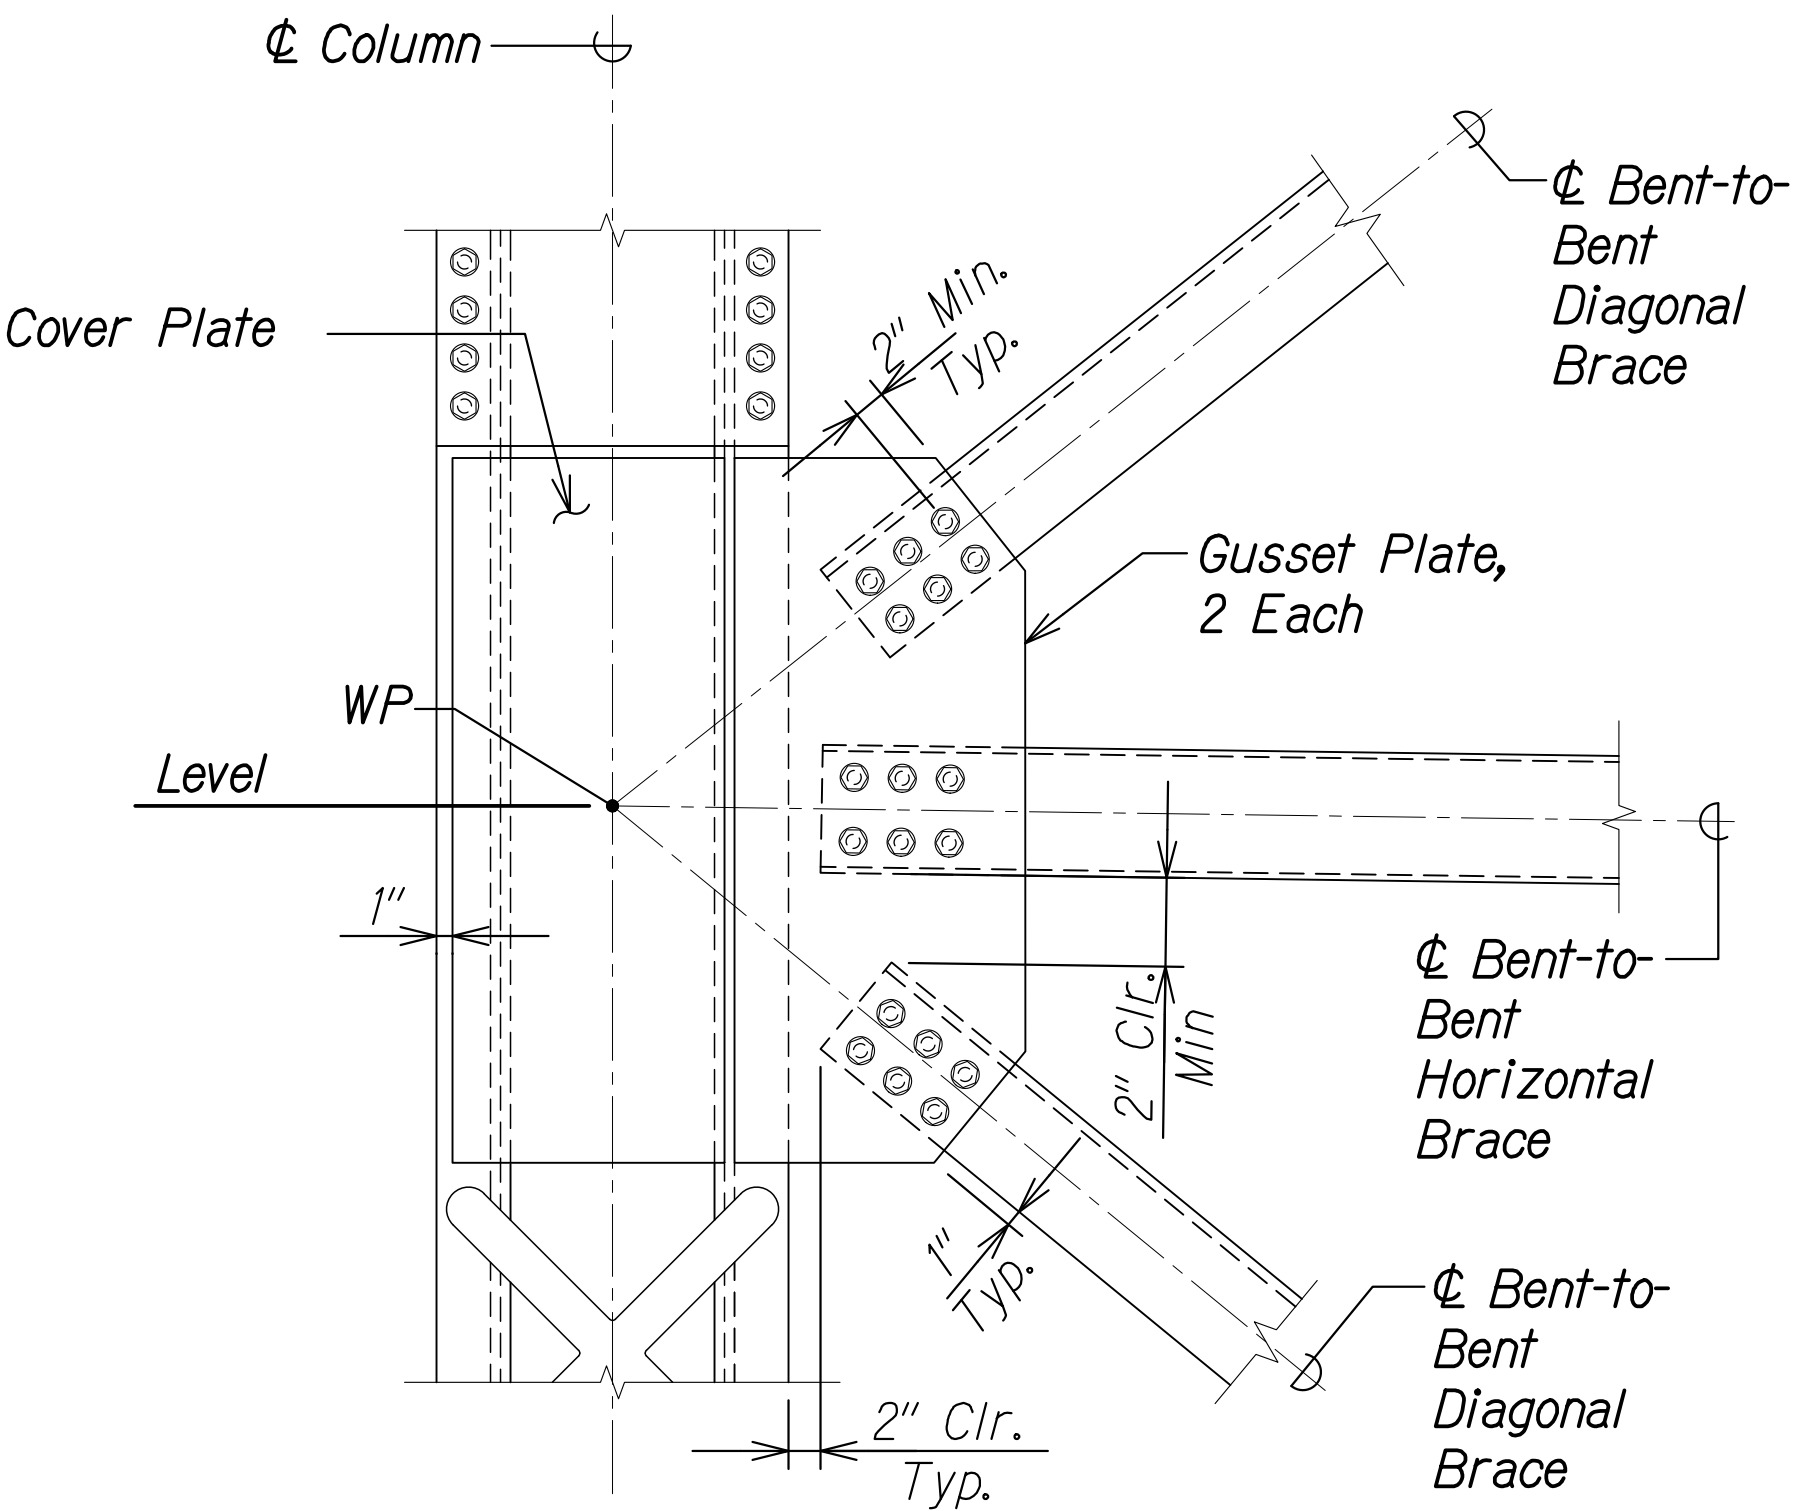


**COLUMN TO BRACE
CONNECTION DETAIL**
Scale: 1" = 1'-0"
SA6.7 SA6.7 1

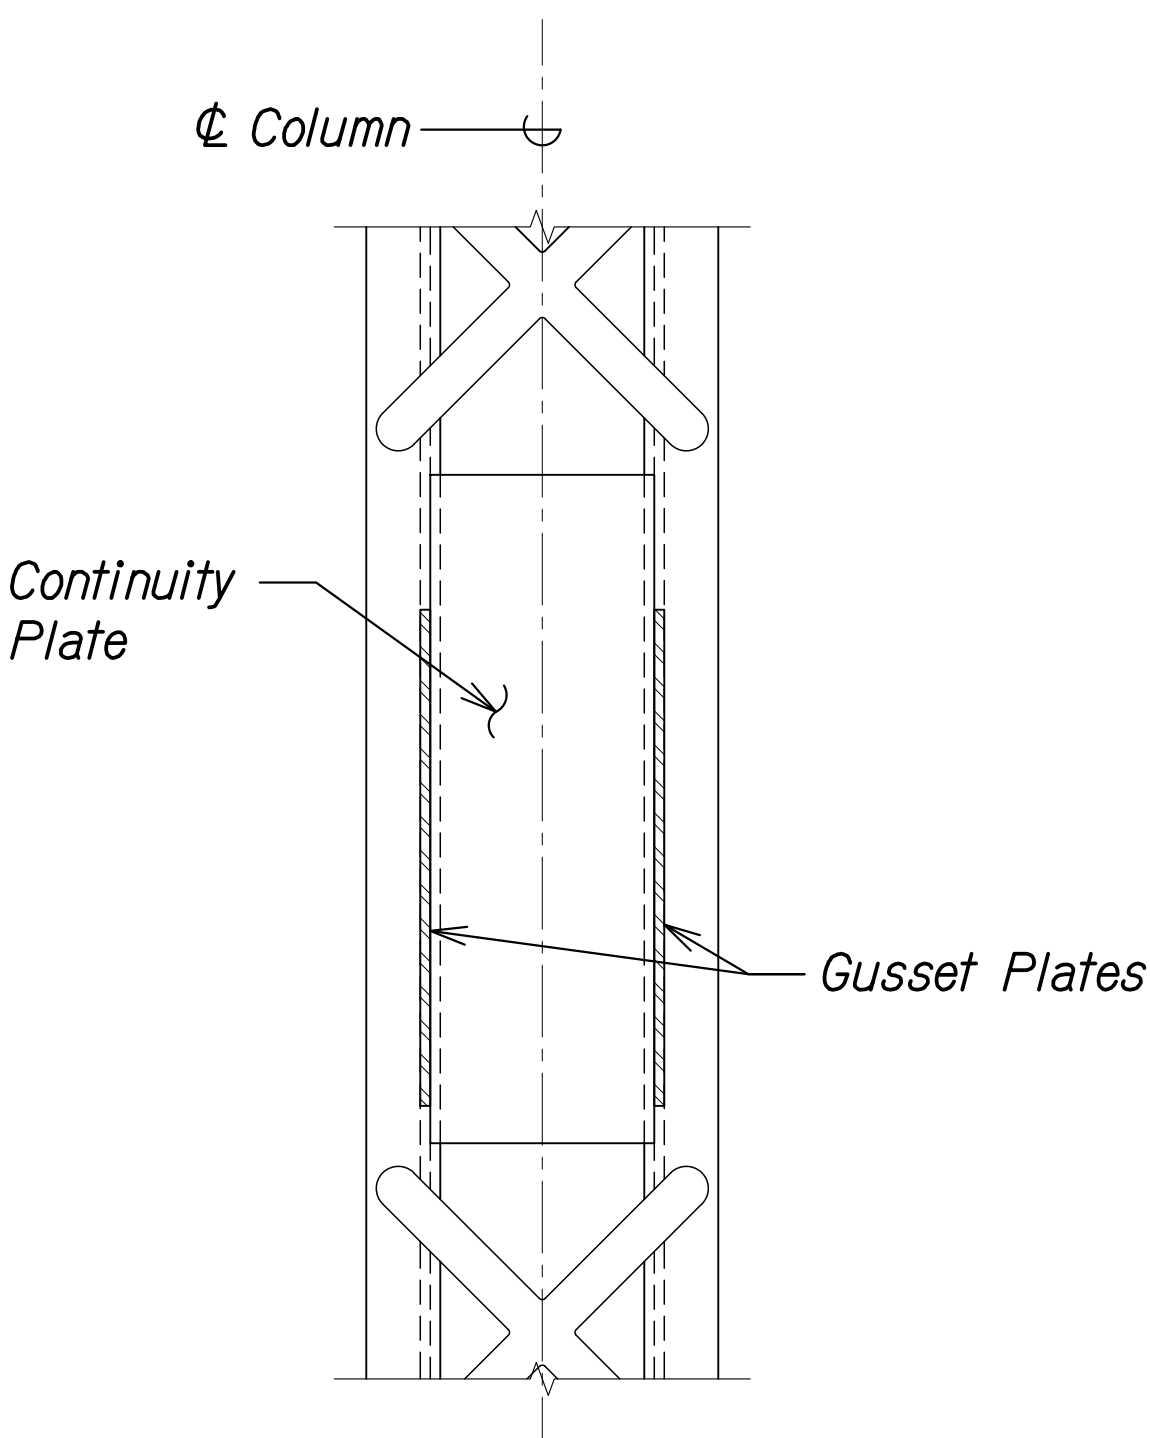


**COLUMN TO BRACE
CONNECTION DETAIL**
Scale: 1" = 1'-0"
SA6.7 SA6.7 1

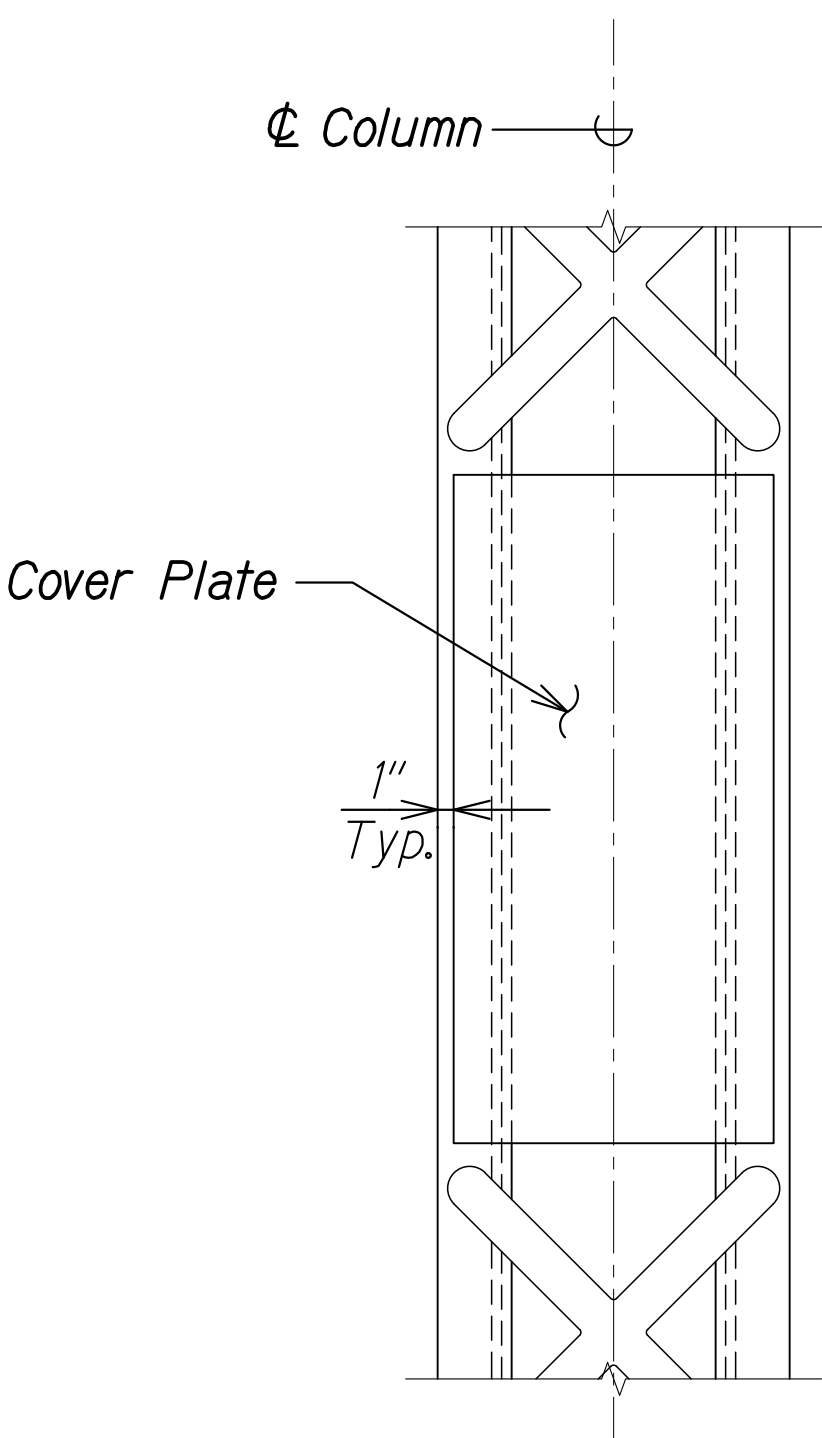

**COVER PLATE
CONNECTION DETAIL**
Scale: 1" = 1'-0"
SA6.7 SA6.7 1

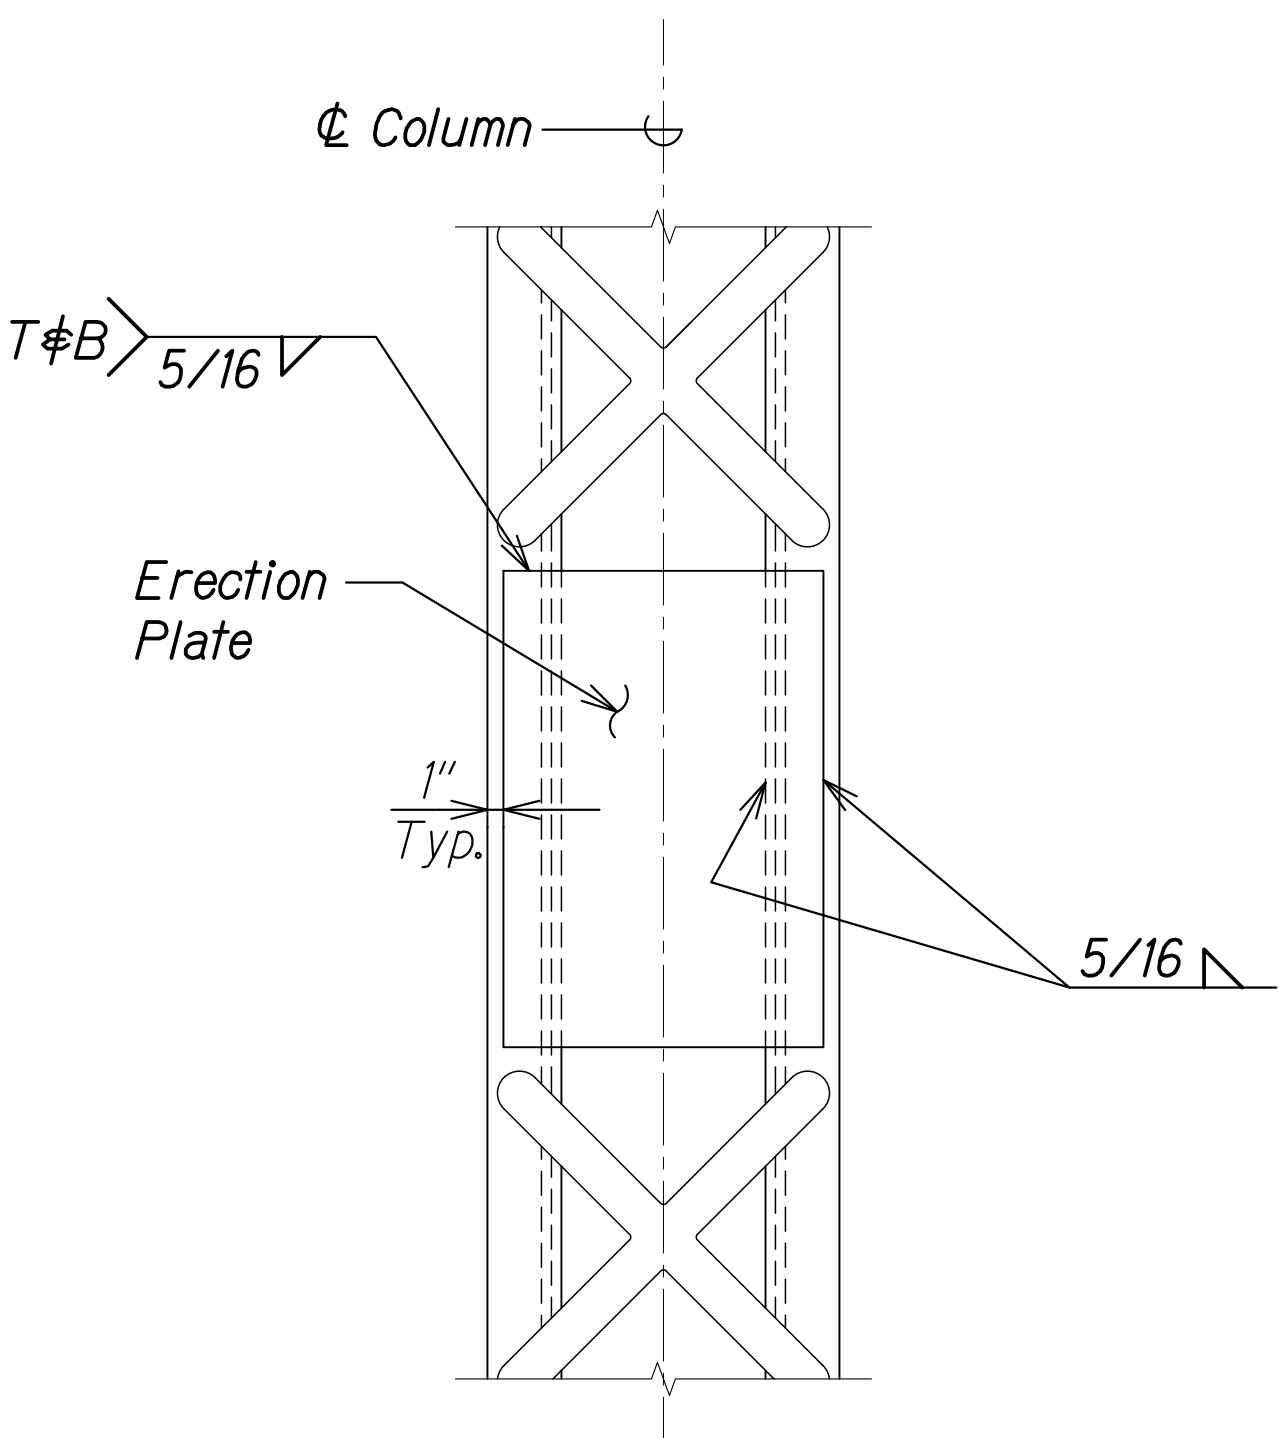


**ERECTION PLATE
CONNECTION DETAIL**
Scale: 1" = 1'-0"
SA6.7 SA6.7 1

12/6/24		Revised Details & Added Notes
DATE	REVISION	

STATE OF HAWAII
DEPARTMENT OF TRANSPORTATION
HIGHWAYS DIVISION

COLUMN TO BRACE
CONNECTION DETAILS
HAWAII BELT ROAD
Nanue Stream Bridge Rehabilitation
Federal Aid Project No. BR-019-2(077)
Scale: As Noted Date: Oct. 2024

SHEET No. SA6.7 OF 22 SHEETS

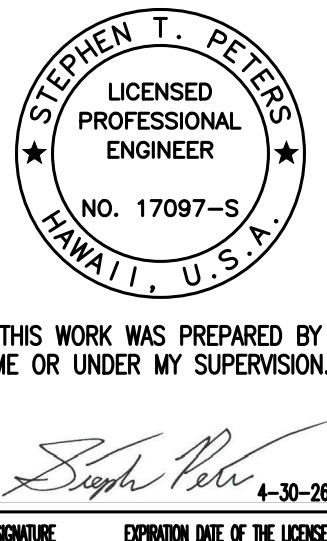

ORIGINAL PLAN	DATE
DESIGNED BY	
TRACED BY	
NOTED BY	
CHECKED BY	

DRAWING NAME: Z:\00 ONGOING\23-022.9-NANUE STR BR PF2-DOT1\01 CAD\12-06-24 ADD\NSR-SA6602-SA6617 CONN DTL'S ADD2.DWG PLOT TIME: 12-05-24 3:33 PM


FED. ROAD DIST. NO.	STATE	FEDERAL AID PROJ. NO.	FISCAL YEAR	SHEET NO.	TOTAL SHEETS
HAWAII	HAW.	BR-019-2(077)	2024	ADD. 114	280

NOTES:

- The Contractor's Steel Detailer is responsible for determining the actual size of each gusset/continuity/cover plate based on the information provided in the Contract Drawings.
- All bolted connections for horizontal and diagonal braces, as detailed on this sheet, shall be pretensioned.
- After erection, touch-up paint the ends of all bolts/nuts/washers.
- Batten plates and lacing on bracing not shown for clarity.




WP OFFSET SCHEDULE			
LOCATION		"H"	"J"
Level 5	Bent No. 3	4"	2"

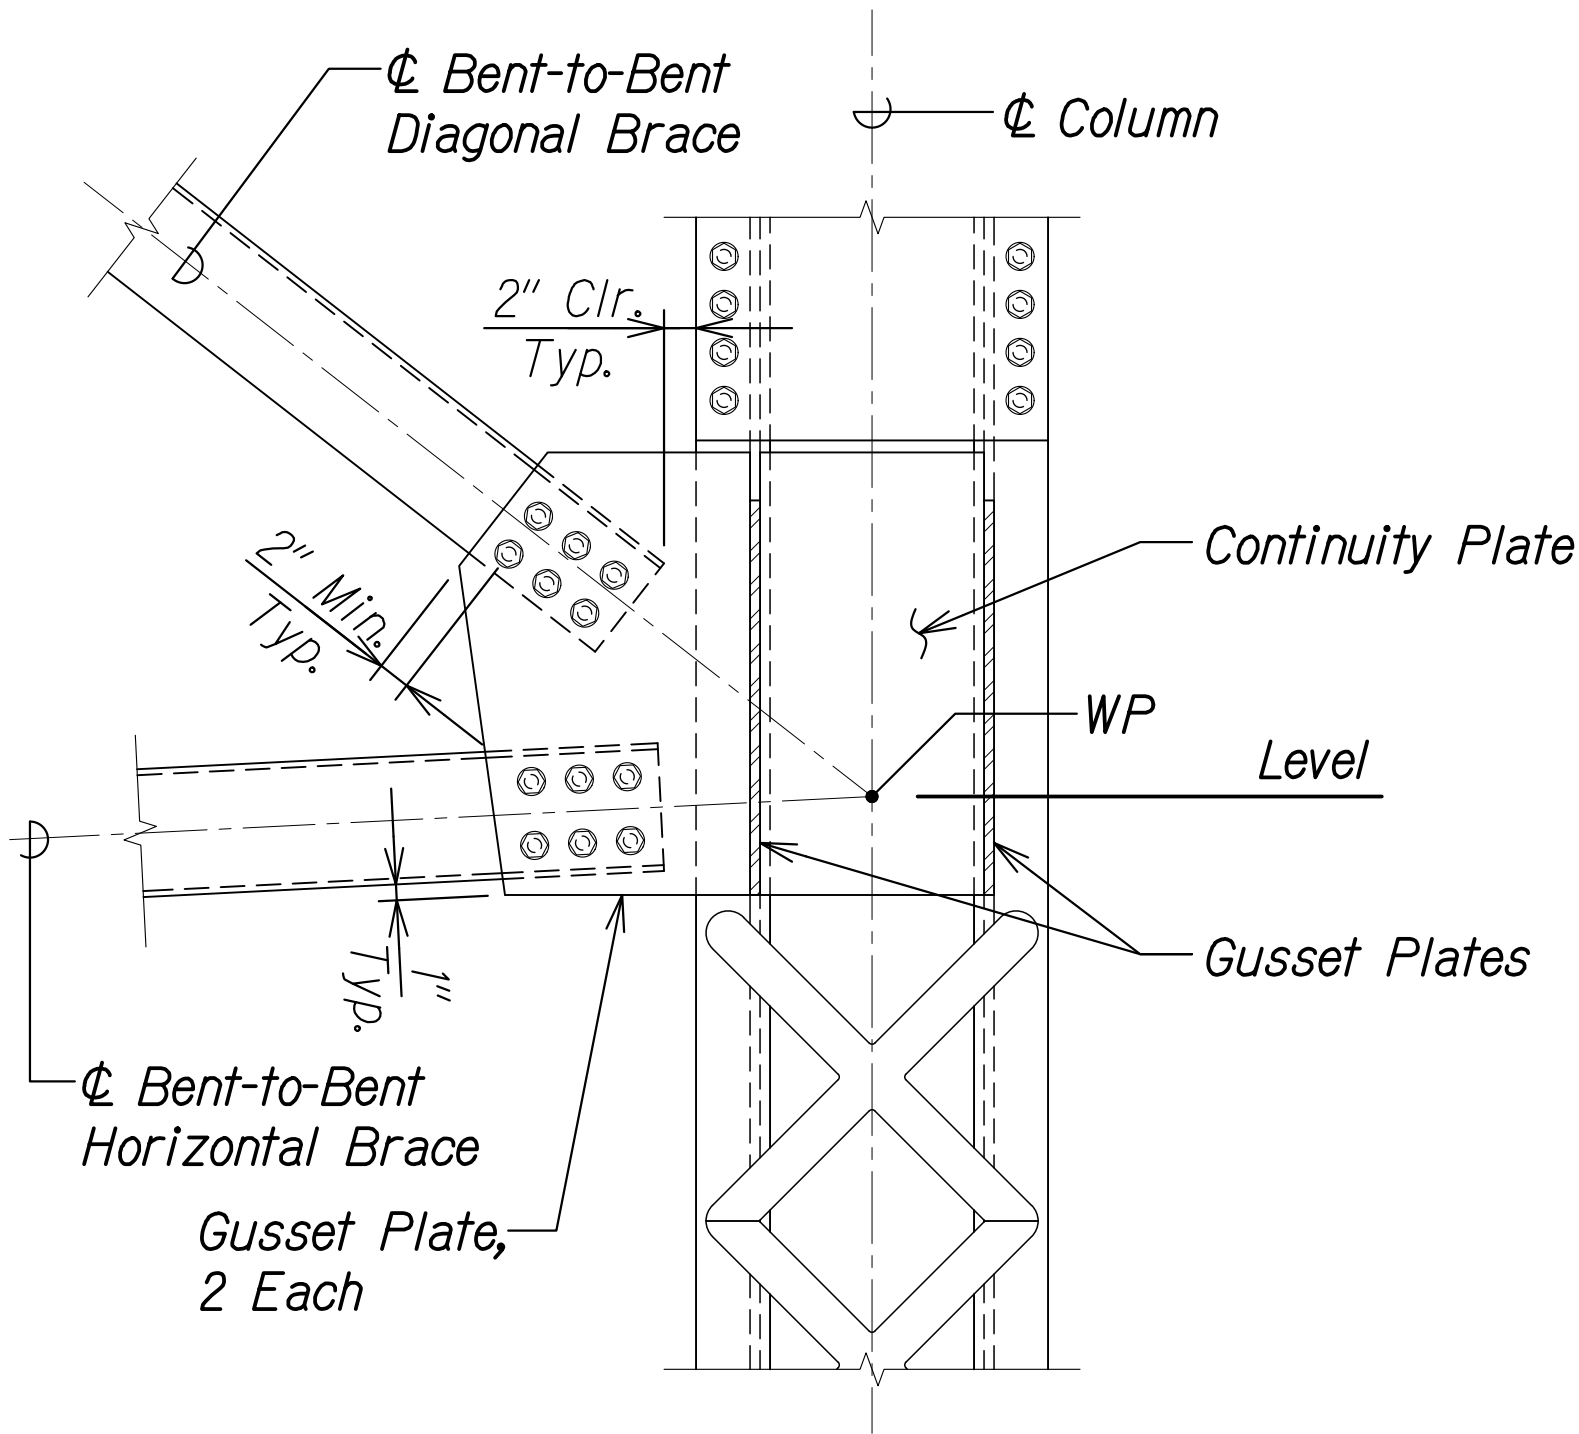


**COLUMN TO BRACE
CONNECTION DETAIL**

Scale: 1" = 1'-0"

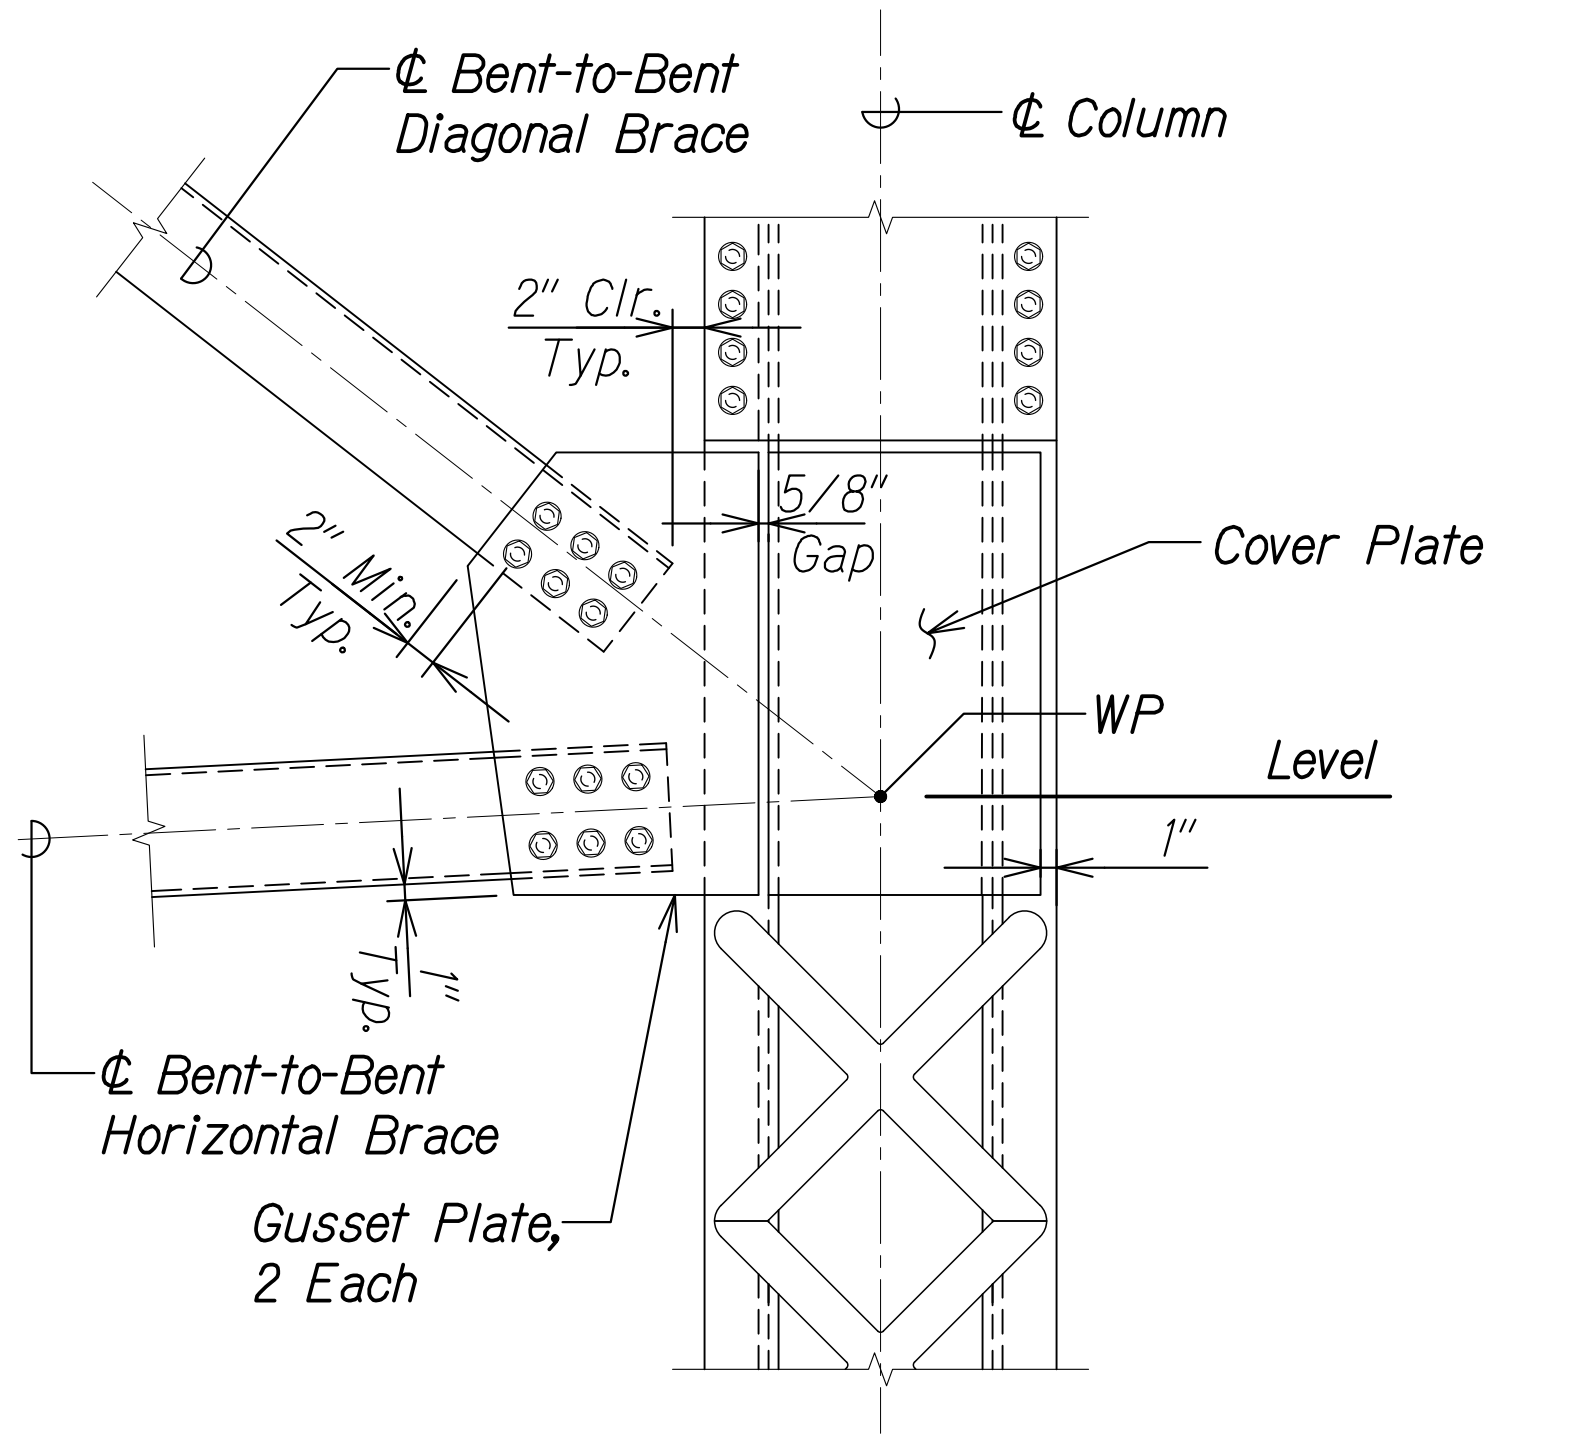


**COLUMN TO BRACE
CONNECTION DETAIL**

Scale: 1" = 1'-0"

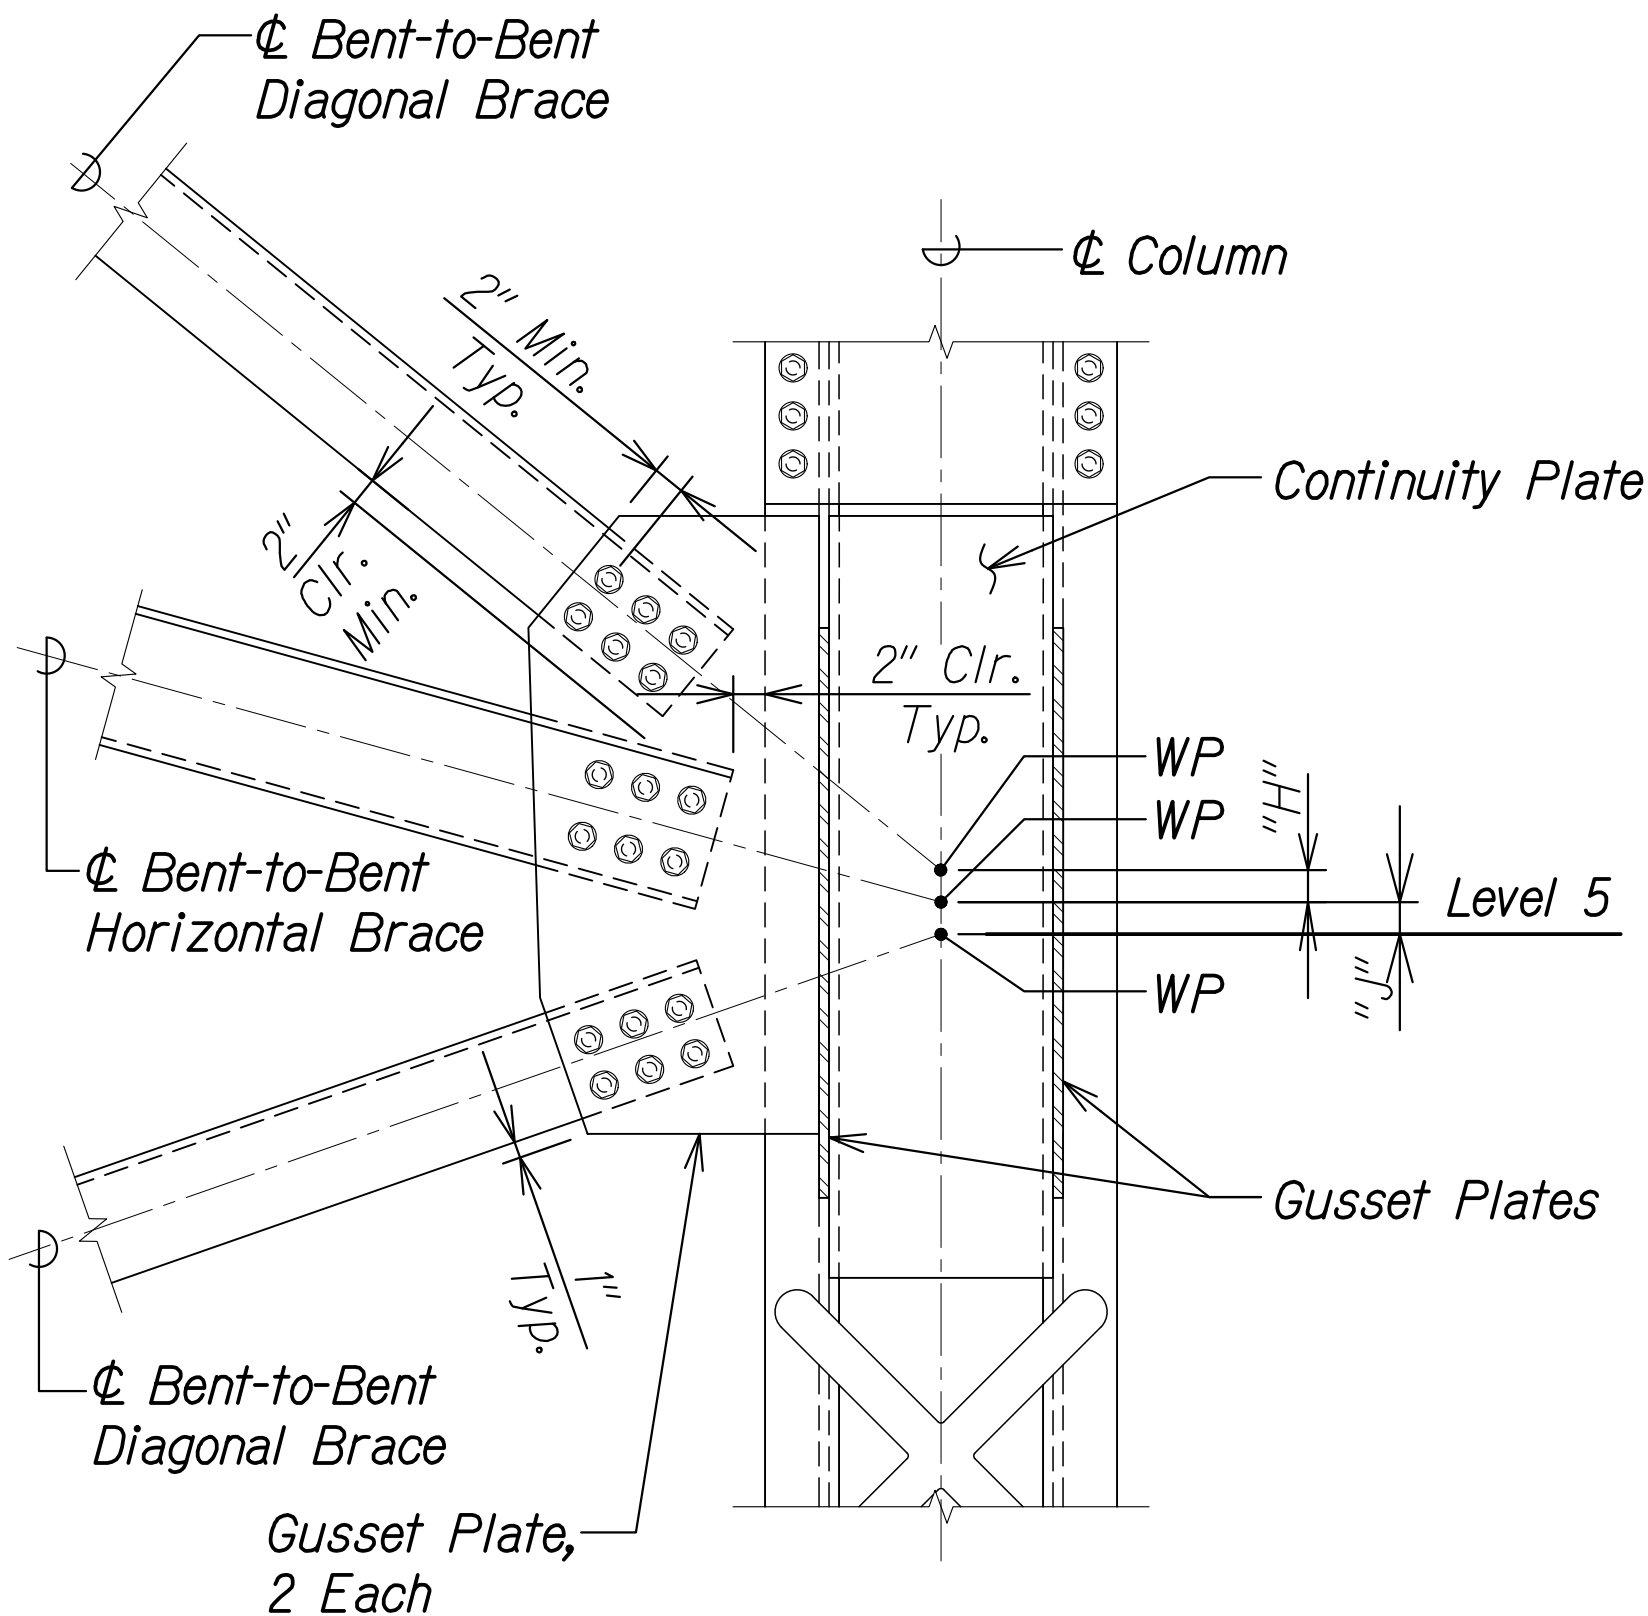


**COLUMN TO BRACE
CONNECTION DETAIL**


Scale: 1" = 1'-0"

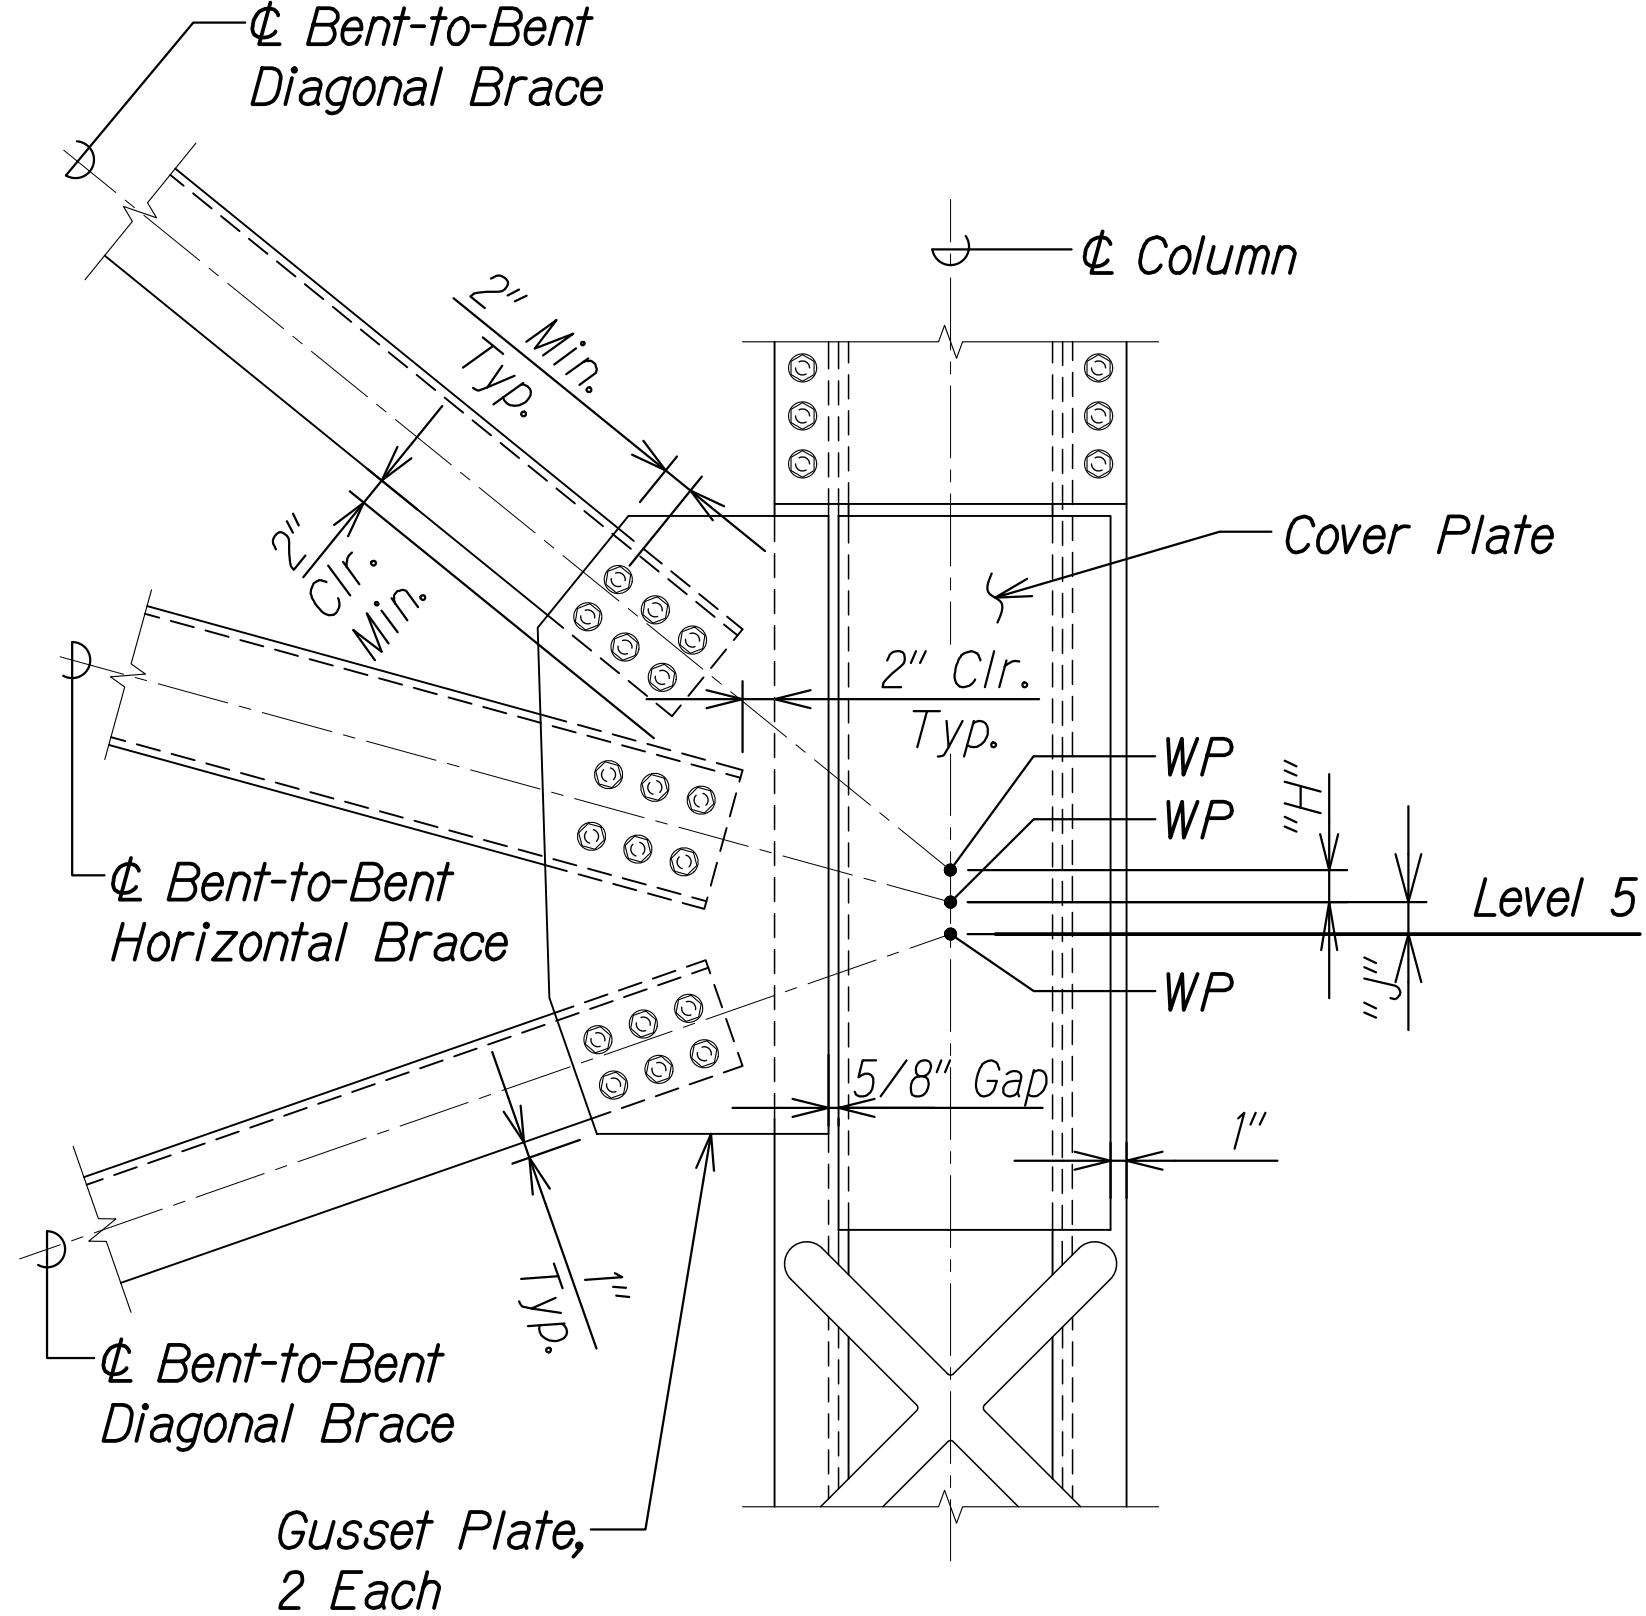

**COLUMN TO BRACE
CONNECTION DETAIL**

Scale: 1" = 1'-0"

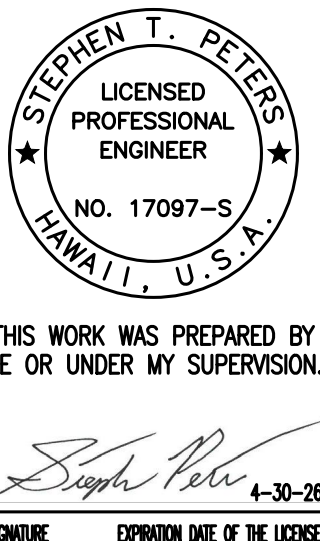

12/6/24		Revised Details & Added Notes & Schedule
DATE	REVISION	

STATE OF HAWAII
DEPARTMENT OF TRANSPORTATION
HIGHWAYS DIVISION


COLUMN TO BRACE
CONNECTION DETAILS
HAWAII BELT ROAD
Nanue Stream Bridge Rehabilitation
Federal Aid Project No. BR-019-2(077)

Scale: As Noted Date: Oct. 2024


FED. ROAD DIST. NO.	STATE	FEDERAL AID PROJ. NO.	FISCAL YEAR	SHEET NO.	TOTAL SHEETS
HAWAII	HAW.	BR-019-2(077)	2024	ADD. 115	280

NOTES:

- The Contractor's Steel Detailer is responsible for determining the actual size of each gusset/continuity/cover plate based on the information provided in the Contract Drawings.
- All bolted connections for horizontal and diagonal braces, as detailed on this sheet, shall be pretensioned.
- After erection, touch-up paint the ends of all bolts/nuts/washers.
- Batten plates and lacing on braces not shown for clarity.

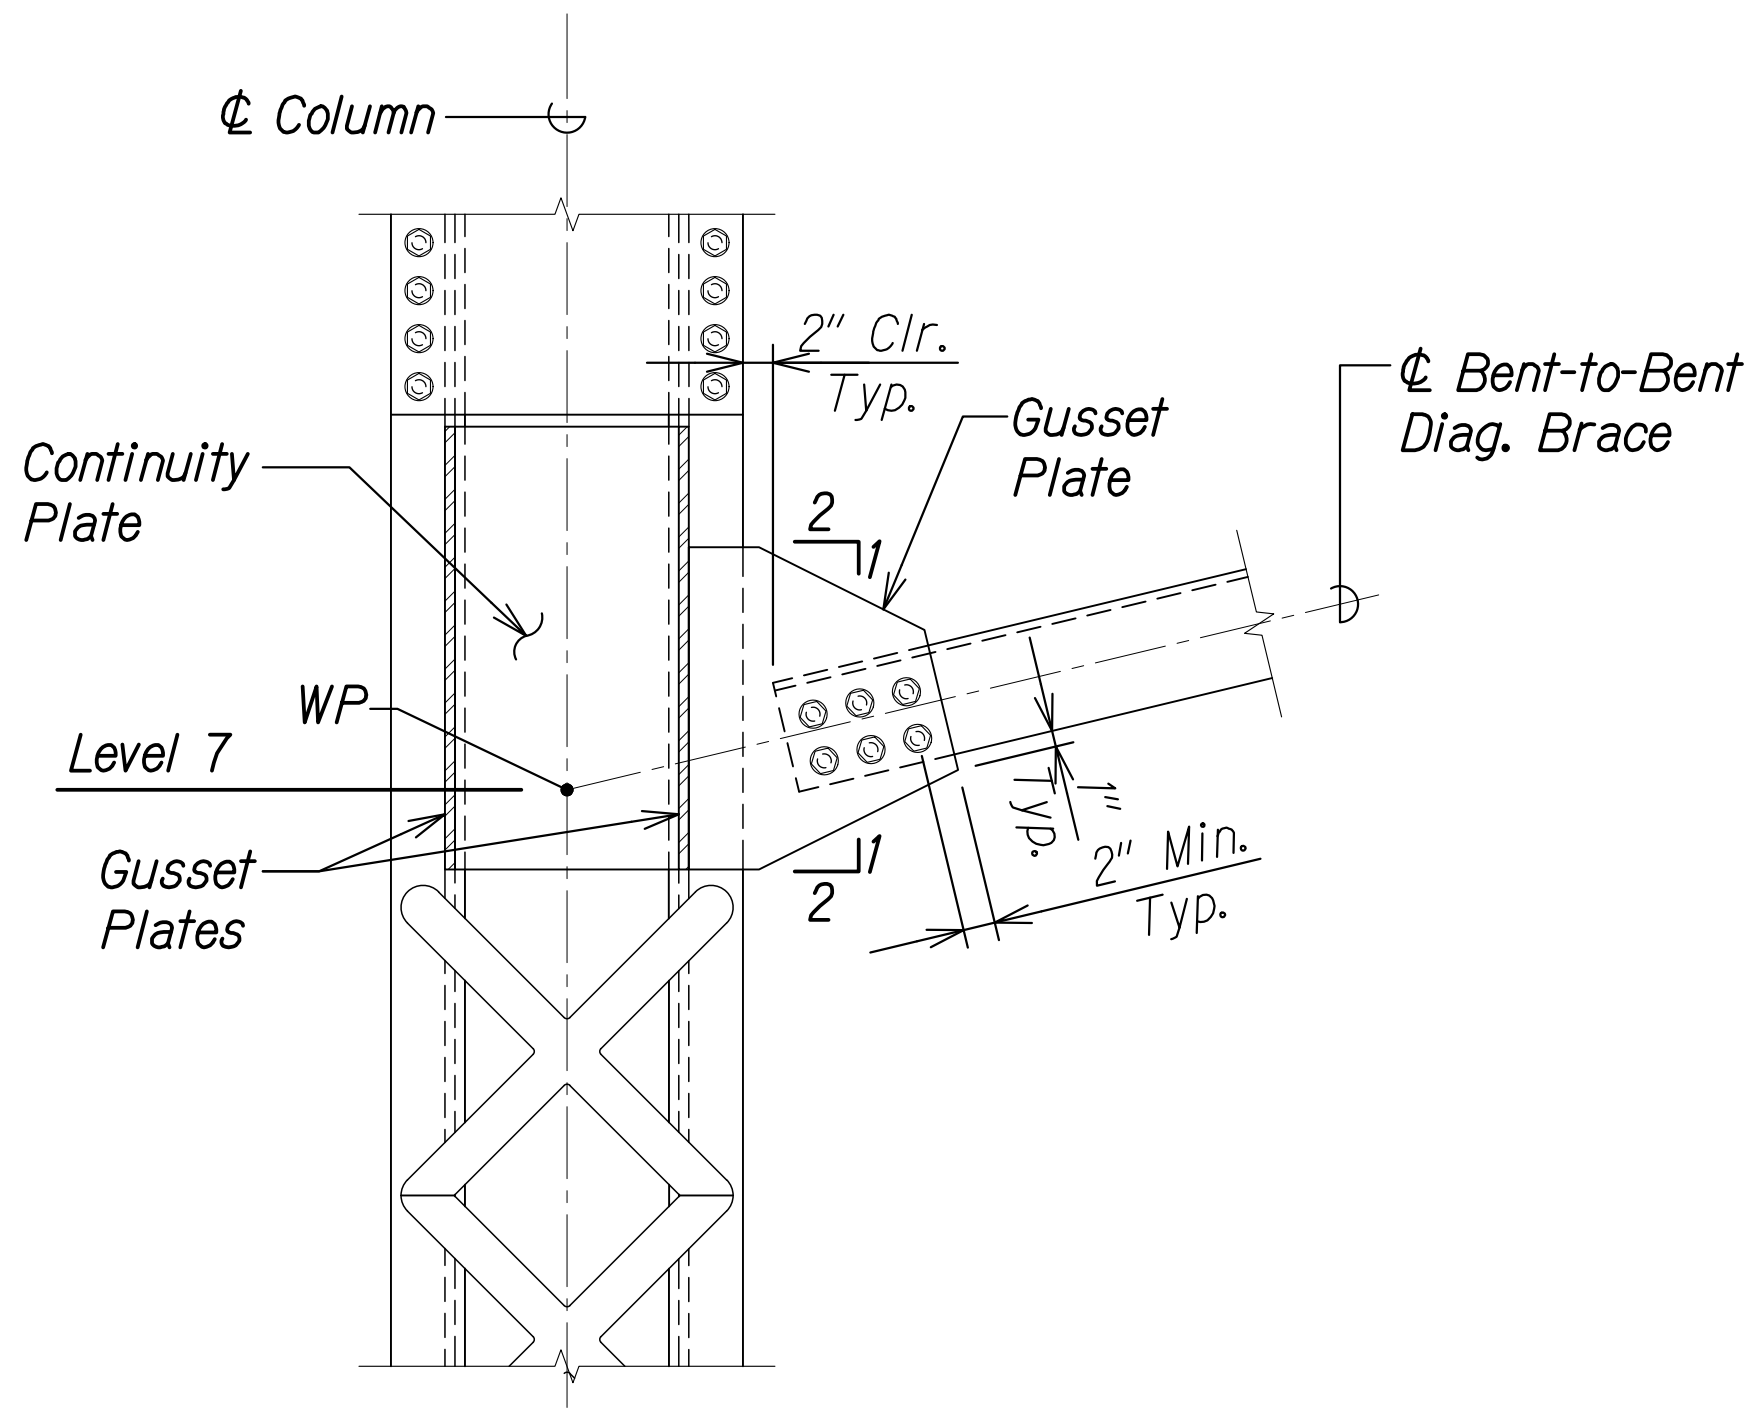


**COLUMN TO BRACE
CONNECTION DETAIL**
Scale: 1" = 1'-0"
SA6.9 SA6.9 1

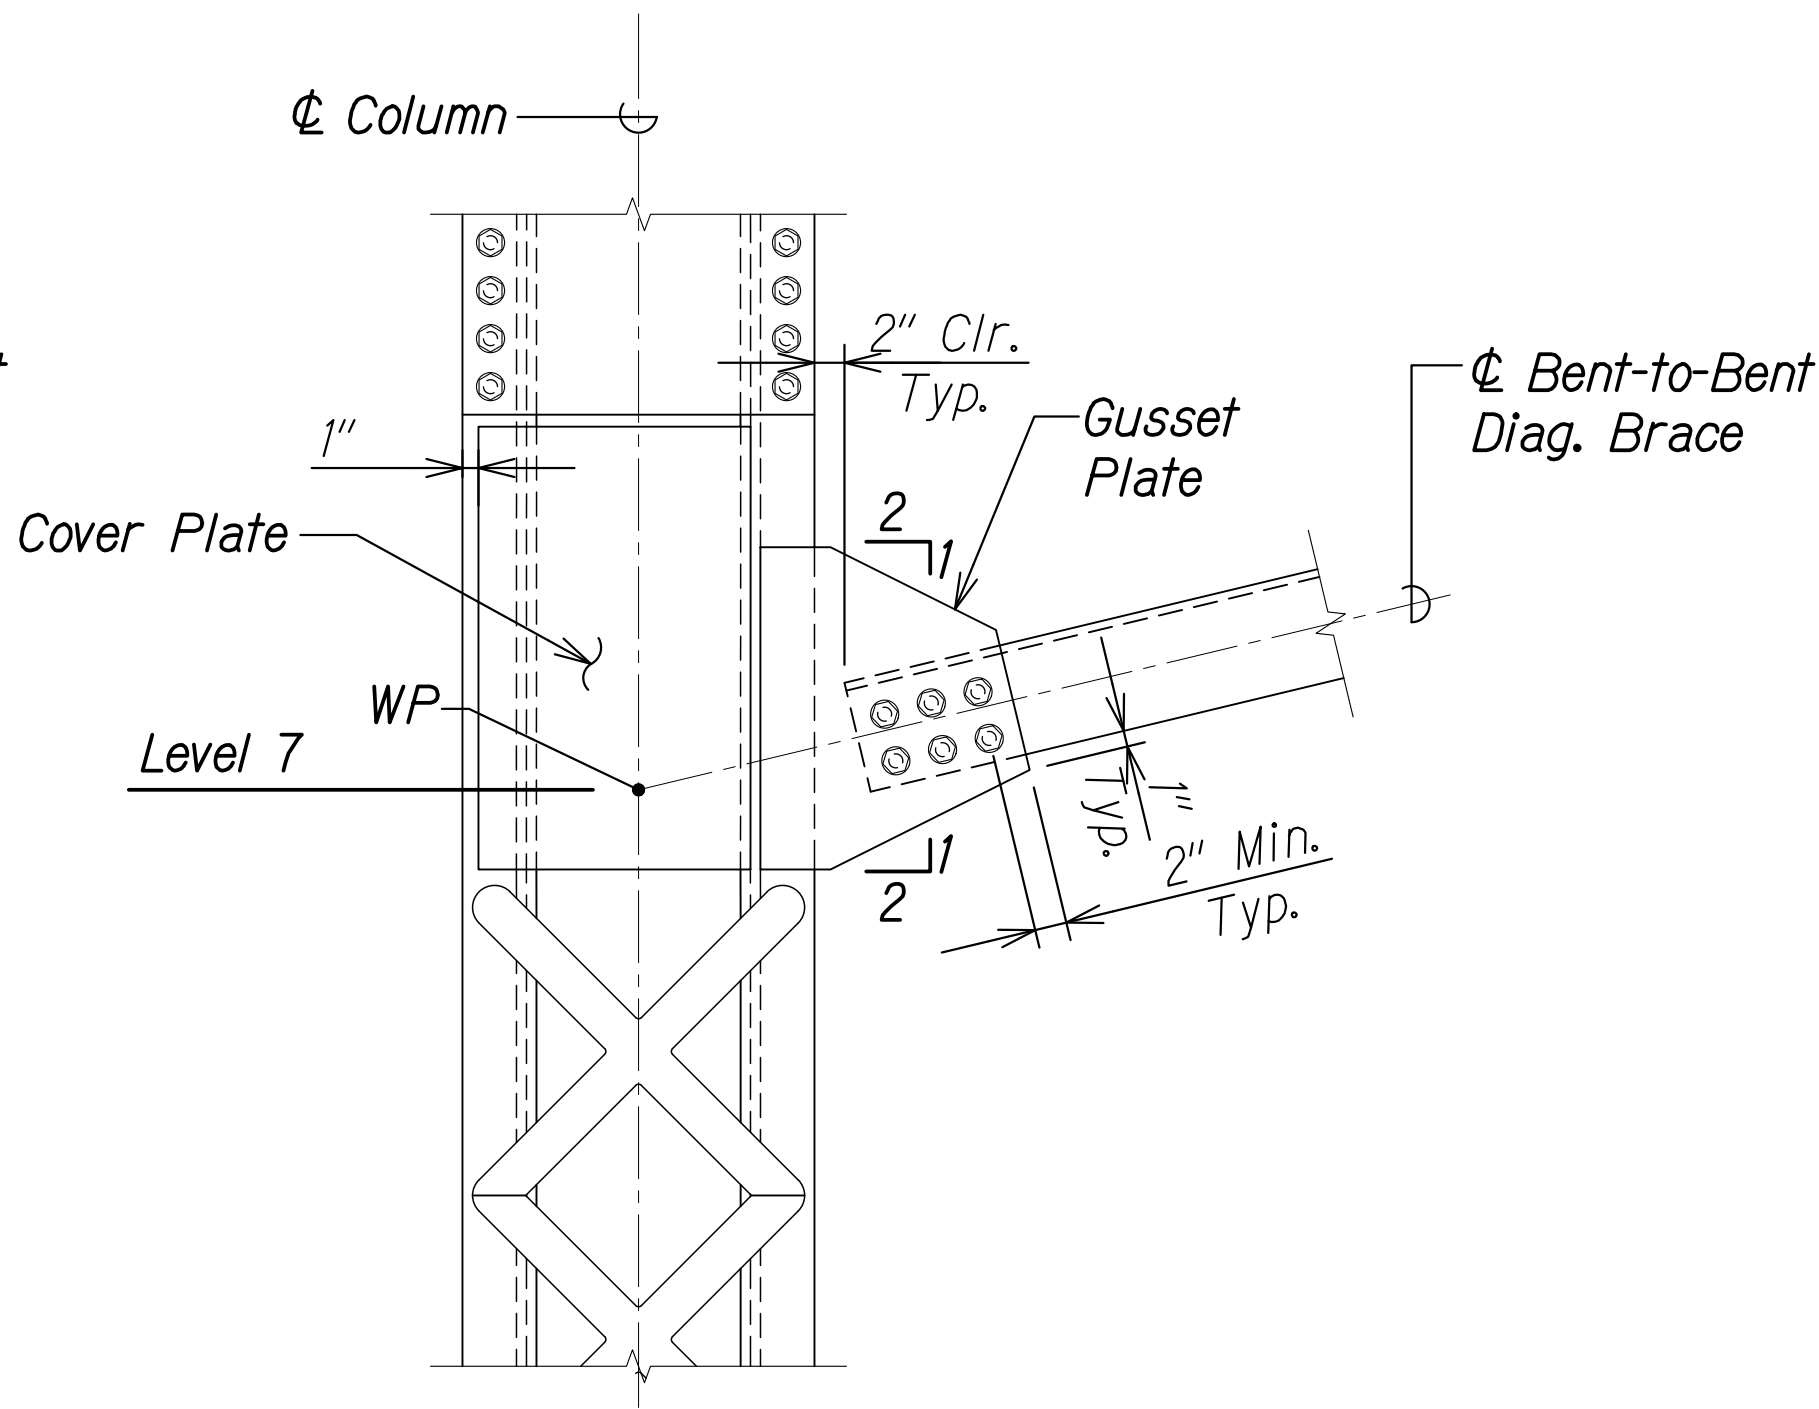

**COLUMN TO BRACE
CONNECTION DETAIL**
Scale: 1" = 1'-0"
SA6.9 SA6.9 1


ORIGINAL PLAN	SURVEY PLOTTED BY	DATE
NOTE BOOK	DRAWN BY	
	DESIGNED BY	
	QUANTITIES BY	
	CHECKED BY	

DRAWING NAME: Z:\00 ONGOING\23-022.9-NANUE STR BR PF2-DOT1\01 CAD\12-06-24 ADD\NSR-SA6602-SAG617 CONN DTL'S ADD2.DWG PLOT TIME: 12-03-24 10:16 PM

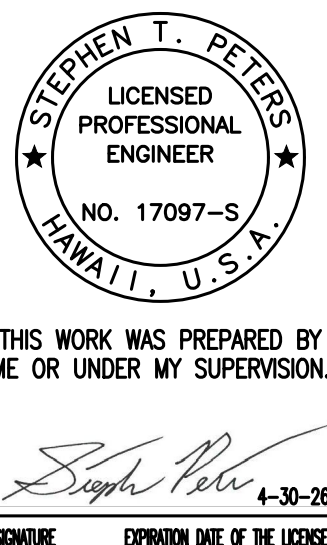

12/6/24	1	Revised Details and Added Notes
DATE	REVISION	
STATE OF HAWAII DEPARTMENT OF TRANSPORTATION HIGHWAYS DIVISION COLUMN TO BRACE CONNECTION DETAILS HAWAII BELT ROAD Nanue Stream Bridge Rehabilitation Federal Aid Project No. BR-019-2(077) Scale: As Noted Date: Oct. 2024		
SHEET No. SA6.9 OF 22 SHEETS		


FED. ROAD DIST. NO.	STATE	FEDERAL AID PROJ. NO.	FISCAL YEAR	SHEET NO.	TOTAL SHEETS
HAWAII	HAW.	BR-019-2(077)	2024	ADD. 116	280

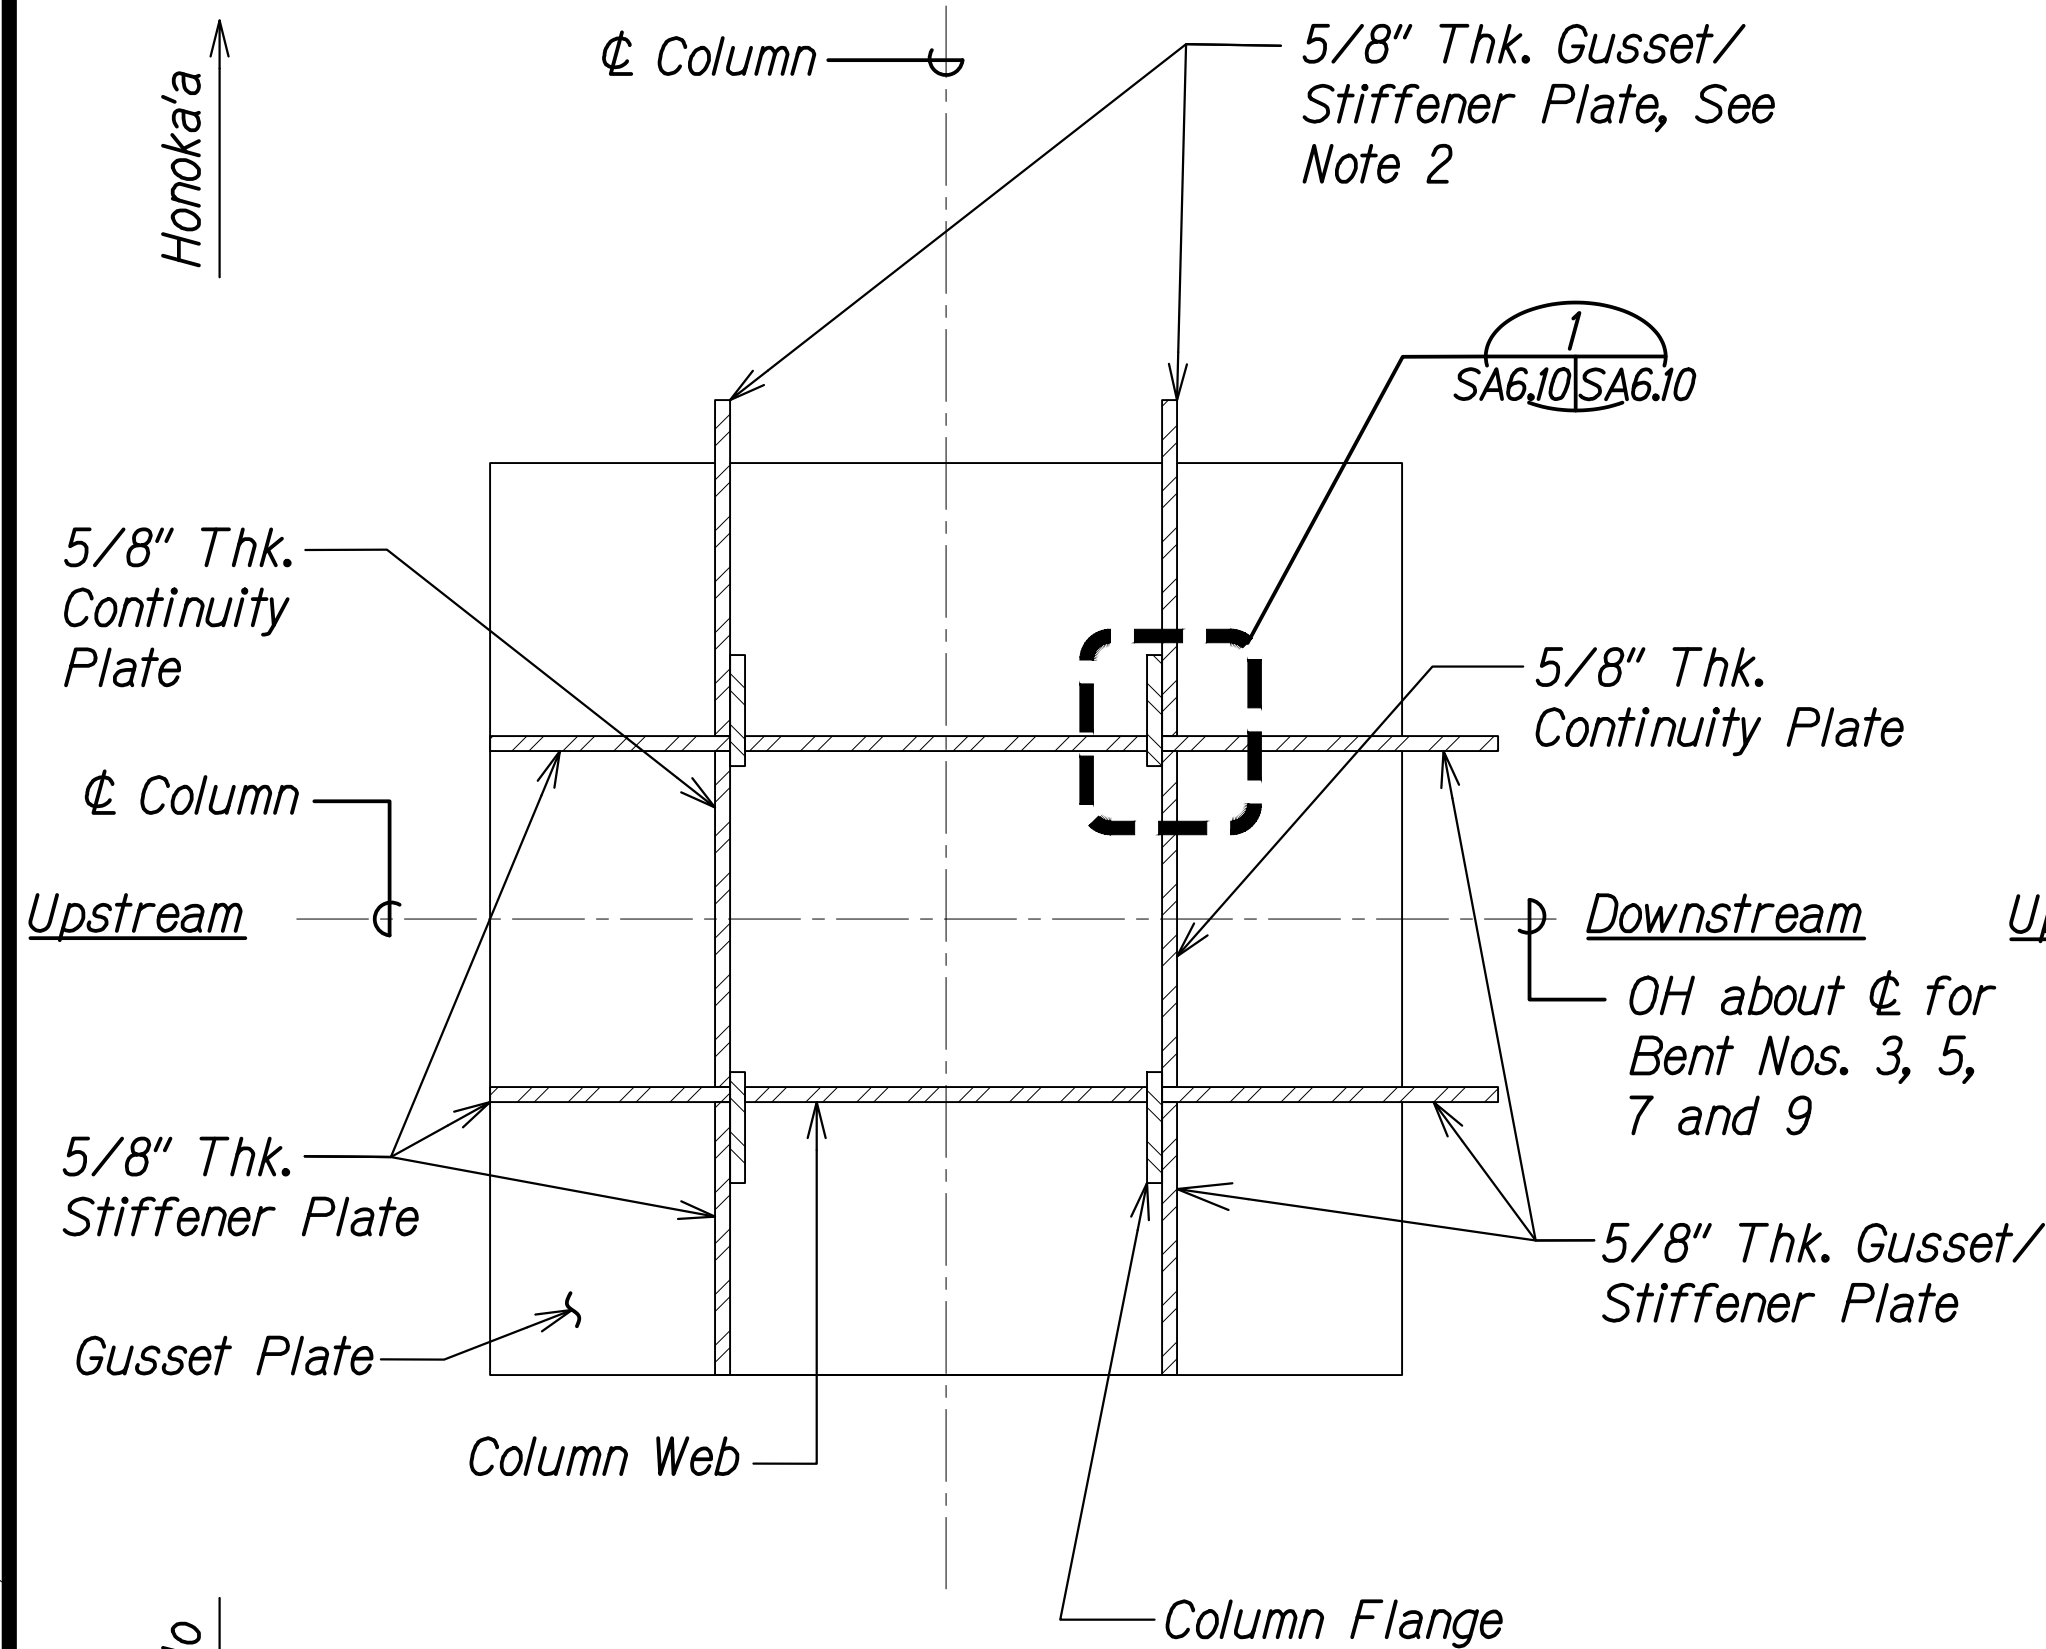

BASE COLUMN TO BRACE
PLAN AT BENT EXTERIOR

Scale: 1 1/2" = 1'-0"


SA6.10|SA6.10 1

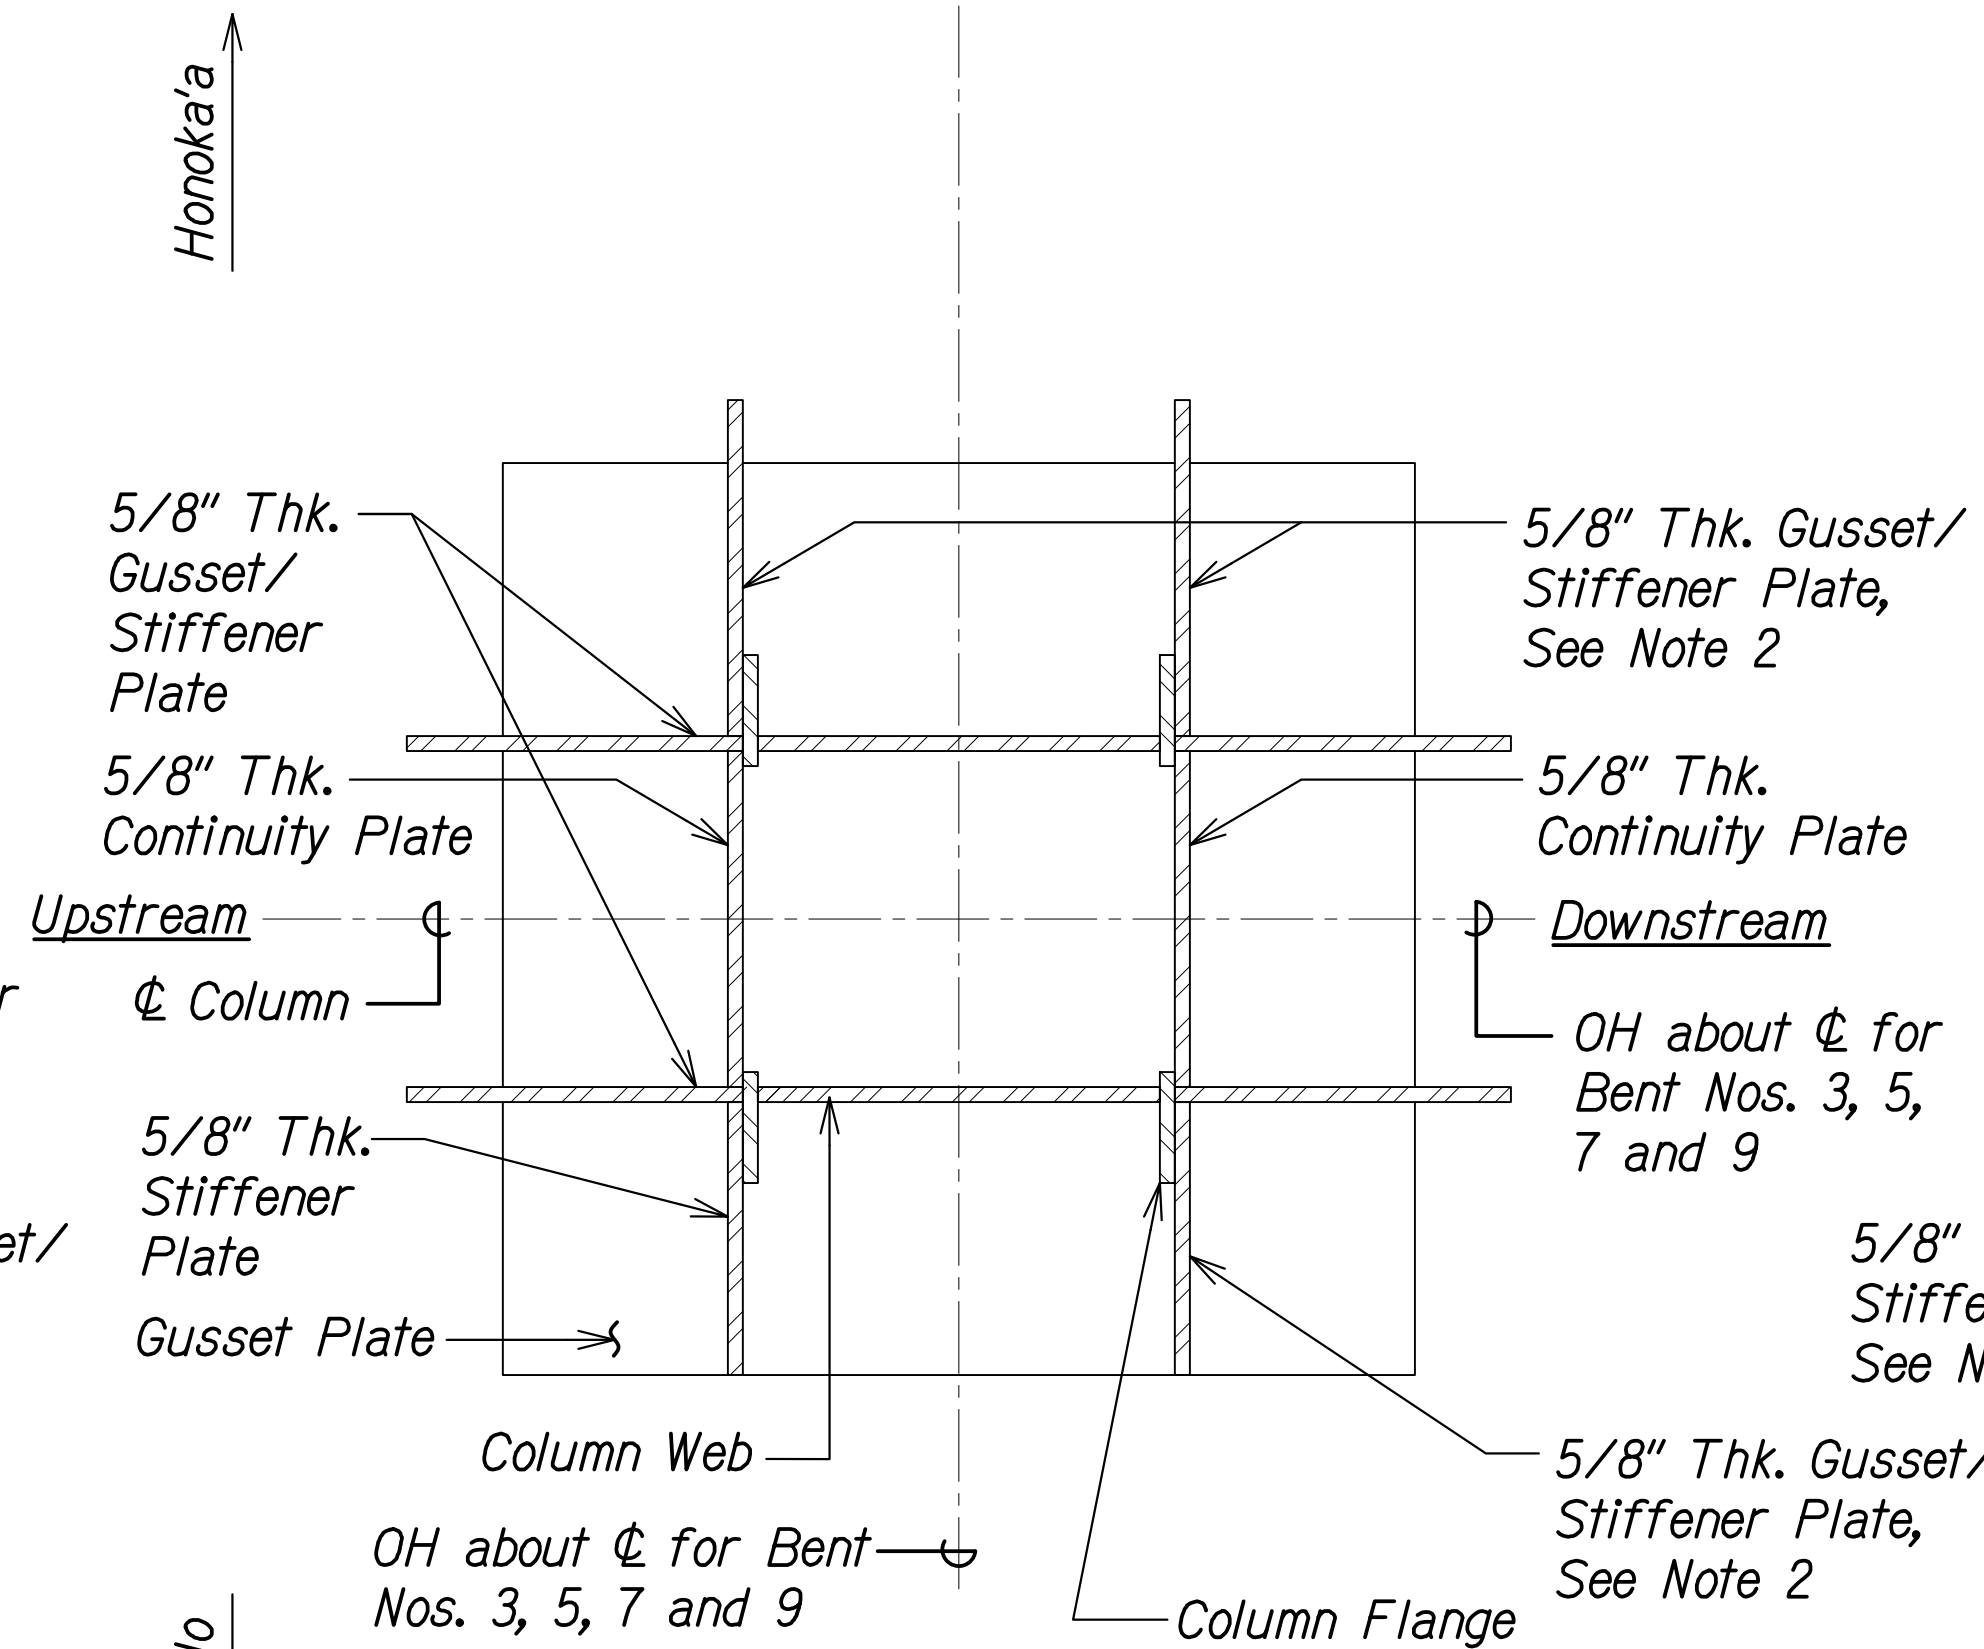

BASE COLUMN TO BRACE
PLAN AT BENT INTERIOR

Scale: 1 1/2" = 1'-0"


SA6.10|SA6.10 1

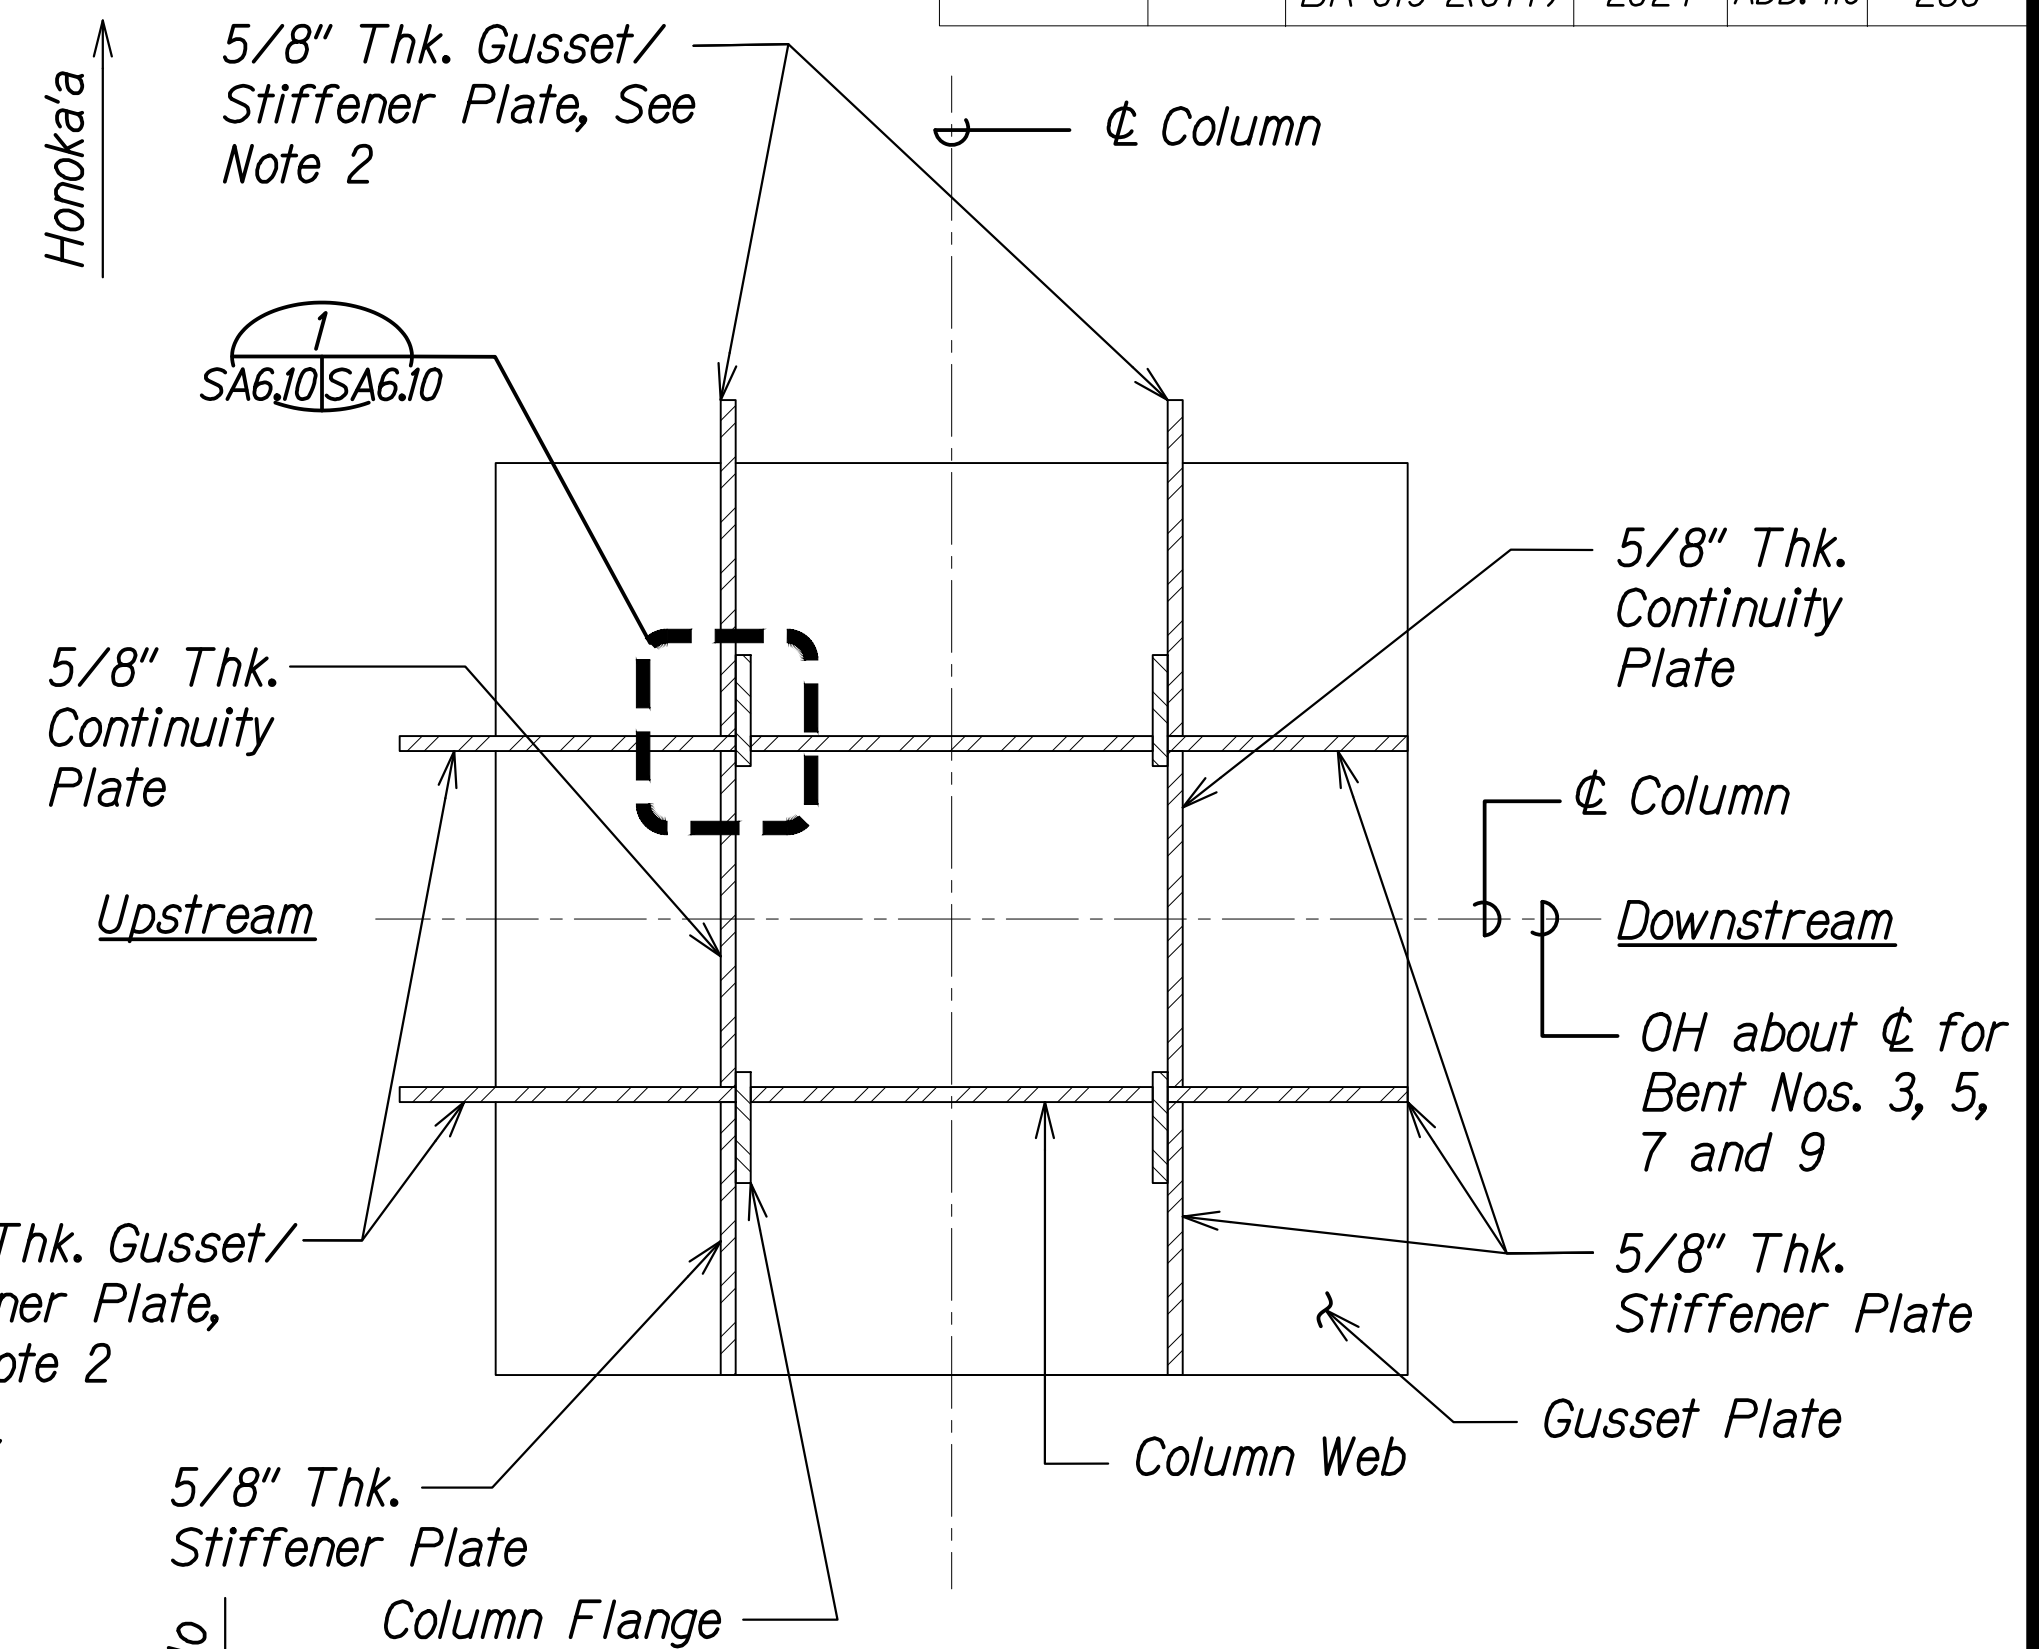

BASE COLUMN TO BRACE
PLAN AT BENT EXTERIOR

Scale: 1 1/2" = 1'-0"

SA6.10|SA6.10 1

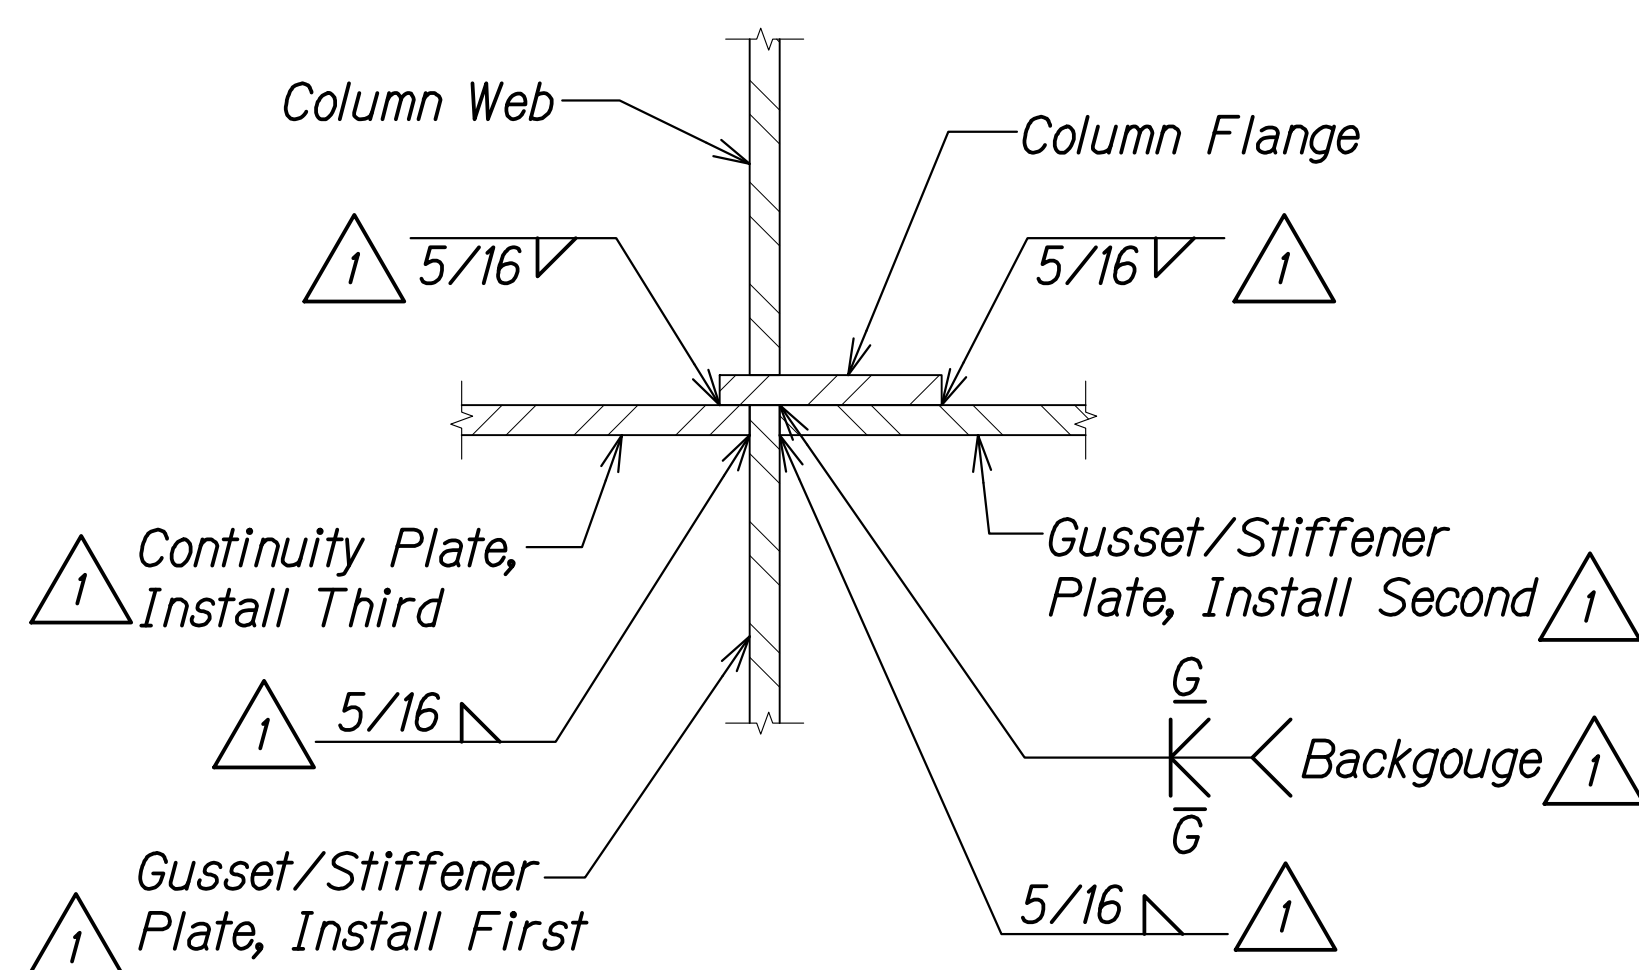


DETAIL

Scale: 3" = 1'-0"

SA6.10|SA6.10 1

NOTES:

- All gusset/cover/continuity/stiffener plates shall receive return fillet welds across the top and bottom connection at faying edge with column flange and base plate to provide a full seal weld to prevent moisture intrusion.
- 5/8" thick stiffener Plate at Bent No. 1.

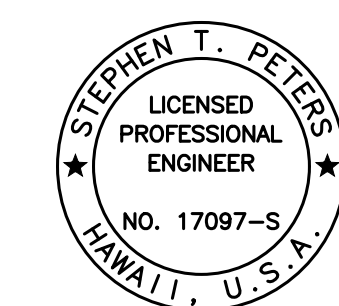

THIS WORK WAS PREPARED BY ME OR UNDER MY SUPERVISION.

SIGNATURE: Stephen T. Peters
EXPIRATION DATE OF THE LICENSE: 4-30-26


12/6/24	1	Revised Details & Added Notes
DATE	REVISION	
STATE OF HAWAII DEPARTMENT OF TRANSPORTATION HIGHWAYS DIVISION BASE COLUMN TO BRACE CONNECTION DETAILS HAWAII BELT ROAD Nanue Stream Bridge Rehabilitation Federal Aid Project No. BR-019-2(077) Scale: As Noted Date: Oct. 2024		
SHEET No. SA6.10 OF 22 SHEETS		

FED. ROAD DIST. NO.	STATE	FEDERAL AID PROJ. NO.	FISCAL YEAR	SHEET NO.	TOTAL SHEETS
HAWAII	HAW.	BR-019-2(077)	2024	ADD. 117	280




NOTES:

1. The Contractor's Steel Detailer is responsible for determining the actual size of each gusset/continuity/cover plate based on the information provided in the Contract Drawings.
2. All bolted connections for horizontal and diagonal braces, as detailed on this sheet, shall be pretensioned.
3. After erection, touch-up paint the ends of all bolts/nuts/washers.
4. Batten plates and lacing not shown for clarity.
5. See Schedule on sheet SA6.12 for WP offsets.

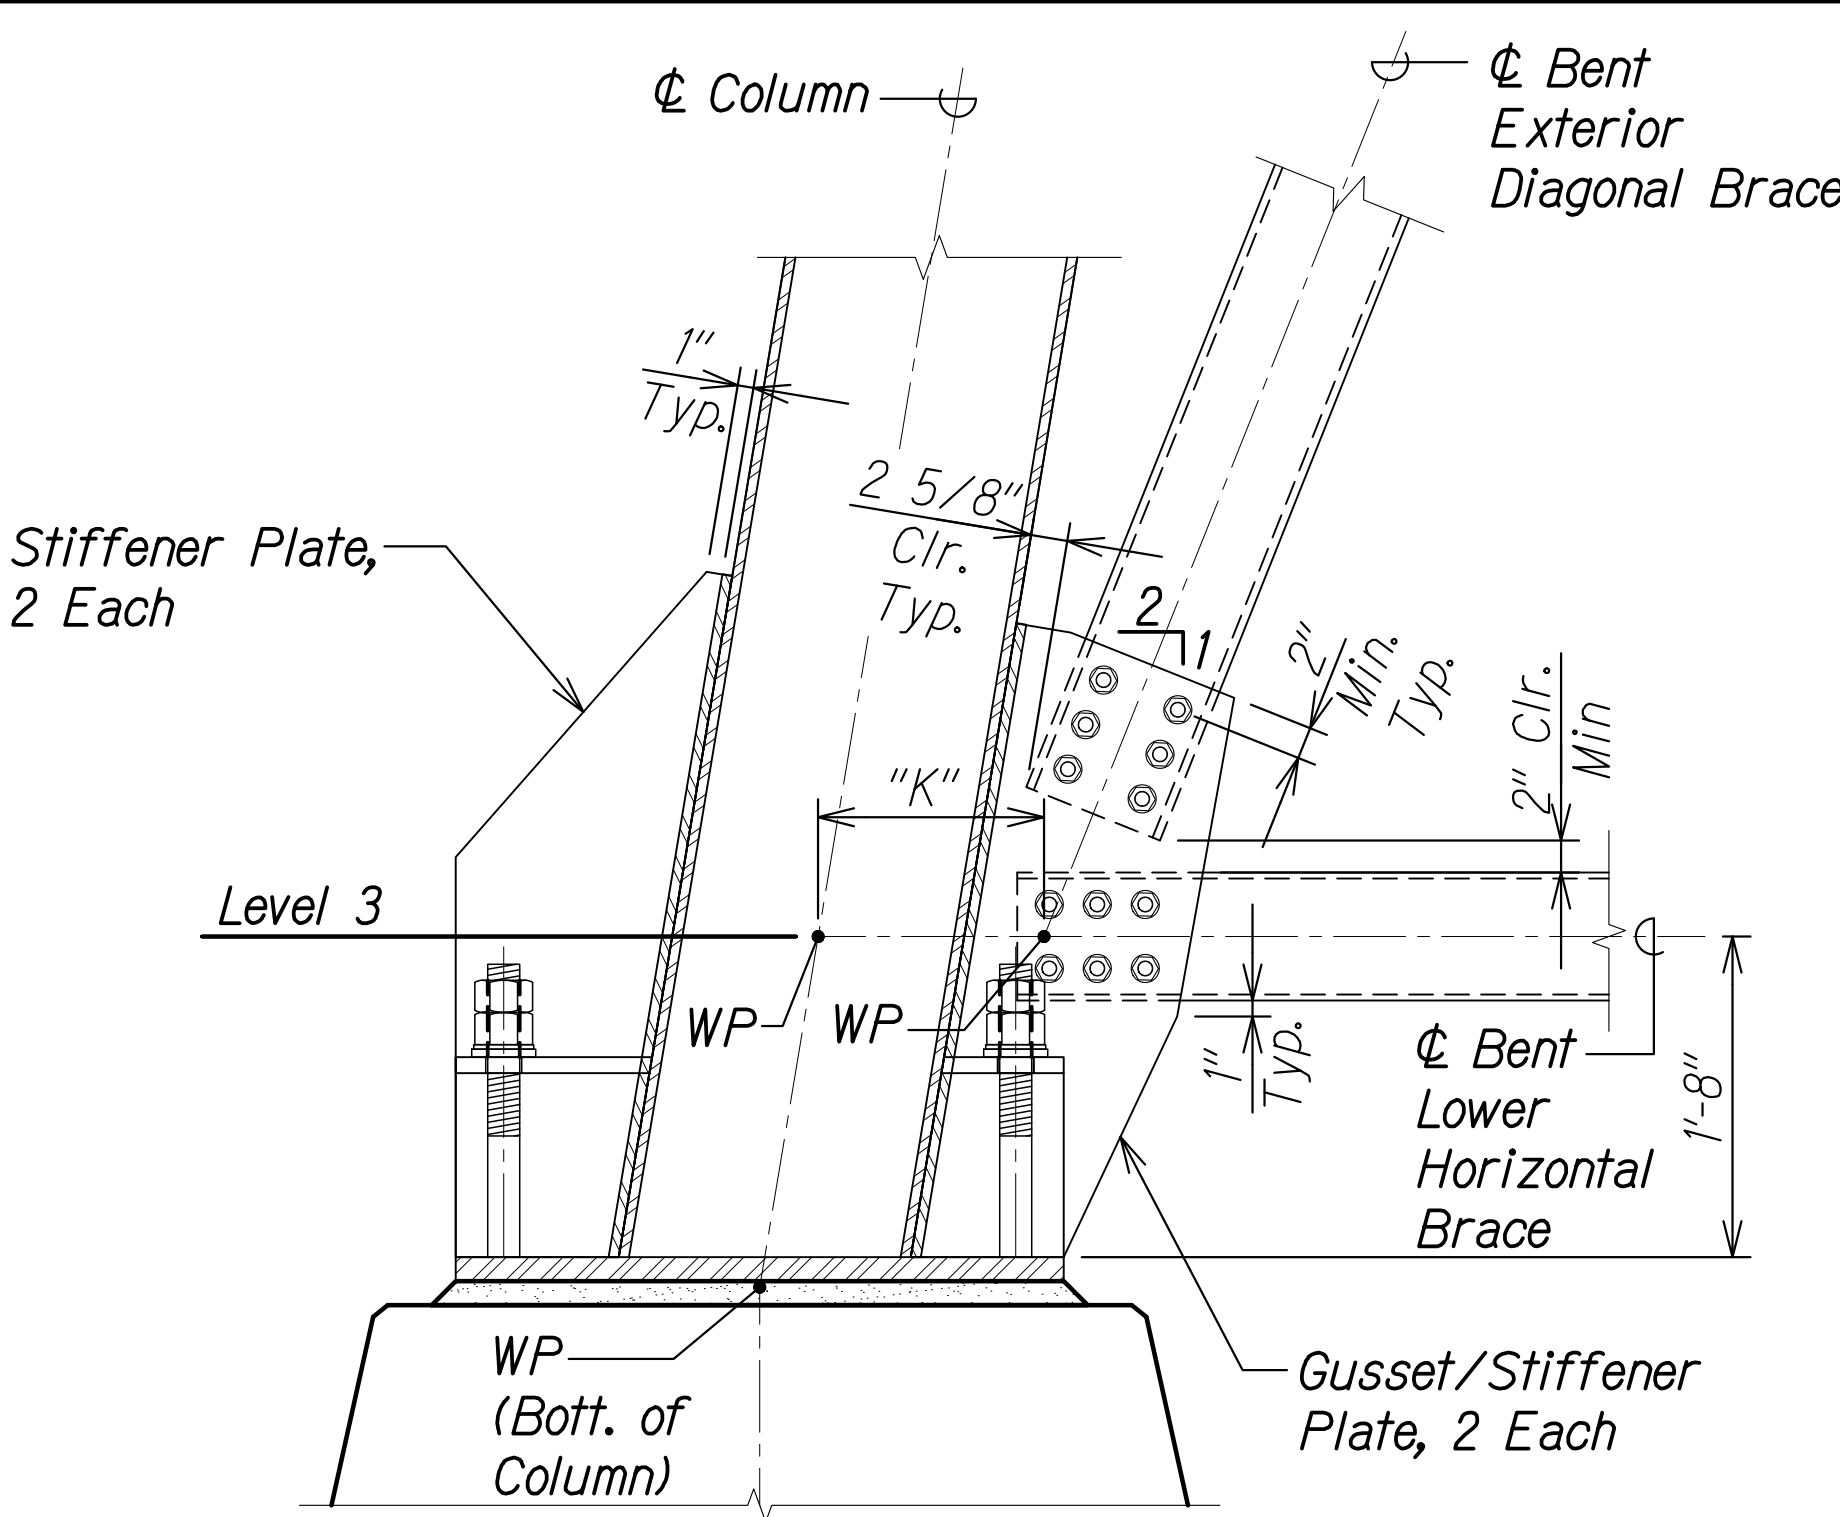


EXT. BASE COLUMN TO BRACE
CONNECTION DETAIL

Scale: 1" = 1'-0"

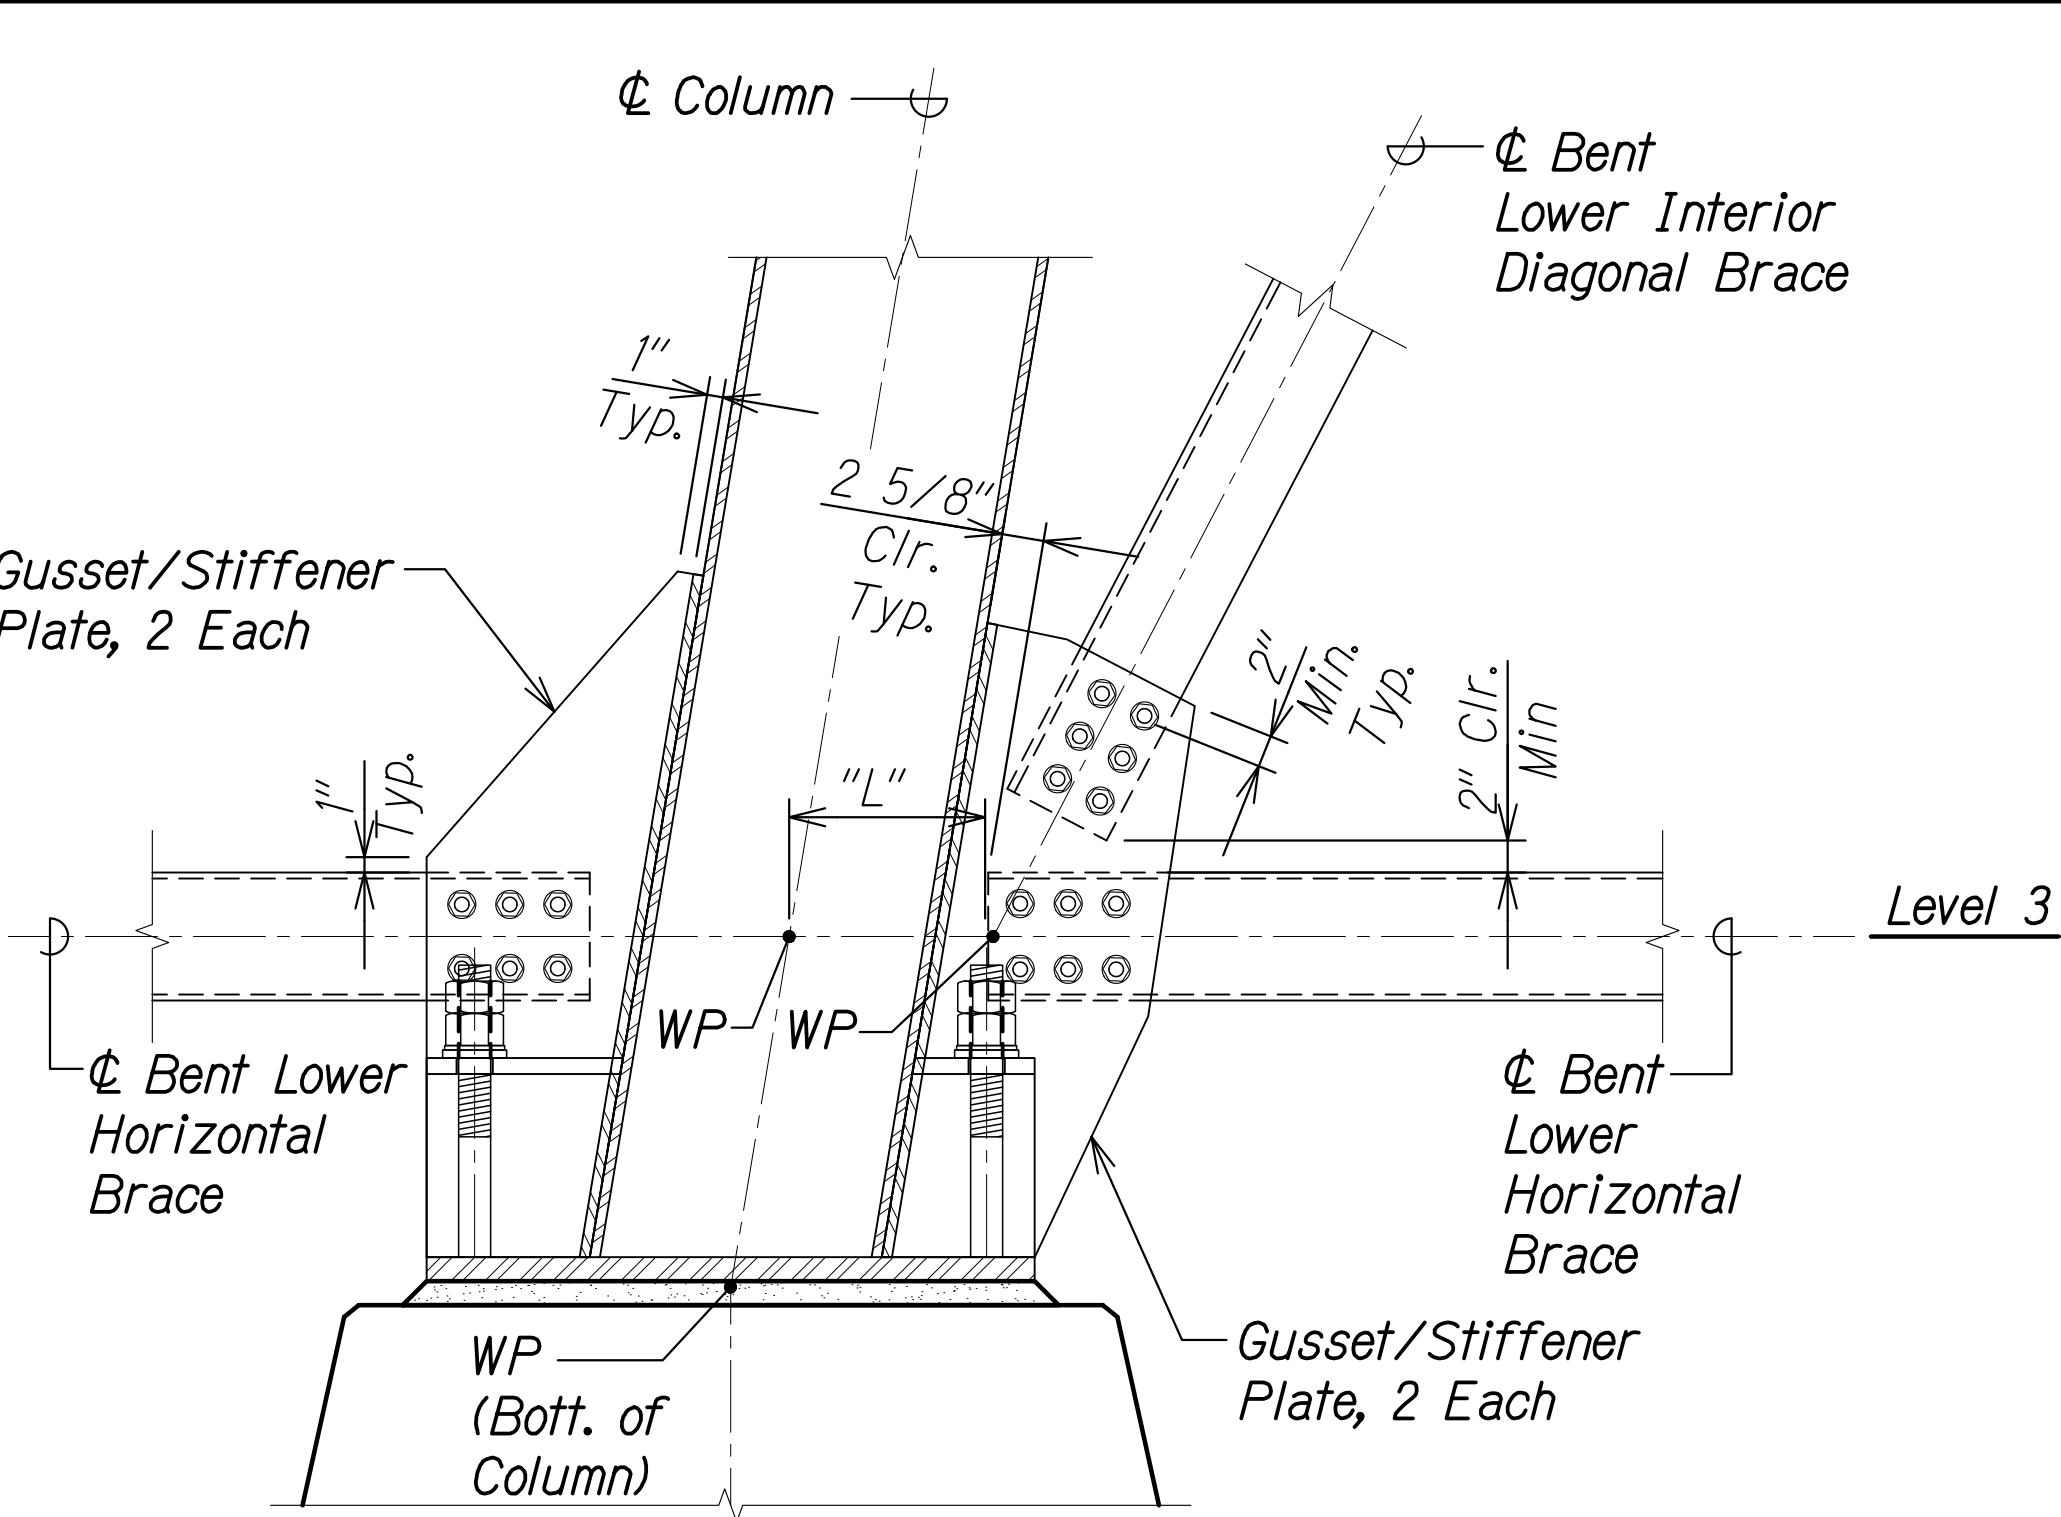


INT. BASE COLUMN TO BRACE
CONNECTION DETAIL

Scale: 1" = 1'-0"

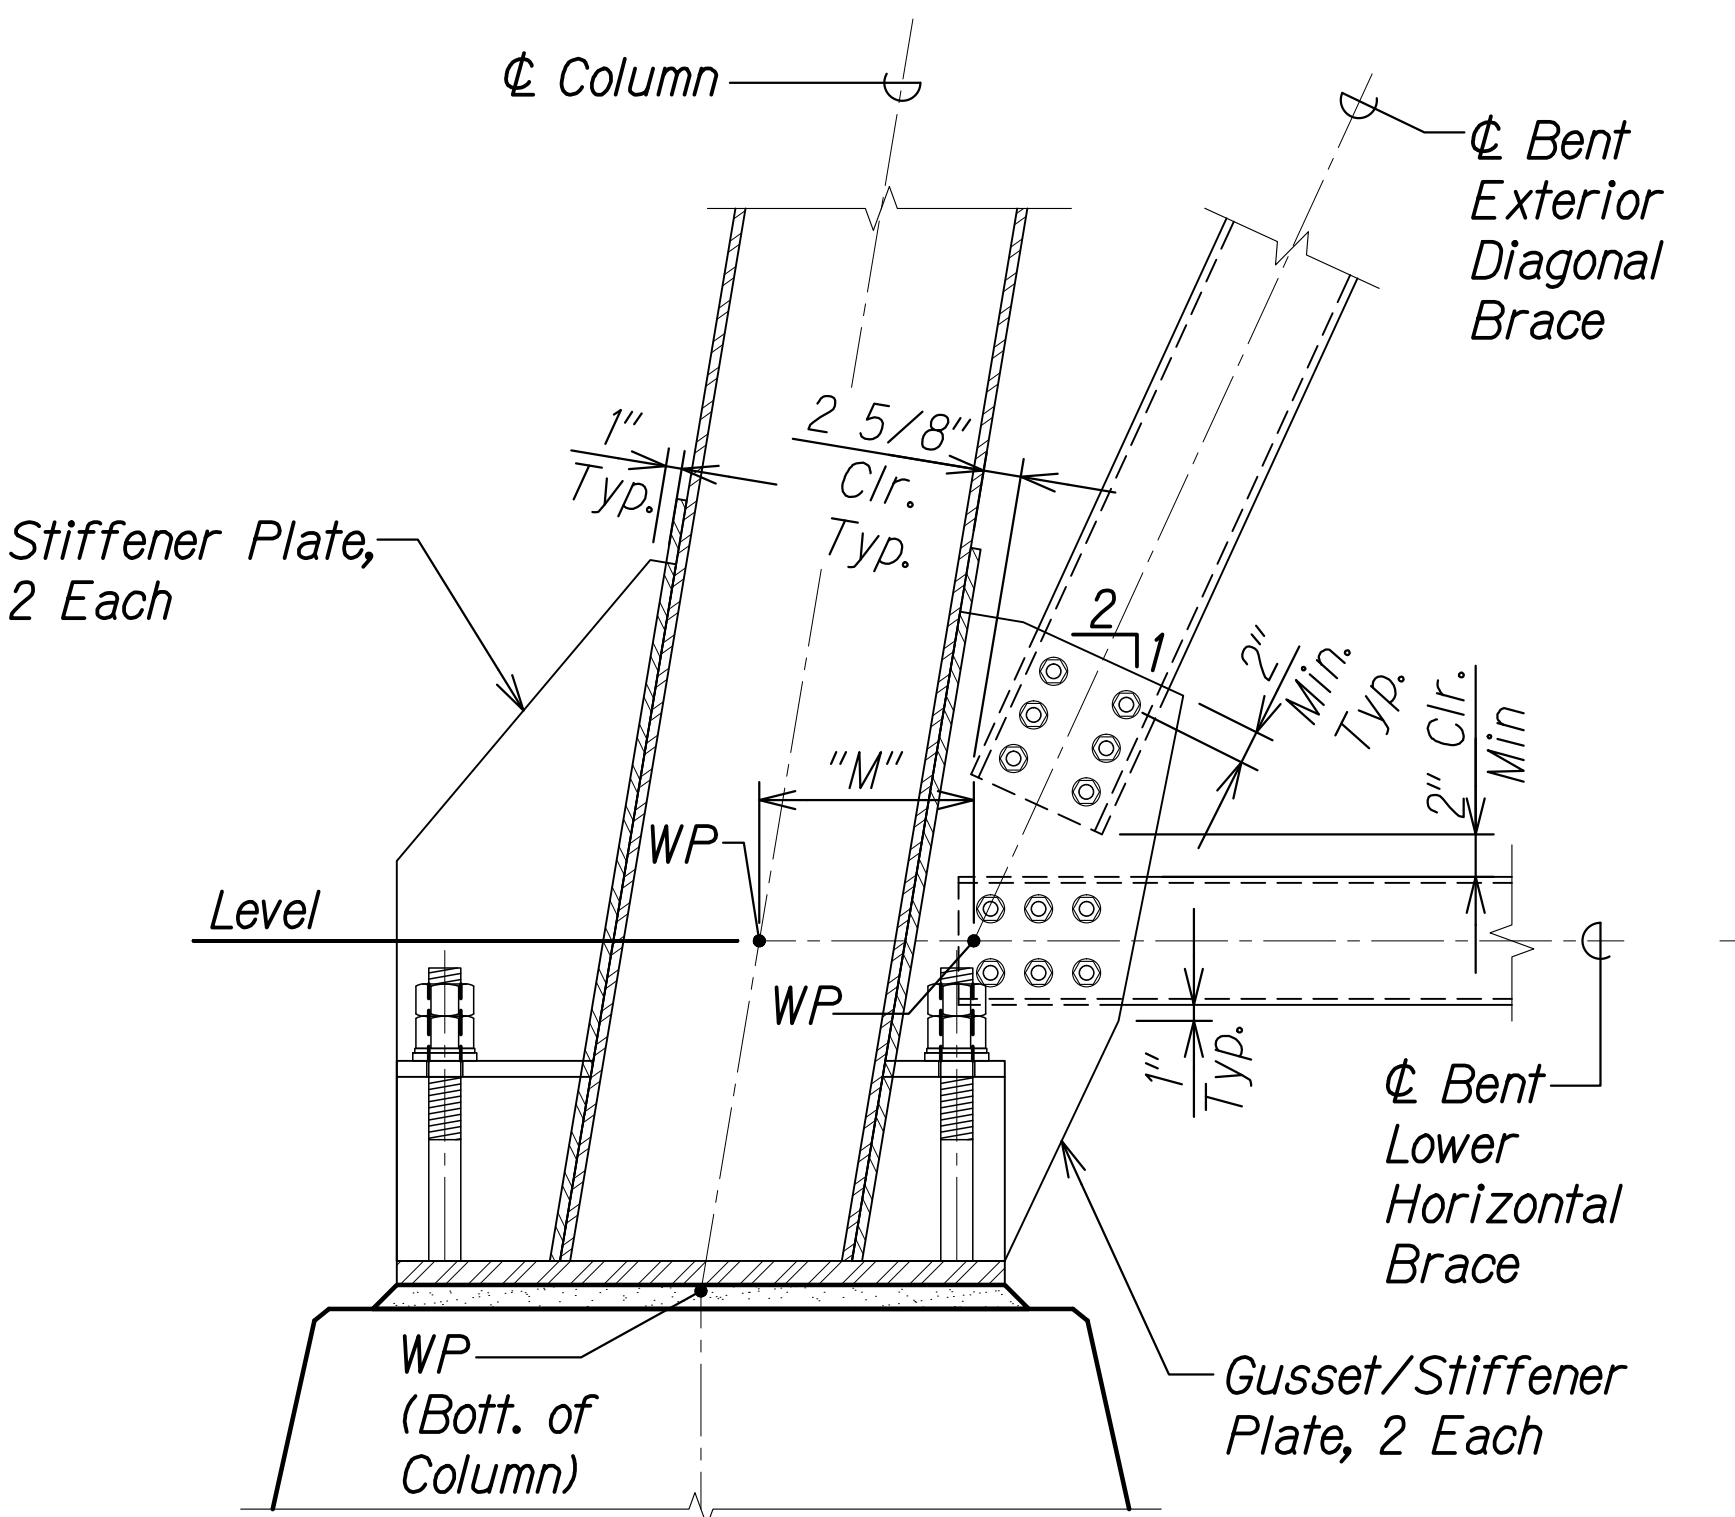


EXT. BASE COLUMN TO BRACE
CONNECTION DETAIL

Scale: 1" = 1'-0"

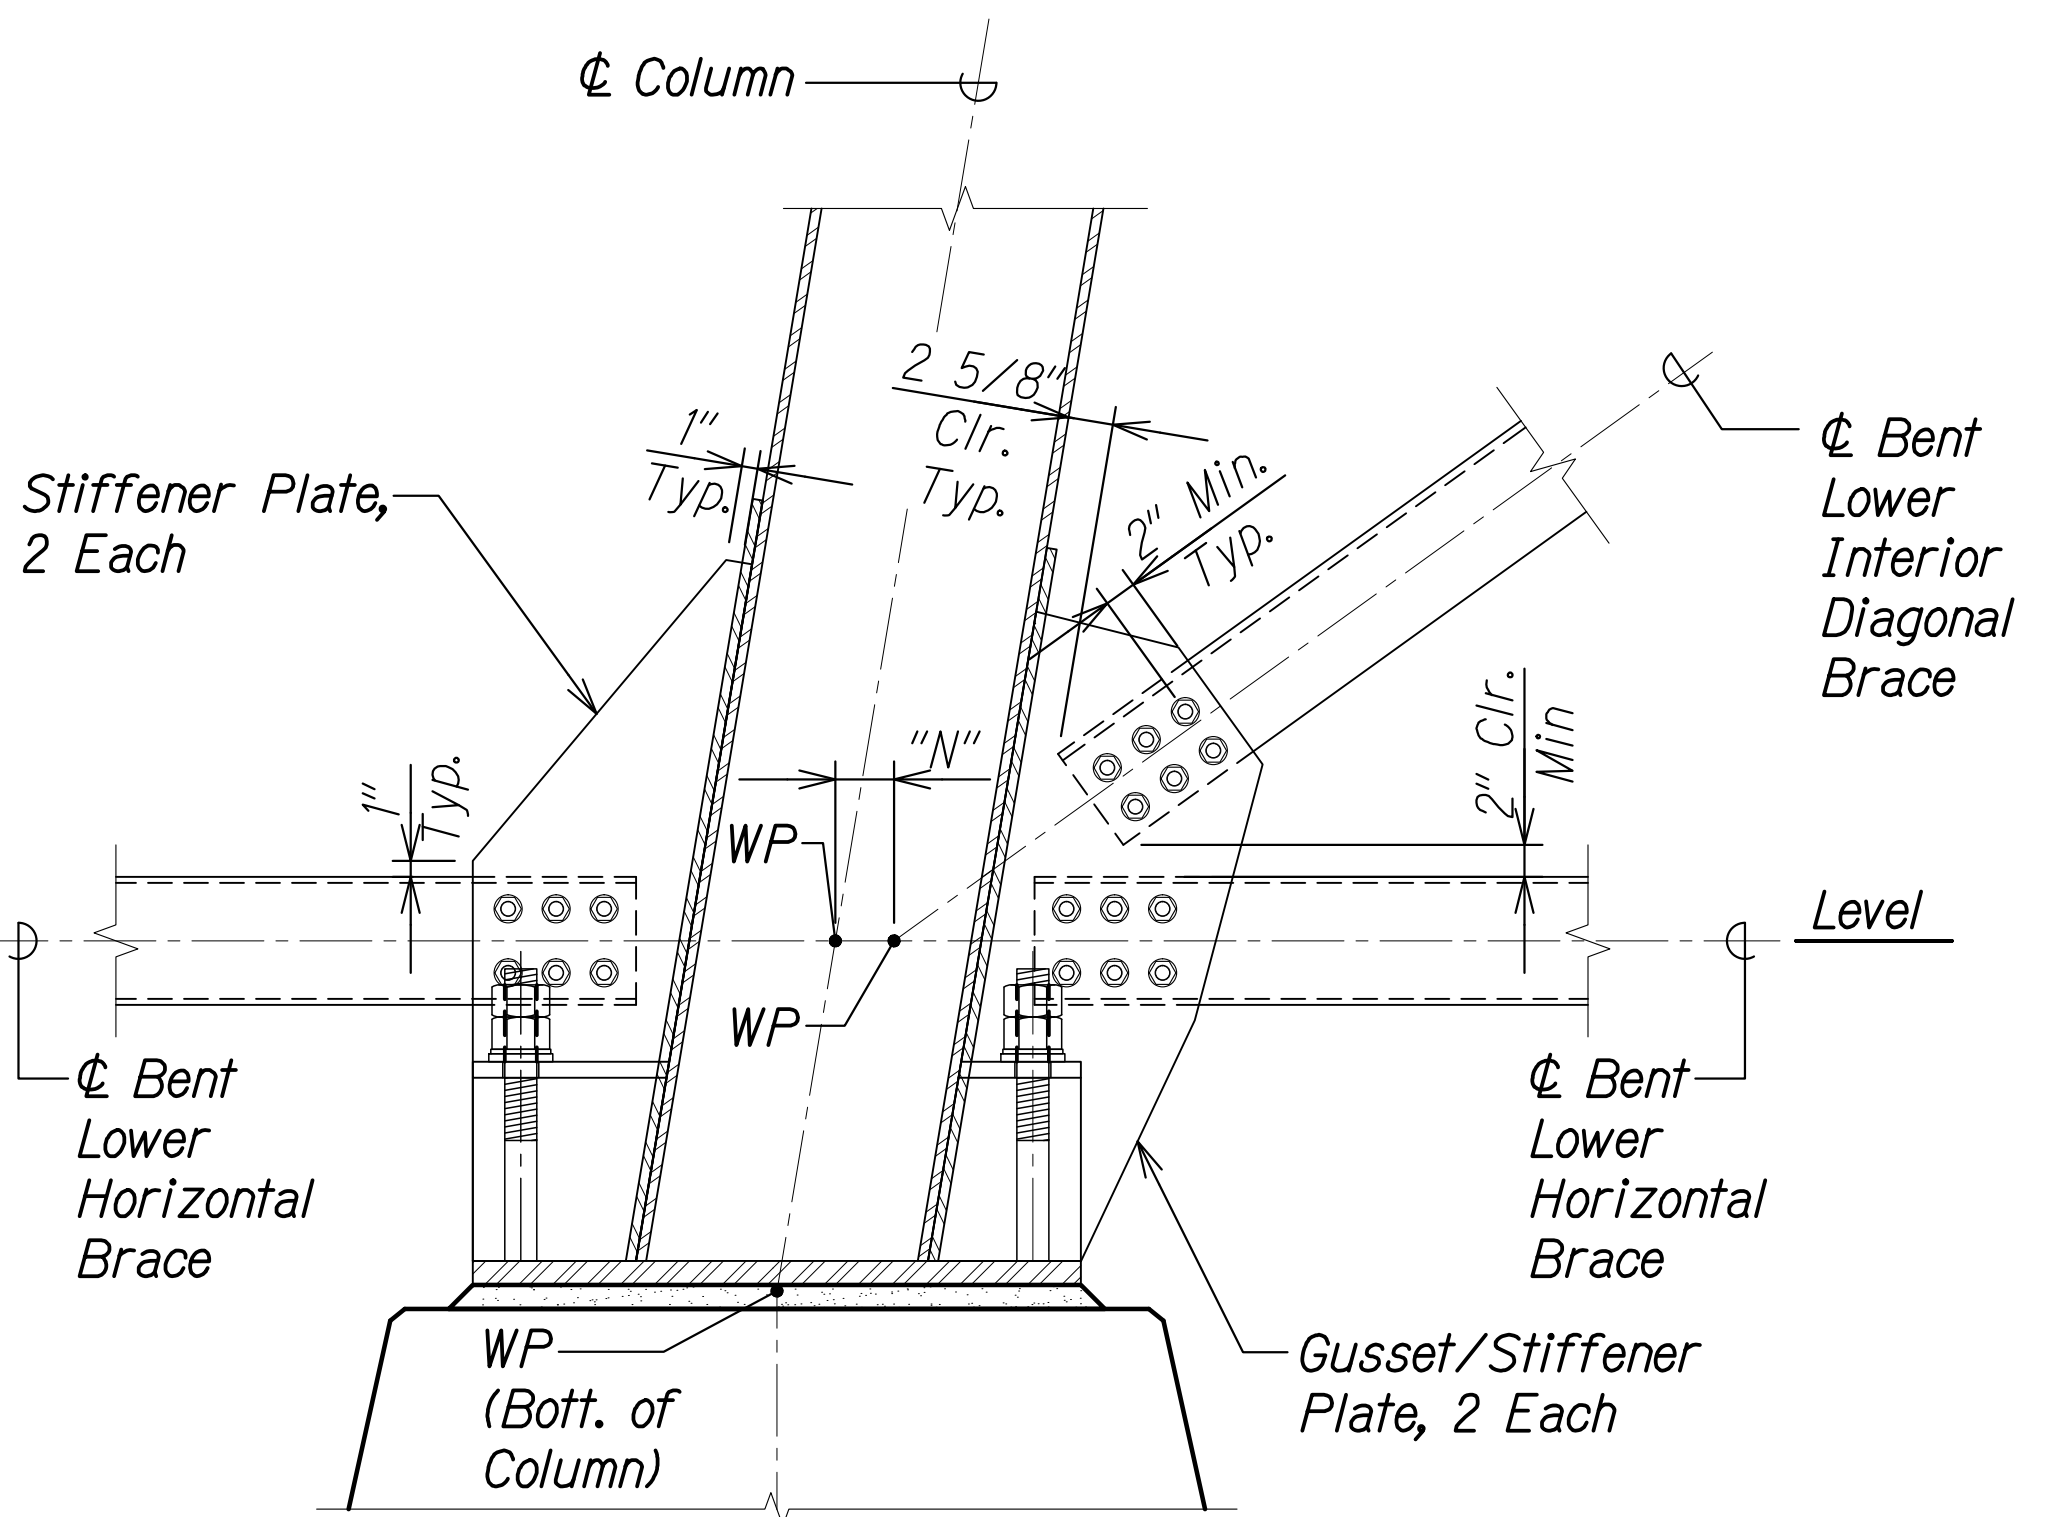


INT. BASE COLUMN TO BRACE
CONNECTION DETAIL

Scale: 1" = 1'-0"

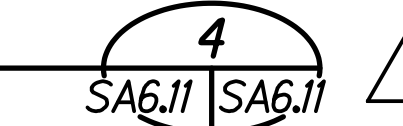

12/6/24	1	Revised Details & Added Notes
DATE		REVISION

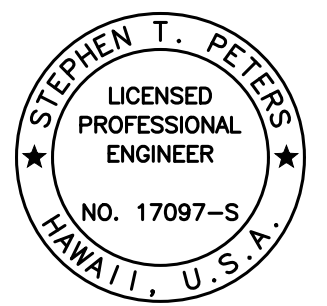

THIS WORK WAS PREPARED BY
ME OR UNDER MY SUPERVISION.
SIGNATURE
EXPIRATION DATE OF THE LICENSE

STATE OF HAWAII
DEPARTMENT OF TRANSPORTATION
HIGHWAYS DIVISION

BASE COLUMN TO BRACE
CONNECTION DETAILS
HAWAII BELT ROAD
Nanue Stream Bridge Rehabilitation
Federal Aid Project No. BR-019-2(077)
Scale: As Noted
Date: Oct. 2024

SHEET No. SA6.11 OF 22 SHEETS

DATE	
SURVEY PLOTTED BY	
ORIGINAL PLAN	
DESIGNED BY	
NOTE BOOK	
QUANTITIES BY	
CHECKED BY	
No.	


DRAWING NAME: Z:\00 ONGOING\23-022-9-NANUE STR BR PF2-DOT\A.01 CAD\12-06-24 ADD\NSR-SA6602-SA6617 CONN DTL'S ADD2.DWG PLOT TIME: 12-05-24 1:27 PM

FED. ROAD DIST. NO.	STATE	FEDERAL AID PROJ. NO.	FISCAL YEAR	SHEET NO.	TOTAL SHEETS
HAWAII	HAW.	BR-019-2(077)	2024	ADD. 118	280




NOTES:

- The Contractor's Steel Detailer is responsible for determining the actual size of each gusset/continuity/cover plate based on the information provided in the Contract Drawings.
- All bolted connections for horizontal and diagonal braces, as detailed on this sheet, shall be pretensioned.
- After erection, touch-up paint the ends of all bolts/nuts/washers.
- Batten plates and lacing not shown for clarity.

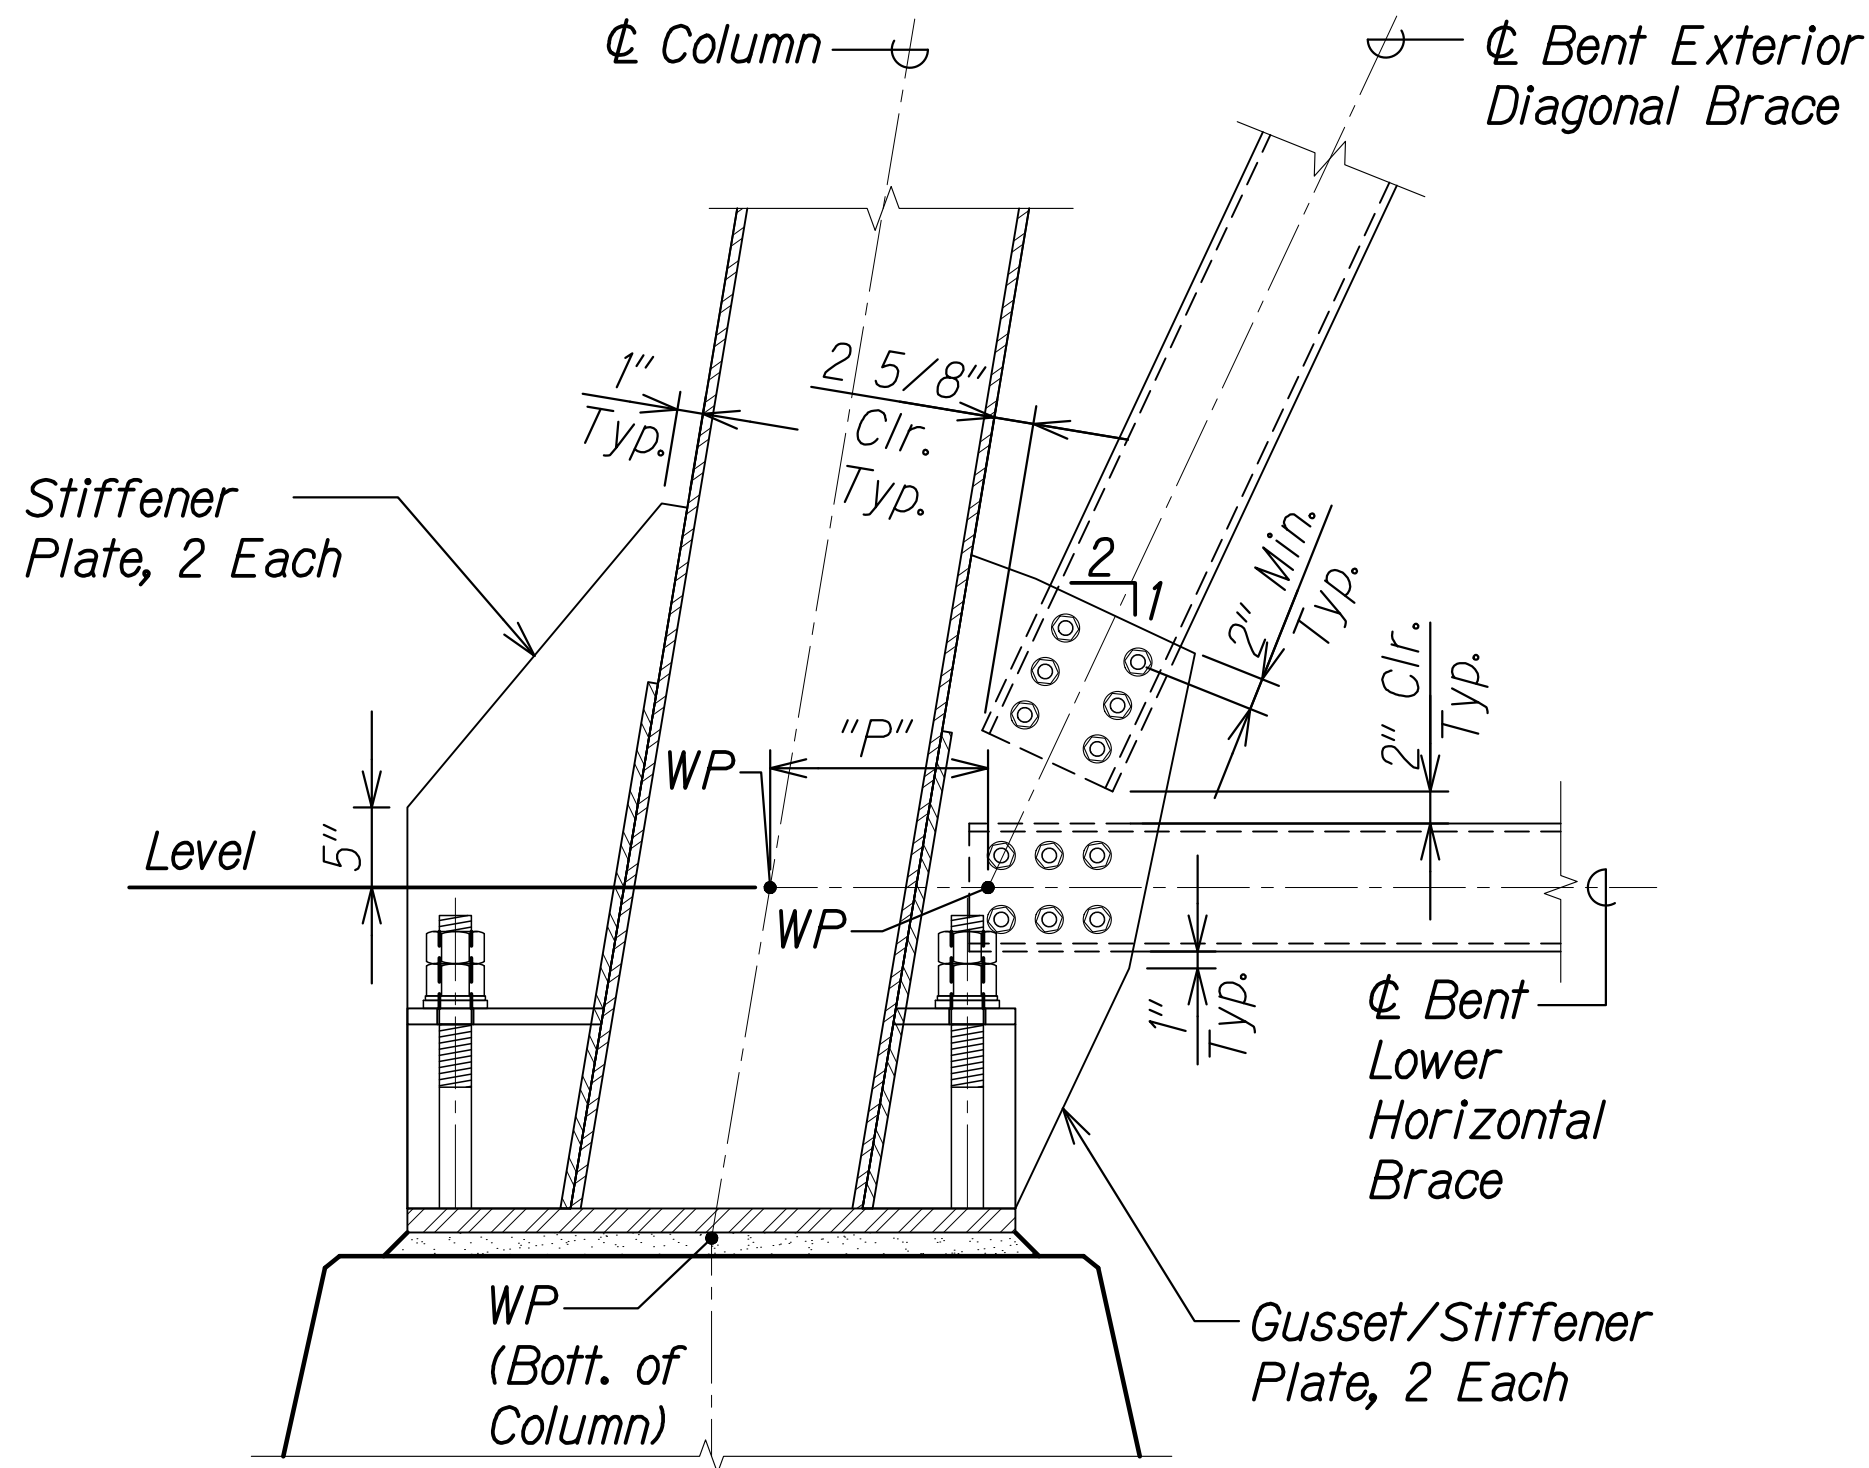

EXT. BASE COLUMN TO BRACE
CONNECTION DETAIL

Scale: 1" = 1'-0"

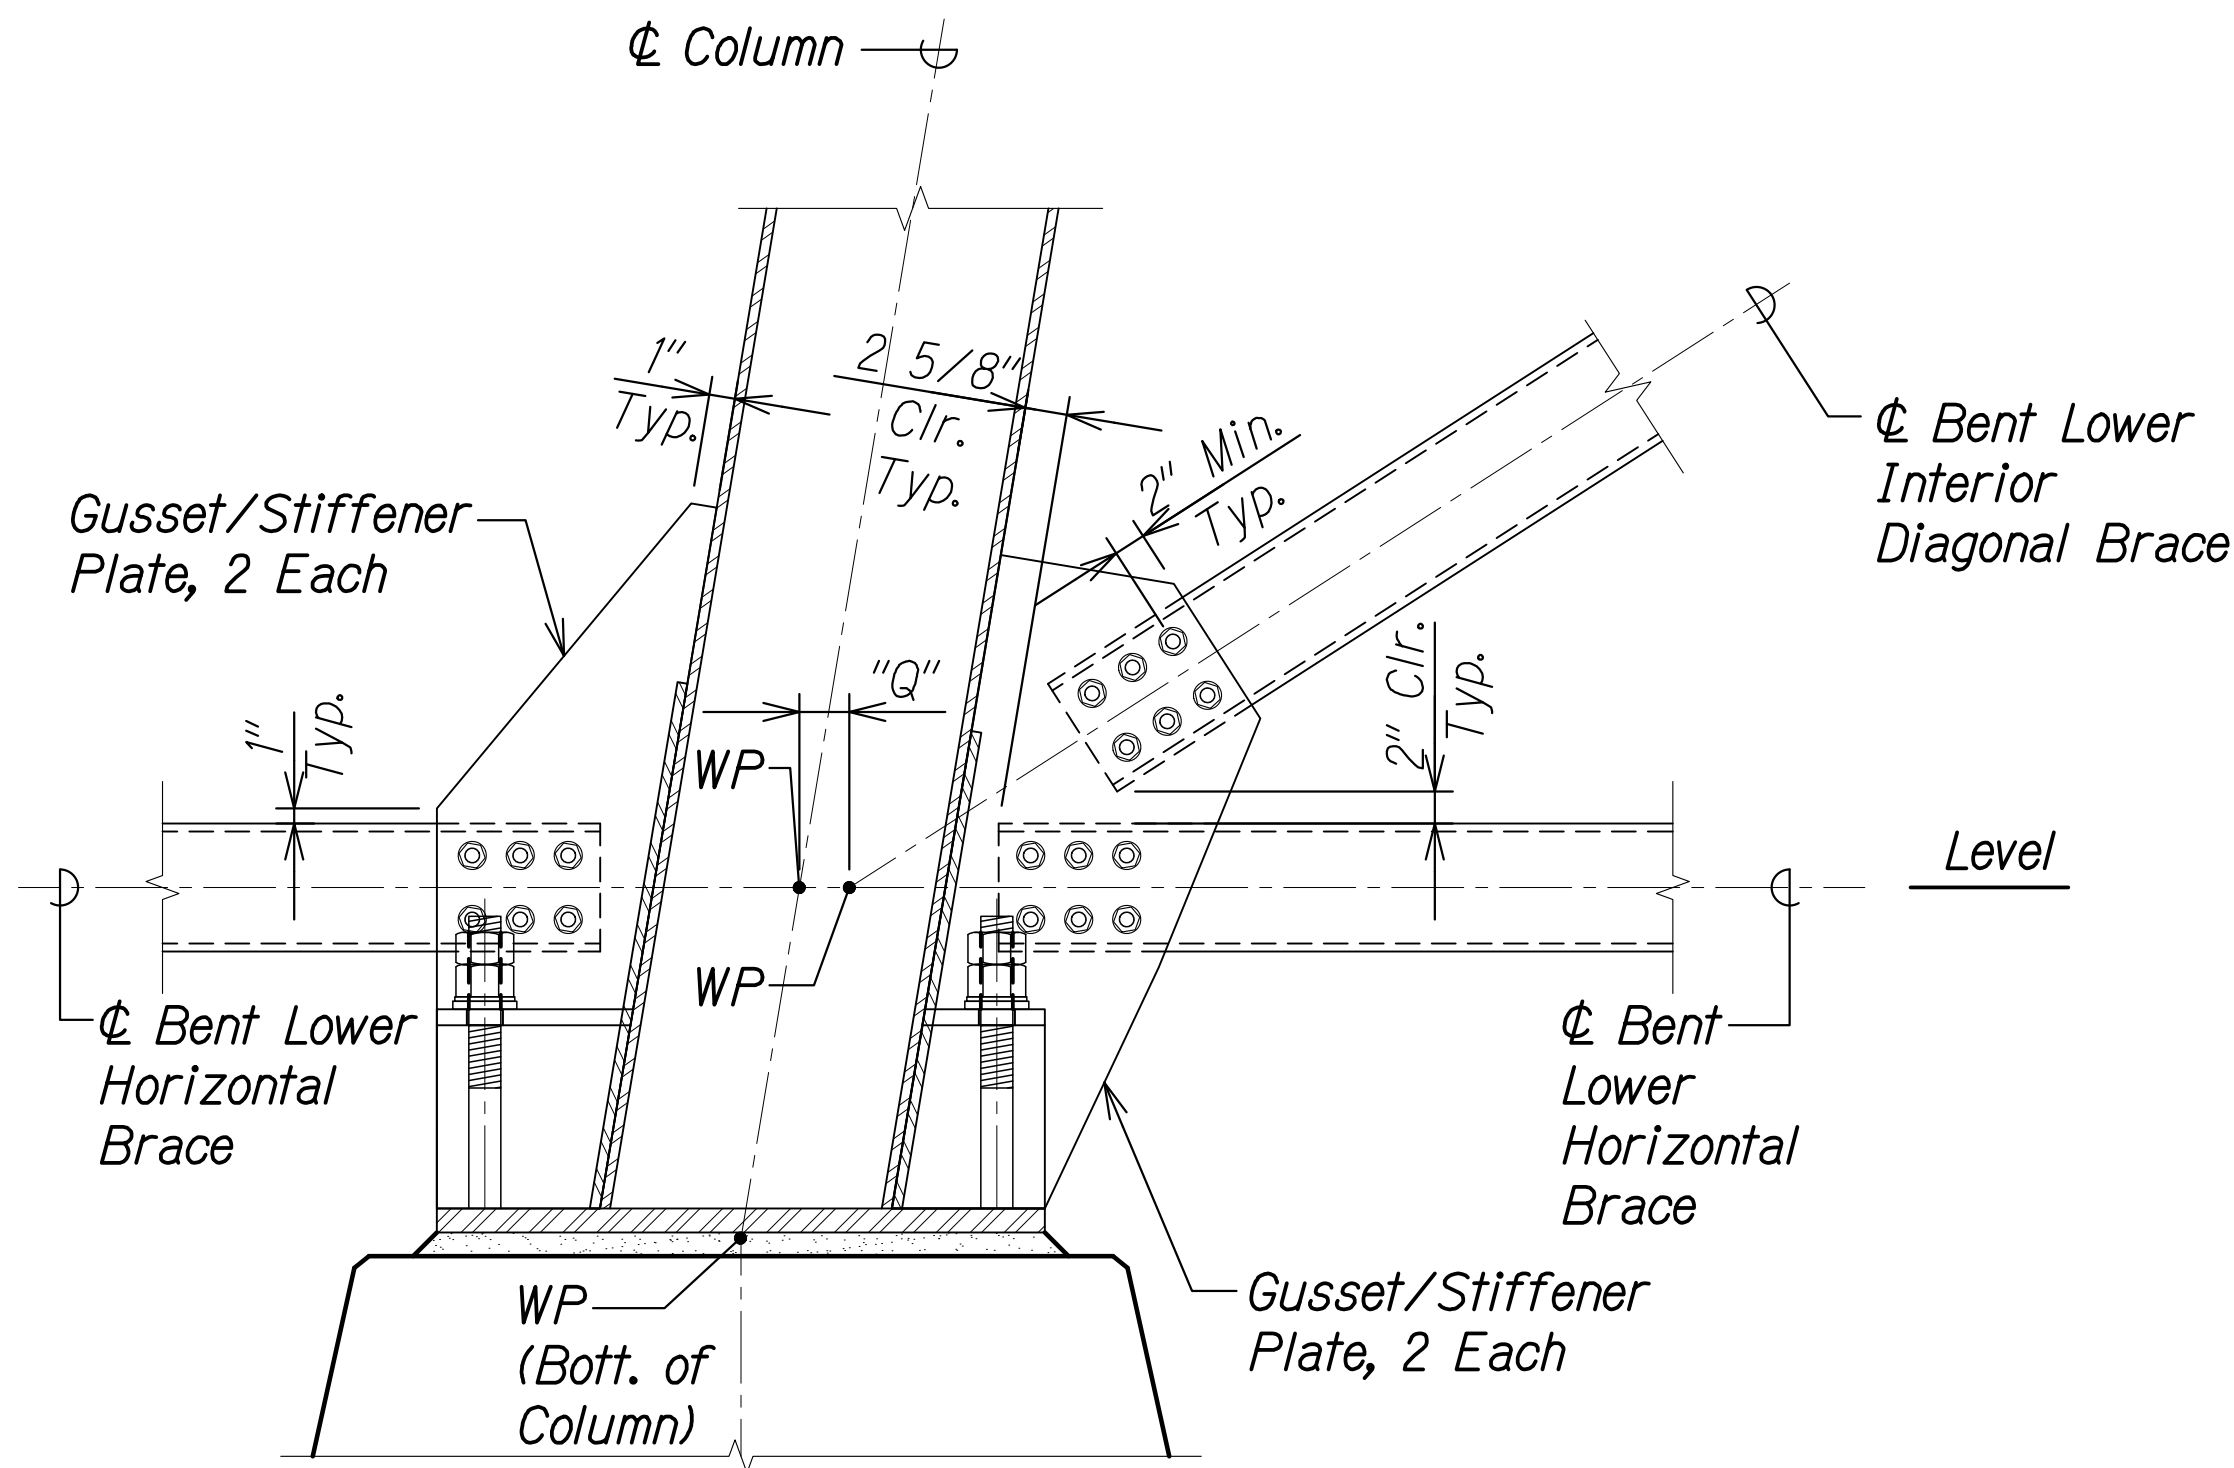

INT. BASE COLUMN TO BRACE
CONNECTION DETAIL

Scale: 1" = 1'-0"




WP OFFSET SCHEDULE						
LOCATION	"K"	"L"	"M"	"N"	"P"	"Q"
Bent No. 1	14 1/4"	12 3/4"	-	-	-	-
Bent No. 2	-	-	13 1/2"	3 3/4"	-	-
Bent No. 3	-	-	-	-	14"	0"
Bent No. 4	-	-	15 1/2"	2 1/2"	-	-
Bent No. 5	-	-	-	-	13 1/2"	3"
Bent No. 6	-	-	-	-	13 1/2"	3"
Bent No. 7	-	-	15"	4"	-	-
Bent No. 8	-	-	-	-	15 1/4"	12 1/2"
Bent No. 9	-	-	13 1/2"	11 3/4"	-	-



ORIGINAL PLAN	DATE
DRAWN BY	
DESIGNED BY	
NOTED BY	
CHECKED BY	

DRAWING NAME: Z:\00 ONGOING\23-022-9-NANUE STR BR PF2-DOT1\01 CAD\12-06-24 ADD\NSR-SAG602-SAG617 CONN DTL5 ADD2.DWG PLOT TIME: 12-05-24 1:31 PM

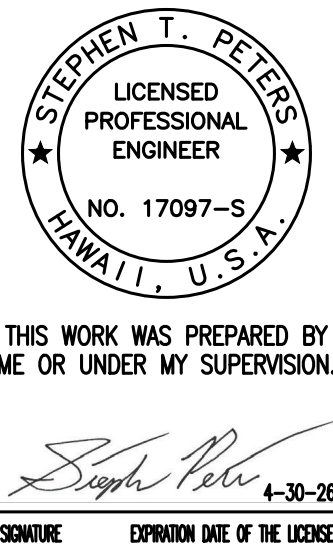


12/6/24	1	Revised Details and Added Notes & Schedule
DATE	REVISION	
STATE OF HAWAII DEPARTMENT OF TRANSPORTATION HIGHWAYS DIVISION BASE COLUMN TO BRACE CONNECTION DETAILS HAWAII BELT ROAD Nanue Stream Bridge Rehabilitation Federal Aid Project No. BR-019-2(077) Scale: As Noted Date: Oct. 2024		
SHEET No.SA6.12 OF 22 SHEETS		

FED. ROAD DIST. NO.	STATE	FEDERAL AID PROJ. NO.	FISCAL YEAR	SHEET NO.	TOTAL SHEETS
HAWAII	HAW.	BR-019-2(077)	2024	ADD. 119	280


1 NOTES:

- The Contractor's Steel Detailer is responsible for determining the actual size of each gusset/continuity/cover plate based on the information provided in the Contract Drawings.
- All bolted connections for horizontal and diagonal braces, as detailed on this sheet, shall be prefensioned.
- After erection, touch-up paint ends of all bolts/nuts/washers.
- Batten plates and lacing on bracing not shown for clarity.

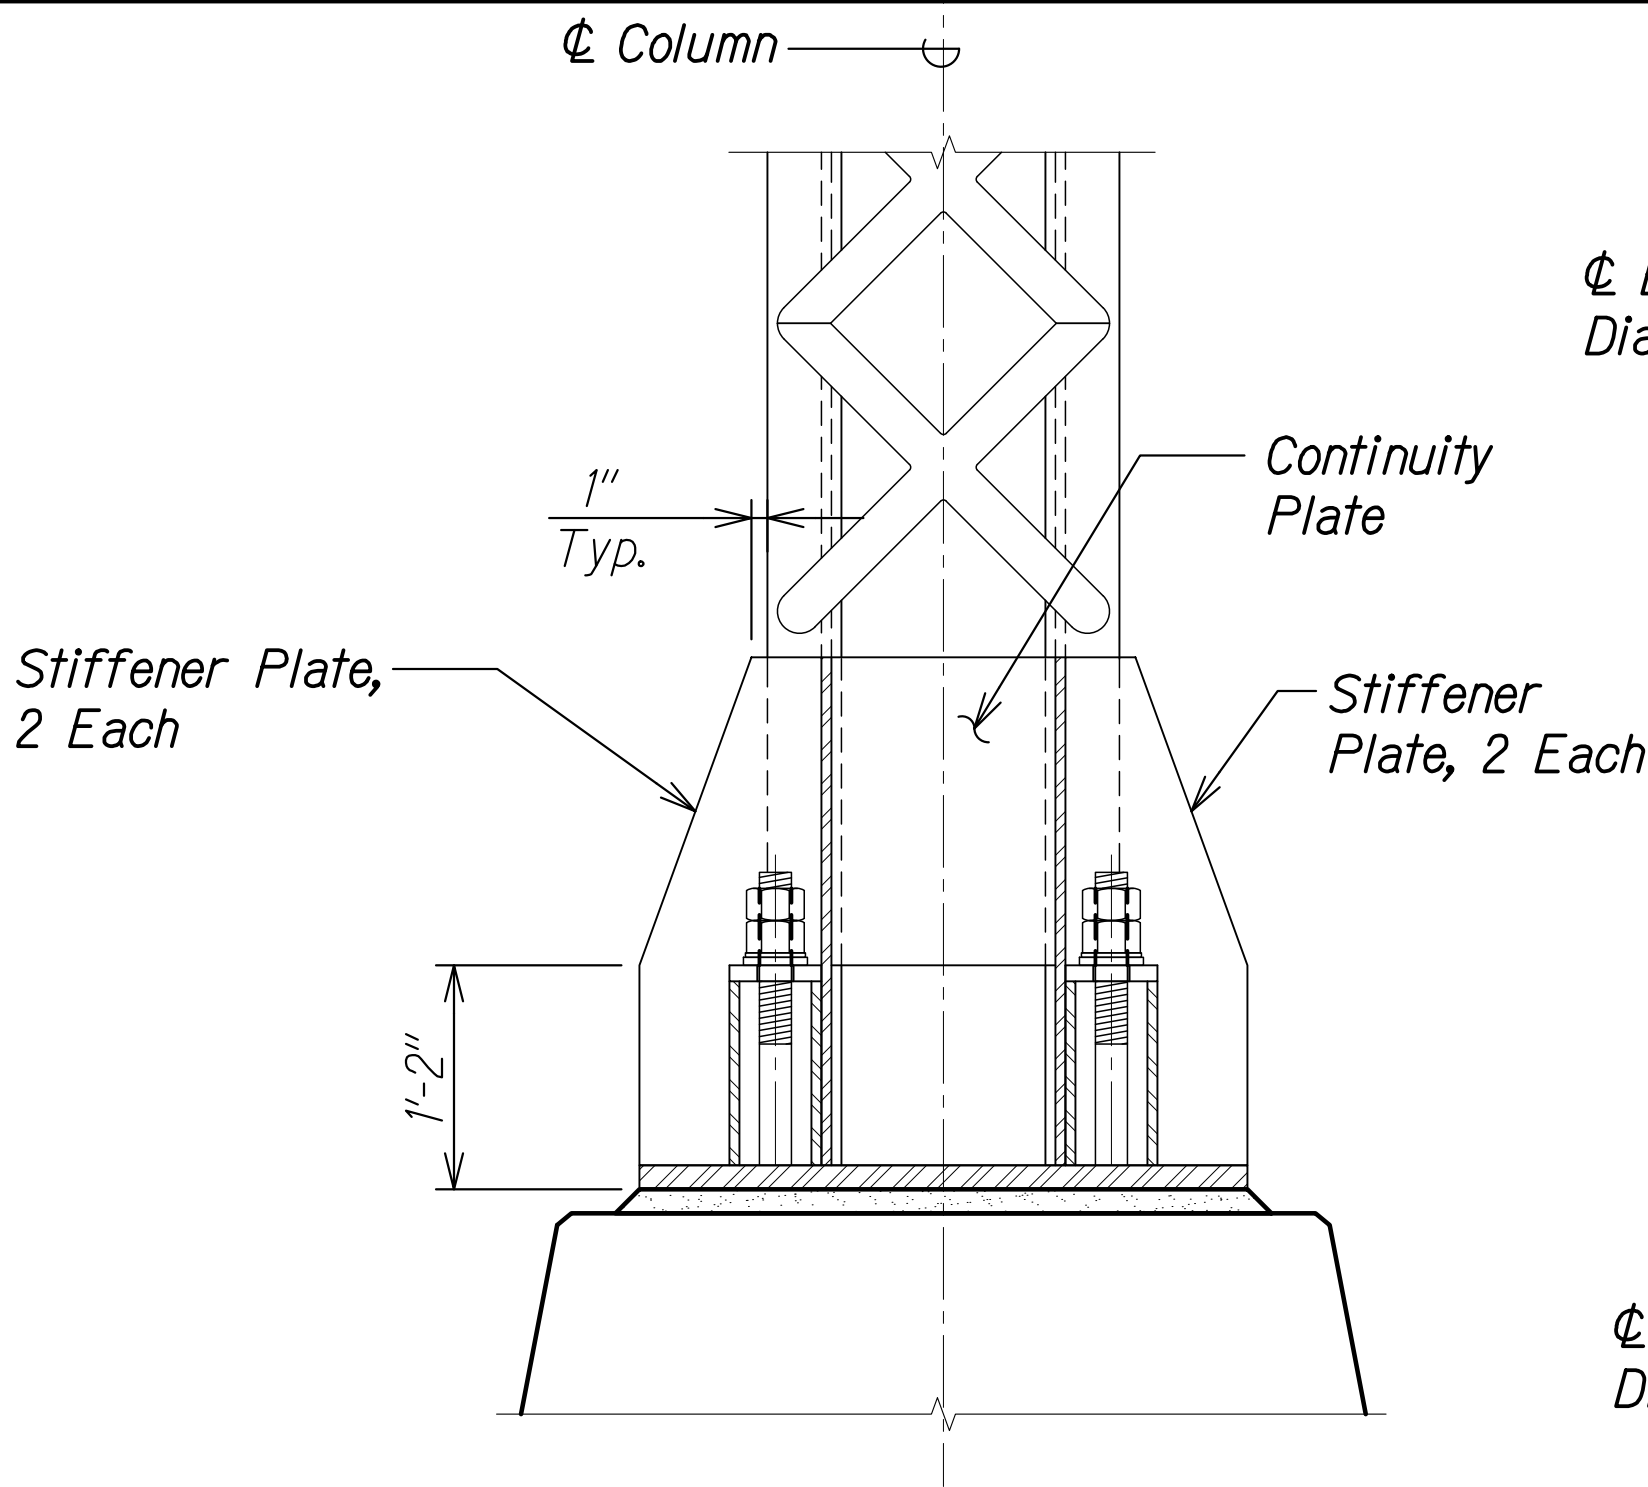


BASE COLUMN TO BRACE
CONNECTION DETAIL

Scale: 1" = 1'-0"

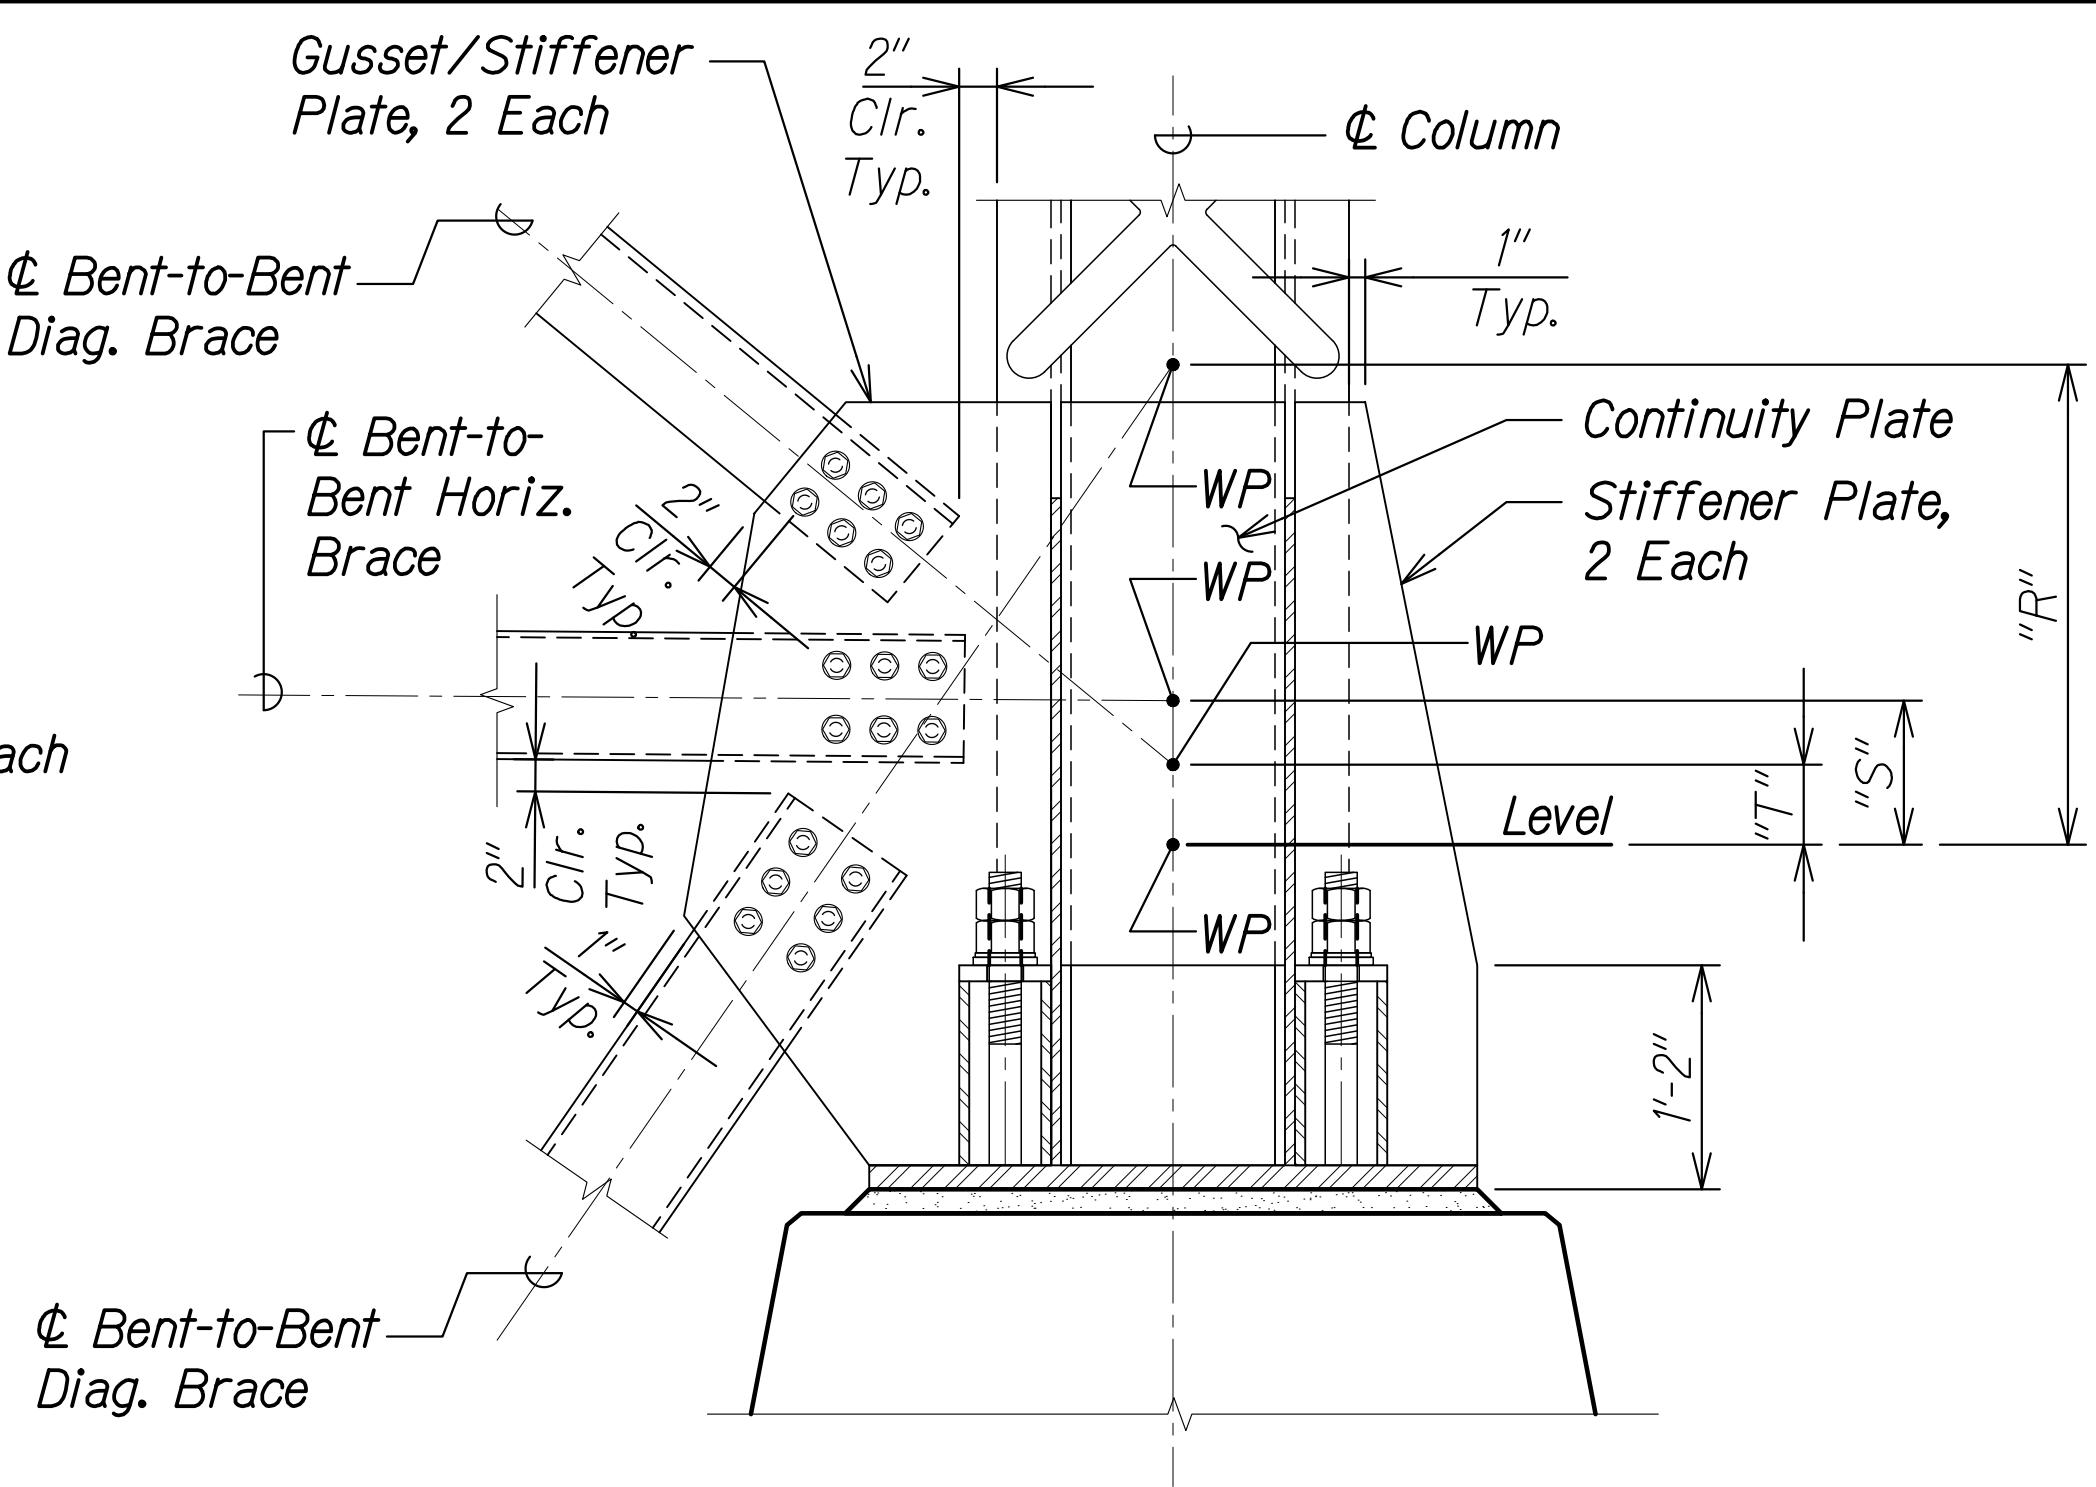

BASE COLUMN TO BRACE
CONNECTION DETAIL

Scale: 1" = 1'-0"

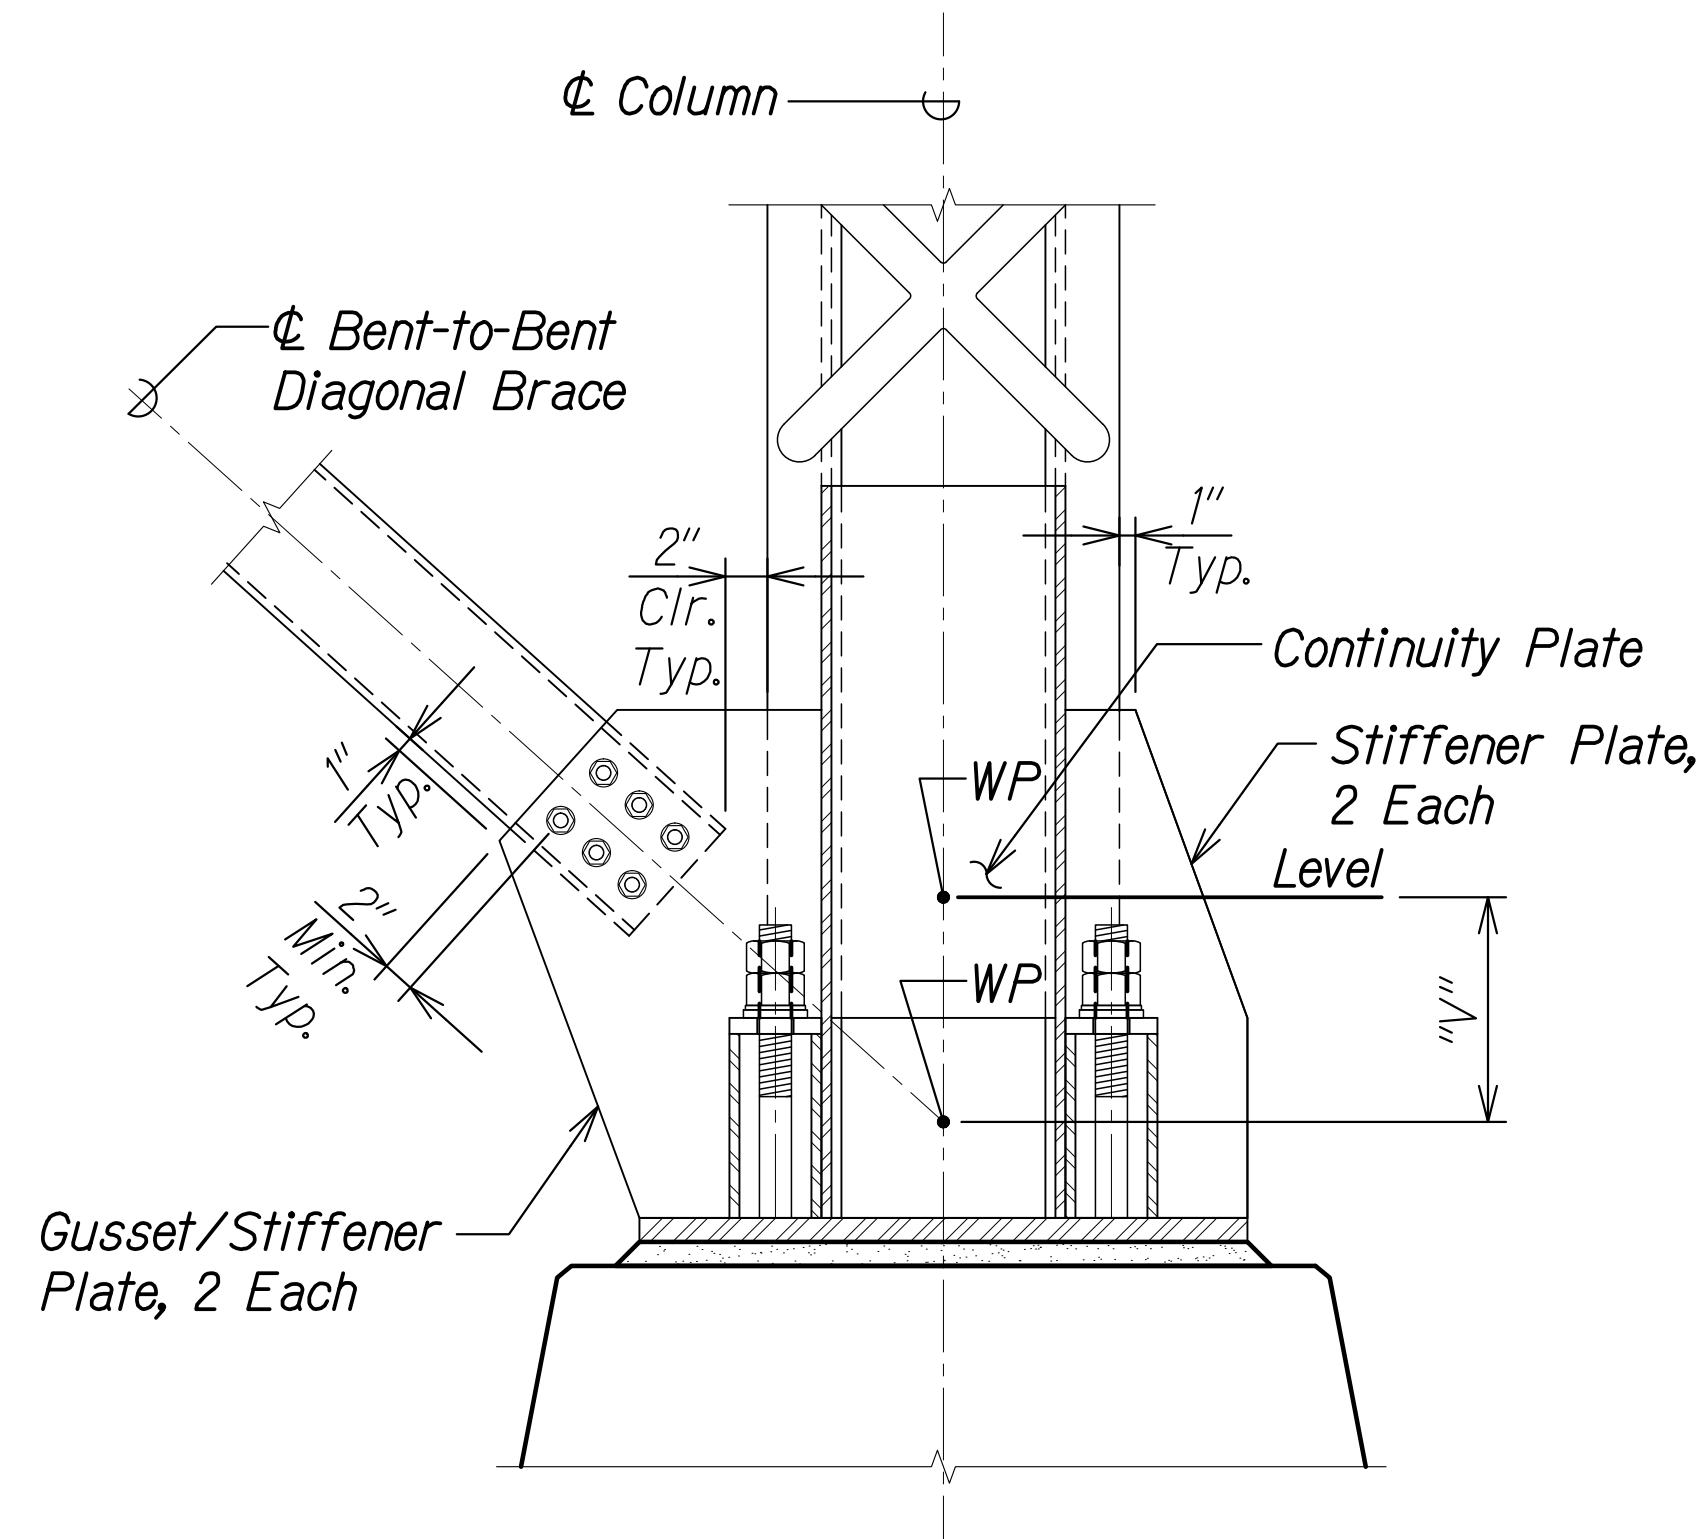


BASE COLUMN TO BRACE
CONNECTION DETAIL

Scale: 1" = 1'-0"




WP OFFSET SCHEDULE				
LOCATION	"R"	"S"	"T"	"V"
Bent No. 2	10"	12"	10"	-
Bent No. 3	-	-	-	14"
Bent No. 4	0"	2"	2"	-
Bent No. 5	-	-	-	5"
Bent No. 6	-	-	-	20"
Bent No. 7	30"	9"	5"	-
Bent No. 8	-	-	-	15"
Bent No. 9	7"	3"	0"	-

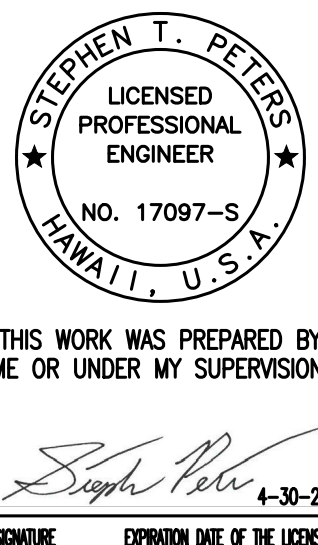


12/6/24	1	Revised Details and Added Notes & Schedule
DATE	REVISION	
STATE OF HAWAII DEPARTMENT OF TRANSPORTATION HIGHWAYS DIVISION BASE COLUMN TO BRACE CONNECTION DETAILS HAWAII BELT ROAD Nanue Stream Bridge Rehabilitation Federal Aid Project No. BR-019-2(077) Scale: As Noted Date: Oct. 2024		


FED. ROAD DIST. NO.	STATE	FEDERAL AID PROJ. NO.	FISCAL YEAR	SHEET NO.	TOTAL SHEETS
HAWAII	HAW.	BR-019-2(077)	2024	ADD. 121	280

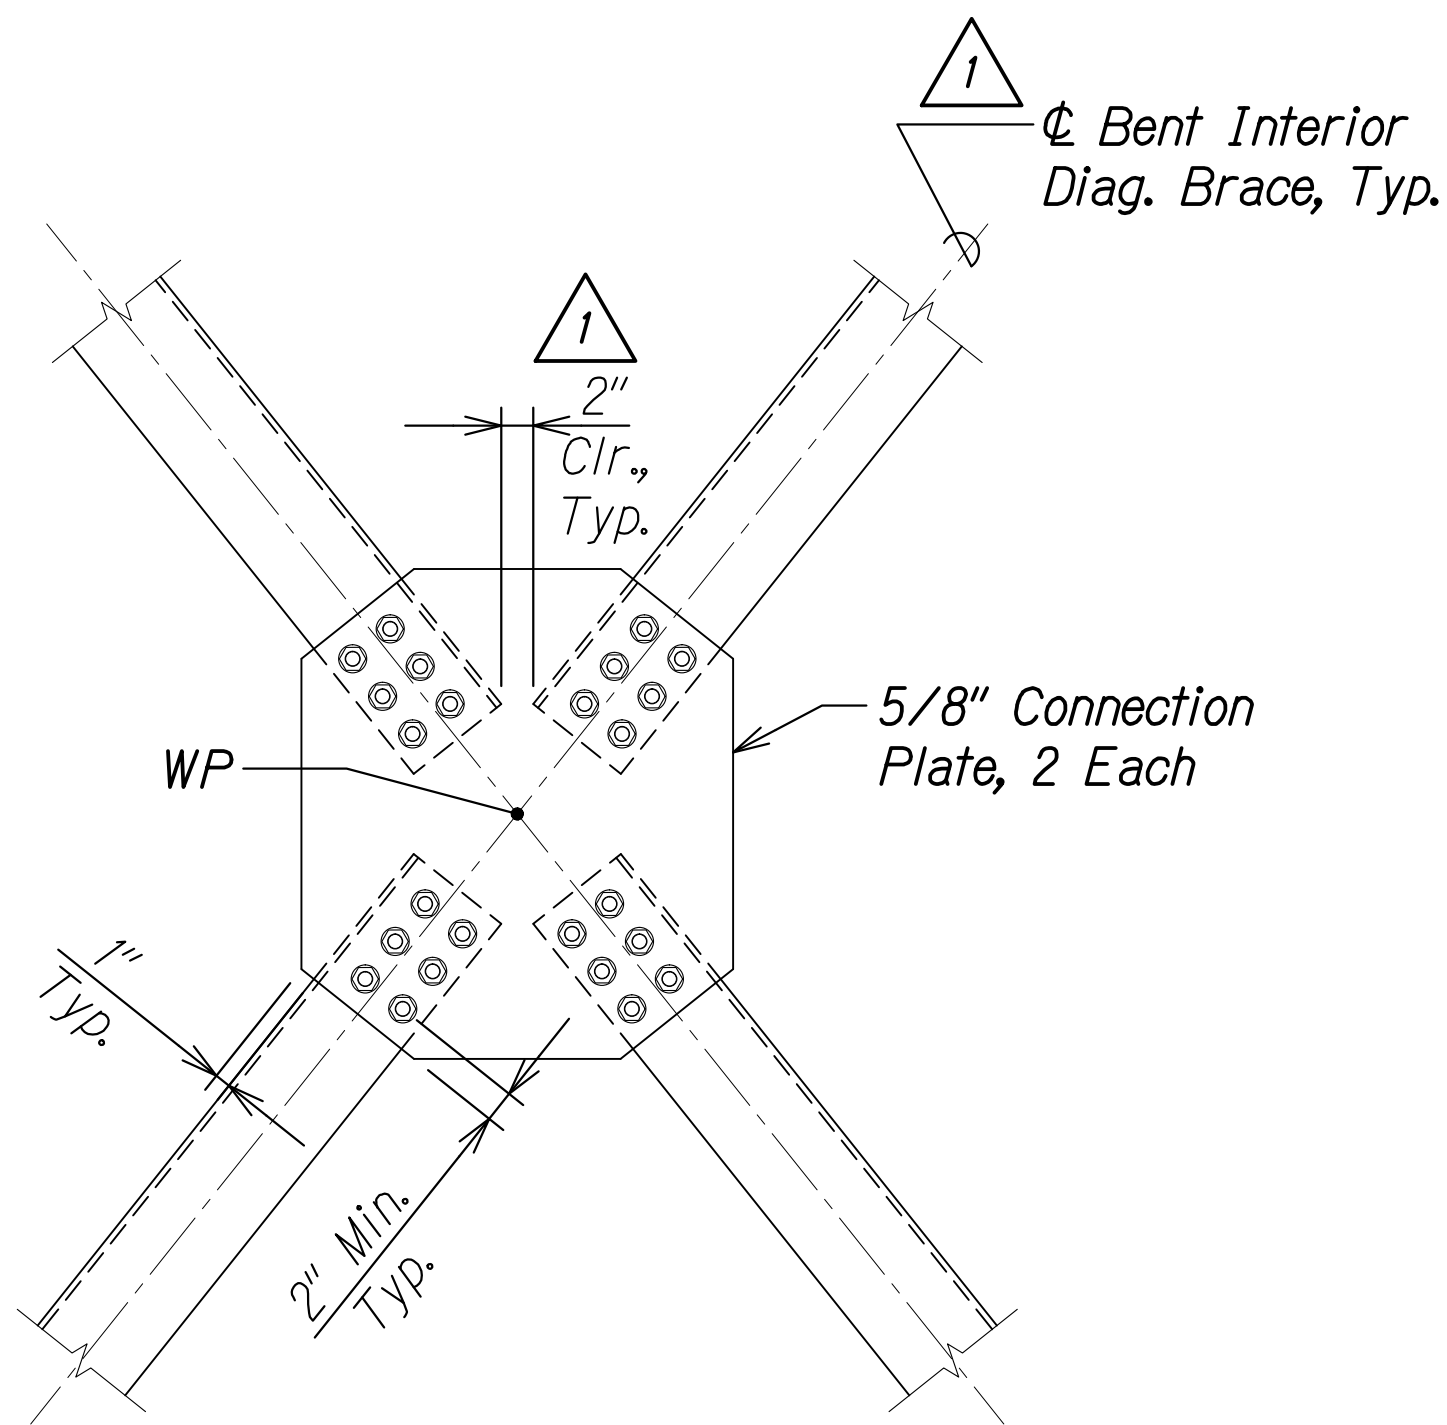

**BRACE TO BRACE
CONNECTION DETAIL** 1
Scale: 1" = 1'-0" SA6.15 SA6.15

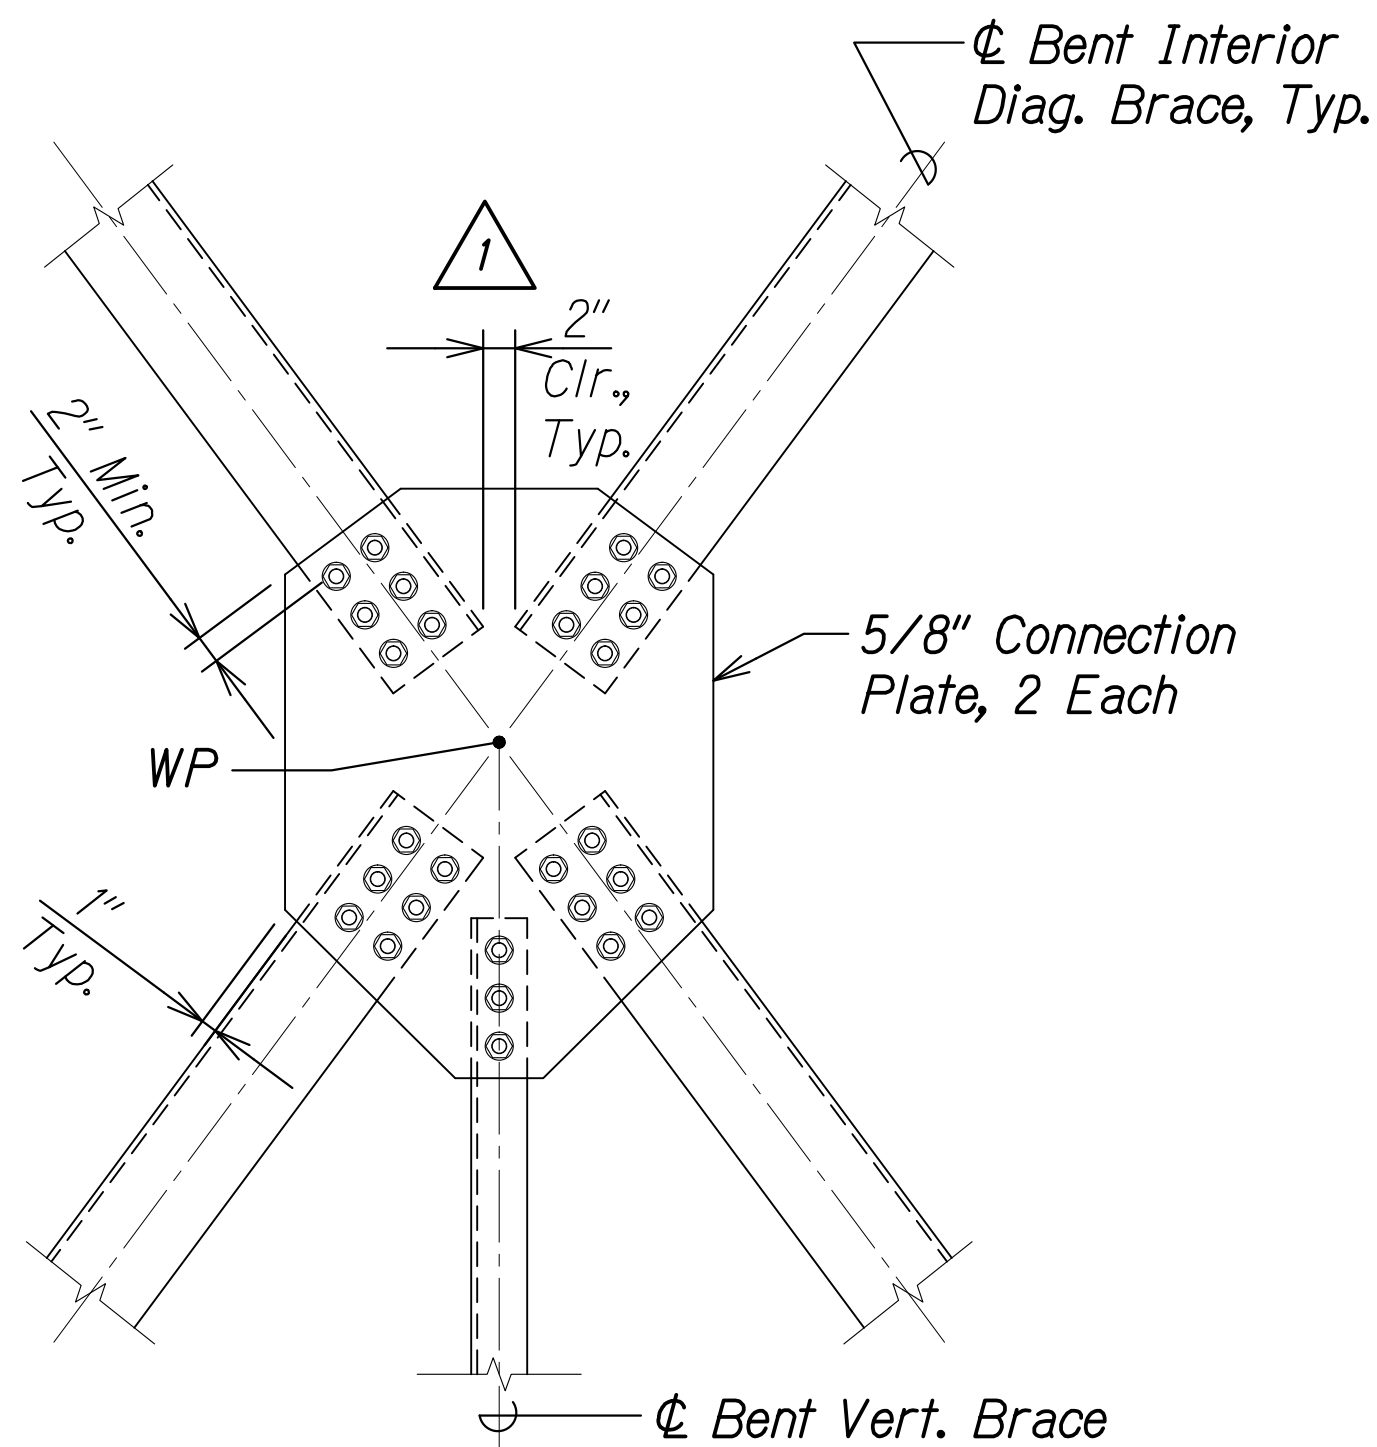


**BRACE TO BRACE
CONNECTION DETAIL** 2
Scale: 1" = 1'-0" SA6.15 SA6.15

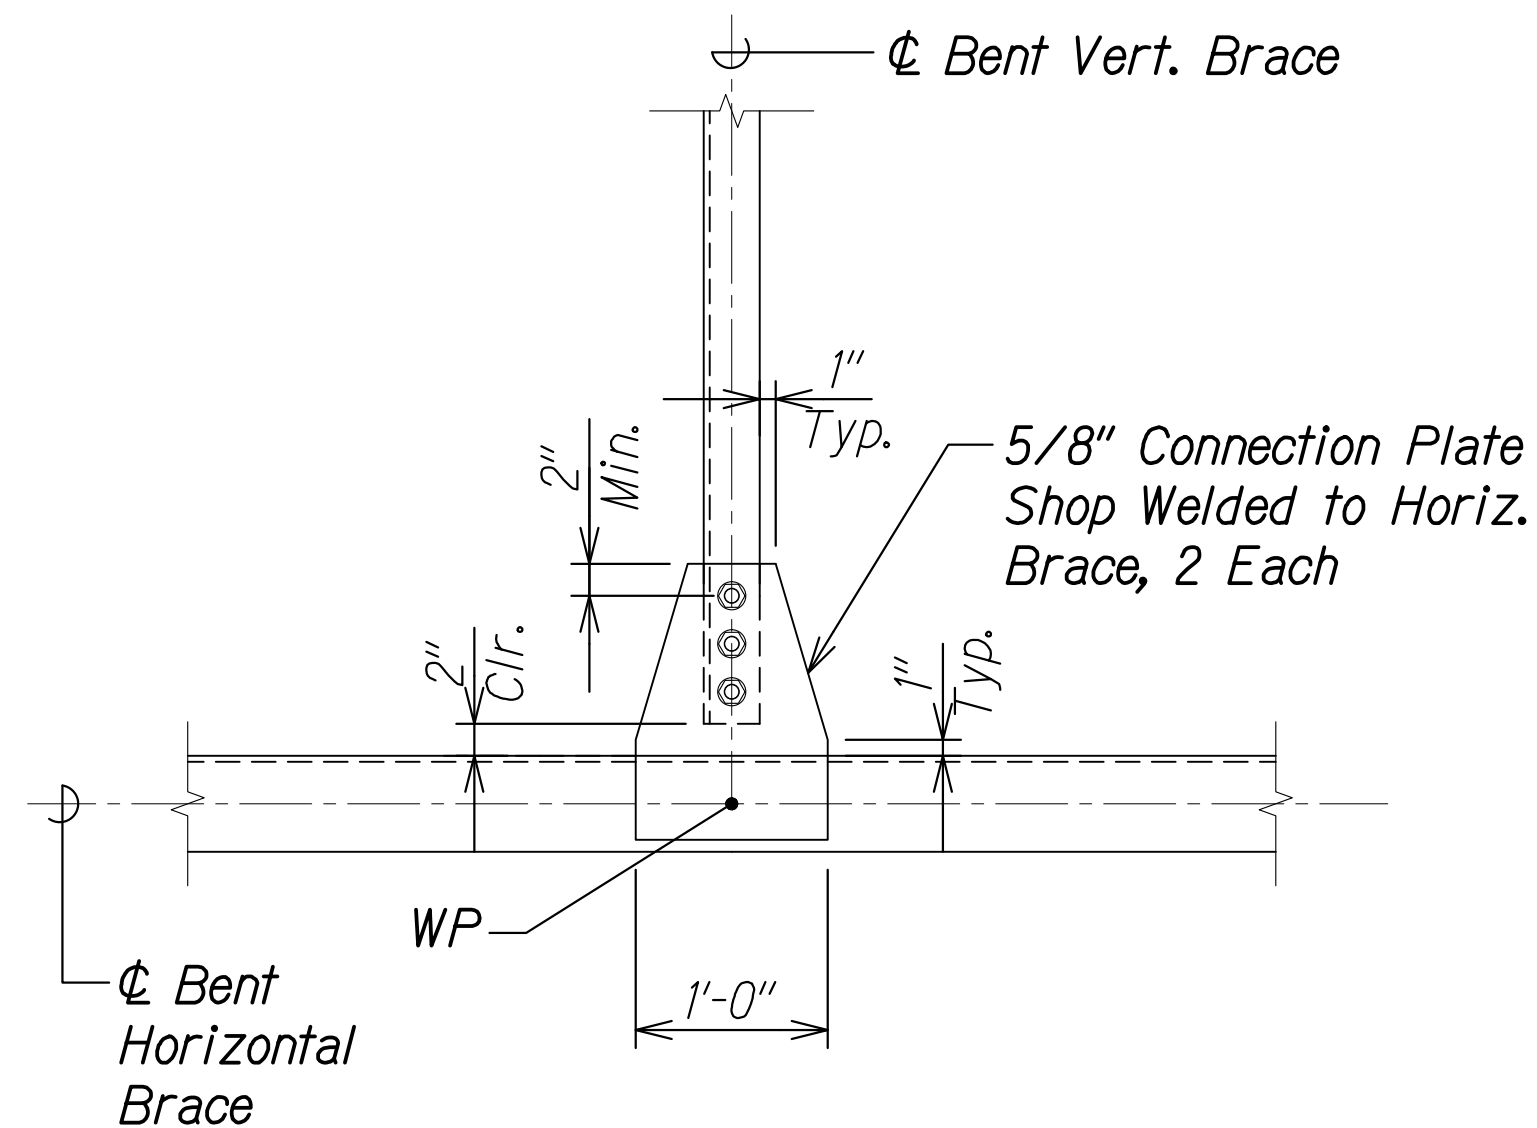


**BRACE TO BRACE
CONNECTION DETAIL** 3
Scale: 1" = 1'-0" SA6.15 SA6.15 1


- 1 **NOTES:**
- The Contractor's Steel Detailer is responsible for determining the actual size of each connection plate based on the information provided in the Contract Drawings.
 - All bolted connections for horizontal and diagonal braces, as detailed on this sheet, shall be pretensioned.
 - After erection, touch-up paint the ends of all bolts/nuts/washers.
 - Batten plates and lacing on braces not shown for clarity.

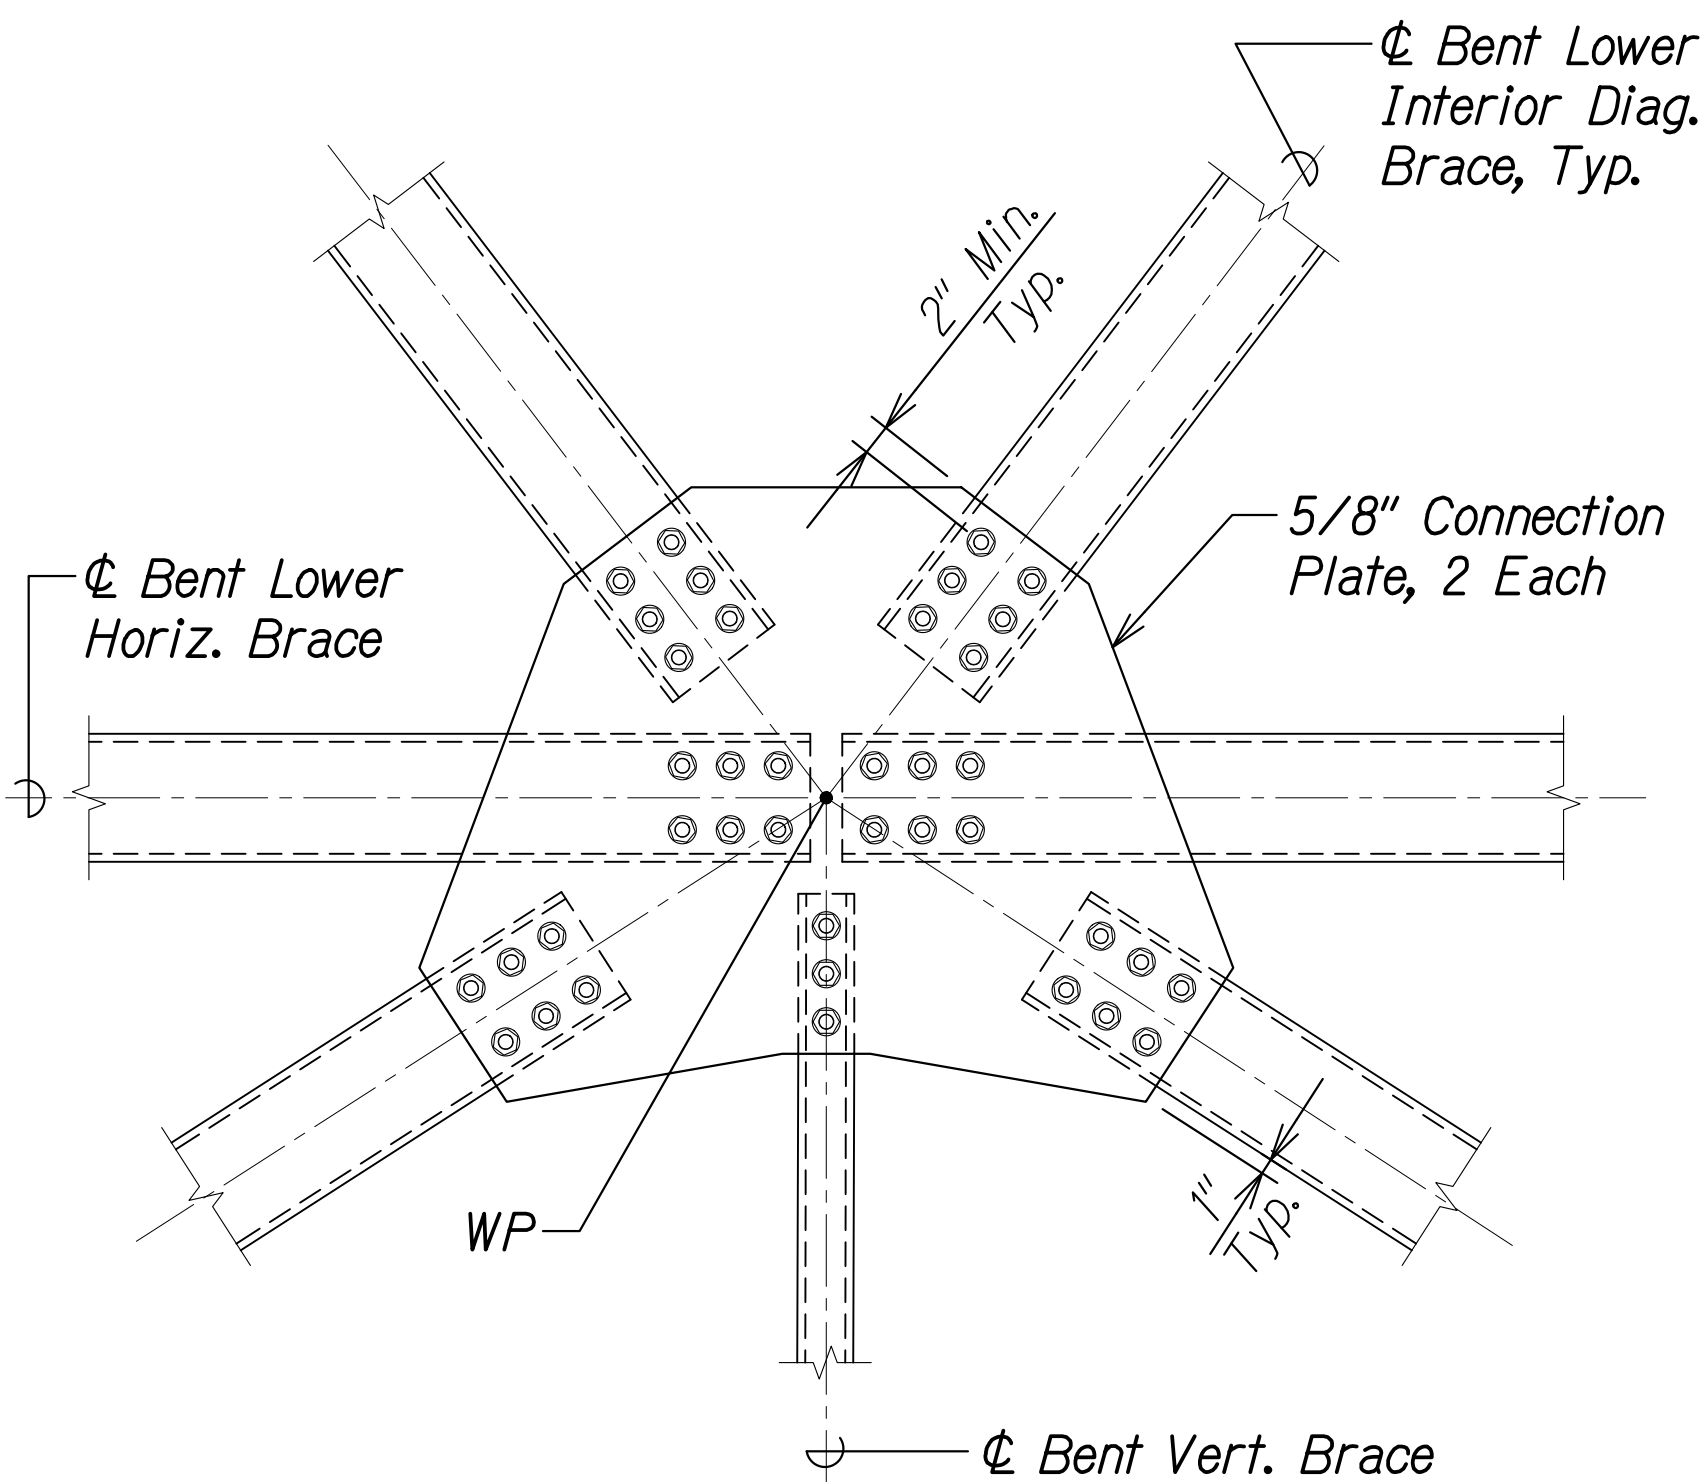

**BRACE TO BRACE
CONNECTION DETAIL** 4 1
Scale: 1" = 1'-0" SA6.15 SA6.15

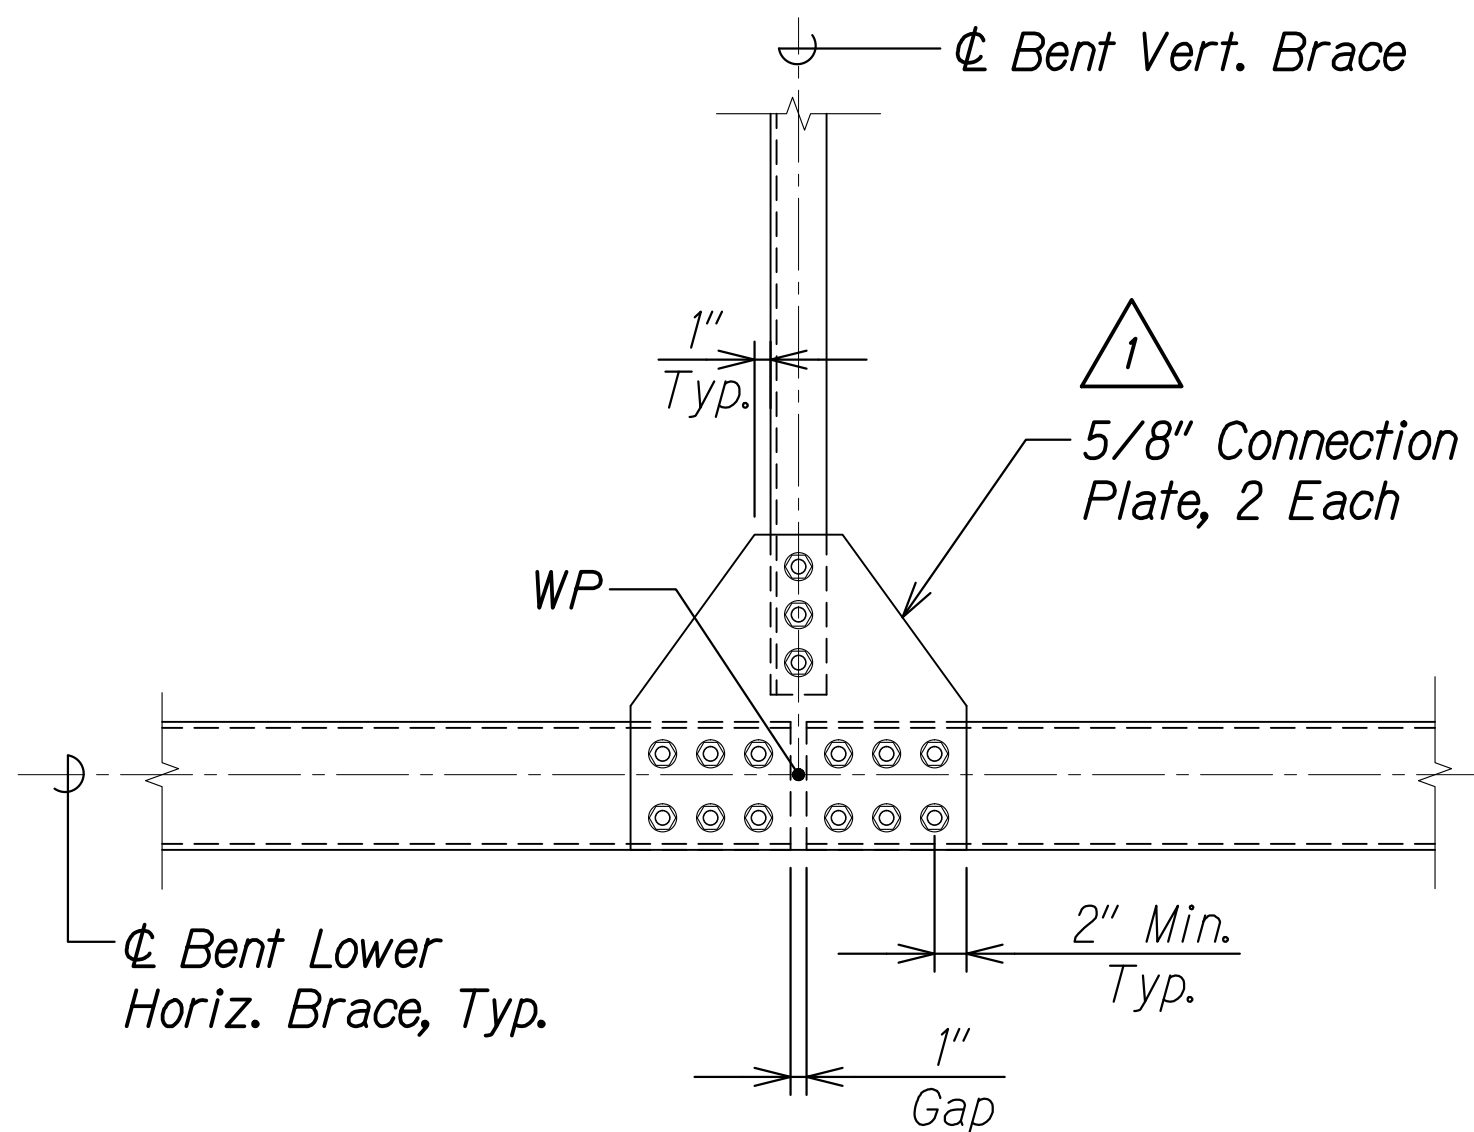


**BRACE TO BRACE
CONNECTION DETAIL** 5
Scale: 1" = 1'-0" SA6.15 SA6.15

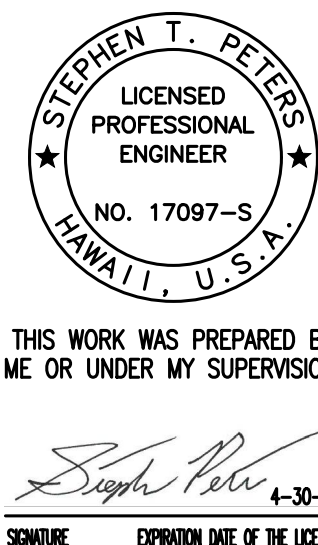


12/6/24	1 Revised Details & Added Notes
DATE	REVISION
STATE OF HAWAII DEPARTMENT OF TRANSPORTATION HIGHWAYS DIVISION BRACE TO BRACE CONNECTION DETAILS HAWAII BELT ROAD Nanue Stream Bridge Rehabilitation Federal Aid Project No. BR-019-2(077) Scale: As Noted Date: Oct. 2024	
SHEET No.SA6.15 OF 22 SHEETS	

FED. ROAD DIST. NO.	STATE	FEDERAL AID PROJ. NO.	FISCAL YEAR	SHEET NO.	TOTAL SHEETS
HAWAII	HAW.	BR-019-2(077)	2024	ADD. 122	280

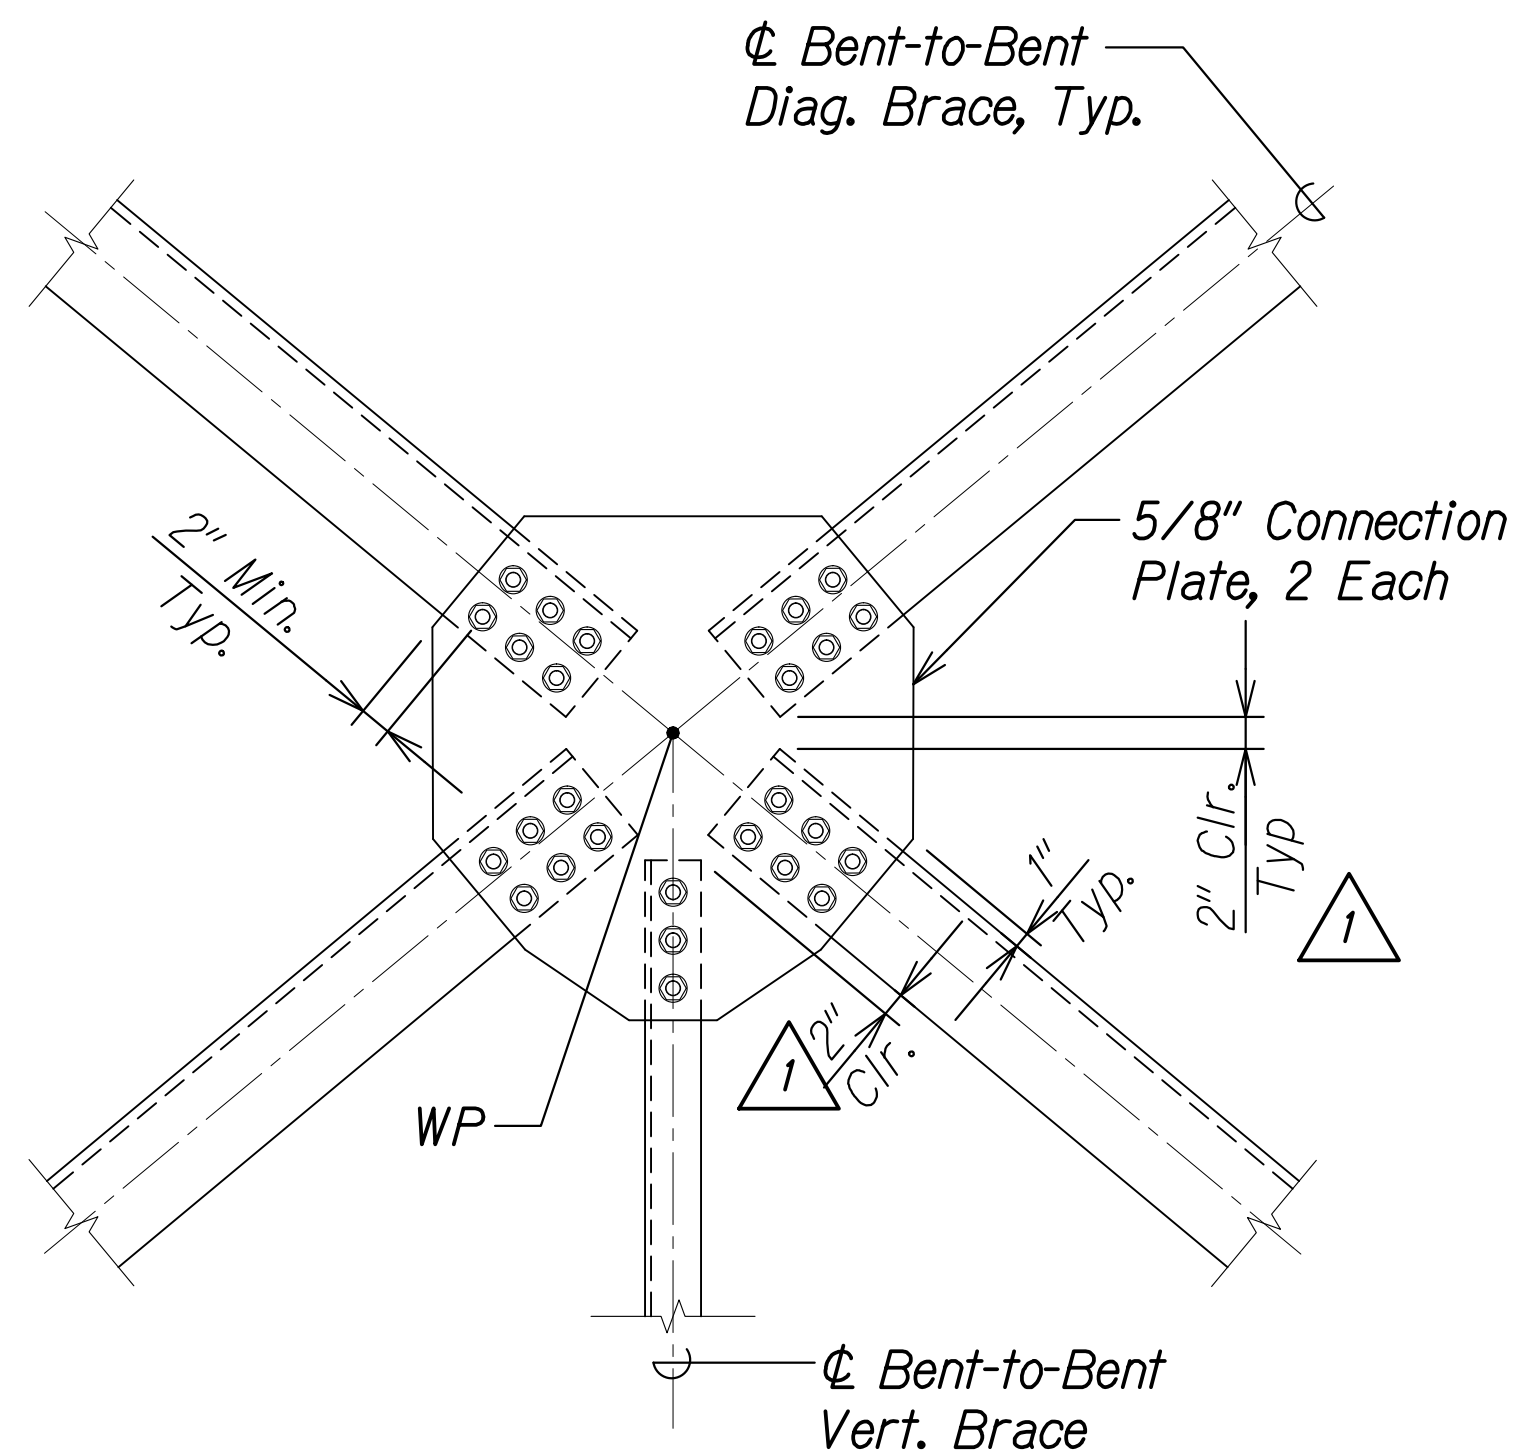


BRACE TO BRACE
CONNECTION DETAIL 1
Scale: 1" = 1'-0"
SA6.16 SA6.16

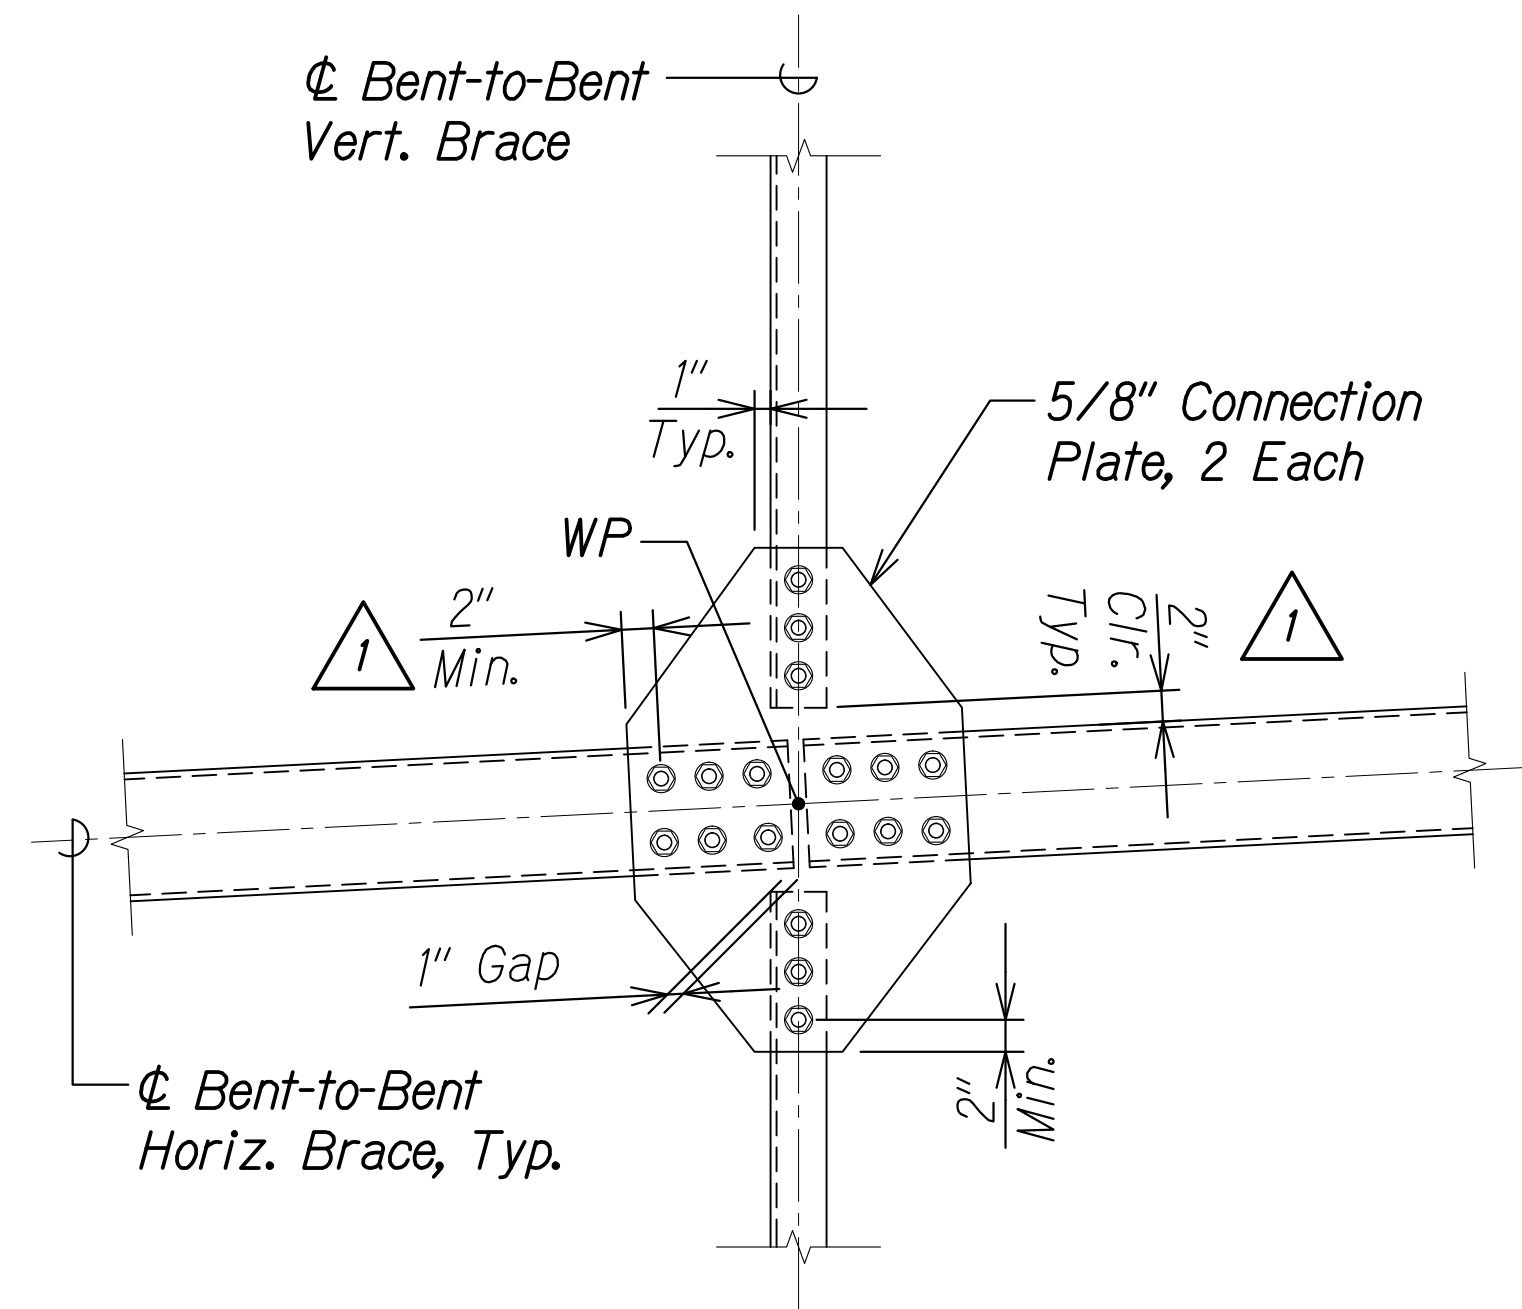


BRACE TO BRACE
CONNECTION DETAIL 2
Scale: 1" = 1'-0"
SA6.16 SA6.16


1. The Contractor's Steel Detailer is responsible for determining the actual size of each connection plate based on the information provided in the Contract Drawings.
2. All bolted connections for horizontal and diagonal braces, as detailed on this sheet, shall be pretensioned.
3. After erection, touch-up paint the ends of all bolts/nuts/washers.
4. Batten plates and lacing on braces not shown for clarity.

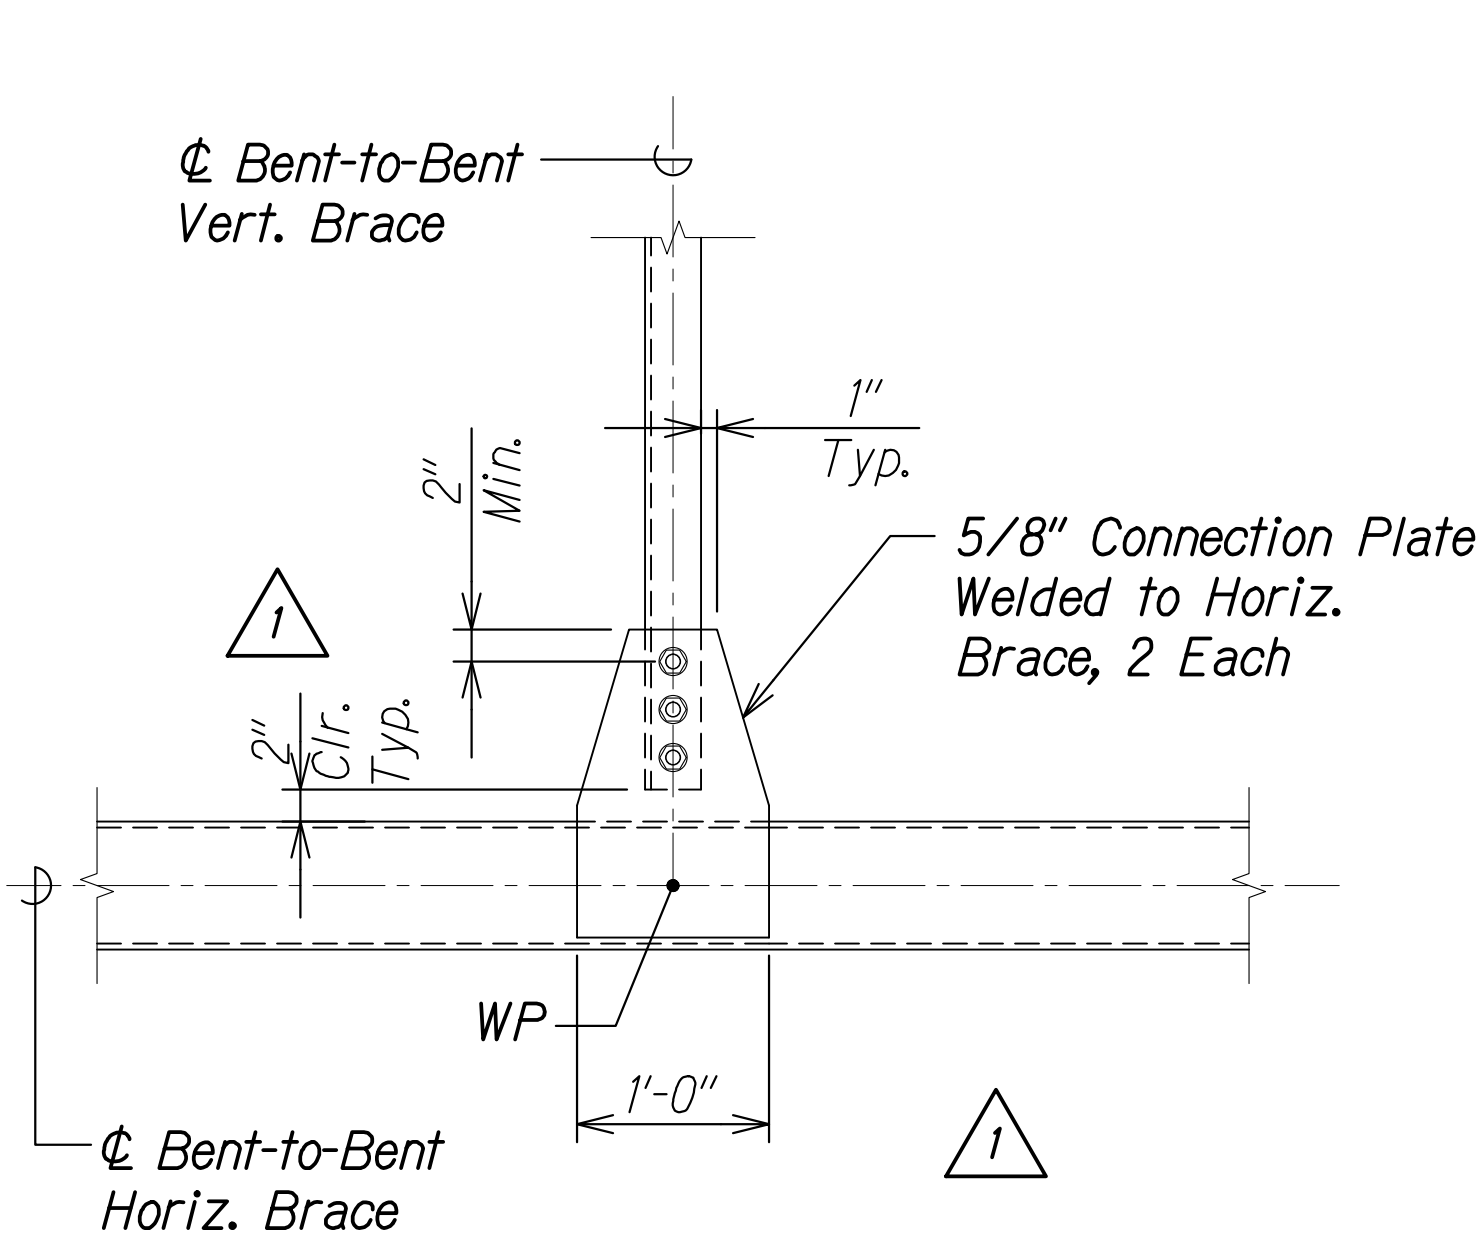


BRACE TO BRACE
CONNECTION DETAIL 3
Scale: 1" = 1'-0"
SA6.16 SA6.16

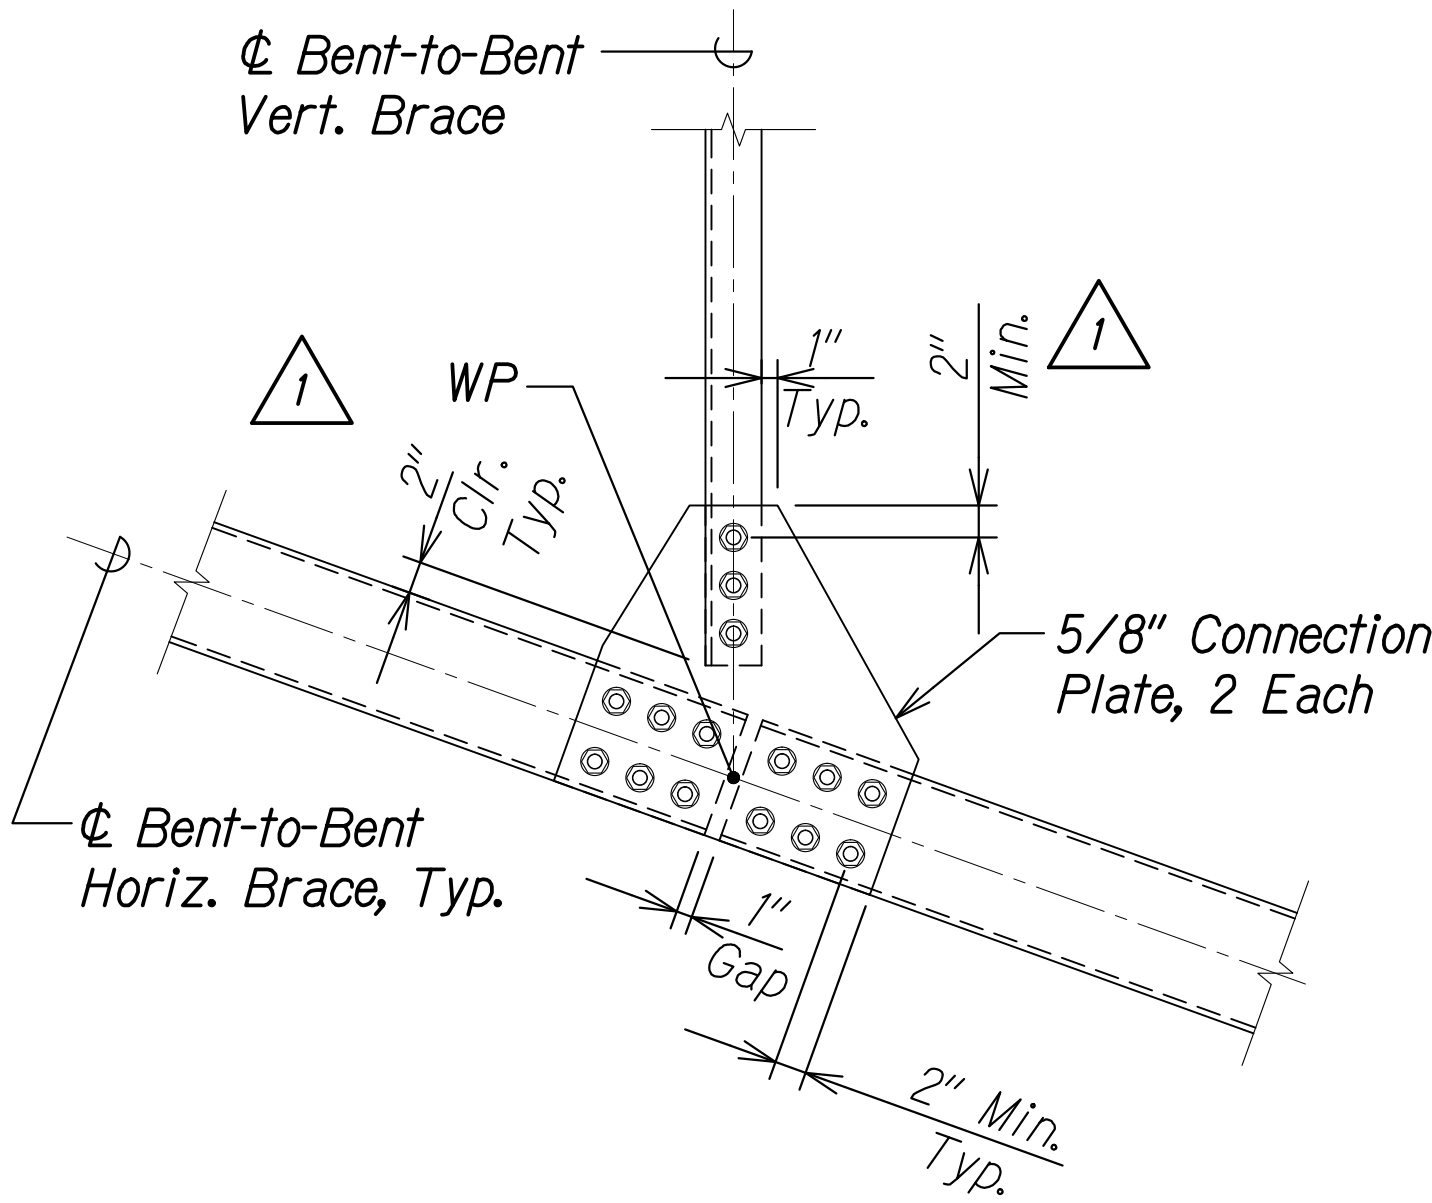

BRACE TO BRACE
CONNECTION DETAIL 4
Scale: 1" = 1'-0"
SA6.16 SA6.16

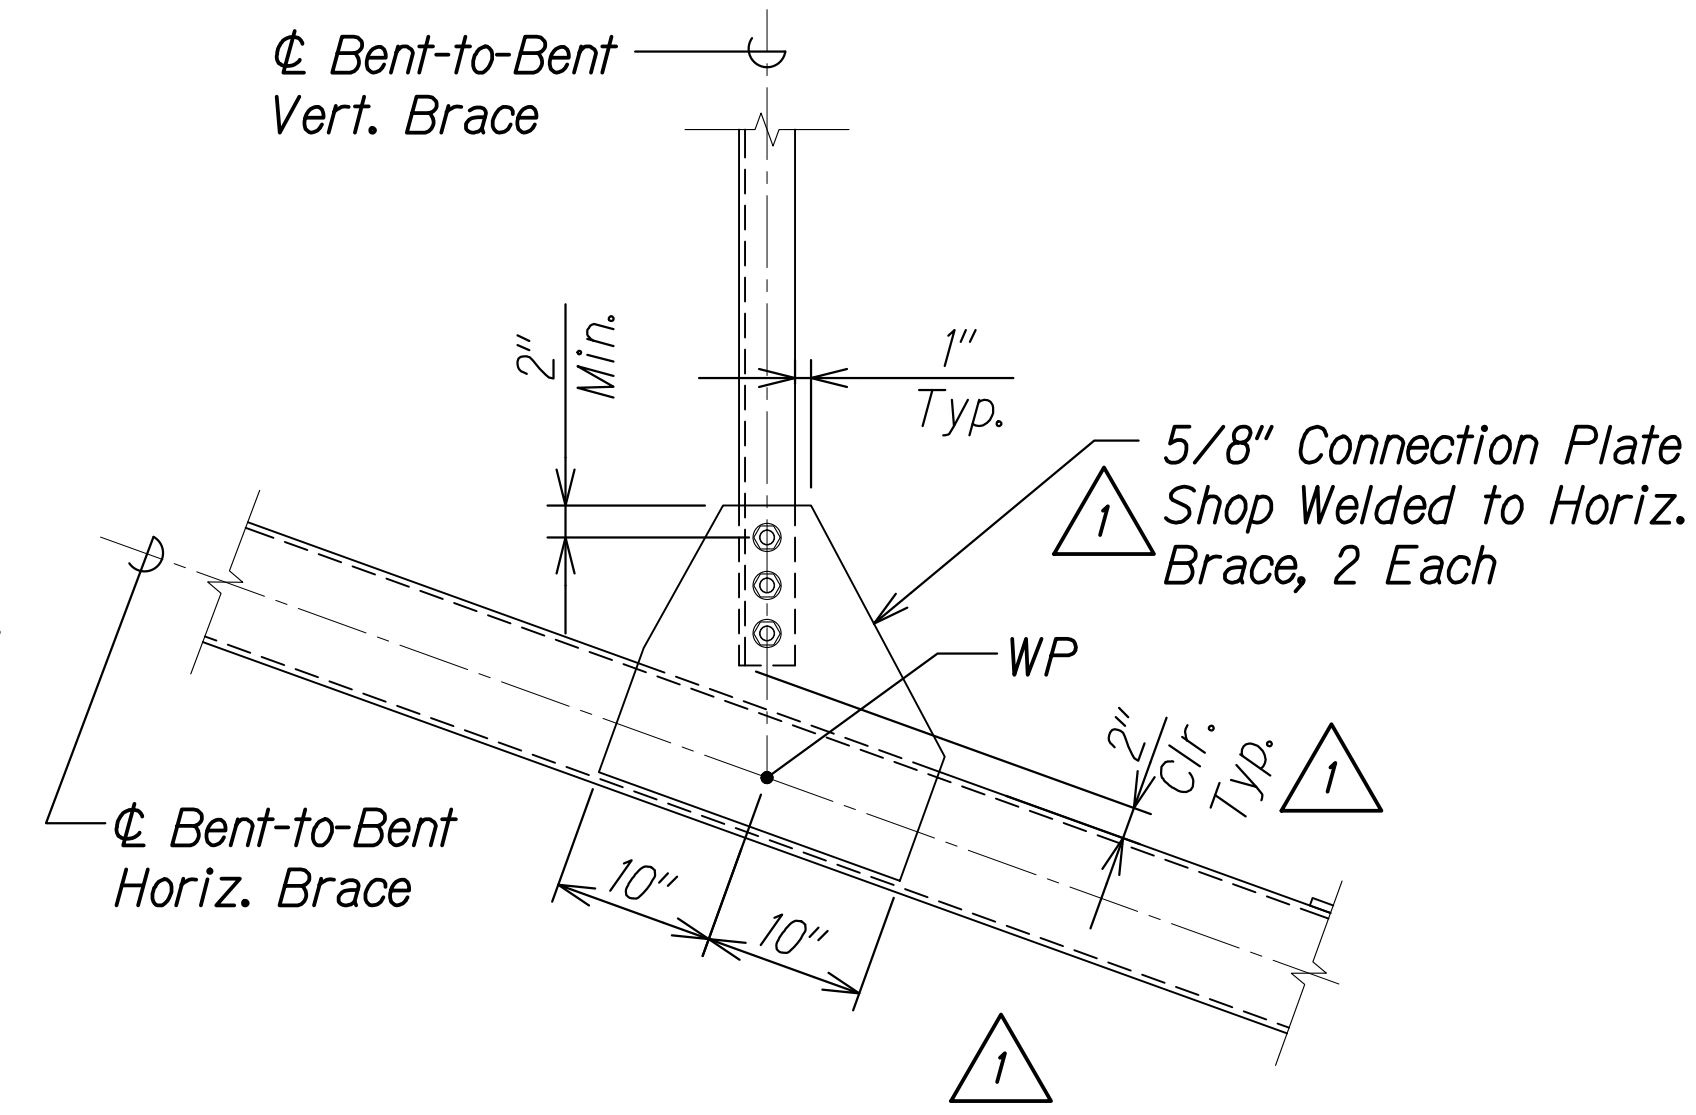


BRACE TO BRACE
CONNECTION DETAIL 5
Scale: 1" = 1'-0"
SA6.16 SA6.16

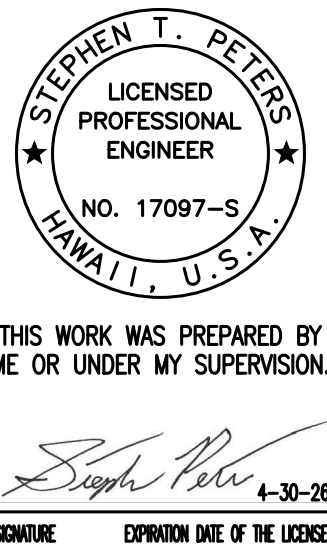


12/6/24	1	Revised Details & Added Notes
DATE	REVISION	
STATE OF HAWAII DEPARTMENT OF TRANSPORTATION HIGHWAYS DIVISION BRACE TO BRACE CONNECTION DETAILS HAWAII BELT ROAD Nanue Stream Bridge Rehabilitation Federal Aid Project No. BR-019-2(077) Scale: As Noted Date: Oct. 2024		
SHEET No. SA6.16 OF 22 SHEETS		

FED. ROAD DIST. NO.	STATE	FEDERAL AID PROJ. NO.	FISCAL YEAR	SHEET NO.	TOTAL SHEETS
HAWAII	HAW.	BR-019-2(077)	2024	ADD. 123	280

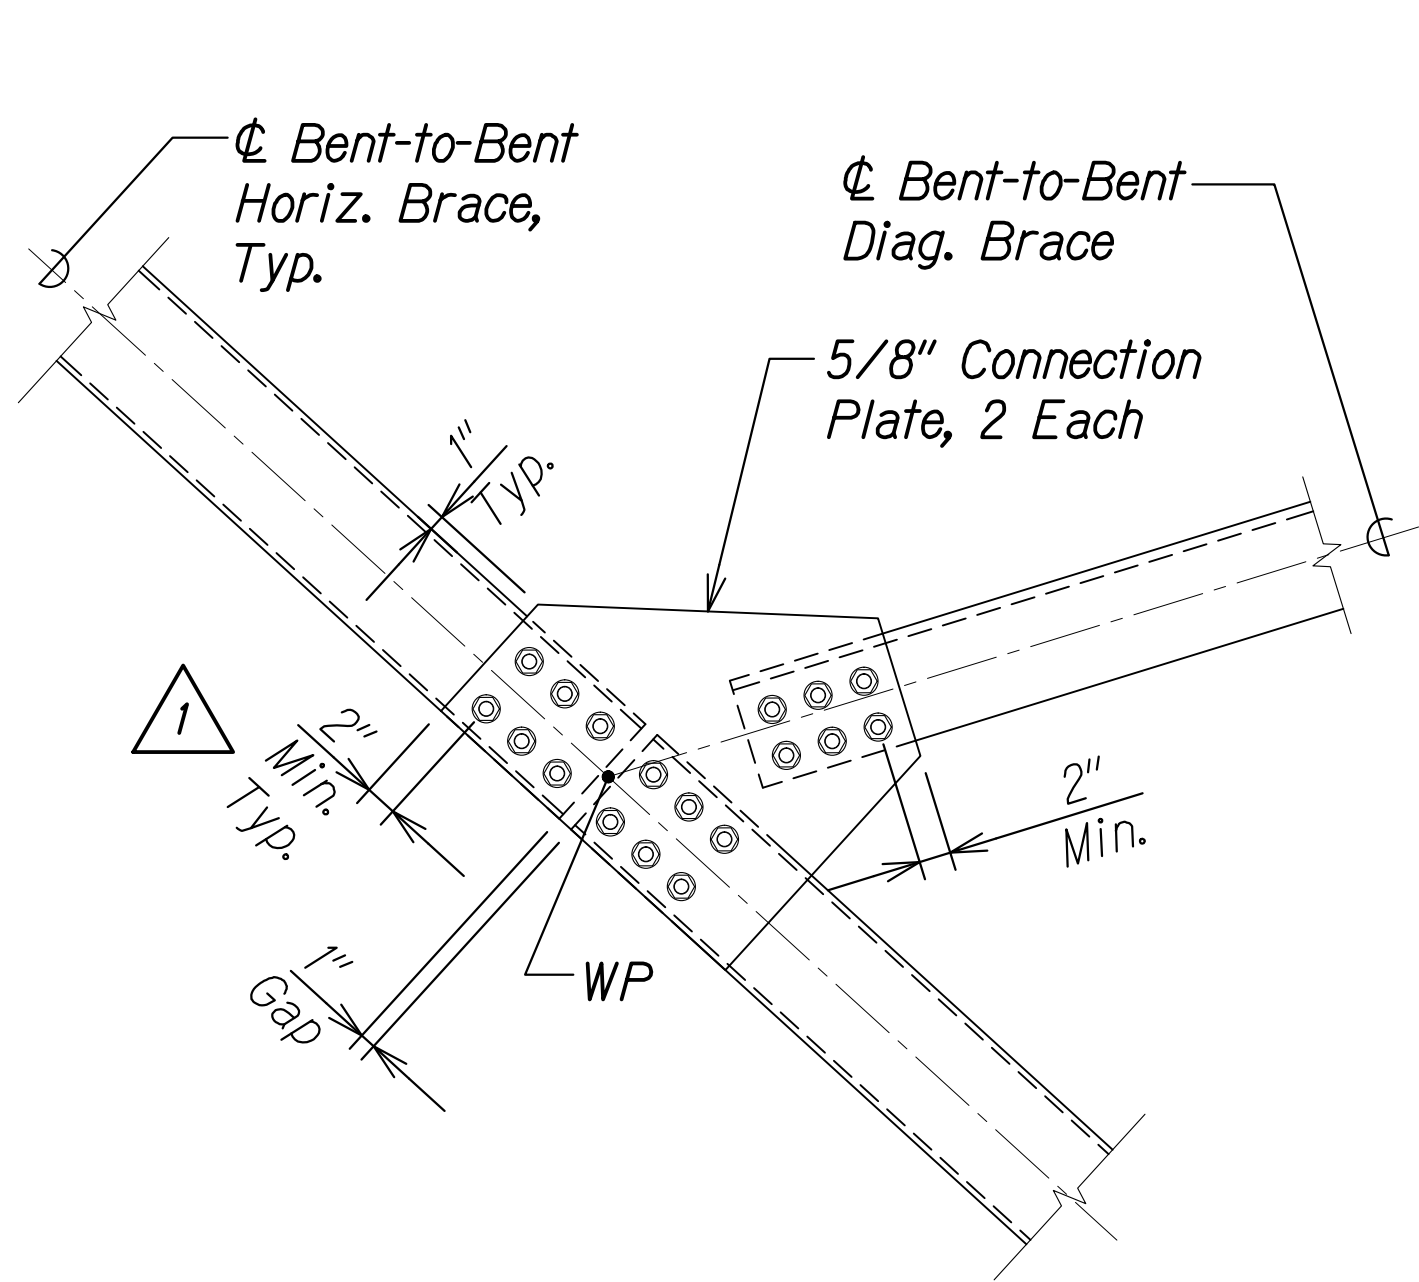

BRACE TO BRACE
CONNECTION DETAIL 1
Scale: 1" = 1'-0" SA6.17 SA6.17

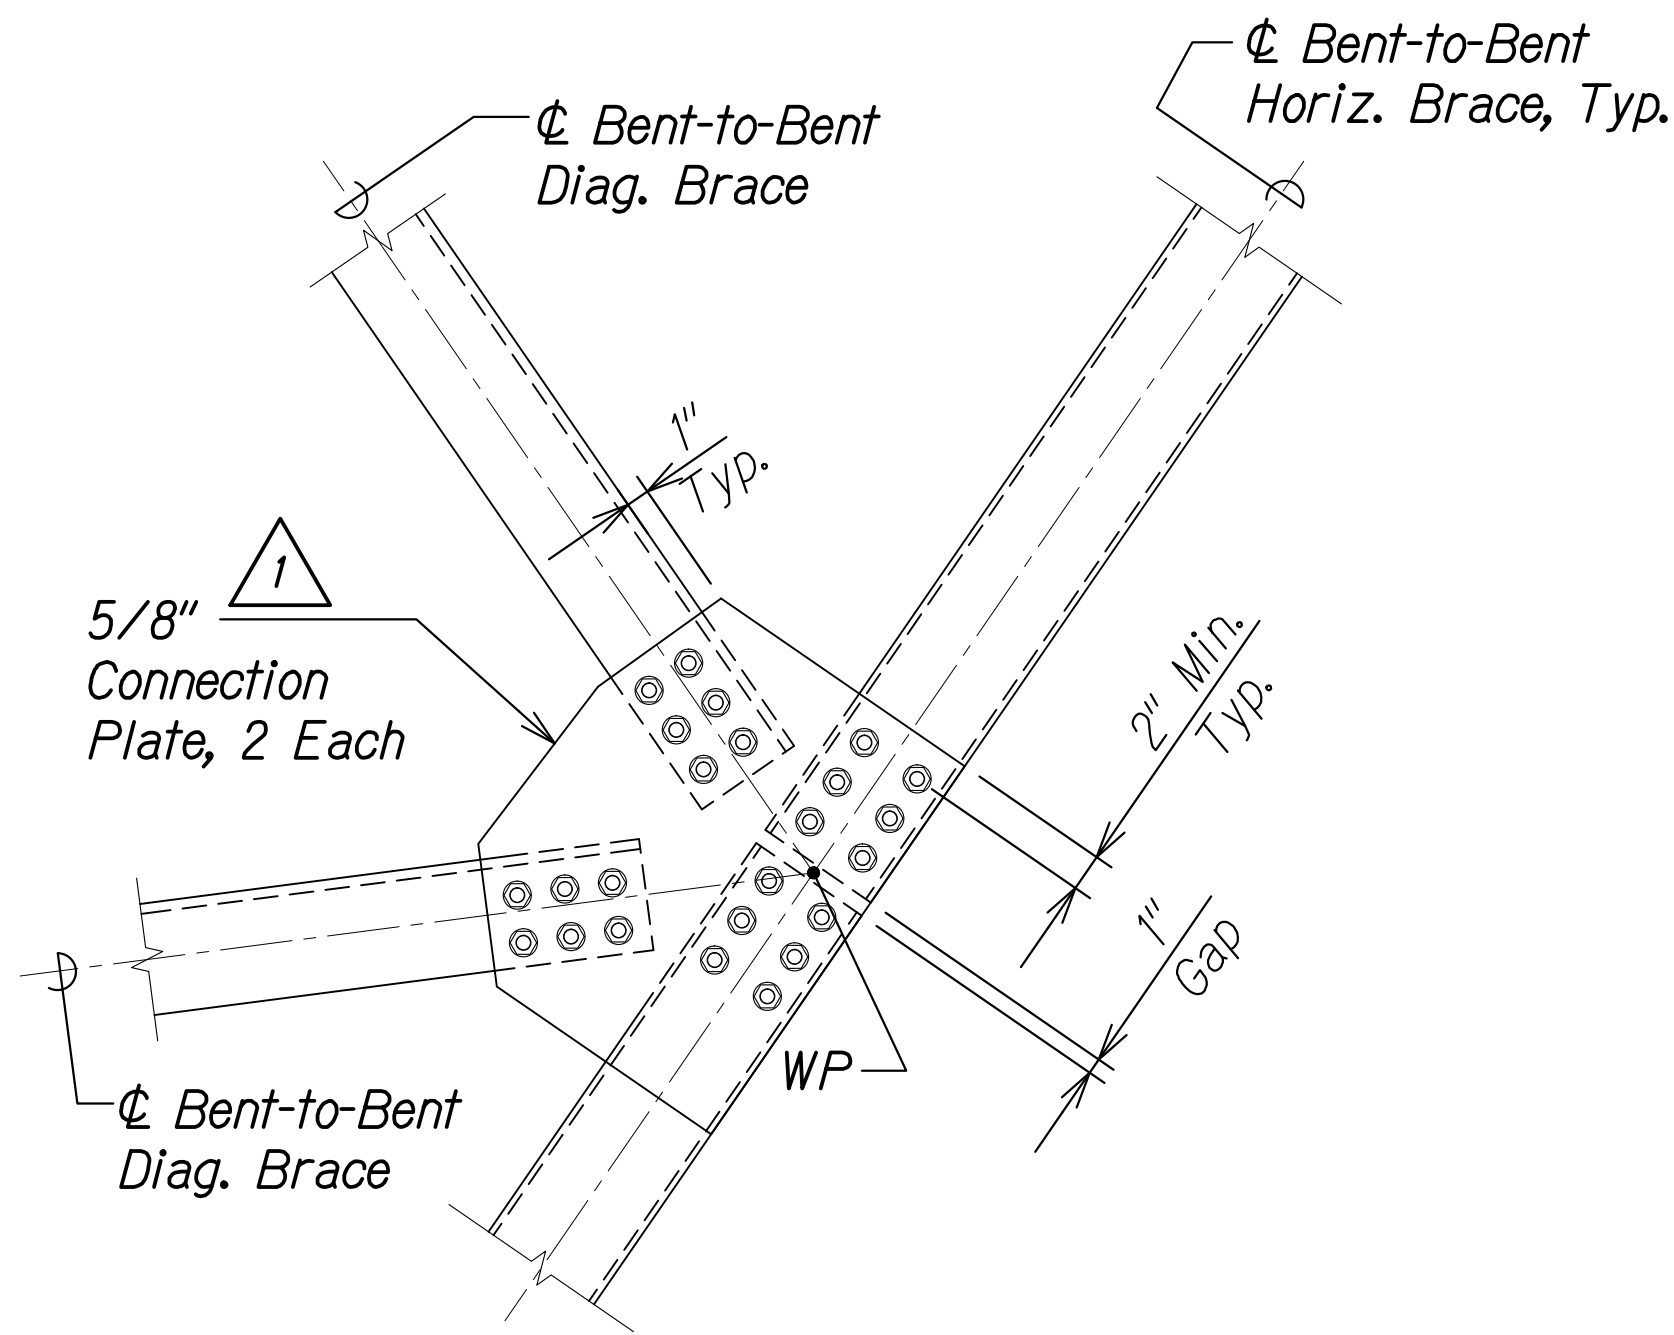


BRACE TO BRACE
CONNECTION DETAIL 2
Scale: 1" = 1'-0" SA6.17 SA6.17

1 **NOTES:**

1. The Contractor's Steel Detailer is responsible for determining the actual size of each connection plate based on the information provided in the Contract Drawings.
2. All bolted connections for horizontal and diagonal braces, as detailed on this sheet, shall be pretensioned.
3. After erection, touch-up paint the ends of all bolts/nuts/washers.
4. Batten plates and lacing on braces not shown for clarity.


ORIGINAL PLAN	SURVEY PLOTTED BY	DATE
NOTE BOOK	DRAWN BY	
	DESIGNED BY	
	QUANTITIES BY	
	CHECKED BY	

DRAWING NAME: Z:\00 ONGOING\23-022.9-NANUE STR BR PF2-DOTHA\01 CAD\12-06-24 ADD\NSR-SA6602-SA6617 CONN DTL5 ADD2.DWG PLOT TIME: 12-05-24 1:33 PM

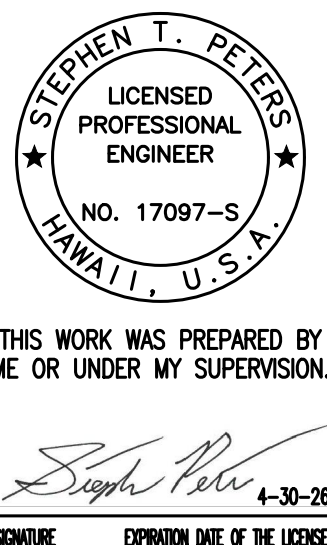


12/6/24	1 Revised Details & Added Notes
DATE	REVISION
STATE OF HAWAII DEPARTMENT OF TRANSPORTATION HIGHWAYS DIVISION BRACE TO BRACE CONNECTION DETAILS HAWAII BELT ROAD Nanue Stream Bridge Rehabilitation Federal Aid Project No. BR-019-2(077) Scale: As Noted Date: Oct. 2024	
SHEET No.SA6.17 OF 22 SHEETS	


FED. ROAD DIST. NO.	STATE	FEDERAL AID PROJ. NO.	FISCAL YEAR	SHEET NO.	TOTAL SHEETS
HAWAII	HAW.	BR-019-2(077)	2024	ADD. 123S-1	280

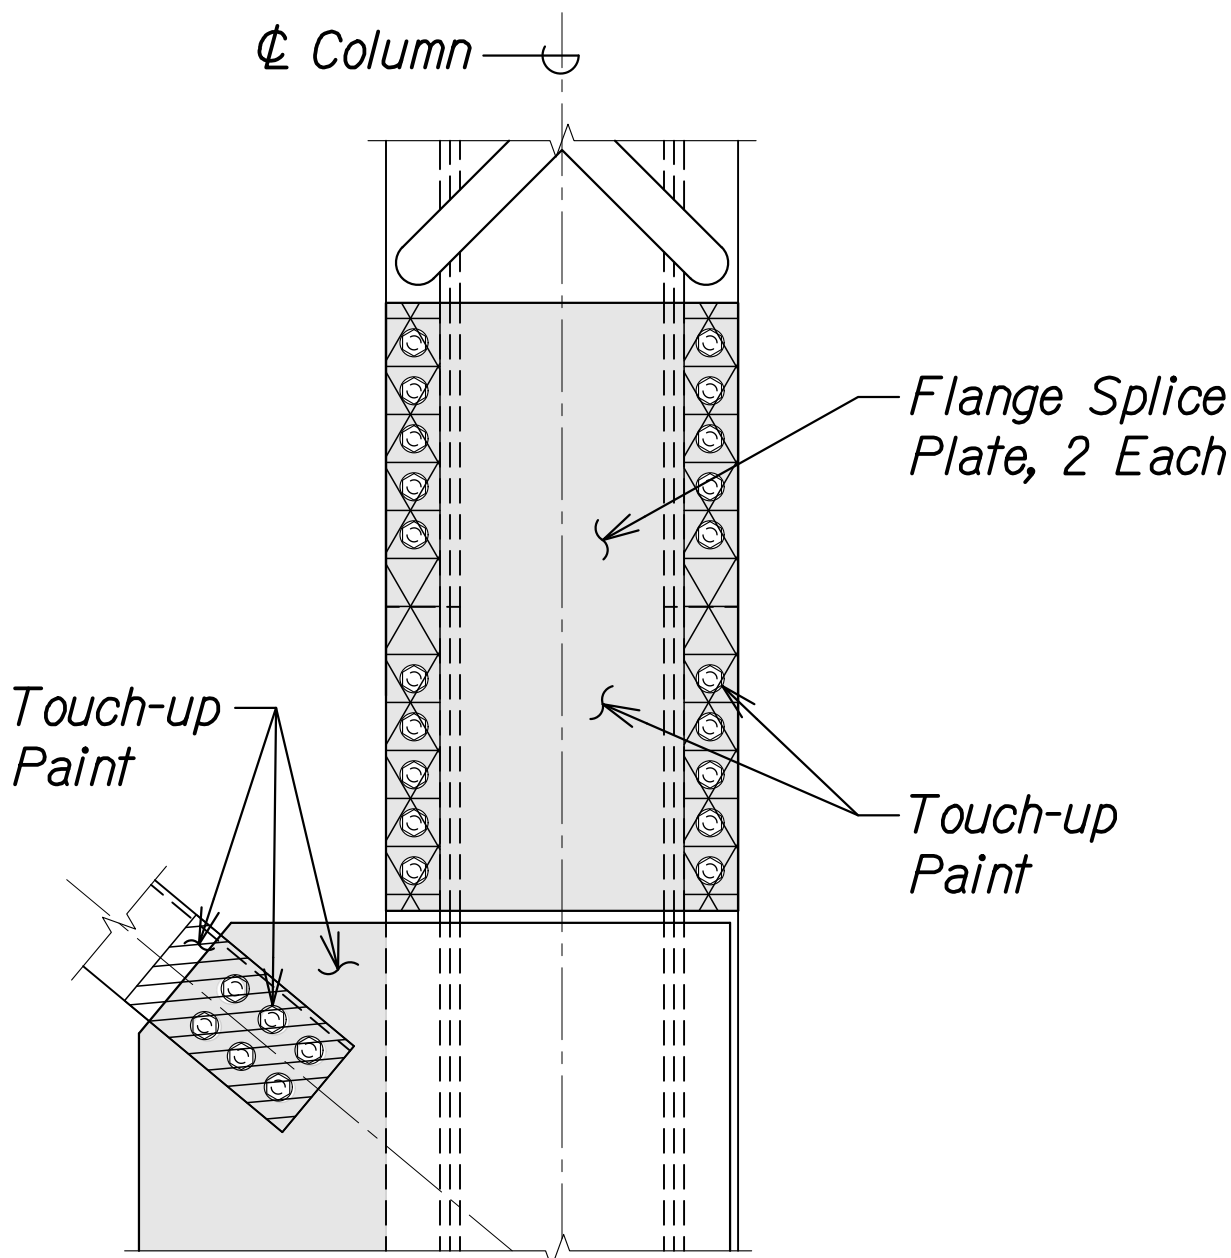


COLUMN FLANGE SPLICE
PAINT BLOCKING DETAIL 1
Scale: 1" = 1'-0" SA6.17A SA6.7A

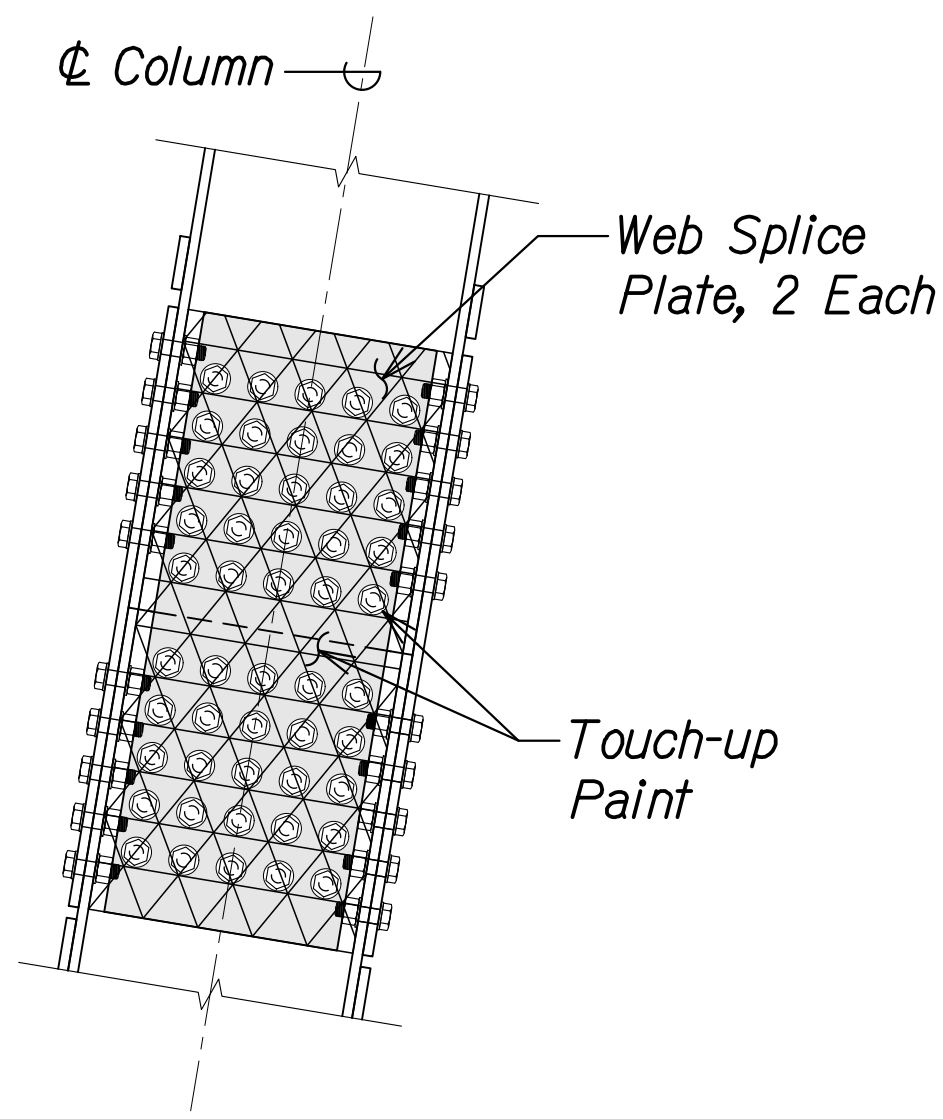


COLUMN WEB SPLICE
PAINT BLOCKING DETAIL 2
Scale: 1" = 1'-0" SA6.17A SA6.7A

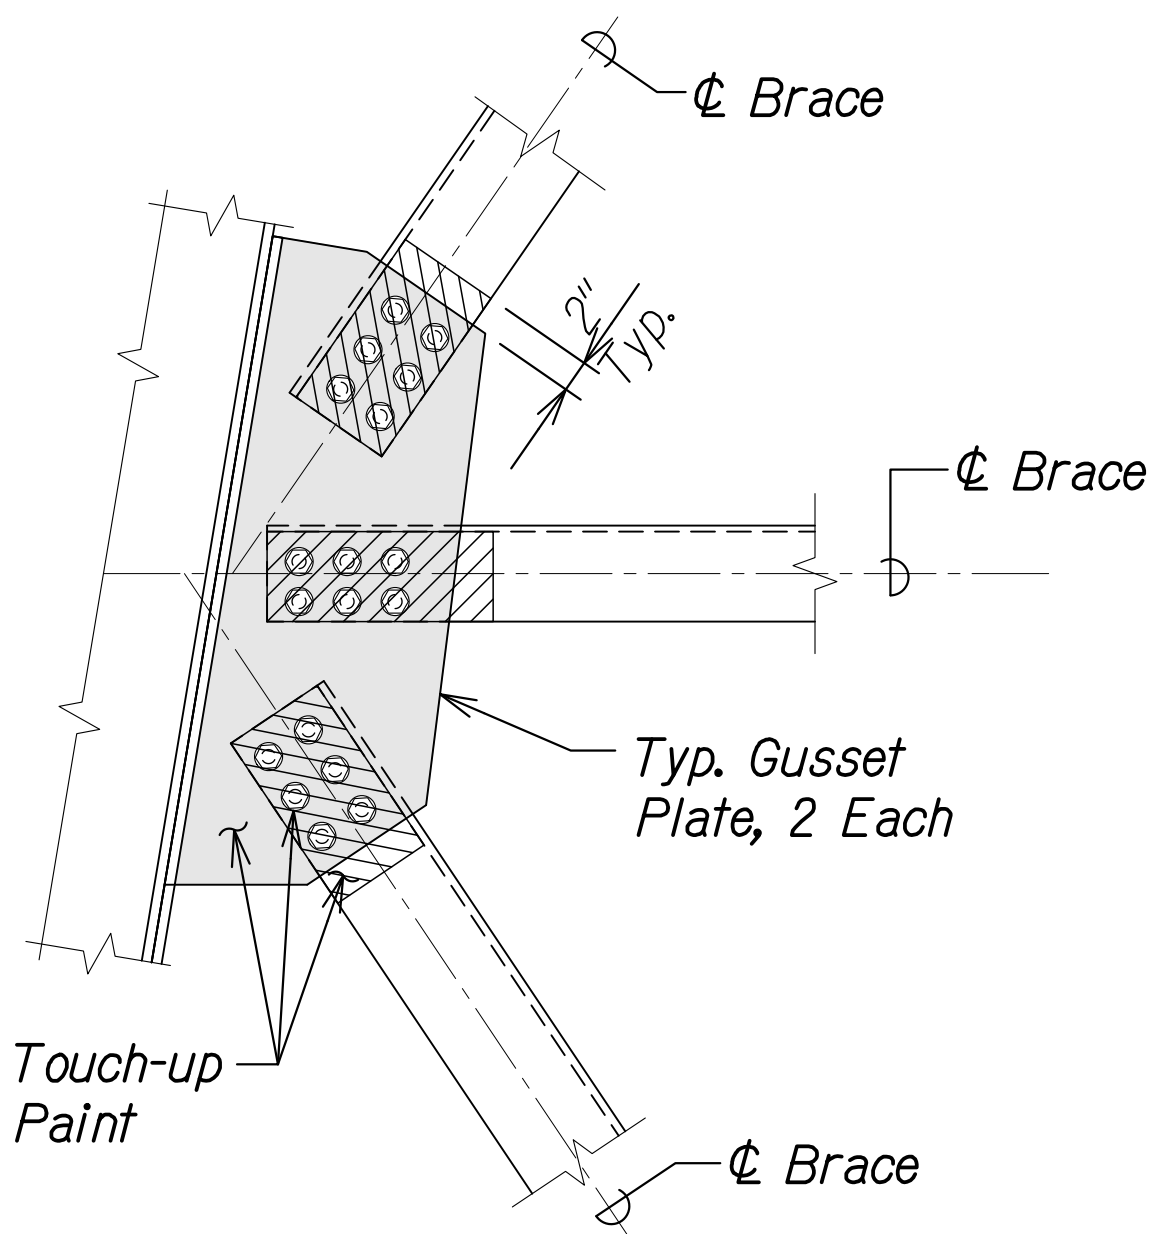


TYP. GUSSET PLATE
PAINT BLOCKING DETAIL 3
Scale: 1" = 1'-0" SA6.17A SA6.7A

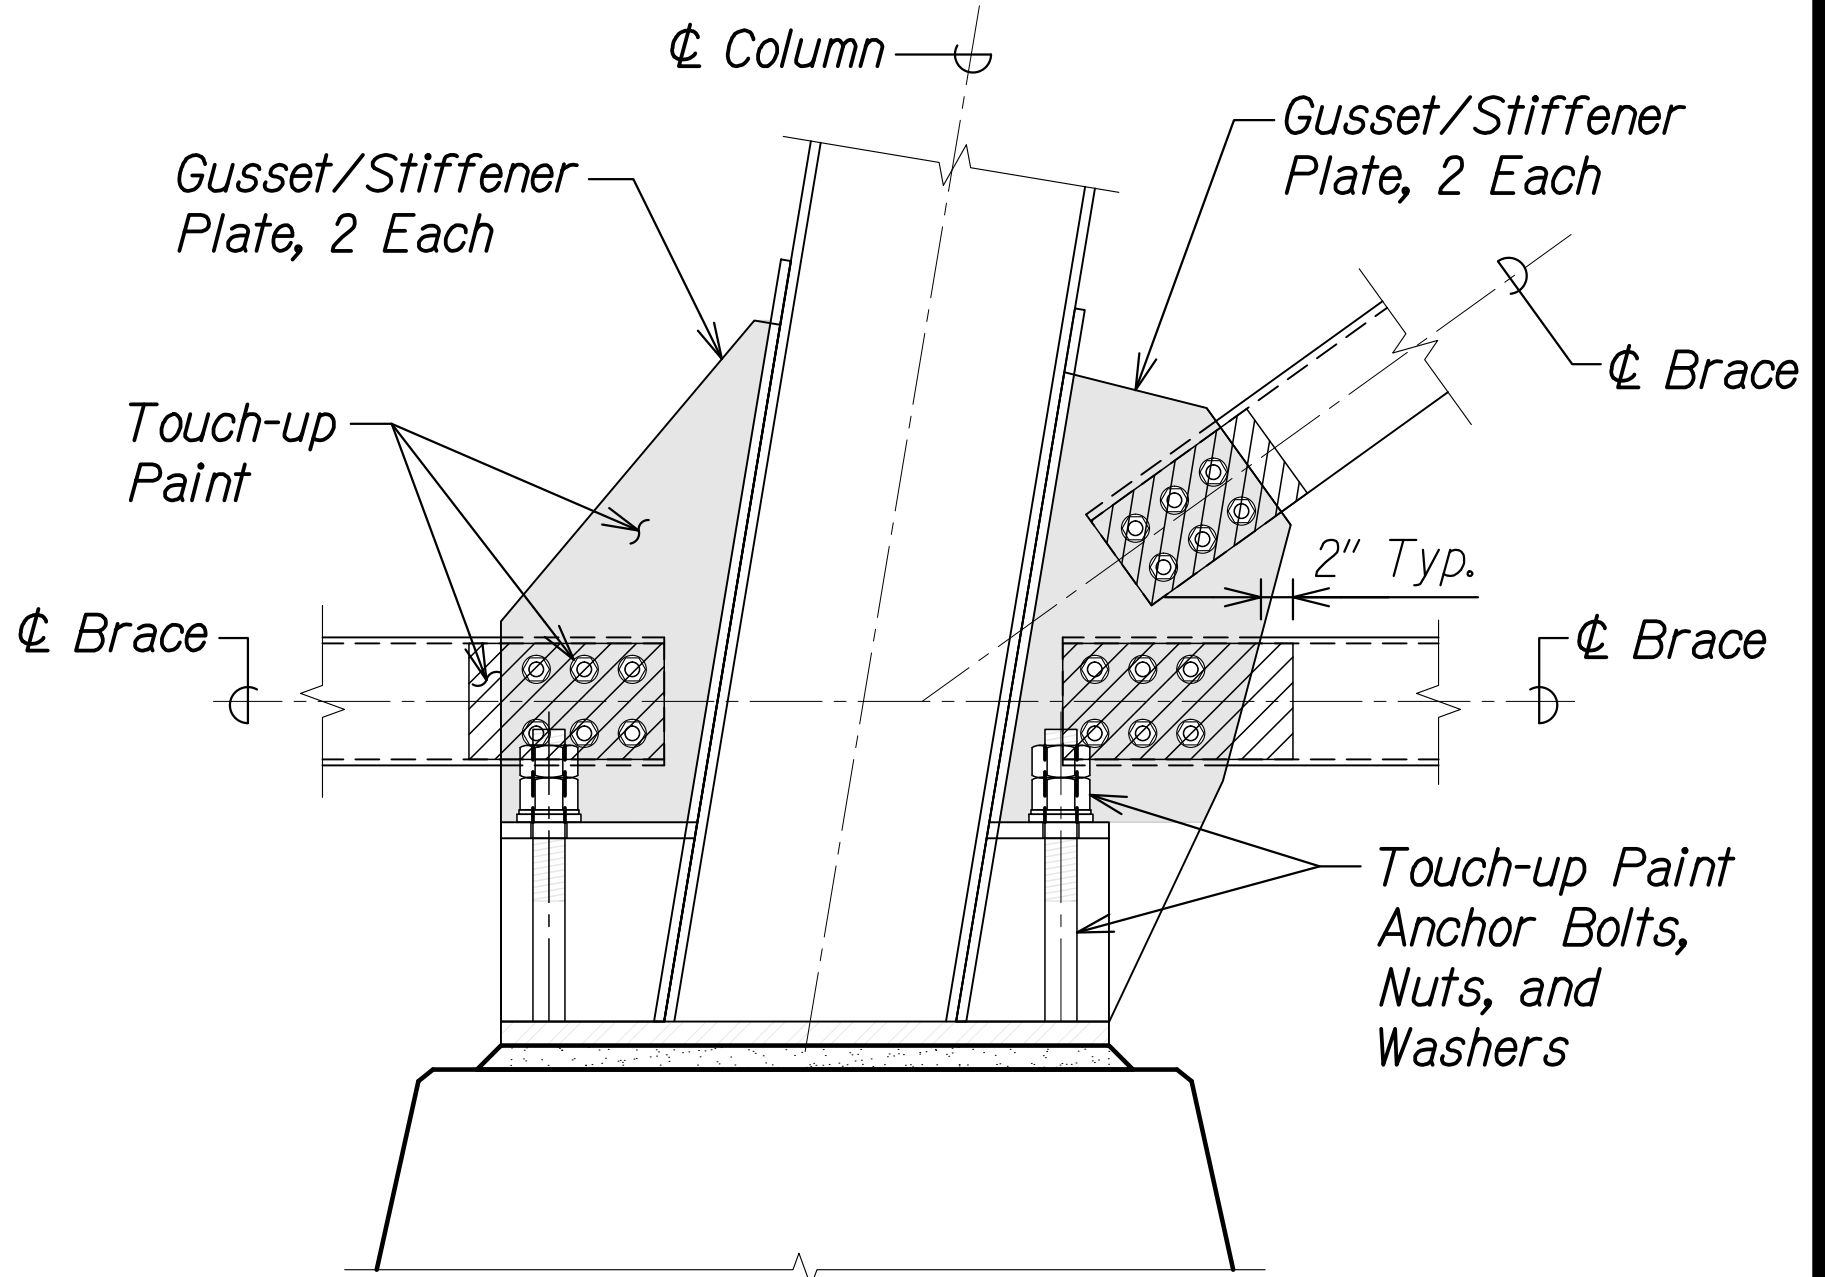


BASE COLUMN GUSSET PLATE
PAINT BLOCKING DETAIL 4
Scale: 1" = 1'-0" SA6.17A SA6.7A

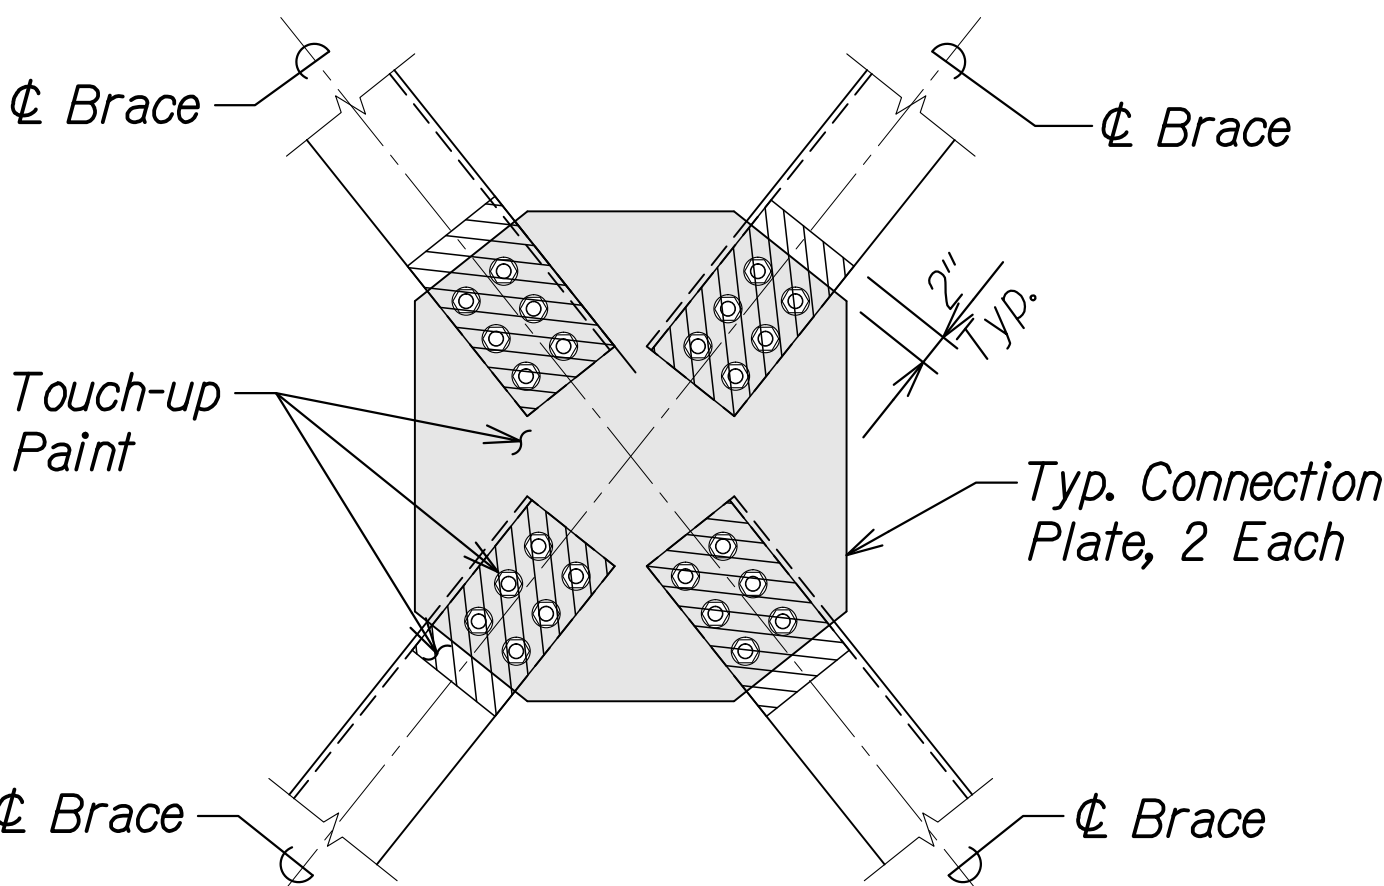

TYP. CONNECTION PLATE
PAINT BLOCKING DETAIL 5
Scale: 1" = 1'-0" SA6.17A SA6.7A

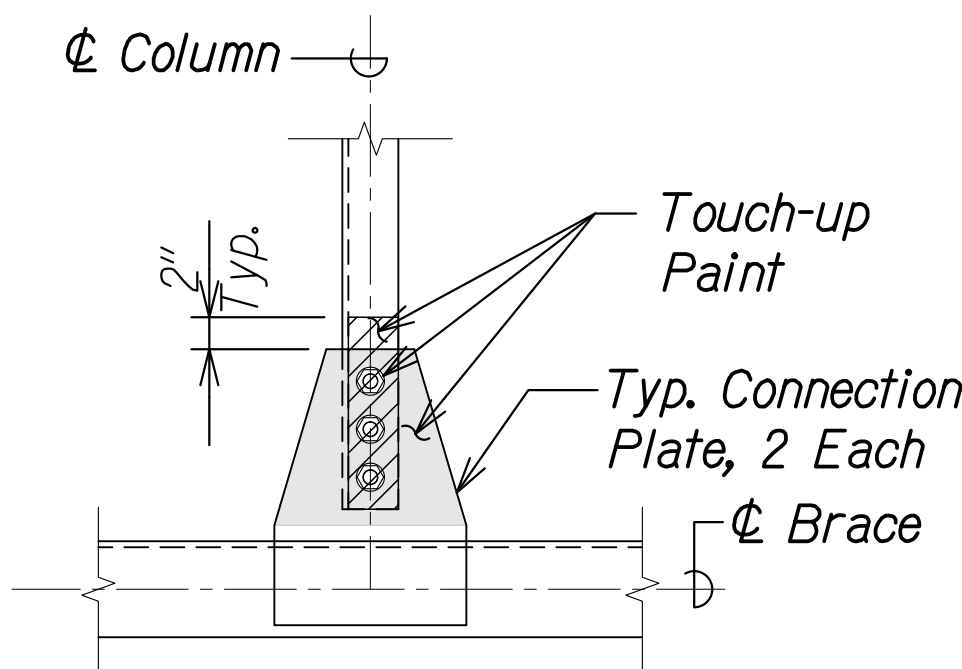

CONNECTION PLATE
PAINT BLOCKING DETAIL 6
Scale: 1" = 1'-0" SA6.17A SA6.7A

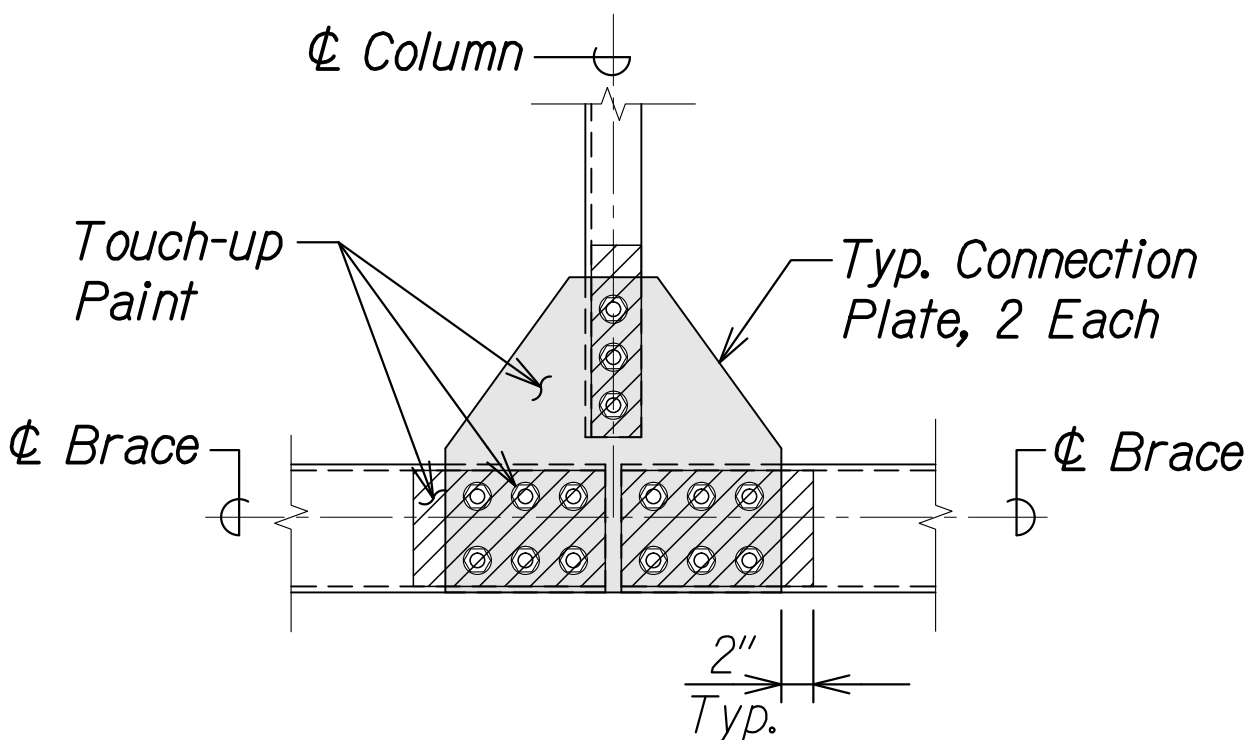

CONNECTION PLATE
PAINT BLOCKING DETAIL 7
Scale: 1" = 1'-0" SA6.17A SA6.7A

PAINT BLOCKING LEGEND

- Mask Outside Face of Splice/Gusset/Connection Plate Only. No Shop Application of Topcoat. Field Touch-up Paint Intermediate and Topcoat After Bolt Installation
- Mask Inside Face of Brace Only. No Shop Application of Topcoat. Field Touch-up Paint Intermediate and Topcoat After Bolt Installation
- Mask Inside Face of Column Flange and Column Web Only. No Shop Application of Topcoat. Field Touch-up Paint Intermediate and Topcoat After Bolt Installation


NOTES:

- Paint blocking details are typical for all bolted connections at bridge trestle.
- See Special Provisions Section 667 - PREPARATION AND COATING OF GALVANIZED BRIDGE STEEL for requirements pertaining to touch-up painting of field bolted connections at trestles.
- Work for touch-up painting of field bolted connections at trestles shall be covered under Pay Item 667.3000.

DATE	DATE
DESIGNED BY	DESIGNED BY
TRACED BY	TRACED BY
QUANTITIES BY	QUANTITIES BY
CHECKED BY	CHECKED BY

DRAWING NAME: Z:\00 ONGOING\23-022.9-NANUE STR BR PF2-DOT\A.01 CAD\12-06-24 ADD\NSR-SAG602-SAG617 CONN DTL'S ADD2.DWG PLOT TIME: 12-05-24 2:05 PM

12/6/24	1 New Sheet
DATE	REVISION

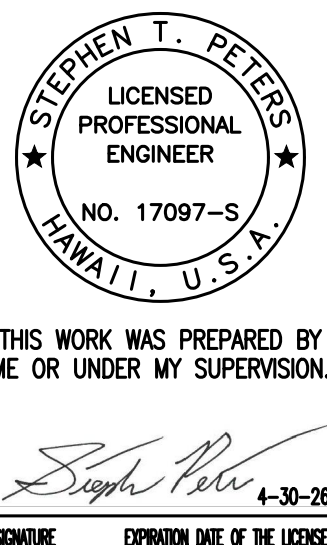

STATE OF HAWAII
DEPARTMENT OF TRANSPORTATION
HIGHWAYS DIVISION

**PAINT BLOCKING DETAILS
AT BOLTED CONNECTIONS**

HAWAII BELT ROAD
Nanue Stream Bridge Rehabilitation
Federal Aid Project No. BR-019-2(077)

Scale: As Noted Date: Oct. 2024

SHEET No. SA6.17A OF 22 SHEETS

FED. ROAD DIST. NO.	STATE	FEDERAL AID PROJ. NO.	FISCAL YEAR	SHEET NO.	TOTAL SHEETS
HAWAII	HAW.	BR-019-2(077)	2024	ADD. 124	280

CONNECTION REFERENCE SCHEDULE

CONNECTION ID				PLAN DETAILS				ELEV. DETAILS							
BENT NO. 1	TP1A1-C	A/SA6.4	1/SA6.14	BENT NO. 2	BP2A5-C	A/SA6.10	3/SA6.11	BENT NO. 4	TP4A1-C	D/SA6.2	1/SA6.14	BENT NO. 5	TP5A1-C	A/SA6.2	1/SA6.14
	TP1B1-C	B/SA6.4	2/SA6.14		BP2B5-C	B/SA6.10	4/SA6.11		TP4B1-C	E/SA6.2	2/SA6.14		TP5B1-C	B/SA6.2	2/SA6.14
	TP1C1-C	B/SA6.4	2/SA6.14 (OH)		SP25	-	3/SA6.15		TP4C1-C	E/SA6.2	2/SA6.14 (OH)		TP5C1-C	B/SA6.2	2/SA6.14 (OH)
	TP1D1-C	C/SA6.4	1/SA6.14 (OH)		BP2C5-C	B/SA6.10	4/SA6.11 (OH)		TP4D1-C	F/SA6.2	1/SA6.14 (OH)		TP5D1-C	C/SA6.2	1/SA6.14 (OH)
	SP1B1-C2	-	1/SA6.15		BP2D5-C	C/SA6.10	3/SA6.11 (OH)		SP4B1-C2	-	1/SA6.15		SP5B1-C2	-	1/SA6.15
	GP1A2-C	A/SA6.4	1/SA6.5						GP4A2-C	A/SA6.4	1/SA6.5		GP5A2-C	A/SA6.4	1/SA6.5
	GP1B2-C	B/SA6.4	2/SA6.5	TP3A1-C	A/SA6.2	1/SA6.14	GP4B2-C		B/SA6.4	2/SA6.5	GP5B2-C		B/SA6.4	2/SA6.5	
	GP1C2-C	B/SA6.4	2/SA6.5 (OH)	TP3B1-C	B/SA6.2	2/SA6.14	GP4C2-C		B/SA6.4	2/SA6.5 (OH)	GP5C2-C		B/SA6.4	2/SA6.5 (OH)	
	GP1D2-C	C/SA6.4	1/SA6.5 (OH)	TP3C1-C	B/SA6.2	2/SA6.14 (OH)	GP4D2-C		C/SA6.4	1/SA6.5 (OH)	GP5D2-C		C/SA6.4	1/SA6.5 (OH)	
SP1B2-C3	-	2/SA6.15	TP3D1-C	C/SA6.2	1/SA6.14 (OH)	SP4B2-C3	-	1/SA6.15	SP5B2-C3	-	1/SA6.15				
			SP3B1-C2	-	1/SA6.15										
BP1A3-C	C/SA6.10	1/SA6.11	BENT NO. 3	GP3A2-C	A/SA6.4	1/SA6.5	BENT NO. 4	GP4A3-C	D/SA6.2	C/SA6.5	BENT NO. 5	GP5A3-C	A/SA6.2	C/SA6.5	
BP1B3-C	B/SA6.10	2/SA6.11		GP3B2-C	B/SA6.4	2/SA6.5		GP4B3-C	E/SA6.2	C/SA6.5		GP5B3-C	B/SA6.2	C/SA6.5	
SP13	-	3/SA6.15		GP3C2-C	B/SA6.4	2/SA6.5 (OH)		GP4C3-C	E/SA6.2	C/SA6.5 (OH)		GP5C3-C	B/SA6.2	C/SA6.5 (OH)	
BP1C3-C	B/SA6.10	2/SA6.11 (OH)		GP3D2-C	C/SA6.4	1/SA6.5 (OH)		GP4D3-C	F/SA6.2	C/SA6.5 (OH)		GP5D3-C	C/SA6.2	C/SA6.5 (OH)	
BP1D3-C	C/SA6.10	1/SA6.11 (OH)		SP3B2-C3	-	1/SA6.15		SP4B3-C4	-	2/SA6.15		SP5B3-C4	-	2/SA6.15	
TP2A1-C	D/SA6.2	1/SA6.14		GP3A3-C	A/SA6.4	C/SA6.5		GP4A4-C	D/SA6.2	C/SA6.5		GP5A4-C	A/SA6.2	C/SA6.5	
TP2B1-C	E/SA6.2	2/SA6.14		GP3B3-C	B/SA6.4	C/SA6.5		GP4B4-C	E/SA6.2	C/SA6.5		GP5B4-C	B/SA6.2	C/SA6.5	
TP2C1-C	E/SA6.2	2/SA6.14 (OH)		GP3C3-C	B/SA6.4	C/SA6.5 (OH)		SP44	-	3/SA6.15		SP54	-	3/SA6.15	
TP2D1-C	F/SA6.2	1/SA6.14 (OH)		GP3D3-C	C/SA6.4	C/SA6.5 (OH)		GP4C4-C	E/SA6.2	C/SA6.5 (OH)		GP5C4-C	B/SA6.2	C/SA6.5 (OH)	
SP2B1-C2	-	1/SA6.15		SP3B3-C4	-	2/SA6.15		GP4D4-C	F/SA6.2	C/SA6.5 (OH)		GP5D4-C	C/SA6.2	C/SA6.5 (OH)	
								SP4B4-C5	-	2/SA6.15		SP5B4-C5	-	2/SA6.15	
GP2A2-C	A/SA6.4	1/SA6.5		GP3A4-C	A/SA6.2	C/SA6.5									
GP2B2-C	B/SA6.4	2/SA6.5		GP3B4-C	B/SA6.2	C/SA6.5		GP4A5-C	D/SA6.2	C/SA6.5		GP5A5-C	A/SA6.2	C/SA6.5	
GP2C2-C	B/SA6.4	2/SA6.5 (OH)		SP34	-	3/SA6.15		GP4B5-C	E/SA6.2	C/SA6.5		GP5B5-C	B/SA6.2	C/SA6.5	
GP2D2-C	C/SA6.4	1/SA6.5 (OH)		GP3C4-C	B/SA6.2	C/SA6.5 (OH)		SP45	-	3/SA6.15		SP55	-	3/SA6.15	
SP2B2-C3	-	1/SA6.15		GP3D4-C	C/SA6.2	C/SA6.5 (OH)		GP4C5-C	E/SA6.2	C/SA6.5 (OH)		GP5C5-C	B/SA6.2	C/SA6.5 (OH)	
				SP3B4-C5	-	2/SA6.15		GP4D5-C	F/SA6.2	C/SA6.5 (OH)		GP5D5-C	C/SA6.2	C/SA6.5 (OH)	
GP2A3-C	D/SA6.2	C/SA6.5						SP4B5-C6	-	2/SA6.15		SP5B5-C6	-	2/SA6.15	
GP2B3-C	E/SA6.2	C/SA6.5		GP3A5-C	A/SA6.2	C/SA6.5									
GP2C3-C	E/SA6.2	C/SA6.5 (OH)		GP3B5-C	B/SA6.2	C/SA6.5		GP4A6-C	D/SA6.2	3/SA6.5					
GP2D3-C	F/SA6.2	C/SA6.5 (OH)		SP35	-	3/SA6.15		GP4B6-C	E/SA6.2	4/SA6.5					
SP2B3-C4	-	2/SA6.15		GP3C5-C	B/SA6.2	C/SA6.5 (OH)		SP46	-	5/SA6.15					
				GP3D5-C	C/SA6.2	C/SA6.5 (OH)		GP4C6-C	E/SA6.2	4/SA6.5 (OH)					
GP2A4-C	D/SA6.2	C/SA6.5		SP3B5-C6	-	2/SA6.15		GP4D6-C	F/SA6.2	3/SA6.5 (OH)					
GP2B4-C	E/SA6.2	C/SA6.5						SP4B6-C7	-	2/SA6.15					
SP24	-	3/SA6.15		BP3A6-C	A/SA6.10 (OH)	1/SA6.12									
GP2C4-C	E/SA6.2	C/SA6.5 (OH)		BP3B6-C	B/SA6.10 (OH)	2/SA6.12		BP4A7-C	A/SA6.10	3/SA6.11					
GP2D4-C	F/SA6.2	C/SA6.5 (OH)	SP36	-	5/SA6.15	BP4B7-C	B/SA6.10	4/SA6.11							
SP2B4-C5	-	2/SA6.15	BP3C6-C	B/SA6.10 (OH)	2/SA6.12 (OH)	SP47	-	5/SA6.15							
			BP3D6-C	C/SA6.10 (OH)	1/SA6.12 (OH)	BP4C7-C	B/SA6.10	4/SA6.11 (OH)							
						BP4D7-C	C/SA6.10	3/SA6.11 (OH)							

STEPHEN T. PETERS

LICENSED PROFESSIONAL ENGINEER

NO. 17097-S

HAWAII, U.S.A.

THIS WORK WAS PREPARED BY ME OR UNDER MY SUPERVISION.

Signature

4-30-26

EXPIRATION DATE OF THE LICENSE

12/6/24

C/SA6.5

Revised Table Values

DATE

REVISION

STATE OF HAWAII

DEPARTMENT OF TRANSPORTATION

HIGHWAYS DIVISION

CONNECTION REFERENCE SCHEDULE

HAWAII BELT ROAD

Nanue Stream Bridge Rehabilitation

Federal Aid Project No. BR-019-2(077)


Scale: As Noted

Date: Oct. 2024

SHEET No.SA618 OF 22 SHEETS

ORIGINAL PLAN	SURVEY PLOTTED BY	DATE
NOTE BOOK	DRAWN BY	
	DESIGNED BY	
	QUANTITIES BY	
	CHECKED BY	

DRAWING NAME: ZA-00-ONGONG-23-022-9-NANUE STR BR PF2-DOT-A-01 CAD\12-06-24 ADD\NSR-SA0618-SA0622 CON DTLS SCHED-ADD2.DWG PLOT TIME: 12-03-24, 10:26 PM

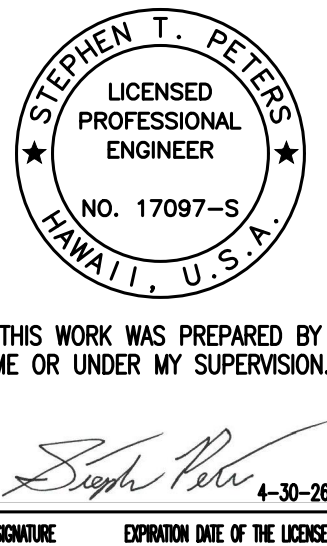

12/6/24	$\triangle 1$ Revised Table Values
DATE	REVISION
STATE OF HAWAII DEPARTMENT OF TRANSPORTATION HIGHWAYS DIVISION CONNECTION REFERENCE SCHEDULE HAWAII BELT ROAD Nanue Stream Bridge Rehabilitation Federal Aid Project No. BR-019-2(077) Scale: As Noted Date: Oct. 2024	
SHEET No.SA6.18 OF 22 SHEETS	

CONNECTION REFERENCE SCHEDULE

CONNECTION ID				PLAN DETAILS				ELEV. DETAILS				CONNECTION ID				PLAN DETAILS				ELEV. DETAILS									
BENT NO. 5	GP5A6-C			A/SA6.2			3/SA6.5			BENT NO. 6	GP6A5-C			D/SA6.2			3/SA6.5			BENT NO. 7	GP7A4-C			A/SA6.2			3/SA6.5		
	GP5B6-C			B/SA6.2			4/SA6.5				GP6B5-C			E/SA6.2			4/SA6.5				GP7B4-C			B/SA6.2			4/SA6.5		
	SP56			-			5/SA6.15				SP65			-			3/SA6.15				SP74			-			3/SA6.15		
	GP5C6-C			B/SA6.2			4/SA6.5 (OH)				GP6C5-C			E/SA6.2			4/SA6.5 (OH)				GP7C4-C			B/SA6.2			4/SA6.5 (OH)		
	GP5D6-C			C/SA6.2			3/SA6.5 (OH)				GP6D5-C			F/SA6.2			3/SA6.5 (OH)				GP7D4-C			C/SA6.2			3/SA6.5 (OH)		
											SP6B5-C6			-			2/SA6.15				SP7B4-C5			-			2/SA6.15		
	GP5A7-C			A/SA6.2			3/SA6.5														GP7A5-C			A/SA6.2			3/SA6.5		
	GP5B7-C			B/SA6.2			1/SA6.6				GP6A6-C			D/SA6.2			3/SA6.5				GP7B5-C			B/SA6.2			4/SA6.5		
	SP5B7-C8			-			4/SA6.15				GP6B6-C			E/SA6.2			4/SA6.5				SP75			-			3/SA6.15		
	GP5C7-C			B/SA6.2			1/SA6.6 (OH)				SP66			-			5/SA6.15				GP7C5-C			B/SA6.2			4/SA6.5 (OH)		
	GP5D7-C			C/SA6.2			3/SA6.5 (OH)				GP6C6-C			E/SA6.2			4/SA6.5 (OH)				GP7D5-C			C/SA6.2			3/SA6.5 (OH)		
											GP6D6-C			F/SA6.2			3/SA6.5 (OH)				SP7B5-C6			-			2/SA6.15		
	BP5A8-C			A/SA6.10 (OH)			1/SA6.12														BP7A6-C			A/SA6.10 (OH)			3/SA6.11		
	BP5B8-C			B/SA6.10 (OH)			2/SA6.12				GP6A7-C			D/SA6.2			3/SA6.5				BP7B6-C			B/SA6.10 (OH)			4/SA6.11		
	SP58			-			5/SA6.15				GP6B7-C			E/SA6.2			1/SA6.6				SP76			-			5/SA6.15		
	BP5C8-C			B/SA6.10 (OH)			2/SA6.12 (OH)				SP6B7-C8			-			4/SA6.15				BP7C6-C			B/SA6.10 (OH)			4/SA6.11 (OH)		
	BP5D8-C			C/SA6.10 (OH)			1/SA6.12 (OH)				GP6C7-C			E/SA6.2			1/SA6.6 (OH)				BP7D6-C			C/SA6.10 (OH)			3/SA6.11 (OH)		
											GP6D7-C			F/SA6.2			3/SA6.5 (OH)												
									BP6A8-C			A/SA6.10			1/SA6.12														
									BP6B8-C			B/SA6.10			2/SA6.12														
									SP68			-			5/SA6.15														
									BP6C8-C			B/SA6.10			2/SA6.12 (OH)														
									BP6D8-C			C/SA6.10			1/SA6.12 (OH)														
BENT NO. 6	TP6A1-C			D/SA6.2			1/SA6.14			BENT NO. 7	TP7A1-C			A/SA6.2			1/SA6.14			BENT NO. 8	TP8A1-C			D/SA6.2			1/SA6.14		
	TP6B1-C			E/SA6.2			2/SA6.14				TP7B1-C			B/SA6.2			2/SA6.14				TP8B1-C			E/SA6.2			2/SA6.14		
	TP6C1-C			E/SA6.2			2/SA6.14 (OH)				TP7C1-C			B/SA6.2			2/SA6.14 (OH)				TP8C1-C			E/SA6.2			2/SA6.14 (OH)		
	TP6D1-C			F/SA6.2			1/SA6.14 (OH)				TP7D1-C			C/SA6.2			1/SA6.14 (OH)				TP8D1-C			F/SA6.2			1/SA6.14 (OH)		
	SP6B1-C2			-			1/SA6.15				SP7B1-C2			-			1/SA6.15				SP8B1-C2			-			1/SA6.15		
	GP6A2-C			A/SA6.4			1/SA6.5				GP7A2-C			A/SA6.4			1/SA6.5				GP8A2-C			A/SA6.4			1/SA6.5		
	GP6B2-C			B/SA6.4			2/SA6.5				GP7B2-C			B/SA6.4			2/SA6.5				GP8B2-C			B/SA6.4			2/SA6.5		
	GP6C2-C			B/SA6.4			2/SA6.5 (OH)				GP7C2-C			B/SA6.4			2/SA6.5 (OH)				GP8C2-C			B/SA6.4			2/SA6.5 (OH)		
	GP6D2-C			C/SA6.4			1/SA6.5 (OH)				GP7D2-C			C/SA6.4			1/SA6.5 (OH)				GP8D2-C			C/SA6.4			1/SA6.5 (OH)		
	SP6B2-C3			-			1/SA6.15				SP7B2-C3			-			1/SA6.15				SP8B2-C3			-			1/SA6.15		
	GP6A3-C			D/SA6.2			3/SA6.5				GP7A3-C			A/SA6.2			3/SA6.5				GP8A3-C			D/SA6.2			3/SA6.5		
	GP6B3-C			E/SA6.2			4/SA6.5				GP7B3-C			B/SA6.2			4/SA6.5				GP8B3-C			E/SA6.2			4/SA6.5		
	GP6C3-C			E/SA6.2			4/SA6.5 (OH)				GP7C3-C			B/SA6.2			4/SA6.5 (OH)				GP8C3-C			E/SA6.2			4/SA6.5 (OH)		
	GP6D3-C			F/SA6.2			3/SA6.5 (OH)				GP7D3-C			C/SA6.2			3/SA6.5 (OH)				GP8D3-C			F/SA6.2			3/SA6.5 (OH)		
	SP6B3-C4			-			2/SA6.15				SP7B3-C4			-			2/SA6.15				SP8B3-C4			-			2/SA6.15		
GP6A4-C			D/SA6.2			3/SA6.5												BP8A4-C			A/SA6.10			1/SA6.12					
GP6B4-C			E/SA6.2			4/SA6.5			GP7A4-C			A/SA6.2			3/SA6.5			BP8B4-C			B/SA6.10			2/SA6.12					
SP64			-			3/SA6.15			GP7B4-C			B/SA6.2			4/SA6.5			SP84			-			3/SA6.15					
GP6C4-C			E/SA6.2			4/SA6.5 (OH)			GP7C4-C			B/SA6.2			4/SA6.5 (OH)			BP8C4-C			B/SA6.10			2/SA6.12 (OH)					
GP6D4-C			F/SA6.2			3/SA6.5 (OH)			GP7D4-C			C/SA6.2			3/SA6.5 (OH)			BP8D4-C			C/SA6.10			1/SA6.12 (OH)					
SP6B4-C5			-			2/SA6.15																							

12/6/24

DATE

1

Revised Table Values

REVISION

STATE OF HAWAII

DEPARTMENT OF TRANSPORTATION

HIGHWAYS DIVISION

CONNECTION REFERENCE

SCHEDULE

HAWAII BELT ROAD

Nanue Stream Bridge Rehabilitation

Federal Aid Project No. BR-019-2(077)

Scale: As Noted

Date: Oct. 2024

STEPHEN T. PETERS

LICENSED PROFESSIONAL ENGINEER

NO. 17097-S

HAWAII, U.S.A.

THIS WORK WAS PREPARED BY ME OR UNDER MY SUPERVISION.

Stephen Peters

4-30-26


SIGNATURE

EXPIRATION DATE OF THE LICENSE

SHEET No.SA6.19 OF 22 SHEETS

ORIGINAL PLAN	SURVEY PLOTTED BY	DATE
NOTE BOOK	DRAWN BY	
	DESIGNED BY	
	QUANTITIES BY	
	CHECKED BY	

DRAWING NAME: Z:\00_ONGOING\23-022-9-NANUE STR BR FE2-DOT\A\01 CAD\12-06-24 ADD\NSR-SA0618-SA0622 CON DTLS SCHD ADD2.DWG PLOT TIME: 12-03-24, 10:27 PM

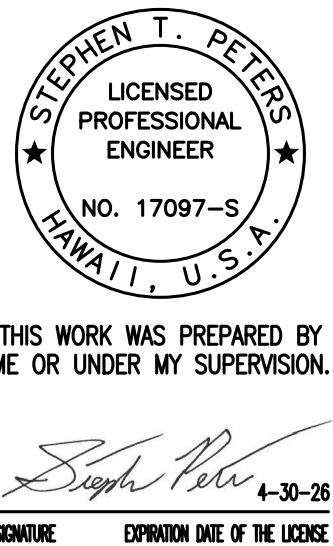

12/6/24	$\triangle 1$ Revised Table Values
DATE	REVISION
STATE OF HAWAII DEPARTMENT OF TRANSPORTATION HIGHWAYS DIVISION CONNECTION REFERENCE SCHEDULE HAWAII BELT ROAD Nanue Stream Bridge Rehabilitation Federal Aid Project No. BR-019-2(077) Scale: As Noted Date: Oct. 2024	
SHEET No.SA6.19 OF 22 SHEETS	


FED. ROAD DIST. NO.	STATE	FEDERAL AID PROJ. NO.	FISCAL YEAR	SHEET NO.	TOTAL SHEETS
HAWAII	HAW.	BR-019-2(077)	2024	ADD. 126	280

CONNECTION REFERENCE SCHEDULE

TRESTLE NO. 1 - COL. LINE "A", "B", "C" AND "D"	CONNECTION ID	PLAN DETAILS	ELEV. DETAILS	
			UPSTREAM	DOWNSTREAM
	TP1A1-B	A/SA6.4	6/SA6.14	5/SA6.14
	BP1A3-B	<div><div>1</div>A/SA6.10</div>	1/SA6.13	1/SA6.13
	TP1B1-B	B/SA6.4	5/SA6.14	5/SA6.14
	BP1B3-B	<div><div>1</div>B/SA6.10</div>	1/SA6.13	1/SA6.13
	TP1C1-B	B/SA6.4	5/SA6.14	5/SA6.14
	BP1C3-B	<div><div>1</div>B/SA6.10</div>	1/SA6.13	1/SA6.13
	TP1D1-B	C/SA6.4	5/SA6.14	6/SA6.14
	BP1D3-B	<div><div>1</div>C/SA6.10</div>	1/SA6.13	1/SA6.13
TRESTLE NO. 2 - COLUMN LINE "A"	TP2A1-B	D/SA6.2	4/SA6.14	3/SA6.14
	TP3A1-B	A/SA6.2	4/SA6.14 (OH)	3/SA6.14 (OH)
	SP23A1-3	-	1/SA6.16	1/SA6.16
	GP2A3-B	D/SA6.2	2/SA6.7	1/SA6.7
	SP23A3	-	3/SA6.16	3/SA6.16
	GP3A3-B	A/SA6.2	2/SA6.7 (OH)	1/SA6.7 (OH)
	SP23A3-4	-	1/SA6.16	1/SA6.16
	GP2A4-B	D/SA6.2	2/SA6.7	1/SA6.7
	SP23A4	-	3/SA6.16	3/SA6.16
	GP3A4-B	A/SA6.2	2/SA6.7 (OH)	1/SA6.7 (OH)
	SP23A4-5	-	1/SA6.16	1/SA6.16
TRESTLE NO. 2 - COLUMN LINE "B"	CONNECTION ID	PLAN DETAILS	ELEV. DETAILS	
			UPSTREAM	DOWNSTREAM
	TP2B1-B	E/SA6.2	3/SA6.14	
	TP3B1-B	B/SA6.2	3/SA6.14 (OH)	
	SP23B1-3	-	1/SA6.16	
	GP2B3-B	E/SA6.2	1/SA6.7	
	SP23B3	-	3/SA6.16	
	GP3B3-B	B/SA6.2	1/SA6.7 (OH)	
	SP23B3-4	-	1/SA6.16	
TRESTLE NO. 2 - COLUMN LINE "C"	CONNECTION ID	PLAN DETAILS	ELEV. DETAILS	
			UPSTREAM	DOWNSTREAM
	TP2C1-B	E/SA6.2	3/SA6.14	
	TP3C1-B	B/SA6.2	3/SA6.14 (OH)	
	SP23C1-3	-	1/SA6.16	
	GP2C3-B	E/SA6.2	1/SA6.7	
	SP23C3	-	3/SA6.16	
	GP3C3-B	B/SA6.2	1/SA6.7 (OH)	
	SP23C3-4	-	1/SA6.16	
	GP2C4-B	E/SA6.2	1/SA6.7	
	SP23C4	-	3/SA6.16	
TRESTLE NO. 2 - COLUMN LINE "D"	CONNECTION ID	PLAN DETAILS	ELEV. DETAILS	
			UPSTREAM	DOWNSTREAM
	TP2D1-B	F/SA6.2	3/SA6.14	4/SA6.14
	TP3D1-B	C/SA6.2	3/SA6.14 (OH)	4/SA6.14 (OH)
	SP23D1-3	-	1/SA6.16	1/SA6.16
	GP2D3-B	F/SA6.2	1/SA6.7	2/SA6.7
	SP23D3	-	3/SA6.16	3/SA6.16
	GP3D3-B	C/SA6.2	1/SA6.7 (OH)	2/SA6.7 (OH)
	SP23D3-4	-	1/SA6.16	1/SA6.16
TRESTLE NO. 2 - COLUMN LINE "B"	CONNECTION ID	PLAN DETAILS	ELEV. DETAILS	
			UPSTREAM	DOWNSTREAM
	TP2D5-B	<div><div>1</div>C/SA6.10</div>	2/SA6.13 (OH)	2/SA6.13 (OH)
	SP23D5	-	5/SA6.16	5/SA6.16
	GP3D5-B	C/SA6.2	3/SA6.8	4/SA6.8
	SP23D5-6	-	1/SA6.17	1/SA6.17
	BP2B5-B	B/SA6.10	2/SA6.13 (OH)	
	SP23B5	-	5/SA6.16	
	GP3B5-B	B/SA6.2	3/SA6.8	
	SP23B5-6	-	1/SA6.17	
	BP3B6-B	B/SA6.10 (OH)	3/SA6.13	
TRESTLE NO. 3 - COLUMN LINE "A"	CONNECTION ID	PLAN DETAILS	ELEV. DETAILS	
			UPSTREAM	DOWNSTREAM
	TP4A1-B	D/SA6.2	4/SA6.14	3/SA6.14
	TP5A1-B	A/SA6.2	4/SA6.14 (OH)	3/SA6.14 (OH)
	SP45A1-3	-	1/SA6.16	1/SA6.16
	GP4A3-B	D/SA6.2	2/SA6.7	1/SA6.7
	SP45A3	-	3/SA6.16	3/SA6.16
	GP5A3-B	A/SA6.2	2/SA6.7 (OH)	1/SA6.7 (OH)
	SP45A3-4	-	1/SA6.16	1/SA6.16
	GP4A4-B	D/SA6.2	2/SA6.7	1/SA6.7
	SP45A4	-	3/SA6.16	3/SA6.16
TRESTLE NO. 3 - COLUMN LINE "B"	CONNECTION ID	PLAN DETAILS	ELEV. DETAILS	
			UPSTREAM	DOWNSTREAM
	TP4B1-B	E/SA6.2	3/SA6.14	
	TP5B1-B	B/SA6.2	3/SA6.14 (OH)	
	SP45B1-3	-	1/SA6.16	
	GP4B3-B	E/SA6.2	1/SA6.7	
	SP45B3	-	3/SA6.16	
	GP5B3-B	B/SA6.2	1/SA6.7 (OH)	
	SP45B3-4	-	1/SA6.16	
	GP4B4-B	E/SA6.2	1/SA6.7	
	SP45B4	-	3/SA6.16	
TRESTLE NO. 3 - COLUMN LINE "A"	CONNECTION ID	PLAN DETAILS	ELEV. DETAILS	
			UPSTREAM	DOWNSTREAM
	TP4A7-B	A/SA6.10	2/SA6.13 (OH)	2/SA6.13 (OH)
	SP45A7	-	2/SA6.16	2/SA6.16
	GP5A7-B	A/SA6.2	2/SA6.8	1/SA6.8
	SP45A7-8	-	4/SA6.16	4/SA6.16
	BP4A7-B	A/SA6.10	2/SA6.13 (OH)	2/SA6.13 (OH)
	SP45A7	-	2/SA6.16	2/SA6.16
	GP5A7-B	A/SA6.2	2/SA6.8	1/SA6.8
	SP45A7-8	-	4/SA6.16	4/SA6.16
	BP5A8-B	A/SA6.10 (OH)	3/SA6.13	3/SA6.13
TRESTLE NO. 3 - COLUMN LINE "B"	CONNECTION ID	PLAN DETAILS	ELEV. DETAILS	
			UPSTREAM	DOWNSTREAM
	TP4B5-B	E/SA6.2	1/SA6.7	
	SP45B5	-	3/SA6.16	
	GP5B5-B	B/SA6.2	1/SA6.7 (OH)	
	SP45B5-6	-	1/SA6.16	
	GP4B6-B	E/SA6.2	1/SA6.7	
	SP45B6	-	3/SA6.16	
	GP5B6-B	B/SA6.2	1/SA6.7 (OH)	
	SP45B6-7	-	1/SA6.16	
	BP4B7-B	B/SA6.10	2/SA6.13 (OH)	
TRESTLE NO. 3 - COLUMN LINE "B"	CONNECTION ID	PLAN DETAILS	ELEV. DETAILS	
			UPSTREAM	DOWNSTREAM
	TP4B7-B	B/SA6.10	2/SA6.13 (OH)	
	SP45B7	-	<div><div>1</div></div> 2/SA6.16	
	GP5B7-B	B/SA6.2	1/SA6.8	
	SP45B7-8	-	4/SA6.16	
	BP5B8-B	B/SA6.10 (OH)	3/SA6.13	


ORIGINAL PLAN	SURVEY PLOTTED BY	DATE
NOTE BOOK	DRAWN BY	
No.	DESIGNED BY	
	QUANTITIES BY	
	CHECKED BY	

DRAWING NAME: Z:\00_Ongoing\23-022-9-NANUE STR BR PF2-DOT\A\01 CAD\12-06-24 ADD\NSR-SA618-SA622 CON DTLS SCHD ADD2.DWG PLOT TIME: 12-03-24, 10:28 PM

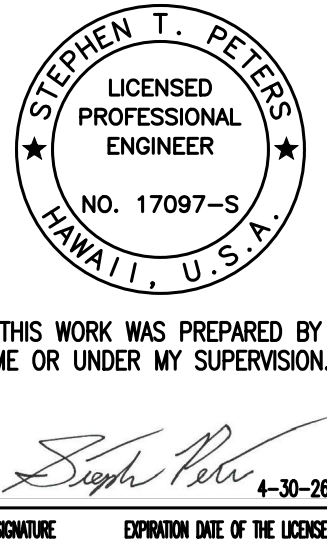

12/6/24	<div><div>1</div></div> Revised Table Values
DATE	REVISION
STATE OF HAWAII DEPARTMENT OF TRANSPORTATION HIGHWAYS DIVISION CONNECTION REFERENCE SCHEDULE HAWAII BELT ROAD Nanue Stream Bridge Rehabilitation Federal Aid Project No. BR-019-2(077) Scale: As Noted Date: Oct. 2024	
SHEET NoSA6.20 OF 22 SHEETS	

CONNECTION REFERENCE SCHEDULE

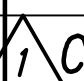TRESTLE NO. 3 - COLUMN LINE "C"	CONNECTION ID	PLAN DETAILS	ELEV. DETAILS	TRESTLE NO. 3 - COLUMN LINE "D"	CONNECTION ID	PLAN DETAILS	ELEV. DETAILS		TRESTLE NO. 4 - COLUMN LINE "A"	CONNECTION ID	PLAN DETAILS	ELEV. DETAILS	
							UPSTREAM	DOWNSTREAM				UPSTREAM	DOWNSTREAM
	TP4C1-B	E/SA6.2	3/SA6.14		TP4D1-B	F/SA6.2	3/SA6.14	4/SA6.14		TP6A1-B	D/SA6.2	4/SA6.14	3/SA6.14
	TP5C1-B	B/SA6.2	3/SA6.14 (OH)		TP5D1-B	C/SA6.2	3/SA6.14 (OH)	4/SA6.14 (OH)		TP7A1-B	A/SA6.2	4/SA6.14 (OH)	3/SA6.14 (OH)
	SP45C1-3	-	1/SA6.16		SP45D1-3	-	1/SA6.16	1/SA6.16		SP67A1-3	-	1/SA6.16	1/SA6.16
	GP4C3-B	E/SA6.2	1/SA6.7		GP4D3-B	F/SA6.2	1/SA6.7	2/SA6.7		GP6A3-B	D/SA6.2	2/SA6.7	1/SA6.7
	SP45C3	-	3/SA6.16		SP45D3	-	3/SA6.16	3/SA6.16		SP67A3	-	3/SA6.16	3/SA6.16
	GP5C3-B	B/SA6.2	1/SA6.7 (OH)		GP5D3-B	C/SA6.2	1/SA6.7 (OH)	2/SA6.7 (OH)		GP7A3-B	A/SA6.2	2/SA6.7 (OH)	1/SA6.7 (OH)
	SP45C3-4	-	1/SA6.16		SP45D3-4	-	1/SA6.16	1/SA6.16		SP67A3-4	-	1/SA6.16	1/SA6.16
	GP4C4-B	E/SA6.2	1/SA6.7		GP4D4-B	F/SA6.2	1/SA6.7	2/SA6.7		GP6A4-B	D/SA6.2	2/SA6.7	1/SA6.7
	SP45C4	-	3/SA6.16		SP45D4	-	3/SA6.16	3/SA6.16		SP67A4	-	3/SA6.16	3/SA6.16
	GP5C4-B	B/SA6.2	1/SA6.7 (OH)		GP5D4-B	C/SA6.2	1/SA6.7 (OH)	2/SA6.7 (OH)		GP7A4-B	A/SA6.2	2/SA6.7 (OH)	1/SA6.7 (OH)
	SP45C4-5	-	1/SA6.16		SP45D4-5	-	1/SA6.16	1/SA6.16		SP67A4-5	-	1/SA6.16	1/SA6.16
	GP4C5-B	E/SA6.2	1/SA6.7		GP4D5-B	F/SA6.2	1/SA6.7	2/SA6.7		GP6A5-B	D/SA6.2	2/SA6.7	1/SA6.7
	SP45C5	-	3/SA6.16		SP45D5	-	3/SA6.16	3/SA6.16		SP67A5	-	3/SA6.16	3/SA6.16
	GP5C5-B	B/SA6.2	1/SA6.7 (OH)		GP5D5-B	C/SA6.2	1/SA6.7 (OH)	2/SA6.7 (OH)		GP7A5-B	A/SA6.2	2/SA6.7 (OH)	1/SA6.7 (OH)
	SP45C5-6	-	1/SA6.16		SP45D5-6	-	1/SA6.16	1/SA6.16		SP67A5-6	-	1/SA6.16	1/SA6.16
	GP4C6-B	E/SA6.2	1/SA6.7		GP4D6-B	F/SA6.2	1/SA6.7	2/SA6.7		GP6A6-B	D/SA6.2	2/SA6.7	1/SA6.7
	SP45C6	-	3/SA6.16		SP45D6	-	3/SA6.16	3/SA6.16		SP67A6	-	3/SA6.16	3/SA6.16
	GP5C6-B	B/SA6.2	1/SA6.7 (OH)		GP5D6-B	C/SA6.2	1/SA6.7 (OH)	2/SA6.7 (OH)		BP7A6-B	A/SA6.10 (OH)	2/SA6.13	2/SA6.13
SP45C6-7	-	1/SA6.16	SP45D6-7	-	1/SA6.16	1/SA6.16							
BP4C7-B	B/SA6.10	2/SA6.13 (OH)	BP4D7-B	 C/SA6.10	2/SA6.13 (OH)	2/SA6.13 (OH)	GP6A7-B	D/SA6.2	2/SA6.9	1/SA6.9			
SP45C7	-	2/SA6.16	SP45D7	-	2/SA6.16	2/SA6.16	SP67A6-7	-	2/SA6.17	2/SA6.17			
GP5C7-B	B/SA6.2	1/SA6.8	GP5D7-B	C/SA6.2	1/SA6.8	2/SA6.8							
SP45C7-8	-	4/SA6.16	SP45D7-8	-	4/SA6.16	4/SA6.16	BP6A8-B	A/SA6.10	3/SA6.13 (OH)	3/SA6.13 (OH)			
							</						

TRESTLE NO. 4 - COLUMN LINE "B"	CONNECTION ID	PLAN DETAILS	ELEV. DETAILS
	TP6B1-B	E/SA6.2	3/SA6.14
	TP7B1-B	B/SA6.2	3/SA6.14 (OH)
	SP67B1-3	-	1/SA6.16
	GP6B3-B	E/SA6.2	1/SA6.7
	SP67B3	-	3/SA6.16
	GP7B3-B	B/SA6.2	1/SA6.7 (OH)
	SP67B3-4	-	1/SA6.16
	GP6B4-B	E/SA6.2	1/SA6.7
	SP67B4	-	3/SA6.16
	GP7B4-B	B/SA6.2	1/SA6.7 (OH)
	SP67B4-5	-	1/SA6.16
	GP6B5-B	E/SA6.2	1/SA6.7
	SP67B5	-	3/SA6.16
	GP7B5-B	B/SA6.2	1/SA6.7 (OH)
	SP67B5-6	-	1/SA6.16
	GP6B6-B	E/SA6.2	1/SA6.7
	SP67B6	-	3/SA6.16
	BP7B6-B	B/SA6.10 (OH)	2/SA6.13
	GP6B7-B	E/SA6.2	1/SA6.9
	SP67B6-7	-	2/SA6.17

ORIGINAL PLAN	SURVEY PLOTTED BY	DATE
NOTE BOOK	DRAWN BY	
No.	DESIGNED BY	
	QUANTITIES BY	
	CHECKED BY	

DRAWING NAME: Z:\00_OINGONG\23-022-9-NANUE STR BR PF2-DOT\A\01 CAD\12-06-24 ADD\NSR-SA618-SA622 CON DTLS SCHD ADD2.DWG PLOT TIME: 12-03-24, 10:28 PM

STEPHEN T. PETERS

LICENSED PROFESSIONAL ENGINEER

NO. 17097-S

HAWAII, U.S.A.

THIS WORK WAS PREPARED BY ME OR UNDER MY SUPERVISION.

Signature

4-30-26

SIGNATURE EXPIRATION DATE OF THE LICENSE

12/6/24	1 Revised Table Values
DATE	REVISION

STATE OF HAWAII

DEPARTMENT OF TRANSPORTATION

HIGHWAYS DIVISION

CONNECTION REFERENCE SCHEDULE

HAWAII BELT ROAD

Nanue Stream Bridge Rehabilitation

Federal Aid Project No. BR-019-2(077)

Scale: As Noted

Date: Oct. 2024


SHEET No.SA6.2I OF 22 SHEETS


CONNECTION REFERENCE SCHEDULE


	CONNECTION ID	PLAN DETAILS	ELEV. DETAILS			CONNECTION ID	PLAN DETAILS	ELEV. DETAILS			CONNECTION ID	PLAN DETAILS	ELEV. DETAILS			CONNECTION ID	PLAN DETAILS	ELEV. DETAILS				
								UPSTREAM	DOWNSTREAM				UPSTREAM	DOWNSTREAM								
TRESTLE NO. 4 - COLUMN LINE "C"	TP6C1-B	E/SA6.2	3/SA6.14	TRESTLE NO. 4 - COLUMN LINE "D"	TP6D1-B	F/SA6.2	3/SA6.14	4/SA6.14	TRESTLE NO. 5 - COLUMN LINE "A"	TP8A1-B	D/SA6.2	4/SA6.14	3/SA6.14	TRESTLE NO. 5 - COLUMN LINE "C"	TP8C1-B	E/SA6.2	3/SA6.14	TRESTLE NO. 5 - COLUMN LINE "D"	CONNECTION ID	PLAN DETAILS	ELEV. DETAILS	
	TP7C1-B	B/SA6.2	3/SA6.14 (OH)		TP7D1-B	C/SA6.2	3/SA6.14 (OH)	4/SA6.14 (OH)		TP9A1-B	A/SA6.2	4/SA6.14 (OH)	3/SA6.14 (OH)		TP9C1-B	B/SA6.2	3/SA6.14 (OH)					
	SP67C1-3	-	1/SA6.16		SP67D1-3	-	1/SA6.16	1/SA6.16		SP89A1-3	-	1/SA6.16	1/SA6.16		SP89C1-3	-	1/SA6.16					
	GP6C3-B	E/SA6.2	1/SA6.7		GP6D3-B	F/SA6.2	1/SA6.7	2/SA6.7		GP8A3-B	D/SA6.2	2/SA6.8 (OH)	1/SA6.8 (OH)		GP8C3-B	E/SA6.2	1/SA6.8 (OH)					
	SP67C3	-	3/SA6.16		SP67D3	-	3/SA6.16	3/SA6.16		SP89A3	-	2/SA6.16 (OH)	2/SA6.16 (OH)		SP89C3	-	2/SA6.16 (OH)					
	GP7C3-B	B/SA6.2	1/SA6.7 (OH)		GP7D3-B	C/SA6.2	1/SA6.7 (OH)	2/SA6.7 (OH)		BP9A3-B	A/SA6.10 (OH)	2/SA6.13	2/SA6.13		BP9C3-B	B/SA6.10 (OH)	2/SA6.13					
	SP67C3-4	-	1/SA6.16		SP67D3-4	-	1/SA6.16	1/SA6.16		SP89A3-4	-	4/SA6.16 (OH)	4/SA6.16 (OH)		SP89C3-4	-	4/SA6.16 (OH)					
	GP6C4-B	E/SA6.2	1/SA6.7		GP6D4-B	F/SA6.2	1/SA6.7	2/SA6.7		BP8A4-B	A/SA6.10	3/SA6.13 (OH)	3/SA6.13 (OH)		BP8C4-B	B/SA6.10	3/SA6.13 (OH)					
	SP67C4	-	3/SA6.16		SP67D4	-	3/SA6.16	3/SA6.16														
	GP7C4-B	B/SA6.2	1/SA6.7 (OH)		GP7D4-B	C/SA6.2	1/SA6.7 (OH)	2/SA6.7 (OH)														
	SP67C4-5	-	1/SA6.16		SP67D4-5	-	1/SA6.16	1/SA6.16														
	GP6C5-B	E/SA6.2	1/SA6.7		GP6D5-B	F/SA6.2	1/SA6.7	2/SA6.7														
	SP67C5	-	3/SA6.16		SP67D5	-	3/SA6.16	3/SA6.16														
	GP7C5-B	B/SA6.2	1/SA6.7 (OH)		GP7D5-B	C/SA6.2	1/SA6.7 (OH)	2/SA6.7 (OH)														
	SP67C5-6	-	1/SA6.16		SP67D5-6	-	1/SA6.16	1/SA6.16														
	GP6C6-B	E/SA6.2	1/SA6.7		GP6D6-B	F/SA6.2	1/SA6.7	2/SA6.7														
	SP67C6	-	3/SA6.16		SP67D6	-	3/SA6.16	3/SA6.16														
	BP7C6-B	B/SA6.10 (OH)	2/SA6.13		BP7D6-B	C/SA6.10 (OH)	2/SA6.13	2/SA6.13														
	GP6C7-B	E/SA6.2	1/SA6.9		GP6D7-B	F/SA6.2	1/SA6.9	2/SA6.9														
	SP67C6-7	-	2/SA6.17		SP67D6-7	-	2/SA6.17	2/SA6.17														
	BP6C8-B	B/SA6.10	3/SA6.13 (OH)		BP6D8-B	C/SA6.10	3/SA6.13 (OH)	3/SA6.13 (OH)														

ORIGINAL PLAN	SURVEY PLOTTED BY	DATE
NOTE BOOK	DRAWN BY	
	DESIGNED BY	
	QUANTITIES BY	
	CHECKED BY	
No.		

DRAWING NAME: Z:\00 ONGOING\23-022-9-NANUE STR BR PF2-DOT\A\01 CAD\12-06-24 ADD\NSR-SA618-SA622 CON DTLS SCHD ADD2.DWG PLOT TIME: 12-03-24, 10:29 PM

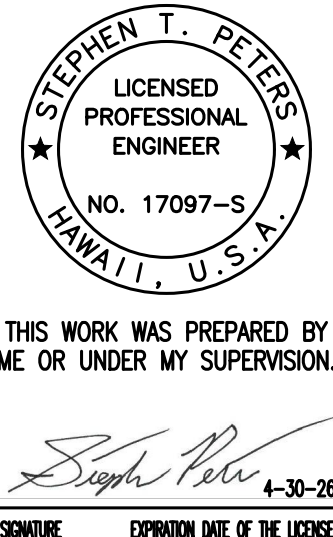

12/6/24		Revised Table Values
DATE	REVISION	
STATE OF HAWAII DEPARTMENT OF TRANSPORTATION HIGHWAYS DIVISION <u>CONNECTION REFERENCE</u> <u>SCHEDULE</u> <u>HAWAII BELT ROAD</u> <u>Nanue Stream Bridge Rehabilitation</u> <u>Federal Aid Project No. BR-019-2(077)</u> Scale: As Noted Date: Oct. 2024		

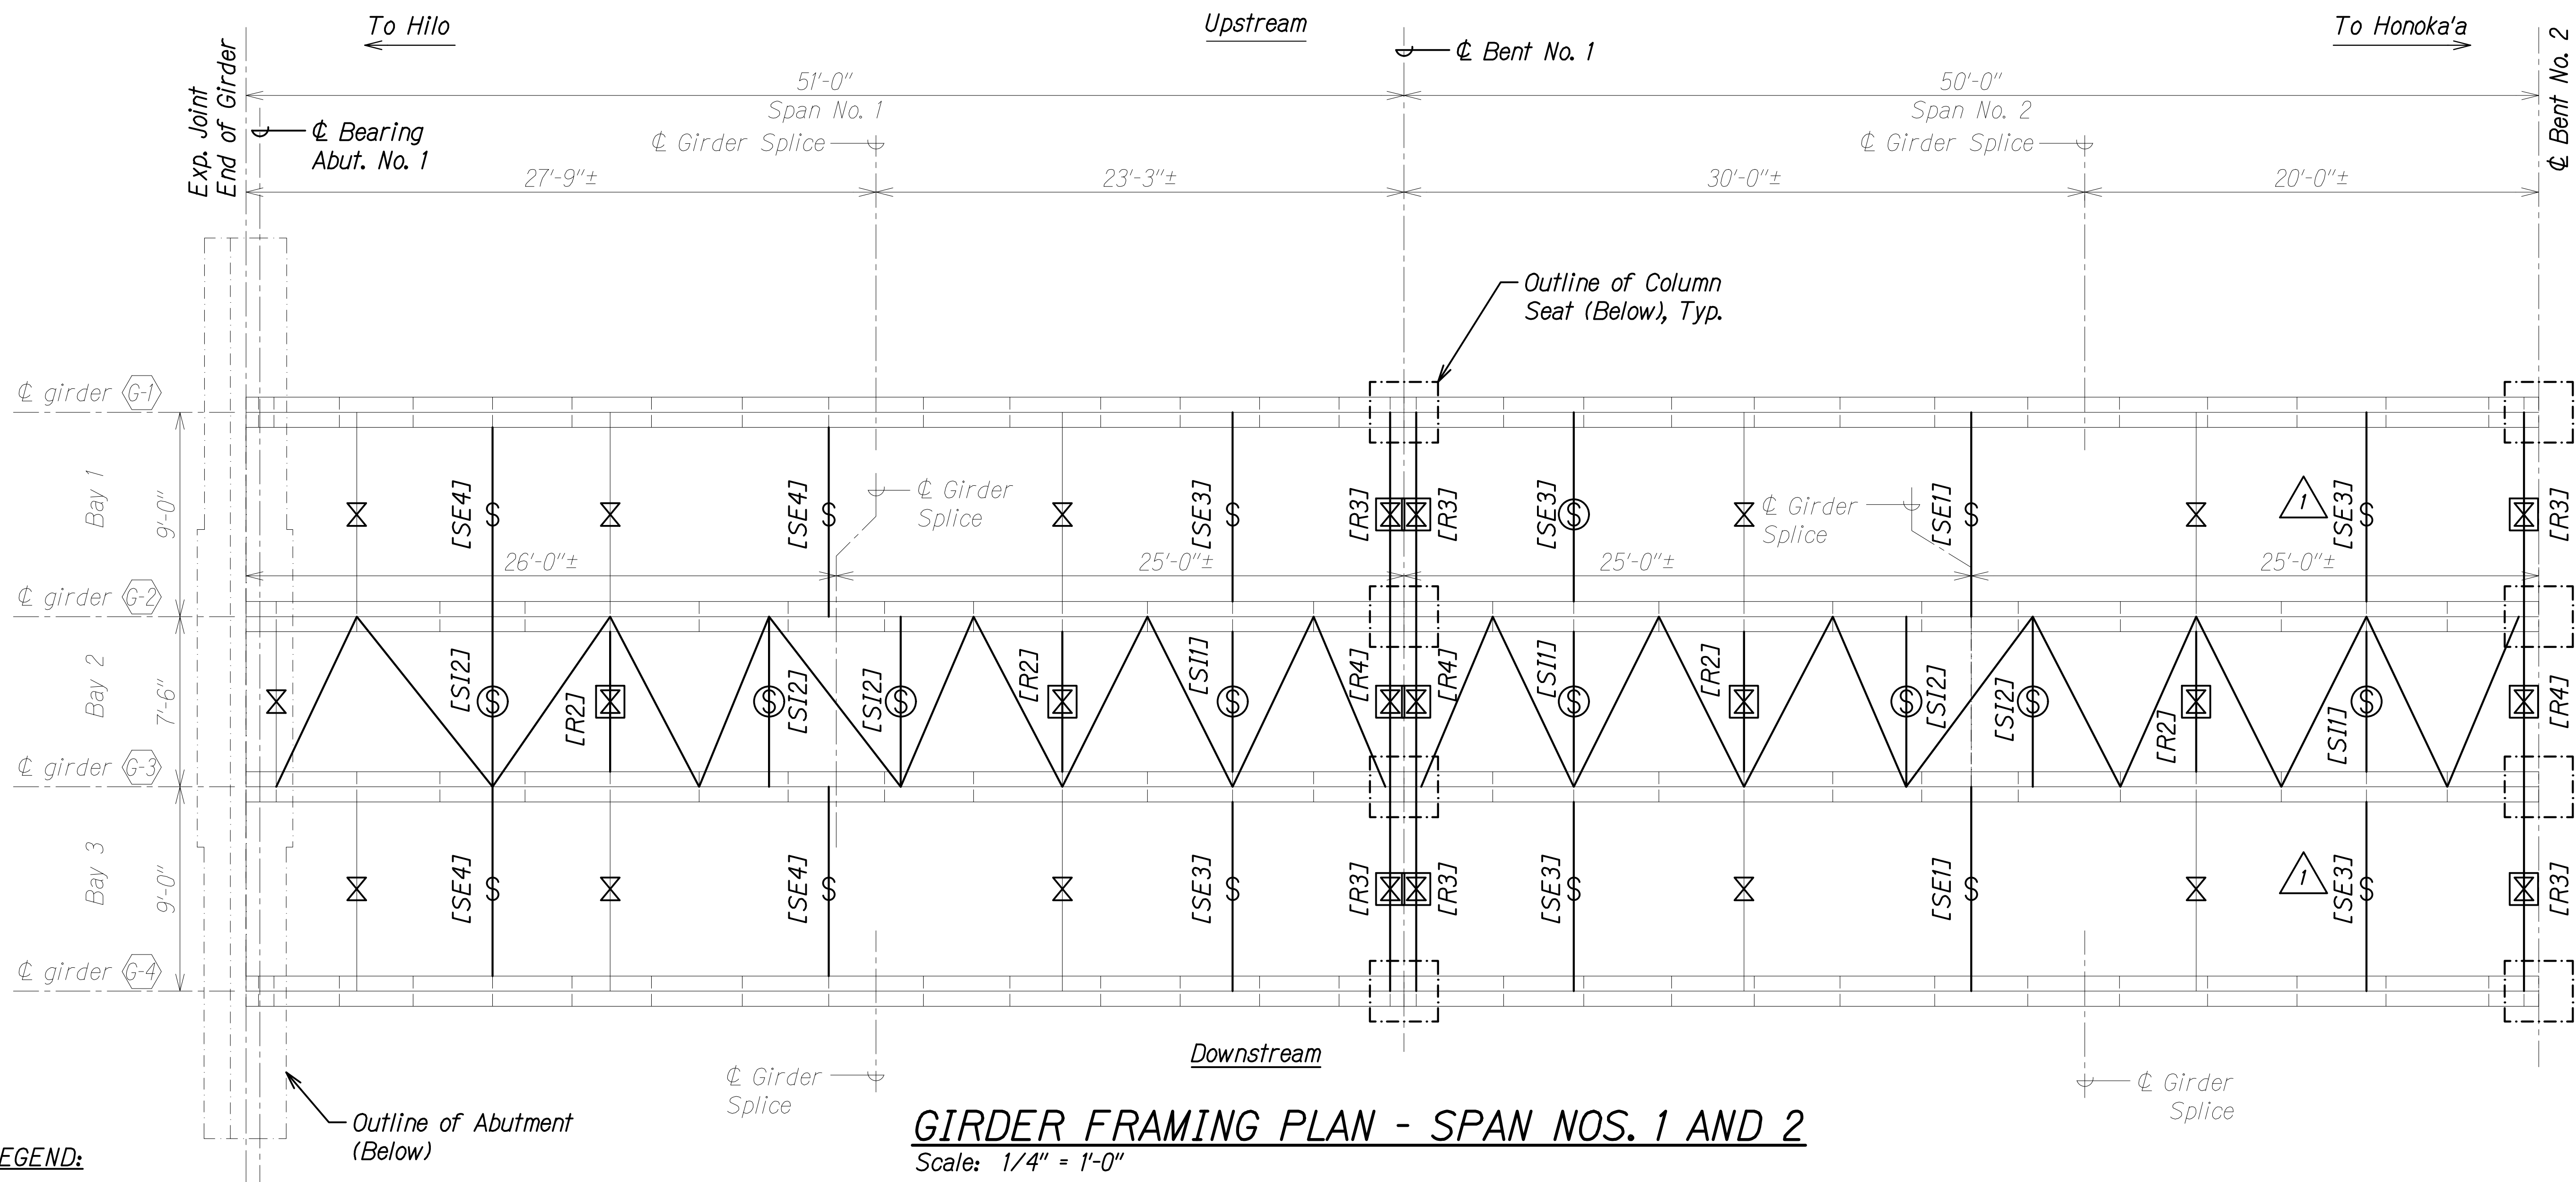

LEGEND:

- Exist. Cross Frame to Remain
- Exist. Cross Frame to be Removed and Replaced
- Exist. Strut to be Removed and Replaced
- New Strut
- New Lateral Diagonal Bracing at Bottom Flange, See Sheet SA10.21 through SA10.24

[] Cross Frame or Strut Mark, See Table


NOTES:

- Cross Frames, Struts, Stiffeners and Lateral Bracing locations to be verified by Contractor.
- Provided dimensions are based on As-Built plans.

GIRDER FRAMING PLAN - SPAN NOS. 1 AND 2
Scale: 1/4" = 1'-0"

INSTALLATION OF MEMBERS AND CONNECTIONS


MARK	REFERENCE	MARK	REFERENCE
SE1	Section A / SA10.12	R3	Section C / SA10.14
SE3	Section C / SA10.12	R4	Section D / SA10.14
SE4	Section D / SA10.12	-	-
SI1	Section A / SA10.13	-	-
SI2	Section B / SA10.13	-	-
R2	Section B / SA10.14	-	-

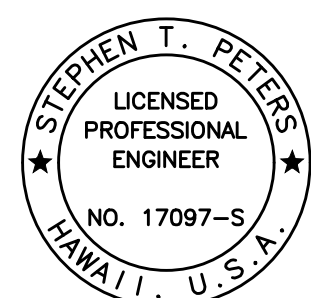

THIS WORK WAS PREPARED BY
ME OR UNDER MY SUPERVISION.
Stephen T. Peters
SIGNATURE EXPIRATION DATE OF THE LICENSE 4-30-26

12/6/24	1 Revised Callouts
DATE	REVISION
STATE OF HAWAII DEPARTMENT OF TRANSPORTATION HIGHWAYS DIVISION GIRDER FRAMING PLAN - SPAN NOS. 1 AND 2 HAWAII BELT ROAD Nanue Stream Bridge Rehabilitation Federal Aid Project No. BR-019-2(077) Scale: As Noted Date: Oct. 2024	

FED. ROAD DIST. NO.	STATE	FEDERAL AID PROJ. NO.	FISCAL YEAR	SHEET NO.	TOTAL SHEETS
HAWAII	HAW.	BR-019-2(077)	2024	ADD. 168	280

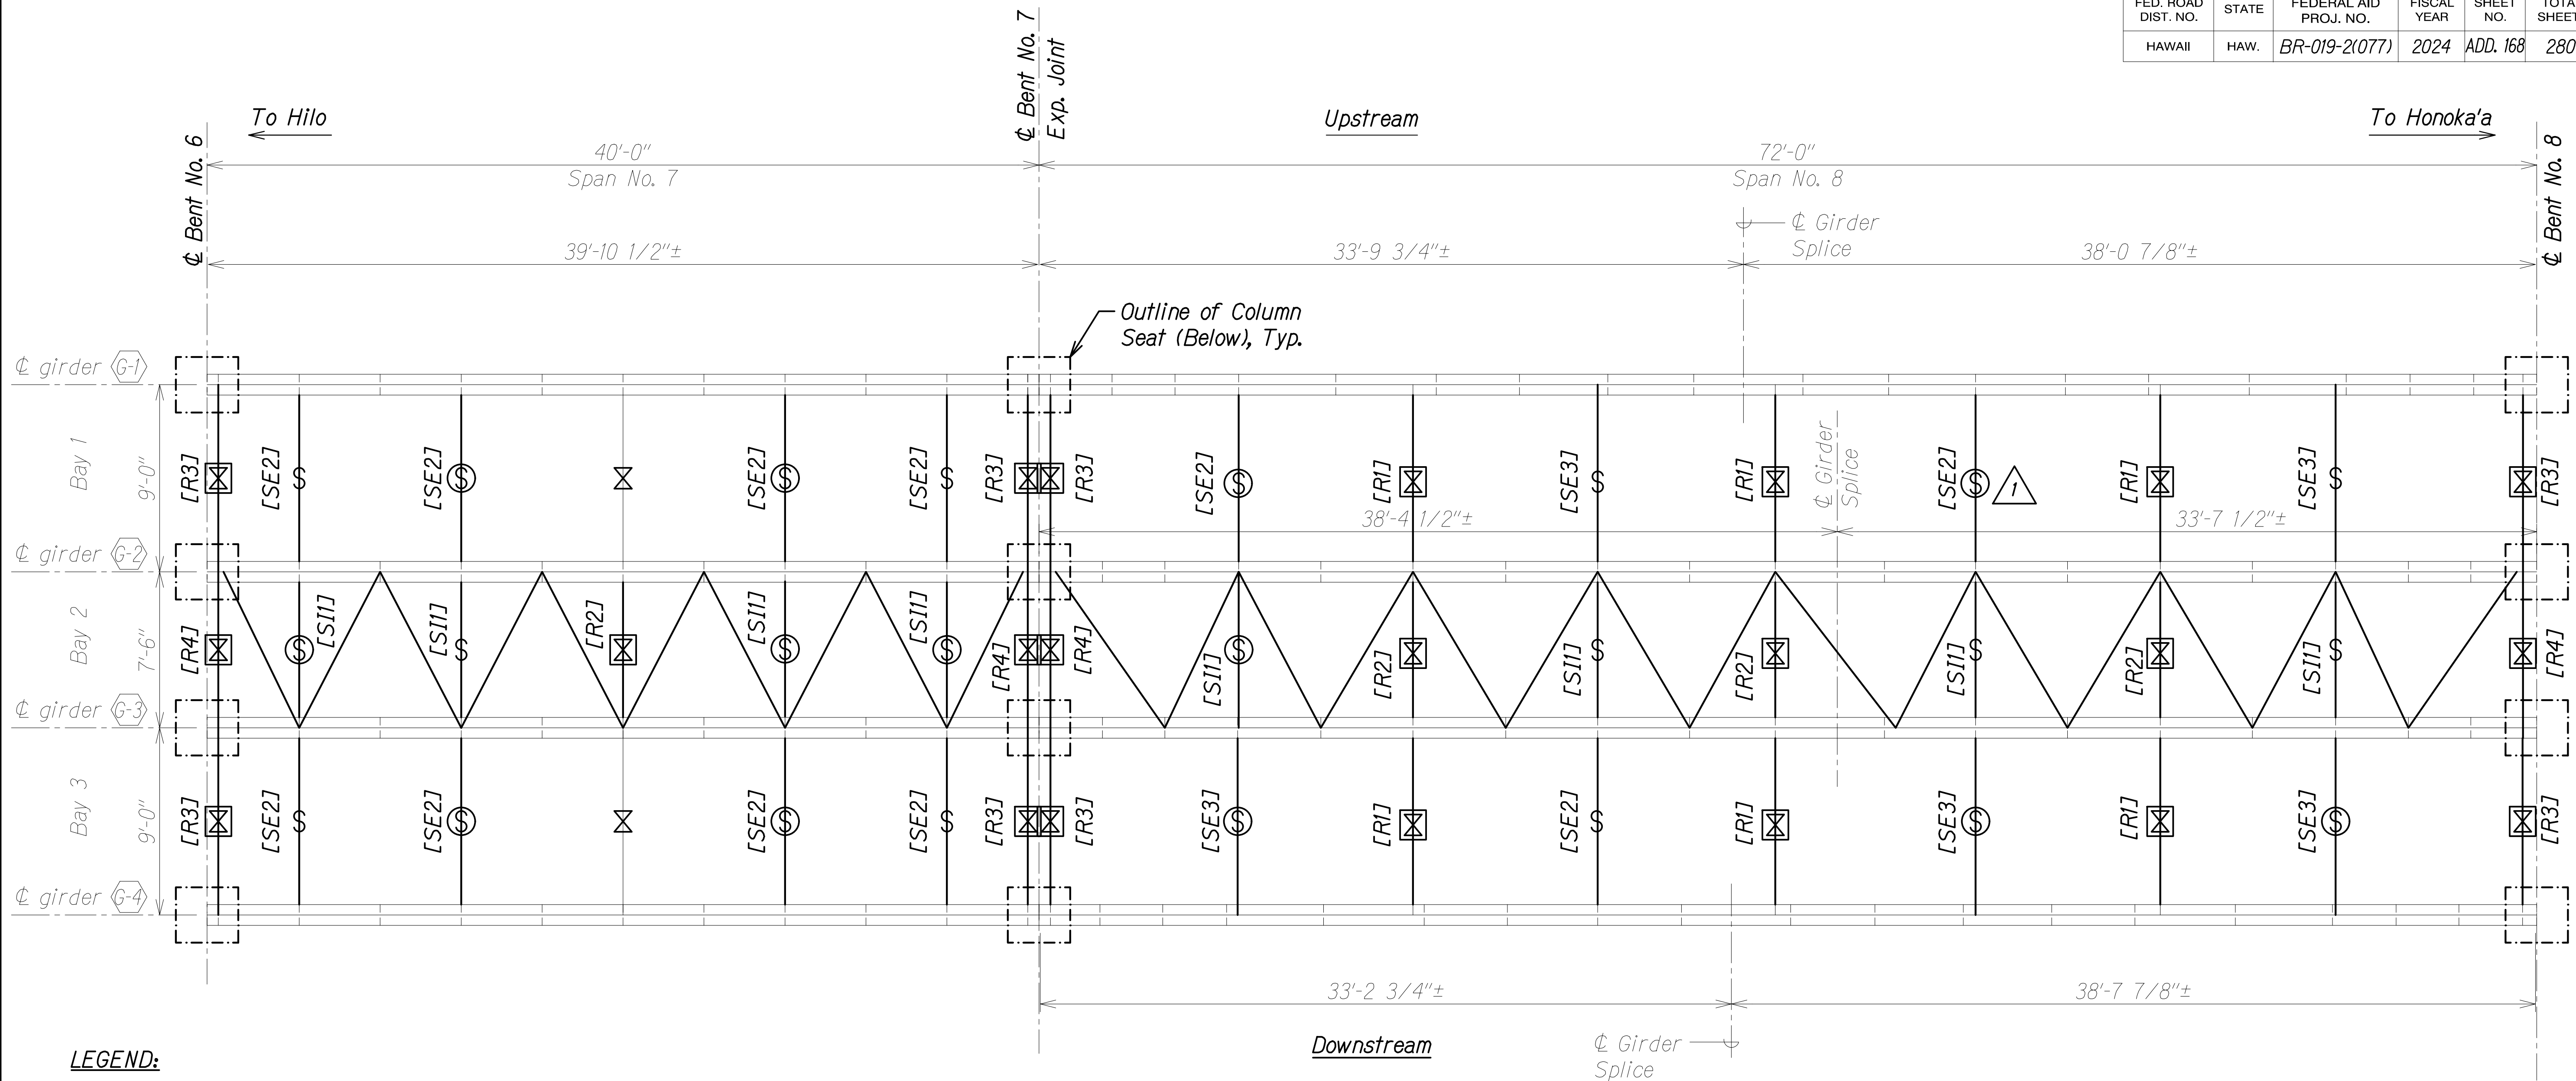

LEGEND:

- Exist. Cross Frame to Remain
- Exist. Cross Frame to be Removed and Replaced
- Exist. Strut to be Removed and Replaced
- New Strut
- New Lateral Diagonal Bracing at Bottom Flange, See Sheet SA10.21 through SA10.24
- Cross Frame or Strut Mark, See Table


NOTES:

- Cross Frames, Struts, Stiffeners and Lateral Bracing locations to be verified by Contractor.
- Provided dimensions are based on As-Built plans.

GIRDER FRAMING PLAN - SPAN NOS. 7 AND 8

Scale: 1/4" = 1'-0"

INSTALLATION OF MEMBERS AND CONNECTIONS			
MARK	REFERENCE	MARK	REFERENCE
SE2	Section B / SA10.12	R1	Section A / SA10.14
SE3	Section C / SA10.12	R2	Section B / SA10.14
SI1	Section A / SA10.13	R3	Section C / SA10.14
-	-	R4	Section D / SA10.14

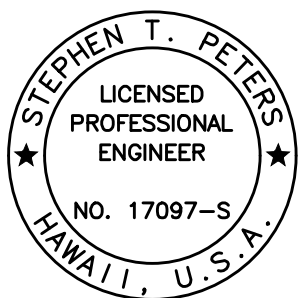

THIS WORK WAS PREPARED BY ME OR UNDER MY SUPERVISION.

SIGNATURE: *Stephen T. Peters* 4-30-26
EXPIRATION DATE OF THE LICENSE

STATE OF HAWAII
DEPARTMENT OF TRANSPORTATION
HIGHWAYS DIVISION

**GIRDER FRAMING PLAN -
SPAN NOS. 7 AND 8**


HAWAII BELT ROAD
Nanue Stream Bridge Rehabilitation
Federal Aid Project No. BR-019-2(077)

Scale: As Noted Date: Oct. 2024

SHEET No. SA9.9 OF 23 SHEETS

12/6/24	1	Revised Callouts
DATE	REVISION	

FED. ROAD DIST. NO.	STATE	FEDERAL AID PROJ. NO.	FISCAL YEAR	SHEET NO.	TOTAL SHEETS
HAWAII	HAW.	BR-019-2(077)	2024	ADD. 170	280

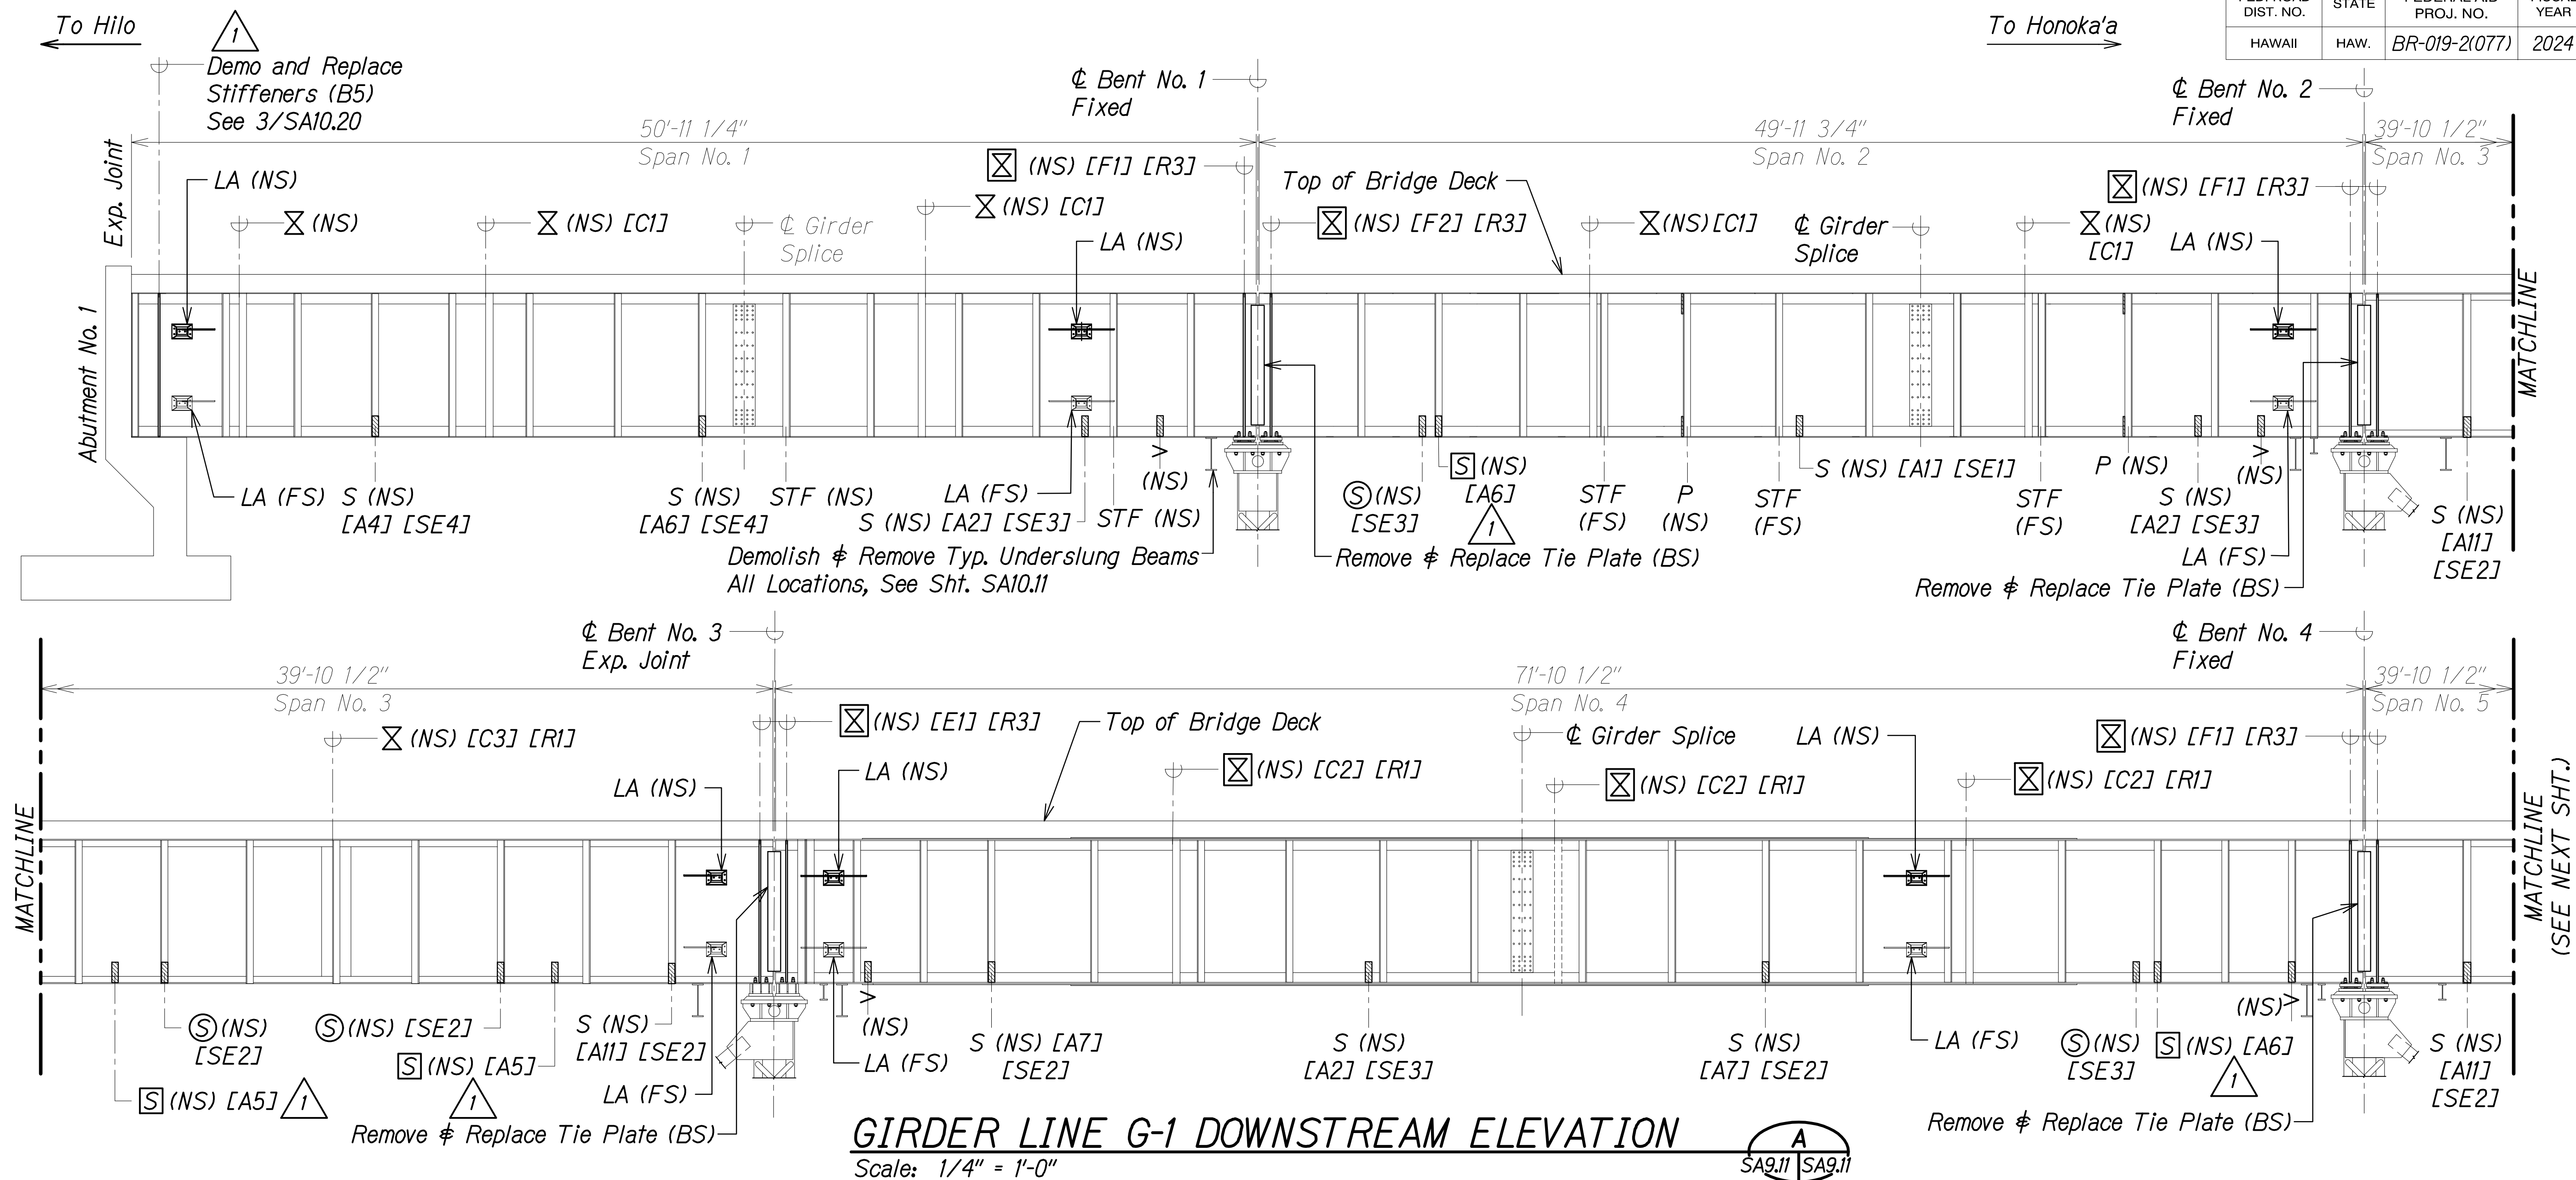

GIRDER LINE G-1 DOWNSTREAM ELEVATION

Scale: 1/4" = 1'-0"

A
SA9.11 SA9.11

LEGEND:

LA Lifeline Anchor,
See Sheet SA10.27

X Cross Frame

BS Both Sides

FS Far Side

NS Near Side

S New Strut

S Exist. Strut to be Removed
and Replaced

S Exist. Strut to be Removed

X Cross Frame to be Removed
and Replaced

STF Deformed Stiffener to be
Repaired, See Structural
General Note 5.AB.

P Plates to be Removed from
Stiffener Location. Plug Weld
Resulting Holes

A Exist. Angle Iron to be
Removed, See Detail 1/SA10.11

Δ Exist. Ancillary Flange Tab to
be Removed, See Detail
3/SA10.11

DEMOLITION OF MEMBERS & CONNECTIONS


MARK	REFERENCE
A1	Section A / SA10.1
A2	Section B / SA10.1
A4	Section D / SA10.1
A5	Section A / SA10.2
A6	Section B / SA10.2
A7	Section C / SA10.2
A11	Section C / SA10.3
C1	Section A / SA10.6
C2	Section B / SA10.6
C3	Section C / SA10.6
E1	Section A / SA10.8
F1	Section A / SA10.9
F2	Section B / SA10.9

INSTALLATION OF MEMBERS & CONN.

MARK	REFERENCE
SE1	Section A / SA10.12
SE2	Section B / SA10.12
SE3	Section C / SA10.12
SE4	Section D / SA10.12
R1	Section A / SA10.14
R3	Section C / SA10.14

NOTES:

- The gap between the ends of the girders at the bents is 1 1/2" according to As-Built drawings. See Sheets SA10.10 and SA10.25 for tie plate details.
- Struts are shown hatched for clarity.
- Replace bearing stiffeners at all locations EF of girder. See Sheet SA10.20.

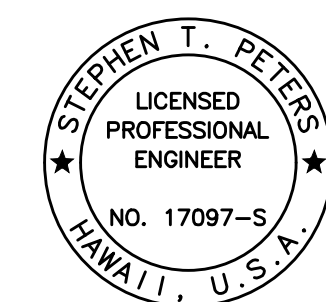

THIS WORK WAS PREPARED BY
ME OR UNDER MY SUPERVISION.

SIGNATURE: *Stephen T. Peters*
EXPIRATION DATE OF THE LICENSE: 4-30-26

STATE OF HAWAII
DEPARTMENT OF TRANSPORTATION
HIGHWAYS DIVISION

**GIRDER LINE G-1
DOWNSTREAM ELEVATION**


HAWAII BELT ROAD
Nanue Stream Bridge Rehabilitation
Federal Aid Project No. BR-019-2(077)

Scale: As Noted Date: Oct. 2024

SHEET No. SA9.11 OF 23 SHEETS

DRAWING NAME: Z:\00 ONGOING\23-022-9-NANUE STR BR PF2-DOT\A.01 CAD\12-06-24 ADD\NSR-SA0911-SA0922 GIRDER ELEV ADD2.DWG PLOT TIME: 12-04-24 3:25 PM

ORIGINAL PLAN	DATE
DRAWN BY	
DESIGNED BY	
NOTED BY	
QUANTITIES BY	
CHECKED BY	

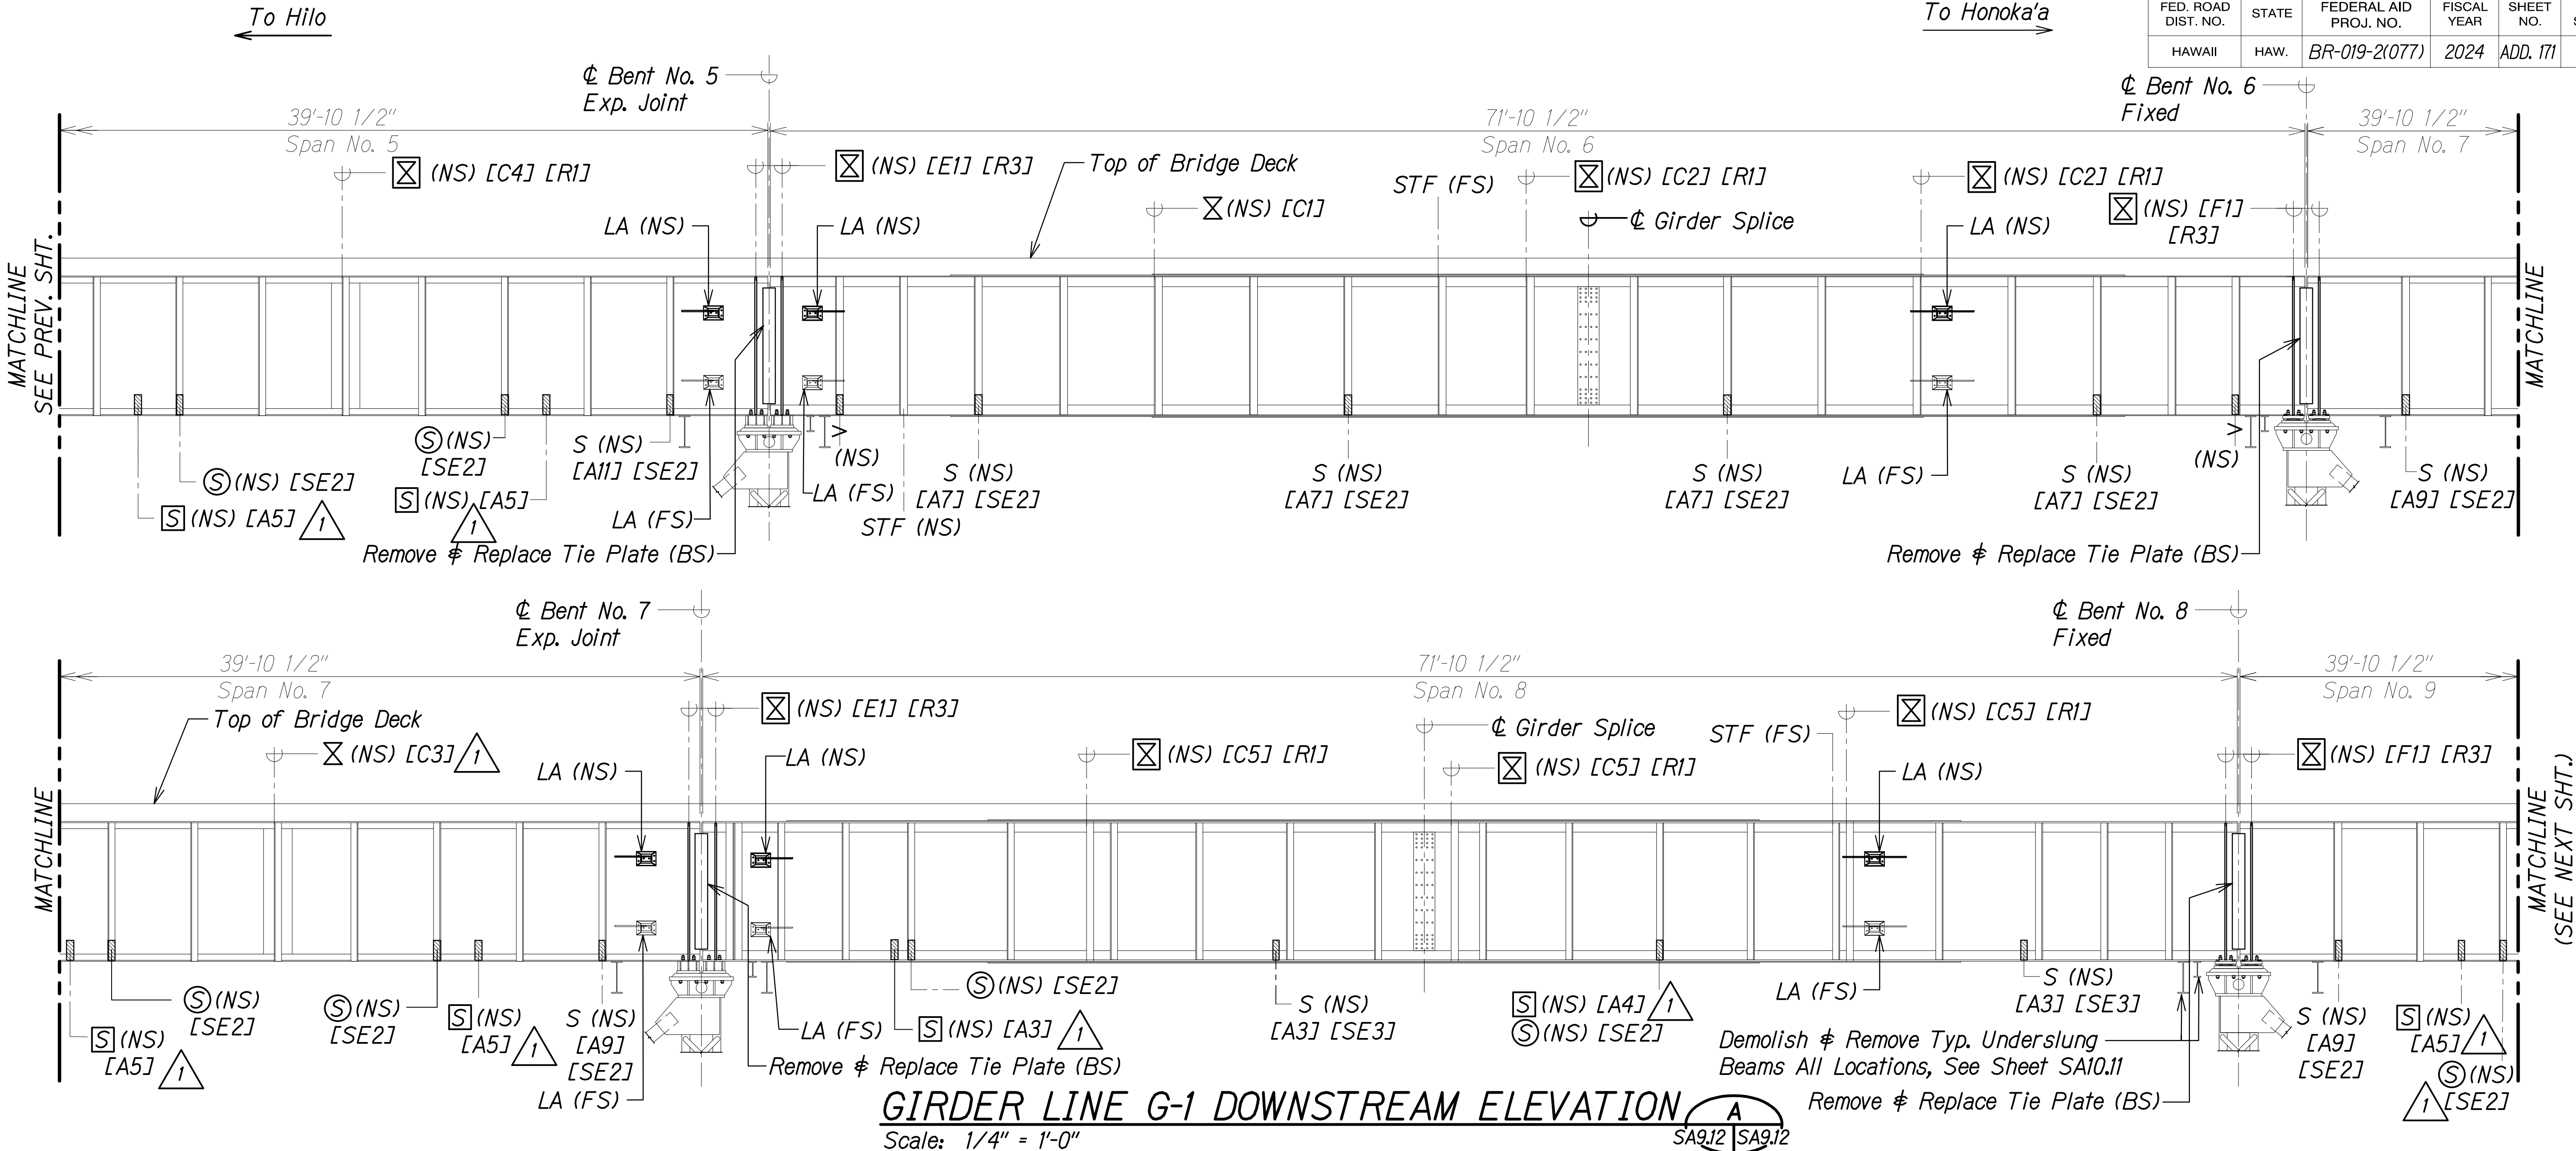

LEGEND:

- LA Lifeline Anchor, See Sheet SA10.27
- ⊗ Cross Frame
- BS Both Sides
- FS Far Side
- NS Near Side
- ⊙ New Strut
- S Exist. Strut to be Removed and Replaced
- ⊠ Exist. Strut to be Removed
- ⊡ Cross Frame to be Removed and Replaced

- STF Deformed Stiffener to be Repaired, See Structural General Note 5.AB.
- P Plates to be Removed from Stiffener Location. Plug Weld Resulting Holes
- ⊢ Exist. Angle Iron to be Removed, See Detail 1/SA10.11
- △ Exist. Ancillary Flange Tab to be Removed, See Detail 3/SA10.11

GIRDER LINE G-1 DOWNSTREAM ELEVATION


Scale: 1/4" = 1'-0"

DEMOLITION OF MEMBERS & CONNECTIONS	
MARK	REFERENCE
A3	Section C / SA10.1
A4	Section D / SA10.1
A5	Section A / SA10.2
A7	Section C / SA10.2
A9	Section A / SA10.3
A11	Section C / SA10.3
C1	Section A / SA10.6
C2	Section B / SA10.6
C3	Section C / SA10.6
C4	Section D / SA10.6
C5	Section E / SA10.6
E1	Section A / SA10.8
F1	Section A / SA10.9

INSTALLATION OF MEMBERS & CONN.	
MARK	REFERENCE
SE1	Section A / SA10.12
SE2	Section B / SA10.12
SE3	Section C / SA10.12
SE4	Section D / SA10.12
R1	Section A / SA10.14
R2	Section B / SA10.14
R3	Section C / SA10.14

NOTES:

- The gap between the ends of the girders at the bents is 1 1/2" according to As-Built drawings. See Sheets SA10.10 and SA10.25 for tie plate details.
- Struts are shown hatched for clarity.
- Replace bearing stiffeners at all locations EF of girder. See Sheet SA10.20.

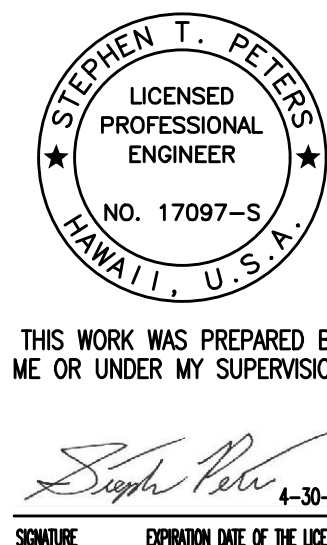

STATE OF HAWAII
DEPARTMENT OF TRANSPORTATION
HIGHWAYS DIVISION

**GIRDER LINE G-1
DOWNSTREAM ELEVATION**


HAWAII BELT ROAD
Nanue Stream Bridge Rehabilitation
Federal Aid Project No. BR-019-2(077)

Scale: As Noted Date: Oct. 2024

SHEET No. SA9.12 OF 23 SHEETS

12/6/24	1 Revised Callouts
DATE	REVISION

FED. ROAD DIST. NO.	STATE	FEDERAL AID PROJ. NO.	FISCAL YEAR	SHEET NO.	TOTAL SHEETS
HAWAII	HAW.	BR-019-2(077)	2024	ADD. 172	280

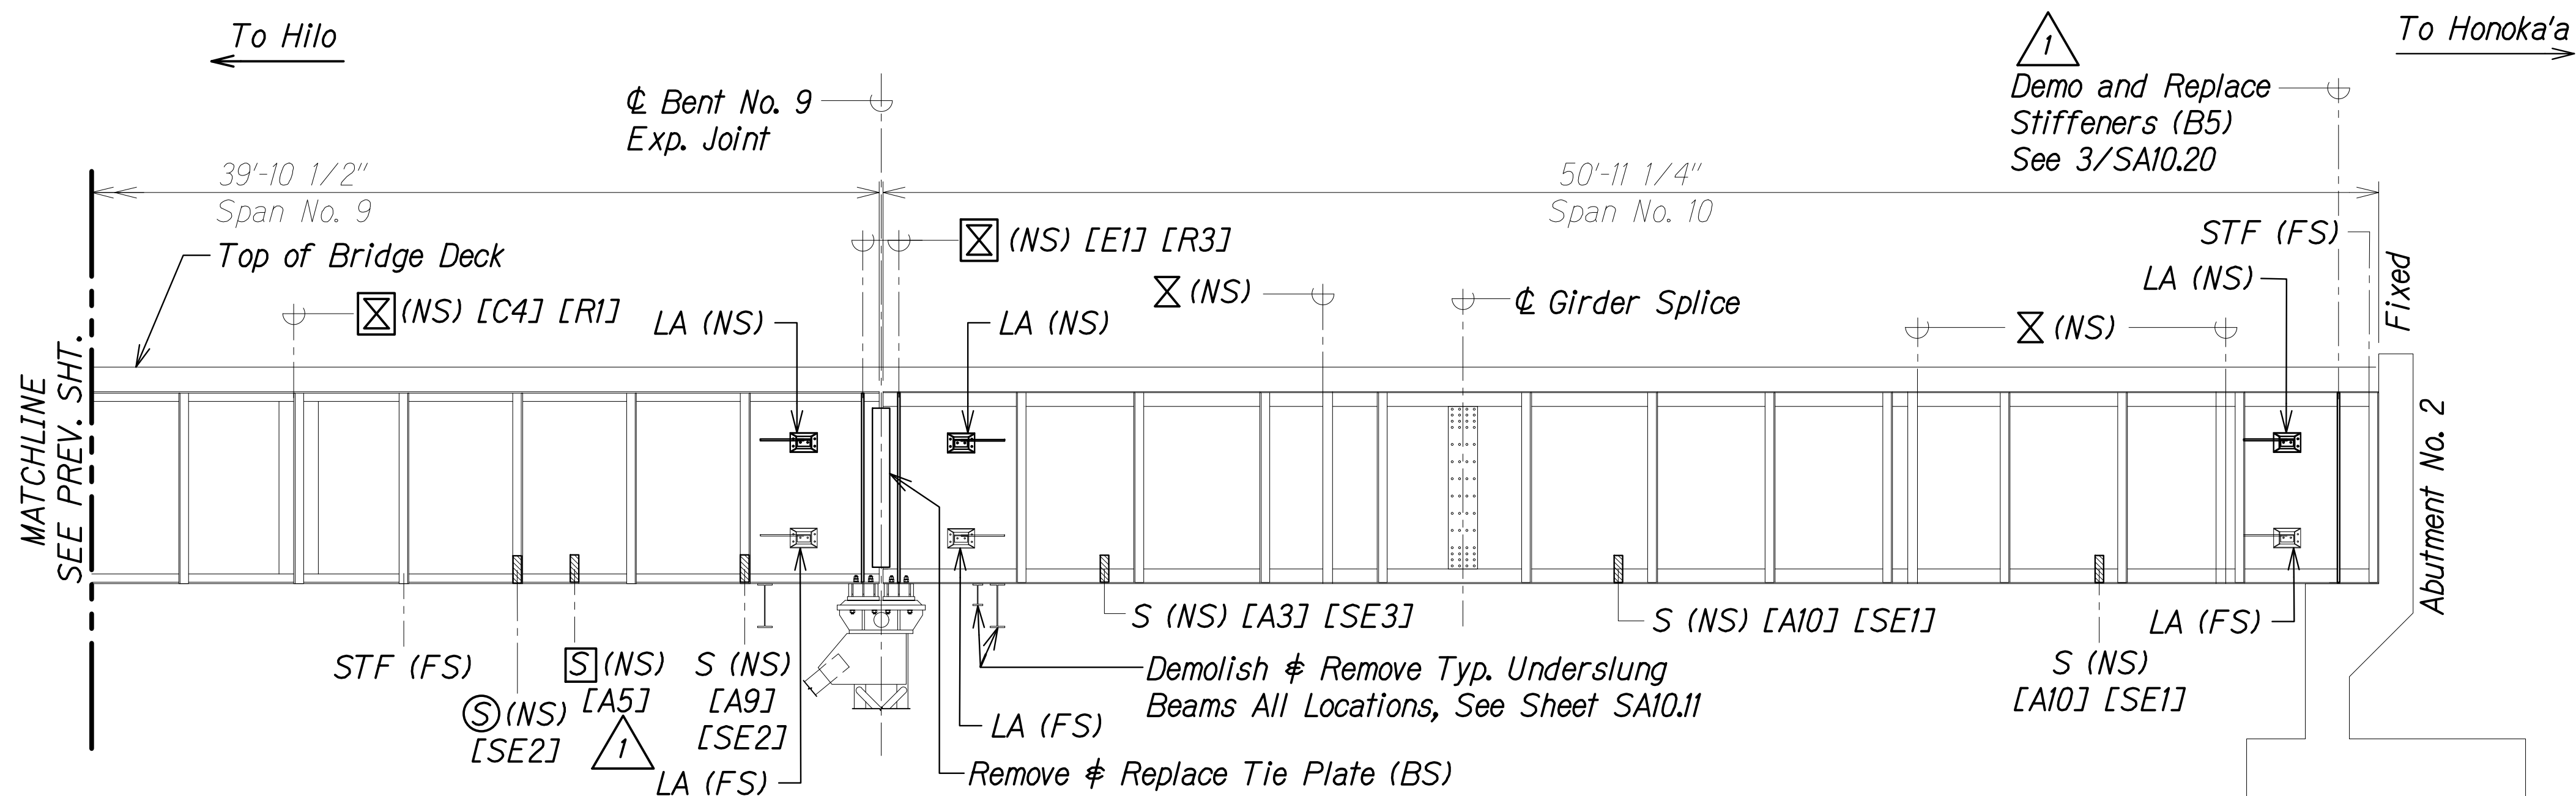

GIRDER LINE G-1
DOWNSTREAM ELEVATION
Scale: 1/4" = 1'-0" A
SA9.13 SA9.13

LEGEND:

LA Lifeline Anchor,
See Sheet SA10.27

⊗ Cross Frame

BS Both Sides

FS Far Side

NS Near Side

⊙ New Strut

S Exist. Strut to be Removed
and Replaced

⊠ Exist. Strut to be Removed

⊗ Cross Frame to be Removed
and Replaced

STF Deformed Stiffener to be
Repaired, See Structural
General Note 5.AB.

P Plates to be Removed from
Stiffener Location. Plug Weld
Resulting Holes

⌋ Exist. Angle Iron to be
Removed, See Detail 1/SA10.11


△ Exist. Ancillary Flange Tab to
be Removed, See Detail
3/SA10.11

DEMOLITION OF MEMBERS ⊗ CONNECTIONS	
MARK	REFERENCE
A3	Section C / SA10.1
A5	Section A / SA10.2
A9	Section A / SA10.3
A10	Section B / SA10.3
C4	Section D / SA10.6
E1	Section A / SA10.8


INSTALLATION OF MEMBERS ⊗ CONN.	
MARK	REFERENCE
SE1	Section A / SA10.12
SE2	Section B / SA10.12
SE3	Section C / SA10.12
R1	Section A / SA10.14
R3	Section C / SA10.14
R4	Section D / SA10.14

NOTES:

- The gap between the ends of the girders at the bents is 1 1/2" according to As-Built drawings. See Sheets SA10.10 and SA10.25 for tie plate details.
- Struts are shown hatched for clarity.
- Replace bearing stiffeners at all locations EF of girder. See Sheet SA10.20.

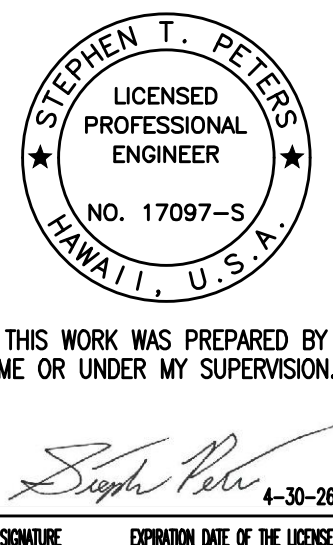

12/6/24	1 Revised Callouts
DATE	REVISION
STATE OF HAWAII DEPARTMENT OF TRANSPORTATION HIGHWAYS DIVISION GIRDER LINE G-1 DOWNSTREAM ELEVATION HAWAII BELT ROAD Nanue Stream Bridge Rehabilitation Federal Aid Project No. BR-019-2(077) Scale: As Noted Date: Oct. 2024	
SHEET No. SA9.13 OF 23 SHEETS	

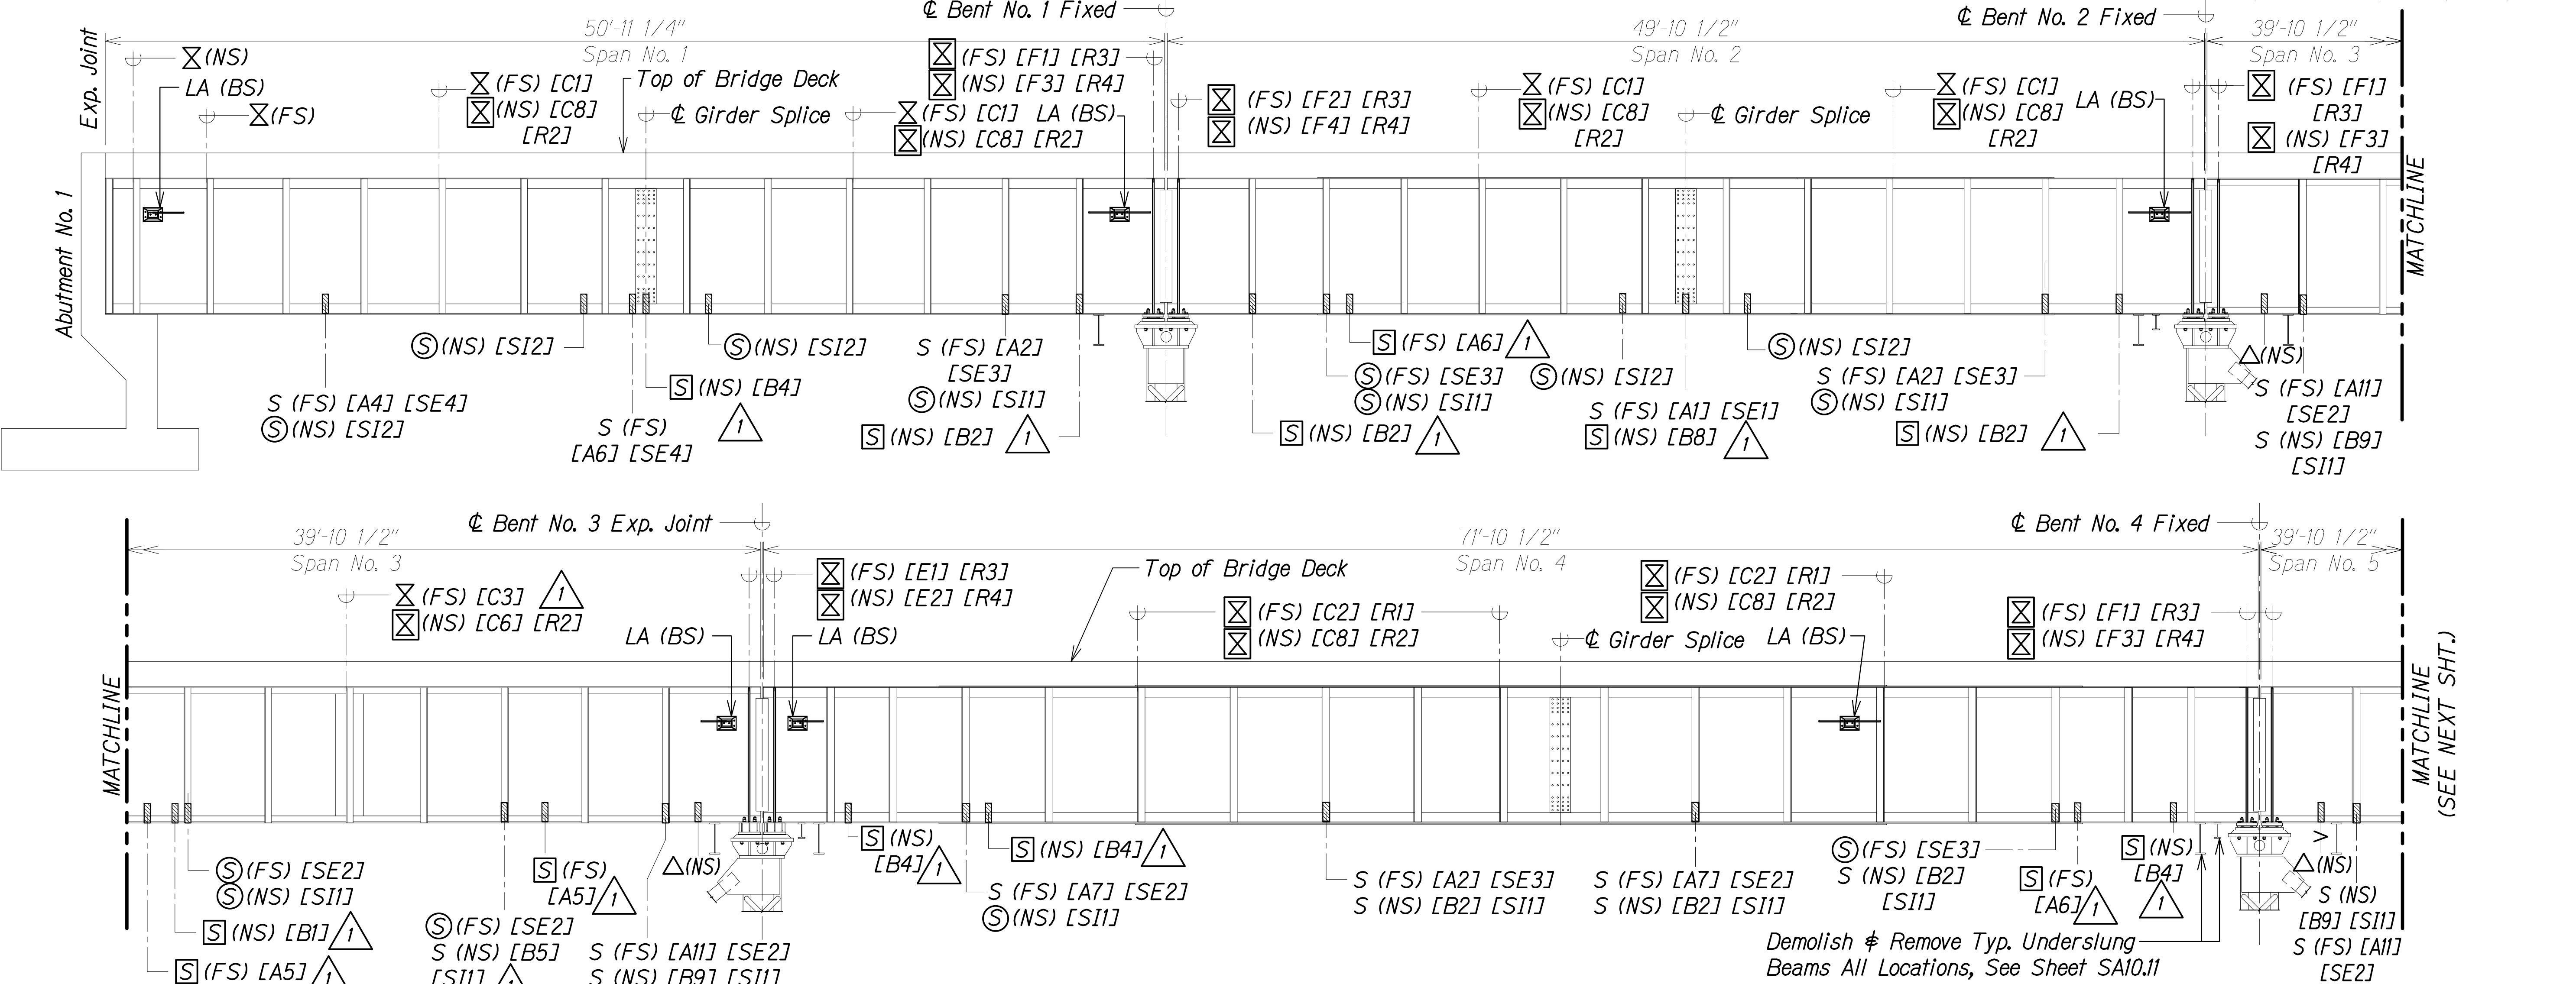

LEGEND:

LA	Lifeline Anchor, See Sheet SA10.27	FS	Far Side
X	Cross Frame	NS	Near Side
BS	Both Sides	(S)	New Strut
S	Exist. Strut to be Removed and Replaced		
[S]	Exist. Strut to be Removed		
[X]	Cross Frame to be Removed and Replaced		
STF	Deformed Stiffener to be Repaired, See Structural General Note 5.AB.		
P	Plates to be Removed from Stiffener Location. Plug Weld Resulting Holes		
↗	Exist. Angle Iron to be Removed, See Detail 1/SA10.11		
△	Exist. Ancillary Flange Tab to be Removed, See Detail 3/SA10.11		

GIRDER LINE G-2 DOWNSTREAM ELEVATION
Scale: 1/4" = 1'-0"

DEMOLITION OF MEMBERS & CONNECTIONS			
MARK	REFERENCE	MARK	REFERENCE
A1	Section A / SA10.1	B9	Section E / SA10.5
A2	Section B / SA10.1	C1	Section A / SA10.6
A4	Section D / SA10.1	C2	Section B / SA10.6
A5	Section A / SA10.2	C3	Section C / SA10.6
A6	Section B / SA10.2	C6	Section A / SA10.7
A7	Section C / SA10.2	C8	Section C / SA10.7
A11	Section C / SA10.3	E1	Section A / SA10.8
B1	Section A / SA10.4	E2	Section B / SA10.8
B2	Section B / SA10.4	F1	Section A / SA10.9
B4	Section D / SA10.4	F2	Section B / SA10.9
B5	Section A / SA10.5	F3	Section C / SA10.9
B8	Section D / SA10.5	F4	Section D / SA10.9

INSTALLATION OF MEMBERS & CONN.	
MARK	REFERENCE
SE1	Section A / SA10.12
SE2	Section B / SA10.12
SE3	Section C / SA10.12
SE4	Section D / SA10.12
SI1	Section A / SA10.13
SI2	Section B / SA10.13
R1	Section A / SA10.14
R2	Section B / SA10.14
R3	Section C / SA10.14
R4	Section D / SA10.14

12/6/24

DATE

1

Revised Callouts

REVISION

NOTES:

- The gap between the ends of the girders at the bents is 1 1/2" according to As-Built drawings.
- Struts are shown hatched for clarity.
- Replace bearing stiffeners at all locations EF of girder. See Sheet SA10.20.

STEPHEN T. PETERS

LICENSED PROFESSIONAL ENGINEER

NO. 17097-S

HAWAII, U.S.A.

THIS WORK WAS PREPARED BY ME OR UNDER MY SUPERVISION.

Signature

4-30-26

EXPIRATION DATE OF THE LICENSE

STATE OF HAWAII

DEPARTMENT OF TRANSPORTATION

HIGHWAYS DIVISION

GIRDER LINE G-2

DOWNSTREAM ELEVATION

HAWAII BELT ROAD

Nanue Stream Bridge Rehabilitation


Federal Aid Project No. BR-019-2(077)

Scale: As Noted

Date: Oct. 2024

SHEET No. SA9.14 OF 23 SHEETS

FED. ROAD DIST. NO.	STATE	FEDERAL AID PROJ. NO.	FISCAL YEAR	SHEET NO.	TOTAL SHEETS
HAWAII	HAW.	BR-019-2(077)	2024	ADD. 176	280

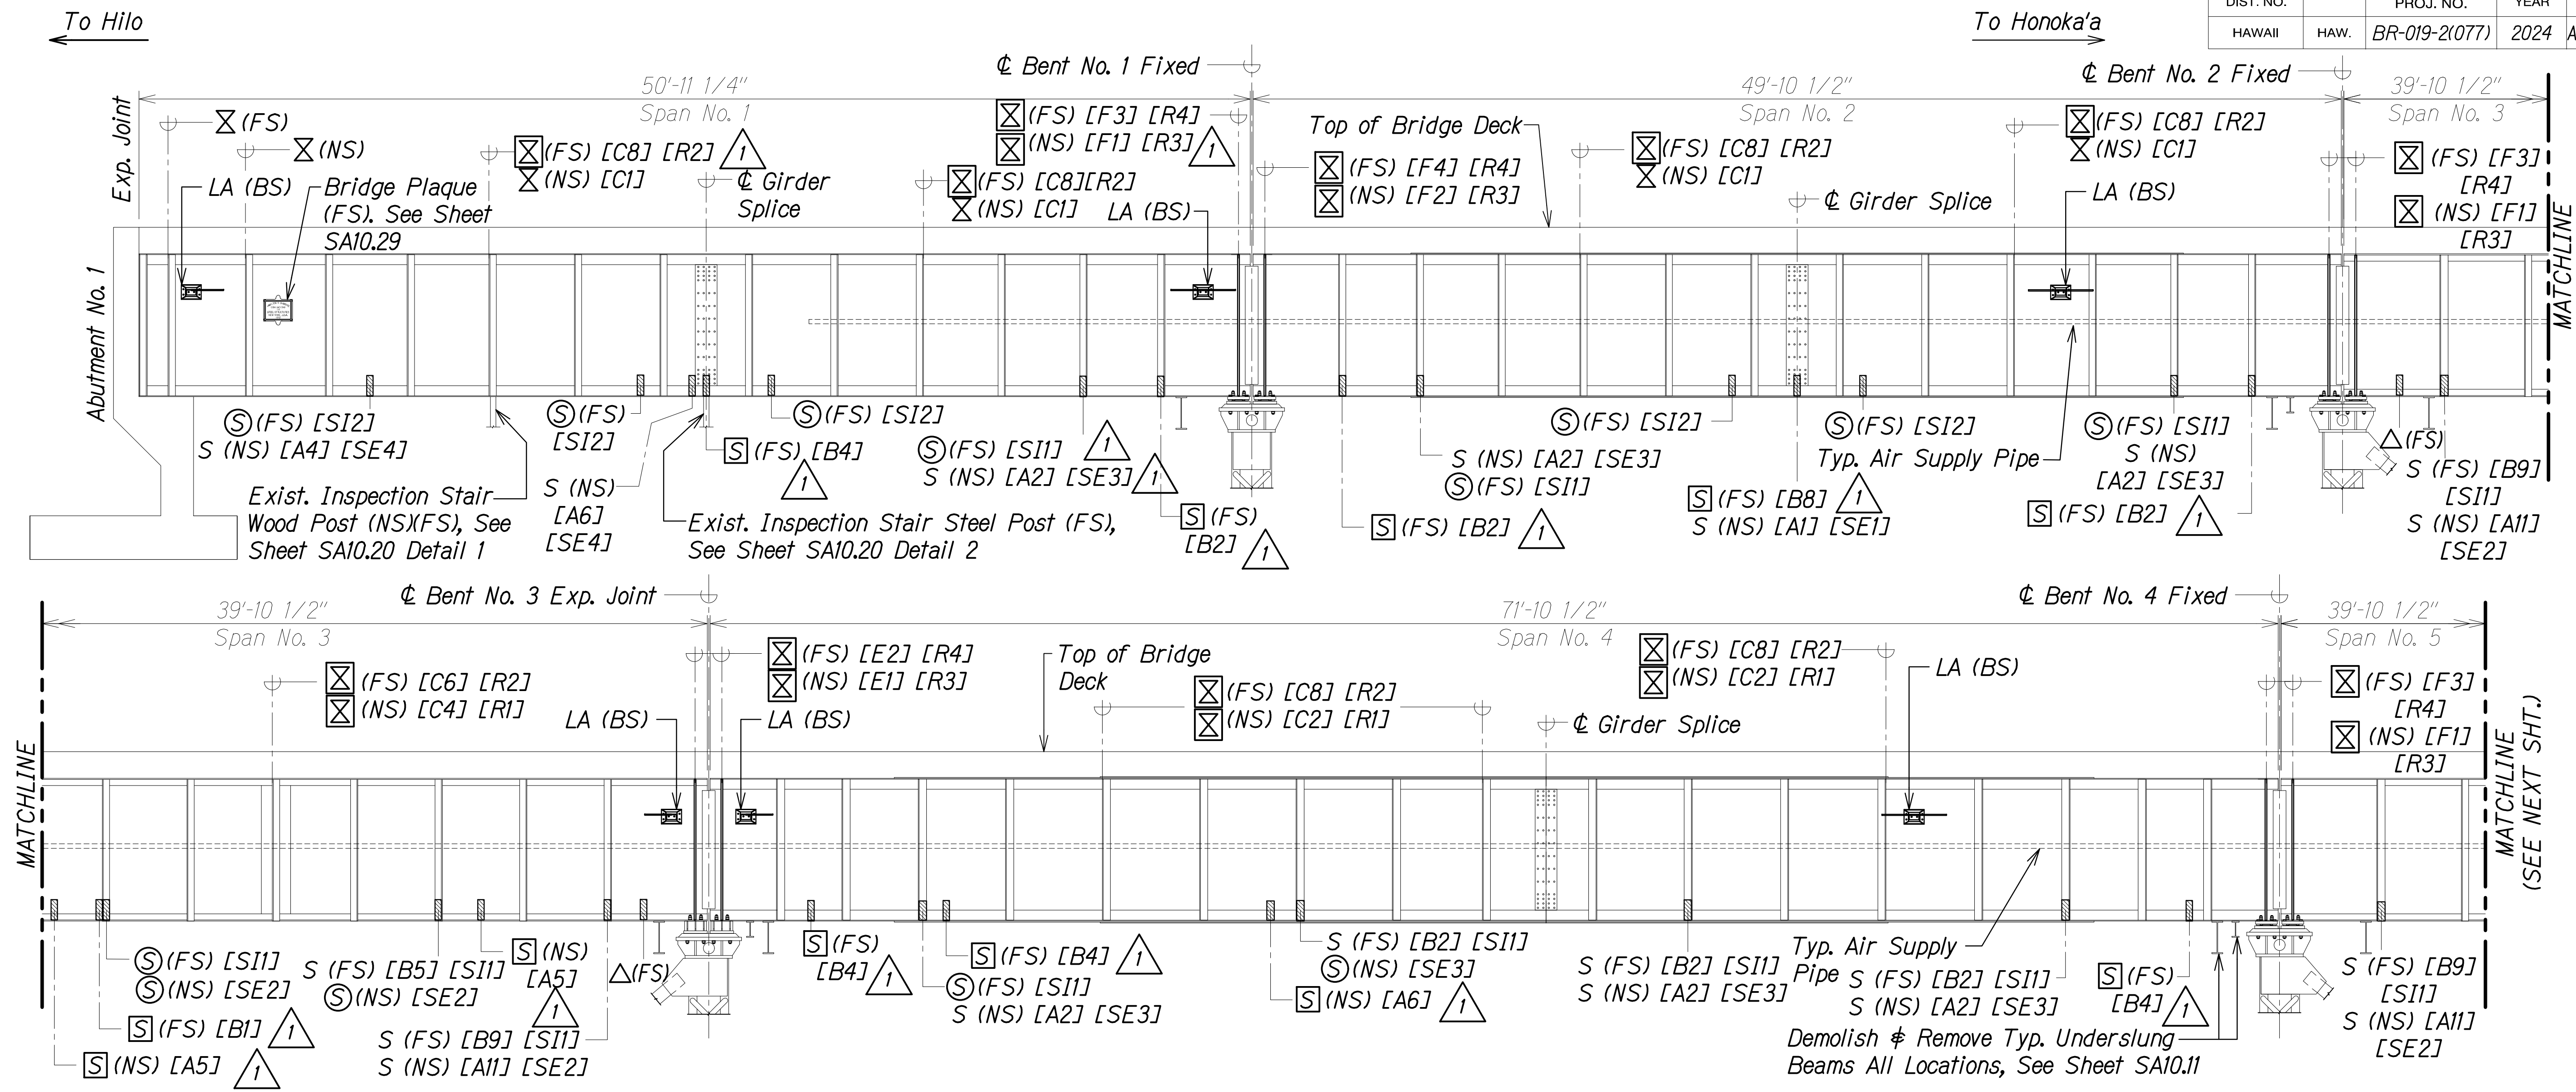

LEGEND:

- | | | | |
|-----|---|-----|-----------|
| LA | Lifeline Anchor, See Sheet SA10.27 | FS | Far Side |
| X | Cross Frame | NS | Near Side |
| BS | Both Sides | (S) | New Strut |
| S | Exist. Strut to be Removed and Replaced | | |
| [S] | Exist. Strut to be Removed | | |
| [X] | Cross Frame to be Removed and Replaced | | |
| STF | Deformed Stiffener to be Repaired, See Structural General Note 5.AB. | | |
| P | Plates to be Removed from Stiffener Location. Plug Weld Resulting Holes | | |
| ↗ | Exist. Angle Iron to be Removed, See Detail 1/SA10.11 | | |
| △ | Exist. Ancillary Flange Tab to be Removed, See Detail 3/SA10.11 | | |

GIRDER LINE G-3 DOWNSTREAM ELEVATION

Scale: 1/4" = 1'-0"


A
SA9.17 SA9.17

DEMOLITION OF MEMBERS & CONNECTIONS			
MARK	REFERENCE	MARK	REFERENCE
A1	Section A / SA10.1	C1	Section A / SA10.6
A2	Section B / SA10.1	C2	Section B / SA10.6
A4	Section D / SA10.1	C4	Section D / SA10.6
A5	Section A / SA10.2	C6	Section A / SA10.7
A6	Section B / SA10.2	C8	Section C / SA10.7
A11	Section C / SA10.3	E1	Section A / SA10.8
B1	Section A / SA10.4	E2	Section B / SA10.8
B2	Section B / SA10.4	F1	Section A / SA10.9
B4	Section D / SA10.4	F2	Section B / SA10.9
B5	Section A / SA10.5	F3	Section C / SA10.9
B8	Section D / SA10.5	F4	Section D / SA10.9
B9	Section E / SA10.5	-	-

INSTALLATION OF MEMBERS & CONN.	
MARK	REFERENCE
SE1	Section A / SA10.12
SE2	Section B / SA10.12
SE3	Section C / SA10.12
SE4	Section D / SA10.12
SI1	Section A / SA10.13
SI2	Section B / SA10.13
R1	Section A / SA10.14
R2	Section B / SA10.14
R3	Section C / SA10.14
R4	Section D / SA10.14

NOTES:

- The gap between the ends of the girders at the bents is 1 1/2" according to As-Built drawings.
- Struts are shown hatched for clarity.
- Replace bearing stiffeners at all locations EF of girder. See Sheet SA10.20.

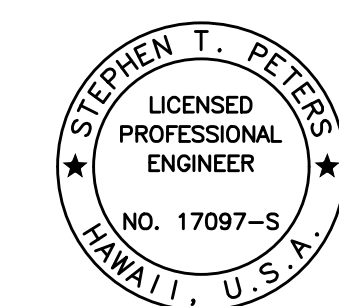

THIS WORK WAS PREPARED BY ME OR UNDER MY SUPERVISION.
SIGNATURE: *Stephen T. Peters* EXPIRATION DATE OF THE LICENSE: 4-30-26


STATE OF HAWAII
DEPARTMENT OF TRANSPORTATION
HIGHWAYS DIVISION

**GIRDER LINE G-3
DOWNSTREAM ELEVATION**

HAWAII BELT ROAD
Nanue Stream Bridge Rehabilitation
Federal Aid Project No. BR-019-2(077)

Scale: As Noted Date: Oct. 2024

SHEET No. SA9.17 OF 23 SHEETS

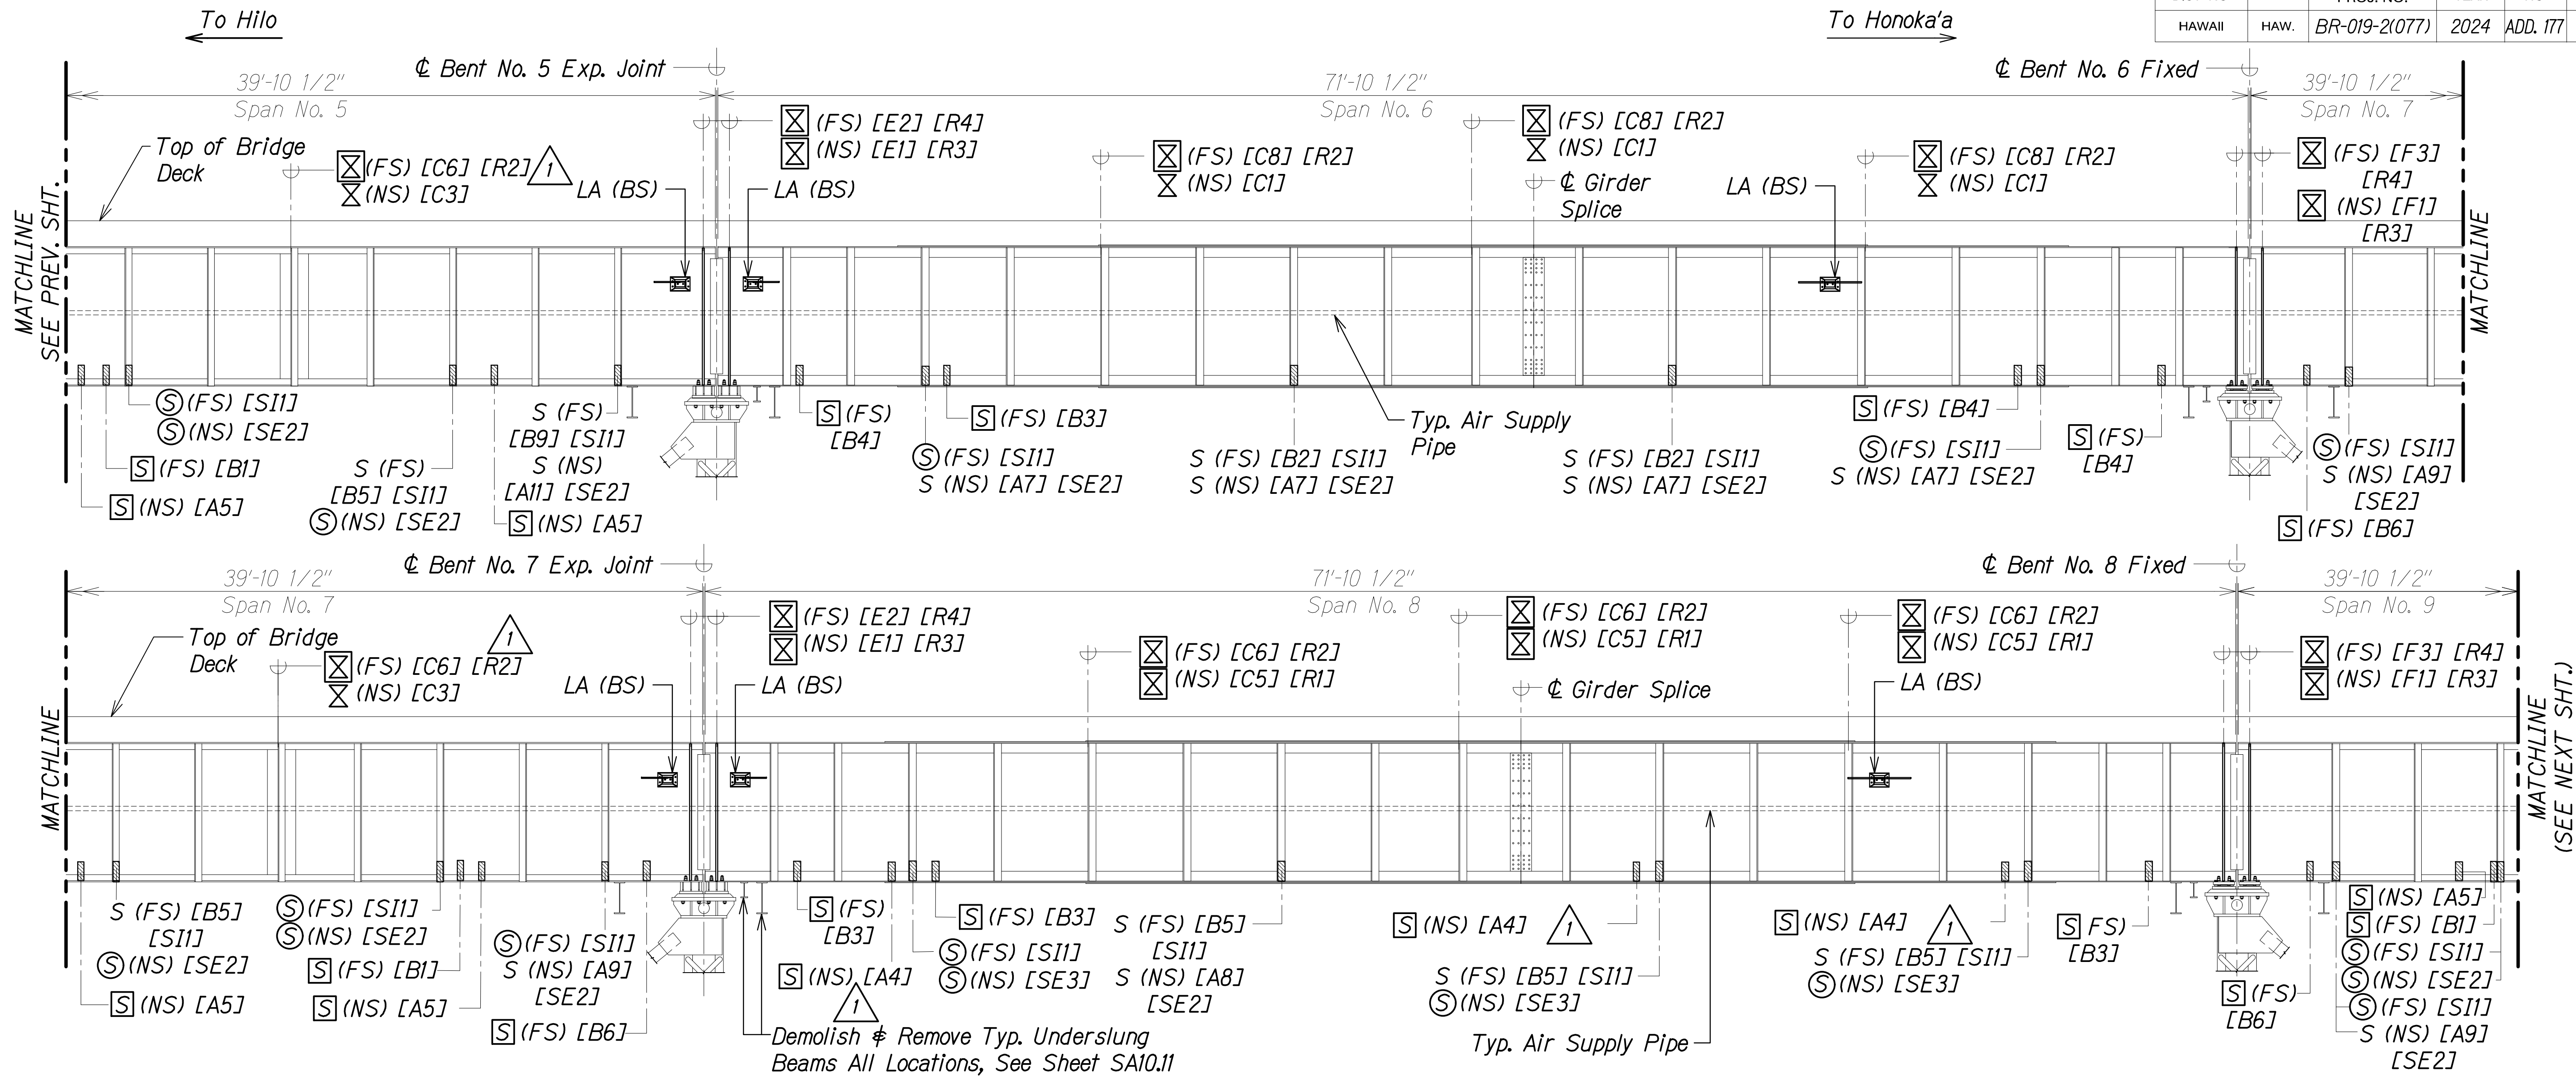

LEGEND:

- LA Lifeline Anchor, See Sheet SA10.27
X Cross Frame
BS Both Sides
S Exist. Strut to be Removed and Replaced
[S] Exist. Strut to be Removed
[X] Cross Frame to be Removed and Replaced
STF Deformed Stiffener to be Repaired, See Structural General Note 5.AB.
P Plates to be Removed from Stiffener Location. Plug Weld Resulting Holes
△ Exist. Angle Iron to be Removed, See Detail 1/SA10.11
△ Exist. Ancillary Flange Tab to be Removed, See Detail 3/SA10.11
- FS Far Side
NS Near Side
⊙ New Strut

GIRDER LINE G-3 DOWNSTREAM ELEVATION

Scale: 1/4" = 1'-0"


A
SA9.18 | SA9.18

DEMOLITION OF MEMBERS & CONNECTIONS			
MARK	REFERENCE	MARK	REFERENCE
A4	Section D / SA10.1	B9	Section E / SA10.5
A5	Section A / SA10.2	C1	Section A / SA10.6
A7	Section C / SA10.2	C3	Section C / SA10.6
A8	Section D / SA10.2	C5	Section E / SA10.6
A9	Section A / SA10.3	C6	Section A / SA10.7
A11	Section C / SA10.3	C8	Section C / SA10.7
B1	Section A / SA10.4	E1	Section A / SA10.8
B2	Section B / SA10.4	E2	Section B / SA10.8
B3	Section C / SA10.4	F1	Section A / SA10.9
B4	Section D / SA10.4	F3	Section C / SA10.9
B5	Section A / SA10.5	-	-
B6	Section B / SA10.5	-	-

INSTALLATION OF MEMBERS & CONN.	
MARK	REFERENCE
SE2	Section B / SA10.12
SE3	Section C / SA10.12
SE4	Section D / SA10.12
SI1	Section A / SA10.13
SI2	Section B / SA10.13
R1	Section A / SA10.14
R2	Section B / SA10.14
R3	Section C / SA10.14
R4	Section D / SA10.14

NOTES:

- The gap between the ends of the girders at the bents is 1 1/2" according to As-Built drawings.
- Struts are shown hatched for clarity.
- Replace bearing stiffeners at all locations EF of girder. See Sheet SA10.20.

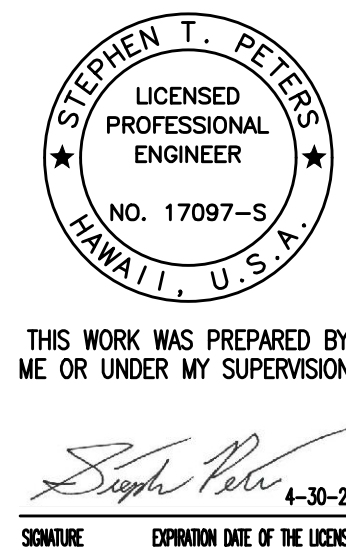

STATE OF HAWAII
DEPARTMENT OF TRANSPORTATION
HIGHWAYS DIVISION


**GIRDER LINE G-3
DOWNSTREAM ELEVATION**

HAWAII BELT ROAD
Nanue Stream Bridge Rehabilitation
Federal Aid Project No. BR-019-2(077)

Scale: As Noted Date: Oct. 2024

SHEET No. SA9.18 OF 23 SHEETS

FED. ROAD DIST. NO.	STATE	FEDERAL AID PROJ. NO.	FISCAL YEAR	SHEET NO.	TOTAL SHEETS
HAWAII	HAW.	BR-019-2(077)	2024	ADD. 178	280

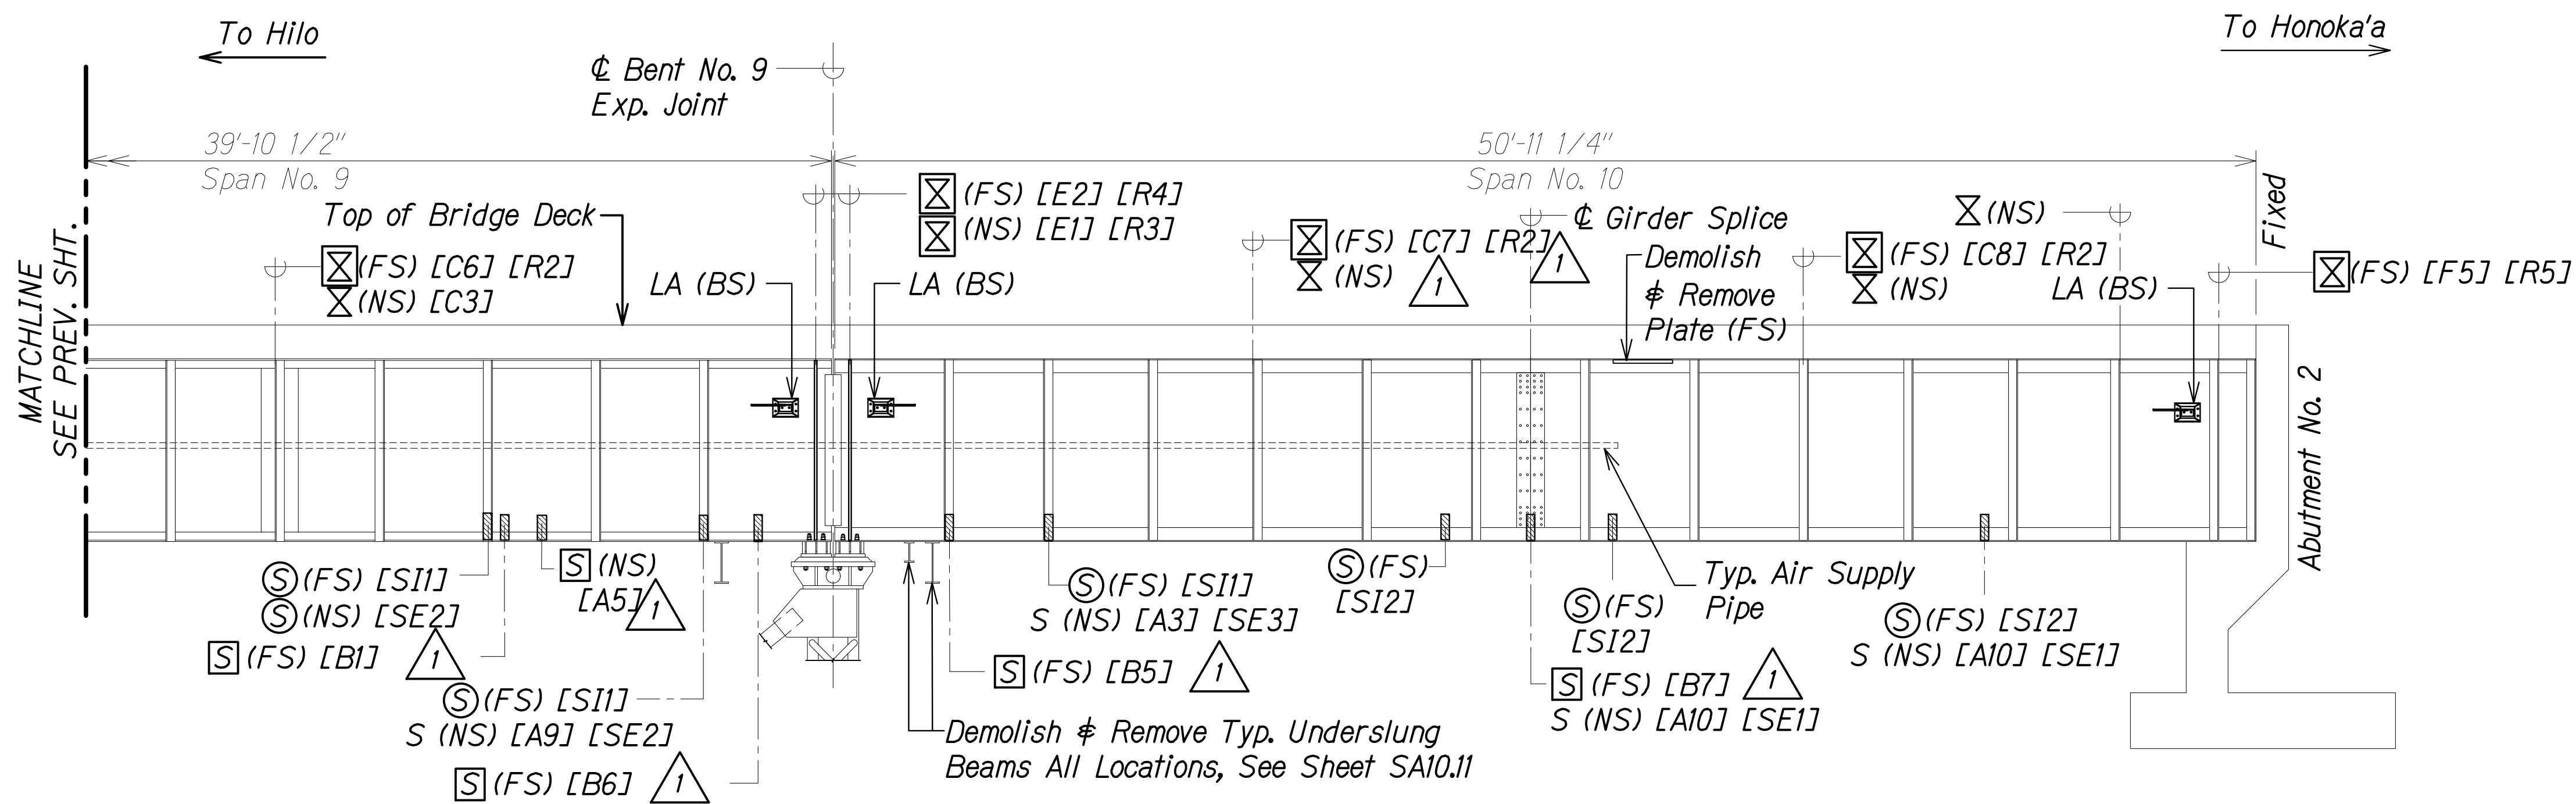

GIRDER LINE G-3
DOWNSTREAM ELEVATION
Scale: 1/4" = 1'-0" A
SA9.19 SA9.19

LEGEND:

- LA Lifeline Anchor, See Sheet SA10.27
X Cross Frame
BS Both Sides
S Exist. Strut to be Removed and Replaced
S Exist. Strut to be Removed
X Cross Frame to be Removed and Replaced
STF Deformed Stiffener to be Repaired, See Structural General Note 5.AB.
P Plates to be Removed from Stiffener Location. Plug Weld Resulting Holes
X Exist. Angle Iron to be Removed, See Detail 1/SA10.11
X Exist. Ancillary Flange Tab to be Removed, See Detail 3/SA10.11
- FS Far Side
NS Near Side
S New Strut

DEMOLITION OF MEMBERS & CONNECTIONS			
MARK	REFERENCE	MARK	REFERENCE
A3	Section C / SA10.1	C7	Section C / SA10.7
A5	Section A / SA10.2	C8	Section C / SA10.7
A9	Section A / SA10.3	E1	Section A / SA10.8
A10	Section B / SA10.3	E2	Section B / SA10.8
B1	Section A / SA10.4	F5	Section E / SA10.9
B5	Section A / SA10.5	-	-
B6	Section B / SA10.5	-	-
B7	Section C / SA10.5	-	-
C3	Section C / SA10.6	-	-
C6	Section A / SA10.7	-	-


NOTES:

- The gap between the ends of the girders at the bents is 1 1/2" according to As-Built drawings.
- Struts are shown hatched for clarity.
- Replace bearing stiffeners at all locations EF of girder. See Sheet SA10.20.

INSTALLATION OF MEMBERS & CONN.	
MARK	REFERENCE
SE1	Section A / SA10.12
SE2	Section B / SA10.12
SE3	Section C / SA10.12
SI1	Section A / SA10.13
SI2	Section B / SA10.13
R1	Section A / SA10.14
R2	Section B / SA10.14
R3	Section C / SA10.14
R4	Section D / SA10.14
R5	Section A / SA10.15

12/6/24 1 Revised Callouts

DATE REVISION

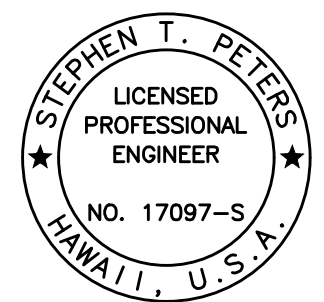

THIS WORK WAS PREPARED BY ME OR UNDER MY SUPERVISION.
SIGNATURE EXPIRATION DATE OF THE LICENSE


STATE OF HAWAII
DEPARTMENT OF TRANSPORTATION
HIGHWAYS DIVISION
**GIRDER LINE G-3
DOWNSTREAM ELEVATION**
HAWAII BELT ROAD
Nanue Stream Bridge Rehabilitation
Federal Aid Project No. BR-019-2(077)
Scale: As Noted Date: Oct. 2024

SHEET No. SA9.19 OF 23 SHEETS

ADD. 178

DRAWING NAME: Z:\00 ONGOING\23-022.9-NANUE STR BR PF2-DOT\A.01 CAD\12-06-24 ADD\NSR-SA0911-SA0922 GIRDER ELEV ADD2.DWG PLOT TIME: 12-05-24, 2:47 PM

FED. ROAD DIST. NO.	STATE	FEDERAL AID PROJ. NO.	FISCAL YEAR	SHEET NO.	TOTAL SHEETS
HAWAII	HAW.	BR-019-2(077)	2024	ADD. 179	280

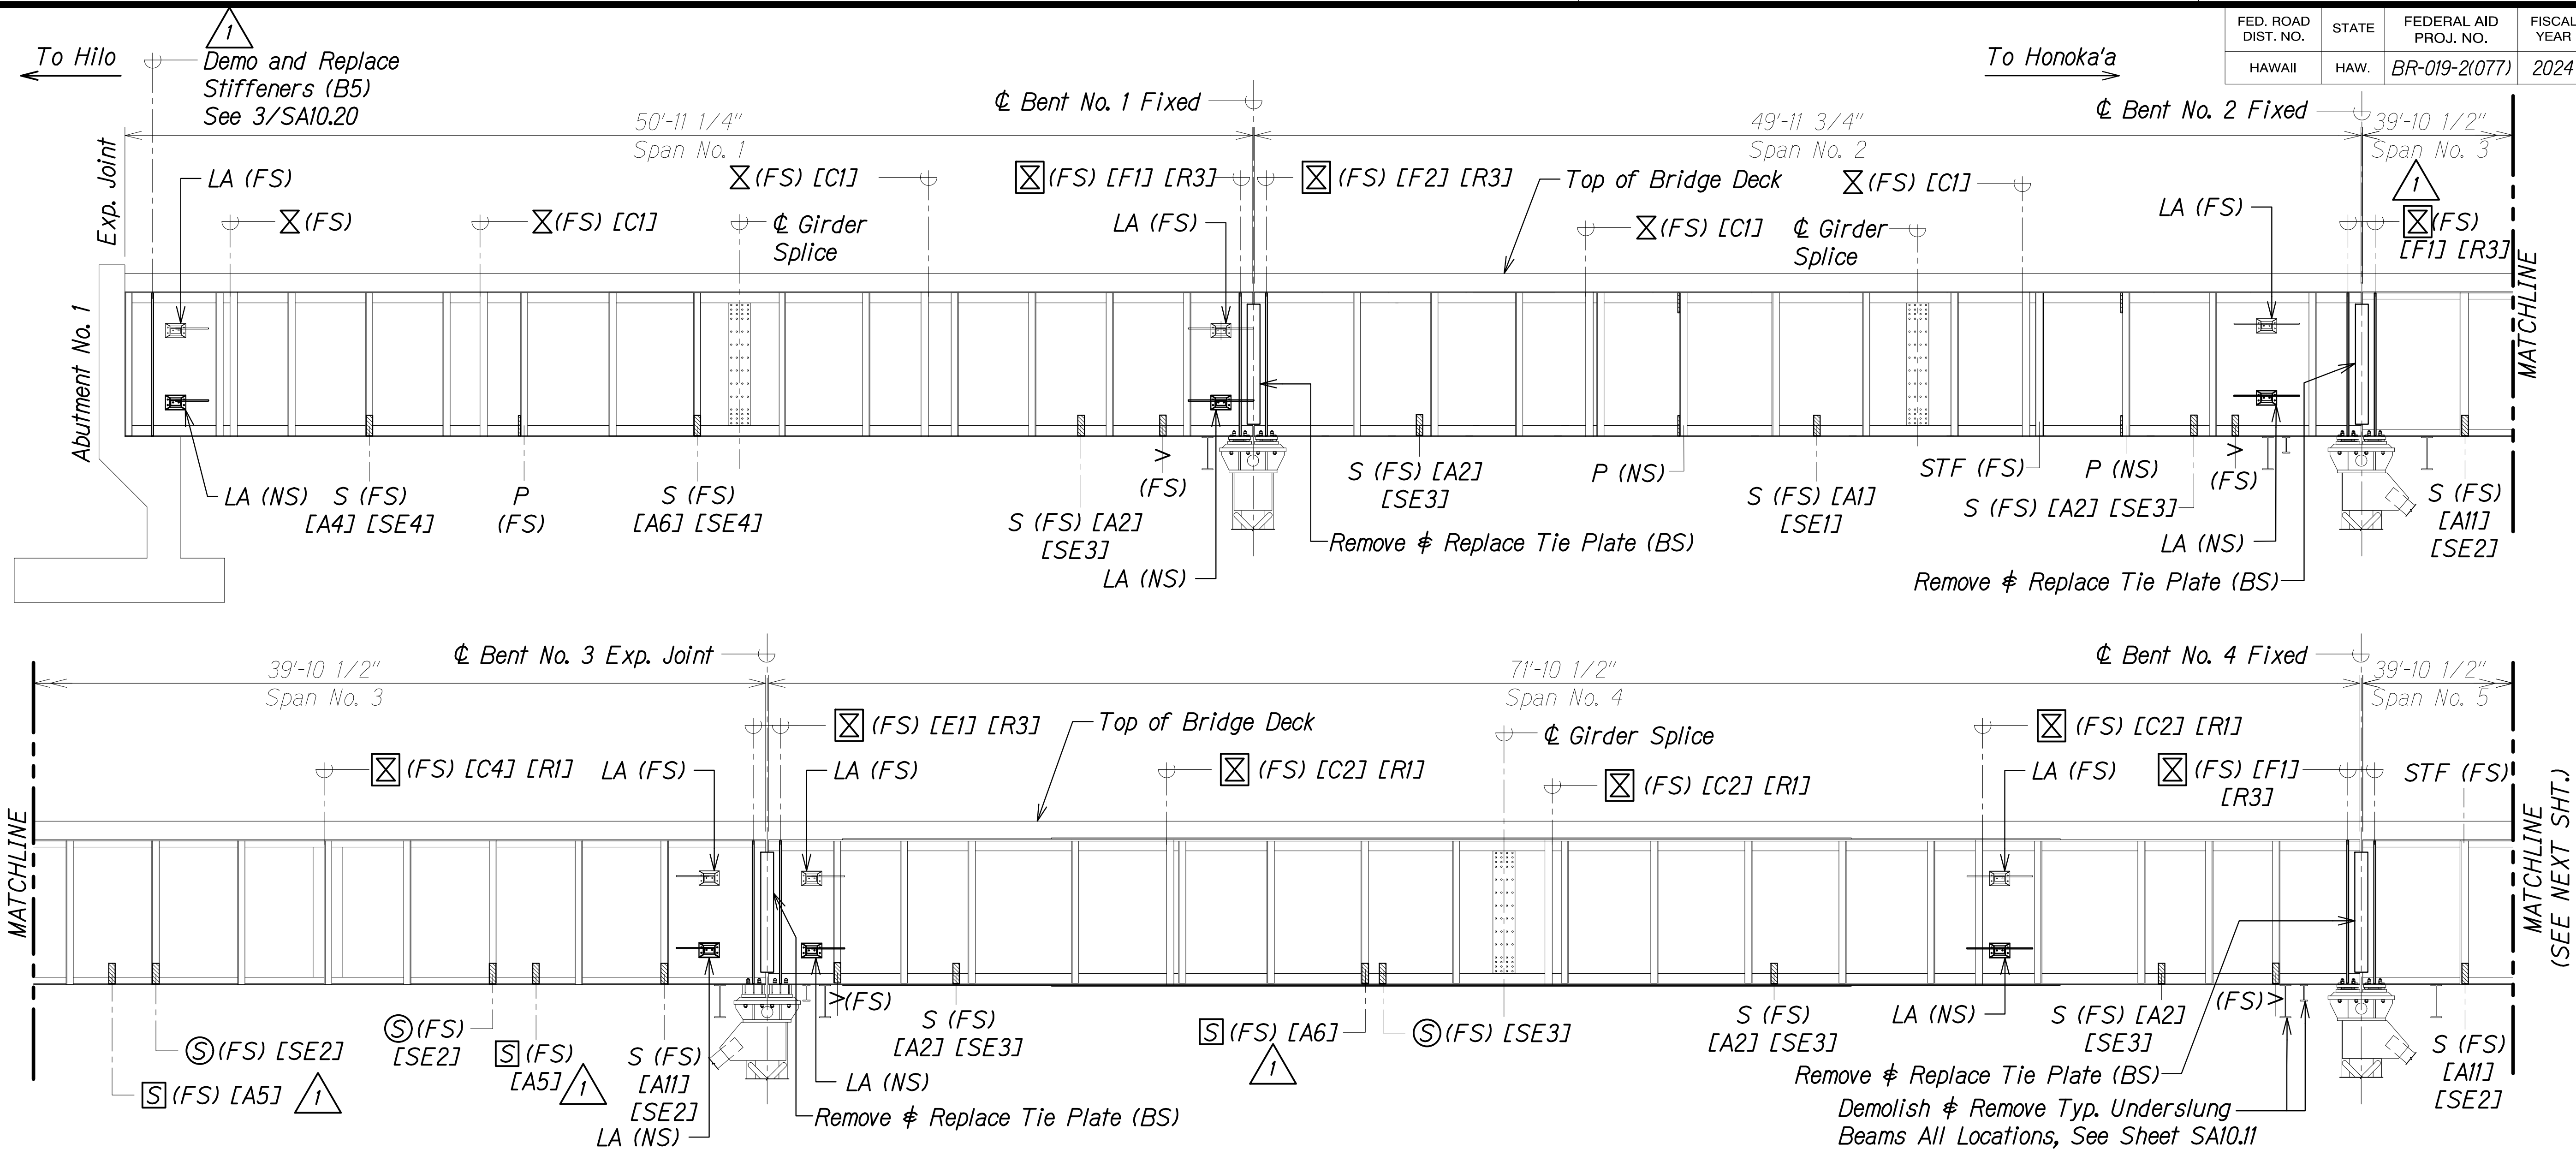

LEGEND:

- LA Lifeline Anchor, See Sheet SA10.27

FS Far Side
- ⊗ Cross Frame

NS Near Side
- BS Both Sides

⊙ New Strut
- S Exist. Strut to be Removed and Replaced

[S] Exist. Strut to be Removed
- ⊗ Cross Frame to be Removed and Replaced

STF Deformed Stiffener to be Repaired, See Structural General Note 5.AB.
- P Plates to be Removed from Stiffener Location. Plug Weld Resulting Holes

↗ Exist. Angle Iron to be Removed, See Detail 1/SA10.11
- △ Exist. Ancillary Flange Tab to be Removed, See Detail 3/SA10.11

GIRDER LINE G-4 DOWNSTREAM ELEVATION
Scale: 1/4" = 1'-0"

A
SA9.20 | SA9.20

DEMOLITION OF MEMBERS & CONNECTIONS	
MARK	REFERENCE
A1	Section A / SA10.1
A2	Section B / SA10.1
A4	Section D / SA10.1
A5	Section A / SA10.2
A6	Section B / SA10.2
A11	Section C / SA10.3
C1	Section A / SA10.6
C2	Section B / SA10.6
C4	Section D / SA10.6
E1	Section A / SA10.8
F1	Section A / SA10.9
F2	Section B / SA10.9

INSTALLATION OF MEMBERS & CONN.	
MARK	REFERENCE
SE1	Section A / SA10.12
SE2	Section B / SA10.12
SE3	Section C / SA10.12
SE4	Section D / SA10.12
R1	Section A / SA10.14
R3	Section C / SA10.14

NOTES:

- The gap between the ends of the girders at the bents is 1 1/2" according to As-Built drawings. See Sheets SA10.10 and SA10.25 for tie plate details.
- Struts are shown hatched for clarity.
- Replace bearing stiffeners at all locations EF of girder. See Sheet SA10.20.

STEPHEN T. PETERS
LICENSED PROFESSIONAL ENGINEER
NO. 17097-S
HAWAII, U.S.A.
THIS WORK WAS PREPARED BY ME OR UNDER MY SUPERVISION.
SIGNATURE
EXPIRATION DATE OF THE LICENSE 4-30-26

STATE OF HAWAII
DEPARTMENT OF TRANSPORTATION
HIGHWAYS DIVISION


GIRDER LINE G-4
DOWNSTREAM ELEVATION

HAWAII BELT ROAD
Nanue Stream Bridge Rehabilitation
Federal Aid Project No. BR-019-2(077)
Scale: As Noted Date: Oct. 2024

SHEET No. SA9.20 OF 23 SHEETS

12/6/24	1 Revised Callouts
DATE	REVISION

FED. ROAD DIST. NO.	STATE	FEDERAL AID PROJ. NO.	FISCAL YEAR	SHEET NO.	TOTAL SHEETS
HAWAII	HAW.	BR-019-2(077)	2024	ADD. 180	280

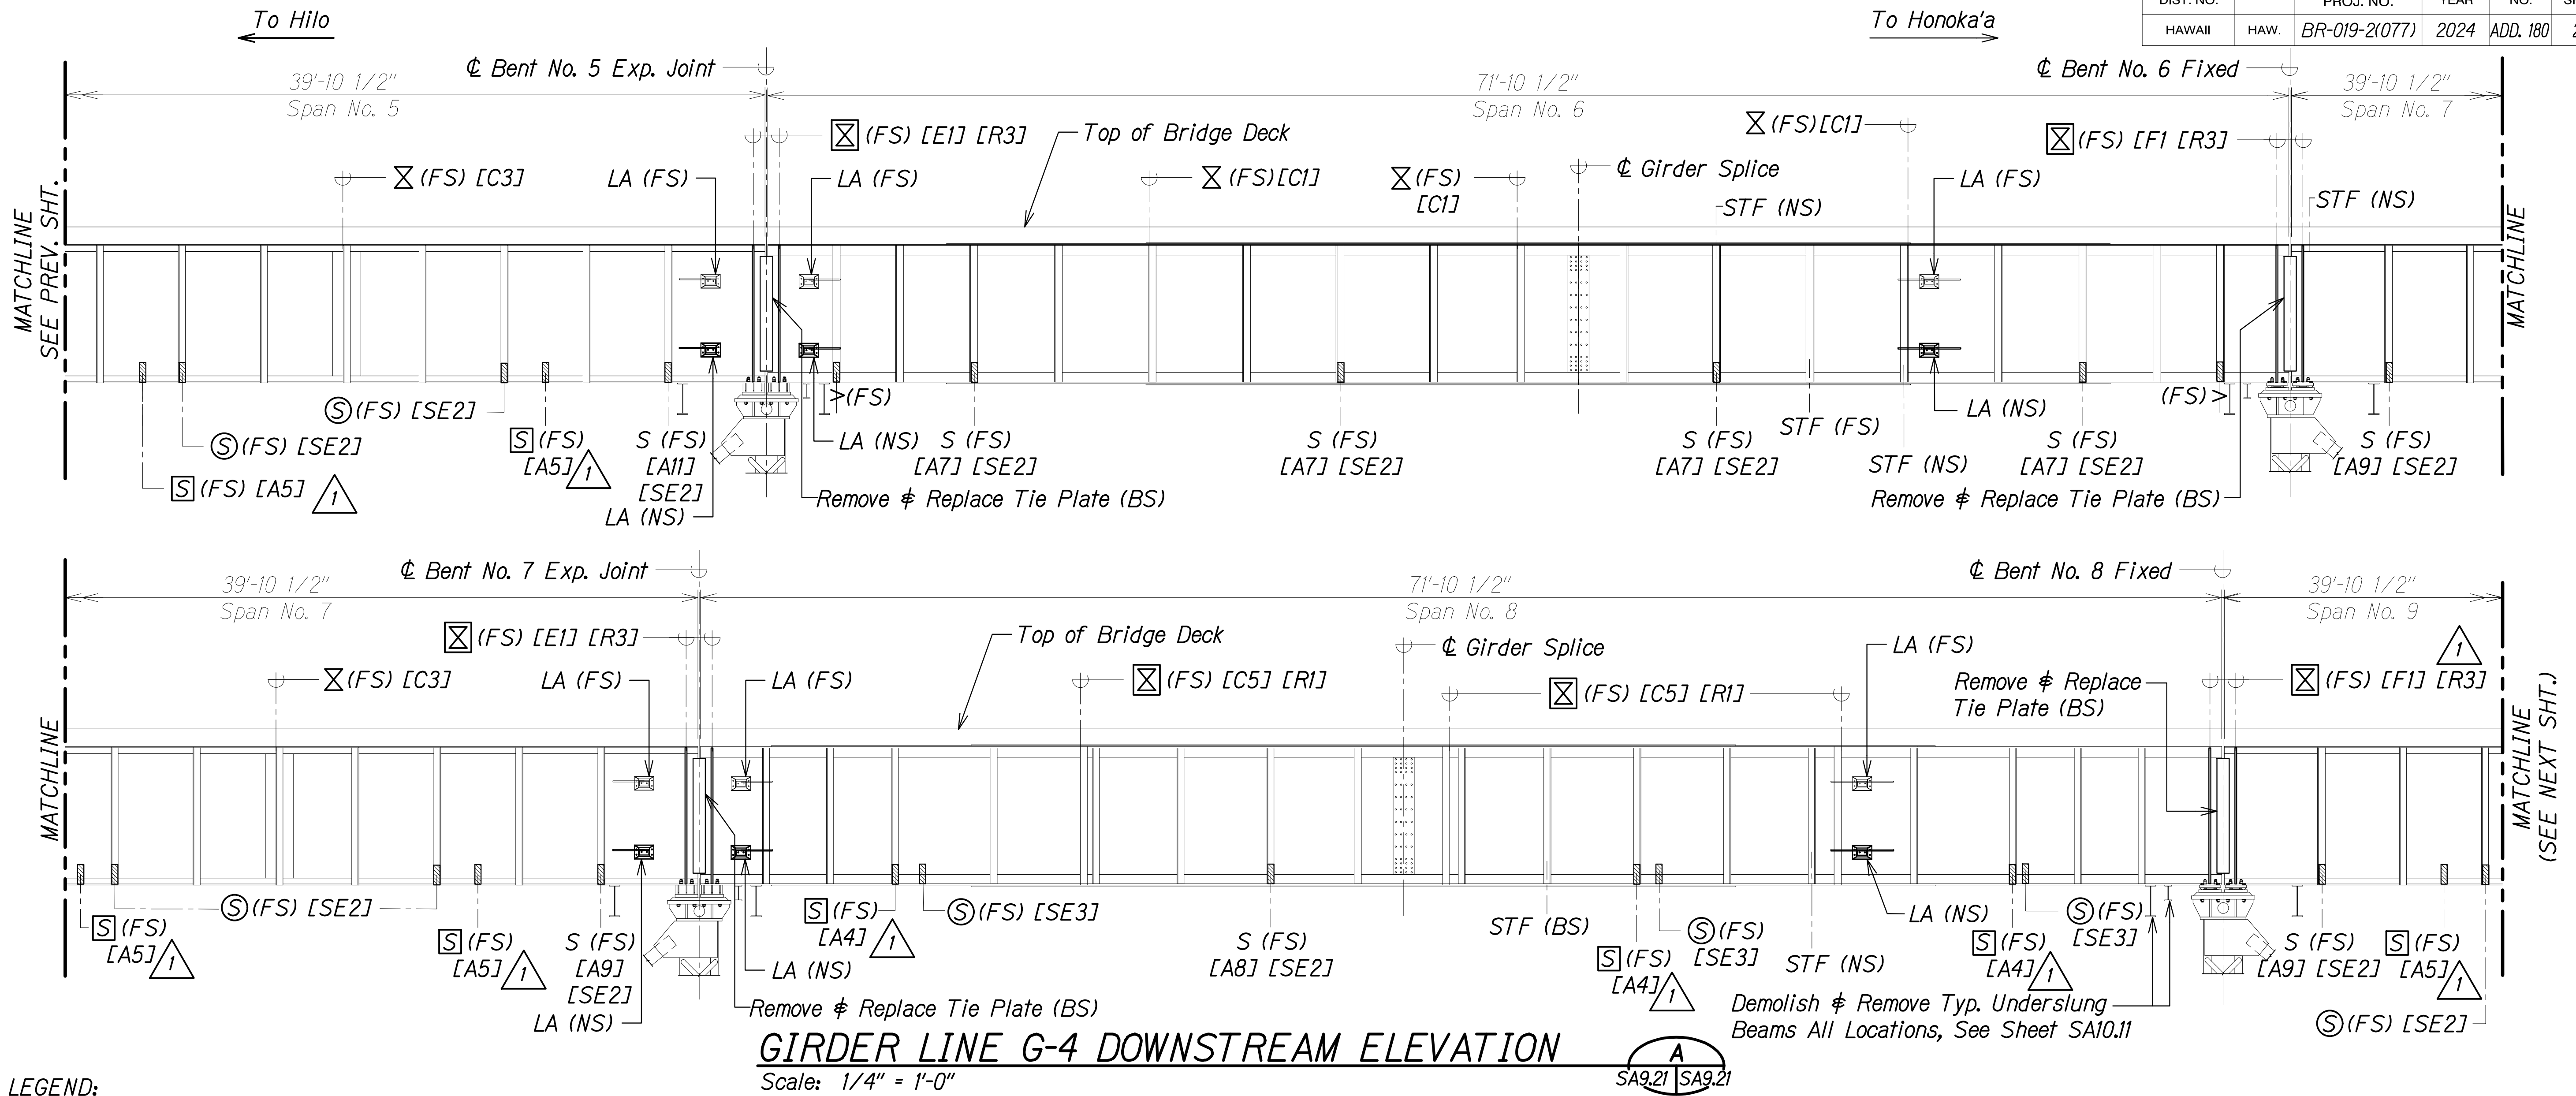

LEGEND:


- LA Lifeline Anchor, See Sheet SA10.27
CF Cross Frame
BS Both Sides
S Exist. Strut to be Removed and Replaced
[S] Exist. Strut to be Removed
[X] Cross Frame to be Removed and Replaced
STF Deformed Stiffener to be Repaired, See Structural General Note 5.AB.
P Plates to be Removed from Stiffener Location. Plug Weld Resulting Holes
Exist. Angle Iron to be Removed, See Detail 1/SA10.11
Exist. Ancillary Flange Tab to be Removed, See Detail 3/SA10.11
- FS Far Side
NS Near Side
[S] New Strut

DEMOLITION OF MEMBERS & CONNECTIONS	
MARK	REFERENCE
A4	Section D / SA10.1
A5	Section A / SA10.2
A7	Section C / SA10.2
A8	Section D / SA10.2
A9	Section A / SA10.3
A11	Section C / SA10.3
C1	Section A / SA10.6
C3	Section C / SA10.6
C5	Section E / SA10.6
E1	Section A / SA10.8
F1	Section A / SA10.9

INSTALLATION OF MEMBERS & CONN.	
MARK	REFERENCE
SE1	Section A / SA10.12
SE2	Section B / SA10.12
SE3	Section C / SA10.12
SE4	Section D / SA10.12
R1	Section A / SA10.14
R3	Section C / SA10.14

NOTES:

- The gap between the ends of the girders at the bents is 1 1/2" according to As-Built drawings. See Sheets SA10.10 and SA10.25 for tie plate details.
- Struts are shown hatched for clarity.
- Replace bearing stiffeners at all locations EF of girder. See Sheet SA10.20.

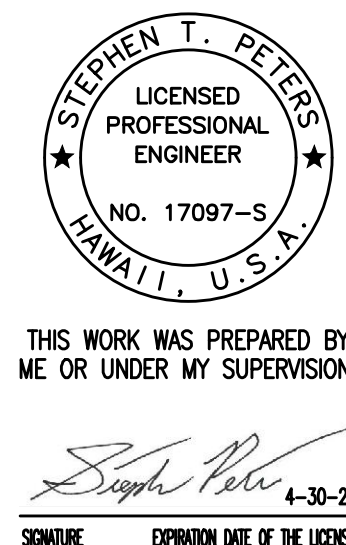

STATE OF HAWAII
DEPARTMENT OF TRANSPORTATION
HIGHWAYS DIVISION

**GIRDER LINE G-4
DOWNSTREAM ELEVATION**


HAWAII BELT ROAD
Nanue Stream Bridge Rehabilitation
Federal Aid Project No. BR-019-2(077)

Scale: As Noted Date: Oct. 2024

SHEET No. SA9.21 OF 23 SHEETS

12/6/24	1 Revised Callouts
DATE	REVISION

FED. ROAD DIST. NO.	STATE	FEDERAL AID PROJ. NO.	FISCAL YEAR	SHEET NO.	TOTAL SHEETS
HAWAII	HAW.	BR-019-2(077)	2024	ADD. 181	280

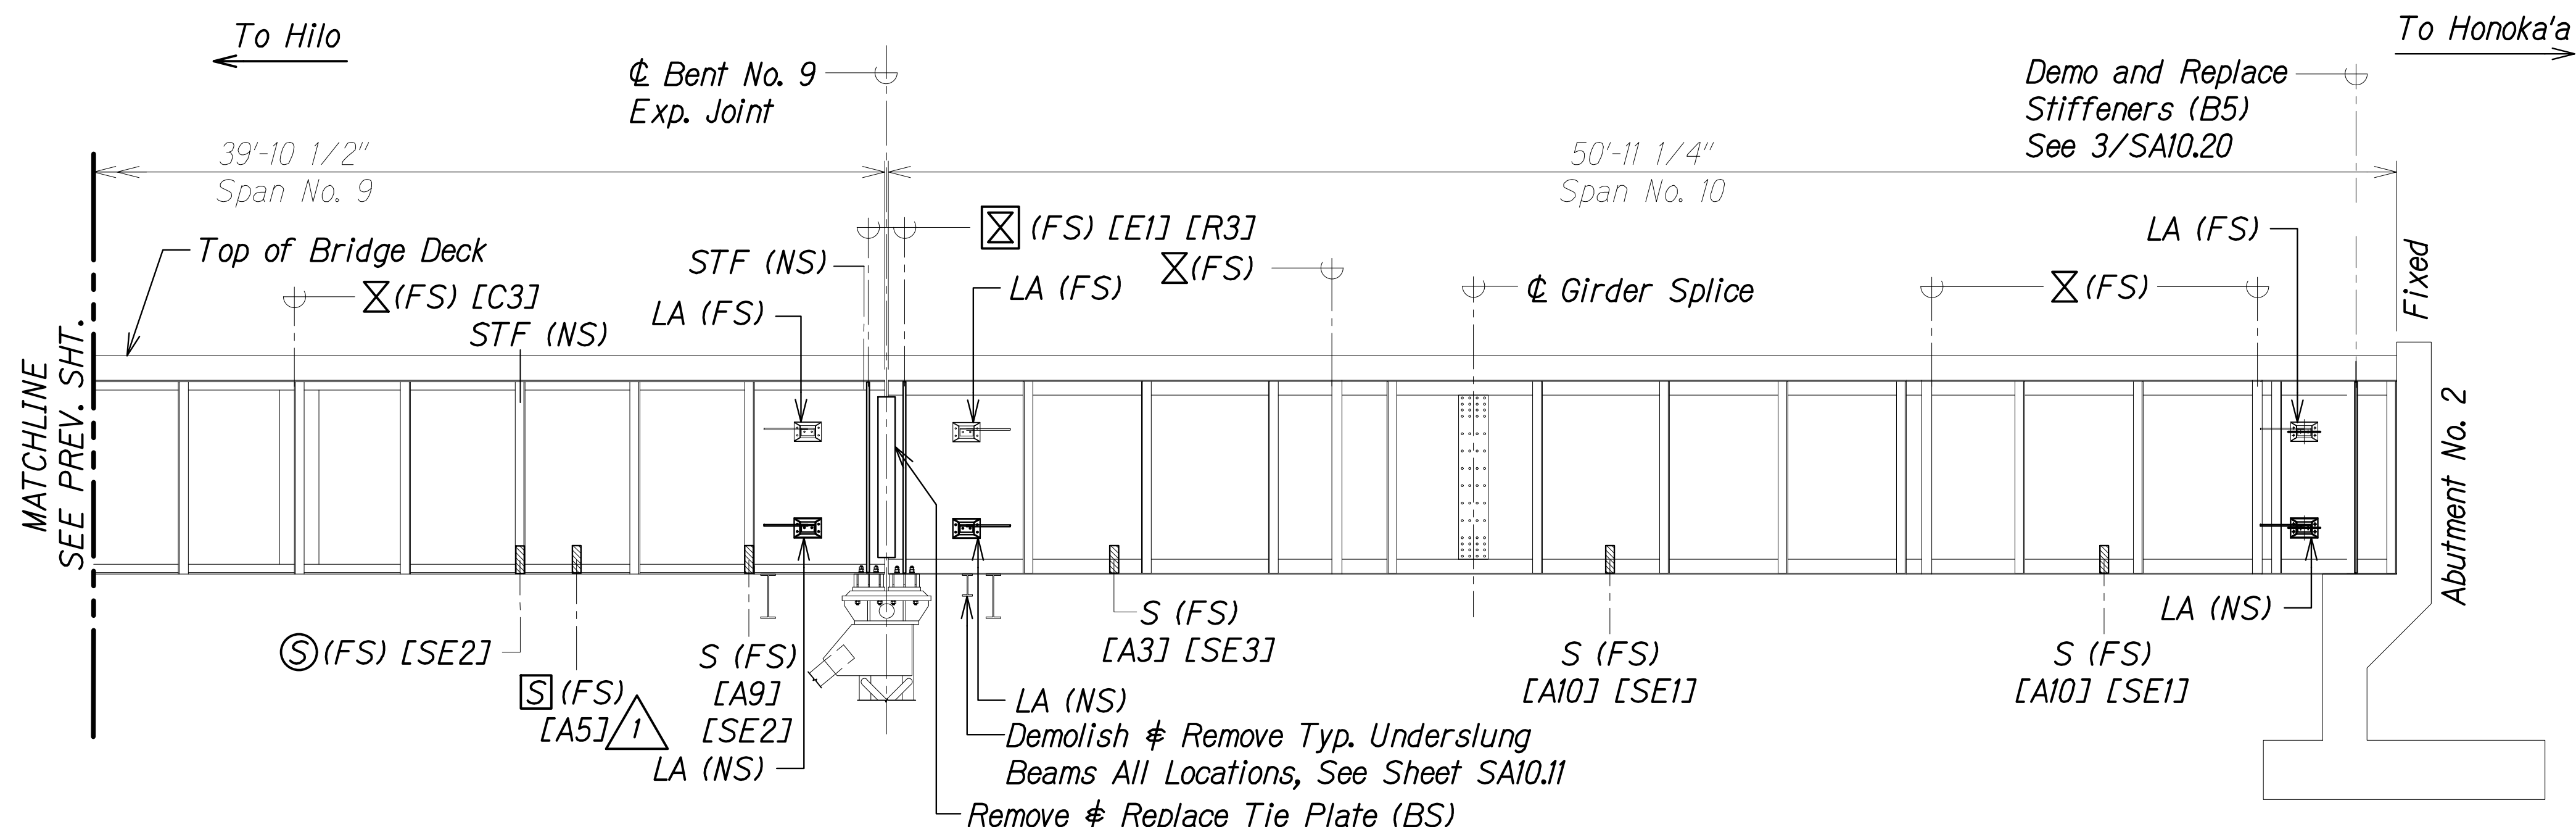

GIRDER LINE G-4
DOWNSTREAM ELEVATION
Scale: 1/4" = 1'-0"
SA9.22 A SA9.22

LEGEND:


- LA Lifeline Anchor, See Sheet SA10.27
X Cross Frame
BS Both Sides
S Exist. Strut to be Removed and Replaced
S Exist. Strut to be Removed
X Cross Frame to be Removed and Replaced
STF Deformed Stiffener to be Repaired, See Structural General Note 5.AB.
P Plates to be Removed from Stiffener Location. Plug Weld Resulting Holes
A Exist. Angle Iron to be Removed, See Detail 1/SA10.11
Δ Exist. Ancillary Flange Tab to be Removed, See Detail 3/SA10.11
- FS Far Side
NS Near Side
S New Strut

DEMOLITION OF MEMBERS & CONNECTIONS	
MARK	REFERENCE
A3	Section C / SA10.1
A5	Section A / SA10.2
A9	Section A / SA10.3
A10	Section B / SA10.3
C3	Section C / SA10.6
E1	Section A / SA10.8

INSTALLATION OF MEMBERS & CONN.	
MARK	REFERENCE
SE1	Section A / SA10.12
SE2	Section B / SA10.12
SE3	Section C / SA10.12
R3	Section C / SA10.14

NOTES:

- The gap between the ends of the girders at the bents is 1 1/2" according to As-Built drawings. See Sheets SA10.10 and SA10.25 for tie plate details.
- Struts are shown hatched for clarity.
- Replace bearing stiffeners at all locations EF of girder. See Sheet SA10.20.

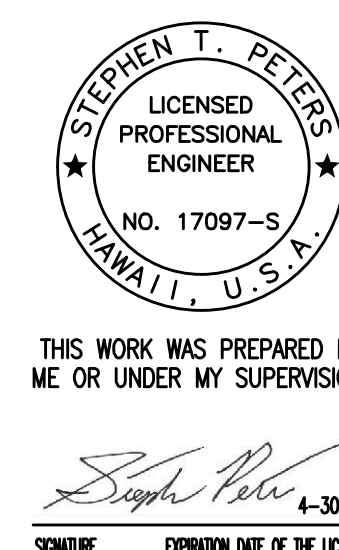

12/6/24	1	Revised Callout
DATE	REVISION	

STATE OF HAWAII
DEPARTMENT OF TRANSPORTATION
HIGHWAYS DIVISION
GIRDER LINE G-4
DOWNSTREAM ELEVATION
HAWAII BELT ROAD
Nanue Stream Bridge Rehabilitation
Federal Aid Project No. BR-019-2(077)
Scale: As Noted Date: Oct. 2024
SHEET No. SA9.22 OF 23 SHEETS

FED. ROAD DIST. NO.	STATE	FEDERAL AID PROJ. NO.	FISCAL YEAR	SHEET NO.	TOTAL SHEETS
HAWAII	HAW.	BR-019-2(077)	2024	ADD. 188	280


LEGEND:

 Demolish and Remove


 [XXX] Cross Frame Mark, See SA9.1 through SA9.5 for locations

NOTES:


- The Contractor shall take care when removing existing steel members so as not to damage the existing steel members to remain.
- Remove all exist. wood board inspection planks (not shown) and deliver to HDOT maintenance yard.
- Details beyond shown bay are not provided.
- See Sheet SA10.11 for miscellaneous demolition details

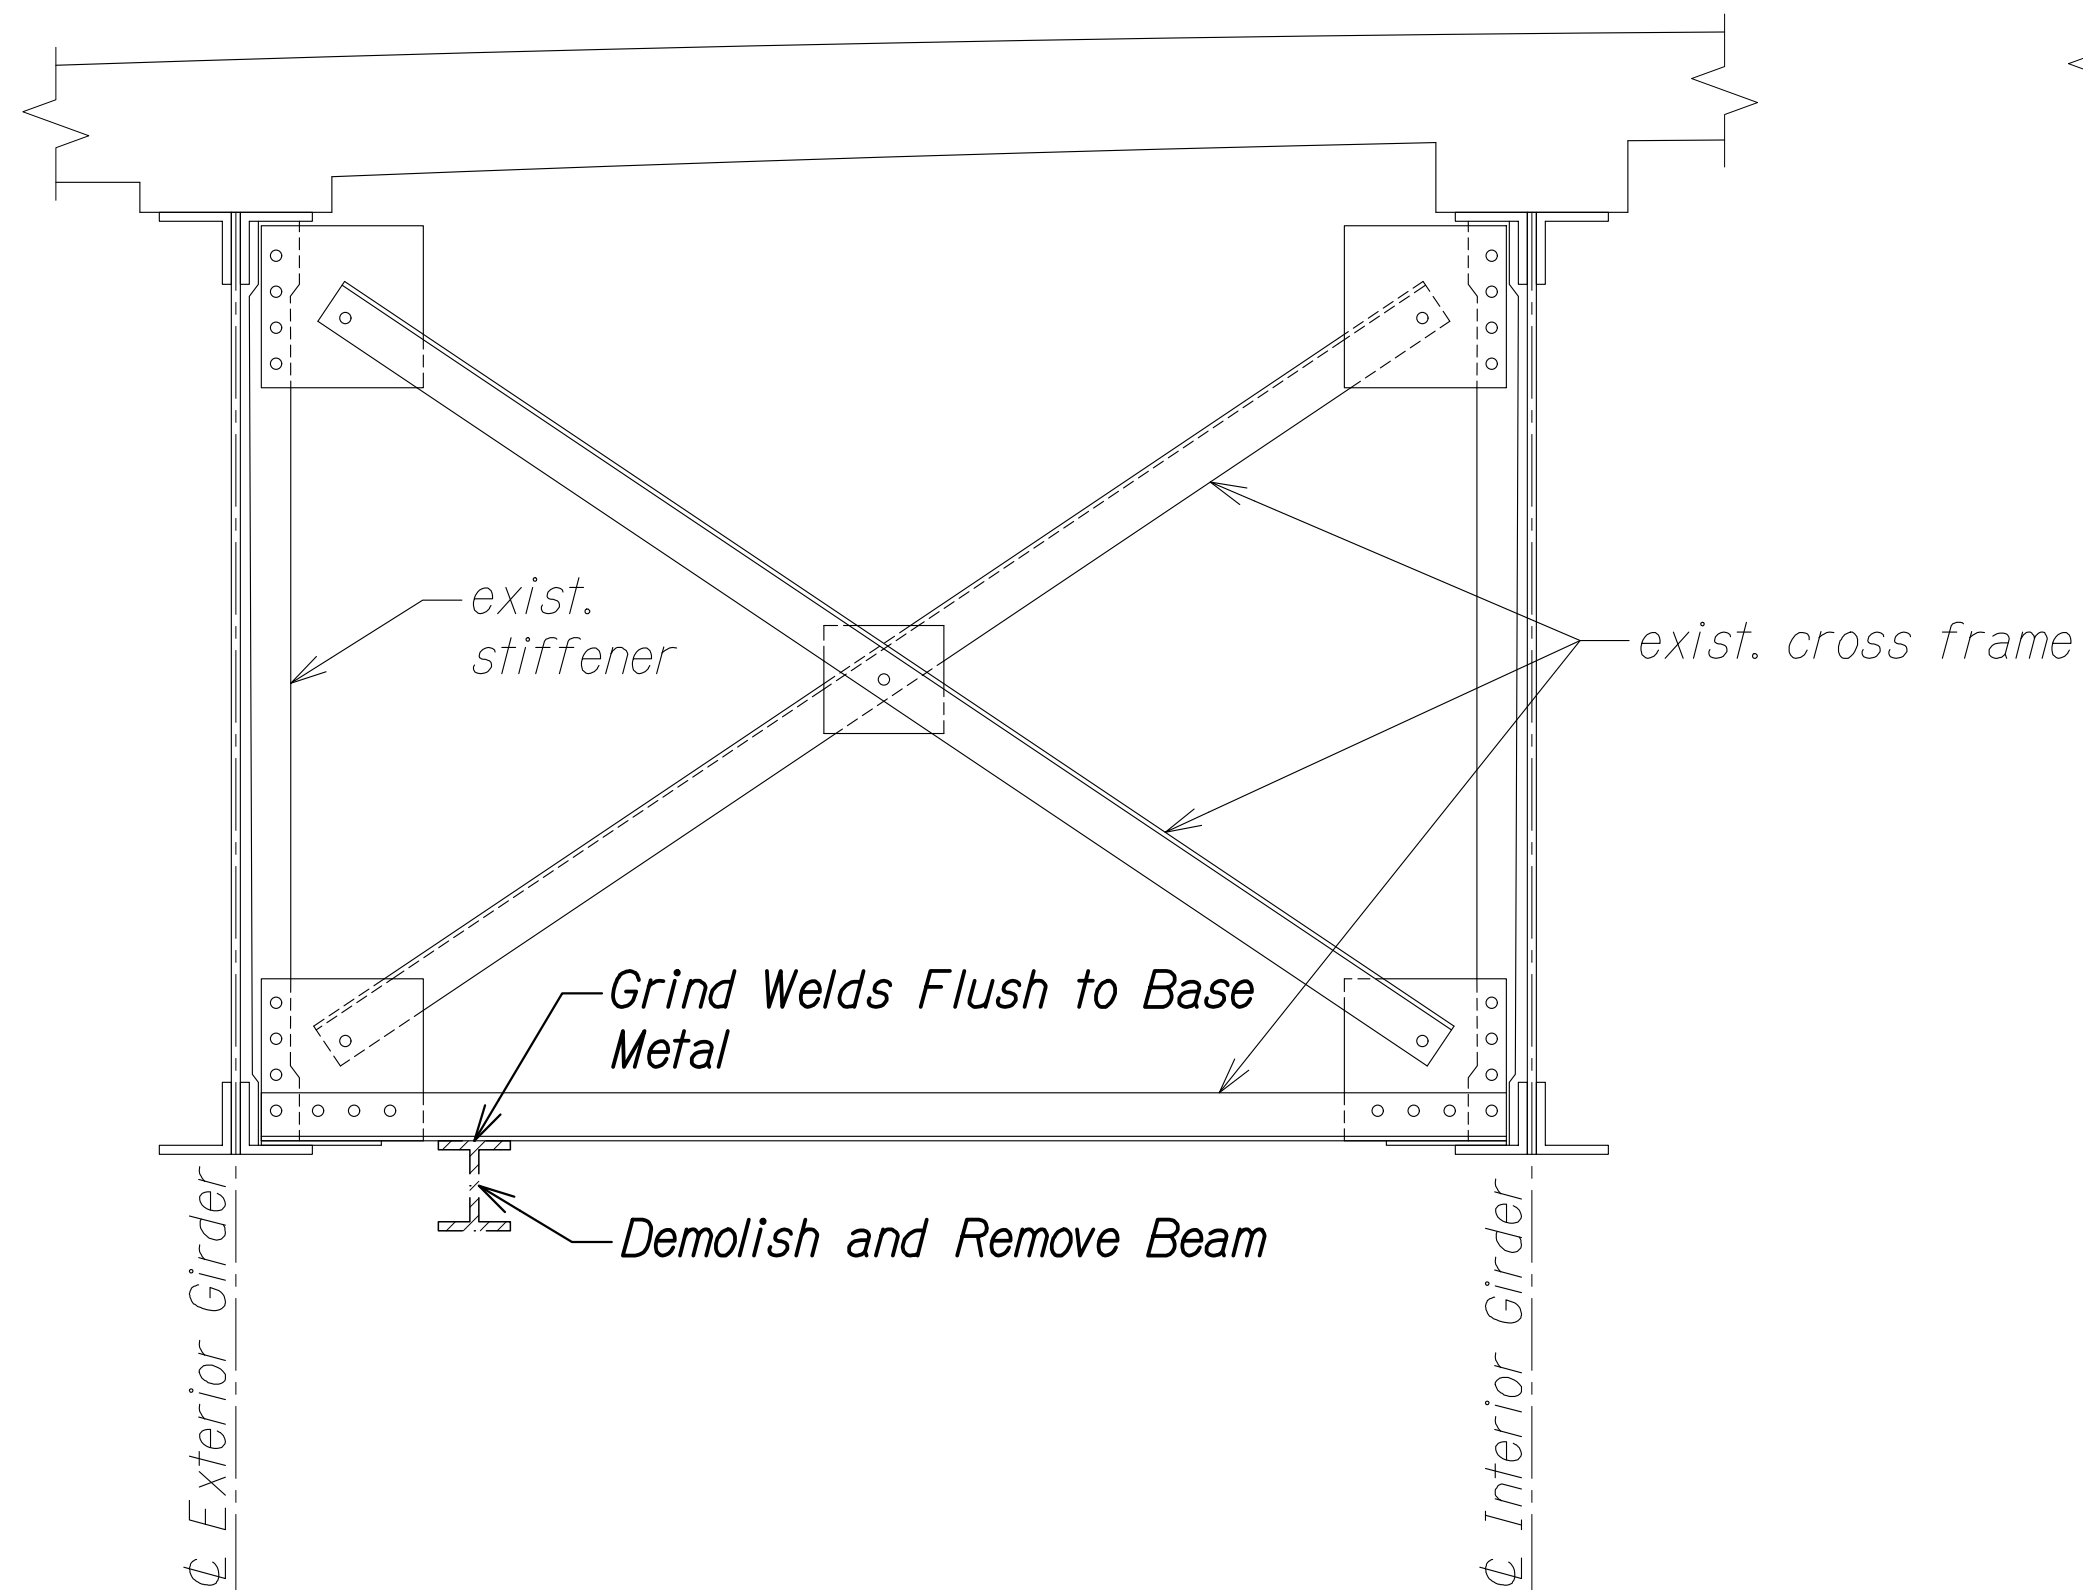


[C1] EXTERIOR BAY DEMO SECTION AT IN-SPAN CROSS FRAME
Scale: 3/4" = 1'-0"
SA10.6 SA10.6

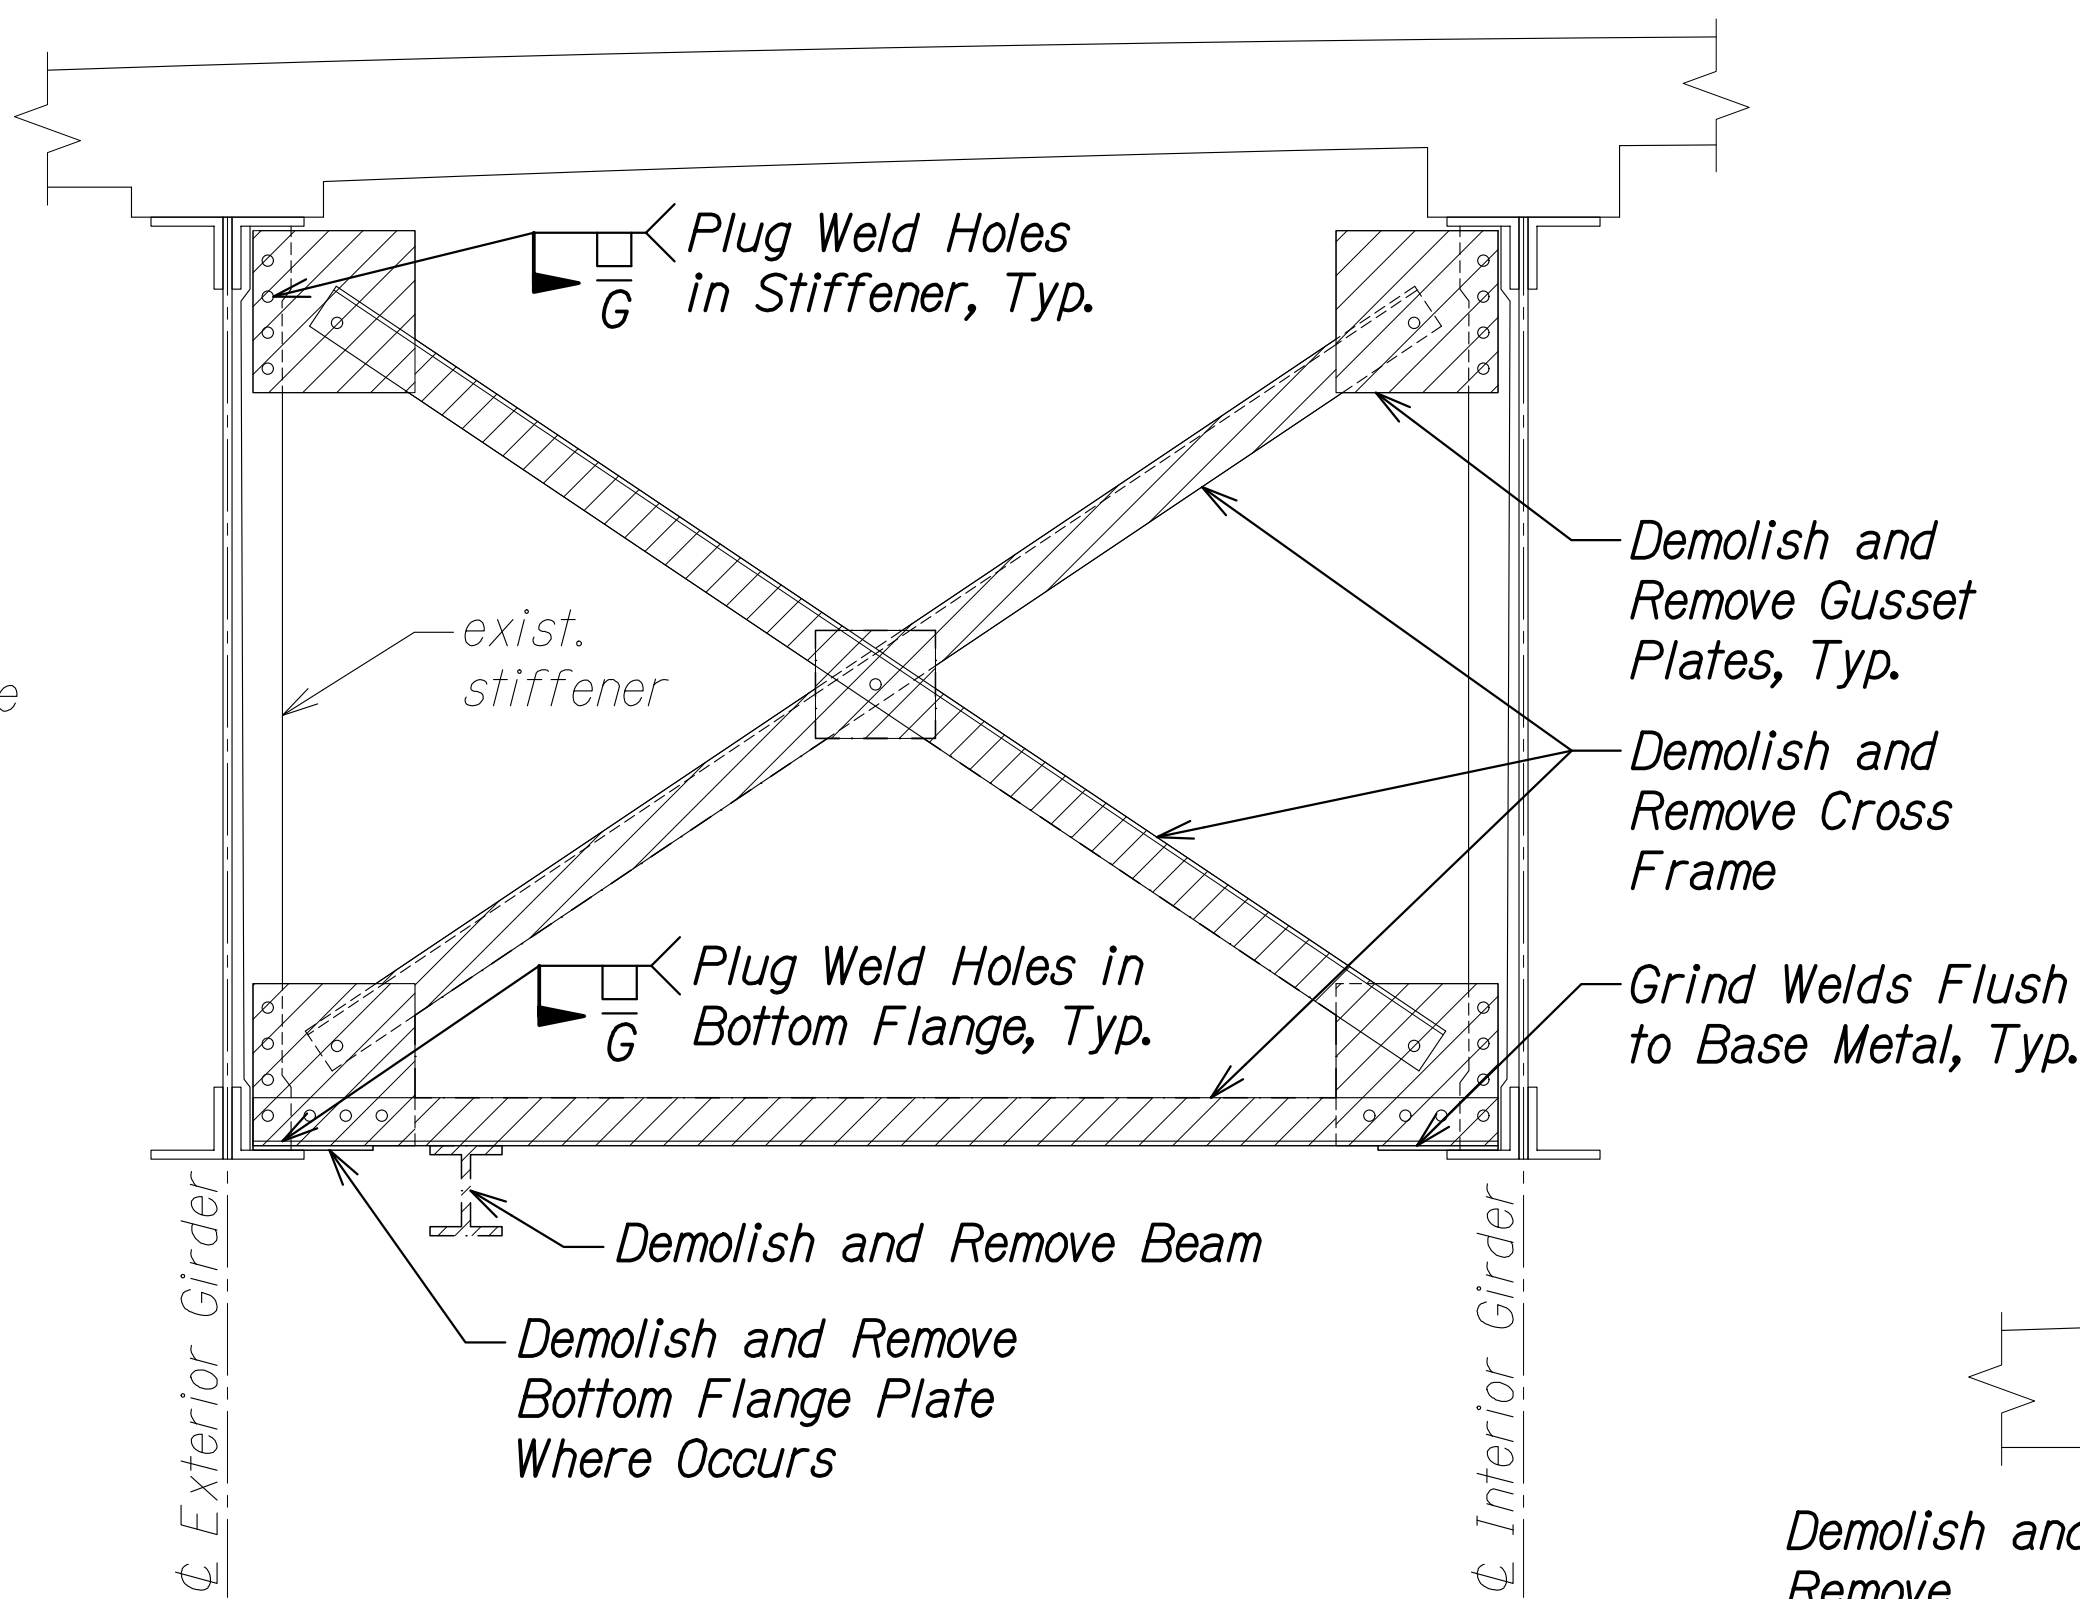


[C2] EXTERIOR BAY DEMO SECTION AT IN-SPAN CROSS FRAME
Scale: 3/4" = 1'-0"
SA10.6 SA10.6

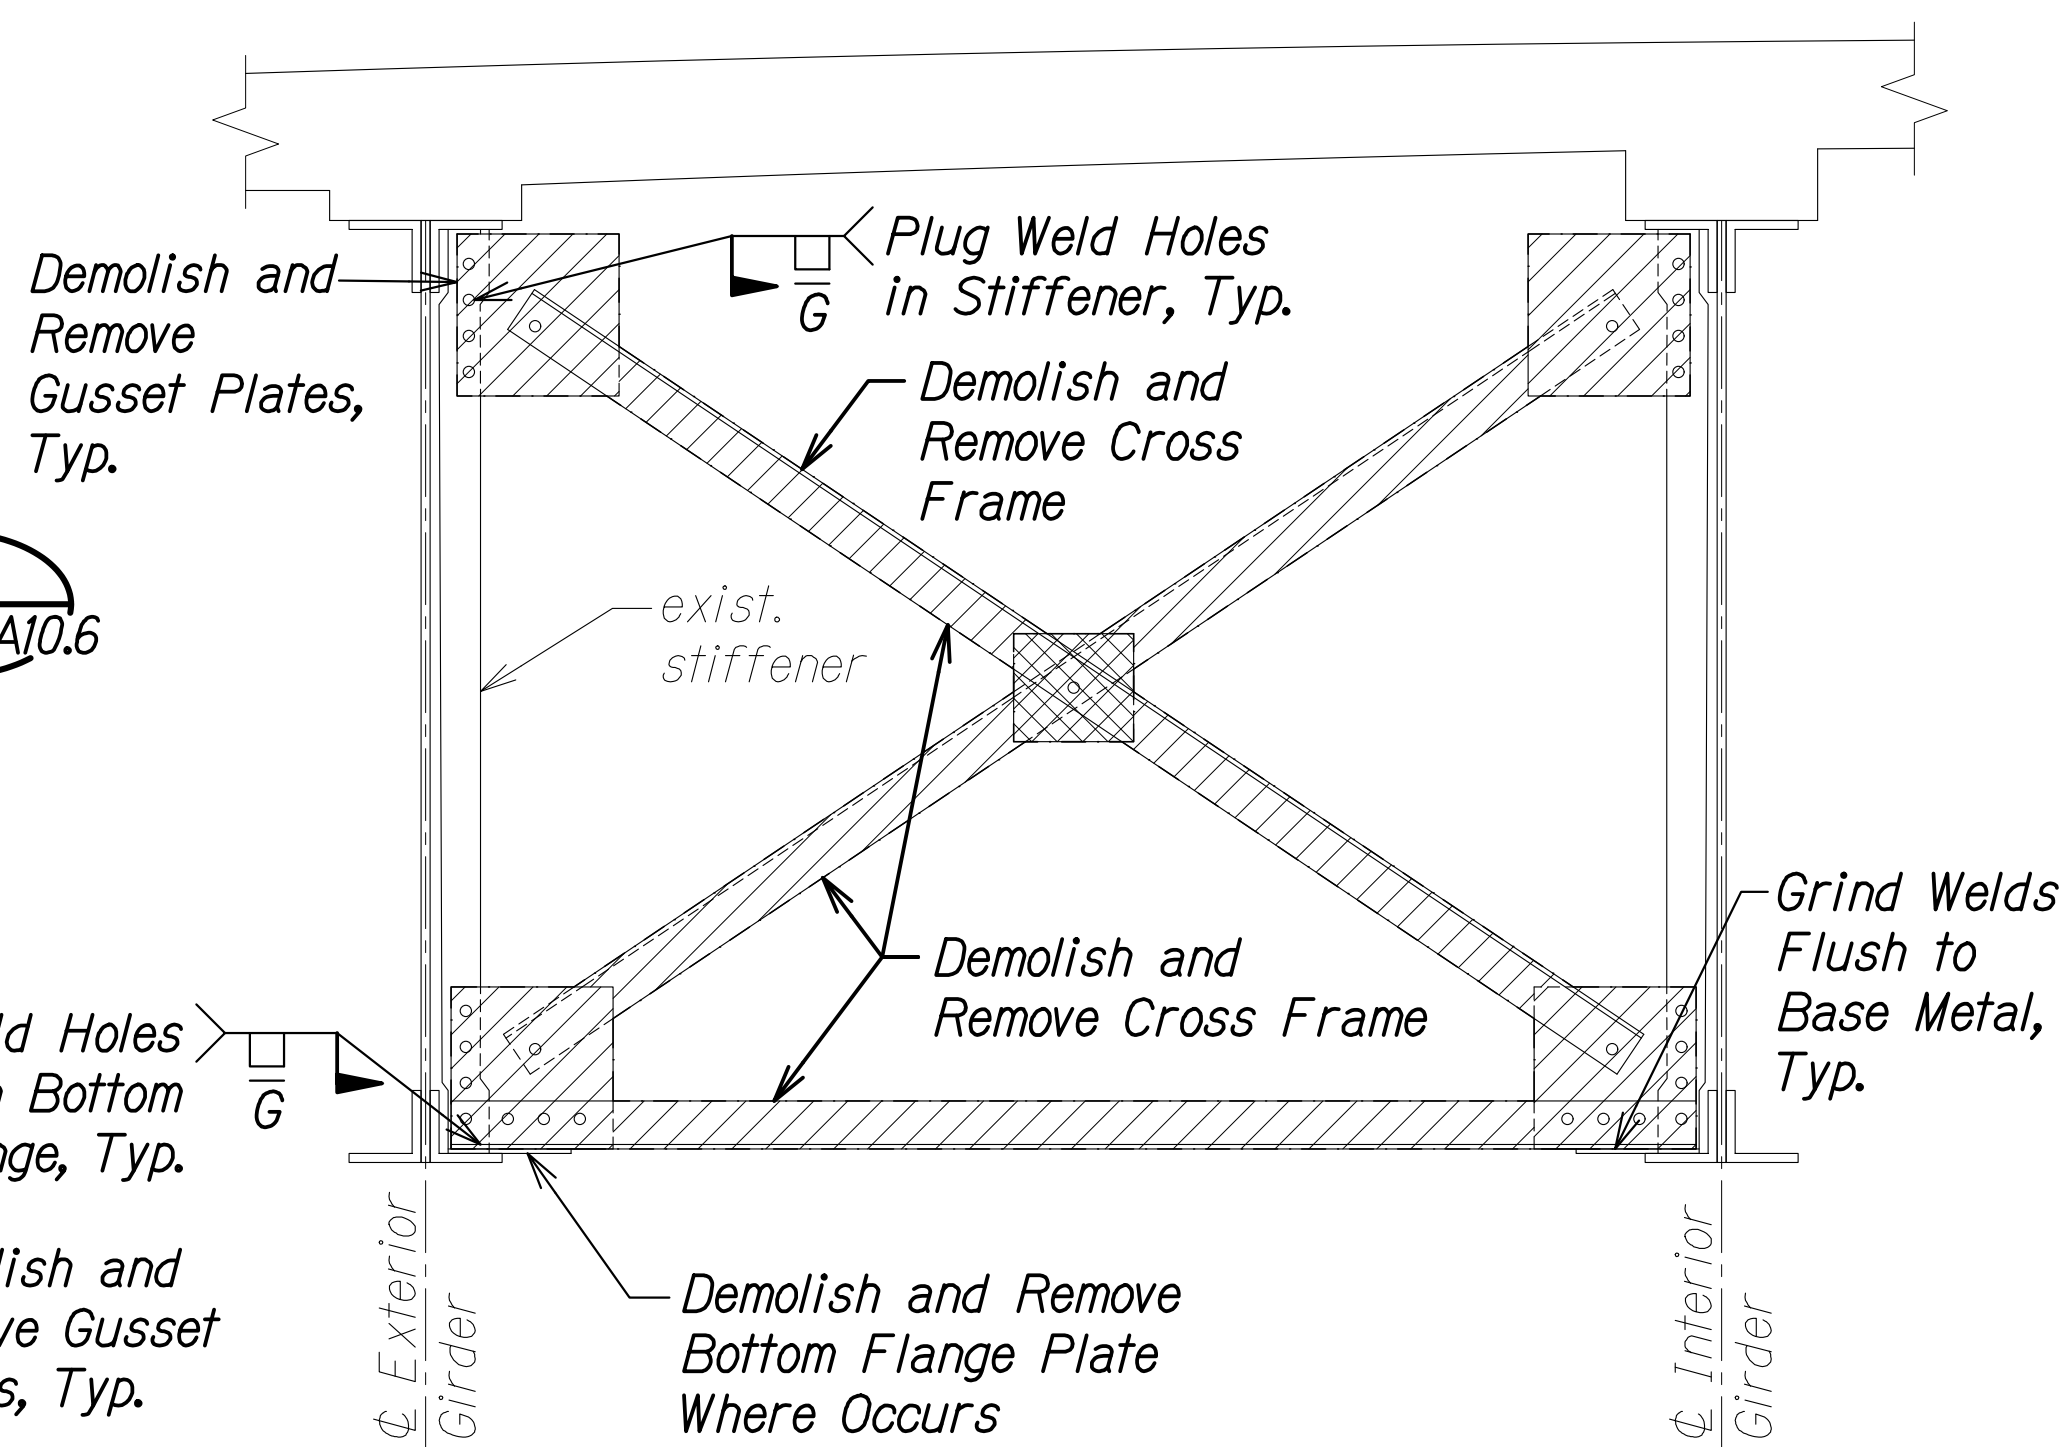


[C5] EXTERIOR BAY DEMO SECTION AT IN-SPAN CROSS FRAME
Scale: 3/4" = 1'-0"
SA10.6 SA10.6

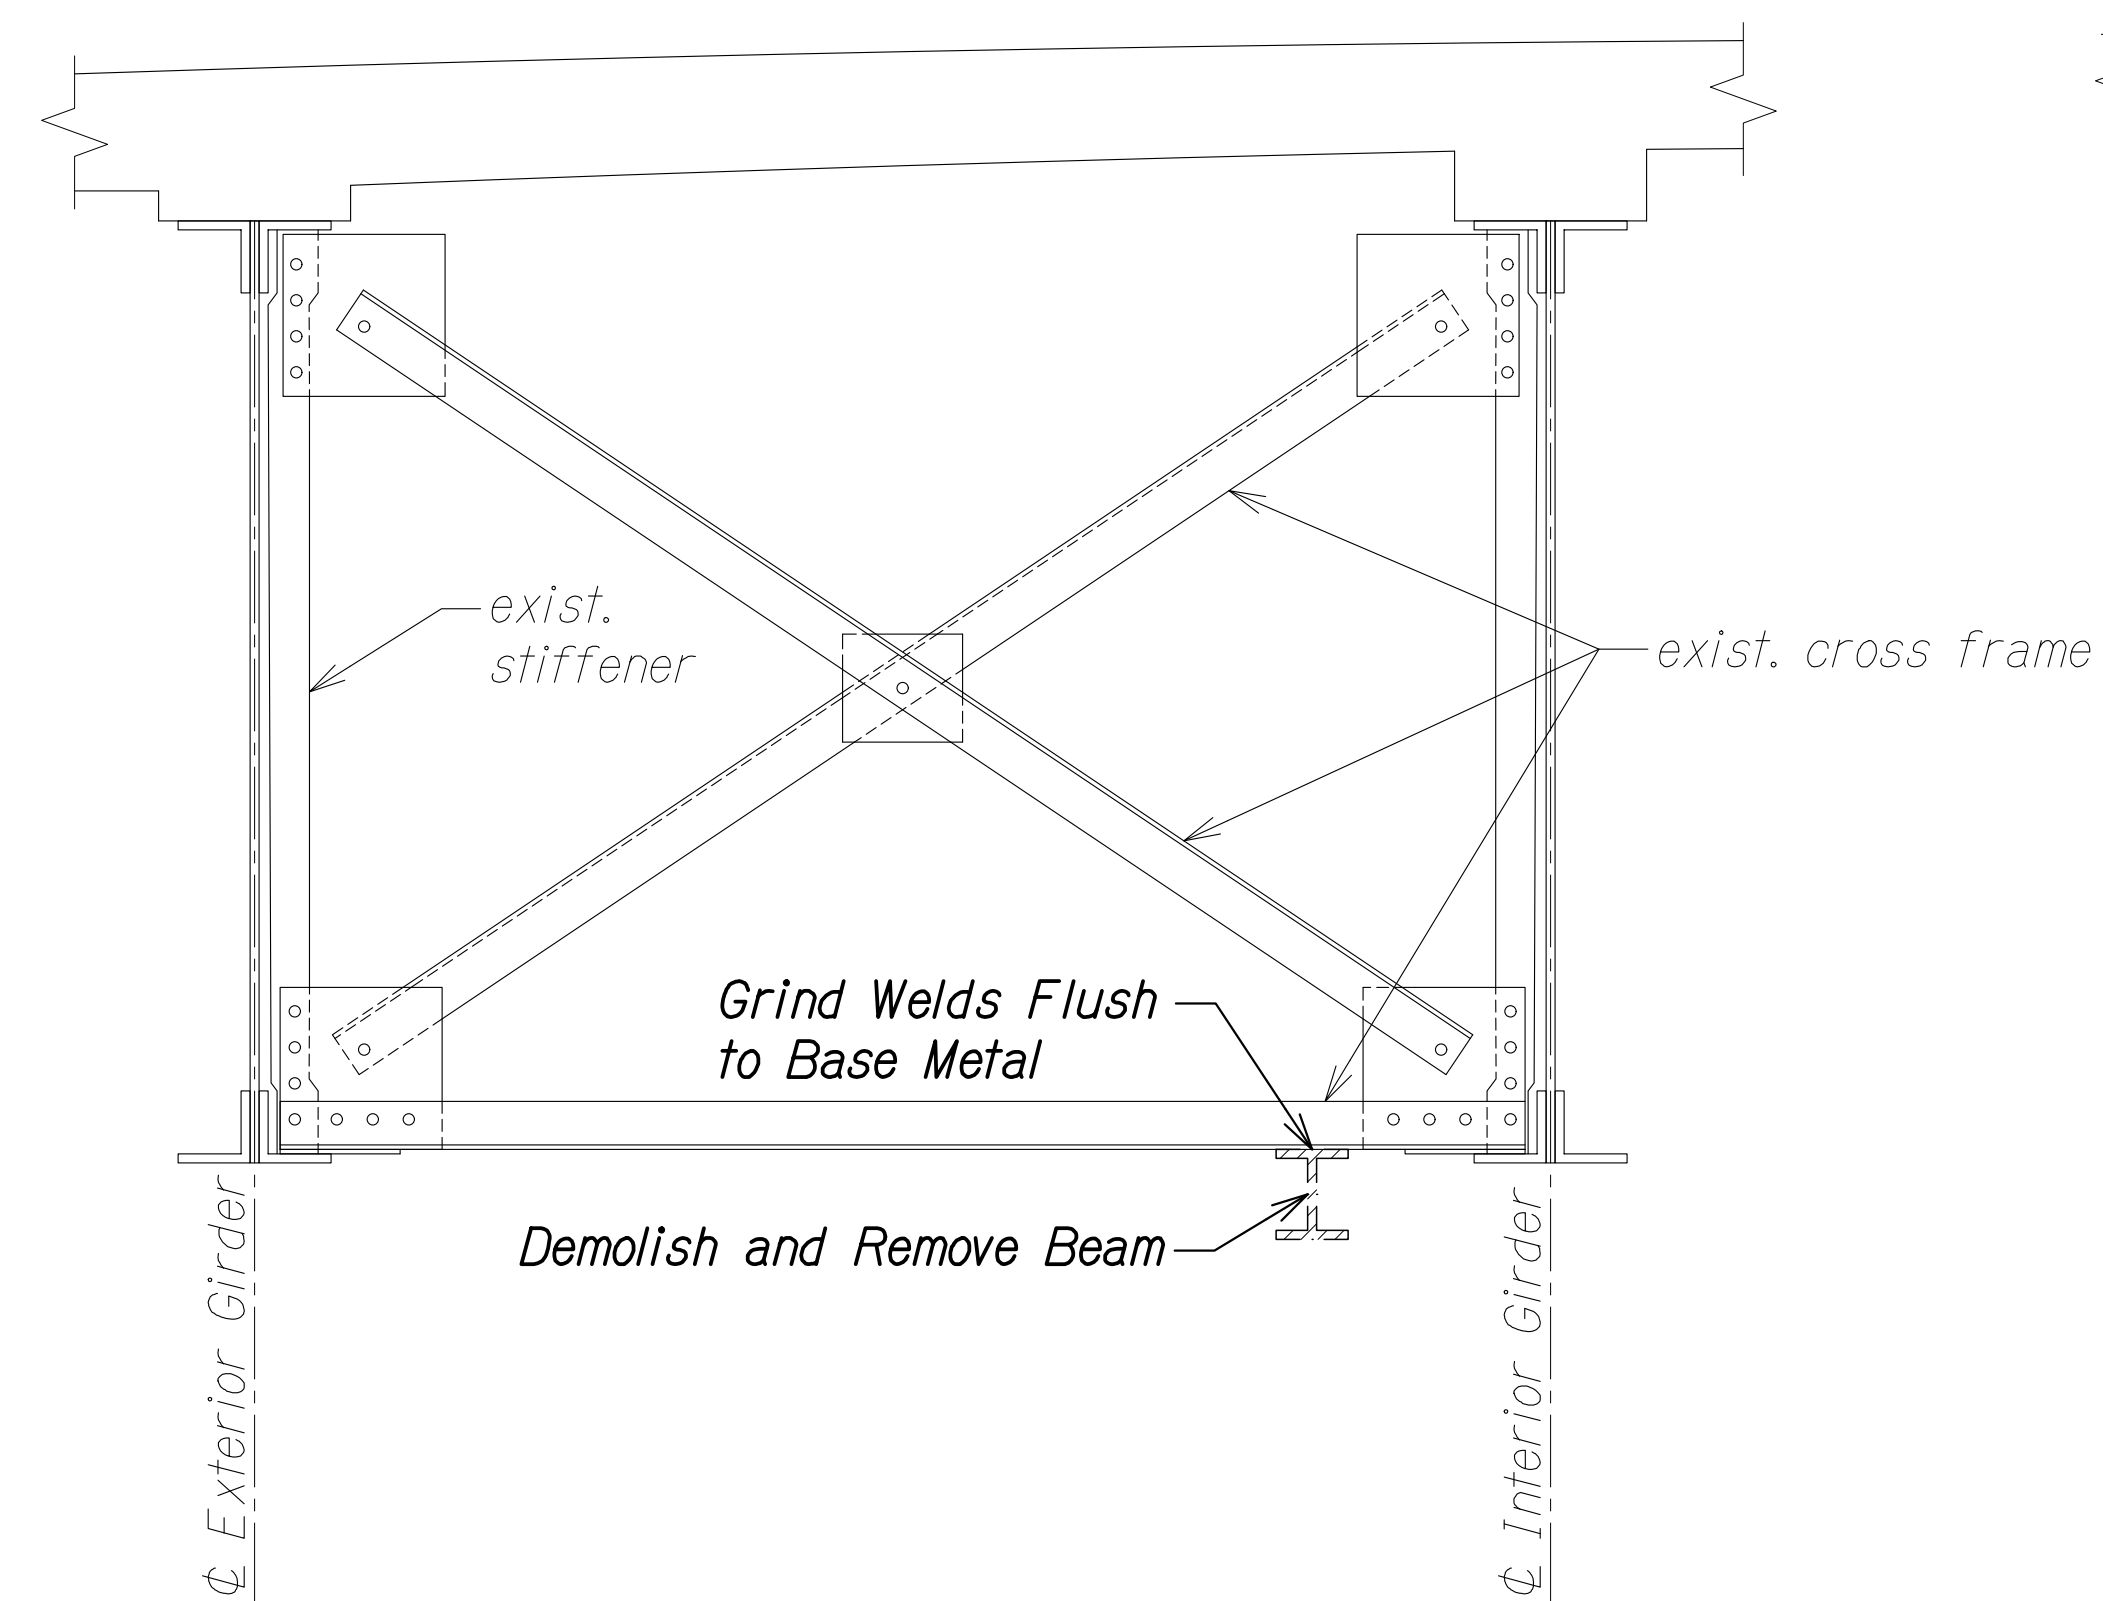

[C3] EXTERIOR BAY DEMO SECTION AT IN-SPAN CROSS FRAME
Scale: 3/4" = 1'-0"
SA10.6 SA10.6

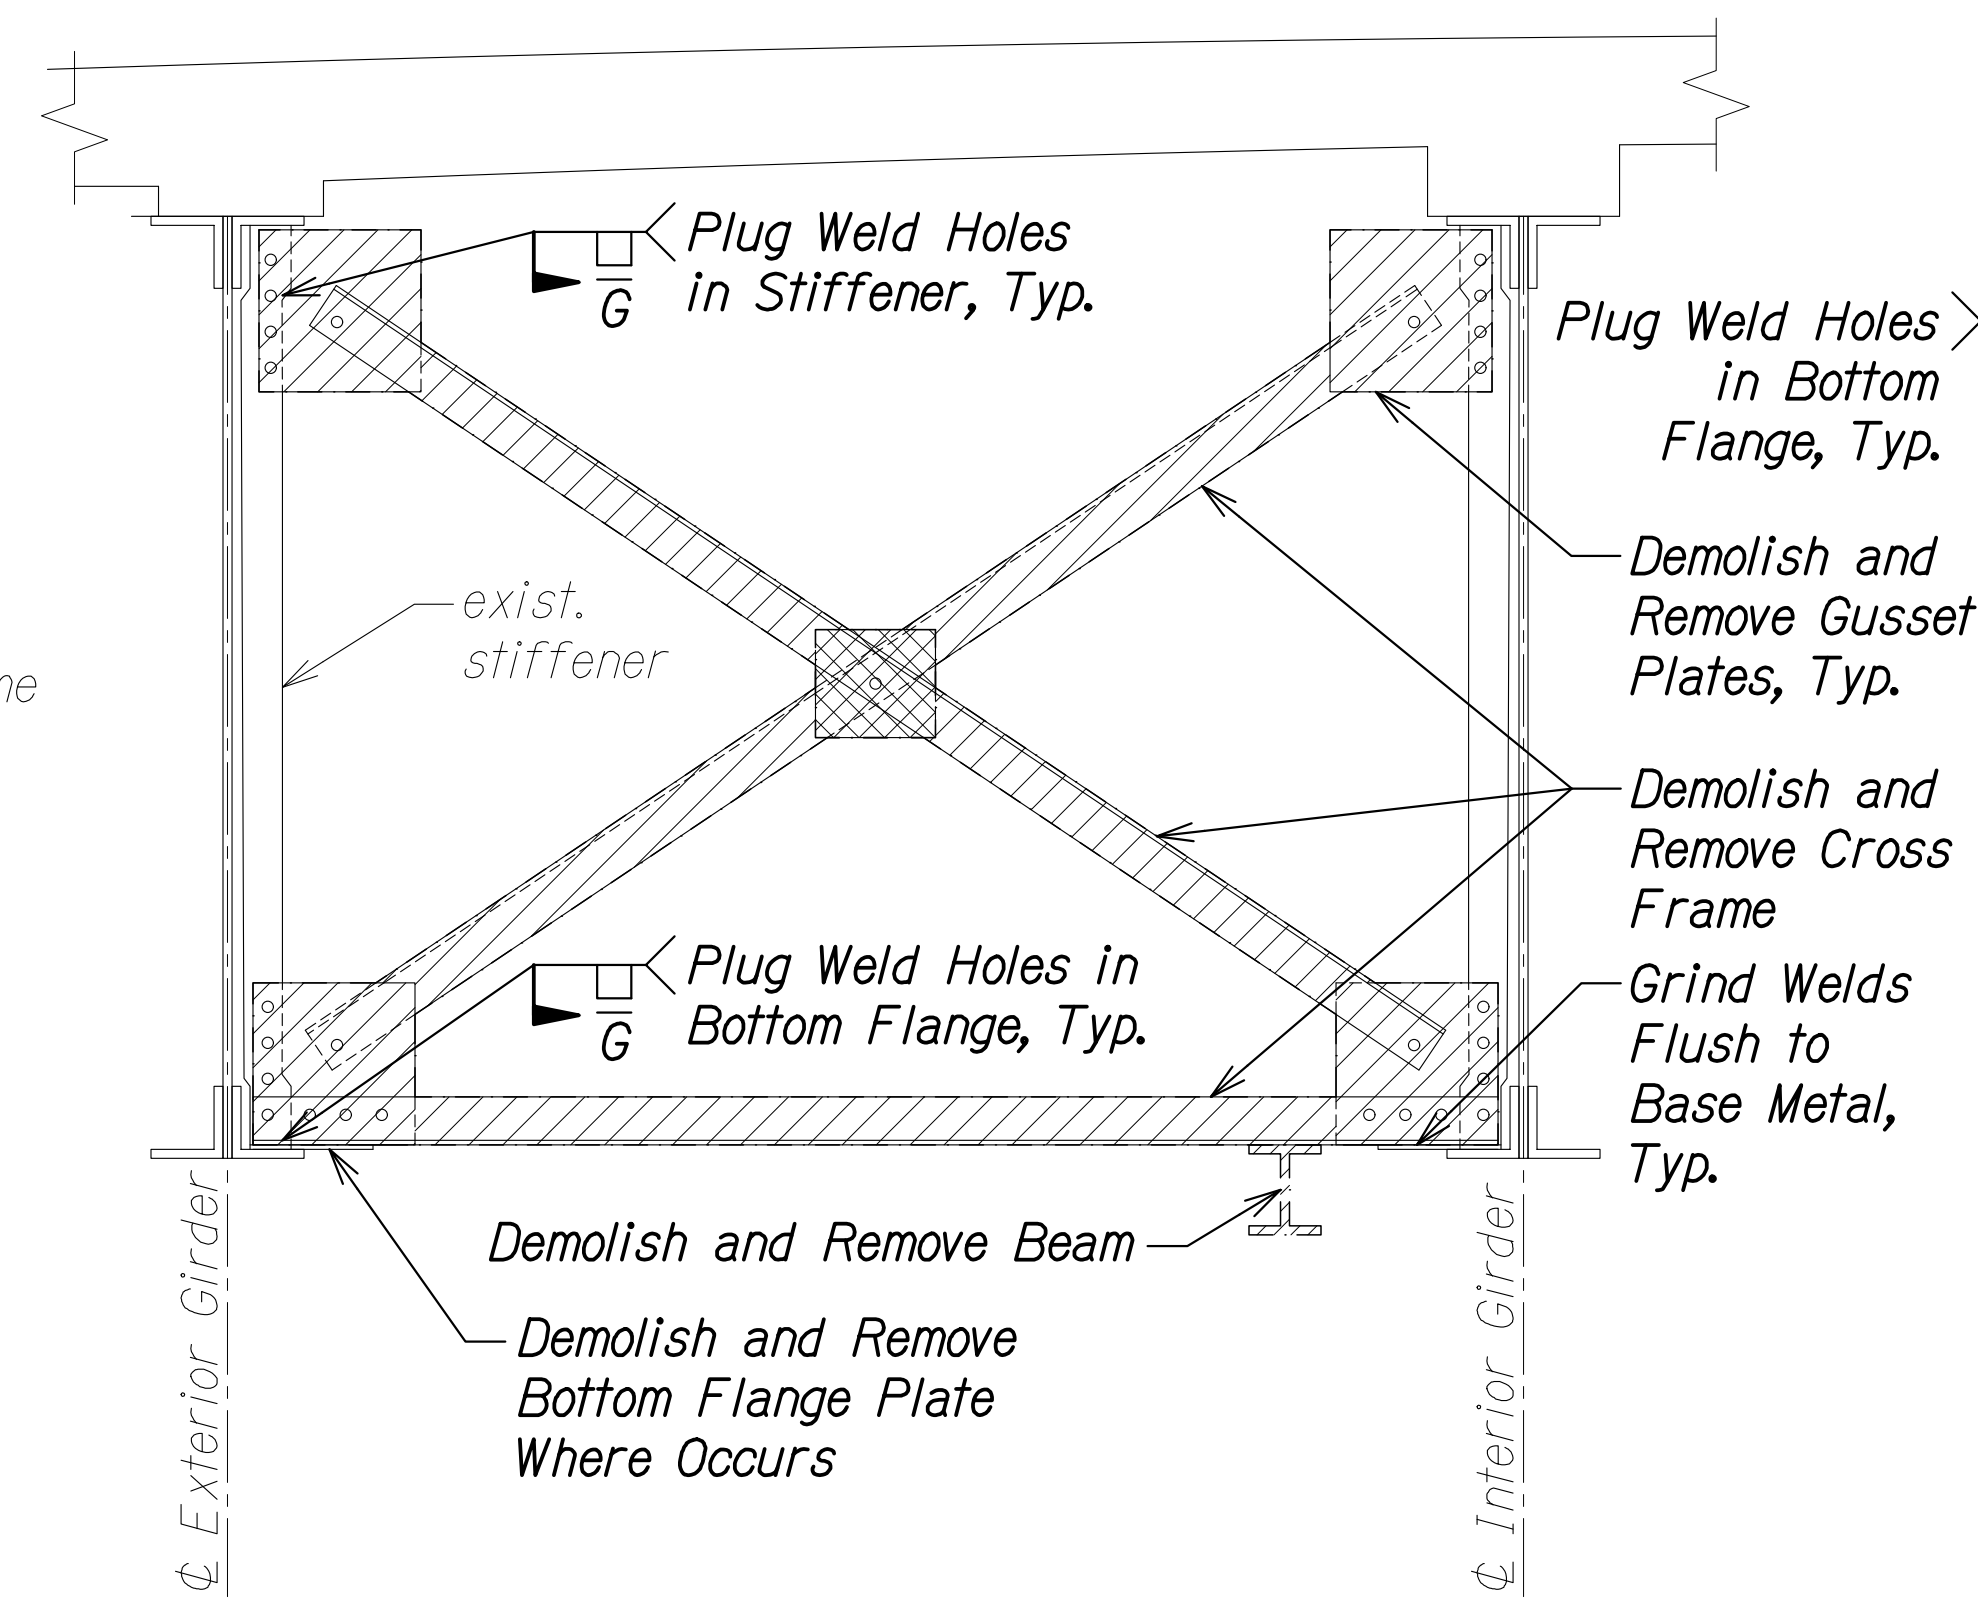

[C4] EXTERIOR BAY DEMO SECTION AT IN-SPAN CROSS FRAME
Scale: 3/4" = 1'-0"
SA10.6 SA10.6

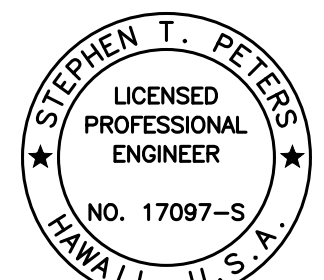

THIS WORK WAS PREPARED BY ME OR UNDER MY SUPERVISION.
SIGNATURE: *Stephen T. Peters* 4-30-26
EXPIRATION DATE OF THE LICENSE

12/6/24	<div>1</div>	Revised Note
DATE	REVISION	

STATE OF HAWAII
DEPARTMENT OF TRANSPORTATION
HIGHWAYS DIVISION

IN-SPAN CROSS FRAME
DEMOLITION SECTIONS
HAWAII BELT ROAD
Nanue Stream Bridge Rehabilitation
Federal Aid Project No. BR-019-2(077)

Scale: As Noted Date: Oct. 2024


SHEET NoSA10.6 OF 30 SHEETS

DRAWING NAME: Z:\00 ONGOING\23-022.9-NANUE STR BR PF2-DOT\A.01 CAD\12-06-24 ADD\NSR-SA1001-SA1009 STRUT DEMO SECT ADD2.DWG PLOT TIME: 12-03-24 10:32 PM

ORIGINAL PLAN	DATE
SURVEY PLOTTED BY	
DRAWN BY	
DESIGNED BY	
QUANTITIES BY	
CHECKED BY	
NOTE BOOK	
No.	

FED. ROAD DIST. NO.	STATE	FEDERAL AID PROJ. NO.	FISCAL YEAR	SHEET NO.	TOTAL SHEETS
HAWAII	HAW.	BR-019-2(077)	2024	ADD. 189	280

LEGEND:

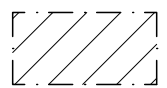


Demolish and Remove



[XX] Cross Frame Mark, See SA9.1 through SA9.5 for locations

NOTES:


- The Contractor shall take care when removing existing steel members so as not to damage the existing steel members to remain.
- Remove all exist. wood board inspection planks (not shown) and deliver to HDOT maintenance yard.
- Details beyond shown bay are not provided.
- See Sheet SA10.11 for miscellaneous demolition details

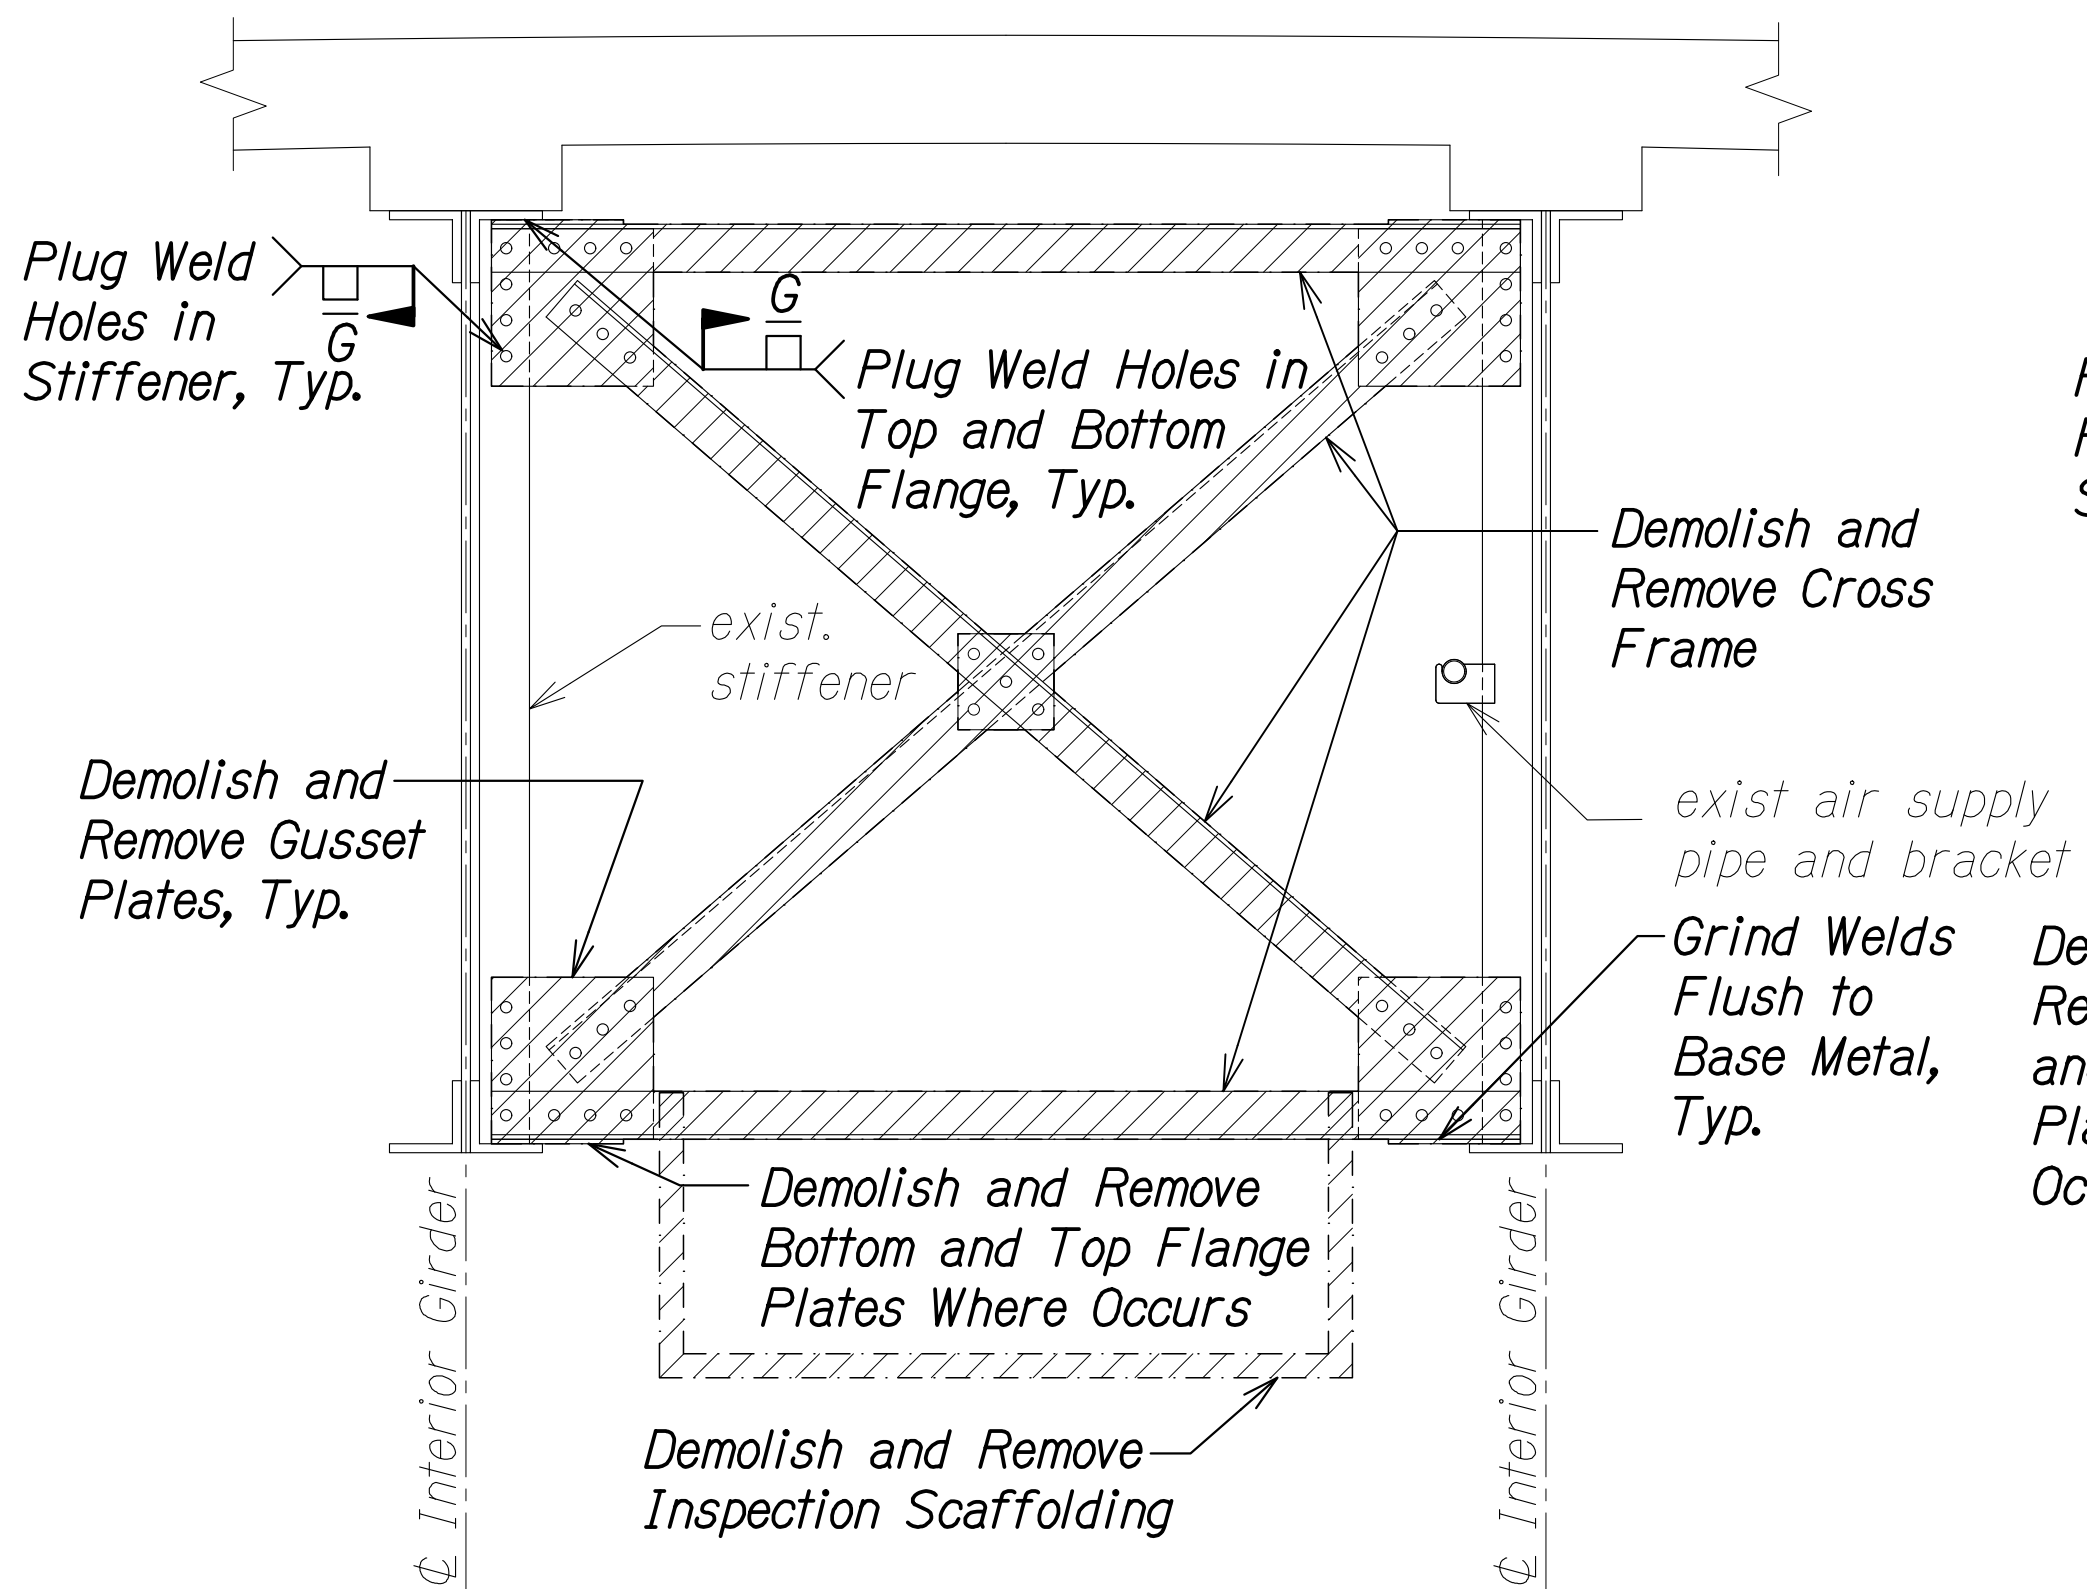

**[C6] INTERIOR BAY DEMO
SECTION AT IN-SPAN CROSS FRAME**

Scale: 3/4" = 1'-0"


SA10.7 A SA10.7

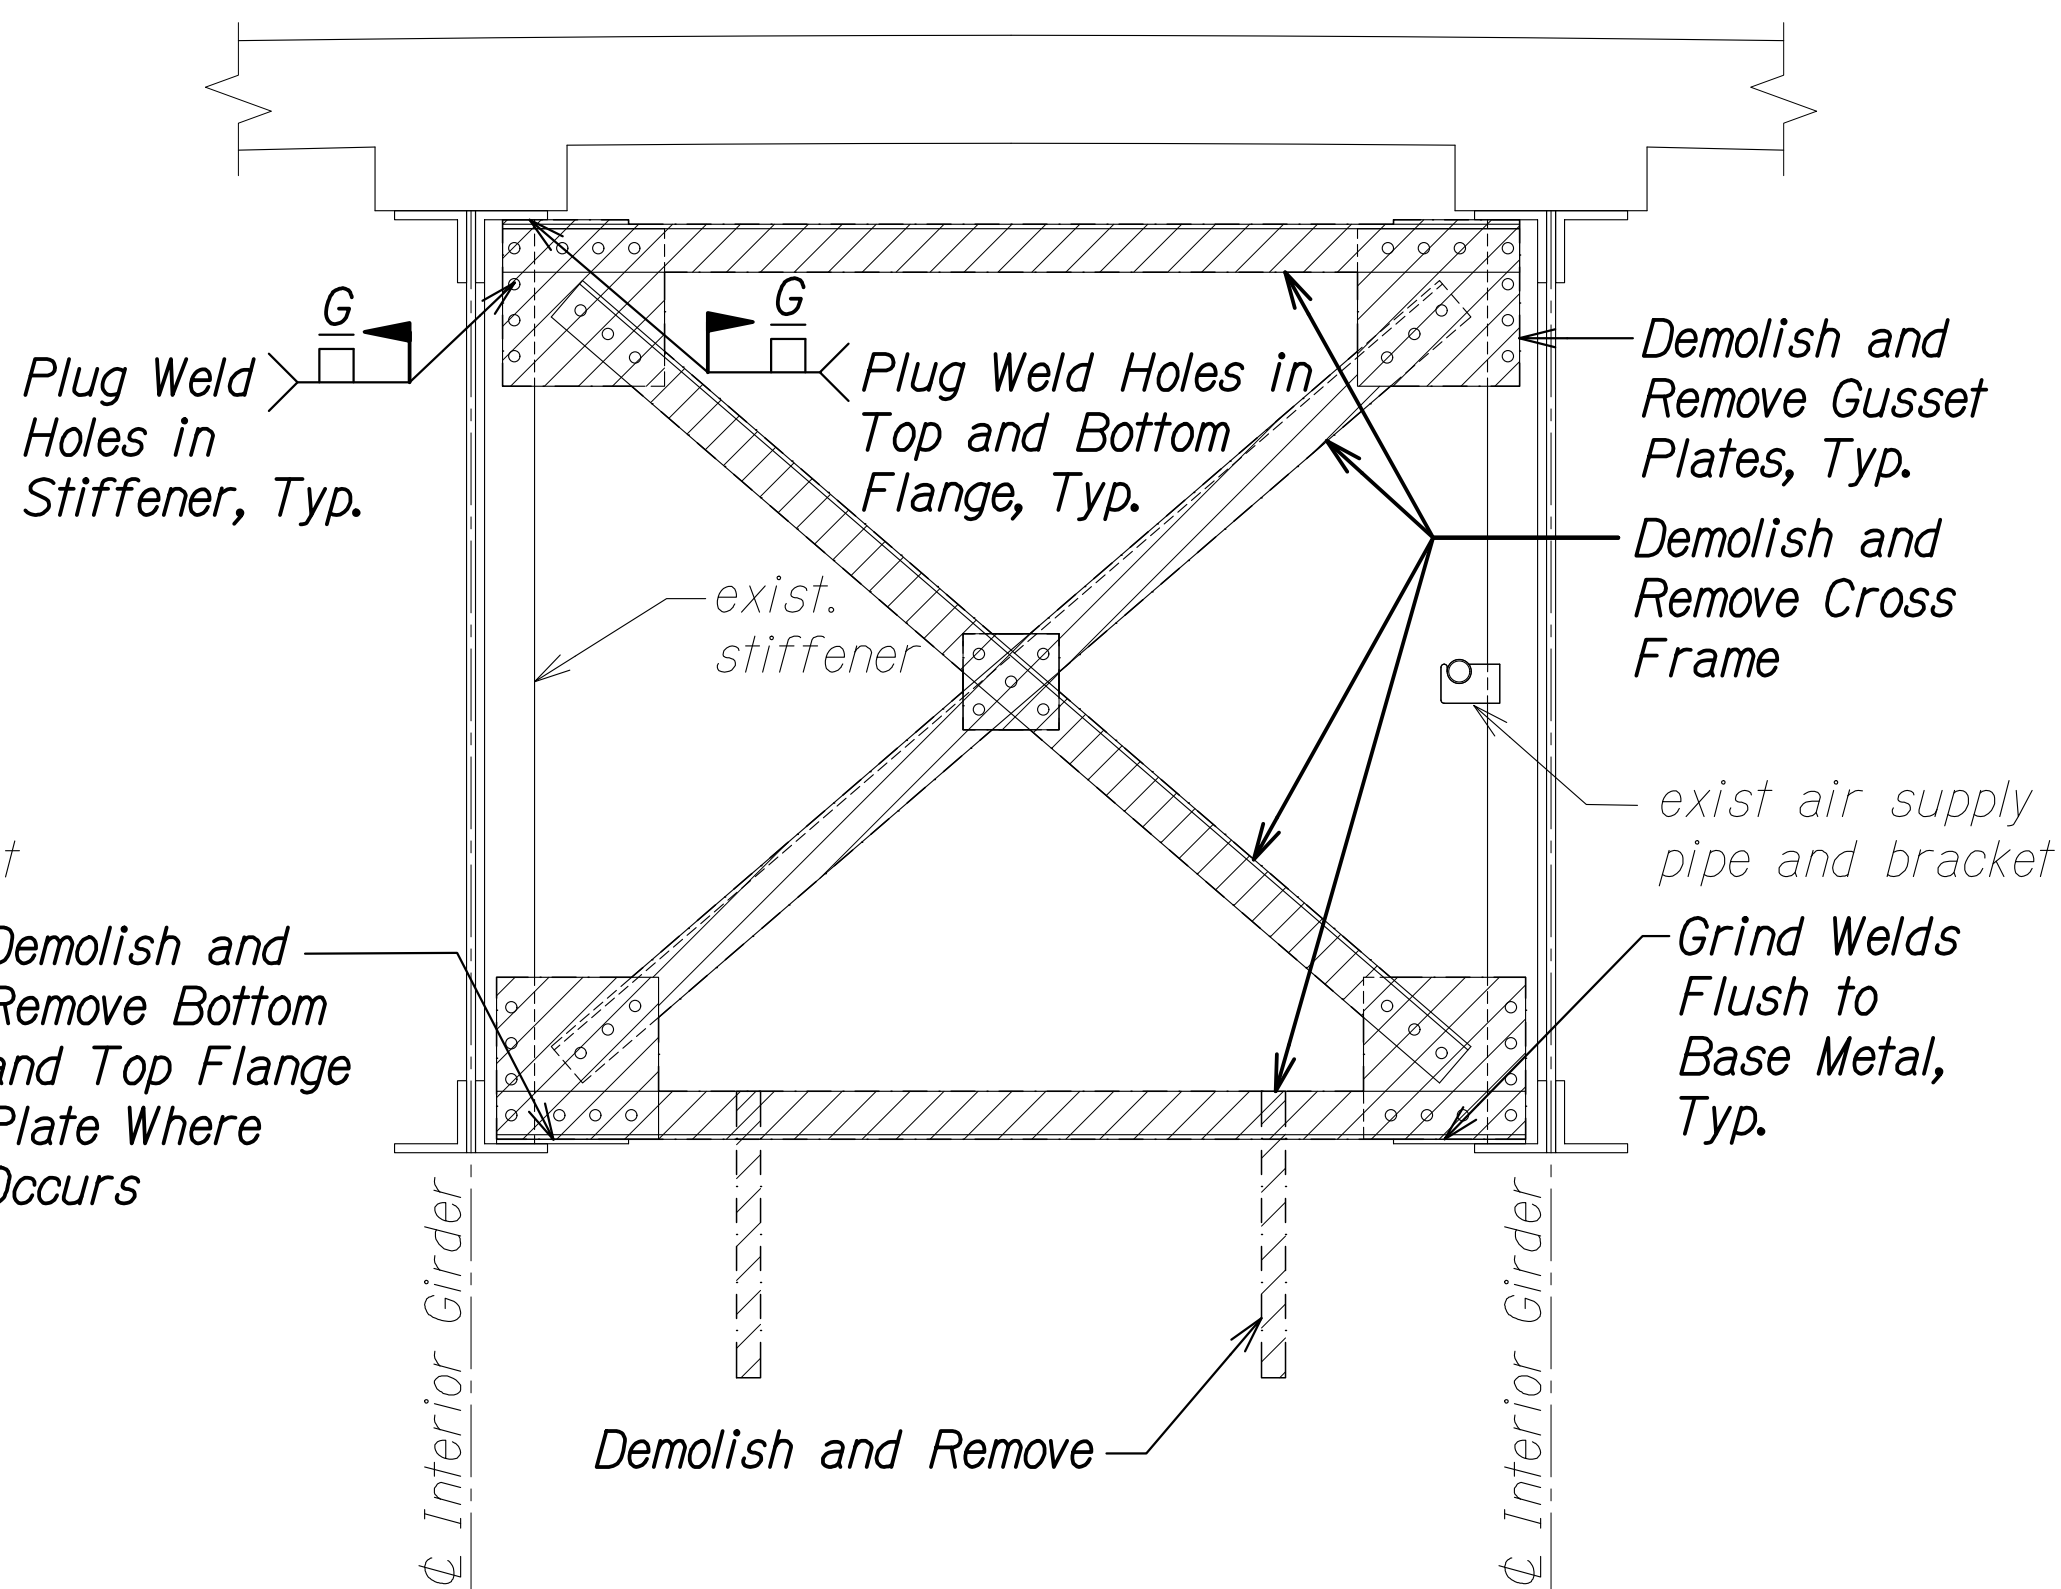

**[C7] INTERIOR BAY DEMO
SECTION AT IN-SPAN CROSS FRAME**

Scale: 3/4" = 1'-0"

SA10.7 B SA10.7

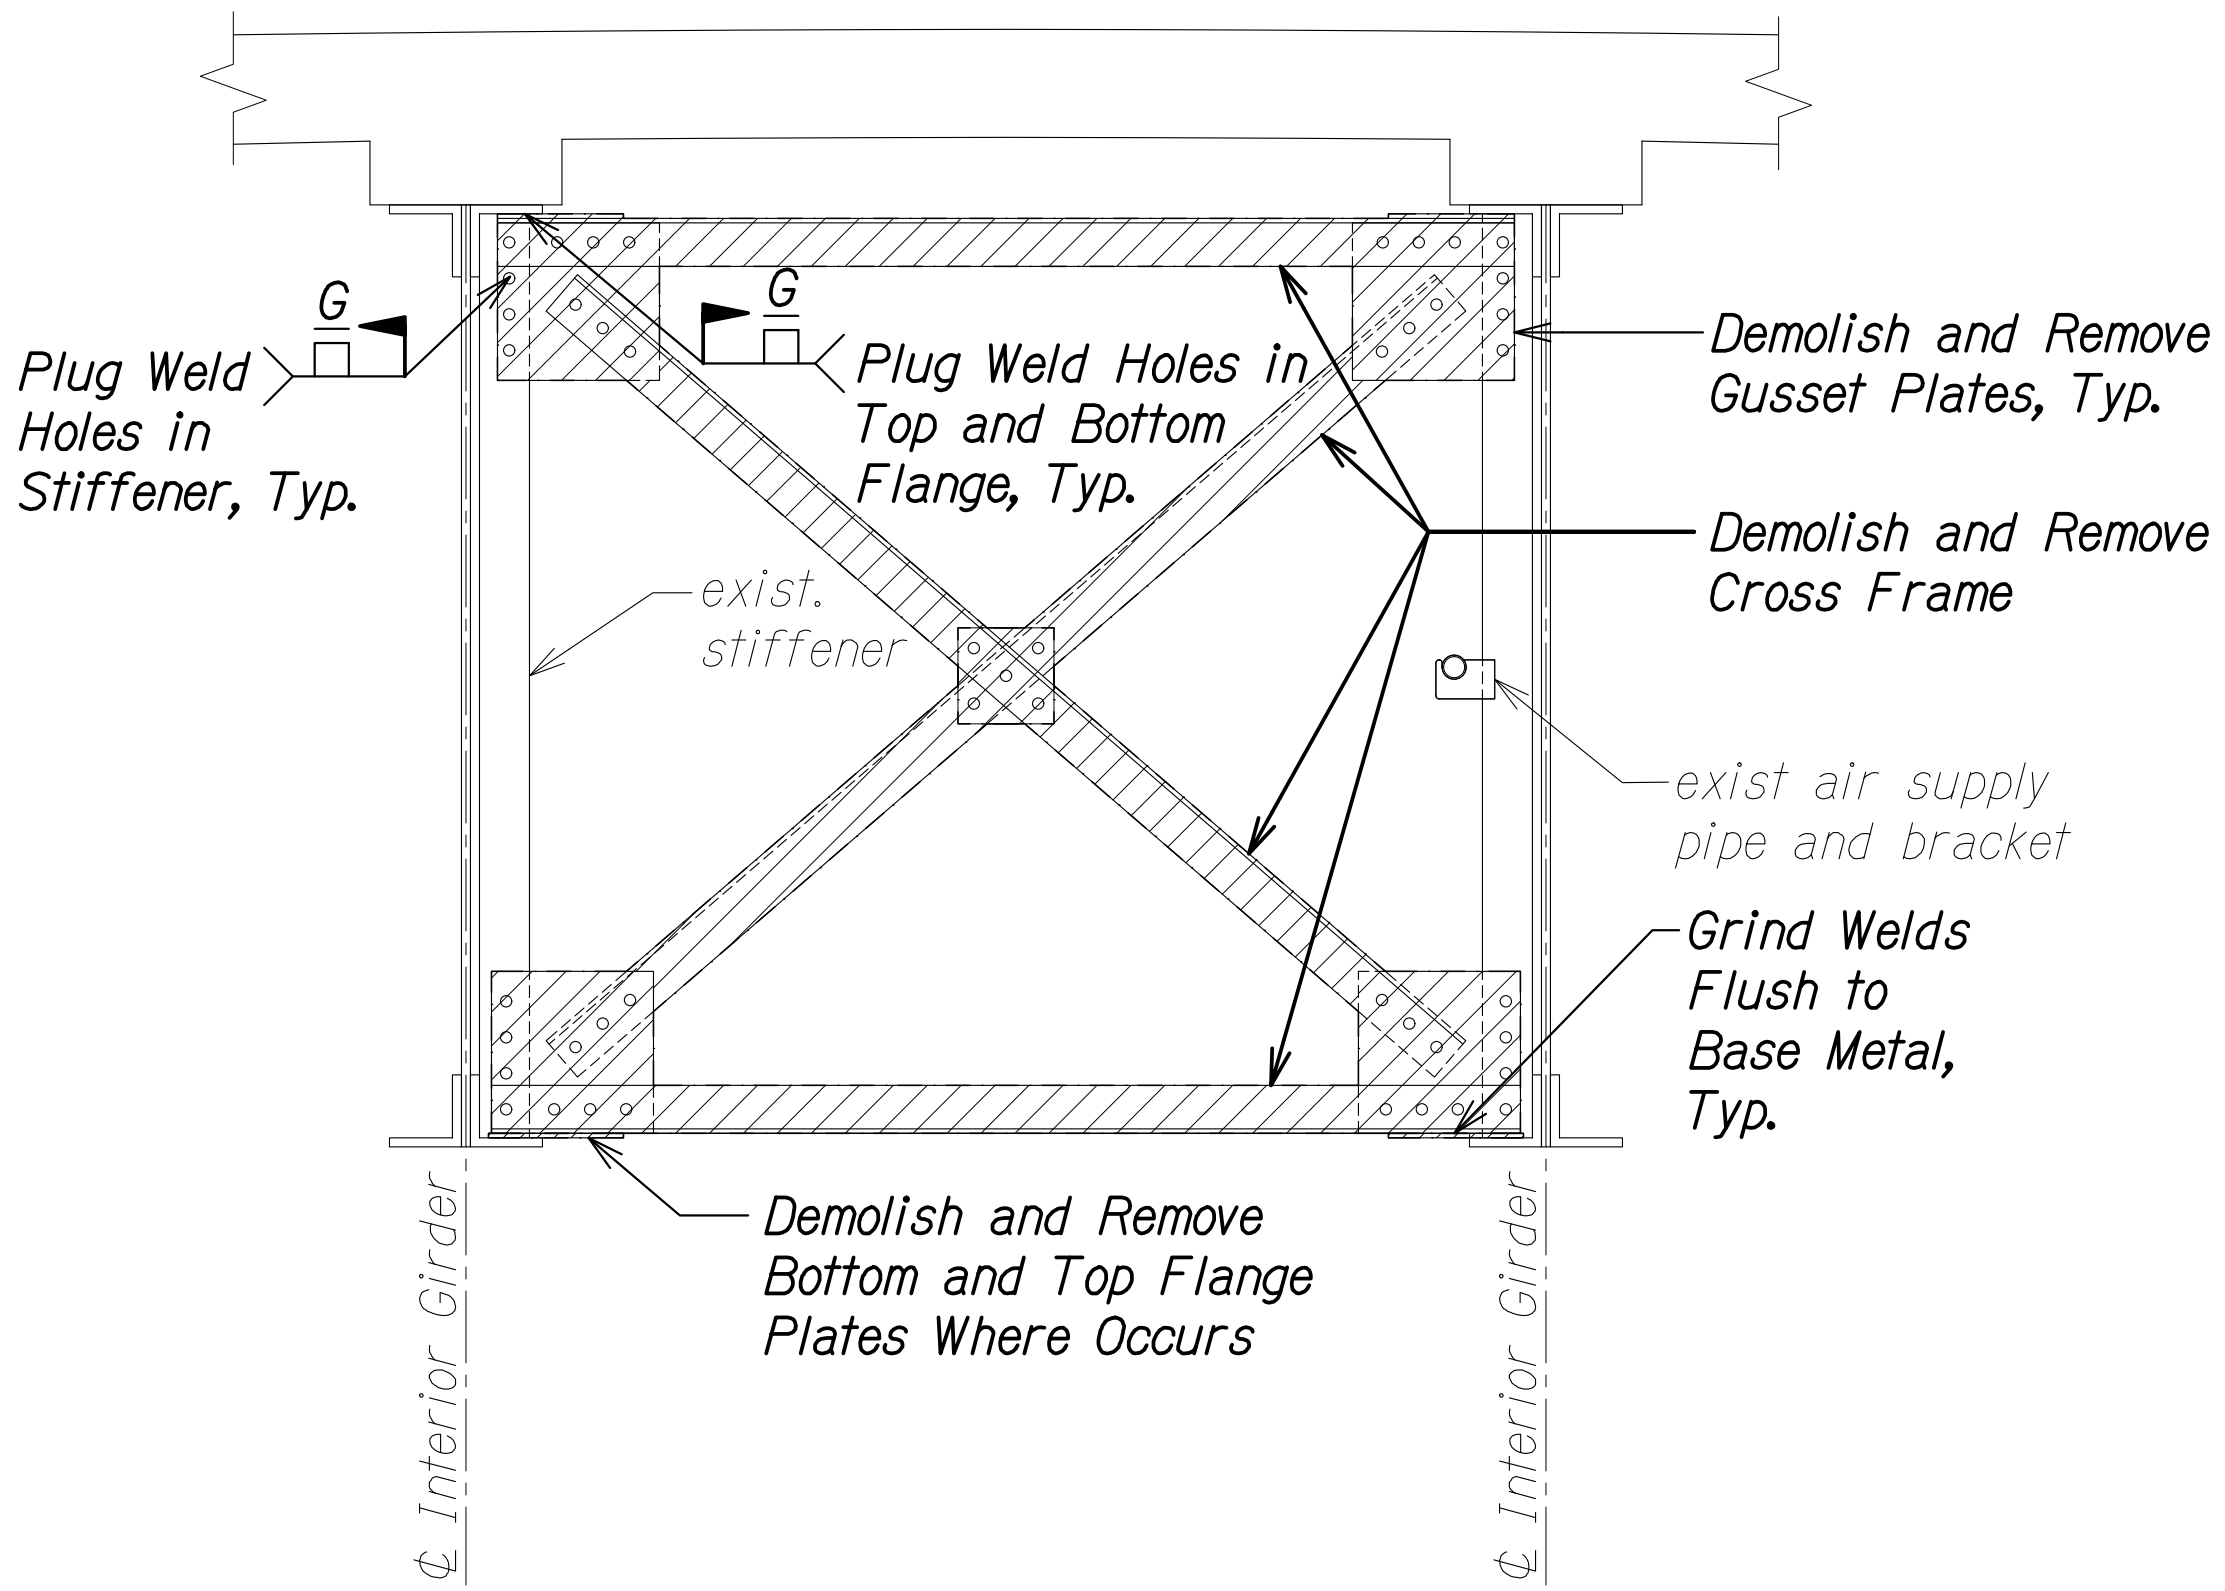


**[C8] INTERIOR BAY DEMO
SECTION AT IN-SPAN CROSS FRAME**

Scale: 3/4" = 1'-0"

SA10.7 C SA10.7

12/6/24	1	Revised Note
DATE		REVISION

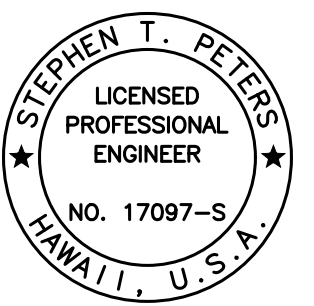

THIS WORK WAS PREPARED BY
ME OR UNDER MY SUPERVISION.
Stephen T. Peters
SIGNATURE EXPIRATION DATE OF THE LICENSE 4-30-26

STATE OF HAWAII
DEPARTMENT OF TRANSPORTATION
HIGHWAYS DIVISION
**IN-SPAN CROSS FRAME
DEMOLITION SECTIONS**
HAWAII BELT ROAD
Nanue Stream Bridge Rehabilitation
Federal Aid Project No. BR-019-2(077)
Scale: As Noted Date: Oct. 2024

ORIGINAL PLAN	SURVEY PLOTTED BY	DATE
NOTE BOOK	DRAWN BY	
No.	DESIGNED BY	
	CHECKED BY	

DRAWING NAME: Z:\00 ONGOING\23-022-9-NANUE STR BR PF2-DOT\A.01 CAD\12-06-24 ADD\NSR-SA1001-STRUT DEMO SECT ADD2.DWG PLOT TIME: 12-03-24 11:34 PM

FED. ROAD DIST. NO.	STATE	FEDERAL AID PROJ. NO.	FISCAL YEAR	SHEET NO.	TOTAL SHEETS
HAWAII	HAW.	BR-019-2(077)	2024	ADD. 190	280


LEGEND:

 Demolish and Remove

 [XXX] Cross Frame Mark, See SA9.1 through SA9.5 for locations

NOTES:


1. The Contractor shall take care when removing existing steel members so as not to damage the existing steel members to remain.
2. Remove all exist. wood board inspection planks (not shown) and deliver to HDOT maintenance yard.
3. Details beyond shown bay are not provided.
4. See Sheet SA10.11 for miscellaneous demolition details

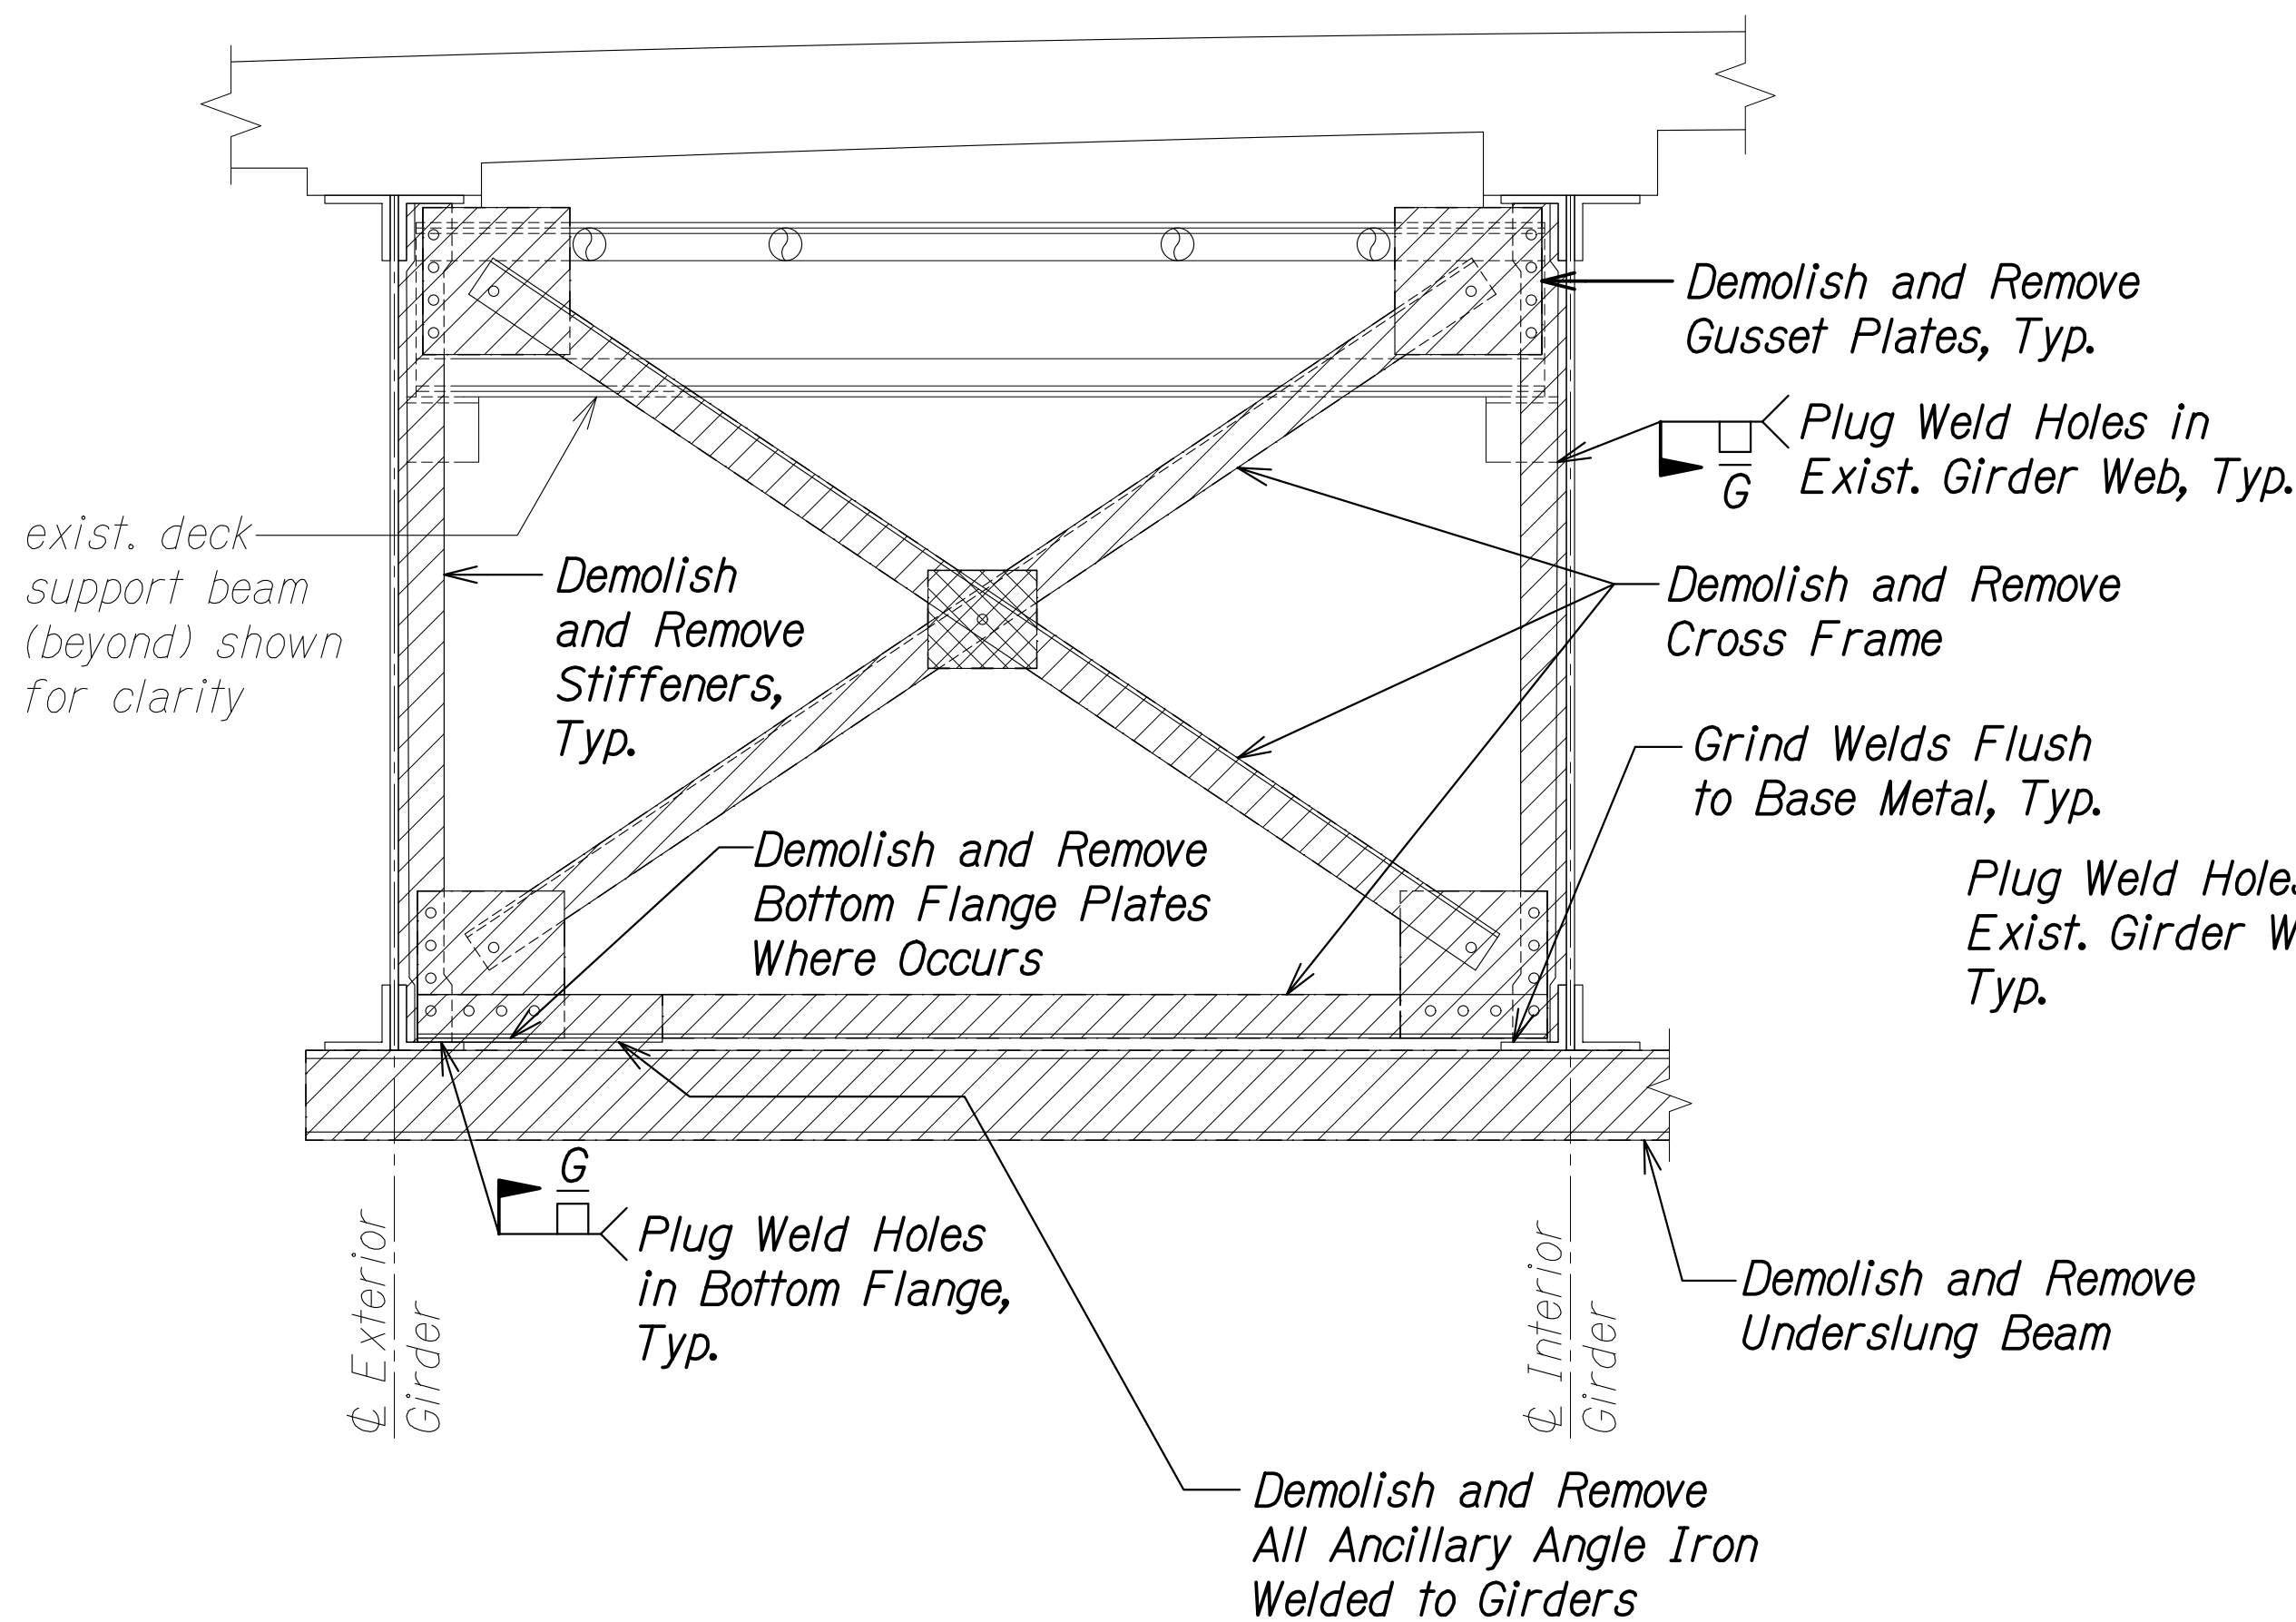

**[E1] EXTERIOR BAY DEMO SECTION
AT EXPANSION BEARING**

Scale: 3/4" = 1'-0"

A
SA10.8 SA10.8

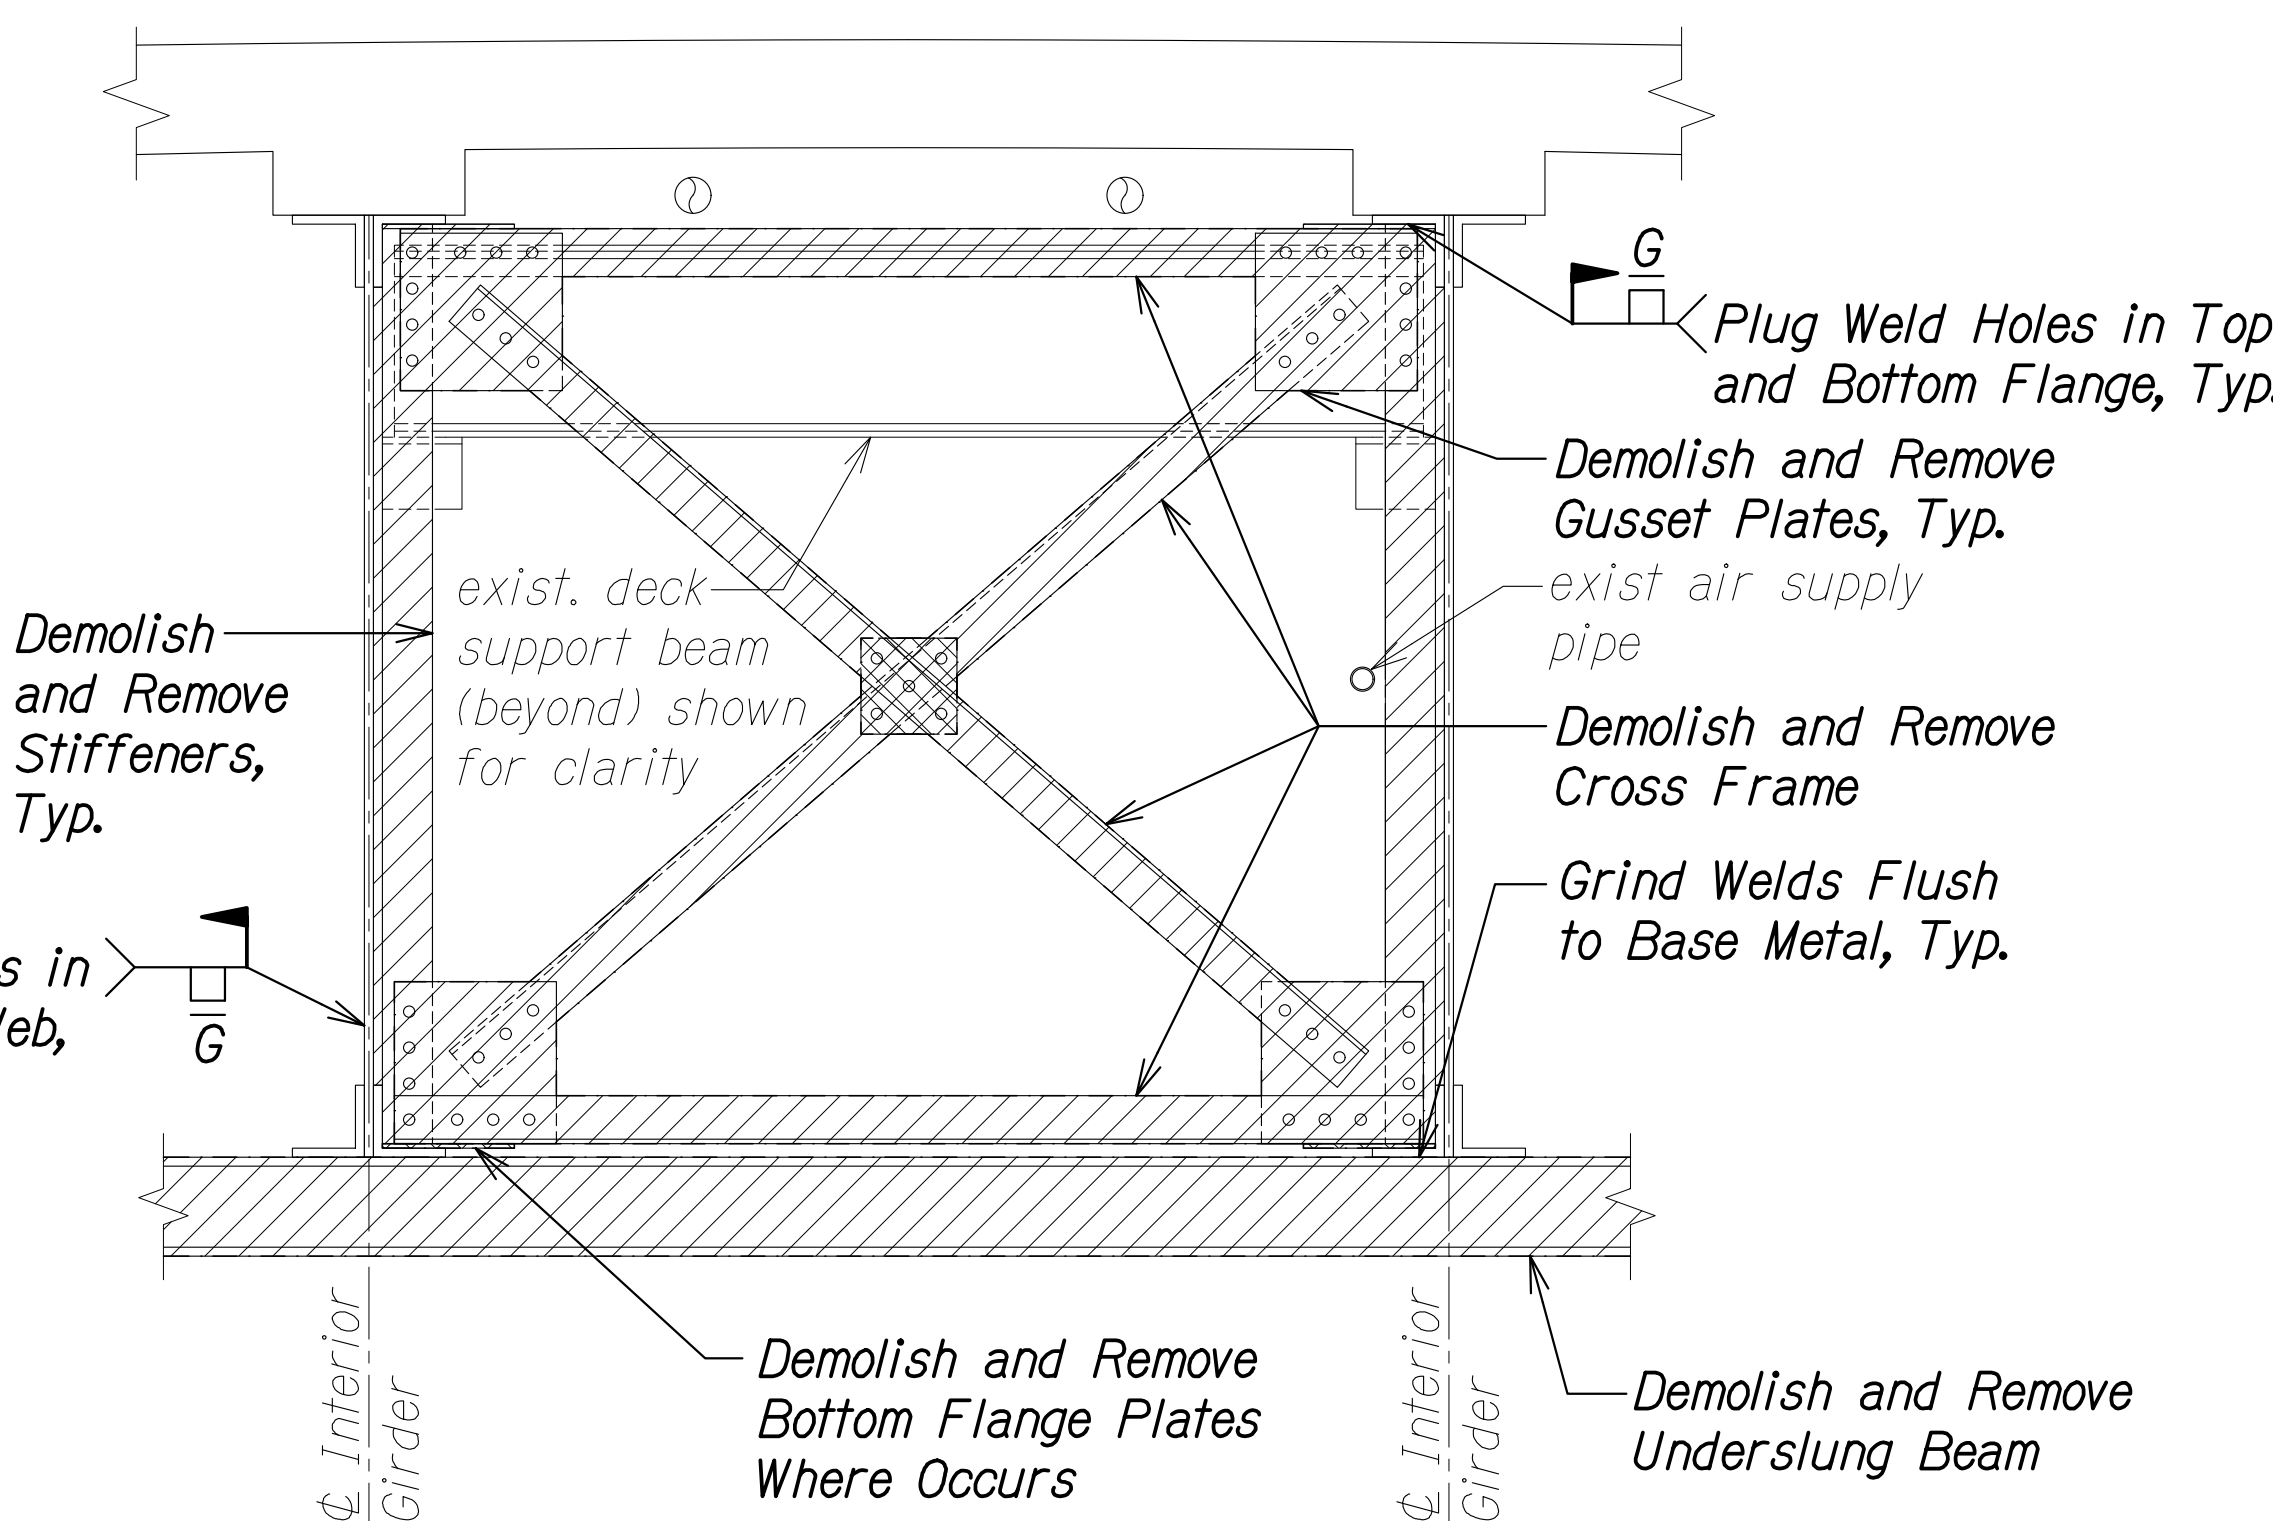


**[E2] TYPICAL INTERIOR BAY
DEMO SECTION AT EXPANSION BEARING**

Scale: 3/4" = 1'-0"

B
SA10.8 SA10.8

12/6/24  Revised Note

DATE REVISION

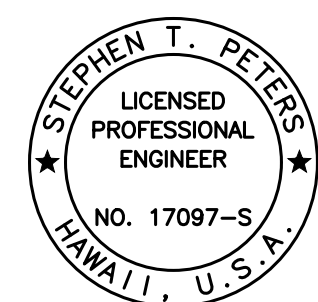

THIS WORK WAS PREPARED BY
ME OR UNDER MY SUPERVISION.


SIGNATURE EXPIRATION DATE OF THE LICENSE 4-30-26

STATE OF HAWAII
DEPARTMENT OF TRANSPORTATION
HIGHWAYS DIVISION
**EXPANSION BEARING CROSS FRAME
DEMOLITION SECTIONS**
HAWAII BELT ROAD
Nanue Stream Bridge Rehabilitation
Federal Aid Project No. BR-019-2(077)
Scale: As Noted Date: Oct. 2024

SHEET No SA10.8 OF 30 SHEETS

ADD. 190

ORIGINAL PLAN	SURVEY PLOTTED BY	DATE
NOTE BOOK	DRAWN BY	
No.	DESIGNED BY	
	QUANTITIES BY	
	CHECKED BY	

DRAWING NAME: Z:\00 ONGOING\23-022-9-NANUE STR BR PF2-DOT\A.01 CAD\12-06-24 ADD\NSR-SA1001-SA1009 STRUT DEMO SECT ADD2.DWG PLOT TIME: 12-03-24 10:33 PM

FED. ROAD DIST. NO.	STATE	FEDERAL AID PROJ. NO.	FISCAL YEAR	SHEET NO.	TOTAL SHEETS
HAWAII	HAW.	BR-019-2(077)	2024	ADD. 191	280


LEGEND:

 Demolish and Remove


 [XX] Cross Frame Mark, See SA9.1 through SA9.5 for locations

NOTES:


- The Contractor shall take care when removing existing steel members so as not to damage the existing steel members to remain.
- Remove all exist. wood board inspection planks (not shown) and deliver to HDOT maintenance yard.
- Details beyond shown bay are not provided.
- See Sheet SA10.11 for miscellaneous demolition details.

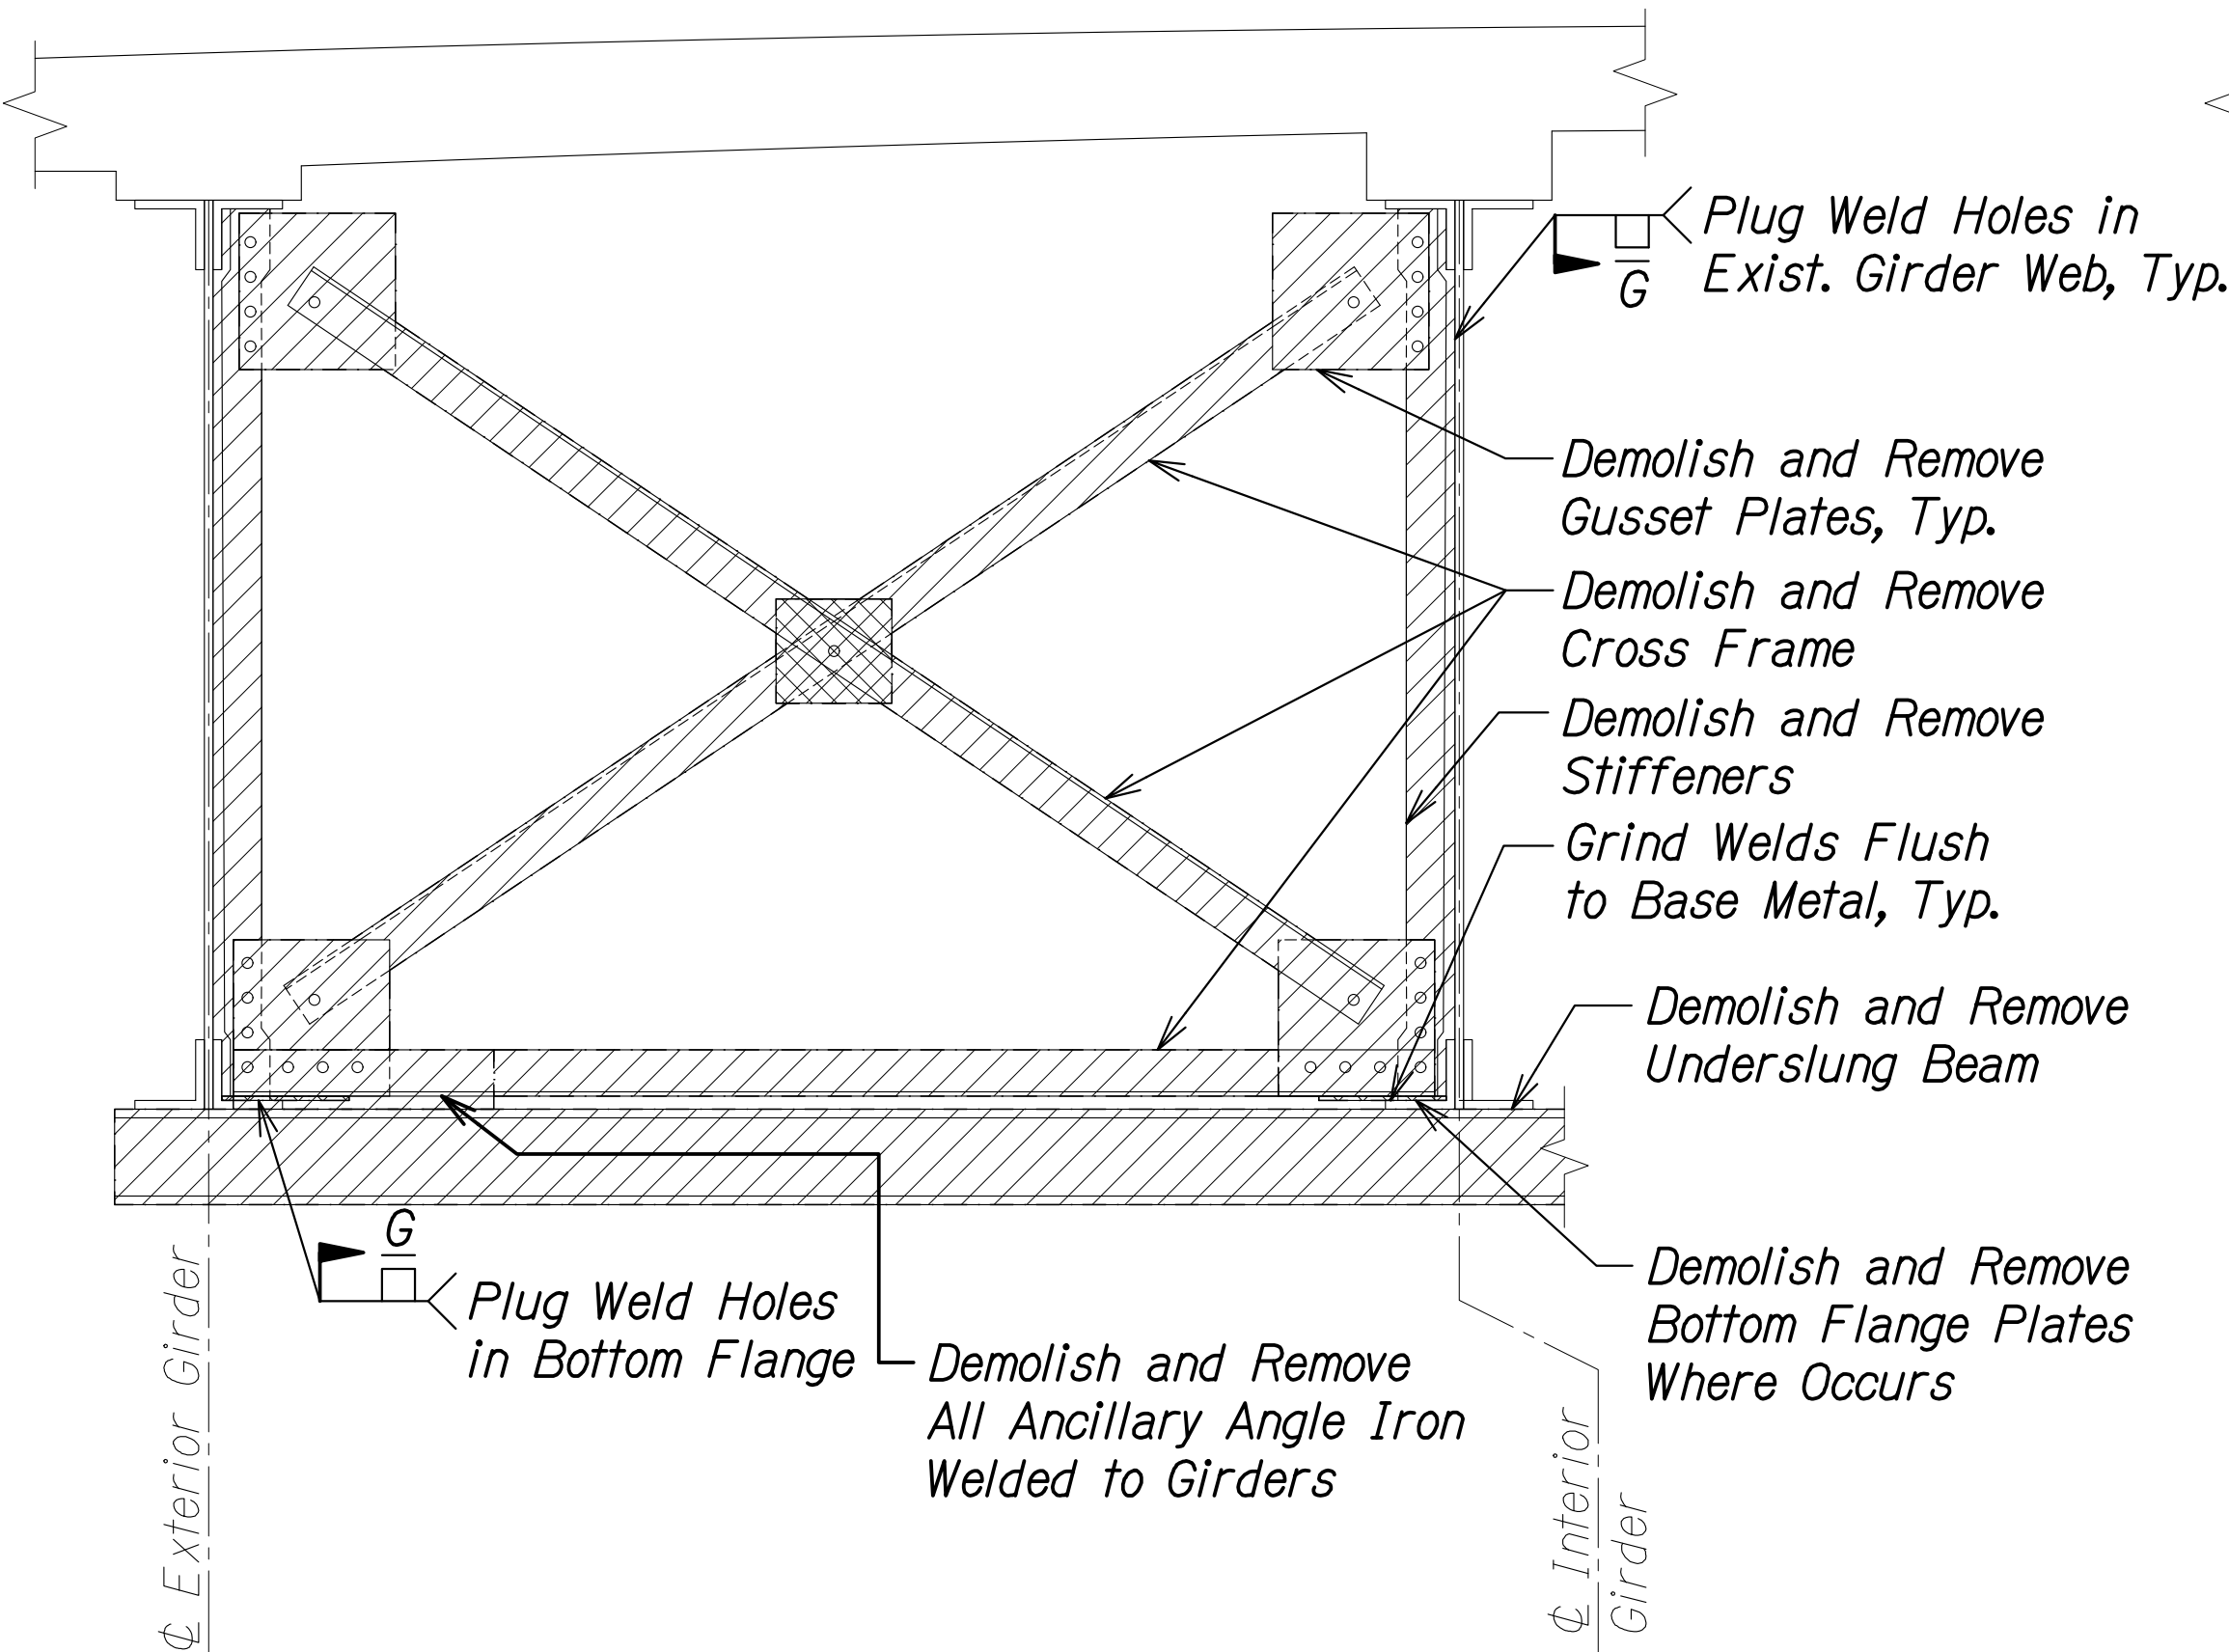


[F1] EXTERIOR BAY DEMO SECTION
AT FIXED BEARING
Scale: 3/4" = 1'-0"
SA10.9 SA10.9

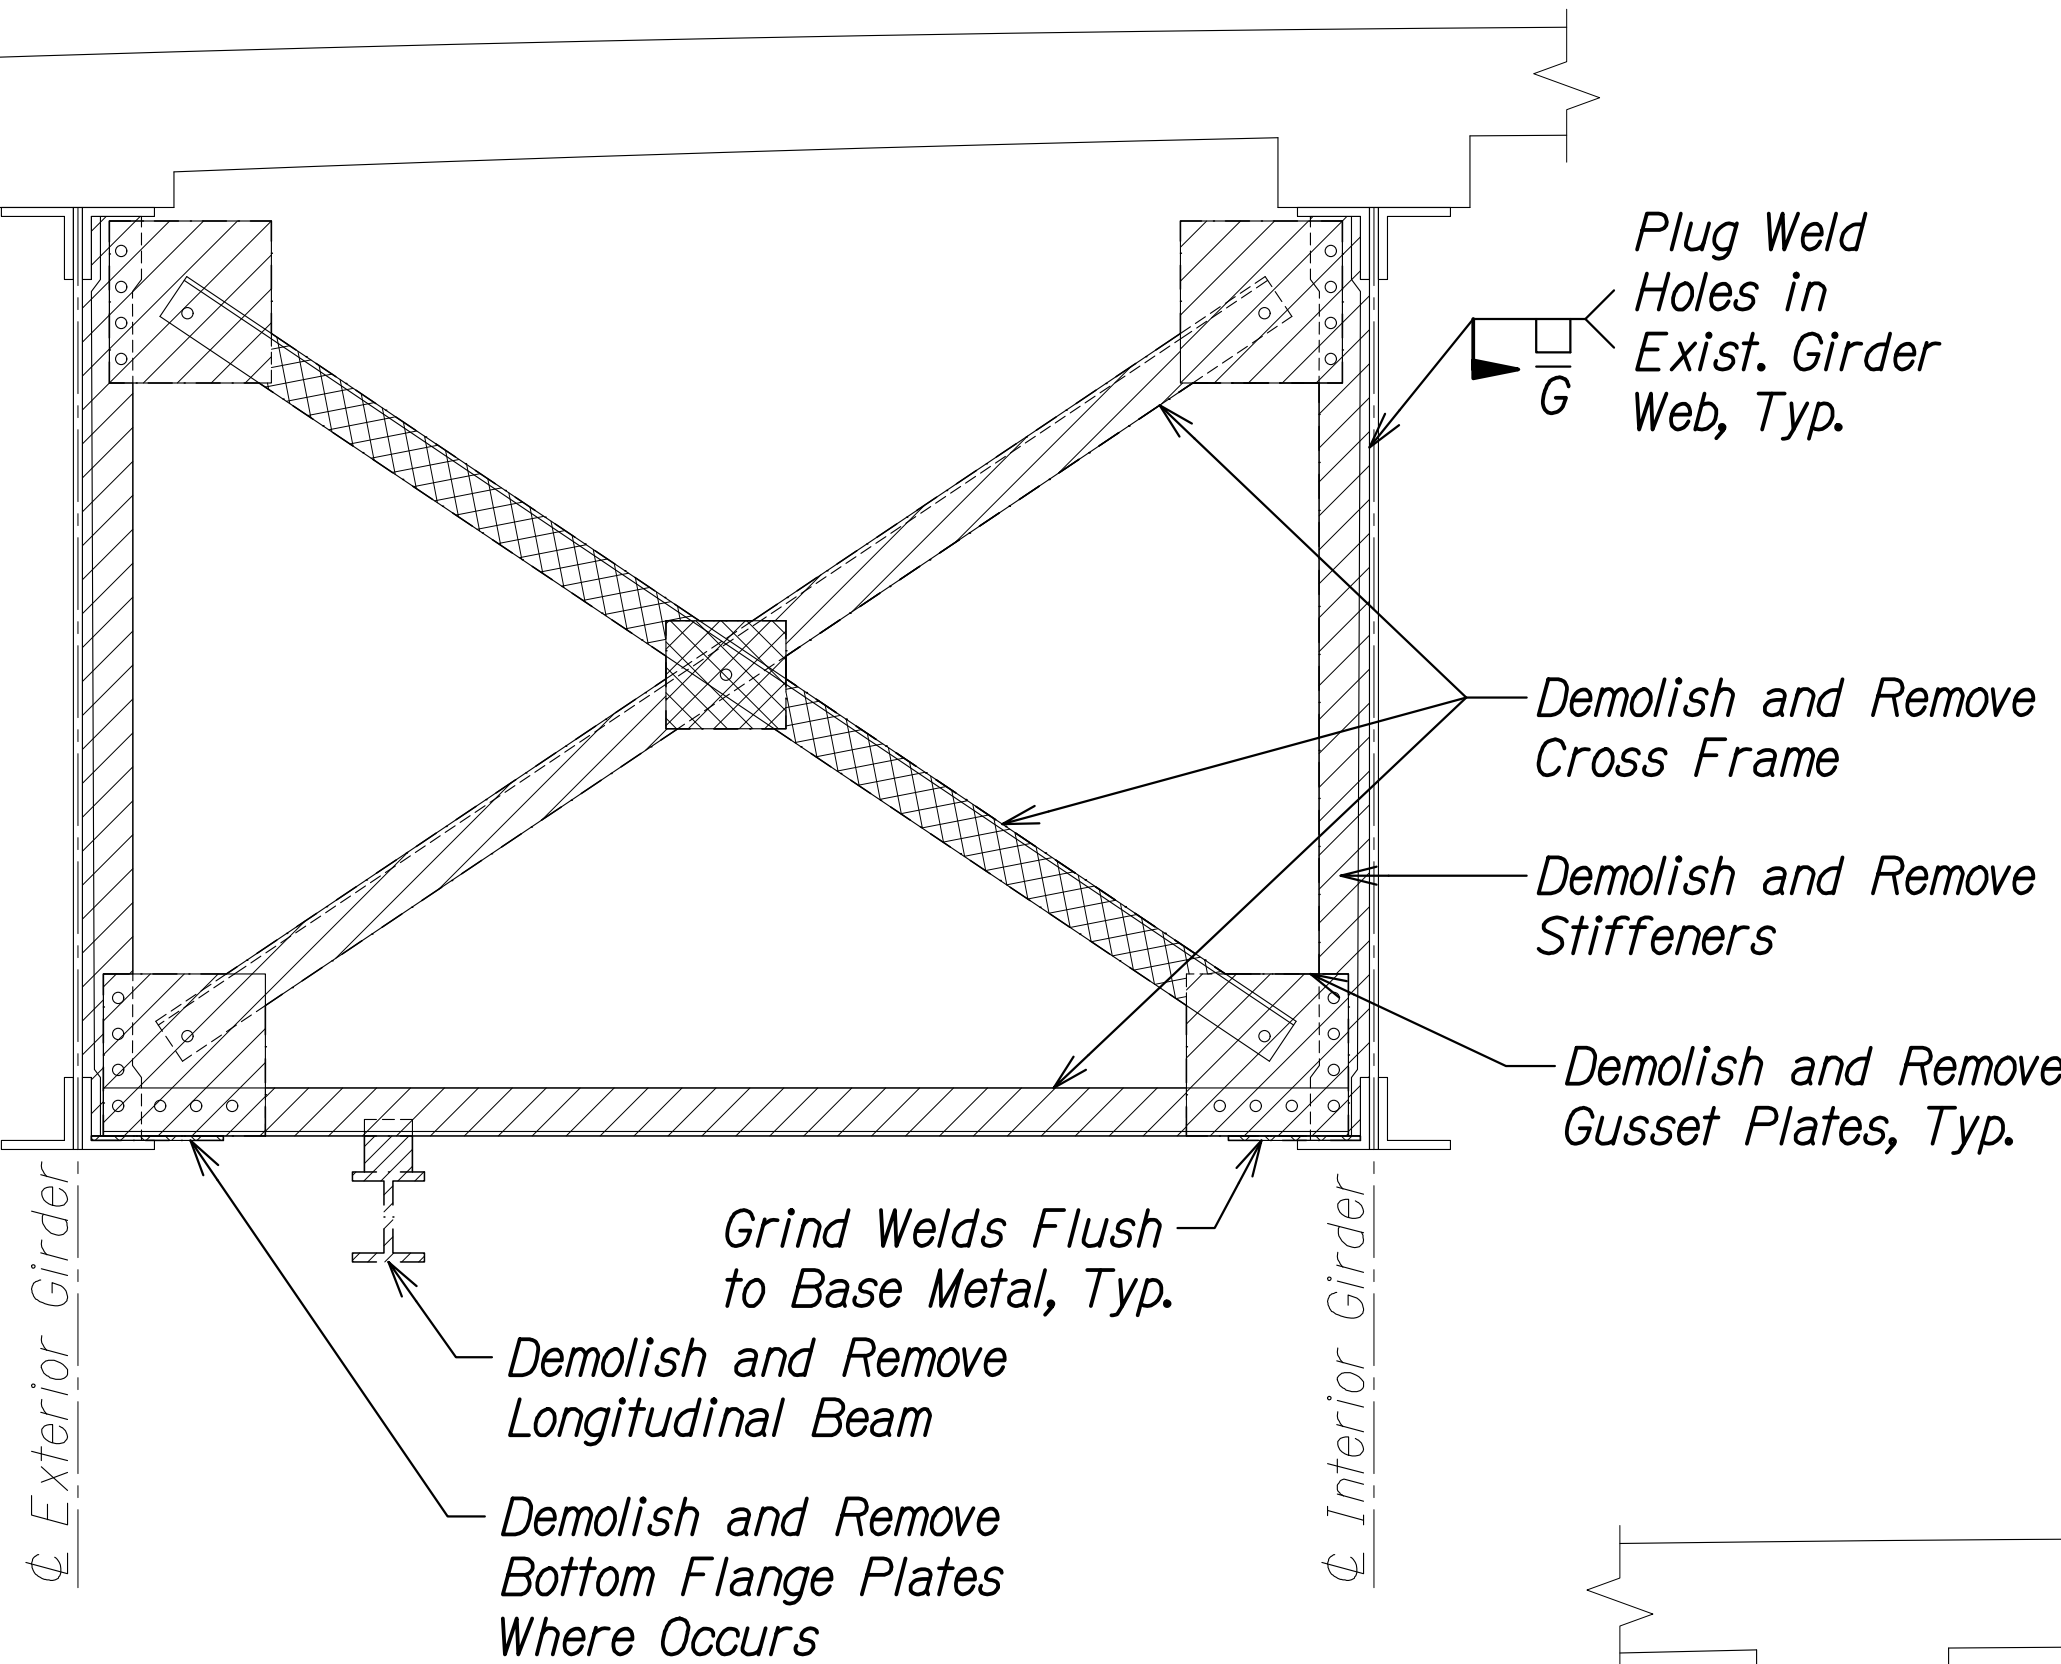


[F2] EXTERIOR BAY DEMO SECTION
AT FIXED BEARING
Scale: 3/4" = 1'-0"
SA10.9 SA10.9

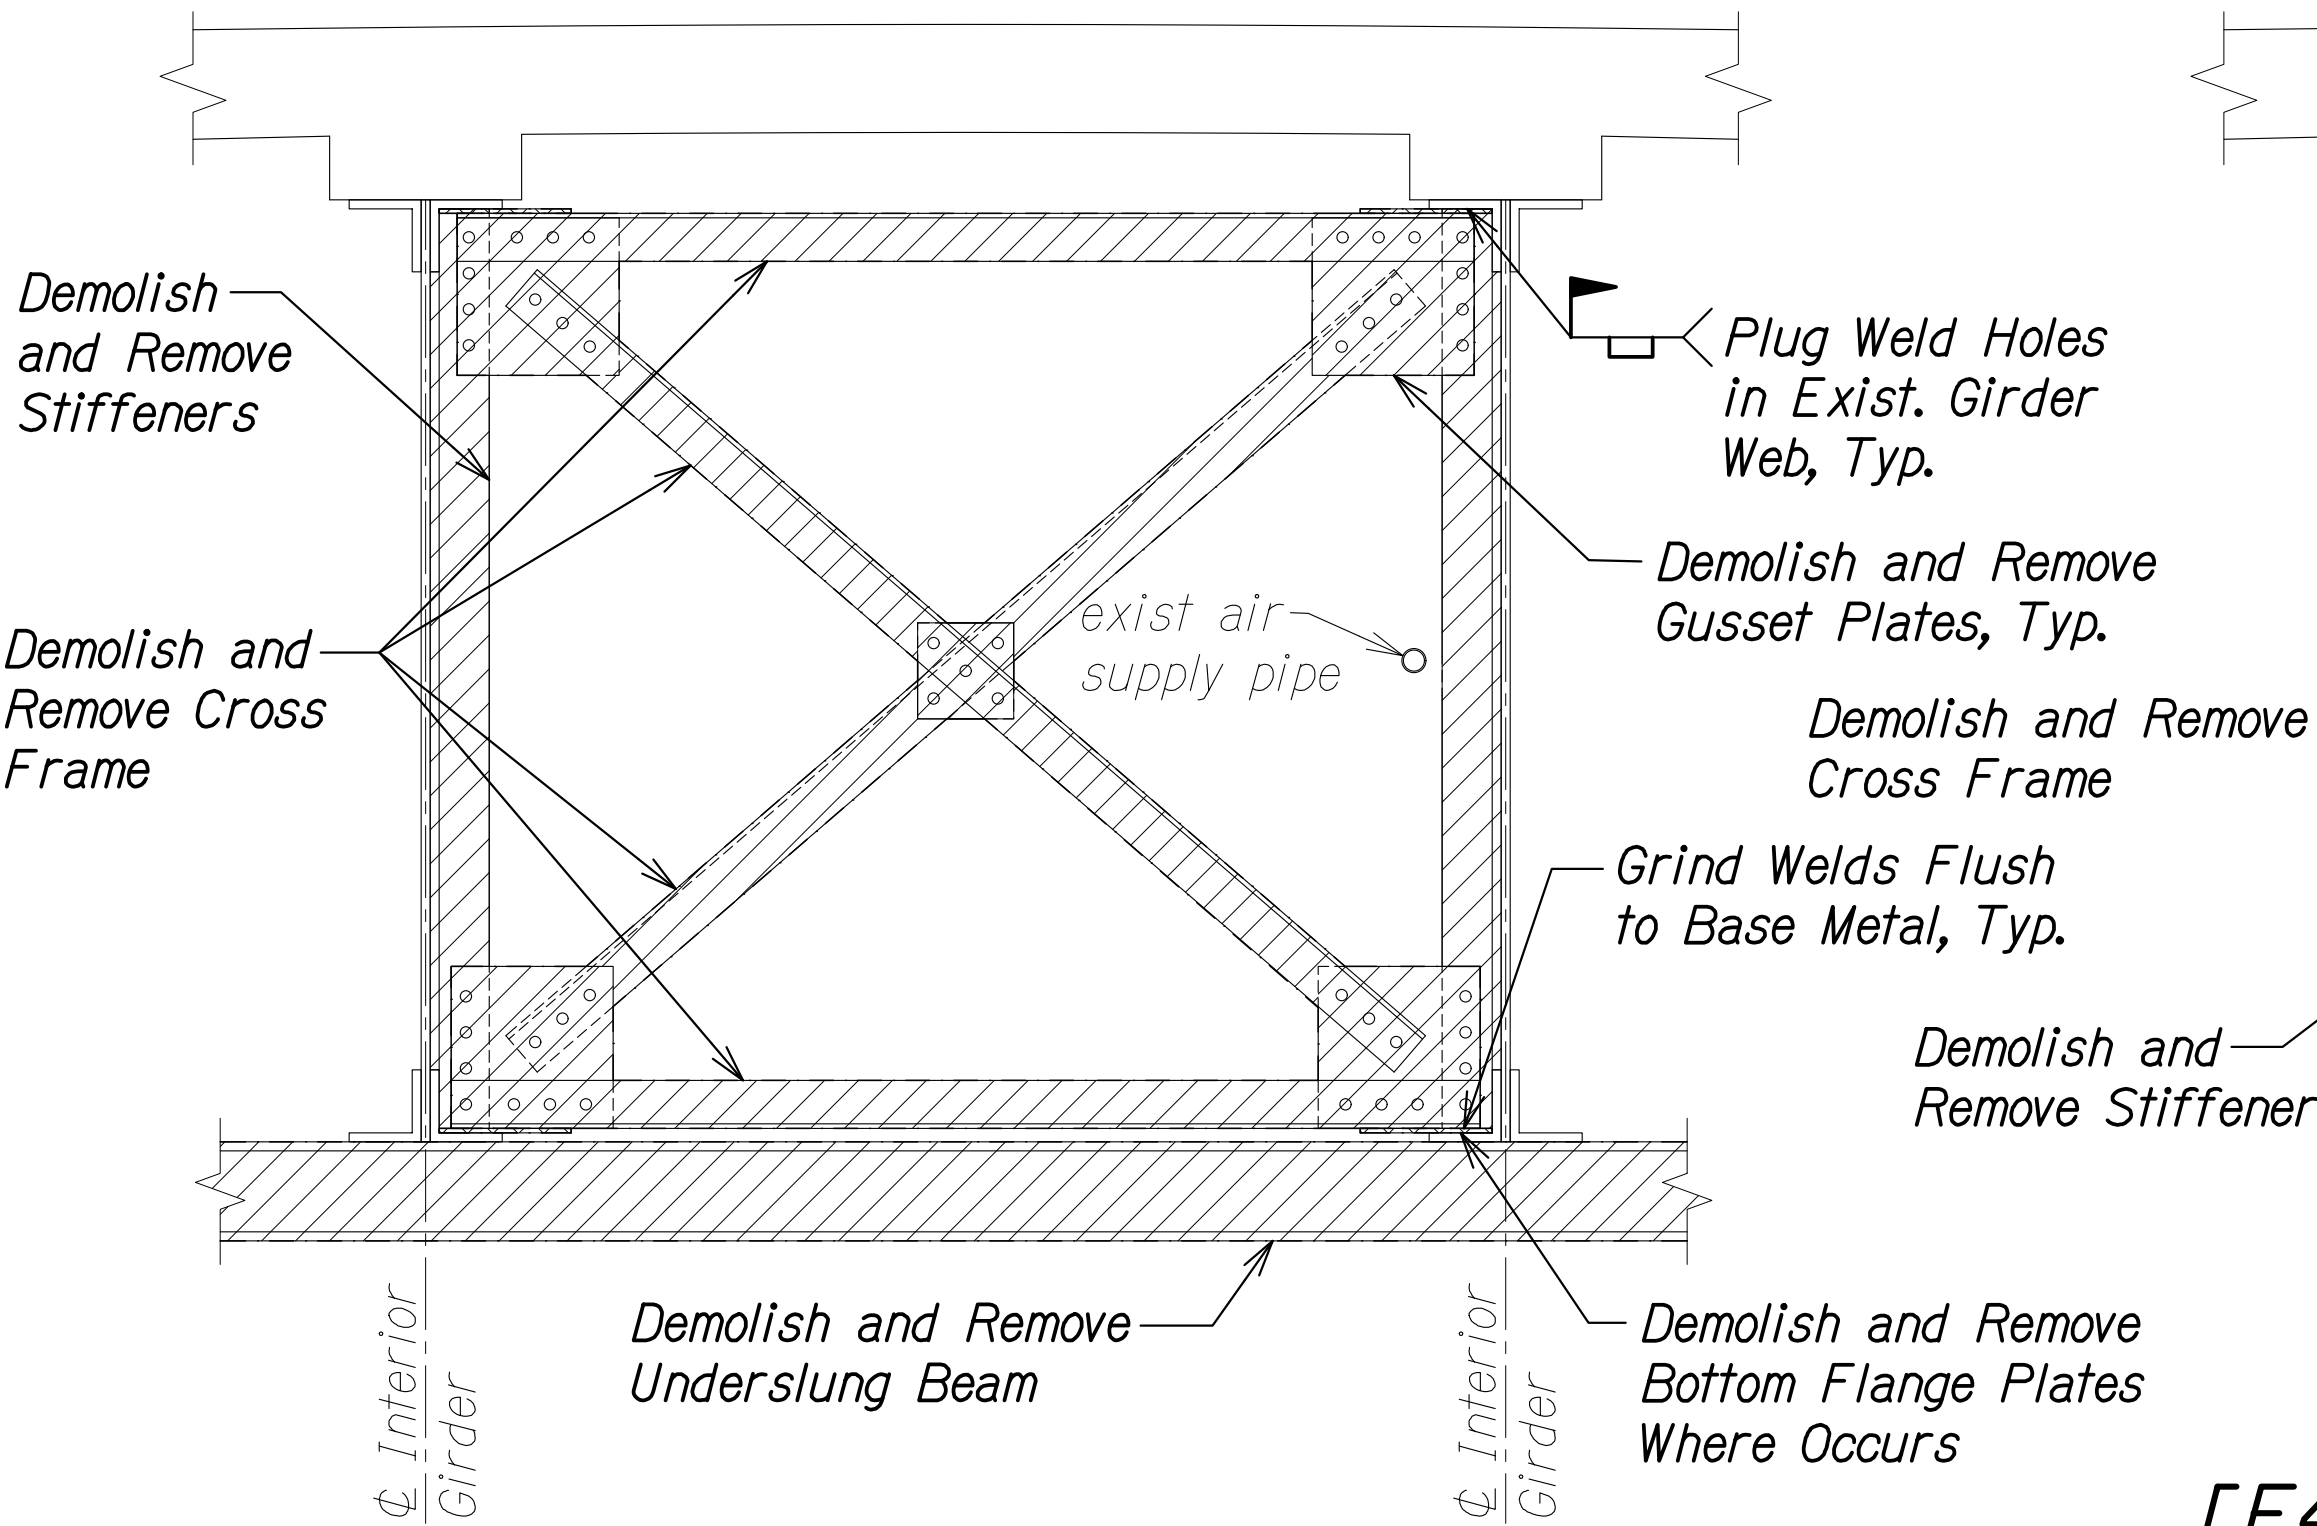

[F3] INTERIOR BAY DEMO SECTION
AT FIXED BEARING
Scale: 3/4" = 1'-0"
SA10.9 SA10.9

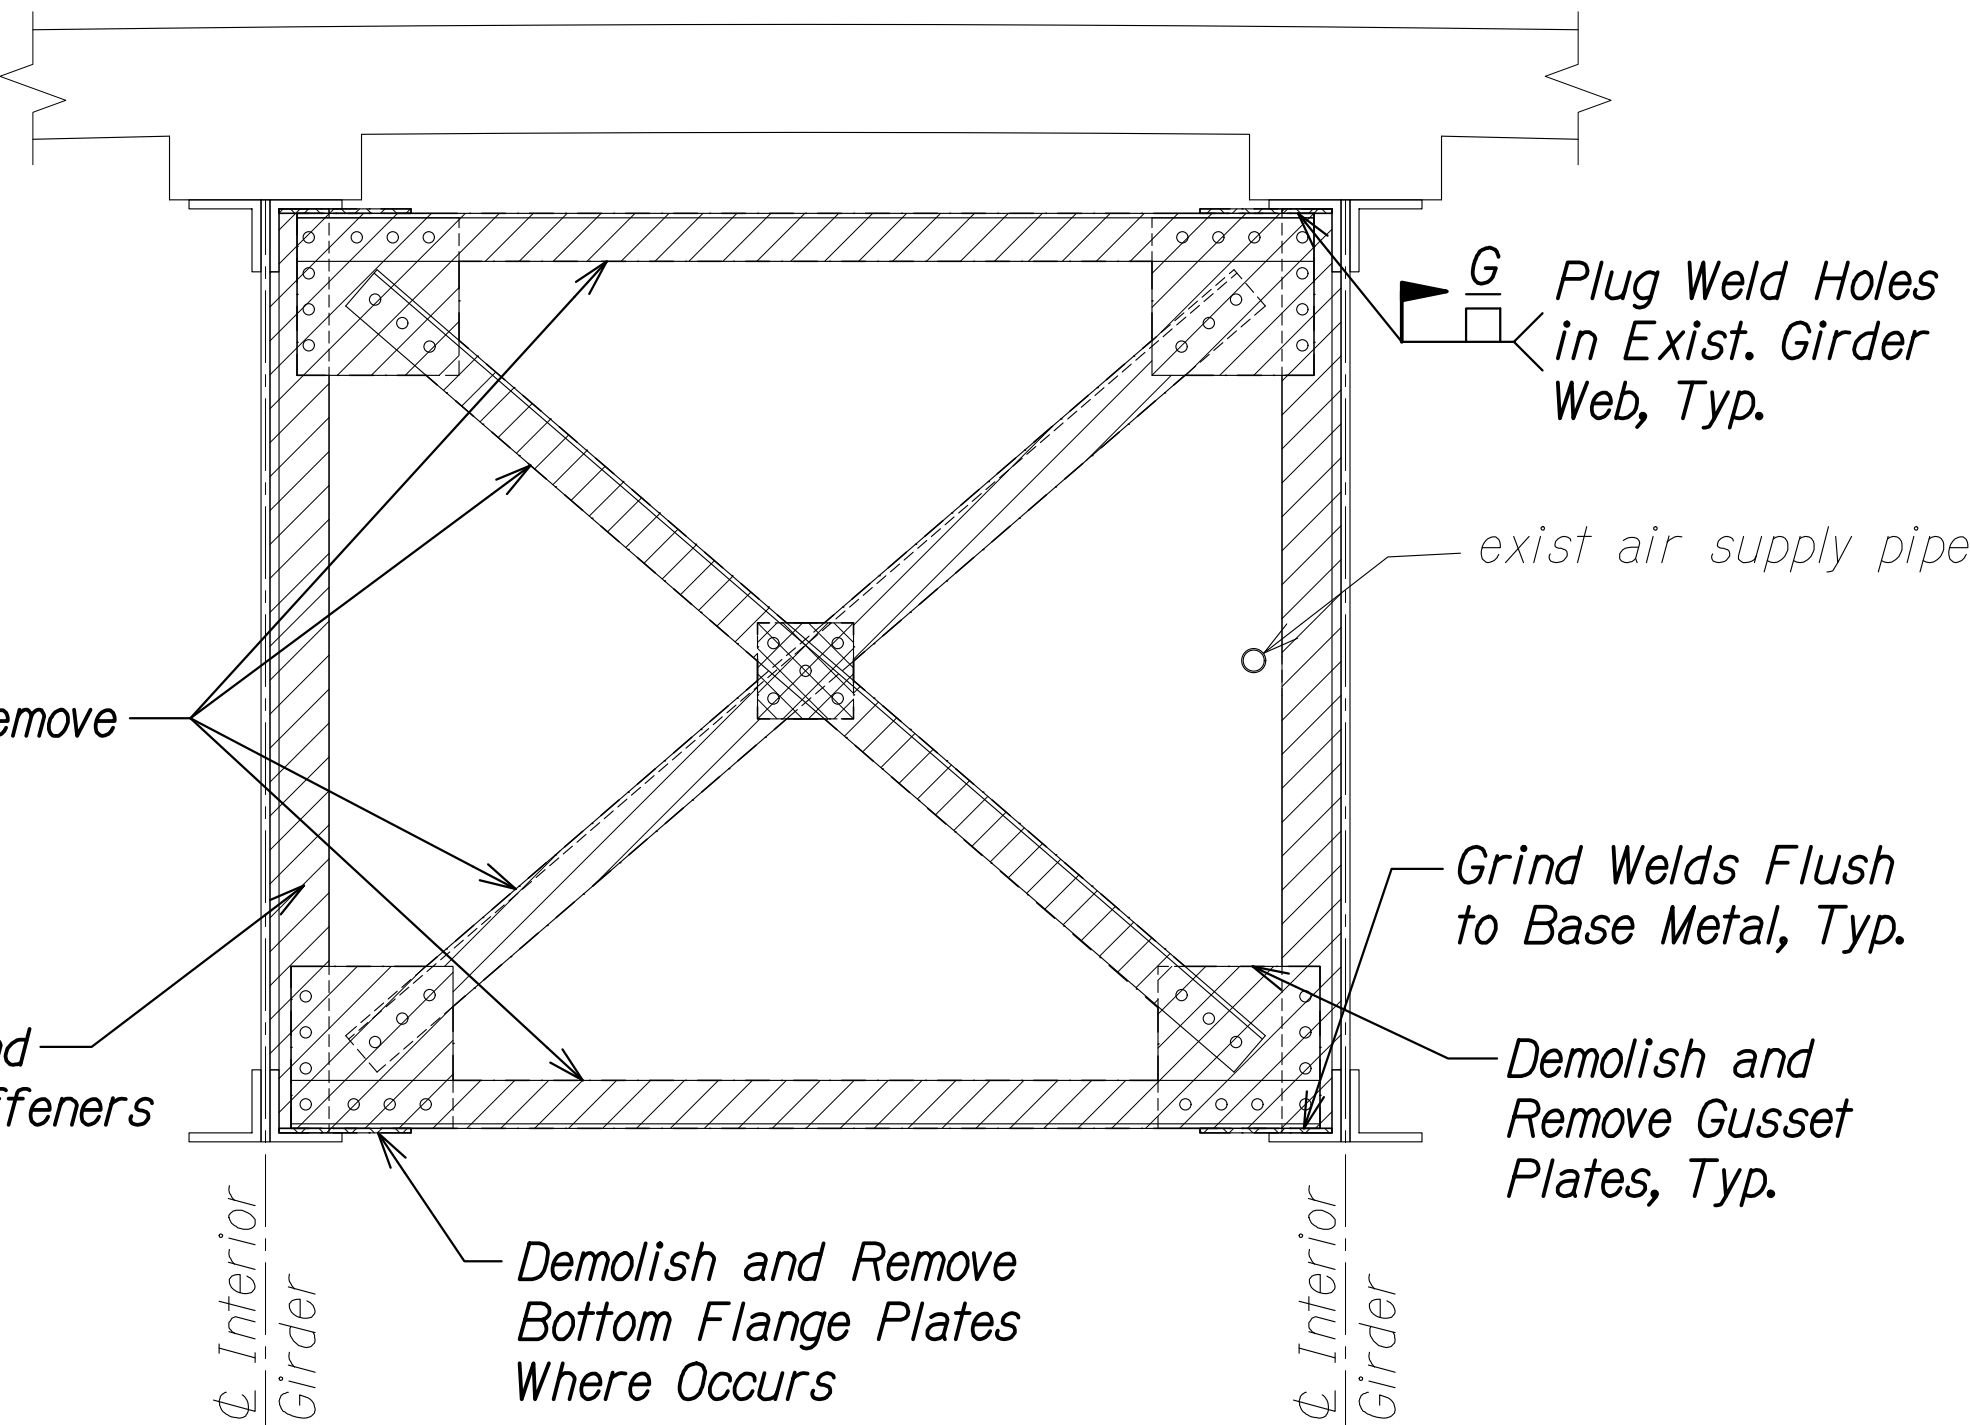


[F4] INTERIOR BAY DEMO SECTION
AT FIXED BEARING
Scale: 3/4" = 1'-0"
SA10.9 SA10.9

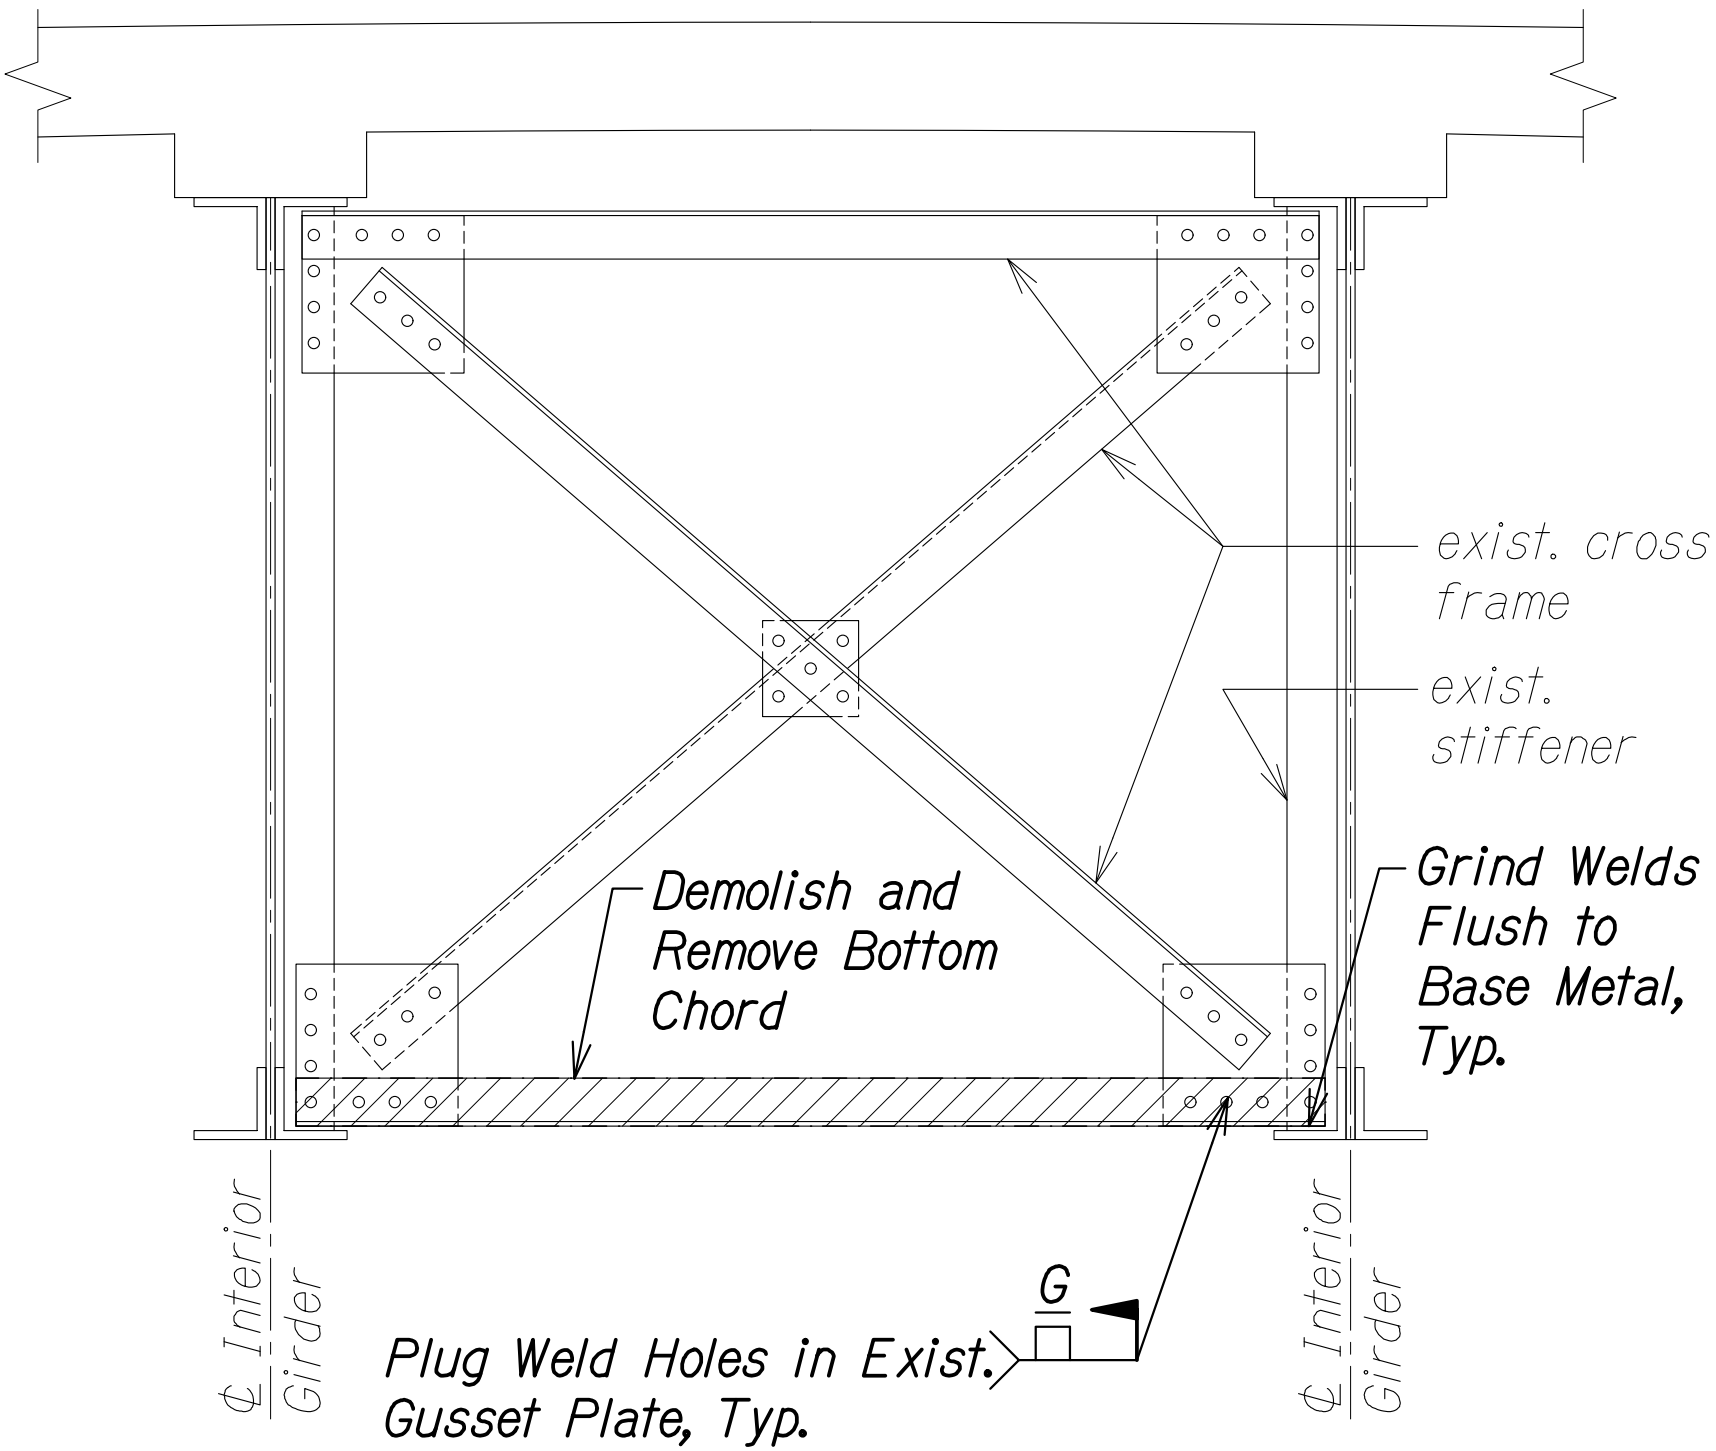

[F5] INTERIOR BAY DEMO SECTION
AT FIXED ABUTMENT
Scale: 3/4" = 1'-0"
SA10.9 SA10.9

DATE	_____
SURVEY PLOTTED BY	_____
DESIGNED BY	_____
TRACED BY	_____
NOTE BOOK	_____
QUANTITIES BY	_____
CHECKED BY	_____
No.	_____

DRAWING NAME: Z:\00 ONGOING\23-022.9-NANUE STR BR PF2-DOT10.1 CAD\12-06-24 ADD\NSR-SA1001-SA1009 STRUT DEMO SECT ADD2.DWG PLOT TIME: 12-03-24 10:34 PM

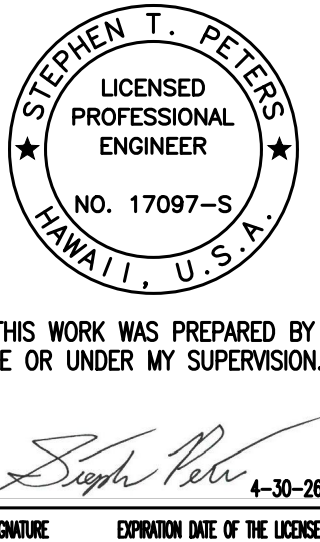

THIS WORK WAS PREPARED BY
ME OR UNDER MY SUPERVISION.
SIGNATURE: *Stephen T. Peters* 4-30-26
EXPIRATION DATE OF THE LICENSE

STATE OF HAWAII
DEPARTMENT OF TRANSPORTATION
HIGHWAYS DIVISION

**FIXED BEARING CROSS FRAME
DEMOLITION SECTIONS**

HAWAII BELT ROAD
Nanue Stream Bridge Rehabilitation
Federal Aid Project No. BR-019-2(077)

Scale: As Noted Date: Oct. 2024

SHEET No SA10.9 OF 30 SHEETS

12/6/24	1	Revised Note
DATE		REVISION

FED. ROAD DIST. NO.	STATE	FEDERAL AID PROJ. NO.	FISCAL YEAR	SHEET NO.	TOTAL SHEETS
HAWAII	HAW.	BR-019-2(077)	2024	ADD. 194	280

LEGEND:


[XXX] Strut Mark, See SA9.6 through SA9.10 for locations

NOTES:

- The Contractor shall field fit strut members and gussets prior to welding and galvanizing assemblies.
- New gussets welded directly to exist. plate girders shall be provided ungalvanized. Field drill standard size holes in exist. girder stiffeners and new welded gusset plates to match bolt pattern in new strut assembly.
- Strut assemblies shall be delivered to the site fully assembled, hot-dip zinc galvanized per ASTM A123 and shop painted with primer, seal, stripe coat, and intermediate in accordance with Section 667 - PREPARATION AND COATING OF GALVANIZED BRIDGE STEEL of the Special Provisions.


1
- Just prior to installation of strut assemblies, the immediate surrounding faying surfaces of existing girder web, flange, and stiffeners as well as new welded gusset plates shall be cleaned in accordance with SSPC-SP 10 or SSPC-SP 11 and painted, by brush, with two coats of the specified primer.
- Perform final abrasive blast cleaning to all girders, stiffeners, etc. Strut assemblies shall be sufficiently shielded from damage during blasting operation and masked from overspray during primer application.

1
- Strut assemblies shall receive field applied top coat in accordance with Section 666 - BLAST, CLEAN, AND PAINT EXISTING BRIDGE STEEL of the Special Provisions.
- Details from adjacent bays not shown for clarity.
- See Sheet SA9.23 for required sequence regarding strut replacement and corresponding traffic control requirements.

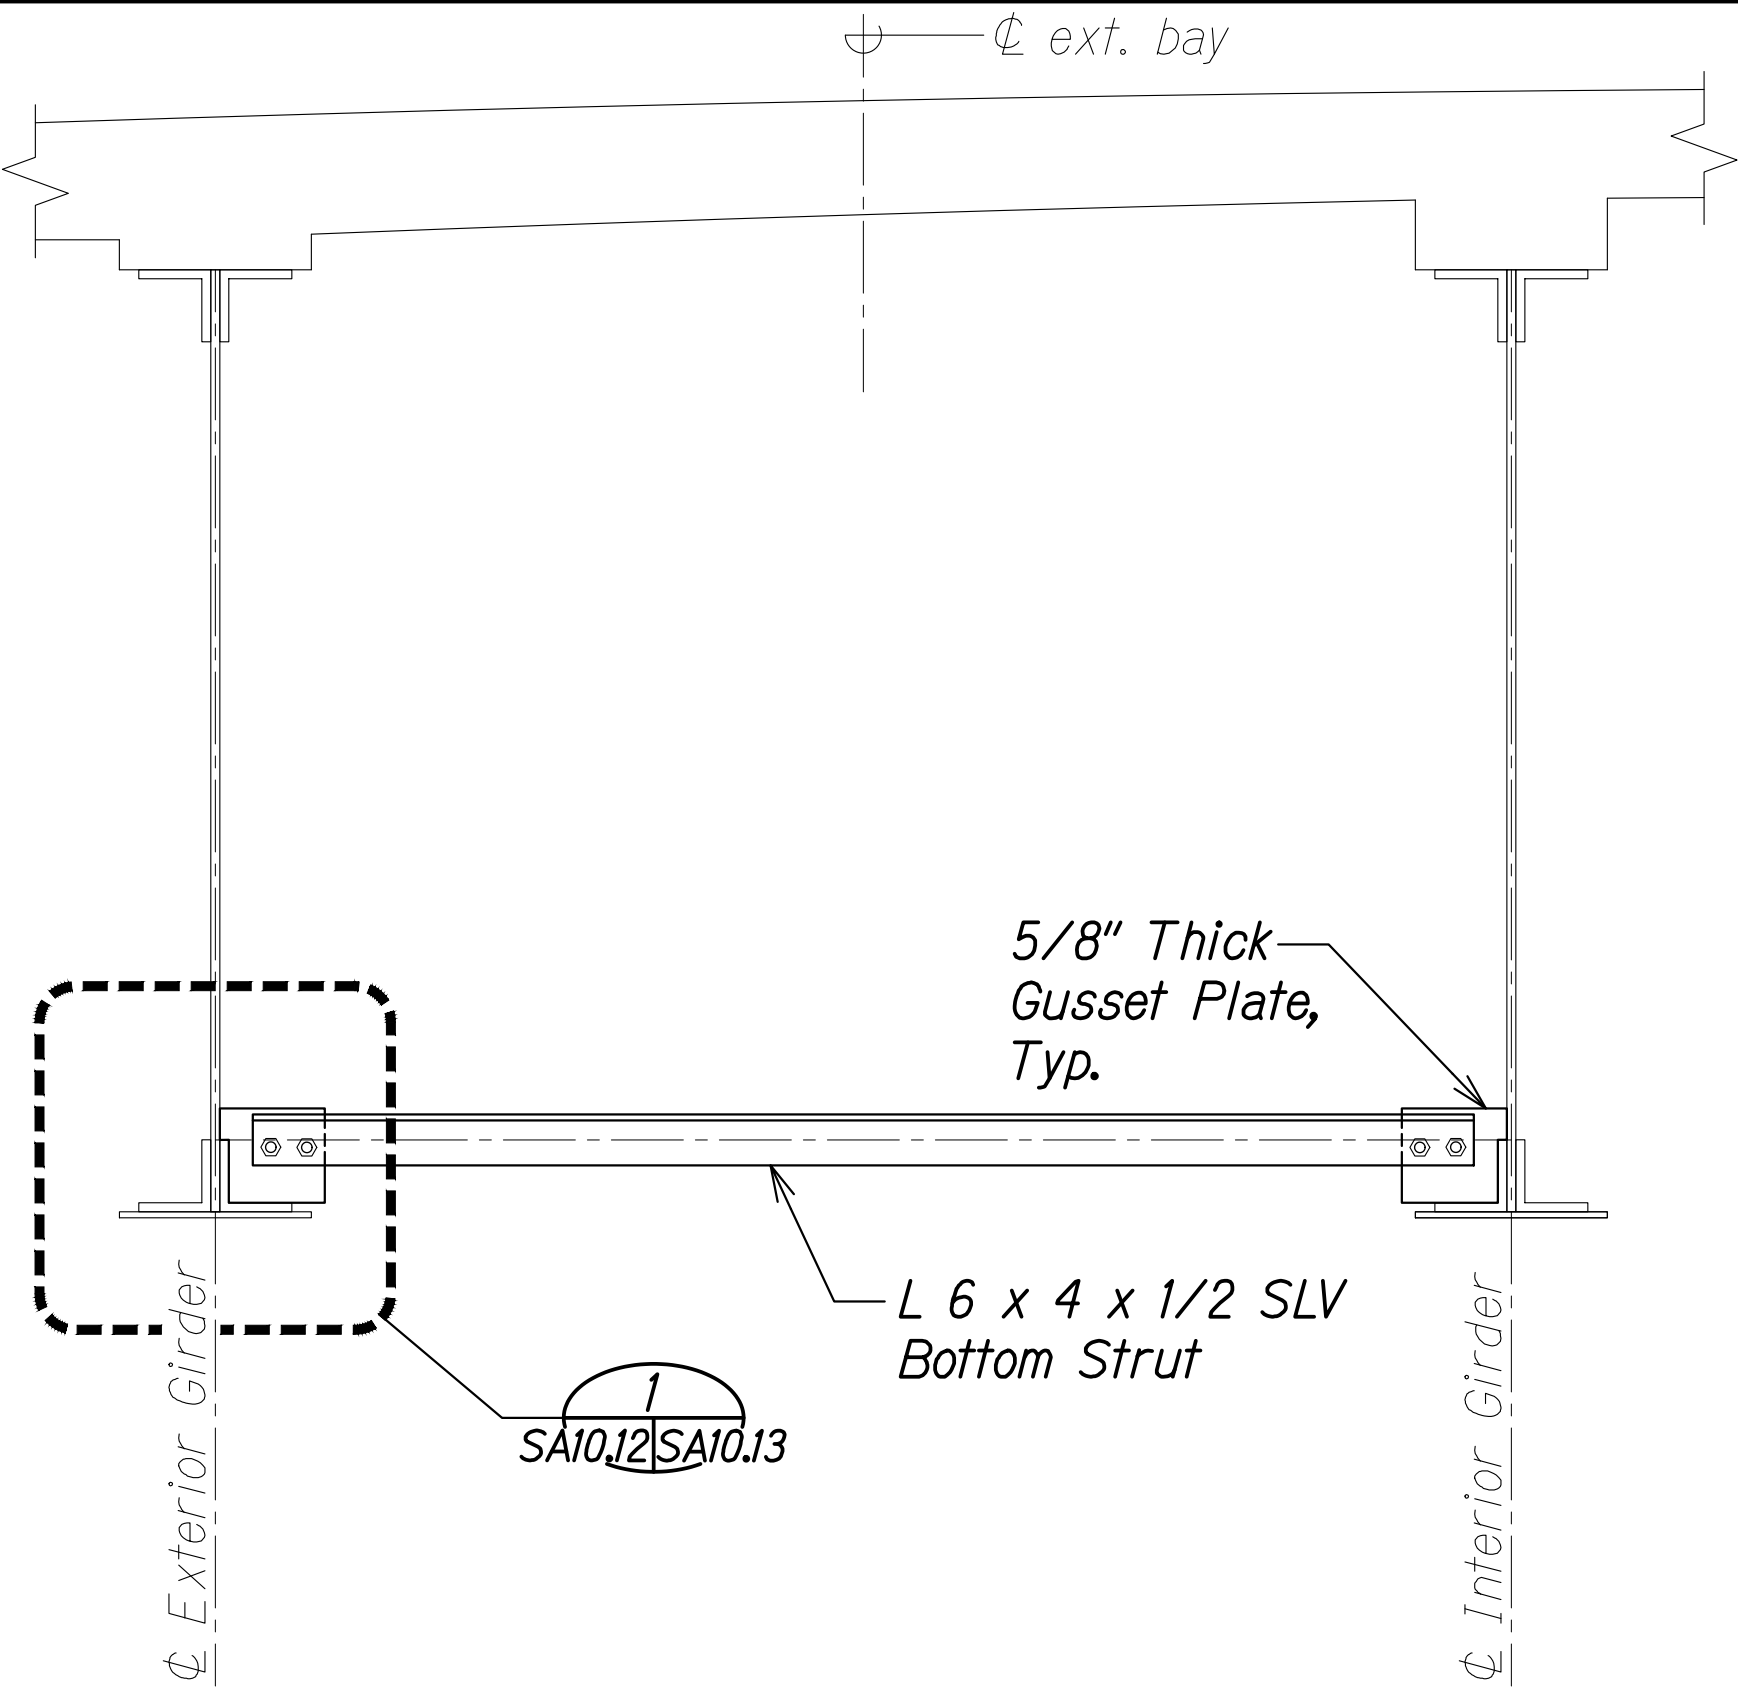


[SE1] EXTERIOR BAY
STRUT SECTION

Scale: 3/4" = 1'-0" A SA10.12 SA10.13

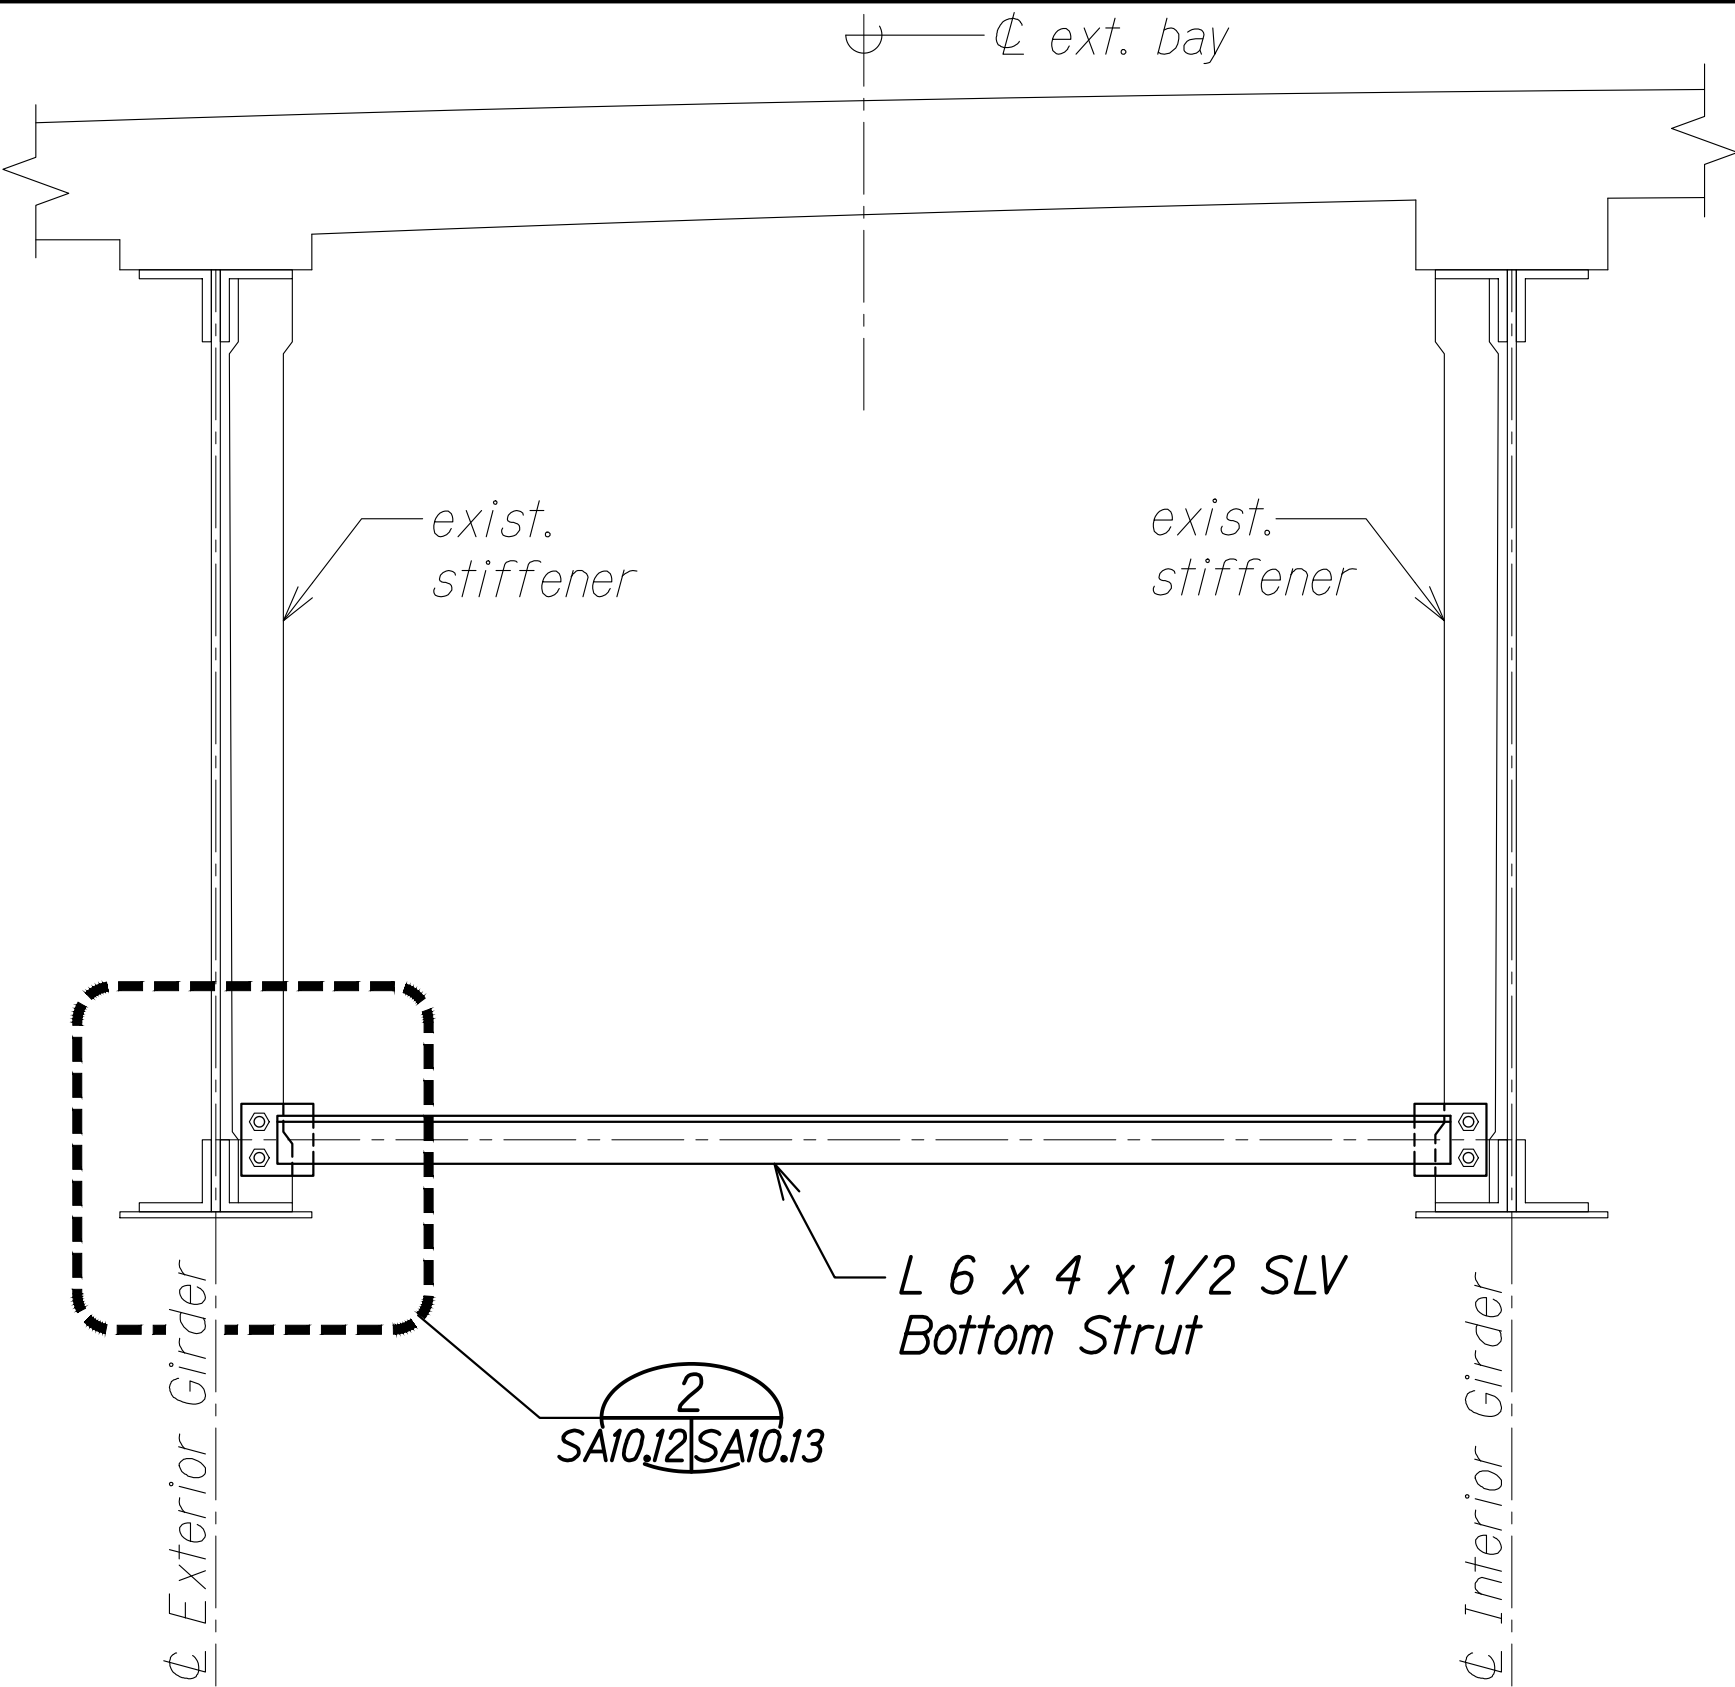


[SE2] EXTERIOR BAY
STRUT SECTION

Scale: 3/4" = 1'-0" B SA10.12 SA10.13

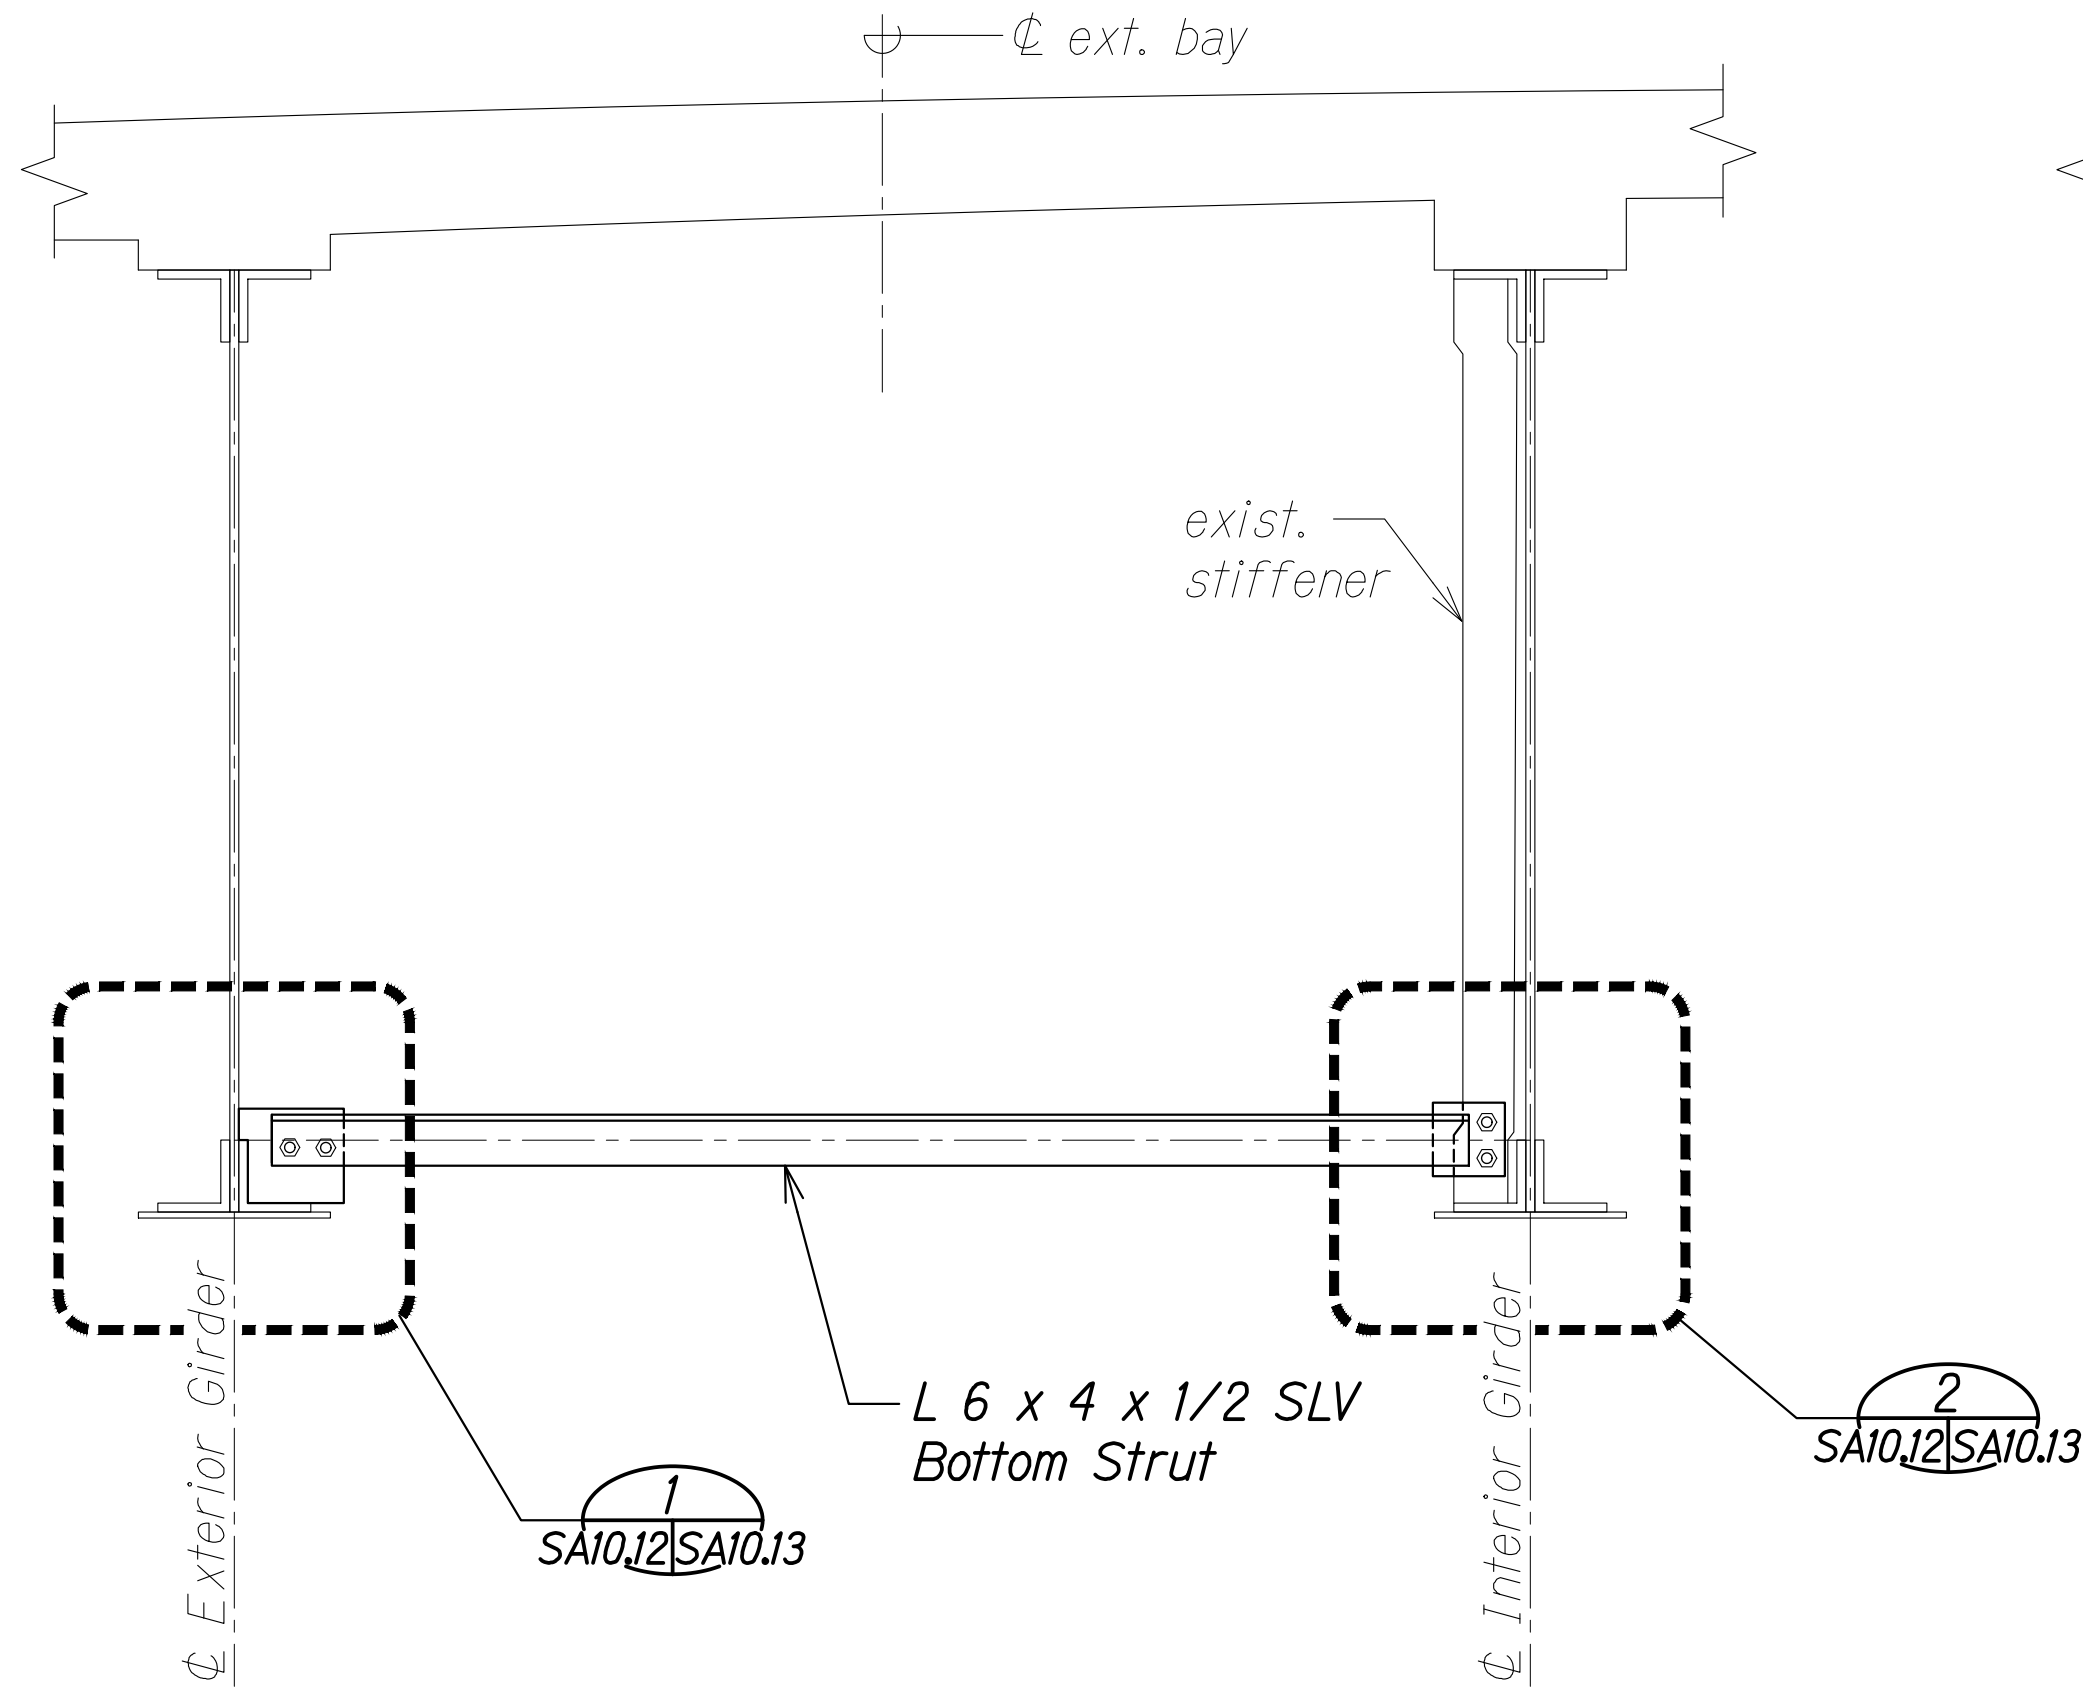

[SE3] EXTERIOR BAY
STRUT SECTION


Scale: 3/4" = 1'-0" C SA10.12 SA10.13

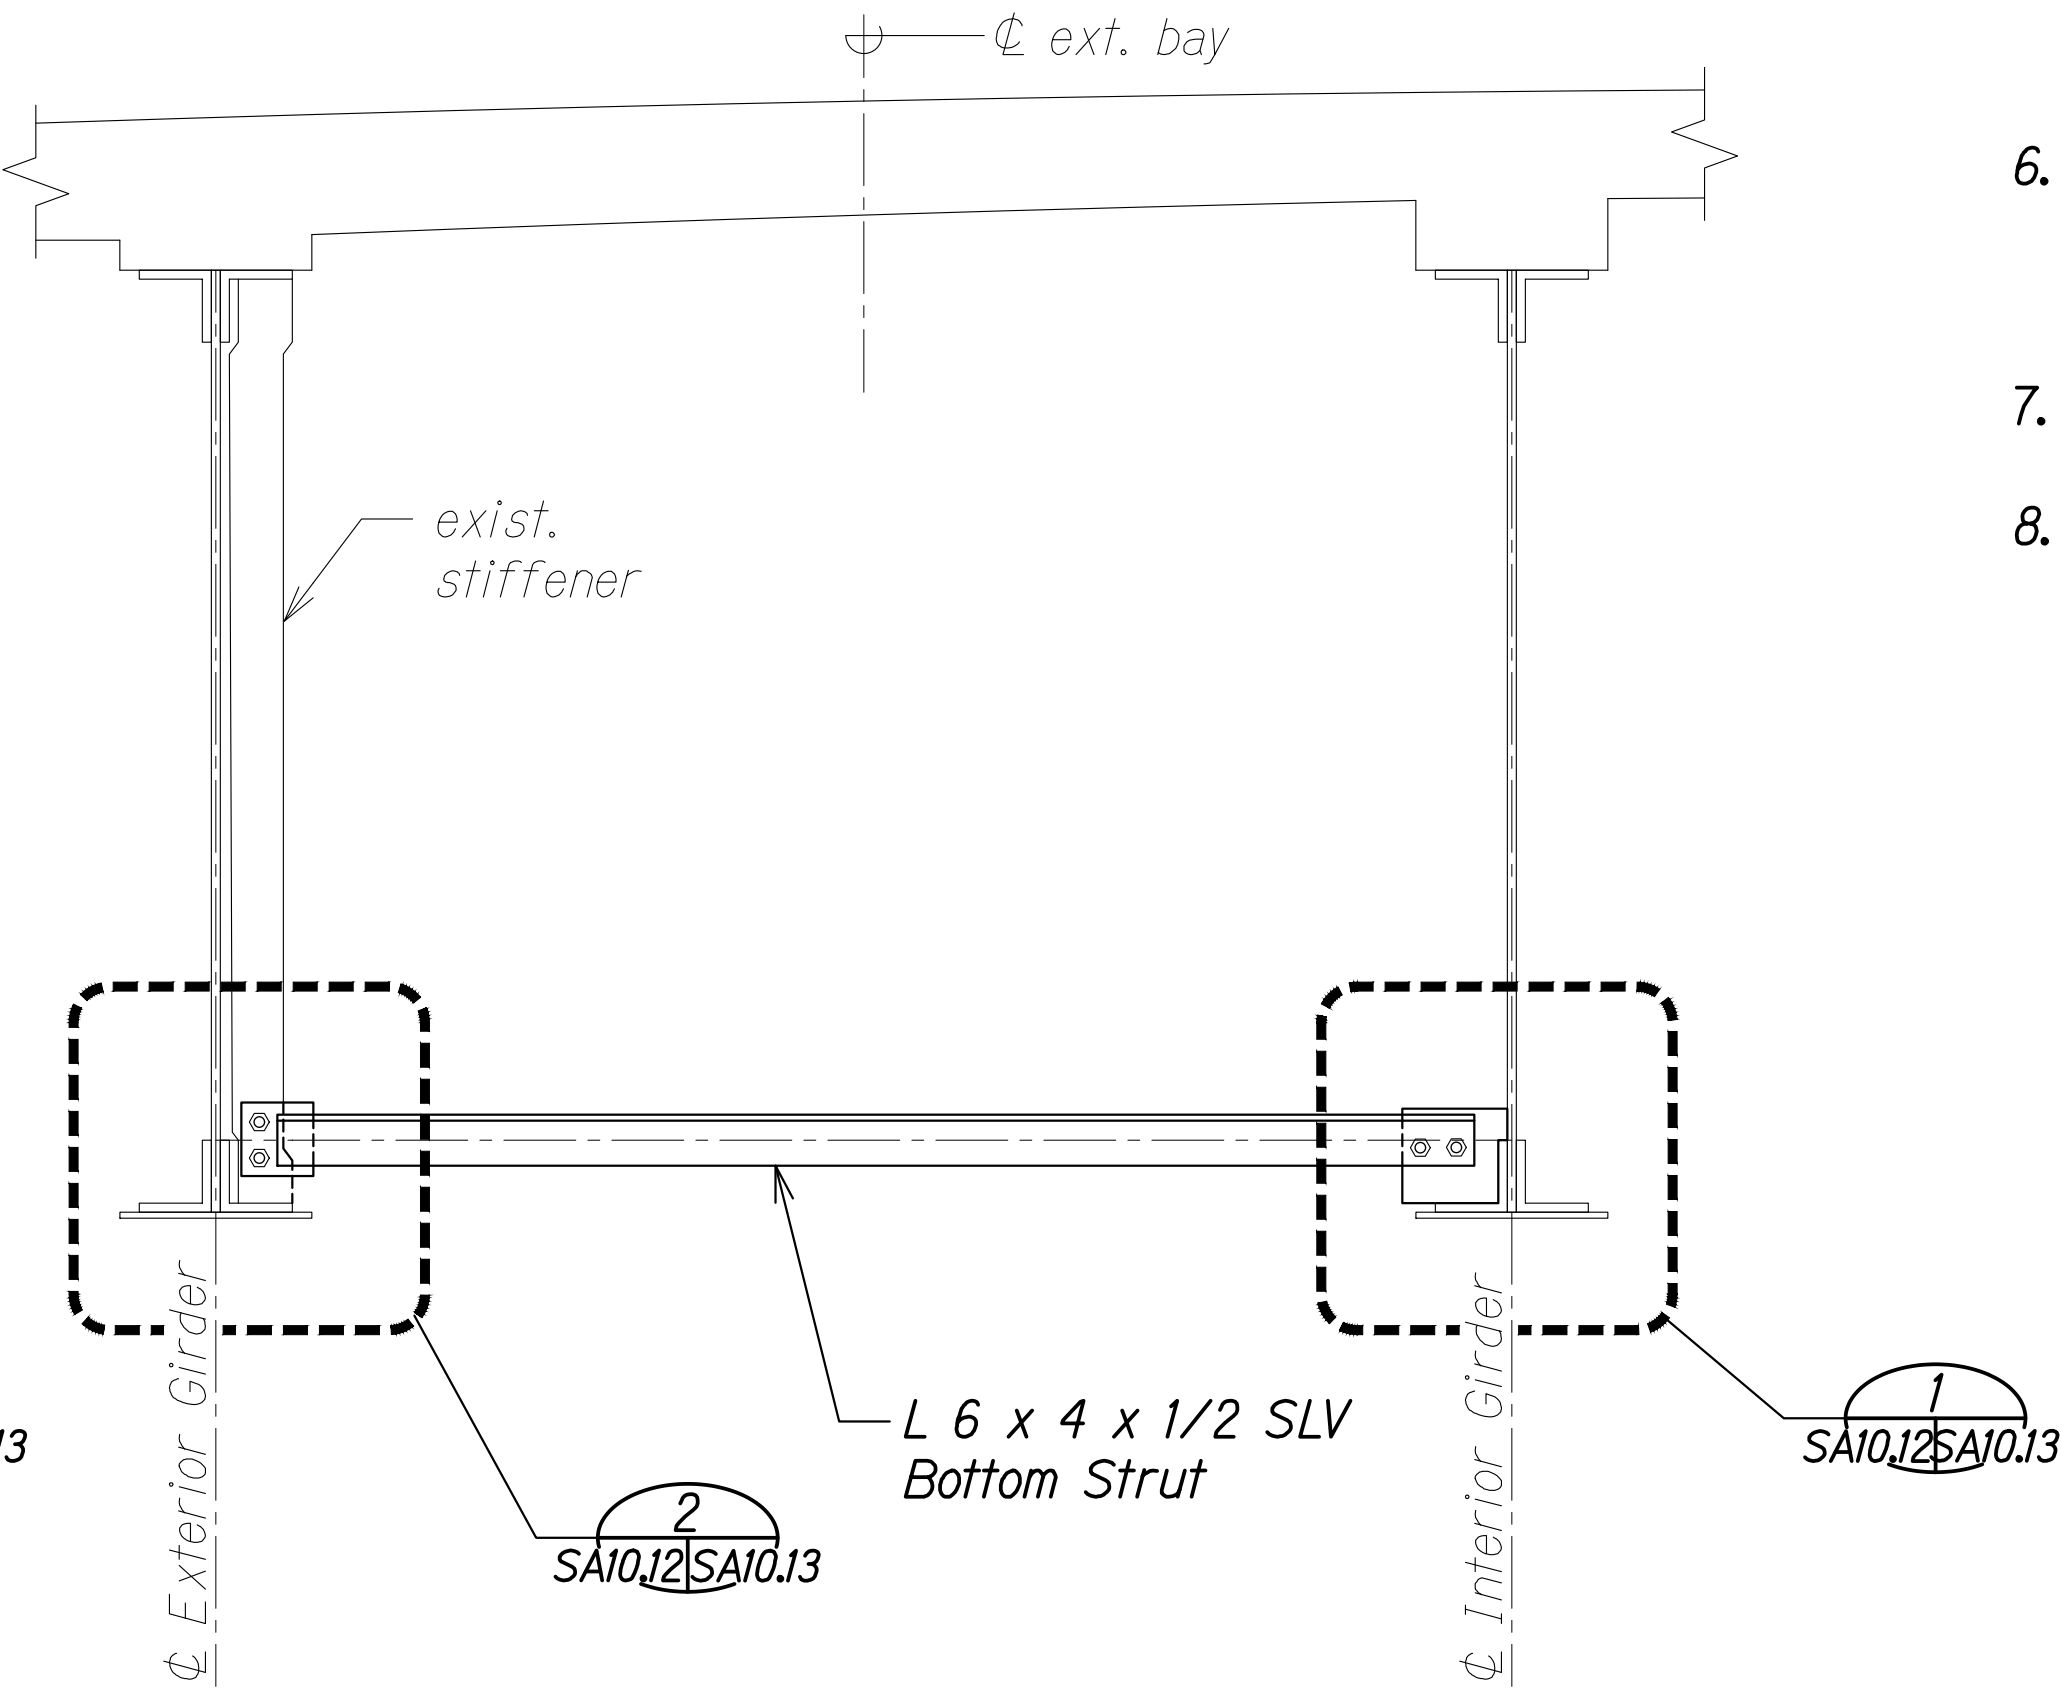

[SE4] EXTERIOR BAY
STRUT SECTION

Scale: 3/4" = 1'-0" D SA10.12 SA10.13

12/6/24	1 Revised Notes
DATE	REVISION
STATE OF HAWAII DEPARTMENT OF TRANSPORTATION HIGHWAYS DIVISION EXTERIOR BAY STRUT SECTIONS HAWAII BELT ROAD Nanue Stream Bridge Rehabilitation Federal Aid Project No. BR-019-2(077) Scale: As Noted Date: Oct. 2024	
SHEET No SA10.12 OF 30 SHEETS	

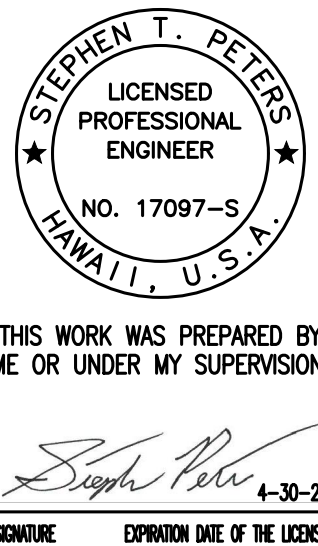

ORIGINAL PLAN	SURVEY PLOTTED BY	DATE
NOTE BOOK	DRAWN BY	
	DESIGNED BY	
	QUANTITIES BY	
	CHECKED BY	

DRAWING NAME: Z:\00 ONGOING\23-022.9-NANUE STR BR PF2-DOT1\01 CAD\12-06-24 ADD\NSR-SA1012-SA1024 STRUT X-FRMG ADD2.DWG PLOT TIME: 12-03-24, 10:39 PM


FED. ROAD DIST. NO.	STATE	FEDERAL AID PROJ. NO.	FISCAL YEAR	SHEET NO.	TOTAL SHEETS
HAWAII	HAW.	BR-019-2(077)	2024	ADD. 195	280

LEGEND:

[XXX] Strut Mark, See SA9.6 through SA9.10 for locations

NOTES:


- The Contractor shall field fit strut members and gussets prior to welding and galvanizing assemblies.
- New gussets welded directly to exist. plate girders shall be provided ungalvanized. Field drill standard size holes in exist. girder stiffeners and new welded gusset plates to match bolt pattern in new strut assembly.
- Strut assemblies shall be delivered to the site fully assembled, hot-dip zinc galvanized per ASTM A123 and shop painted with primer, seal coat, stripe coat, and intermediate in accordance with Section 667 - PREPARATION AND COATING OF GALVANIZED BRIDGE STEEL of the Special Provisions.
- Just prior to installation of strut assemblies, the immediate surrounding faying surfaces of existing girder web, flange, and stiffeners as well as new welded gusset plates shall be cleaned in accordance with SSPC-SP 10 or SSPC-SP 11 and painted, by brush, with two coats of the specified primer.
- Perform final abrasive blast cleaning to all girders, stiffeners, etc. Strut assemblies shall be sufficiently shielded from damage during blasting operation and masked from overspray during primer application.
- Strut assemblies shall receive field applied top coat in accordance with Section 666 - BLAST, CLEAN, AND PAINT EXISTING BRIDGE STEEL of the Special Provisions.
- Details from adjacent bays not shown for clarity.
- See Sheet SA9.23 for required sequence regarding strut replacement and corresponding traffic control requirements.

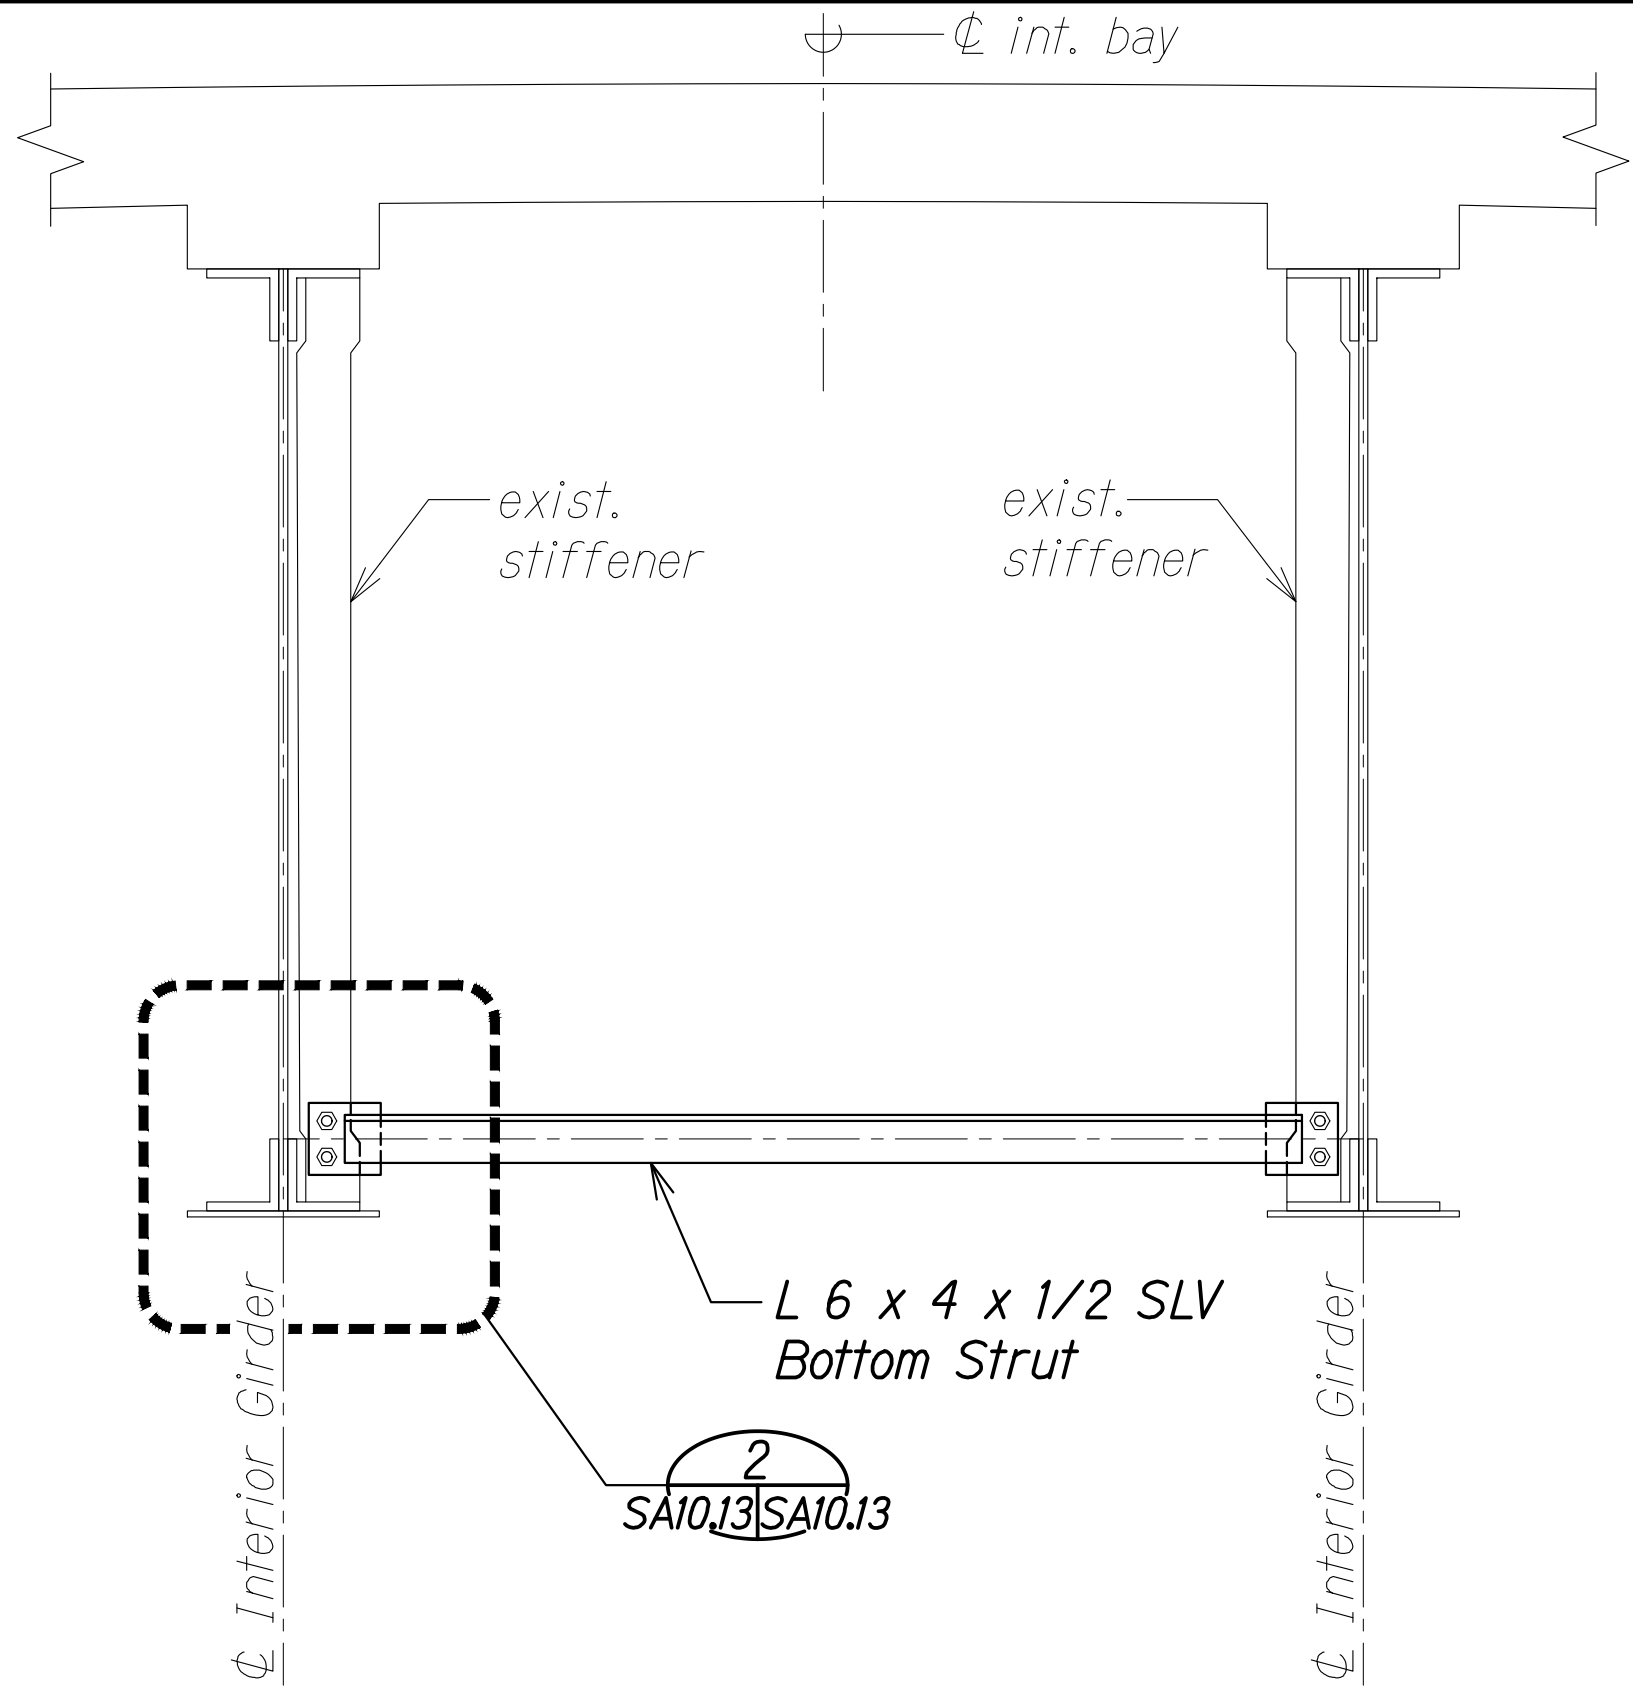

[SI1] INTERIOR BAY
STRUT SECTION

Scale: 3/4" = 1'-0"


SA10.13 A SA10.13

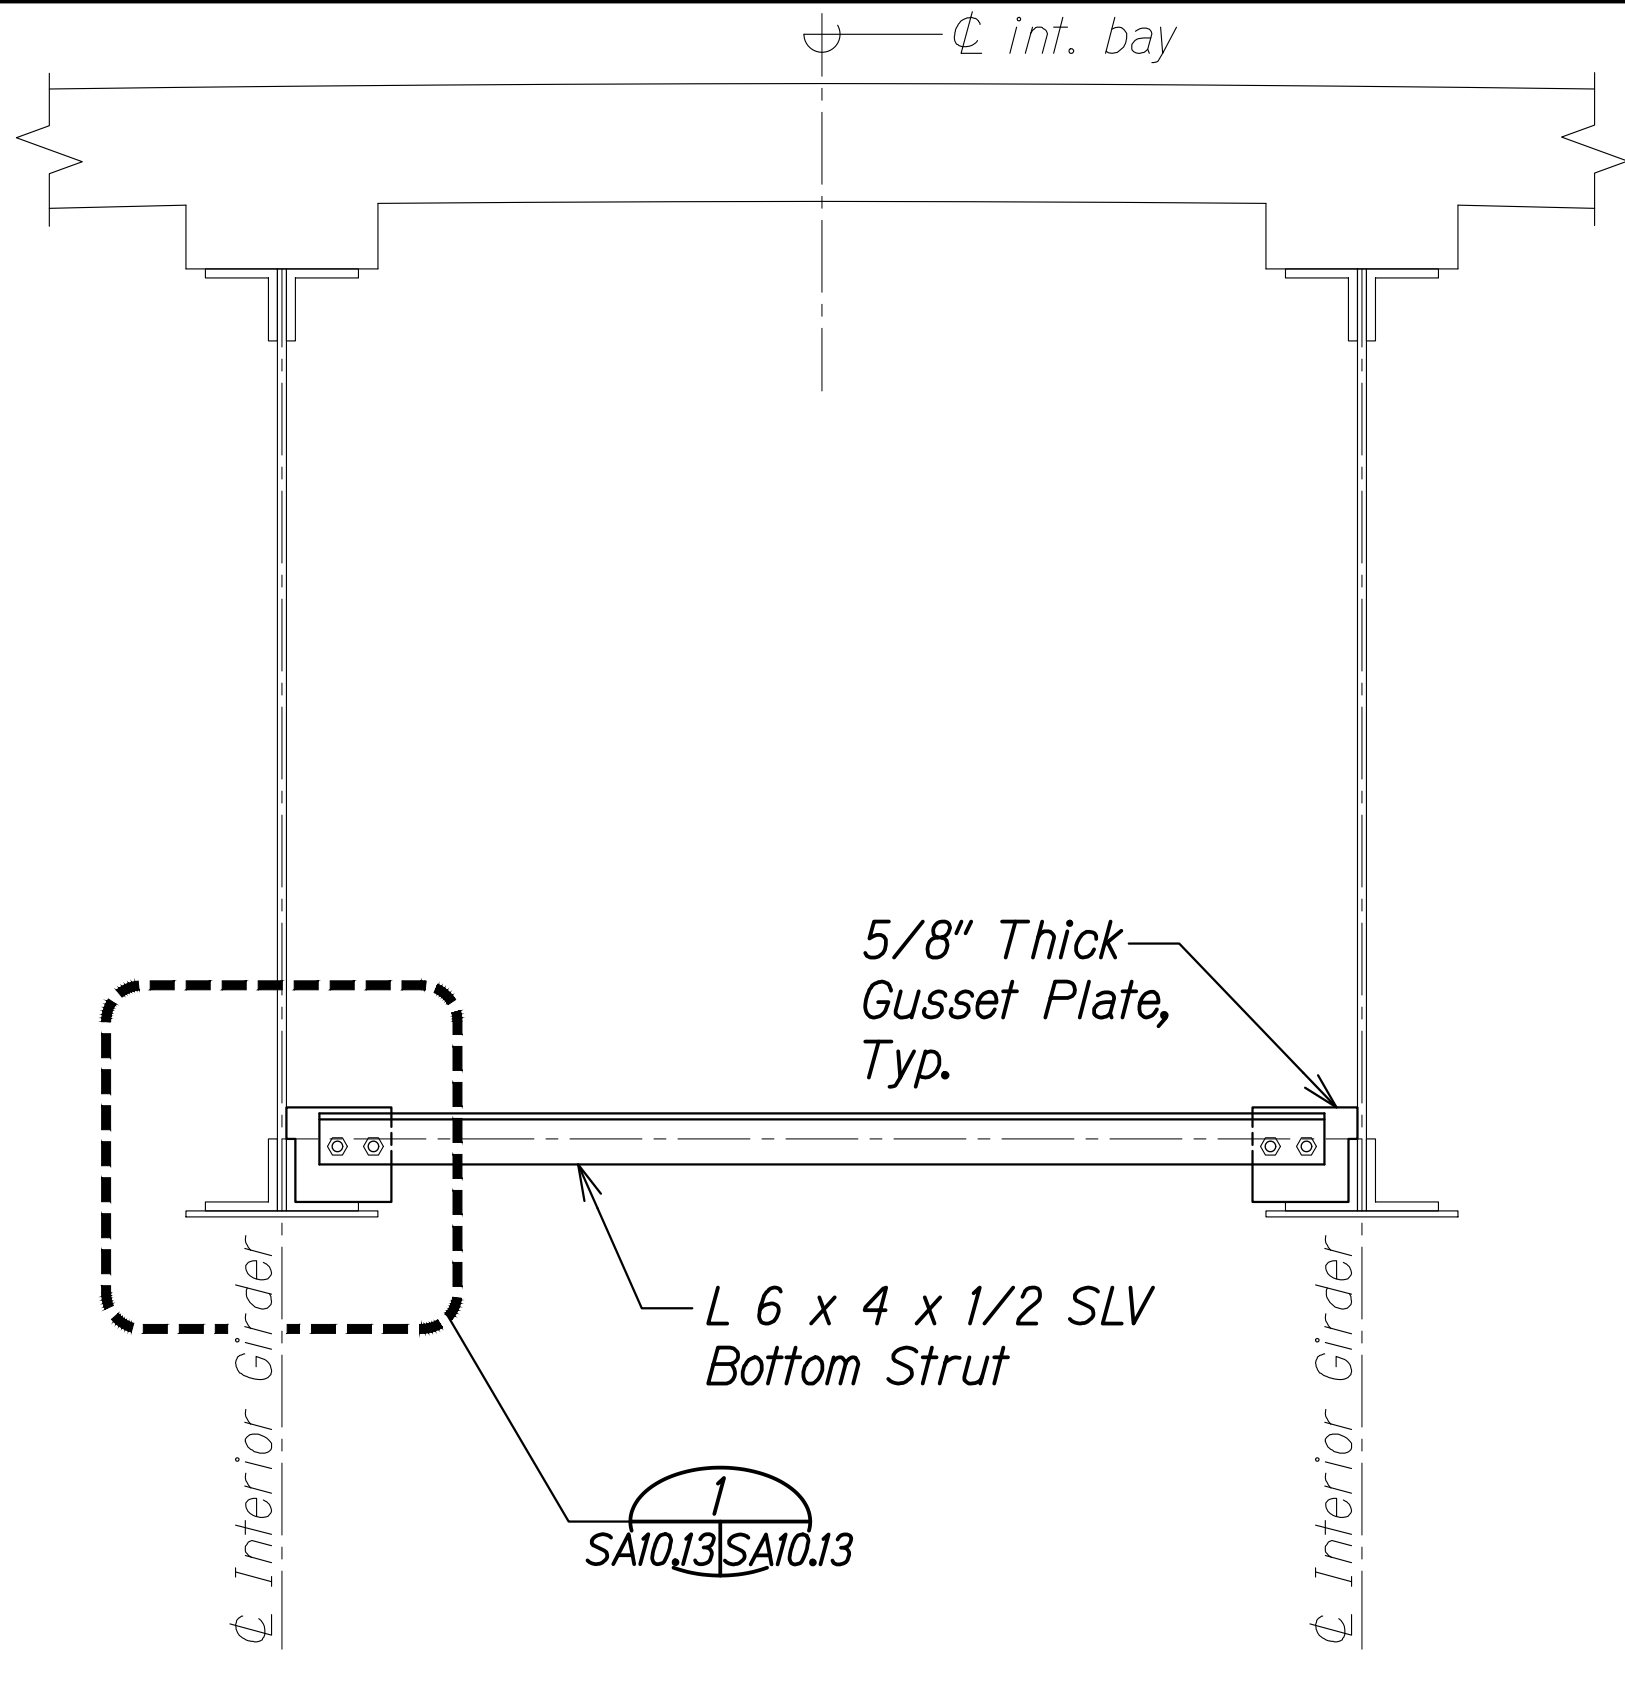

[SI2] INTERIOR BAY
STRUT SECTION

Scale: 3/4" = 1'-0"


SA10.13 B SA10.13

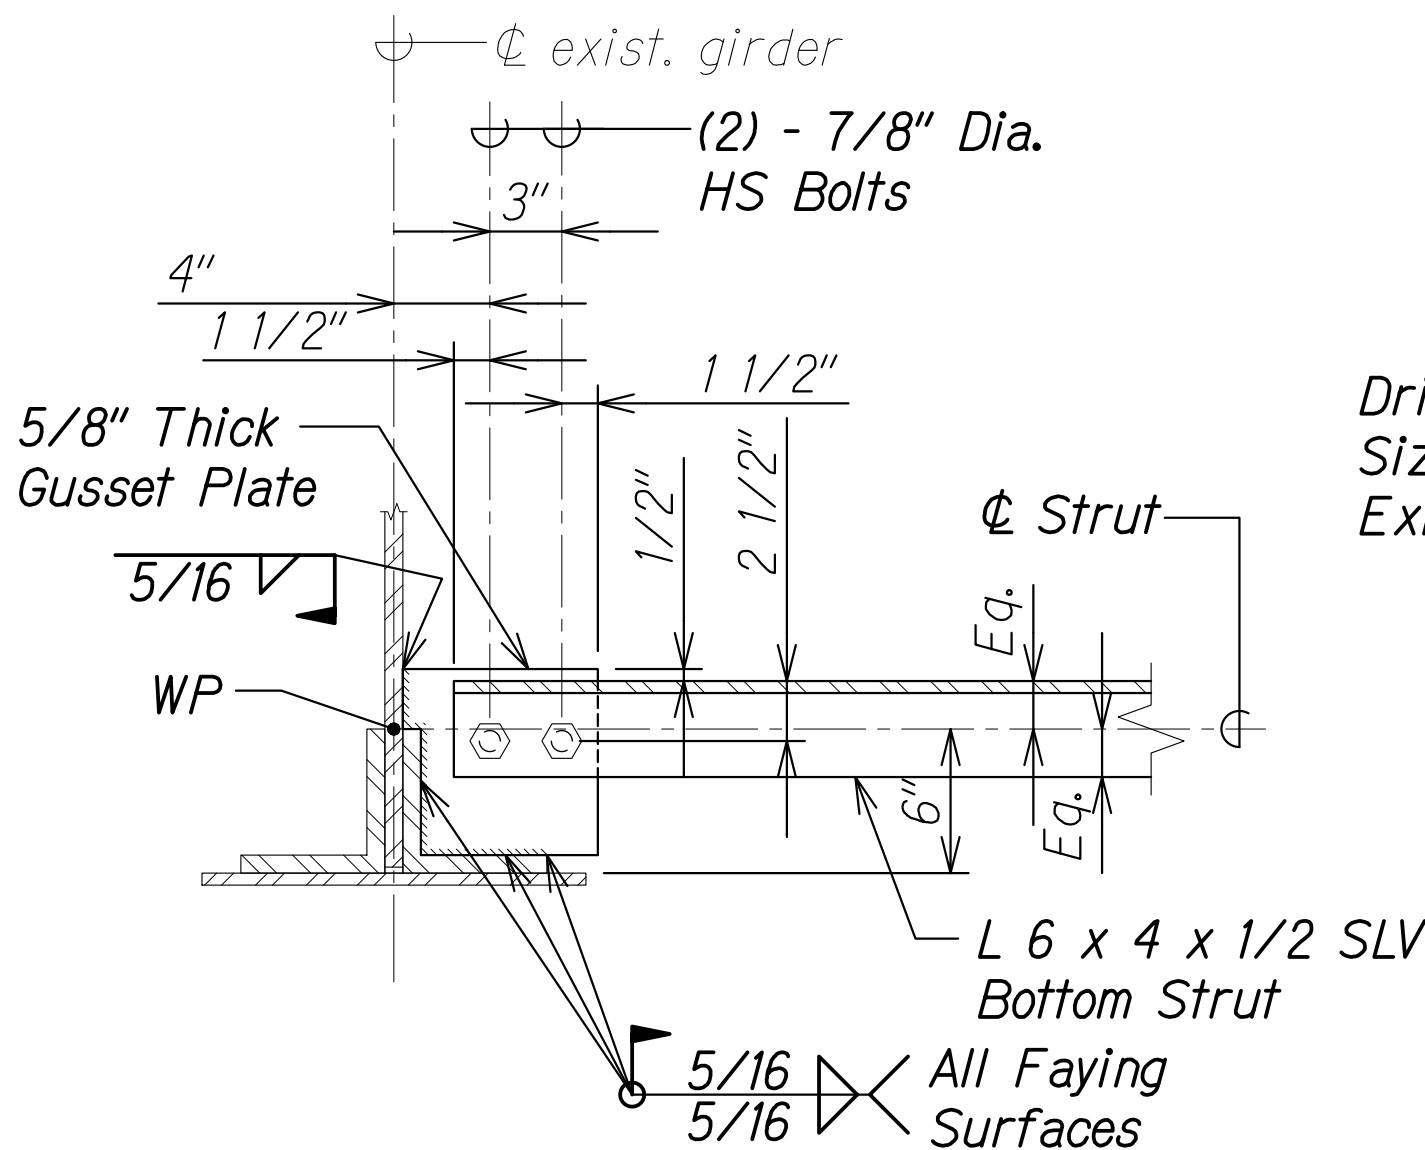

DETAIL

Scale: 1 1/2" = 1'-0"


SA10.12 1 SA10.13
SA10.13

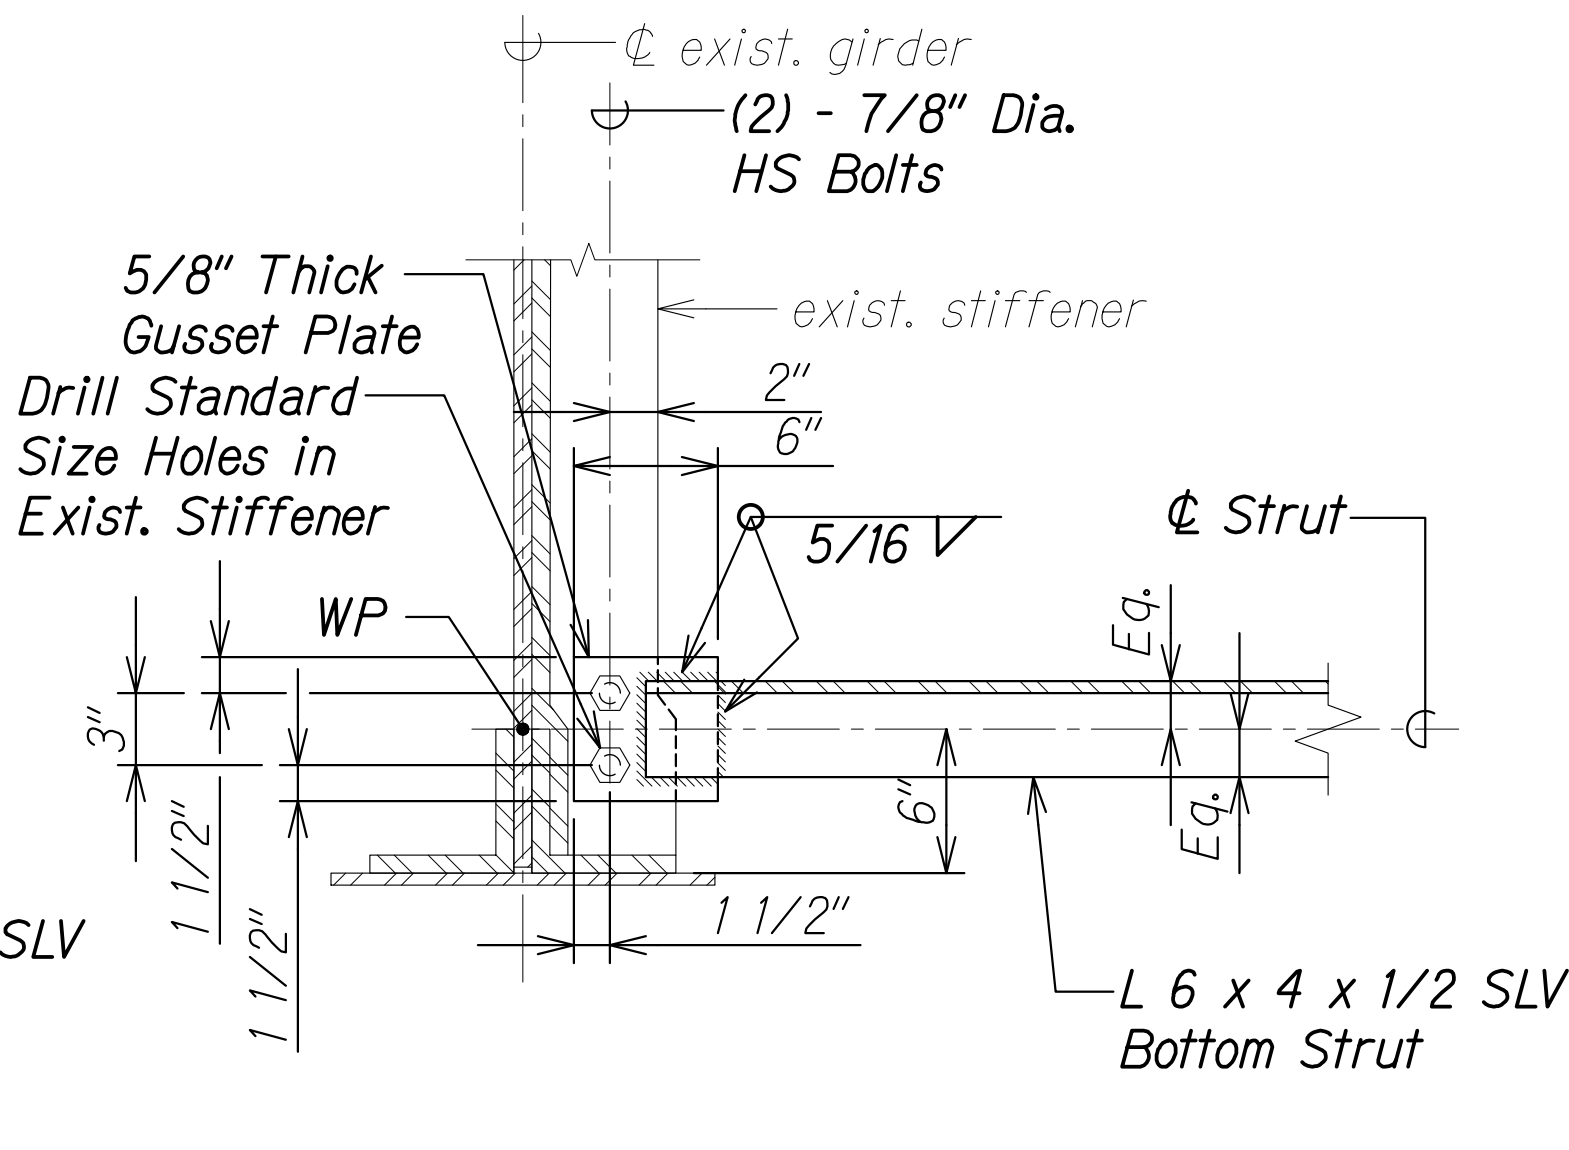

DETAIL

Scale: 1 1/2" = 1'-0"


SA10.12 2 SA10.13
SA10.13

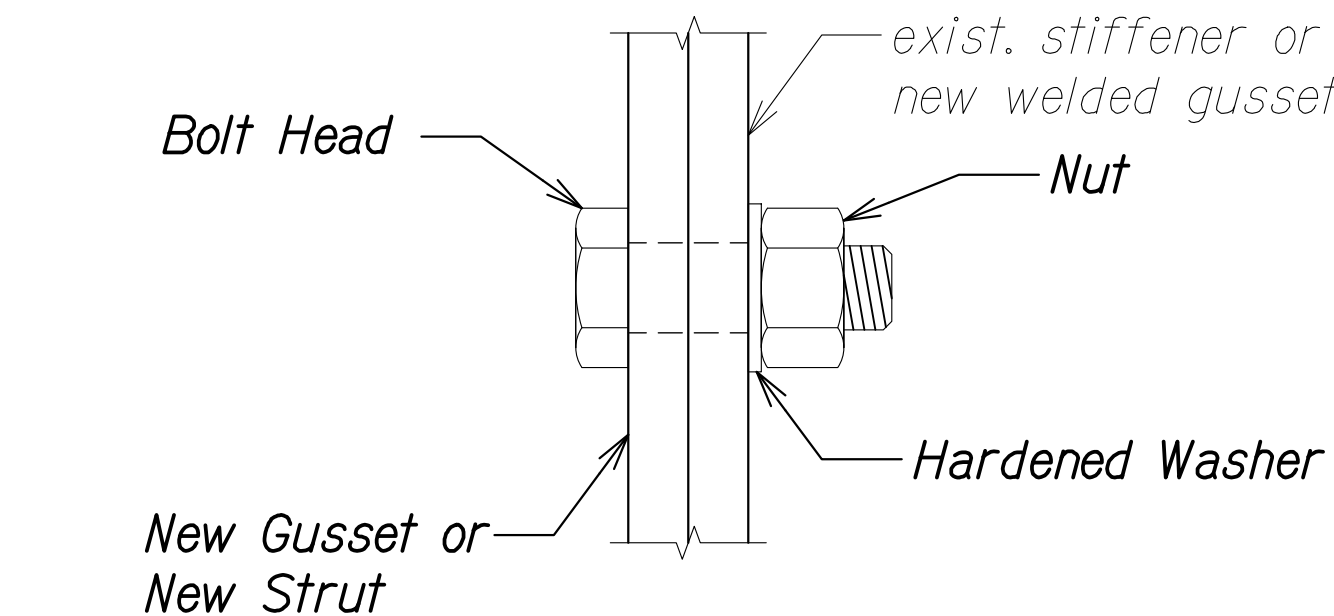

BOLT CONNECTION DETAIL

Scale: 6" = 1'-0"

SA10.13 3 SA10.13

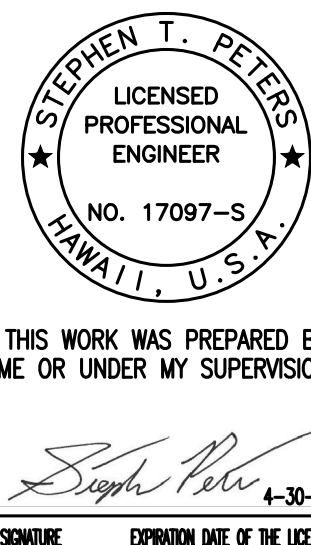

12/6/24	1 Revised Notes
DATE	REVISION
STATE OF HAWAII DEPARTMENT OF TRANSPORTATION HIGHWAYS DIVISION INTERIOR BAY STRUT SECTIONS AND DETAILS HAWAII BELT ROAD Nanue Stream Bridge Rehabilitation Federal Aid Project No. BR-019-2(077) Scale: As Noted Date: Oct. 2024	
SHEET NoSA10.13 OF 30 SHEETS	


FED. ROAD DIST. NO.	STATE	FEDERAL AID PROJ. NO.	FISCAL YEAR	SHEET NO.	TOTAL SHEETS
HAWAII	HAW.	BR-019-2(077)	2024	ADD. 196	280

LEGEND:

[XXX] Cross Frame Mark, See SA9.6 through SA9.10 for locations


NOTES:

- The Contractor shall field fit frame members and gussets prior to welding and galvanizing assemblies.
- New girder stiffeners shall be provided ungalvanized and field welded to existing plate girders. Field drill standard size holes in existing/new girder stiffeners to match bolt pattern in new cross frame assembly.
- Existing stiffeners at in-span cross frames shall remain. Existing bearing stiffeners at fixed and expansion bearing cross frames shall be replaced. See Sheet SA10.20 for stiffener replacement details.
- Cross frame assemblies shall be delivered to the site fully assembled, hot-dip zinc galvanized per ASTM A123, and shop painted with primer, seal coat, stripe coat, and intermediate in accordance with Section 667 - PREPARATION AND COATING OF GALVANIZED BRIDGE STEEL of the Special Provisions.
- Just prior to installation of cross frame assemblies, the immediate surrounding faying surfaces of existing/new girder stiffeners shall be cleaned in accordance with SSPC-SP 10 or SSPC-SP 11 and painted, by brush, with two coats of the specified primer.
- Perform final abrasive blast cleaning to all girders, stiffeners, etc. Cross frame assemblies shall be sufficiently shielded from damage during blasting operation and masked from overspray during primer application.
- Cross frame assemblies shall receive field applied top coat in accordance with Section 666 - BLAST, CLEAN, AND PAINT EXISTING BRIDGE STEEL of the Special Provisions.
- Details from adjacent bays not shown for clarity.
- See Sheet SA9.23 for required sequence regarding cross frame replacement and corresponding traffic control requirements.

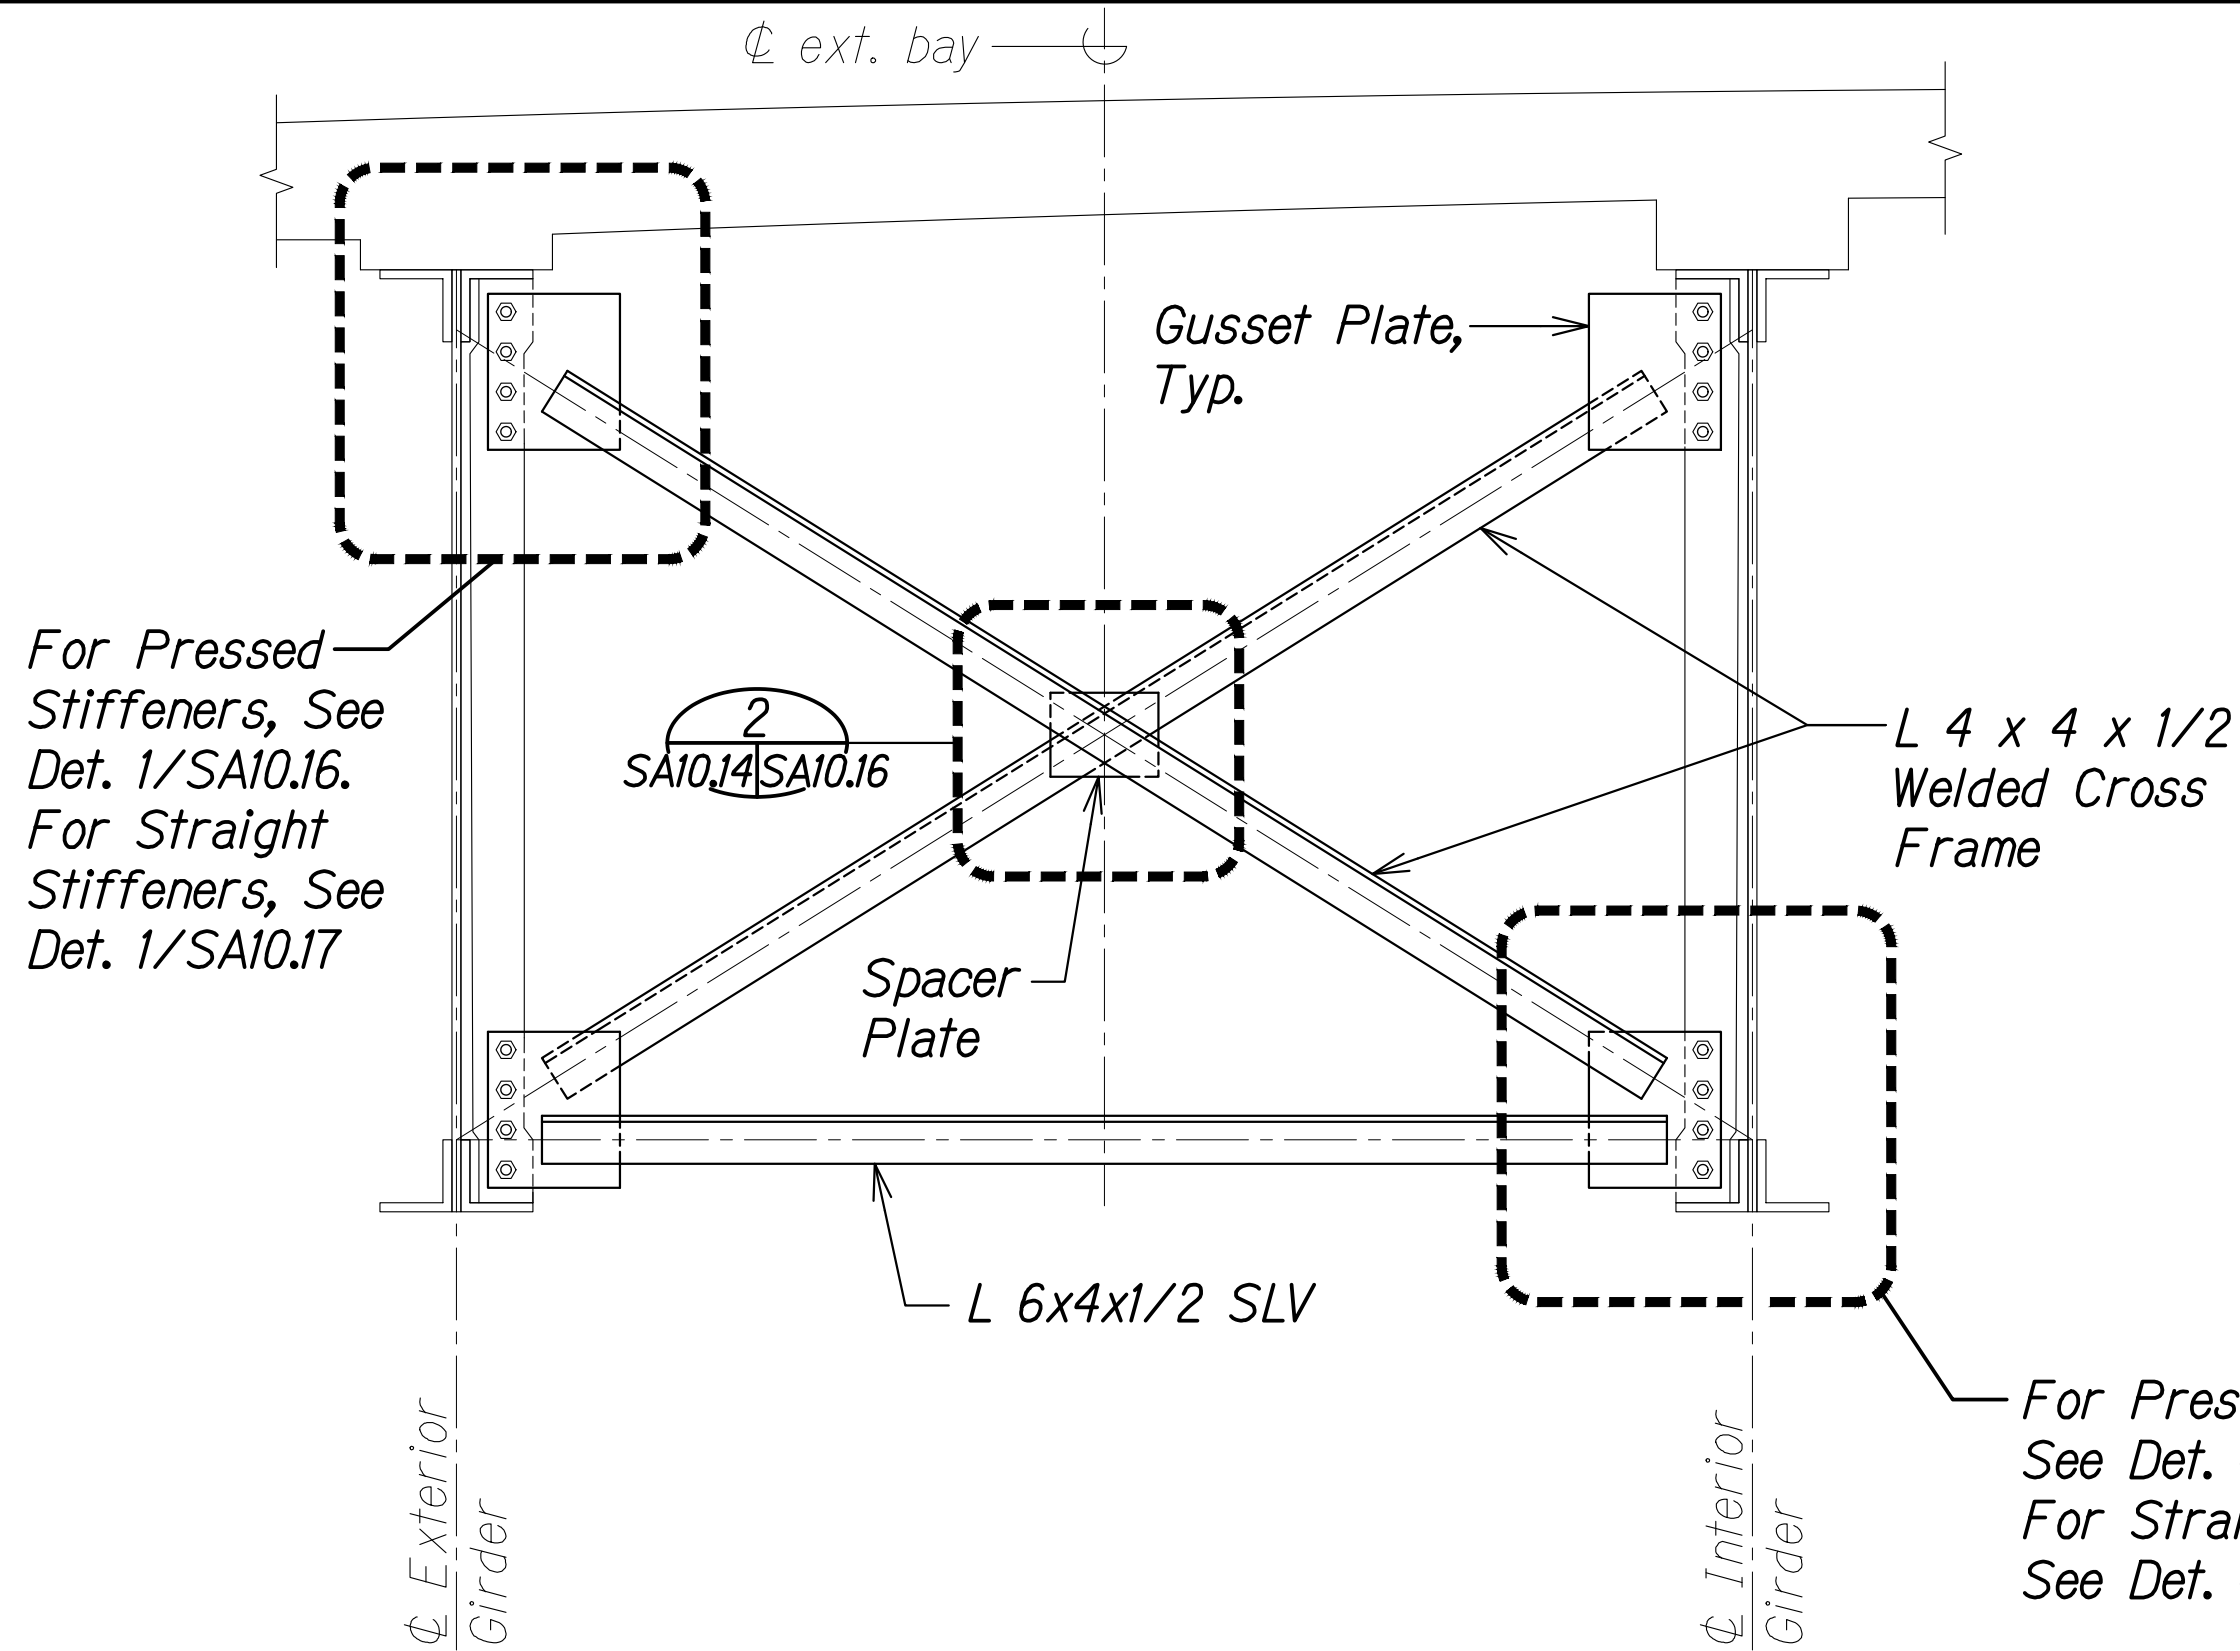


[R1] EXTERIOR BAY SECTION
AT IN-SPAN CROSS FRAME A

Scale: 3/4" = 1'-0" SA10.14 SA10.14

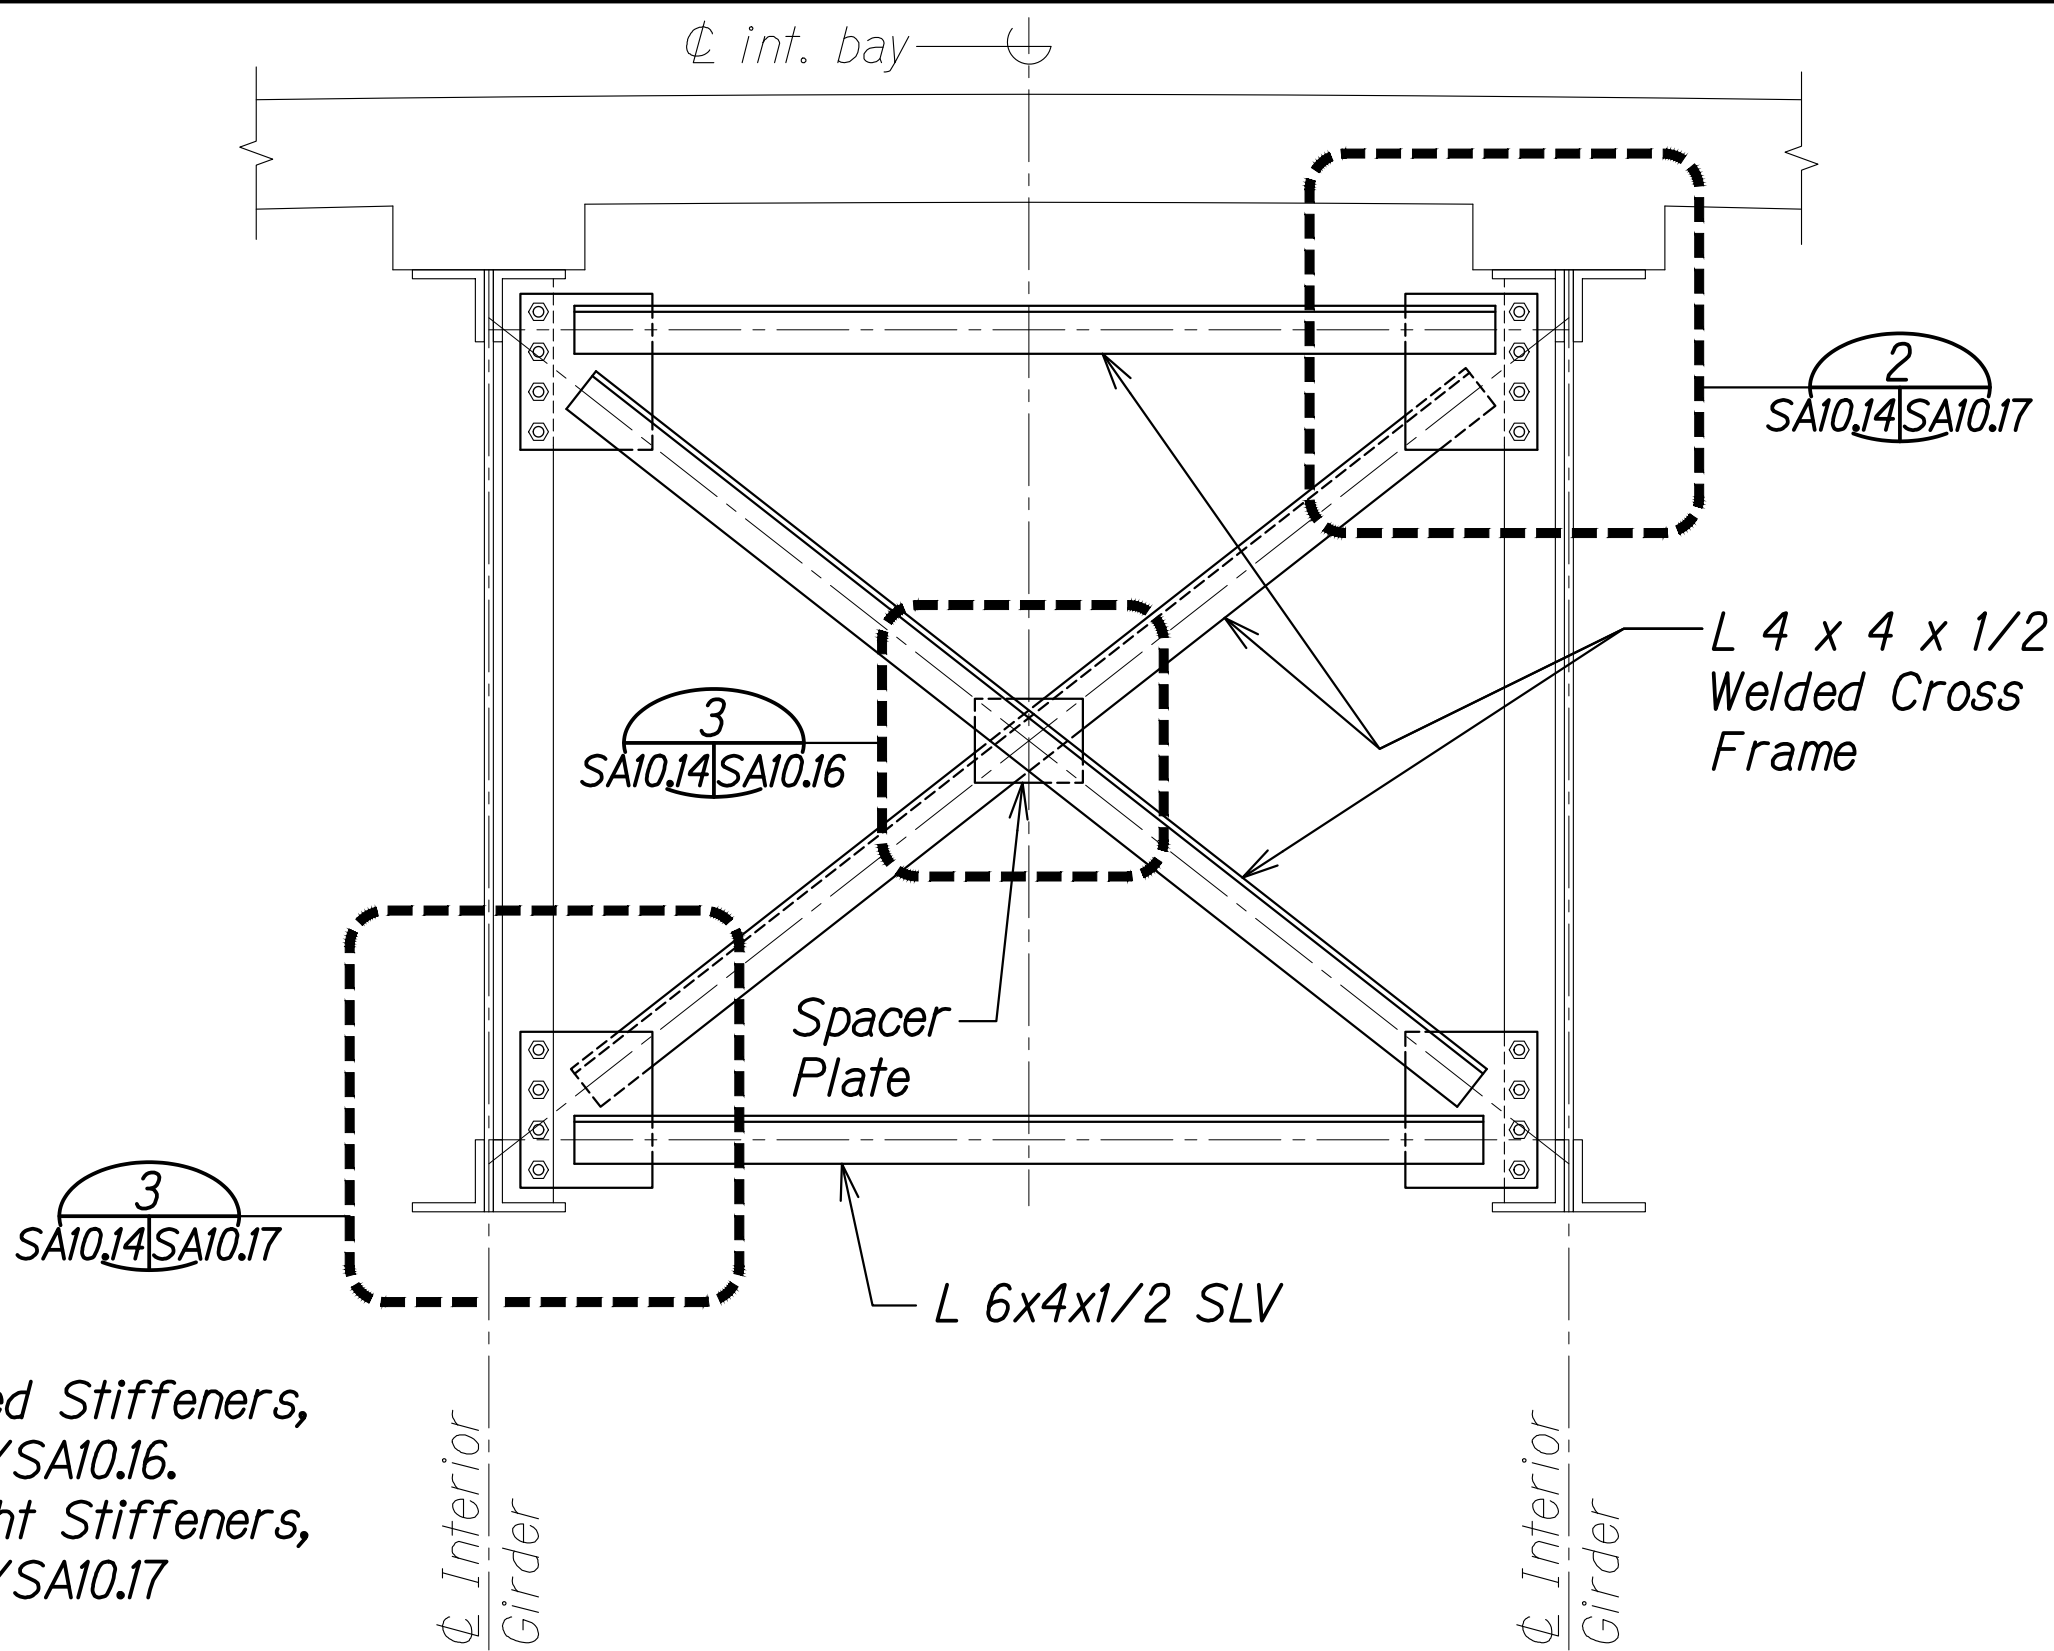


[R2] INTERIOR BAY SECTION
AT IN-SPAN CROSS FRAME B

Scale: 3/4" = 1'-0" SA10.14 SA10.14

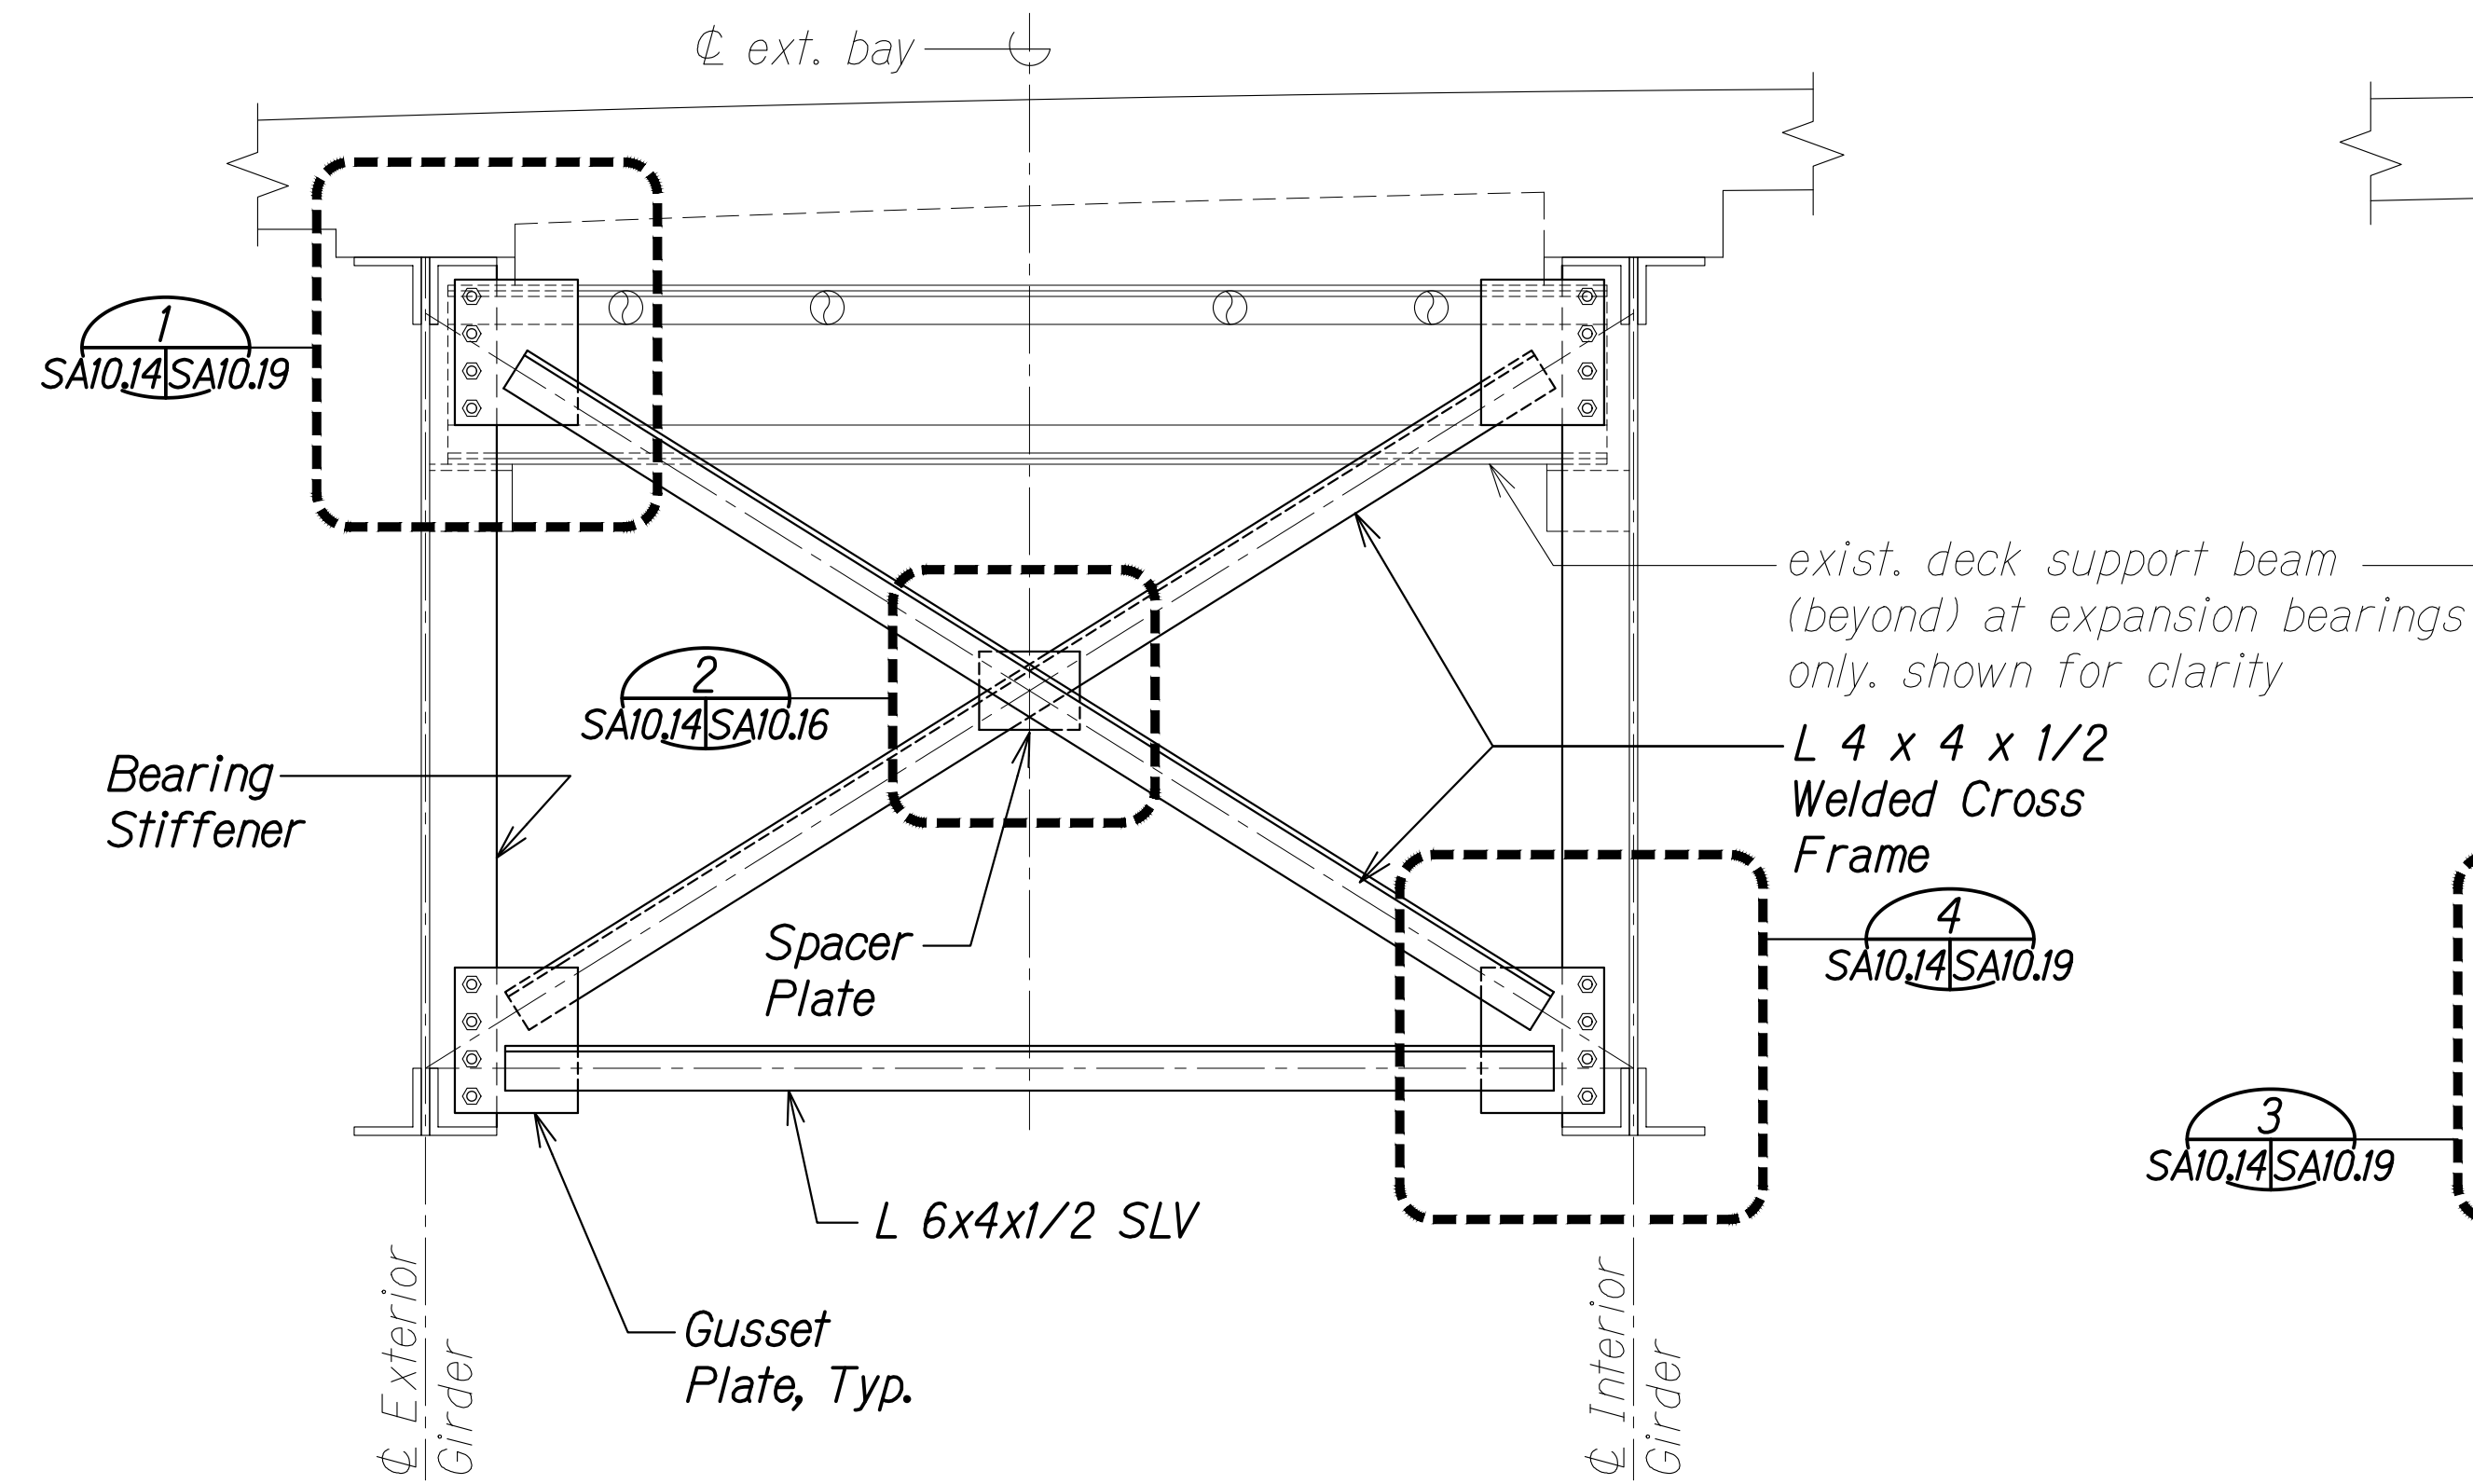


[R3] EXTERIOR BAY SECTION AT FIXED &
EXPANSION BEARING CROSS FRAMES C

Scale: 3/4" = 1'-0" SA10.14 SA10.14

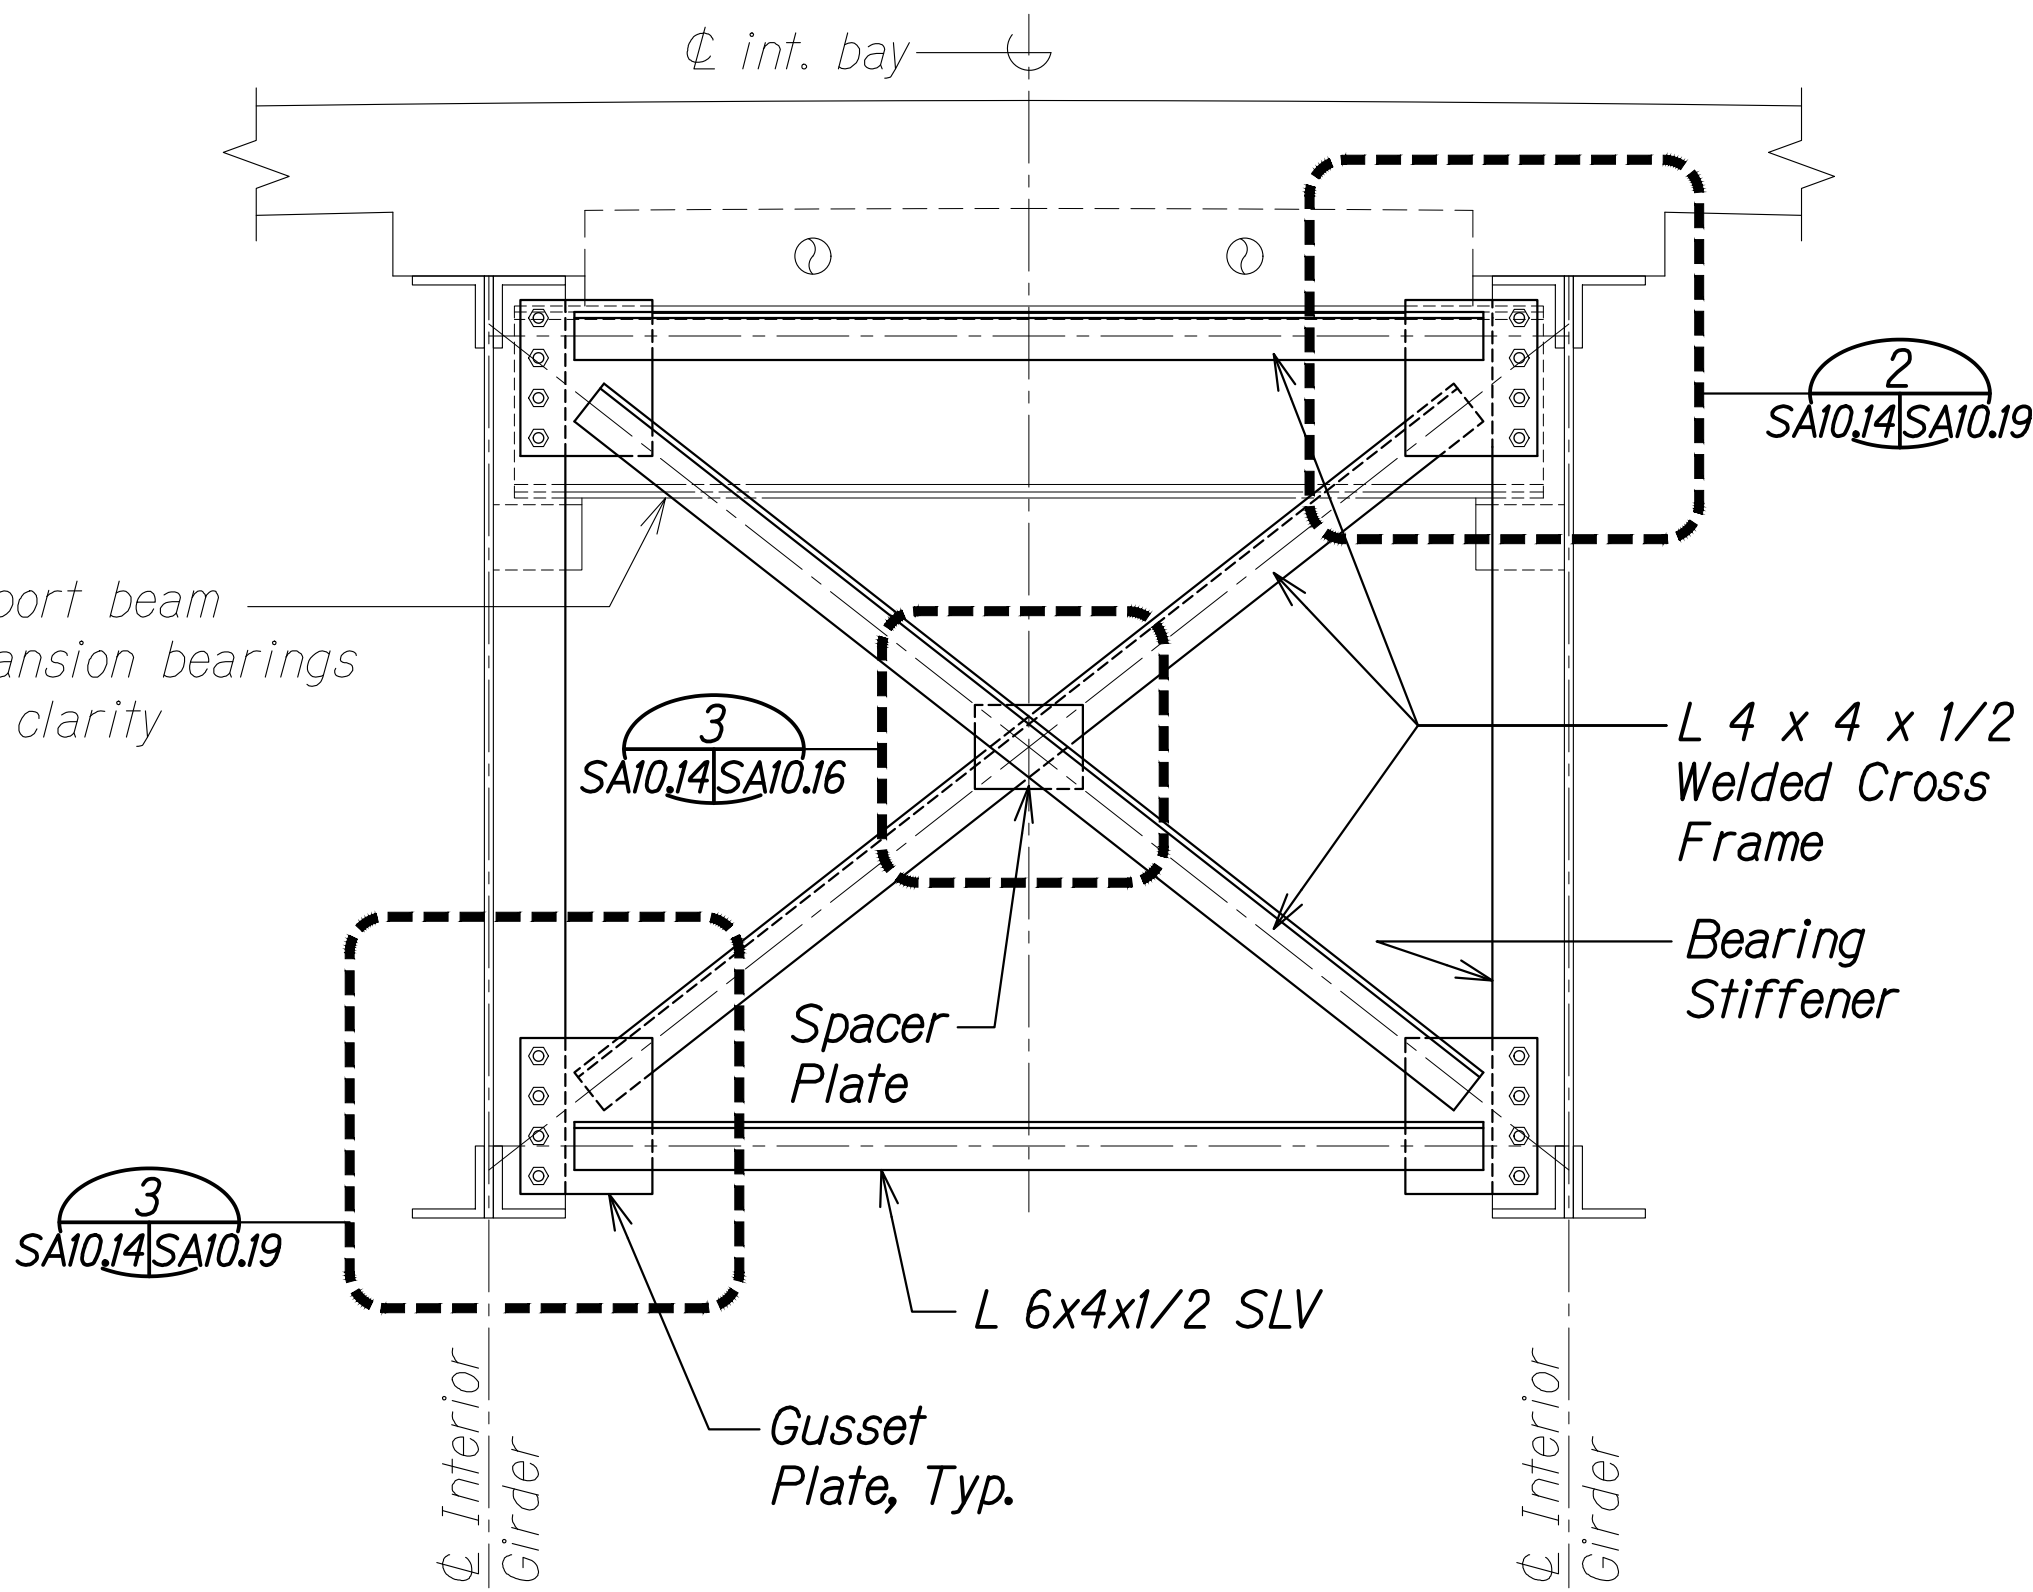

[R4] INTERIOR BAY SECTION AT FIXED &
EXPANSION BEARING CROSS FRAMES D

Scale: 3/4" = 1'-0" SA10.14 SA10.14

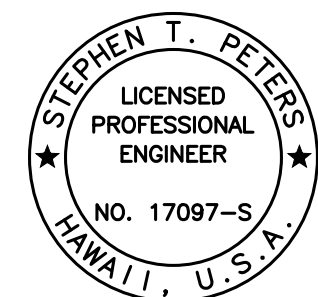

THIS WORK WAS PREPARED BY
ME OR UNDER MY SUPERVISION.
SIGNATURE EXPIRATION DATE OF THE LICENSE

12/6/24 1 Revised Notes

DATE REVISION

STATE OF HAWAII
DEPARTMENT OF TRANSPORTATION
HIGHWAYS DIVISION

IN-SPAN, ELEVATION, AND FIXED BEARING
CROSS FRAME SECTIONS


HAWAII BELT ROAD
Nanue Stream Bridge Rehabilitation
Federal Aid Project No. BR-019-2(077)
Scale: As Noted Date: Oct. 2024

SHEET No SA10.14 OF 30 SHEETS


FED. ROAD DIST. NO.	STATE	FEDERAL AID PROJ. NO.	FISCAL YEAR	SHEET NO.	TOTAL SHEETS
HAWAII	HAW.	BR-019-2(077)	2024	ADD. 204	280

NOTES:


- The Contractor shall field fit lateral diagonal bracing and gussets prior to galvanizing. Predrill holes in the field, including those through the bottom flange of the girder.
- Lateral diagonal bracing and gussets shall be delivered to the site hot-dip zinc galvanized per ASTM A123, and shop painted with the complete coating system in accordance with Special Provisions Section 667-PREPARATION AND COATING OF GALVANIZED BRIDGE STEEL.
- Install lateral diagonal bracing and gussets following completion of painting in Bay 2. Touch up paint ends of bolts, nuts and washers. Payment for work under Pay Item 667.3000 does not apply.

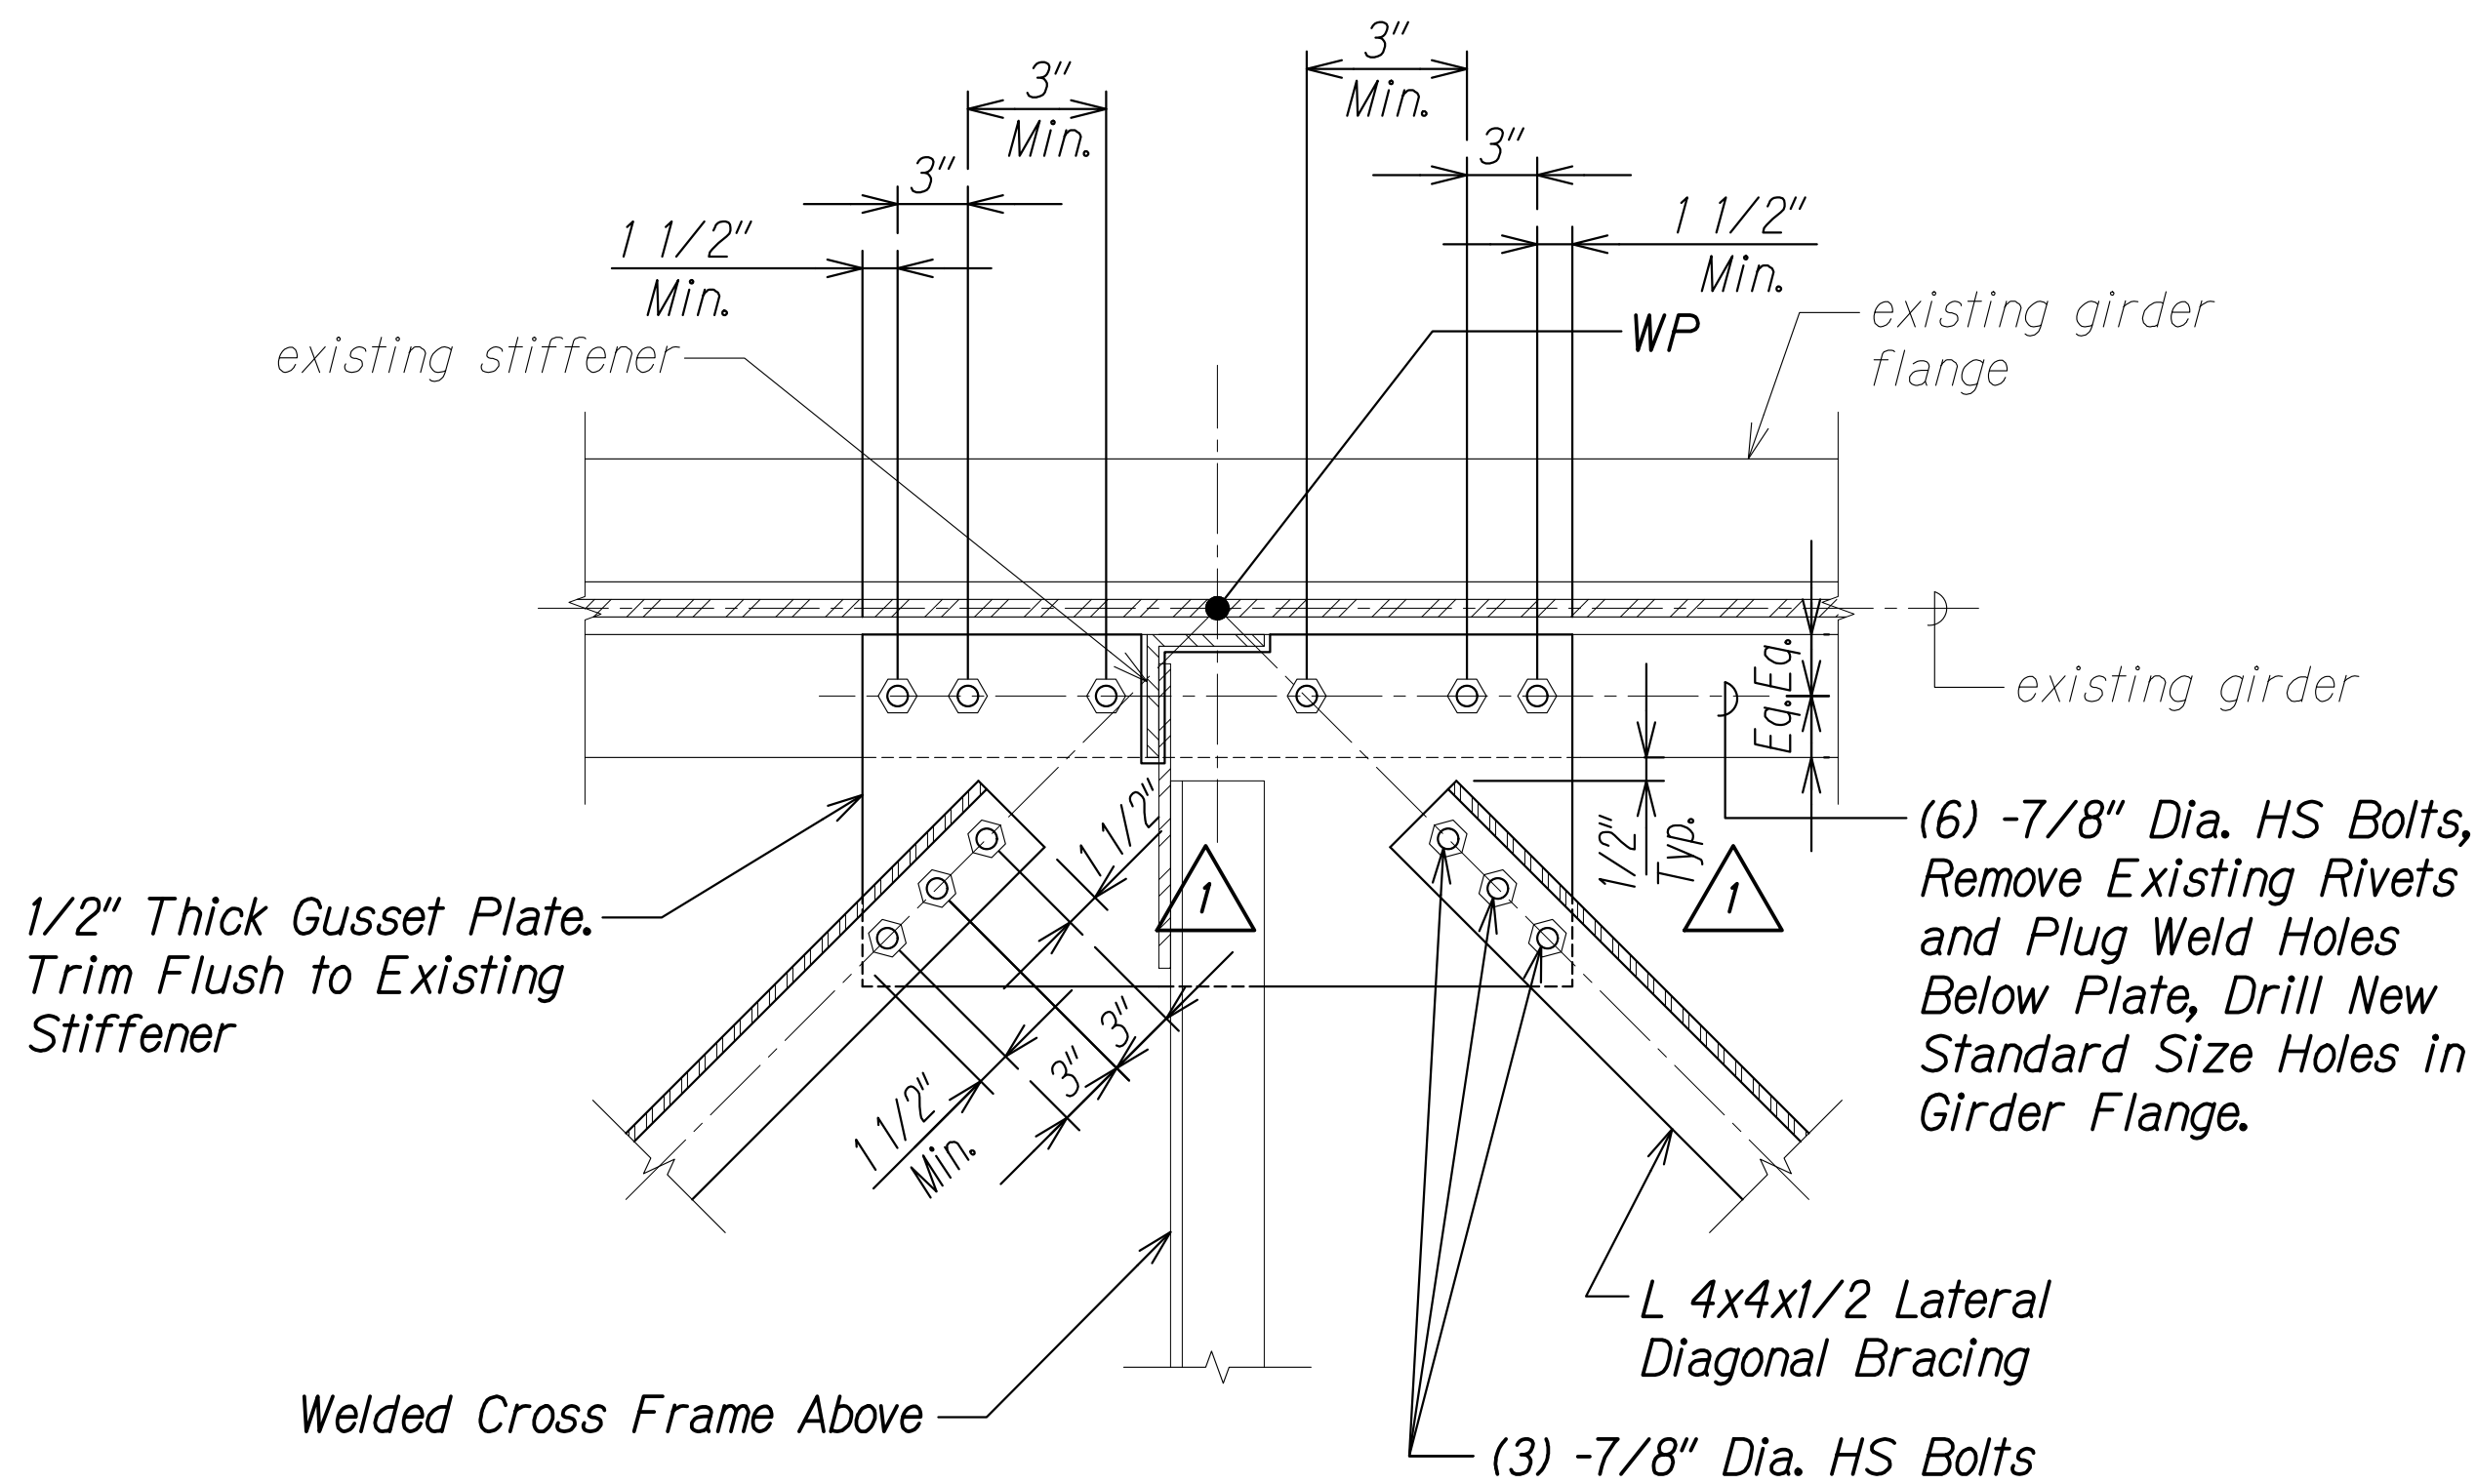


PLAN AT CROSS FRAME
Scale: 1 1/2" = 1'-0"
SA10.22 SA10.22

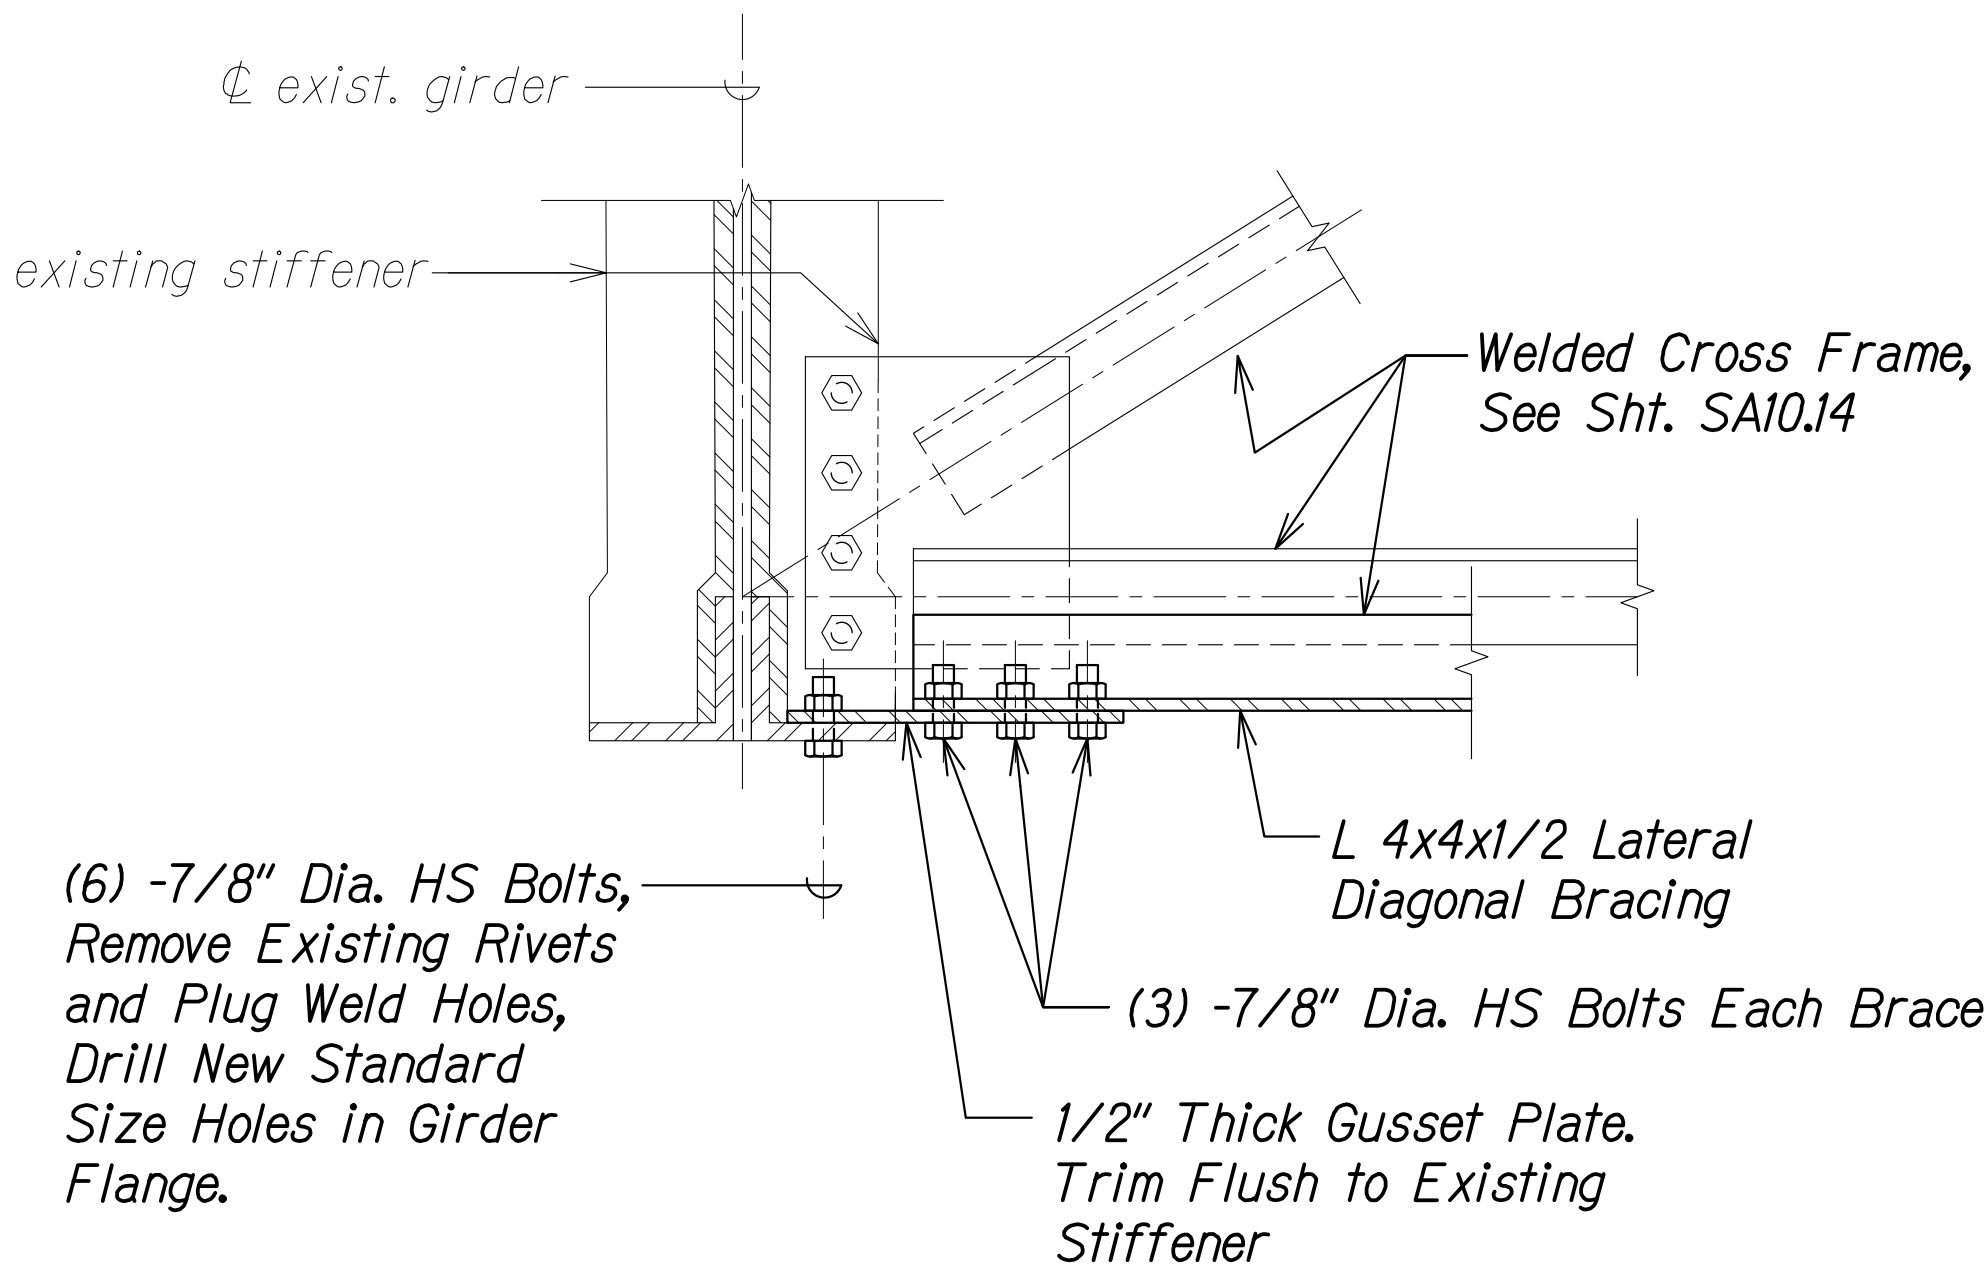

SECTION AT CROSS FRAME
Scale: 1 1/2" = 1'-0"
SA10.22 SA10.22

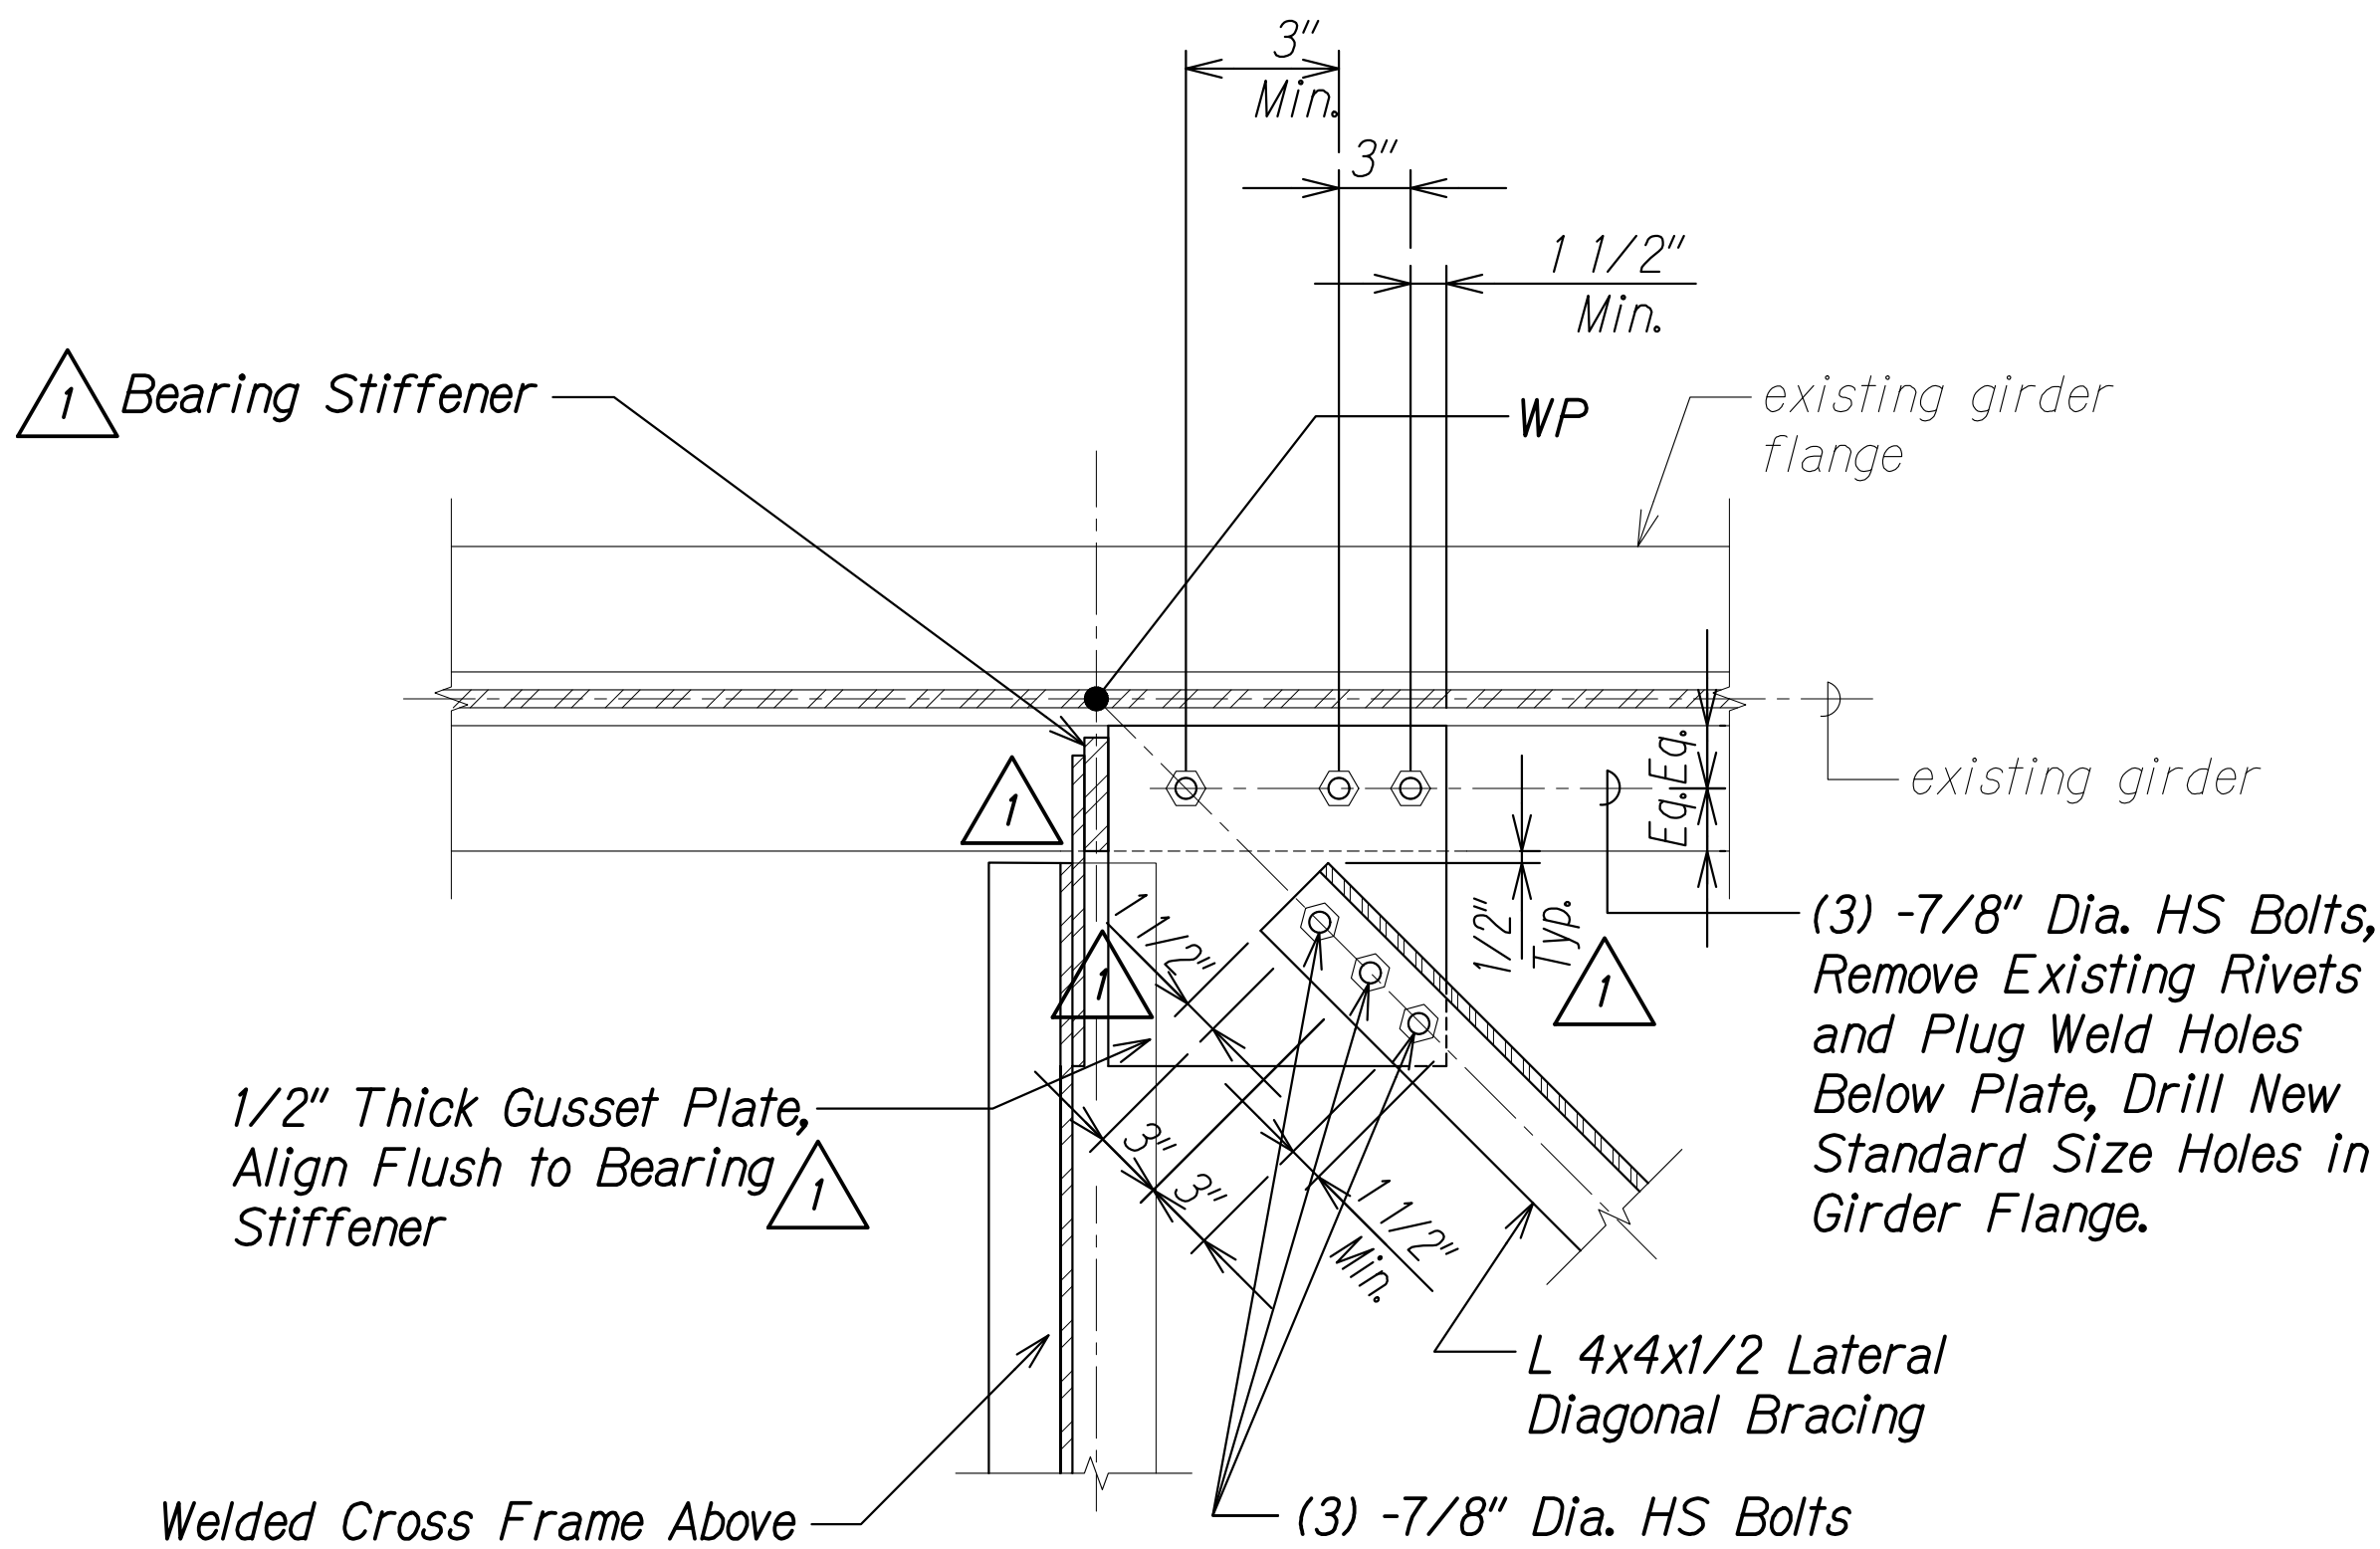


PLAN AT BEARING CROSS FRAME
Scale: 1 1/2" = 1'-0"
SA10.22 SA10.22

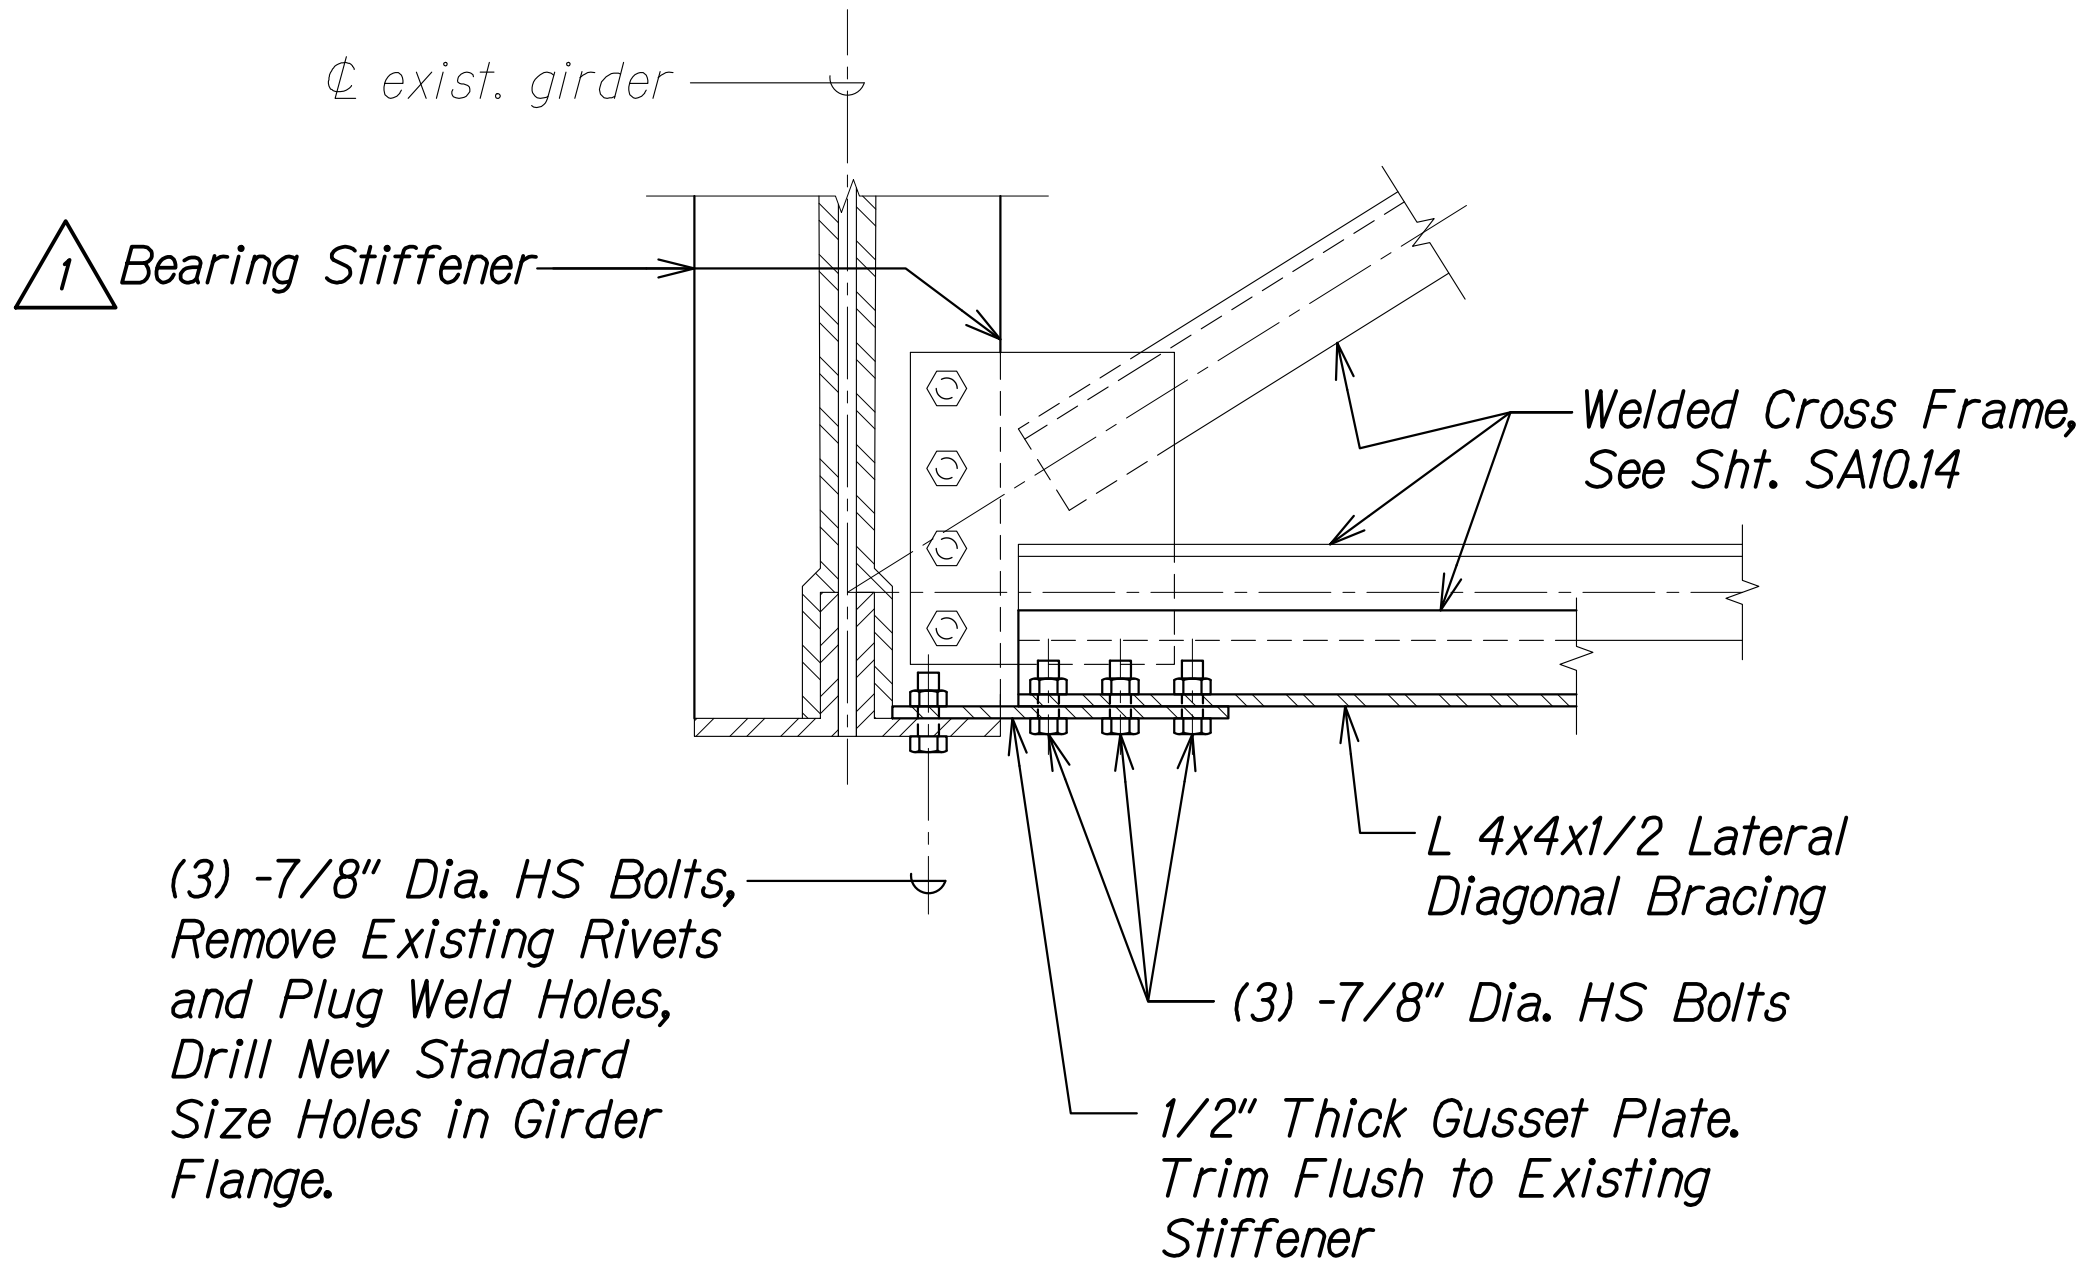

SECTION AT BEARING CROSS FRAME
Scale: 1 1/2" = 1'-0"
SA10.22 SA10.22


INTERIOR BAY LATERAL DIAGONAL BRACING DETAILS

12/6/24		<i>Revised Details Revised Notes and Added/ Revised Dimensions</i>
DATE	REVISION	


STATE OF HAWAII
DEPARTMENT OF TRANSPORTATION
HIGHWAYS DIVISION

LATERAL DIAGONAL
BRACING DETAILS
HAWAII BELT ROAD
Nanue Stream Bridge Rehabilitation
Federal Aid Project No. BR-019-2(077)
Scale: As Noted *Date: Oct. 2024*


SHEET NoSA10.22 OF 30 SHEETS

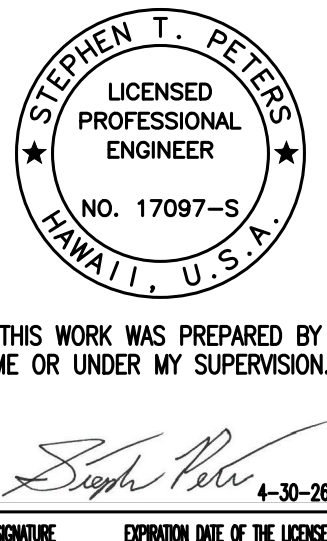


FED. ROAD DIST. NO.	STATE	FEDERAL AID PROJ. NO.	FISCAL YEAR	SHEET NO.	TOTAL SHEETS
HAWAII	HAW.	BR-019-2(077)	2024	ADD. 205	280

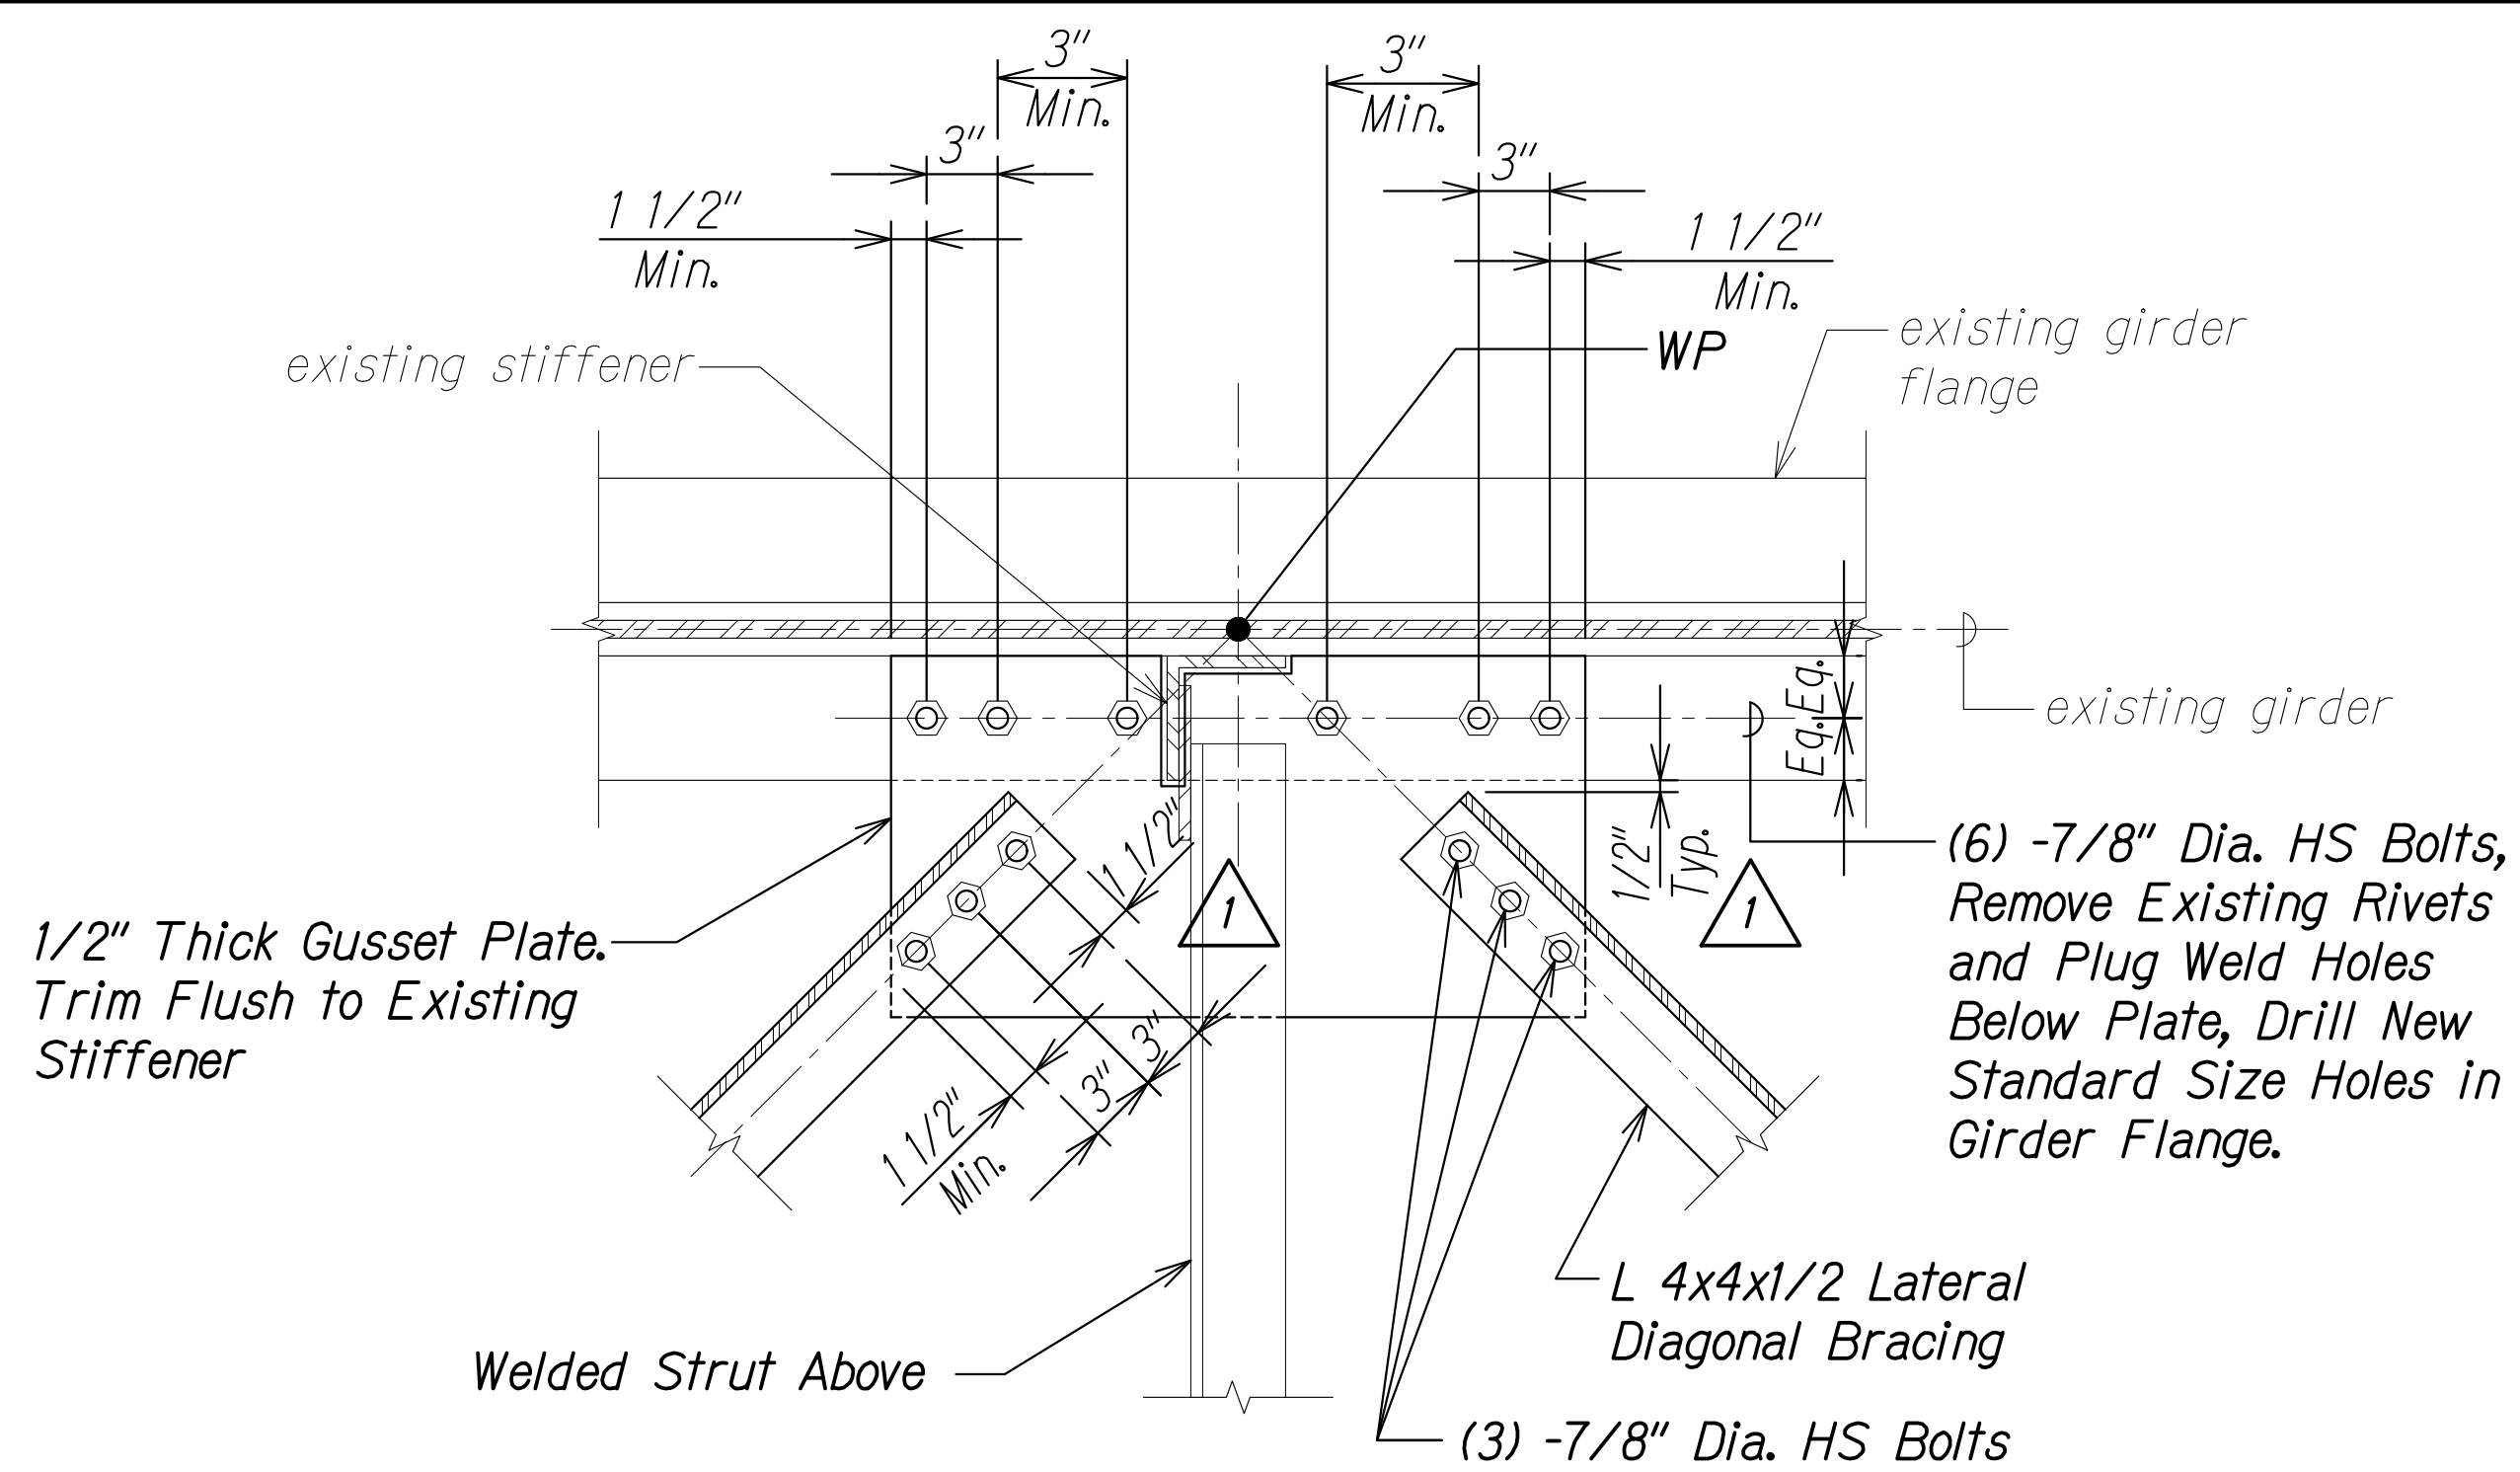


PLAN AT STRUT A
Scale: 1 1/2" = 1'-0" SA10.23 SA10.23

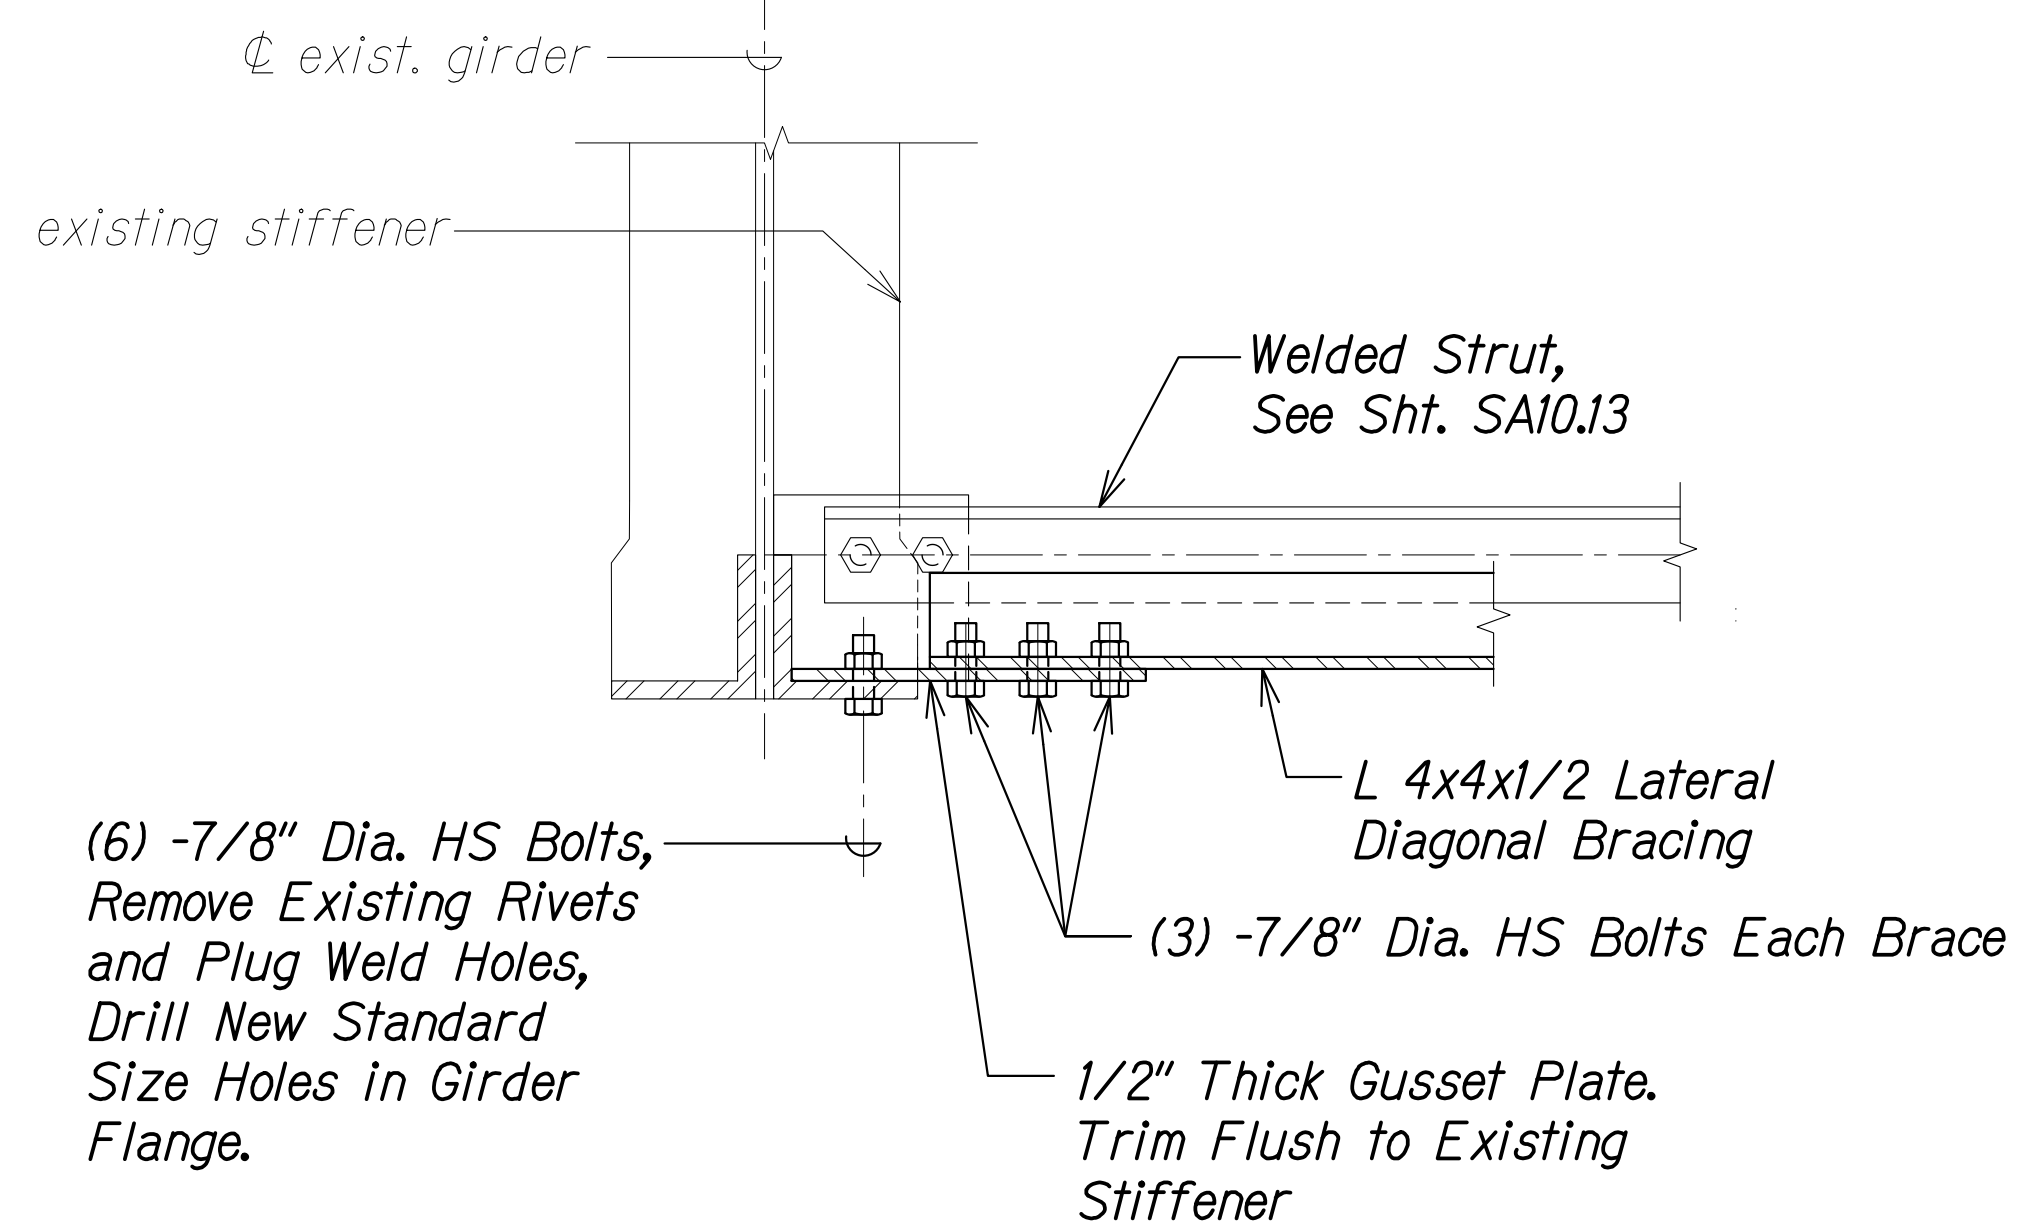

SECTION AT STRUT B
Scale: 1 1/2" = 1'-0" SA10.23 SA10.23

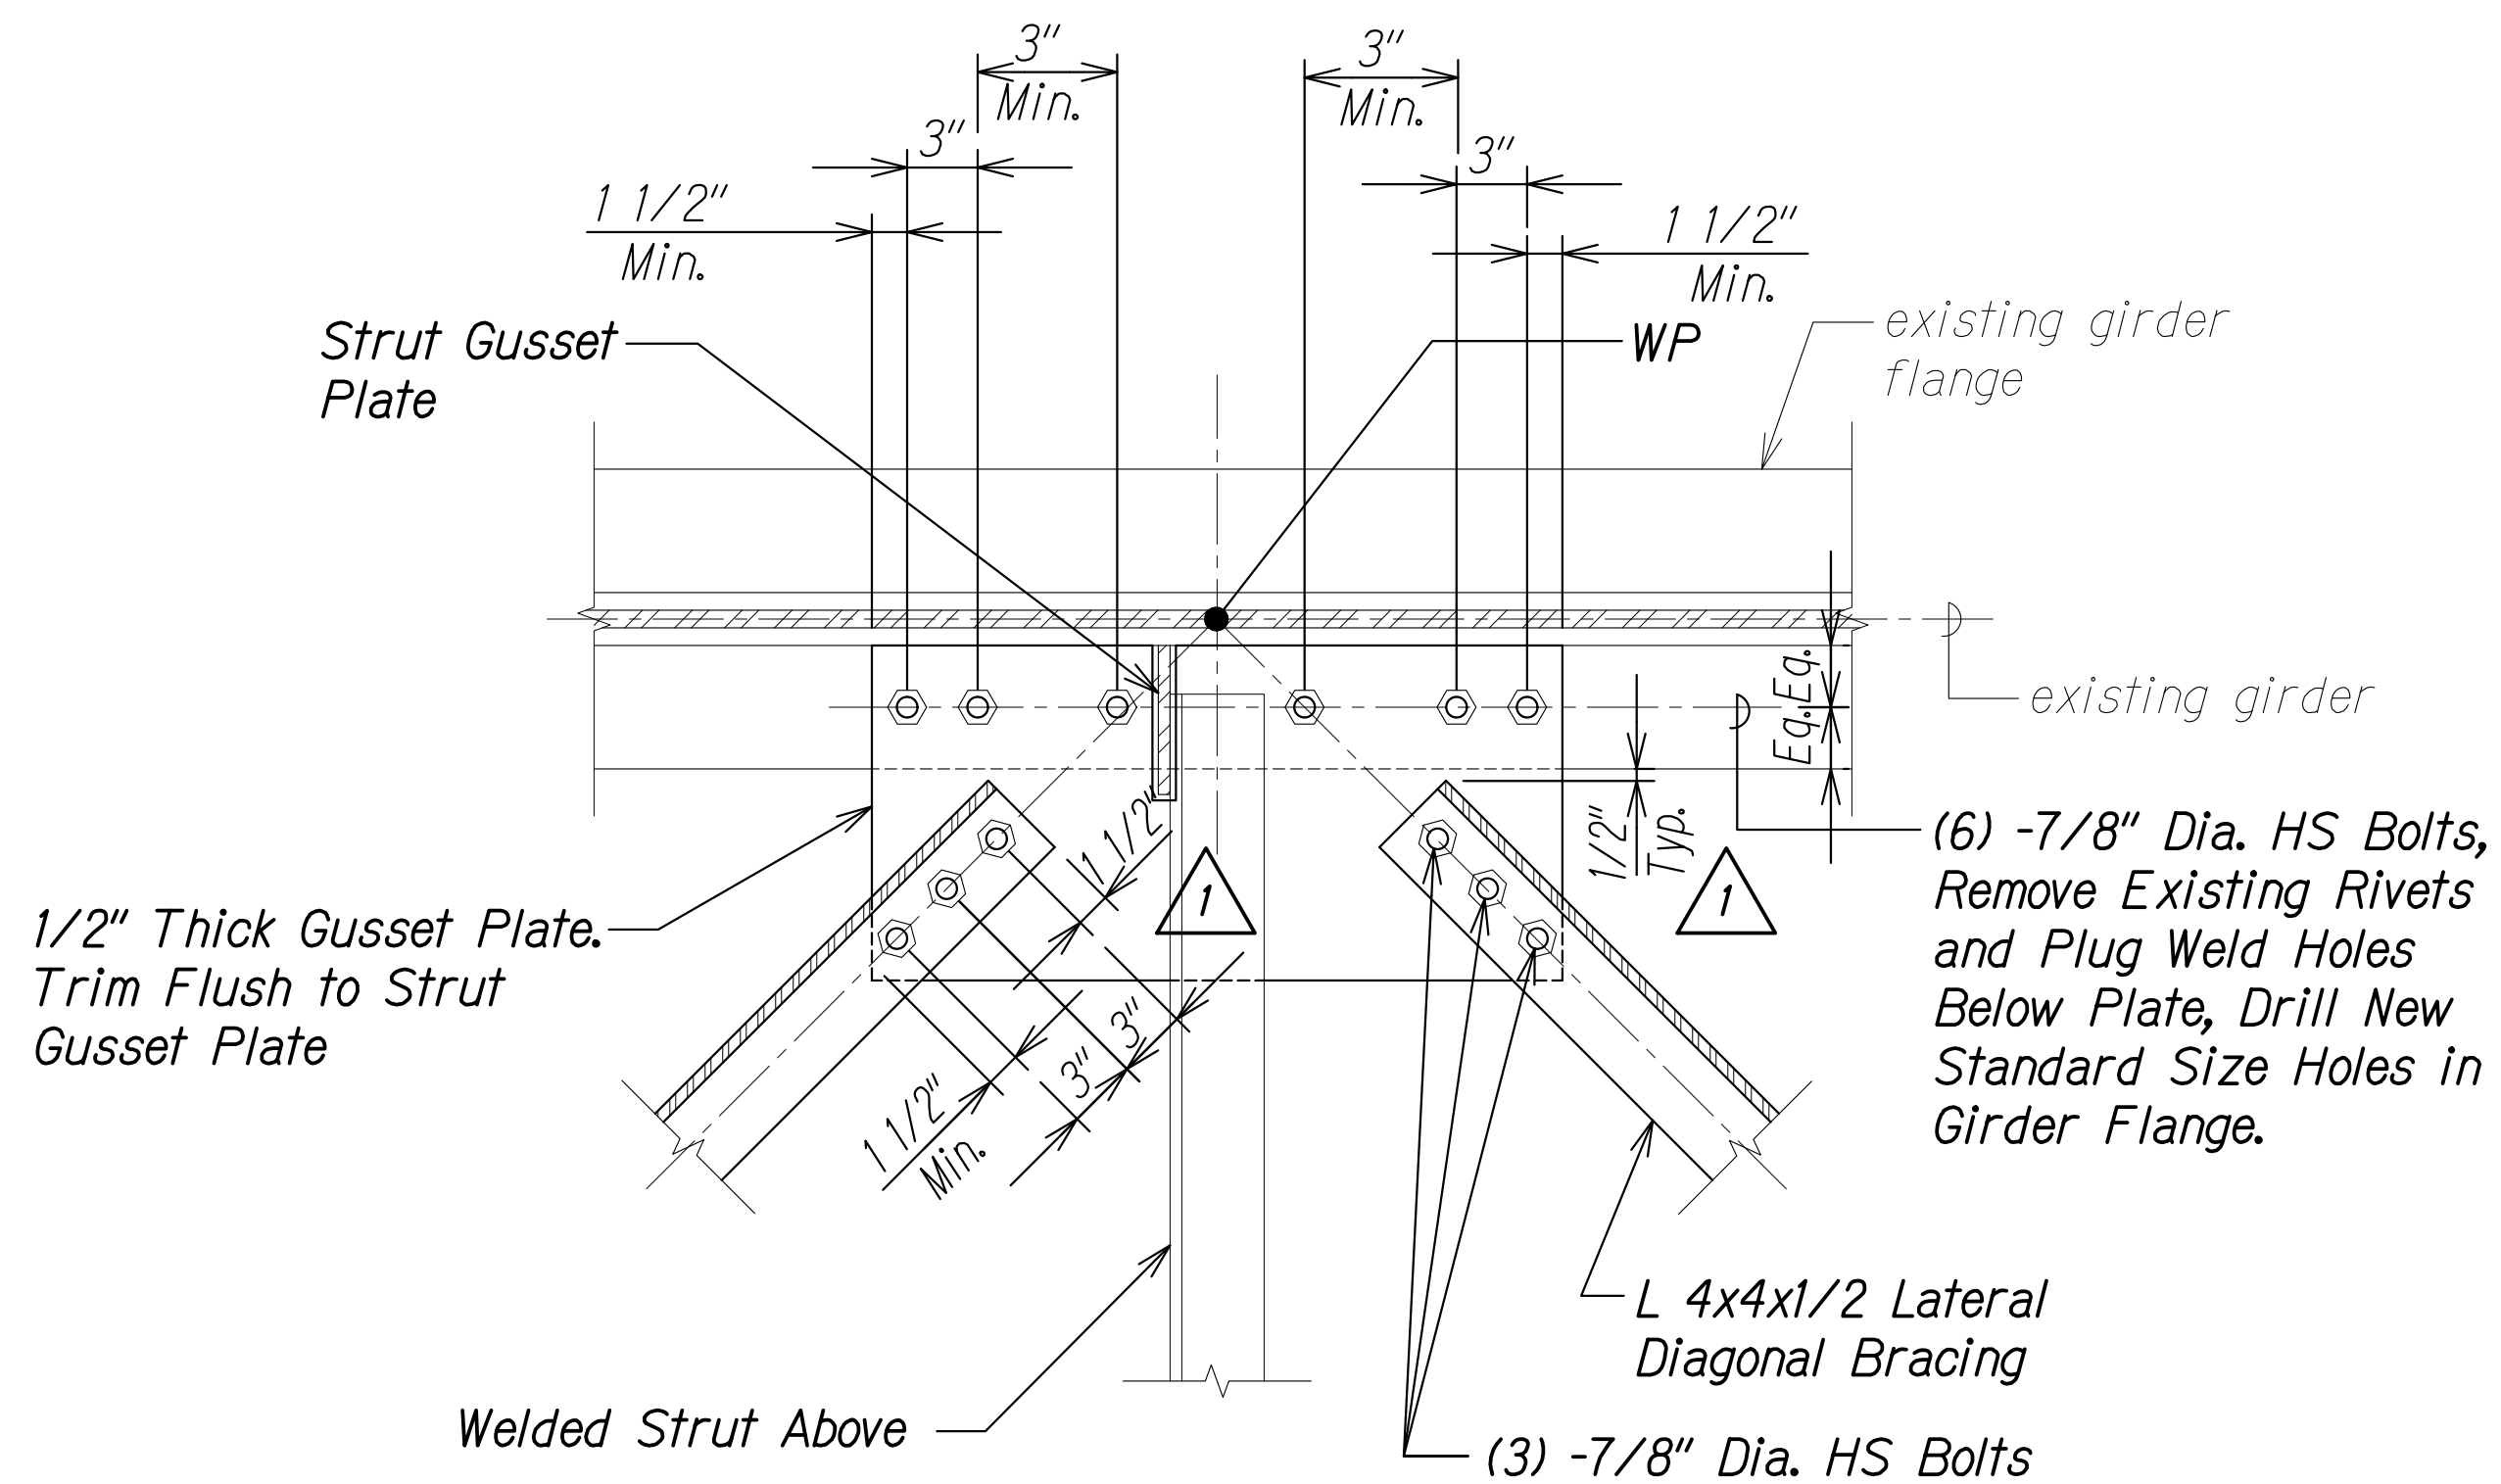

PLAN AT STRUT C
Scale: 1 1/2" = 1'-0" SA10.23 SA10.23

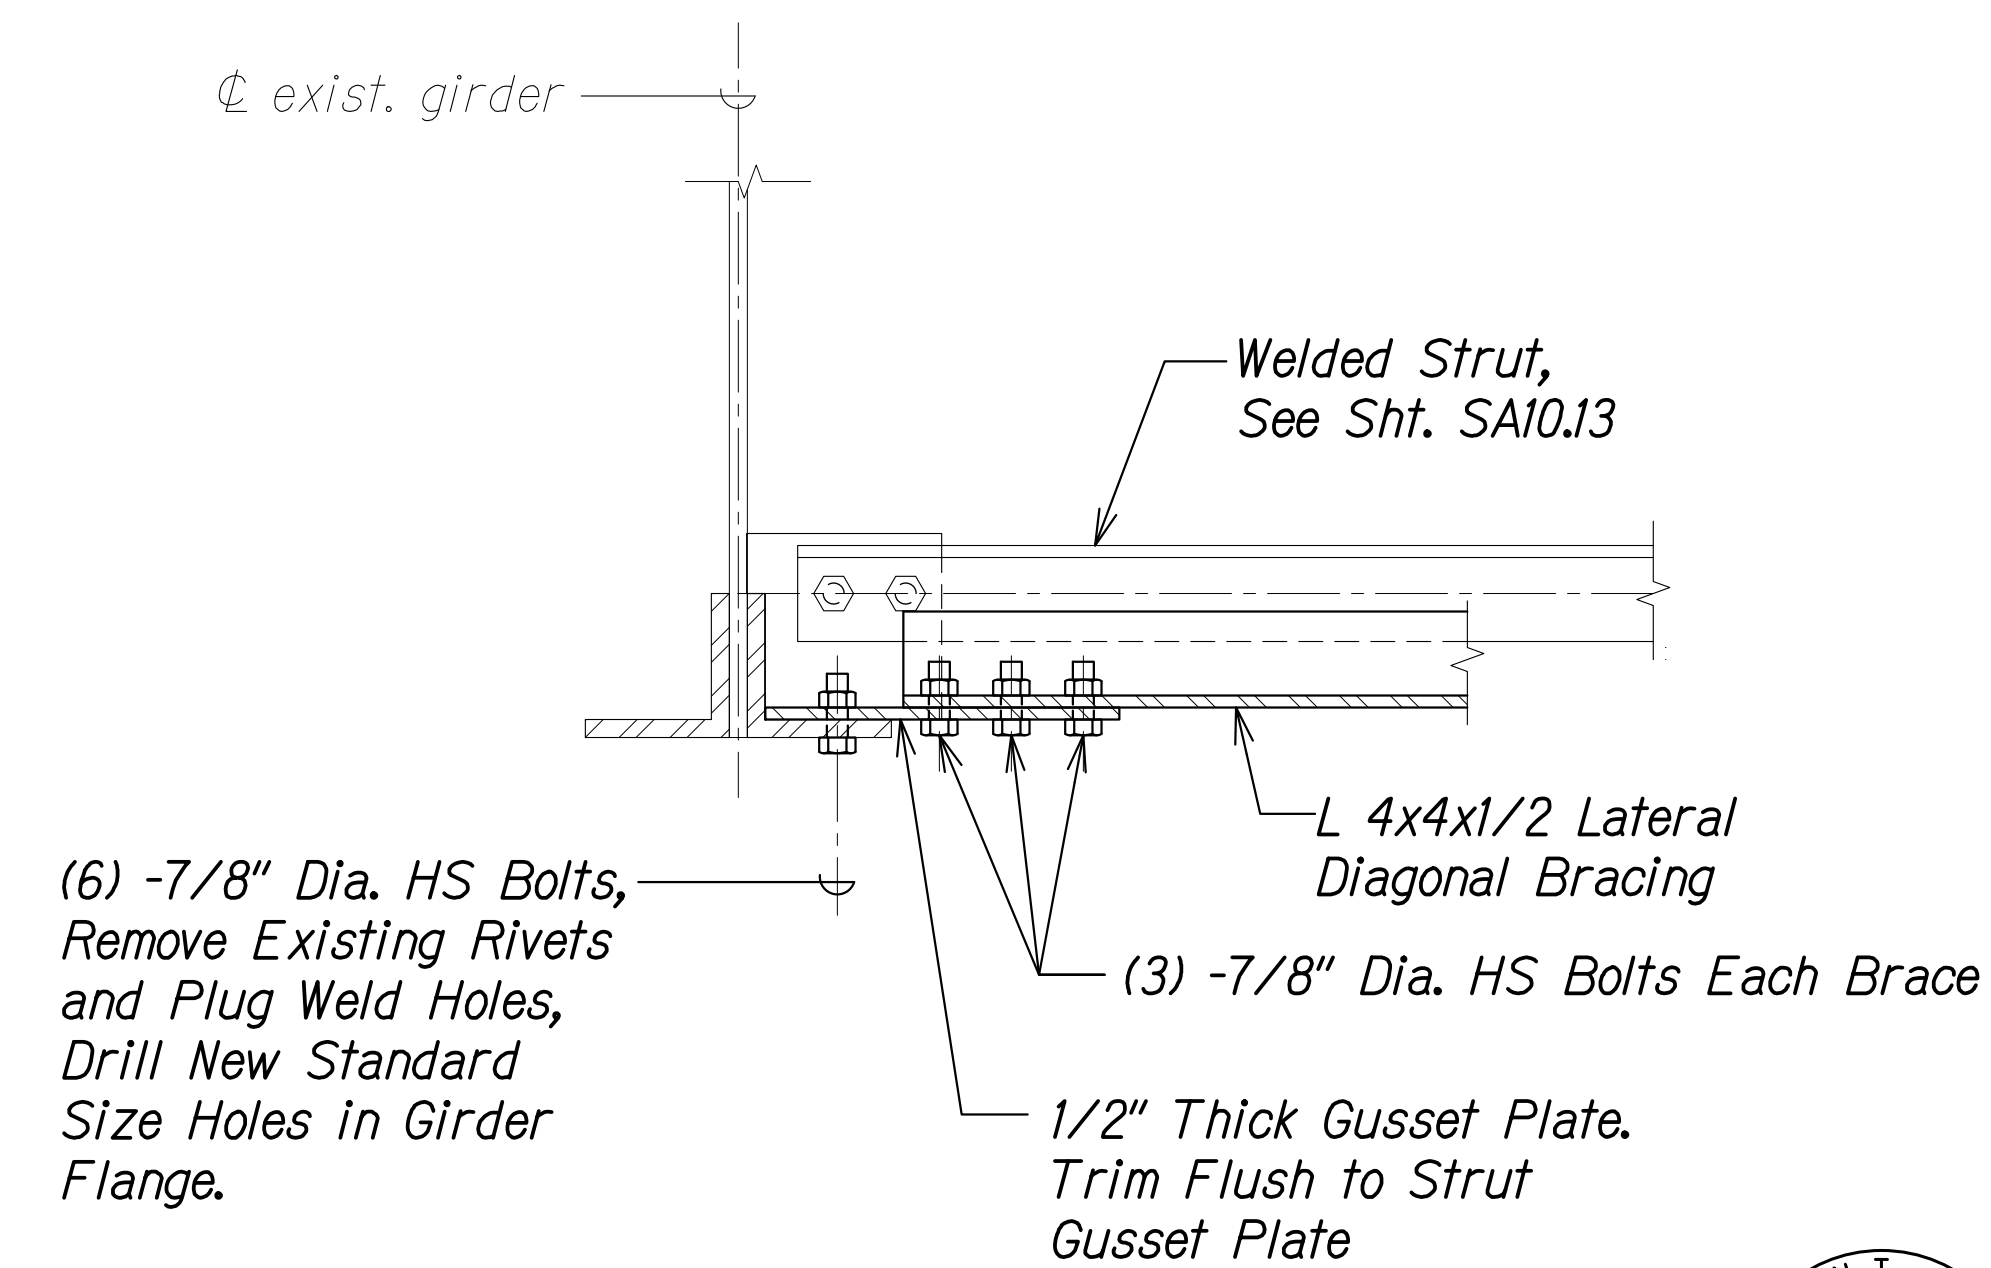


SECTION AT STRUT D
Scale: 1 1/2" = 1'-0" SA10.23 SA10.23

NOTES:

- The Contractor shall field fit lateral diagonal bracing and gussets prior to galvanizing. Predrill holes in the field, including those through the bottom flange of the girder.
- Lateral diagonal bracing and gussets shall be delivered to the site hot-dip zinc galvanized per ASTM A123, and shop painted with the complete coating system in accordance with Special Provisions Section 667-PREPARATION AND COATING OF GALVANIZED BRIDGE STEEL.
- Install lateral diagonal bracing and gussets following completion of painting in Bay 2. Touch up paint ends of bolts, nuts and washers. Payment for work under Pay Item 667.3000 does not apply.

DATE	REVISION
12/6/24	1 Revised Notes and Added/ Revised Dimensions
STATE OF HAWAII DEPARTMENT OF TRANSPORTATION HIGHWAYS DIVISION LATERAL DIAGONAL BRACING DETAILS HAWAII BELT ROAD Nanue Stream Bridge Rehabilitation Federal Aid Project No. BR-019-2(077) Scale: As Noted Date: Oct. 2024	

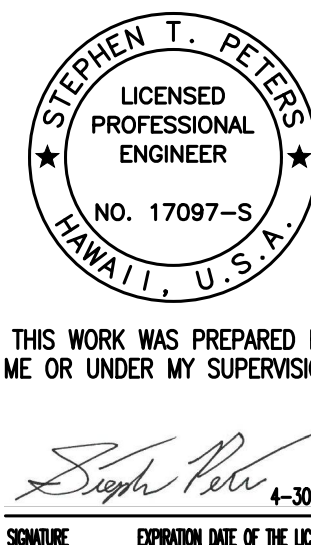


INTERIOR BAY LATERAL DIAGONAL BRACING DETAILS

FED. ROAD DIST. NO.	STATE	FEDERAL AID PROJ. NO.	FISCAL YEAR	SHEET NO.	TOTAL SHEETS
HAWAII	HAW.	BR-019-2(077)	2024	ADD. 207	280

NOTES:

1. Bolt assembly at tie plate connection must not be pretensioned.
2. See girder line elevations for location of tie plate replacement.
3. Redrill standard size holes at the ends of girder web to match bolt pattern in tie plate prior to painting.
4. Clean and paint girders prior to installation of tie plates.
5. Tie plates shall be delivered to the site hot-dip zinc galvanized per ASTM A123 and shop painted with the complete coating system in accordance with Special Provisions Section 667 - PREPARATION AND COATING OF GALVANIZED BRIDGE STEEL.
6. Touch-up paint ends of all hardware (bolt, nut, washers) after installation. Payment for work under Pay Item 667.3000 does not apply.

12/6/24	1 Revised Notes
DATE	REVISION

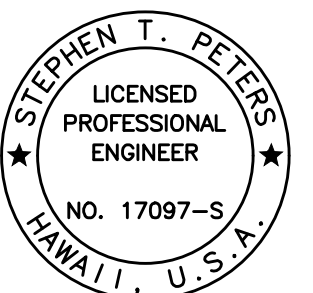

THIS WORK WAS PREPARED BY ME OR UNDER MY SUPERVISION.

SIGNATURE: Stephen Peters
EXPIRATION DATE OF THE LICENSE: 4-30-26


STATE OF HAWAII
DEPARTMENT OF TRANSPORTATION
HIGHWAYS DIVISION

TIE PLATE
ELEVATIONS AND DETAILS AT BEARINGS


HAWAII BELT ROAD
Nanue Stream Bridge Rehabilitation
Federal Aid Project No. BR-019-2(077)

Scale: As Noted Date: Oct. 2024


SHEET No. SA10.25 OF 30 SHEETS

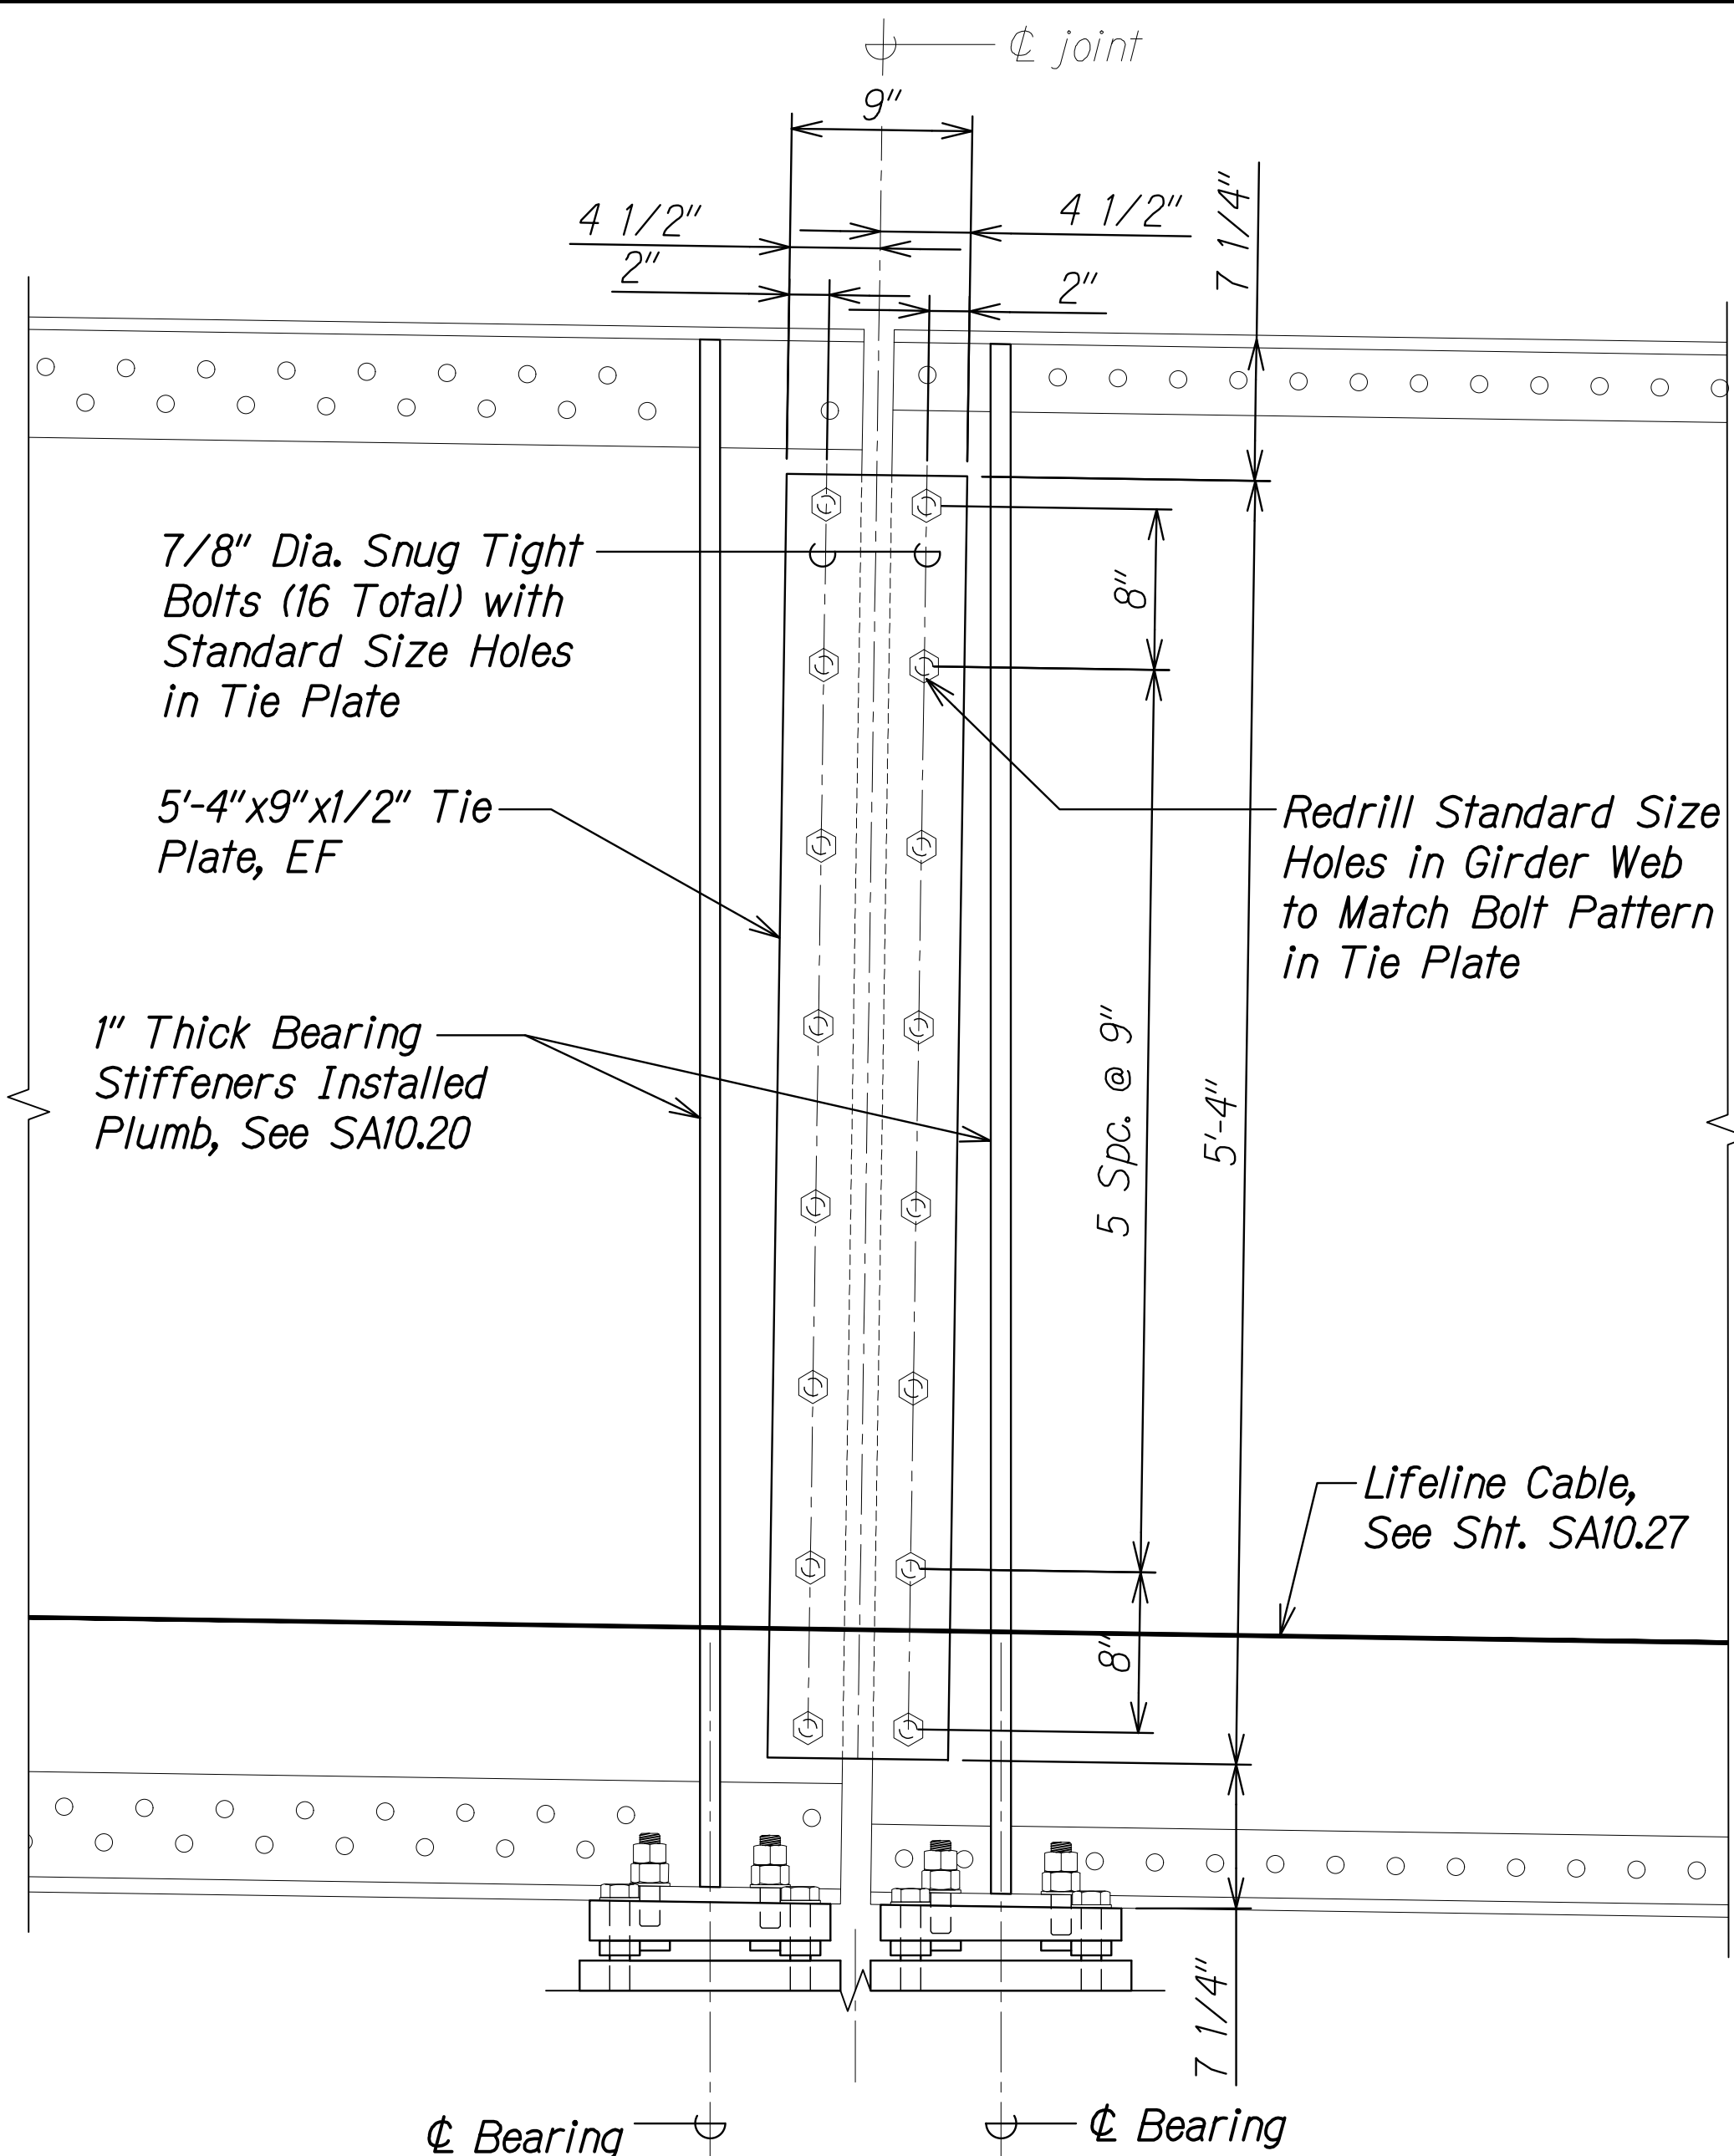


TIE PLATE ELEVATION - FIXED BEARING A
Scale: 1 1/2" = 1'-0" SA10.25 SA10.25

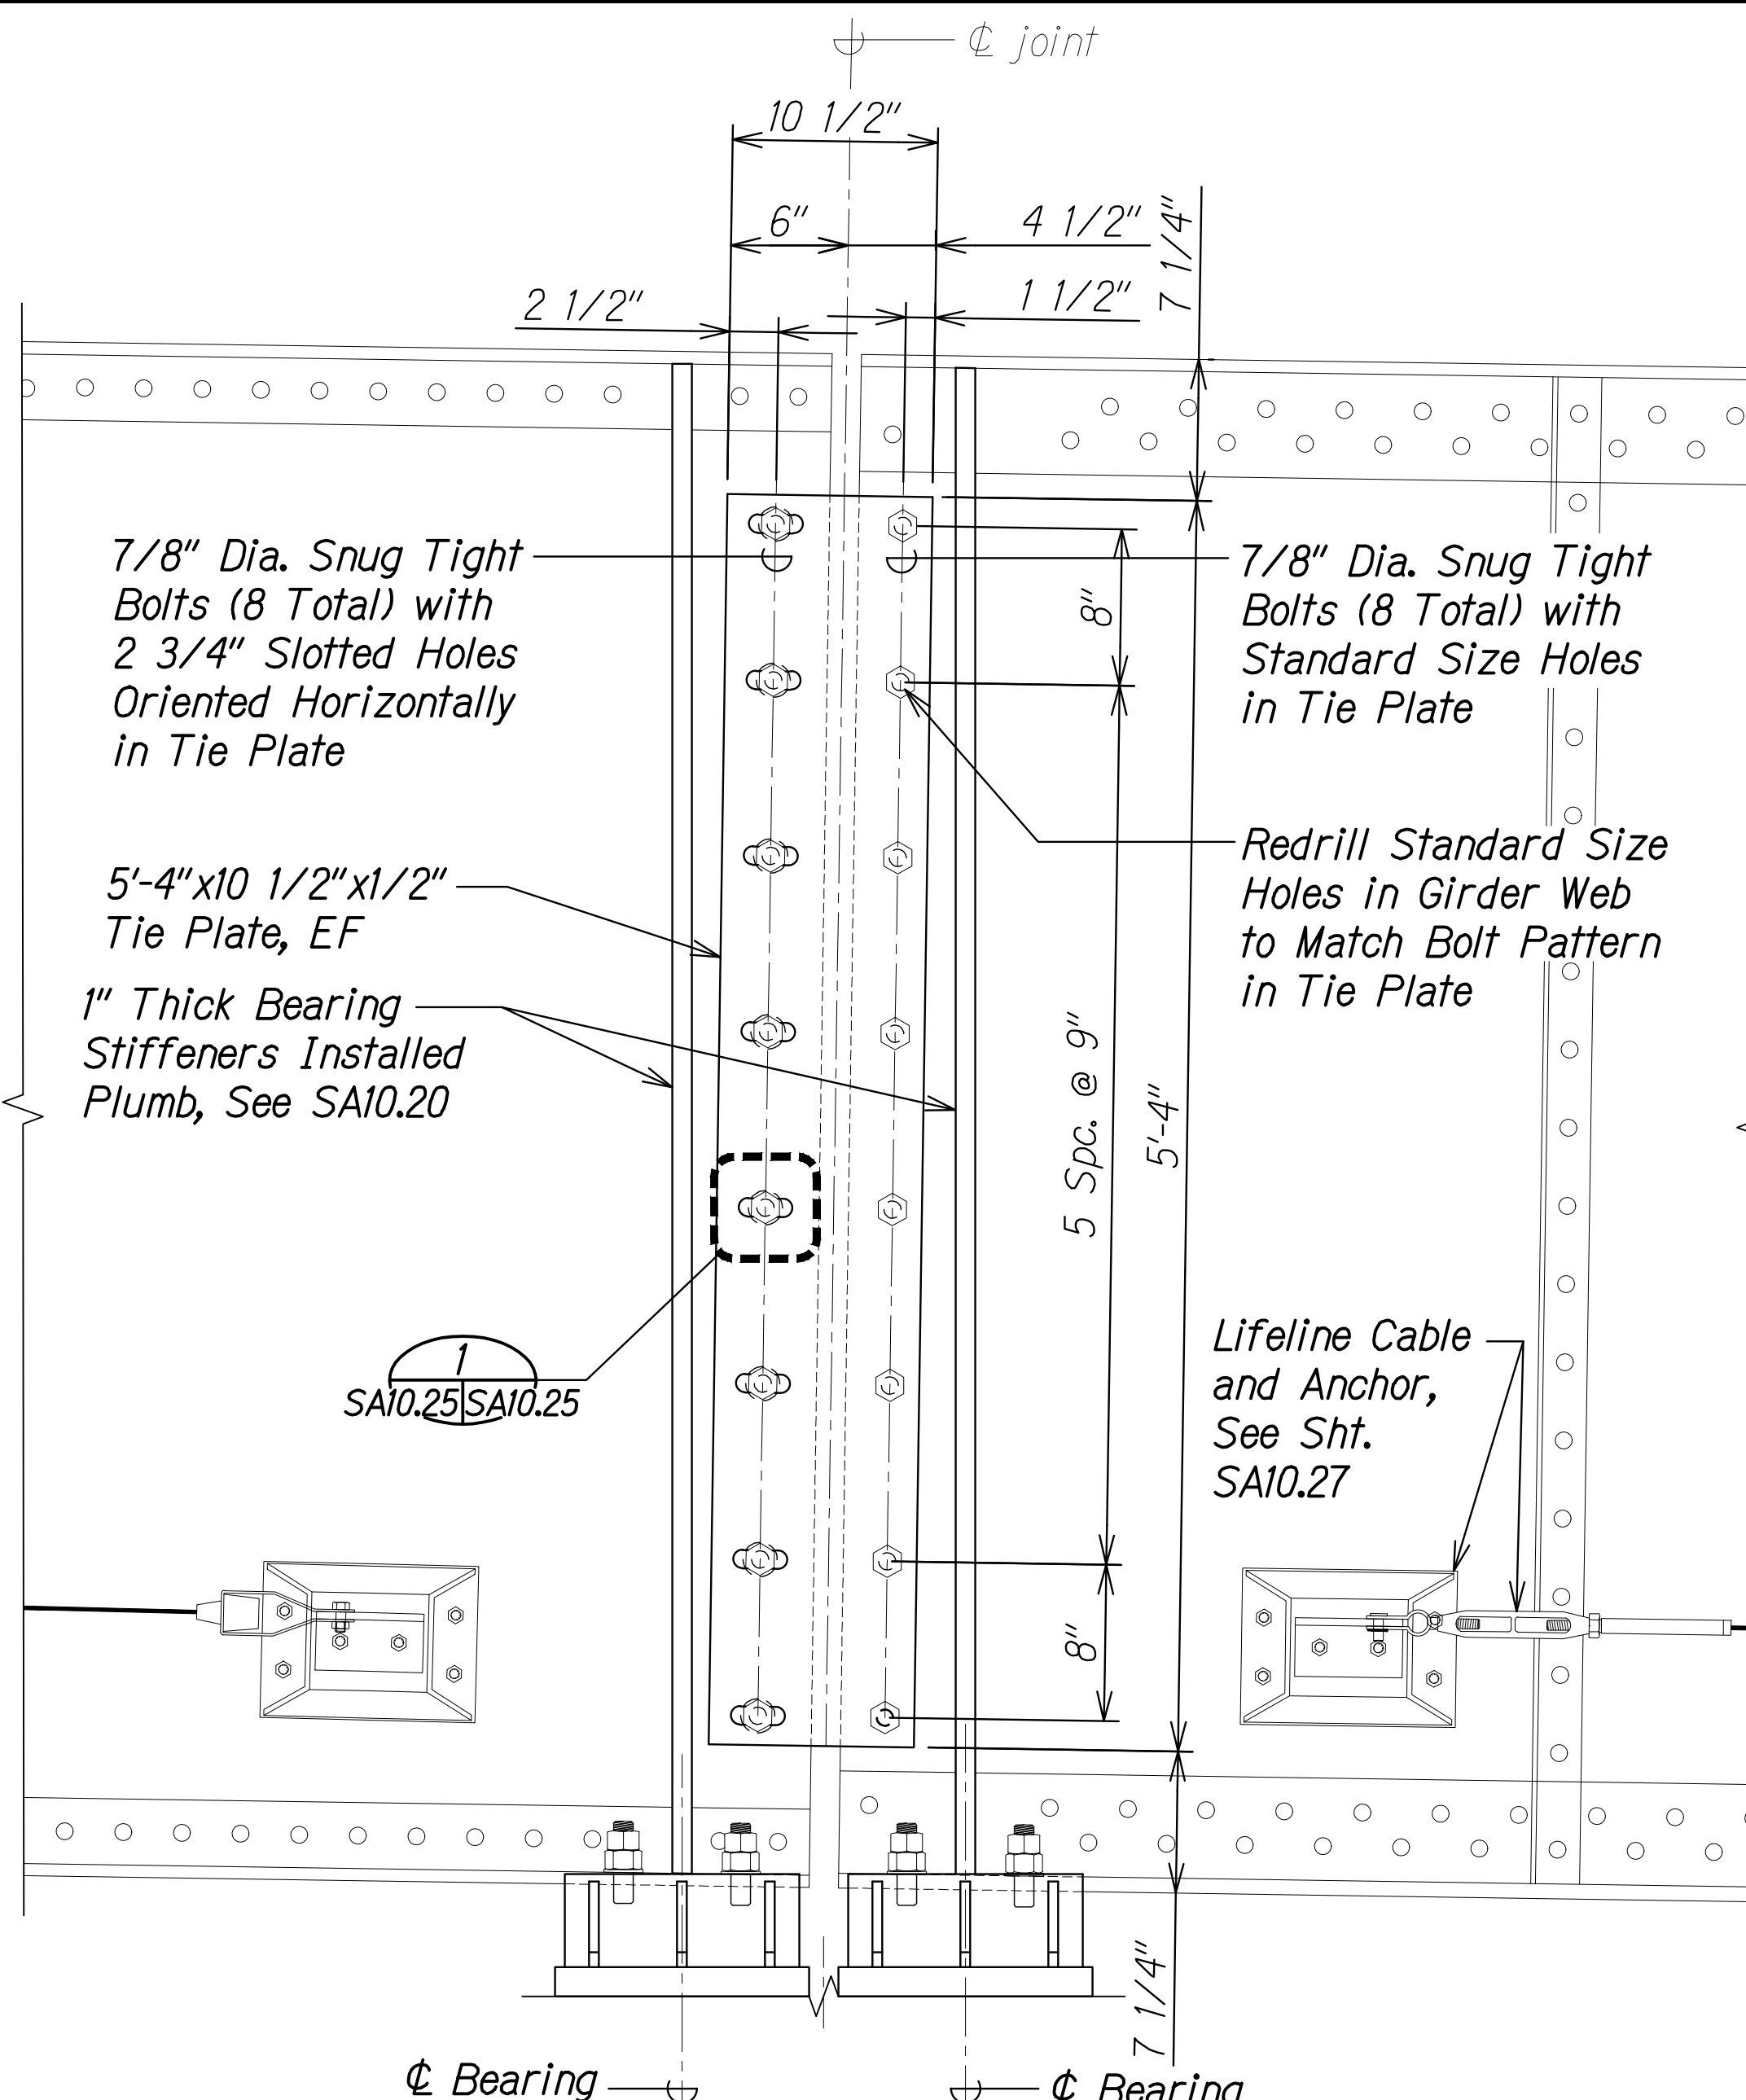


TIE PLATE ELEVATION - EXPANSION BEARING B
Scale: 1 1/2" = 1'-0" SA10.25 SA10.25

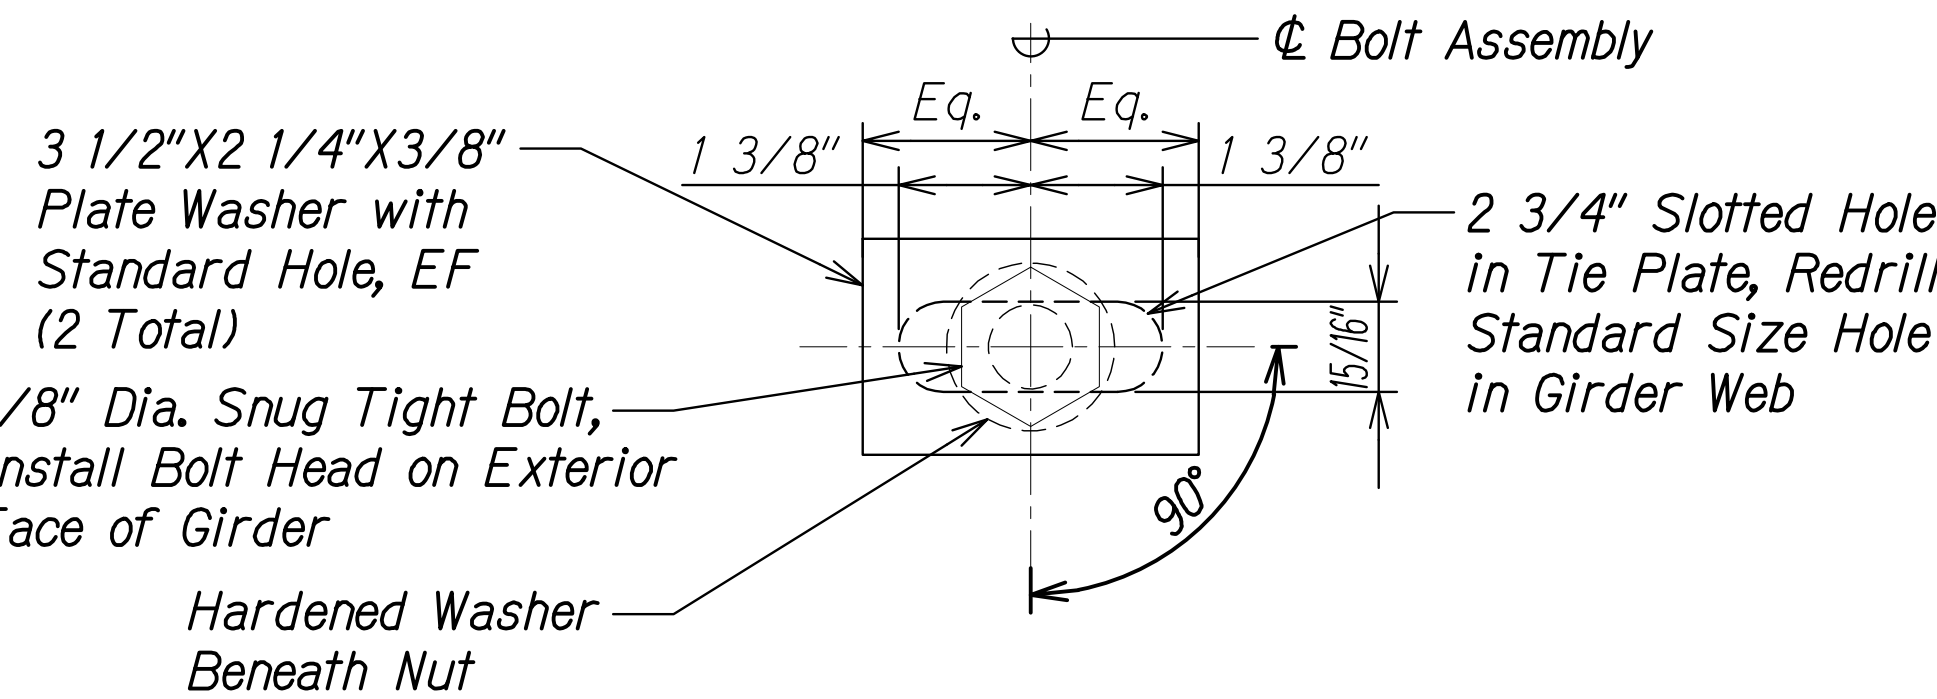

BOLT CONNECTION DETAIL AT SLOTTED HOLE 1
Scale: 6" = 1'-0" SA10.25 SA10.25

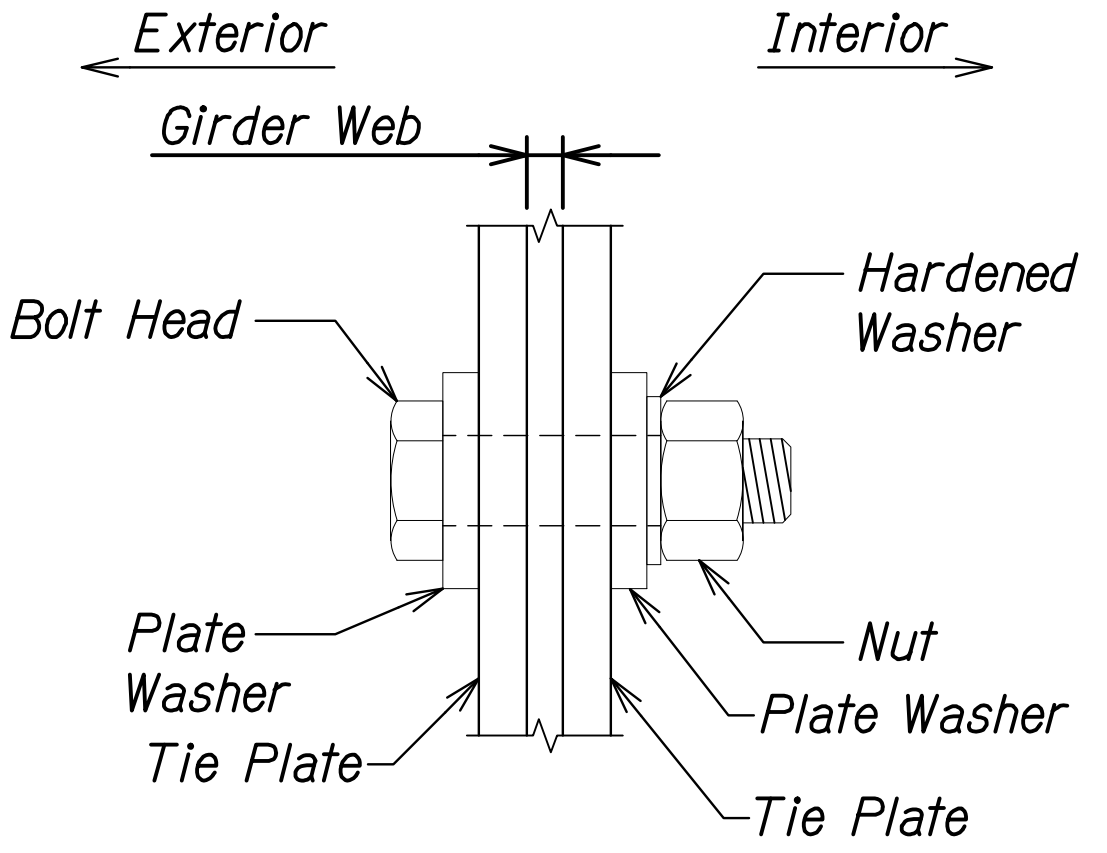

BOLT CONNECTION DETAIL AT SLOTTED HOLE 2
Scale: 6" = 1'-0" SA10.25 SA10.25

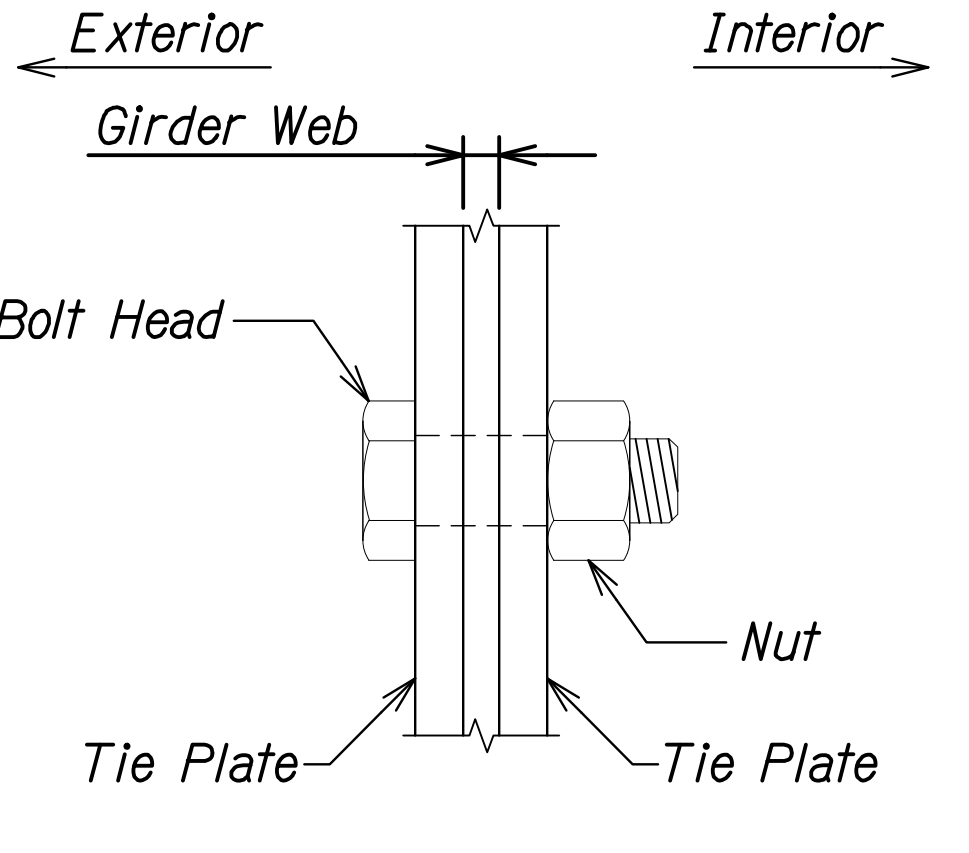


TYP. BOLT CONNECTION DETAIL 3
Scale: 6" = 1'-0" SA10.25 SA10.25

DATE	12-03-24
SURVEY PLOTTED BY	ADDX NSR-SA1025 TIE PLATE ADDX.DWG
DRAWN BY	ADDX NSR-SA1025 TIE PLATE ADDX.DWG
DESIGNED BY	ADDX NSR-SA1025 TIE PLATE ADDX.DWG
QUANTITIES BY	ADDX NSR-SA1025 TIE PLATE ADDX.DWG
CHECKED BY	ADDX NSR-SA1025 TIE PLATE ADDX.DWG


DRAWING NAME: Z:\00 ONGOING\23-022-9-NANUE STR BR PF2-DOT\A.01 CAD\12-06-24 ADDX NSR-SA1025 TIE PLATE ADDX.DWG PLOT TIME: 12-03-24 11:04 PM

FED. ROAD DIST. NO.	STATE	FEDERAL AID PROJ. NO.	FISCAL YEAR	SHEET NO.	TOTAL SHEETS
HAWAII	HAW.	BR-019-2(077)	2024	ADD. 212	280

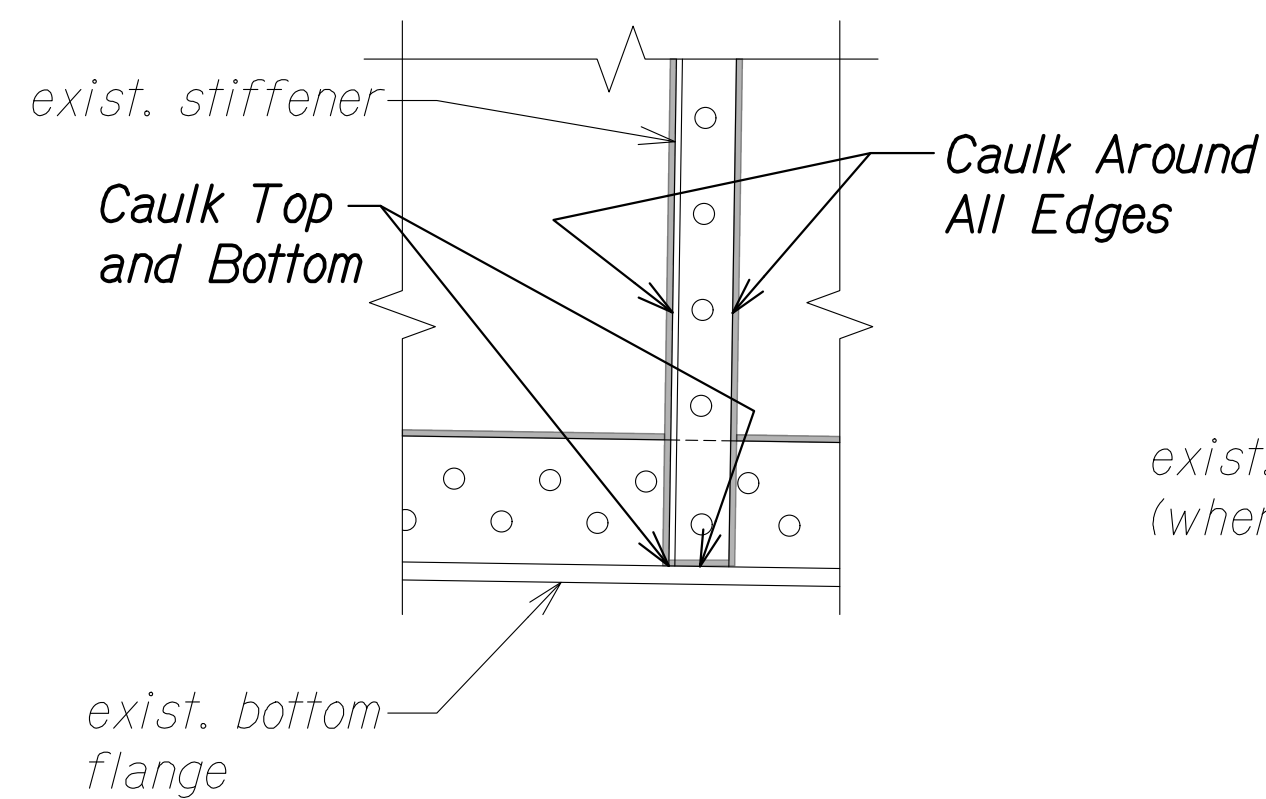



STIFFENER CONNECTION

Scale: 1 1/2" = 1'-0"

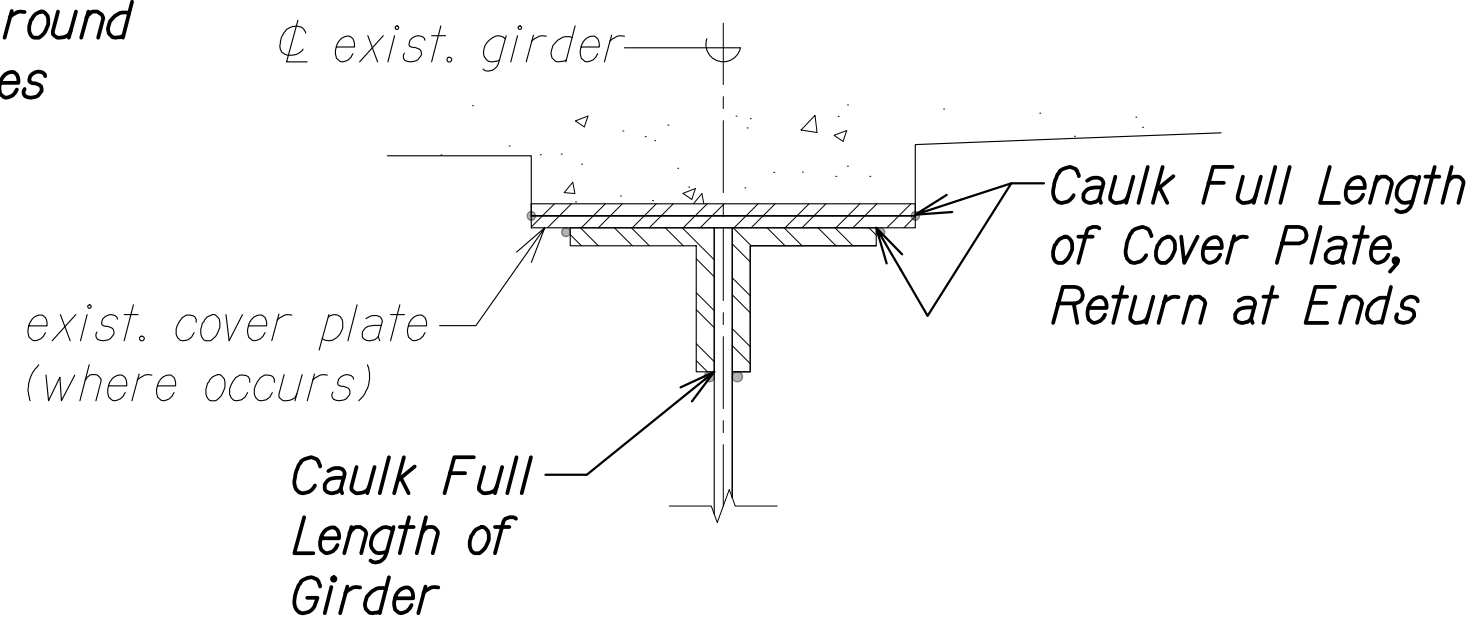


TOP FLANGE CONNECTION

Scale: 1 1/2" = 1'-0"

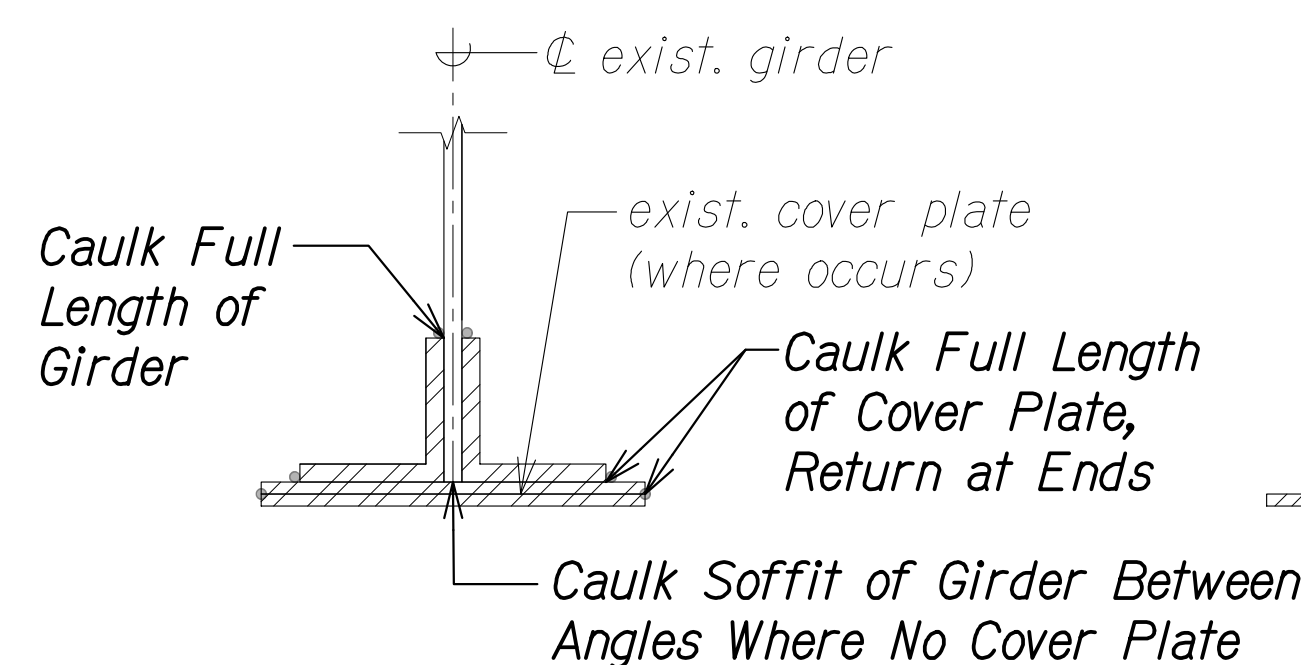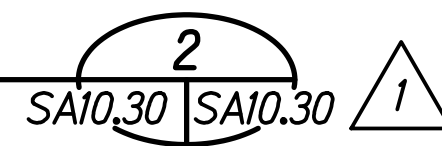



BOTTOM FLANGE CONNECTION

Scale: 1 1/2" = 1'-0"

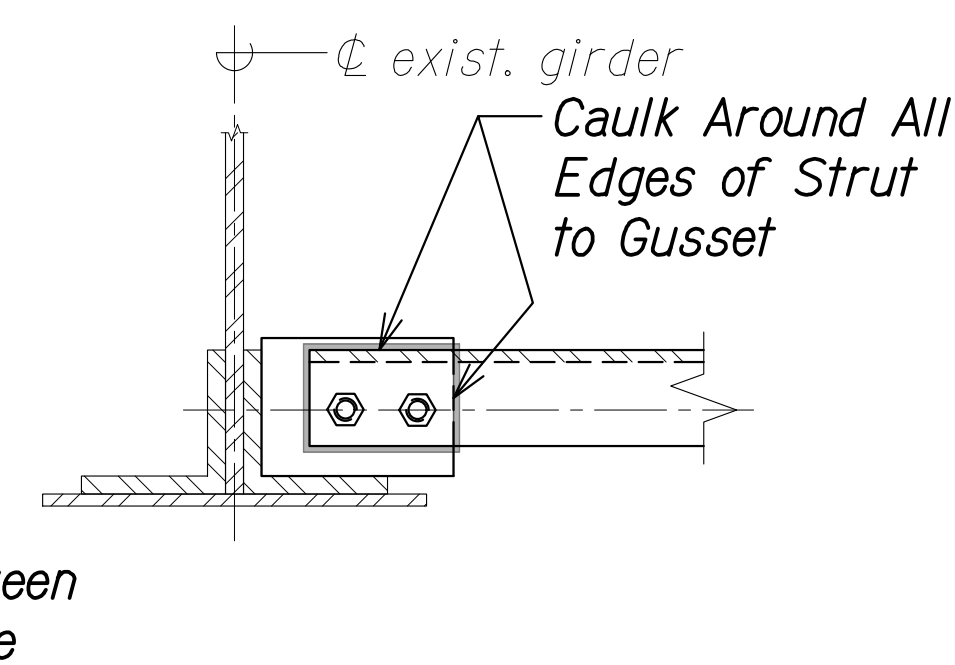



STRUT CONNECTION

Scale: 1 1/2" = 1'-0"

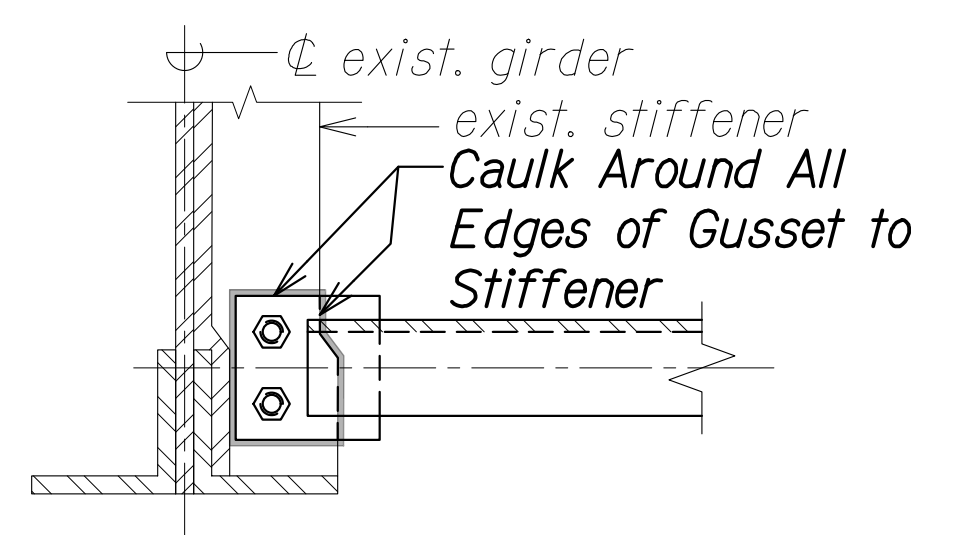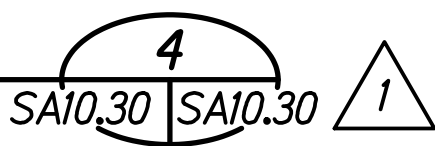



STRUT CONNECTION

Scale: 1 1/2" = 1'-0"

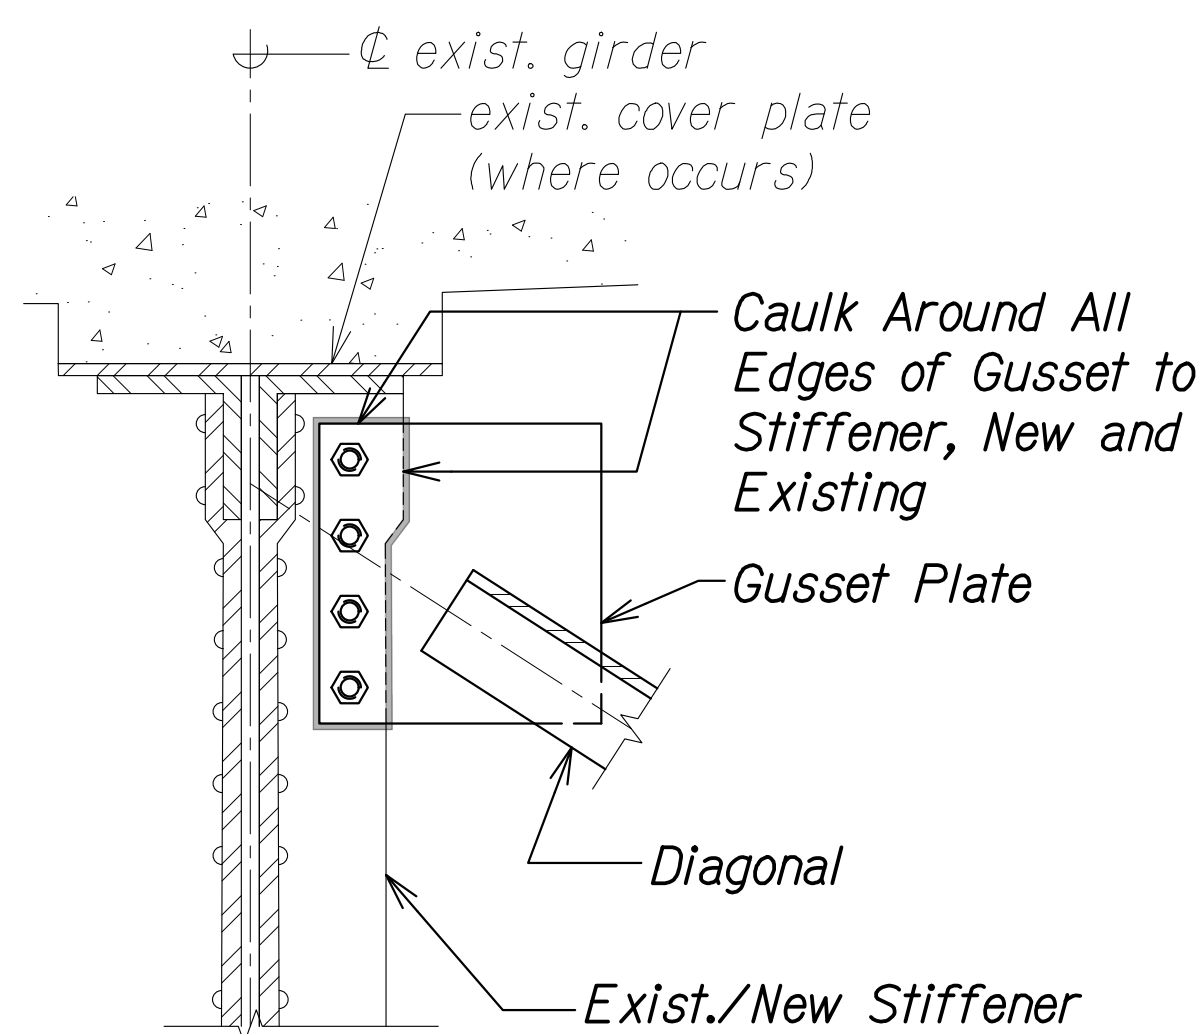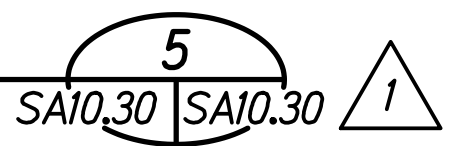


CROSS-FRAME CONNECTION

Scale: 1 1/2" = 1'-0"

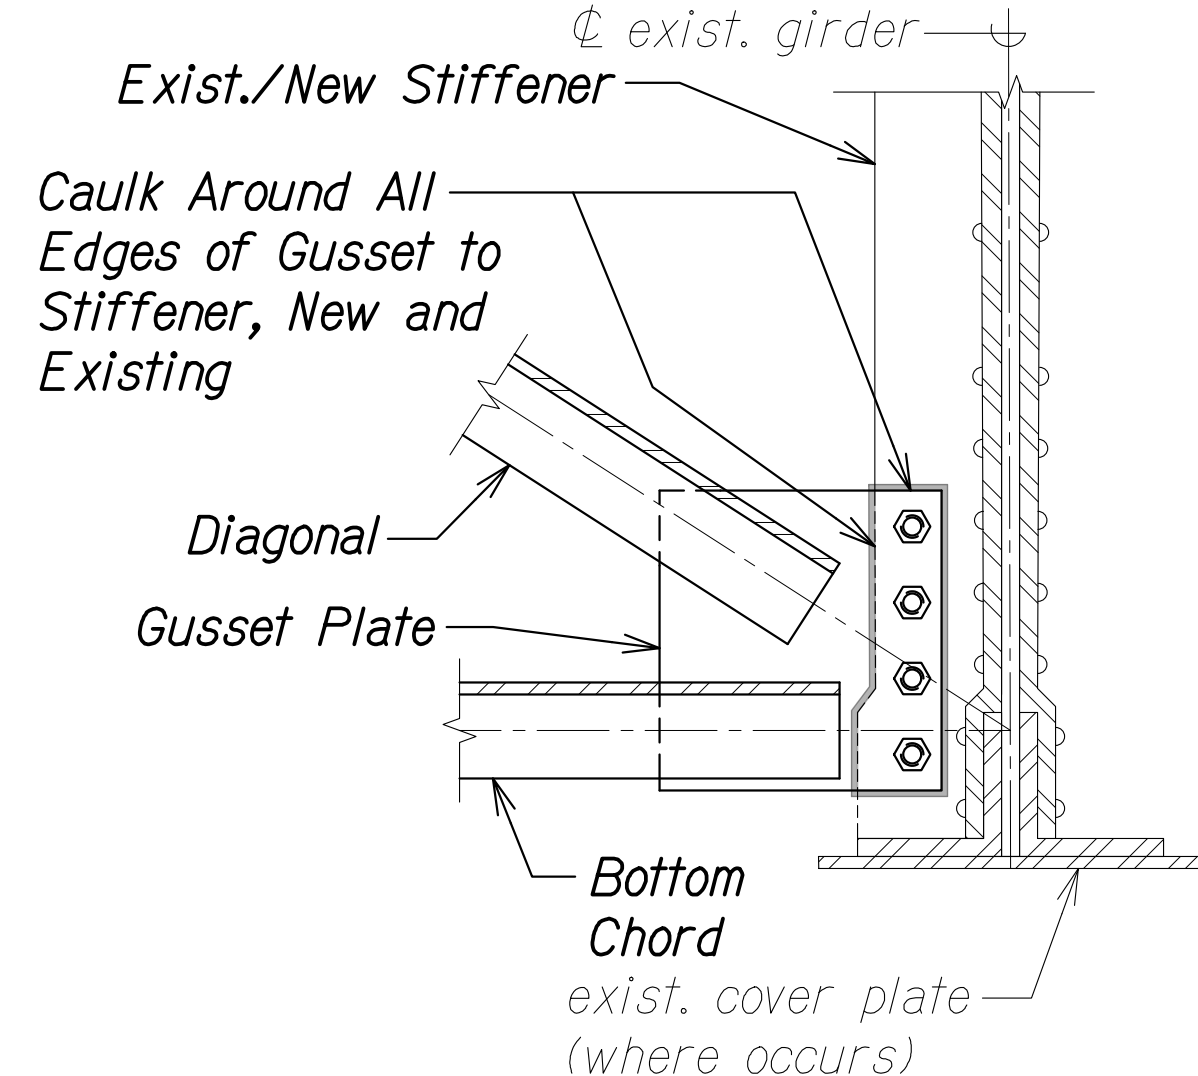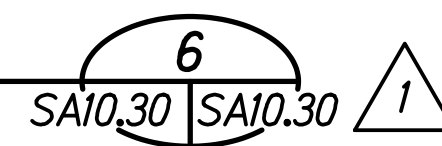

CROSS-FRAME CONNECTION

Scale: 1 1/2" = 1'-0"

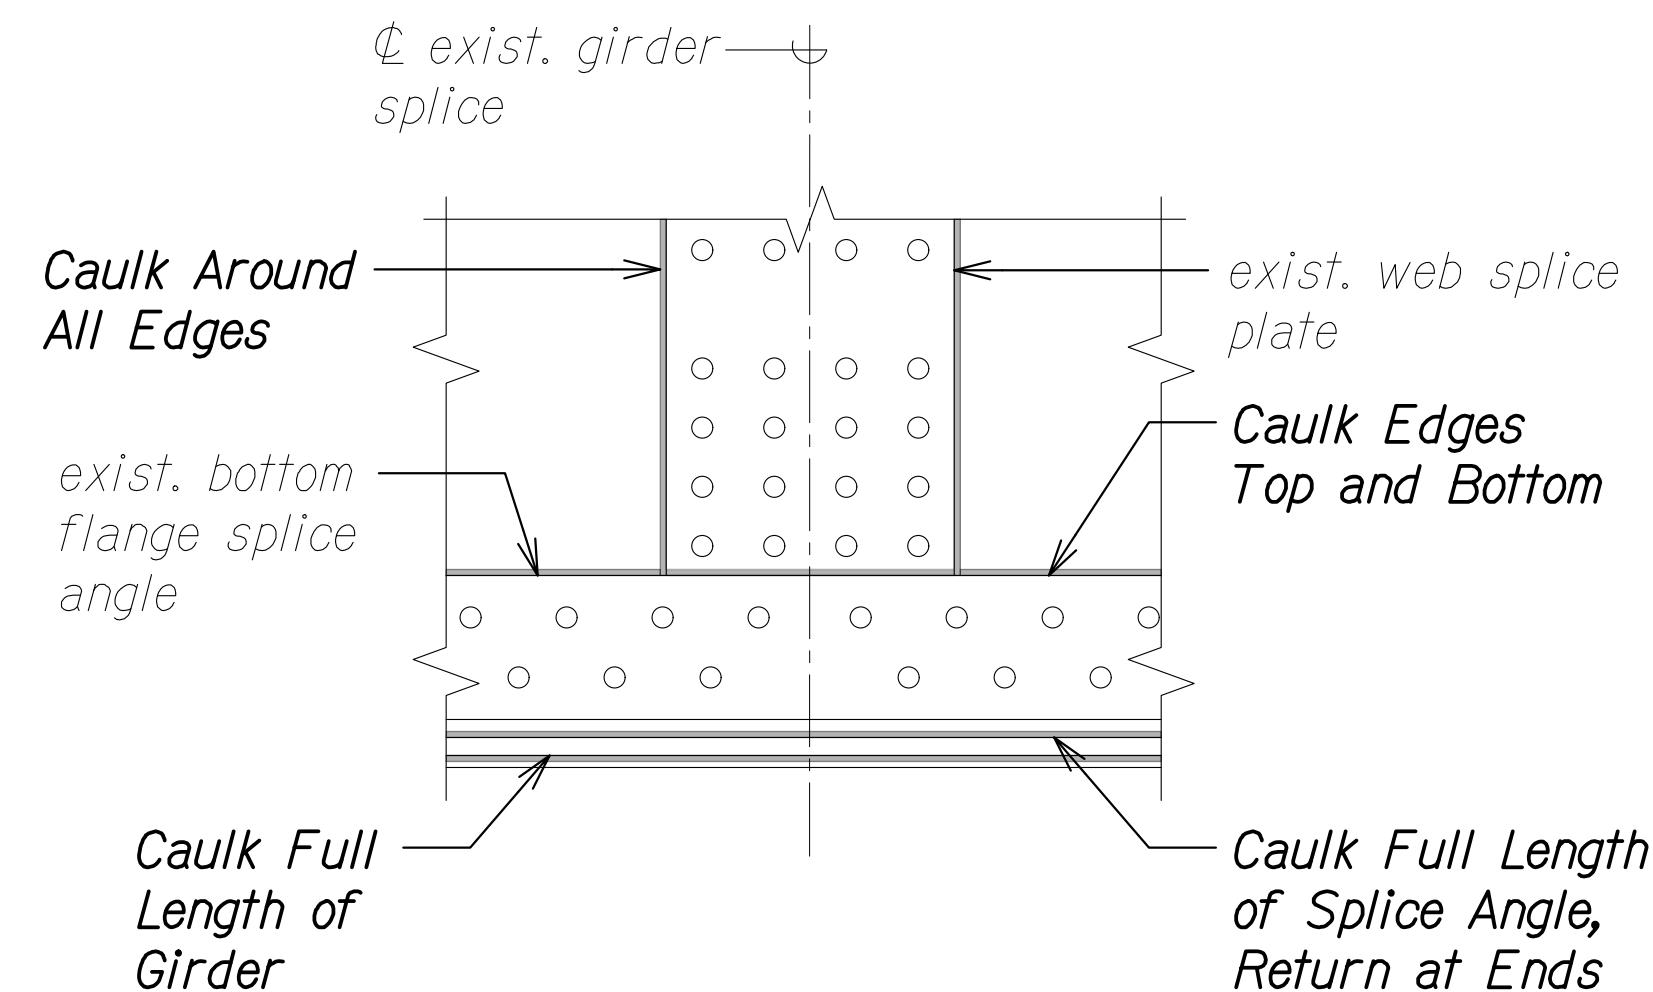

GIRDER SPLICE CONNECTION

Scale: 1 1/2" = 1'-0"




NOTES:

1. All details are shown as typical and shall be applied at all locations throughout the bridge.
2. Caulk shall be applied after applicable dry-to recoat time of the epoxy mist coat, as described in its product data sheet.
3. The cost for caulking shall be covered under Pay Item 666.3000.

ORIGINAL PLAN	SURVEY PLOTTED BY	DATE
NOTE BOOK	DRAWN BY	
No.	DESIGNED BY	
	QUANTITIES BY	
	CHECKED BY	

DRAWING NAME: Z:\00 ONGOING\23-022.9-NANUE STR BR PF2-DOT1\01 CAD\12-06-24 ADD\NSR-SA1030 PAINT ADD2.DWG PLOT TIME: 12-05-24 3:37 PM

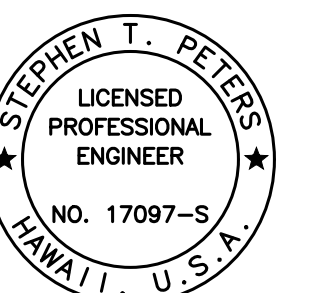

THIS WORK WAS PREPARED BY ME OR UNDER MY SUPERVISION.

SIGNATURE: *Stephen T. Peters* EXPIRATION DATE OF THE LICENSE: 4-30-26

STATE OF HAWAII
DEPARTMENT OF TRANSPORTATION
HIGHWAYS DIVISION

PAINT/CAULKING DETAILS

HAWAII BELT ROAD
Nanue Stream Bridge Rehabilitation
Federal Aid Project No. BR-019-2(077)
Scale: As Noted Date: Oct. 2024

12/6/24	1	Added Detail and Revised Details & Notes
DATE	REVISION	

SHEET NoSA10.30 OF 30 SHEETS

ADD. 212