



| FED. ROAD DIST. NO. | STATE | PROJ. NO.          | FISCAL YEAR | SHEET NO. | TOTAL SHEETS |
|---------------------|-------|--------------------|-------------|-----------|--------------|
| HAWAII              | HAW.  | 105H-02-71 Unit II | 1979        | 33        | 38           |

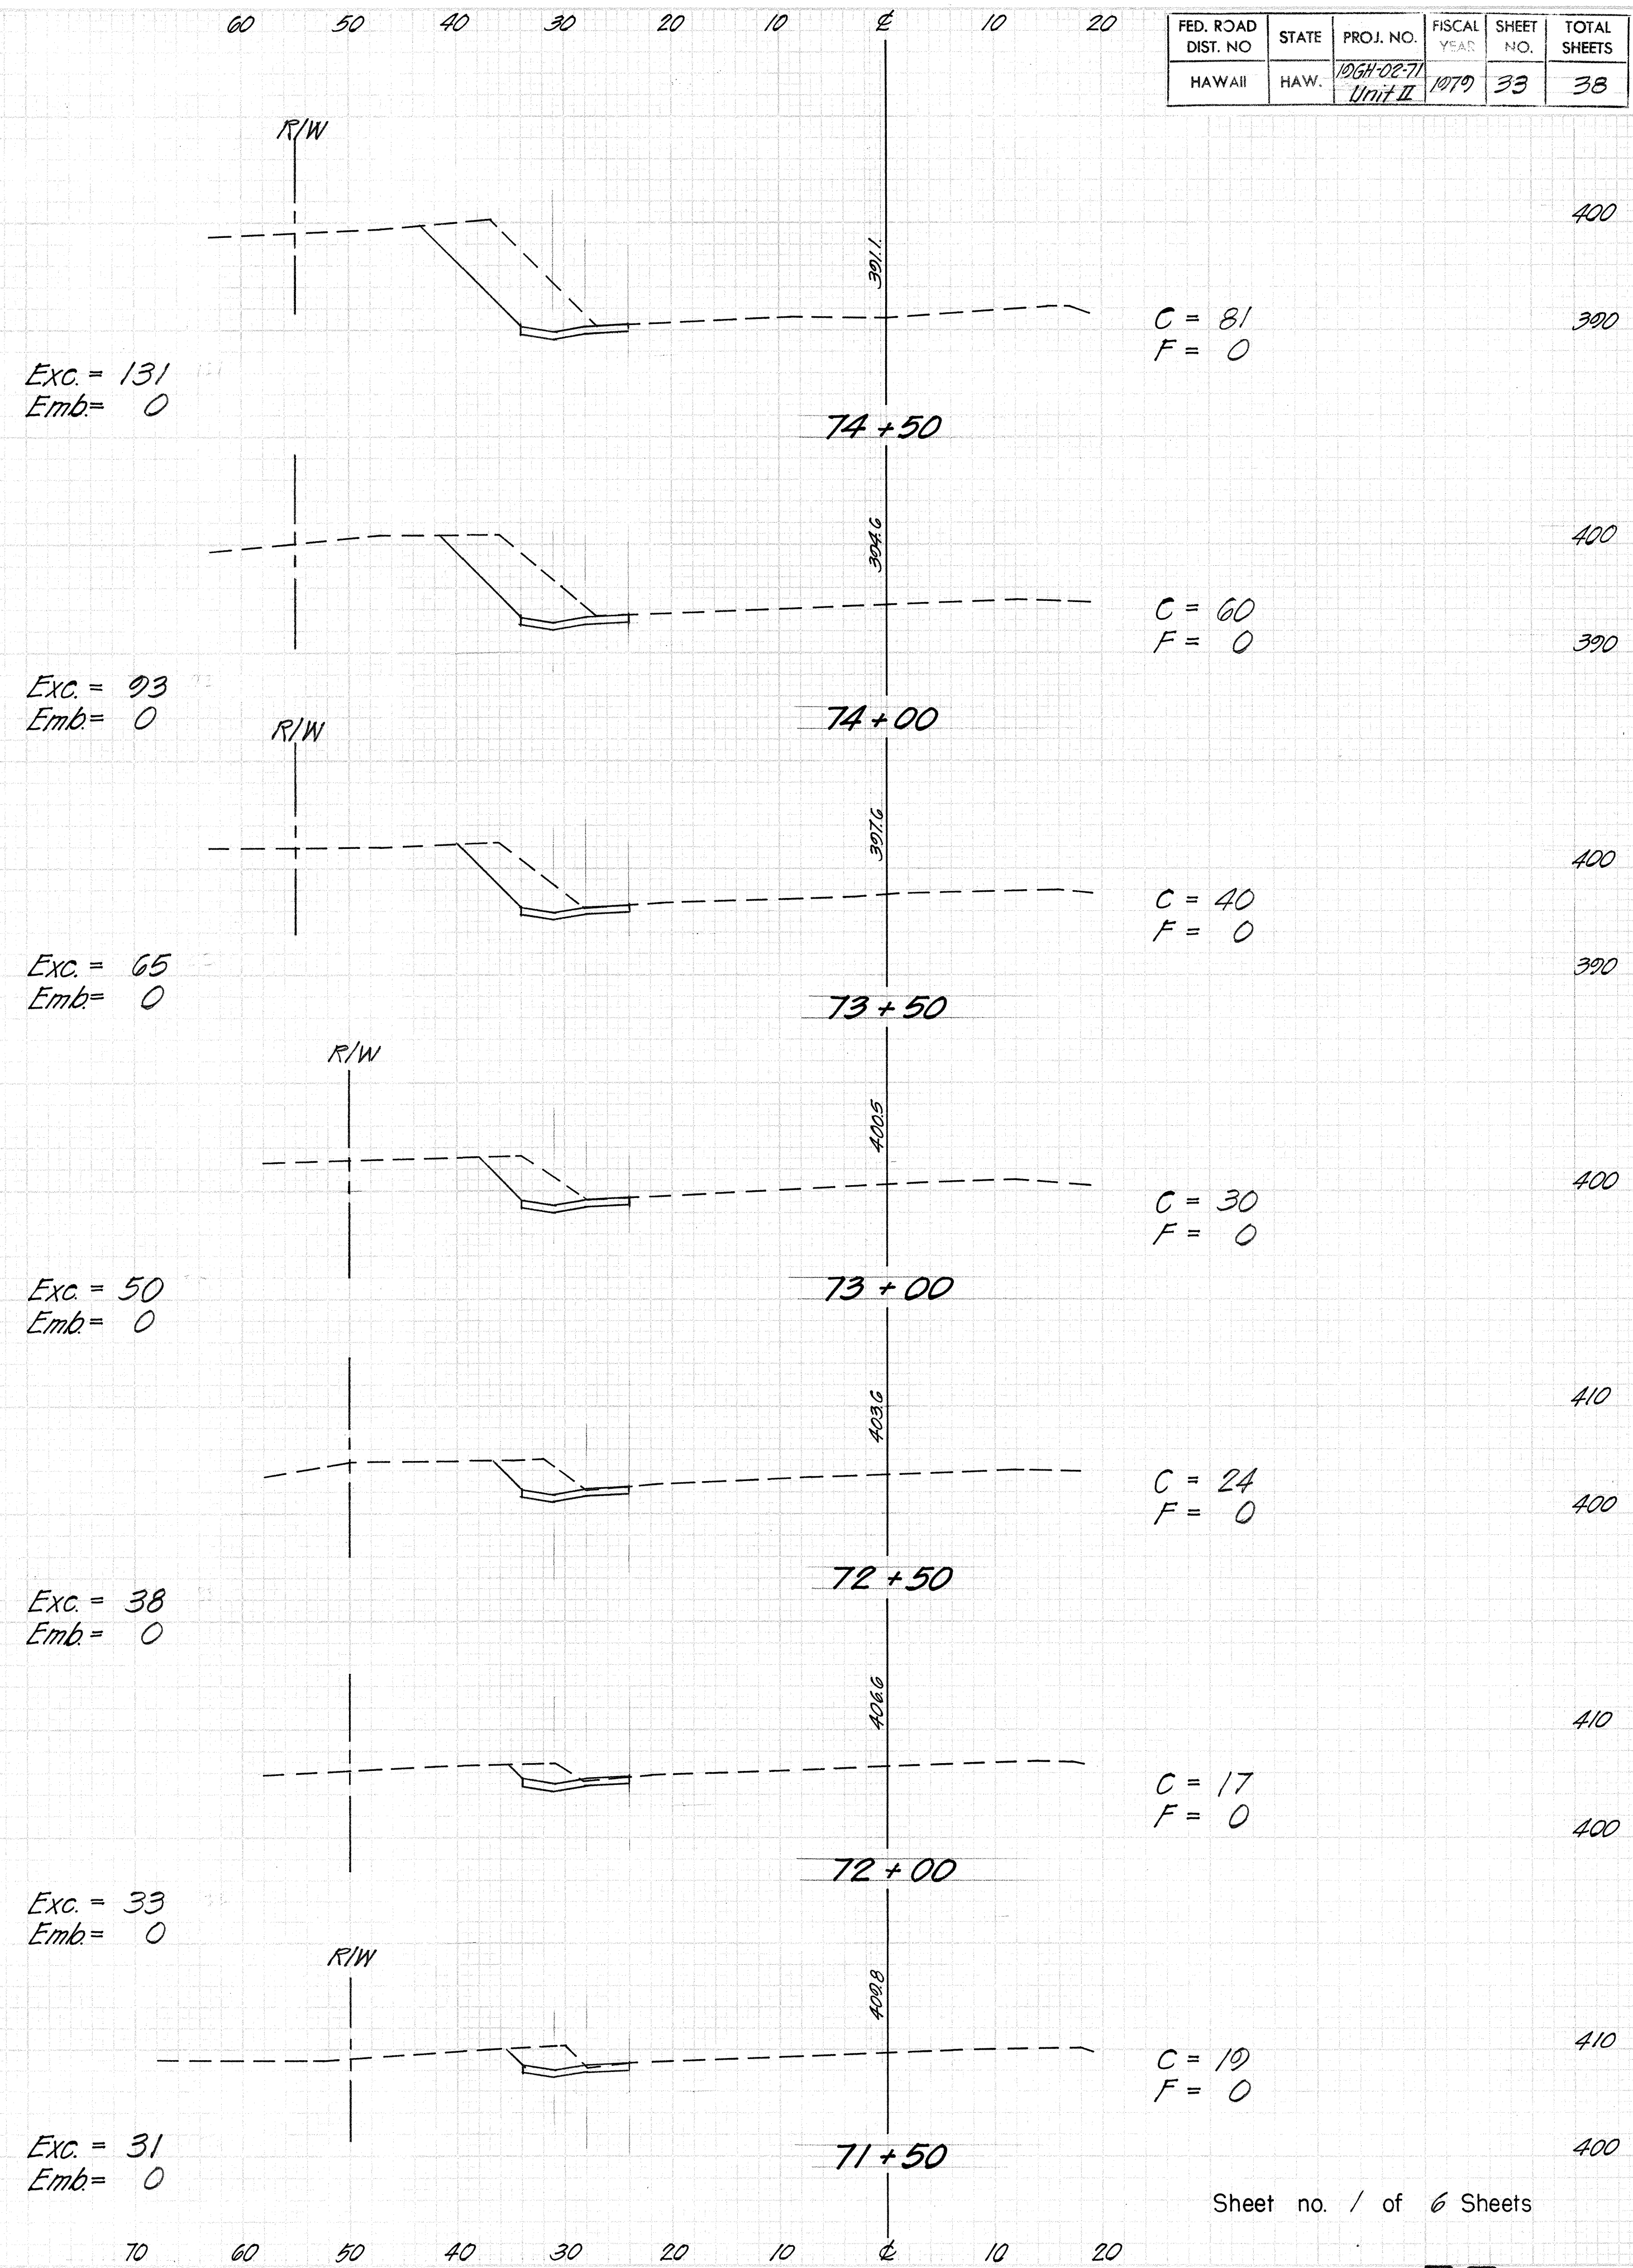


Sheet no. / of 6 Sheets

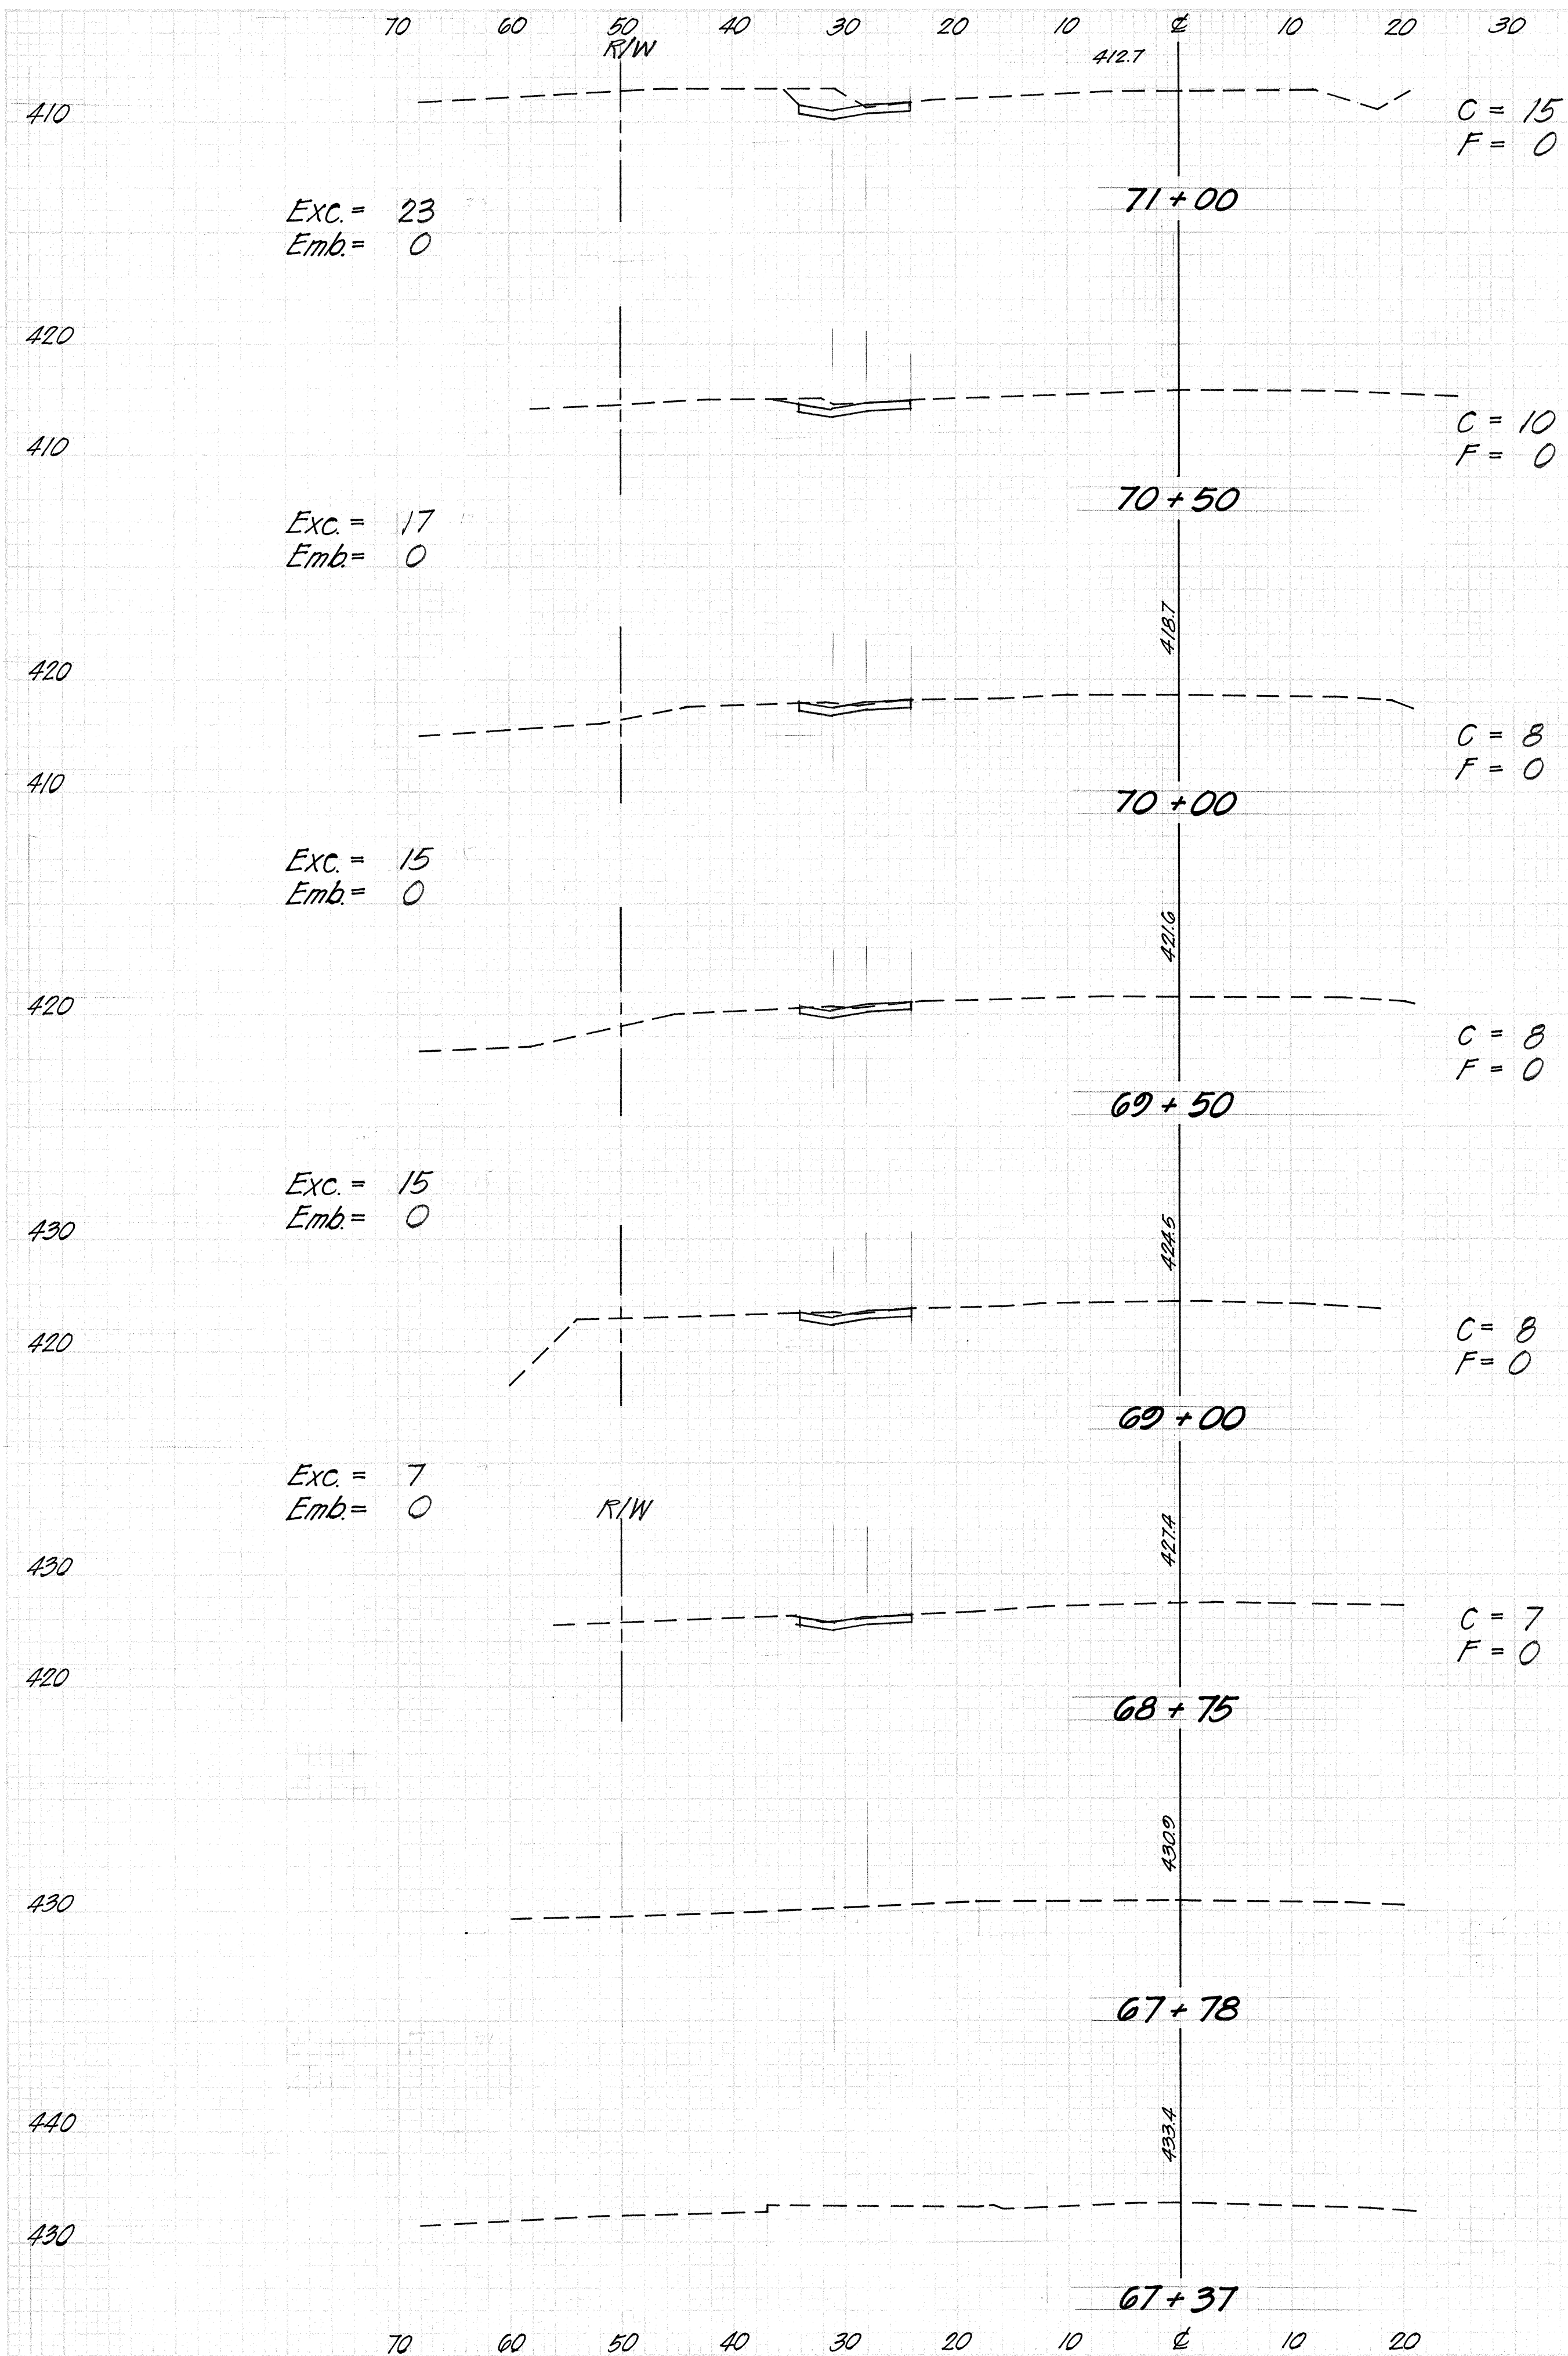

| FED. ROAD DIST. NO. | STATE | PROJ. NO.          | FISCAL YEAR | SHEET NO. | TOTAL SHEETS |
|---------------------|-------|--------------------|-------------|-----------|--------------|
| HAWAII              | HAW.  | 1964-02-71 Unit II | 1979        | 34        | 38           |

FINAL SURVEY  
BY: [ ]  
DATE: [ ]  
REVISIONS: [ ]  
NOTES: [ ]  
AREAS: [ ]  
CHECKED: [ ]

ORIGINAL SURVEY  
BY: [ ]  
DATE: [ ]  
REVISIONS: [ ]  
NOTES: [ ]  
AREAS: [ ]  
CHECKED: [ ]

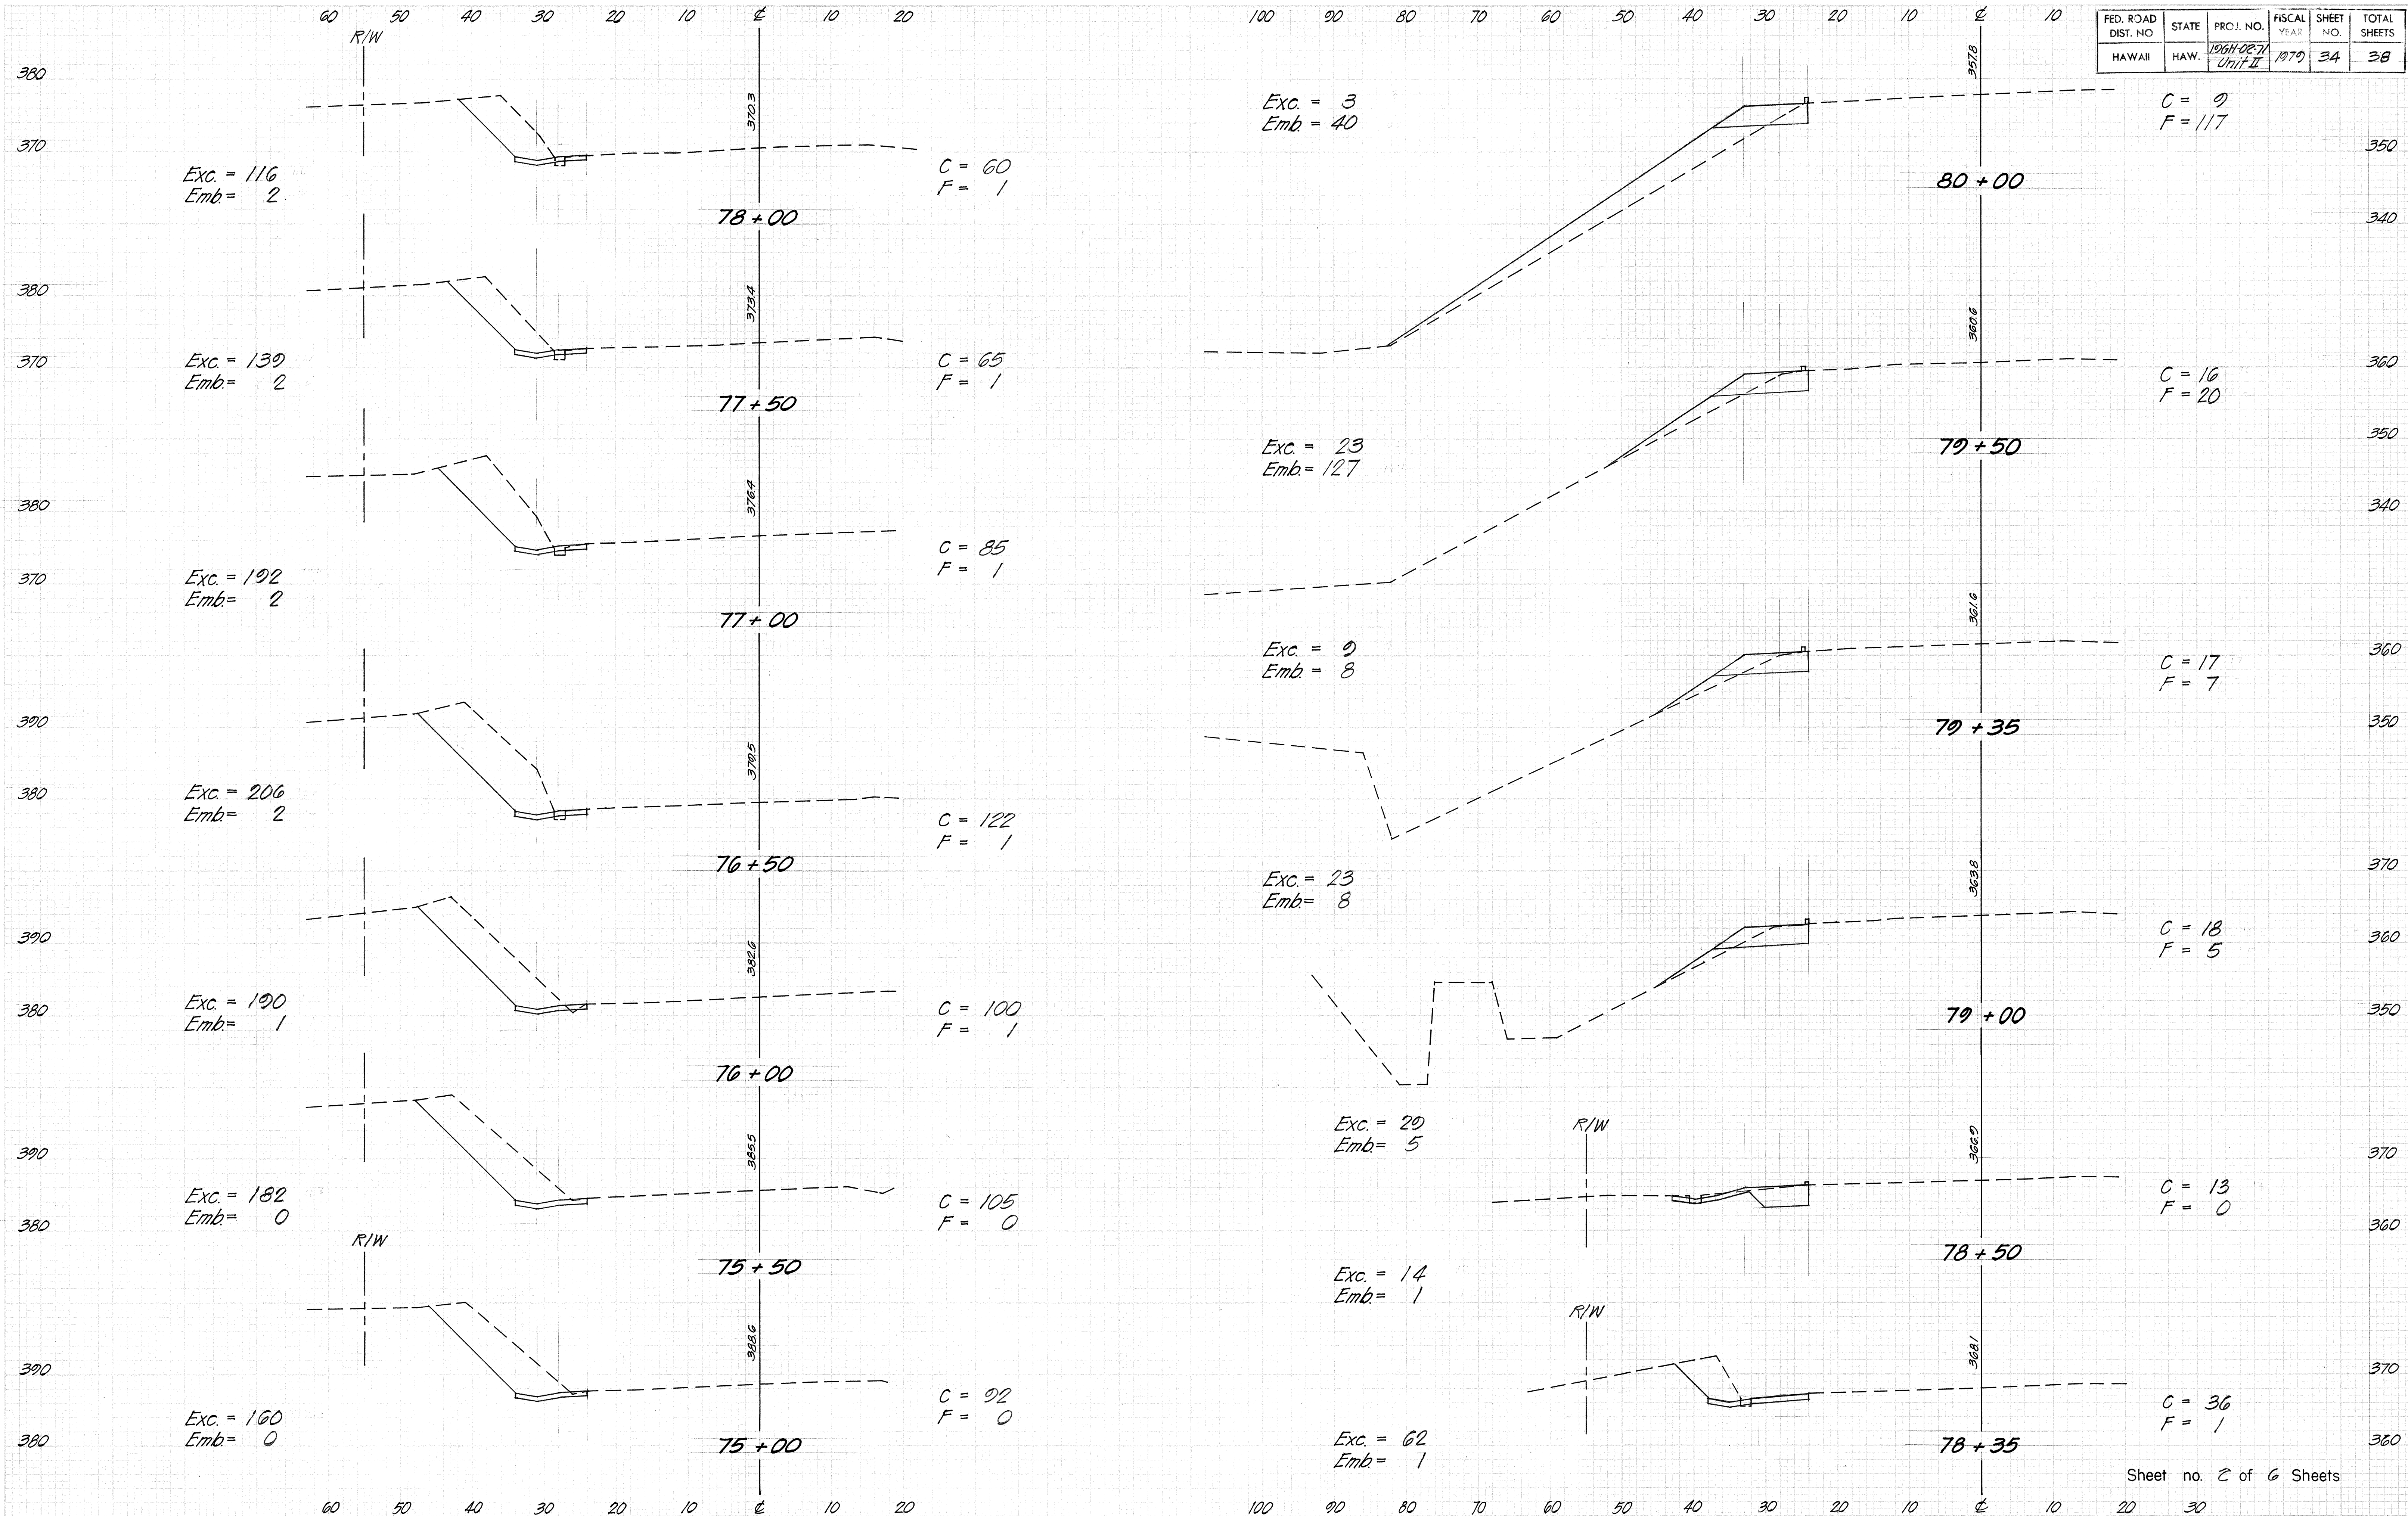


Sheet no. 2 of 6 Sheets




|            |             |
|------------|-------------|
| DATE       | BY          |
| DESIGNED   | CHECKED     |
| SURVEY     | PLANNED     |
| ROUTE WORK | TEMPERATURE |
| AREAS      | AREAS       |
| NO.        | NO.         |

|            |             |
|------------|-------------|
| DATE       | BY          |
| DESIGNED   | CHECKED     |
| SURVEY     | PLANNED     |
| ROUTE WORK | TEMPERATURE |
| AREAS      | AREAS       |
| NO.        | NO.         |

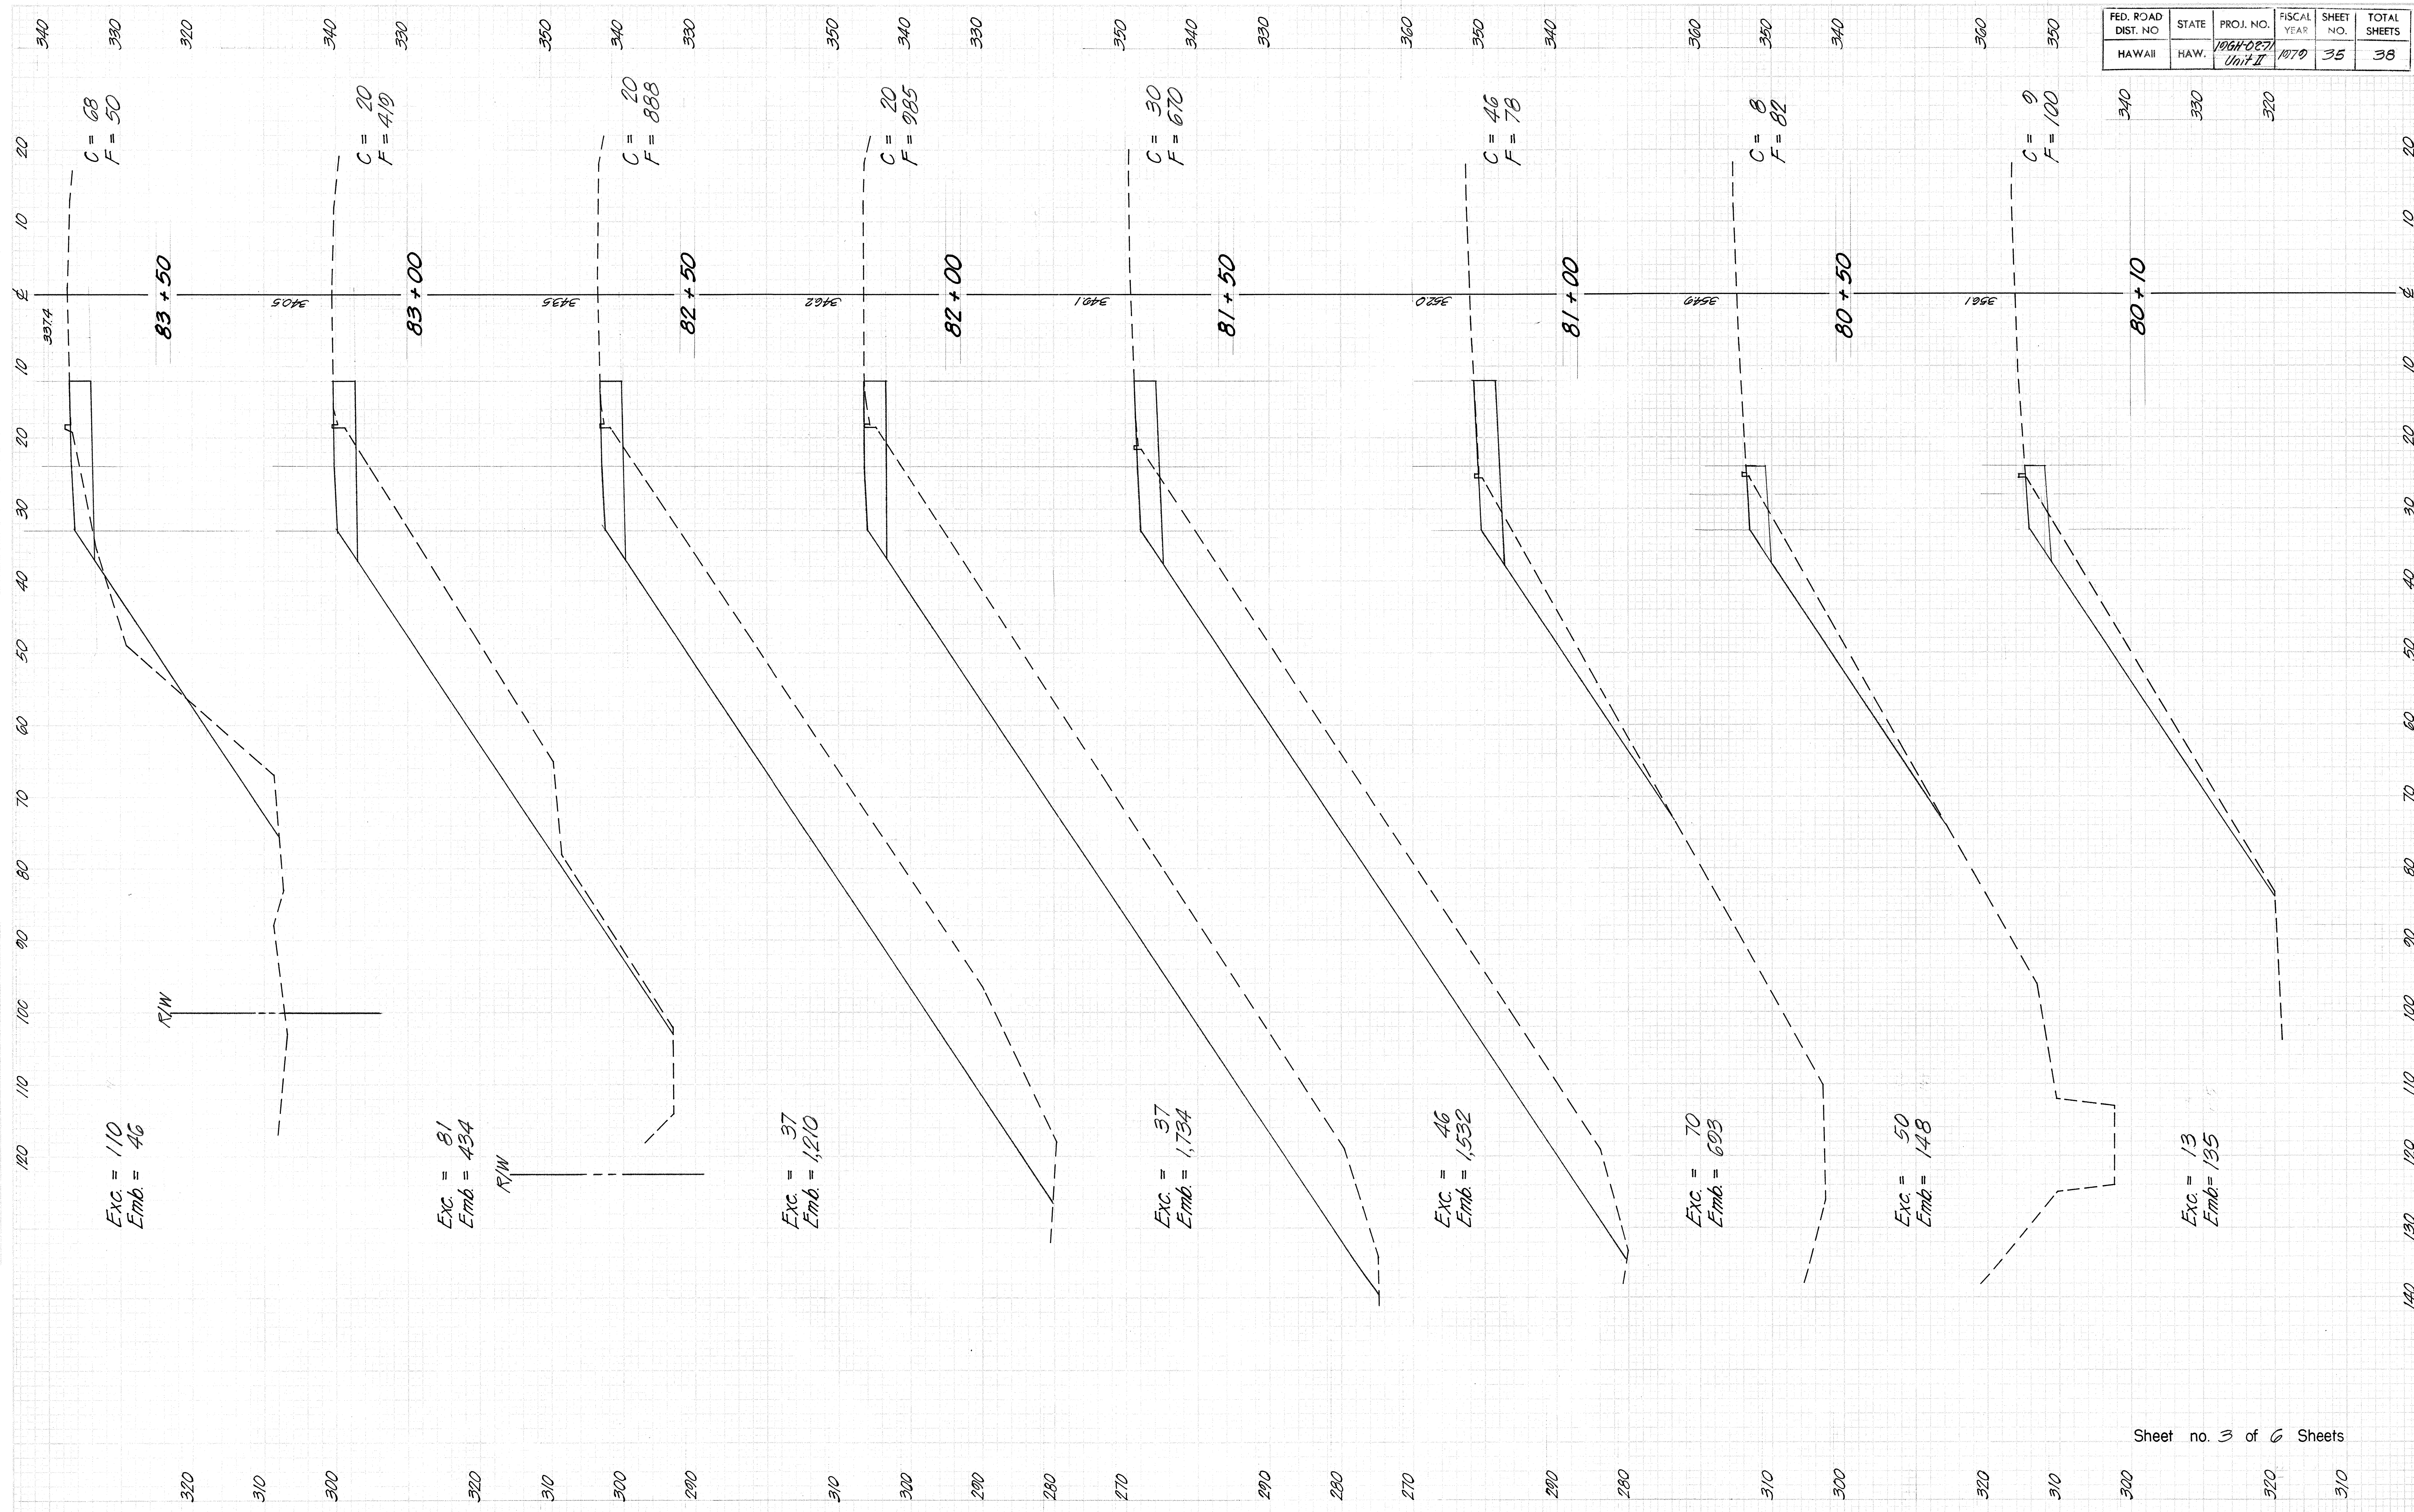




| FED. ROAD DIST. NO. | STATE | PROJ. NO.          | FISCAL YEAR | SHEET NO. | TOTAL SHEETS |
|---------------------|-------|--------------------|-------------|-----------|--------------|
| HAWAII              | HAW.  | 1964-02-27 Unit II | 1979        | 36        | 38           |

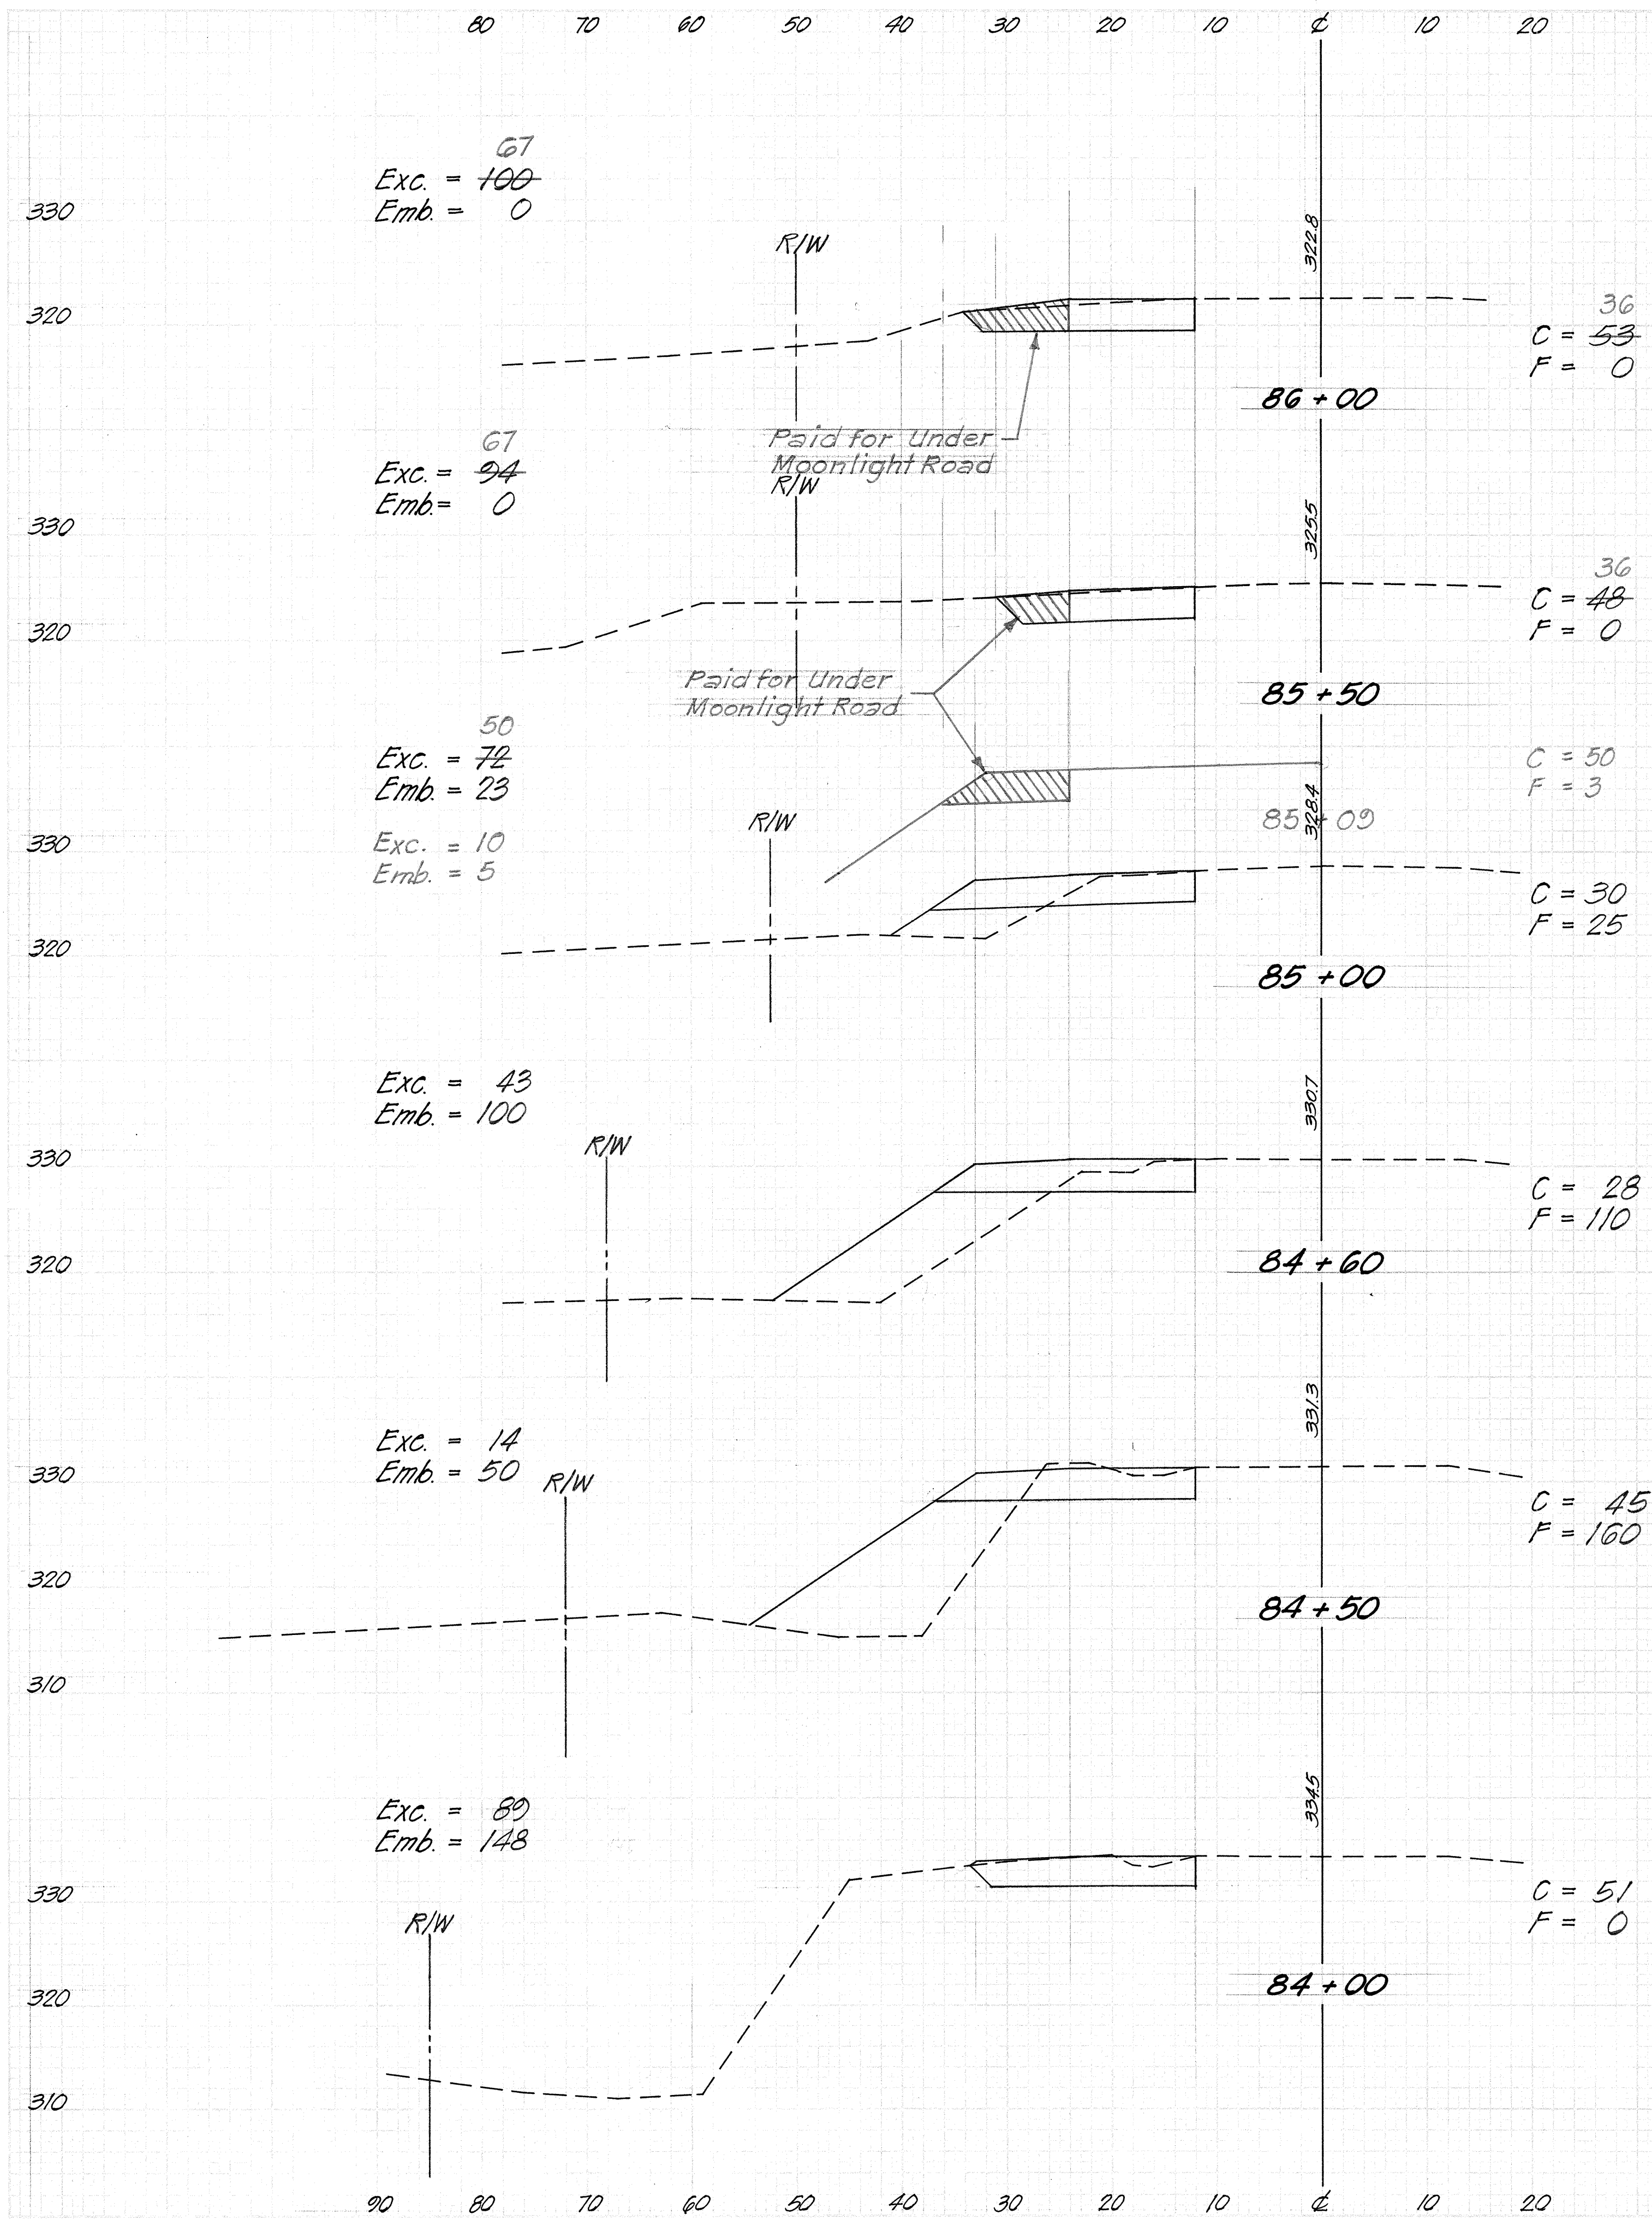



Exc. = 46  
Emb. = 265

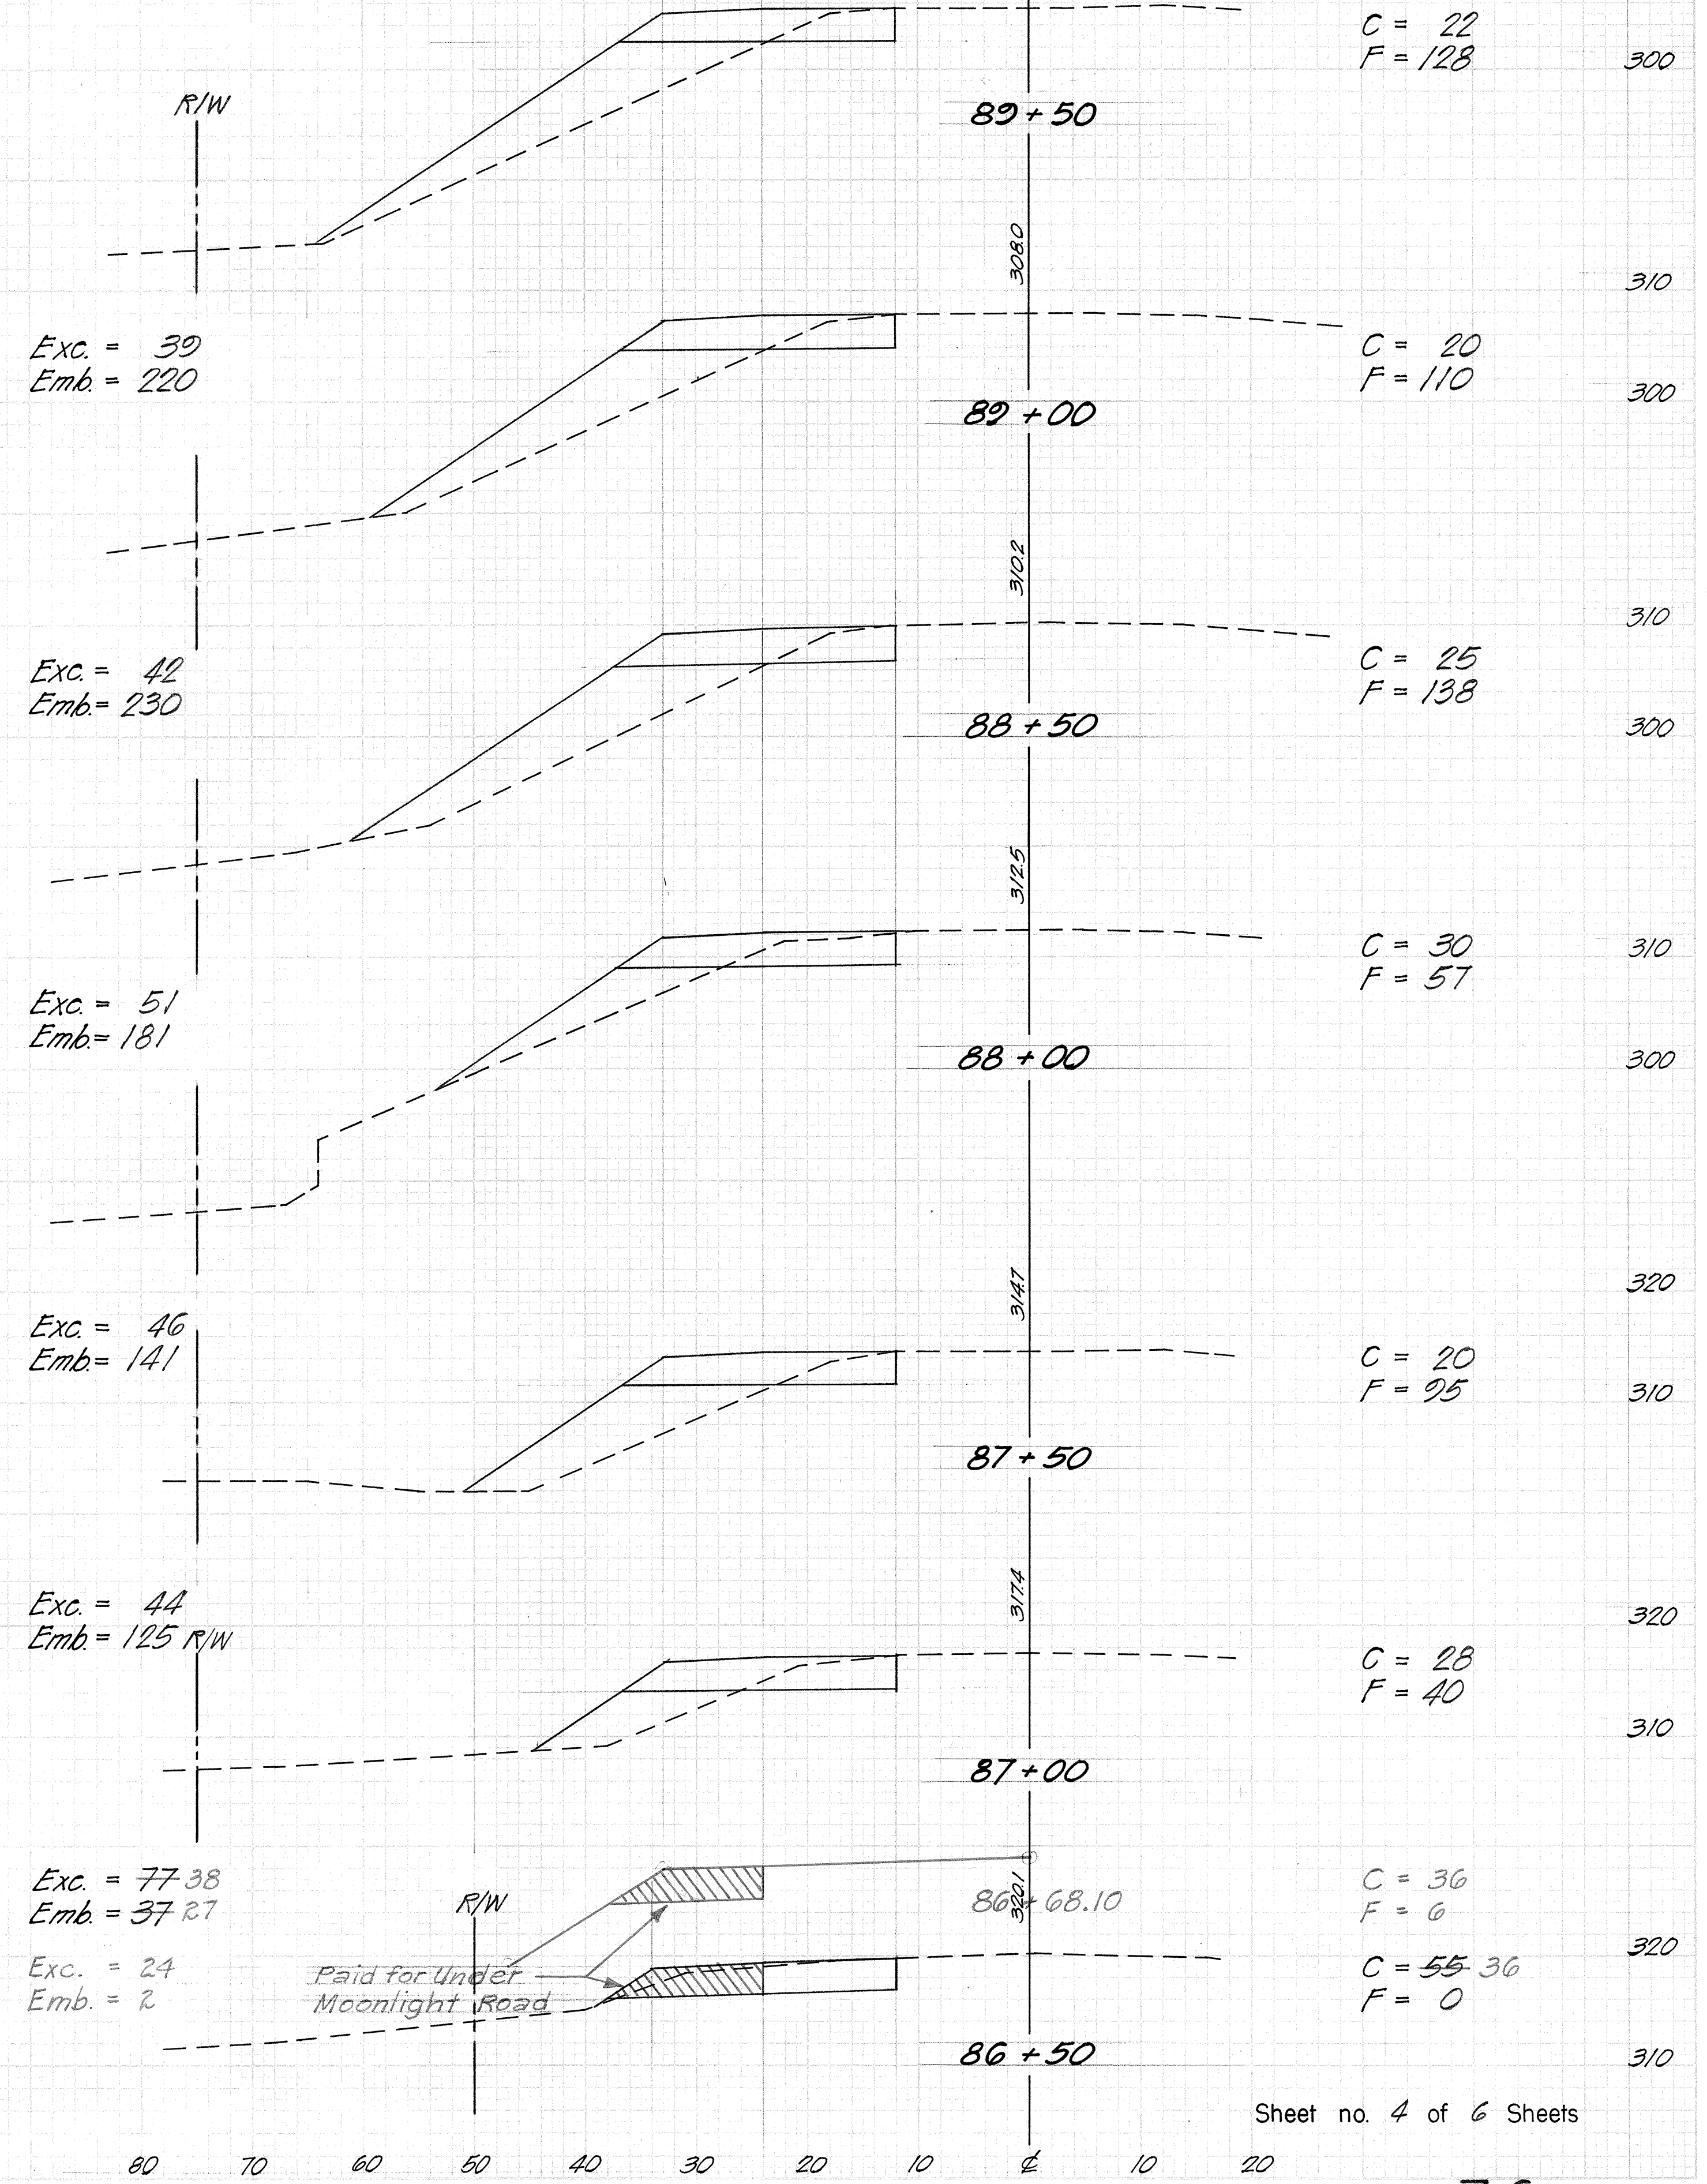

Sheet no. 4 of 6 Sheets



| FED. ROAD DIST. NO. | STATE | PROJ. NO.             | FISCAL YEAR | SHEET NO. | TOTAL SHEETS |
|---------------------|-------|-----------------------|-------------|-----------|--------------|
| HAWAII              | HAW.  | 196H-02-71<br>Unit II | 1979        | 37        | 38           |

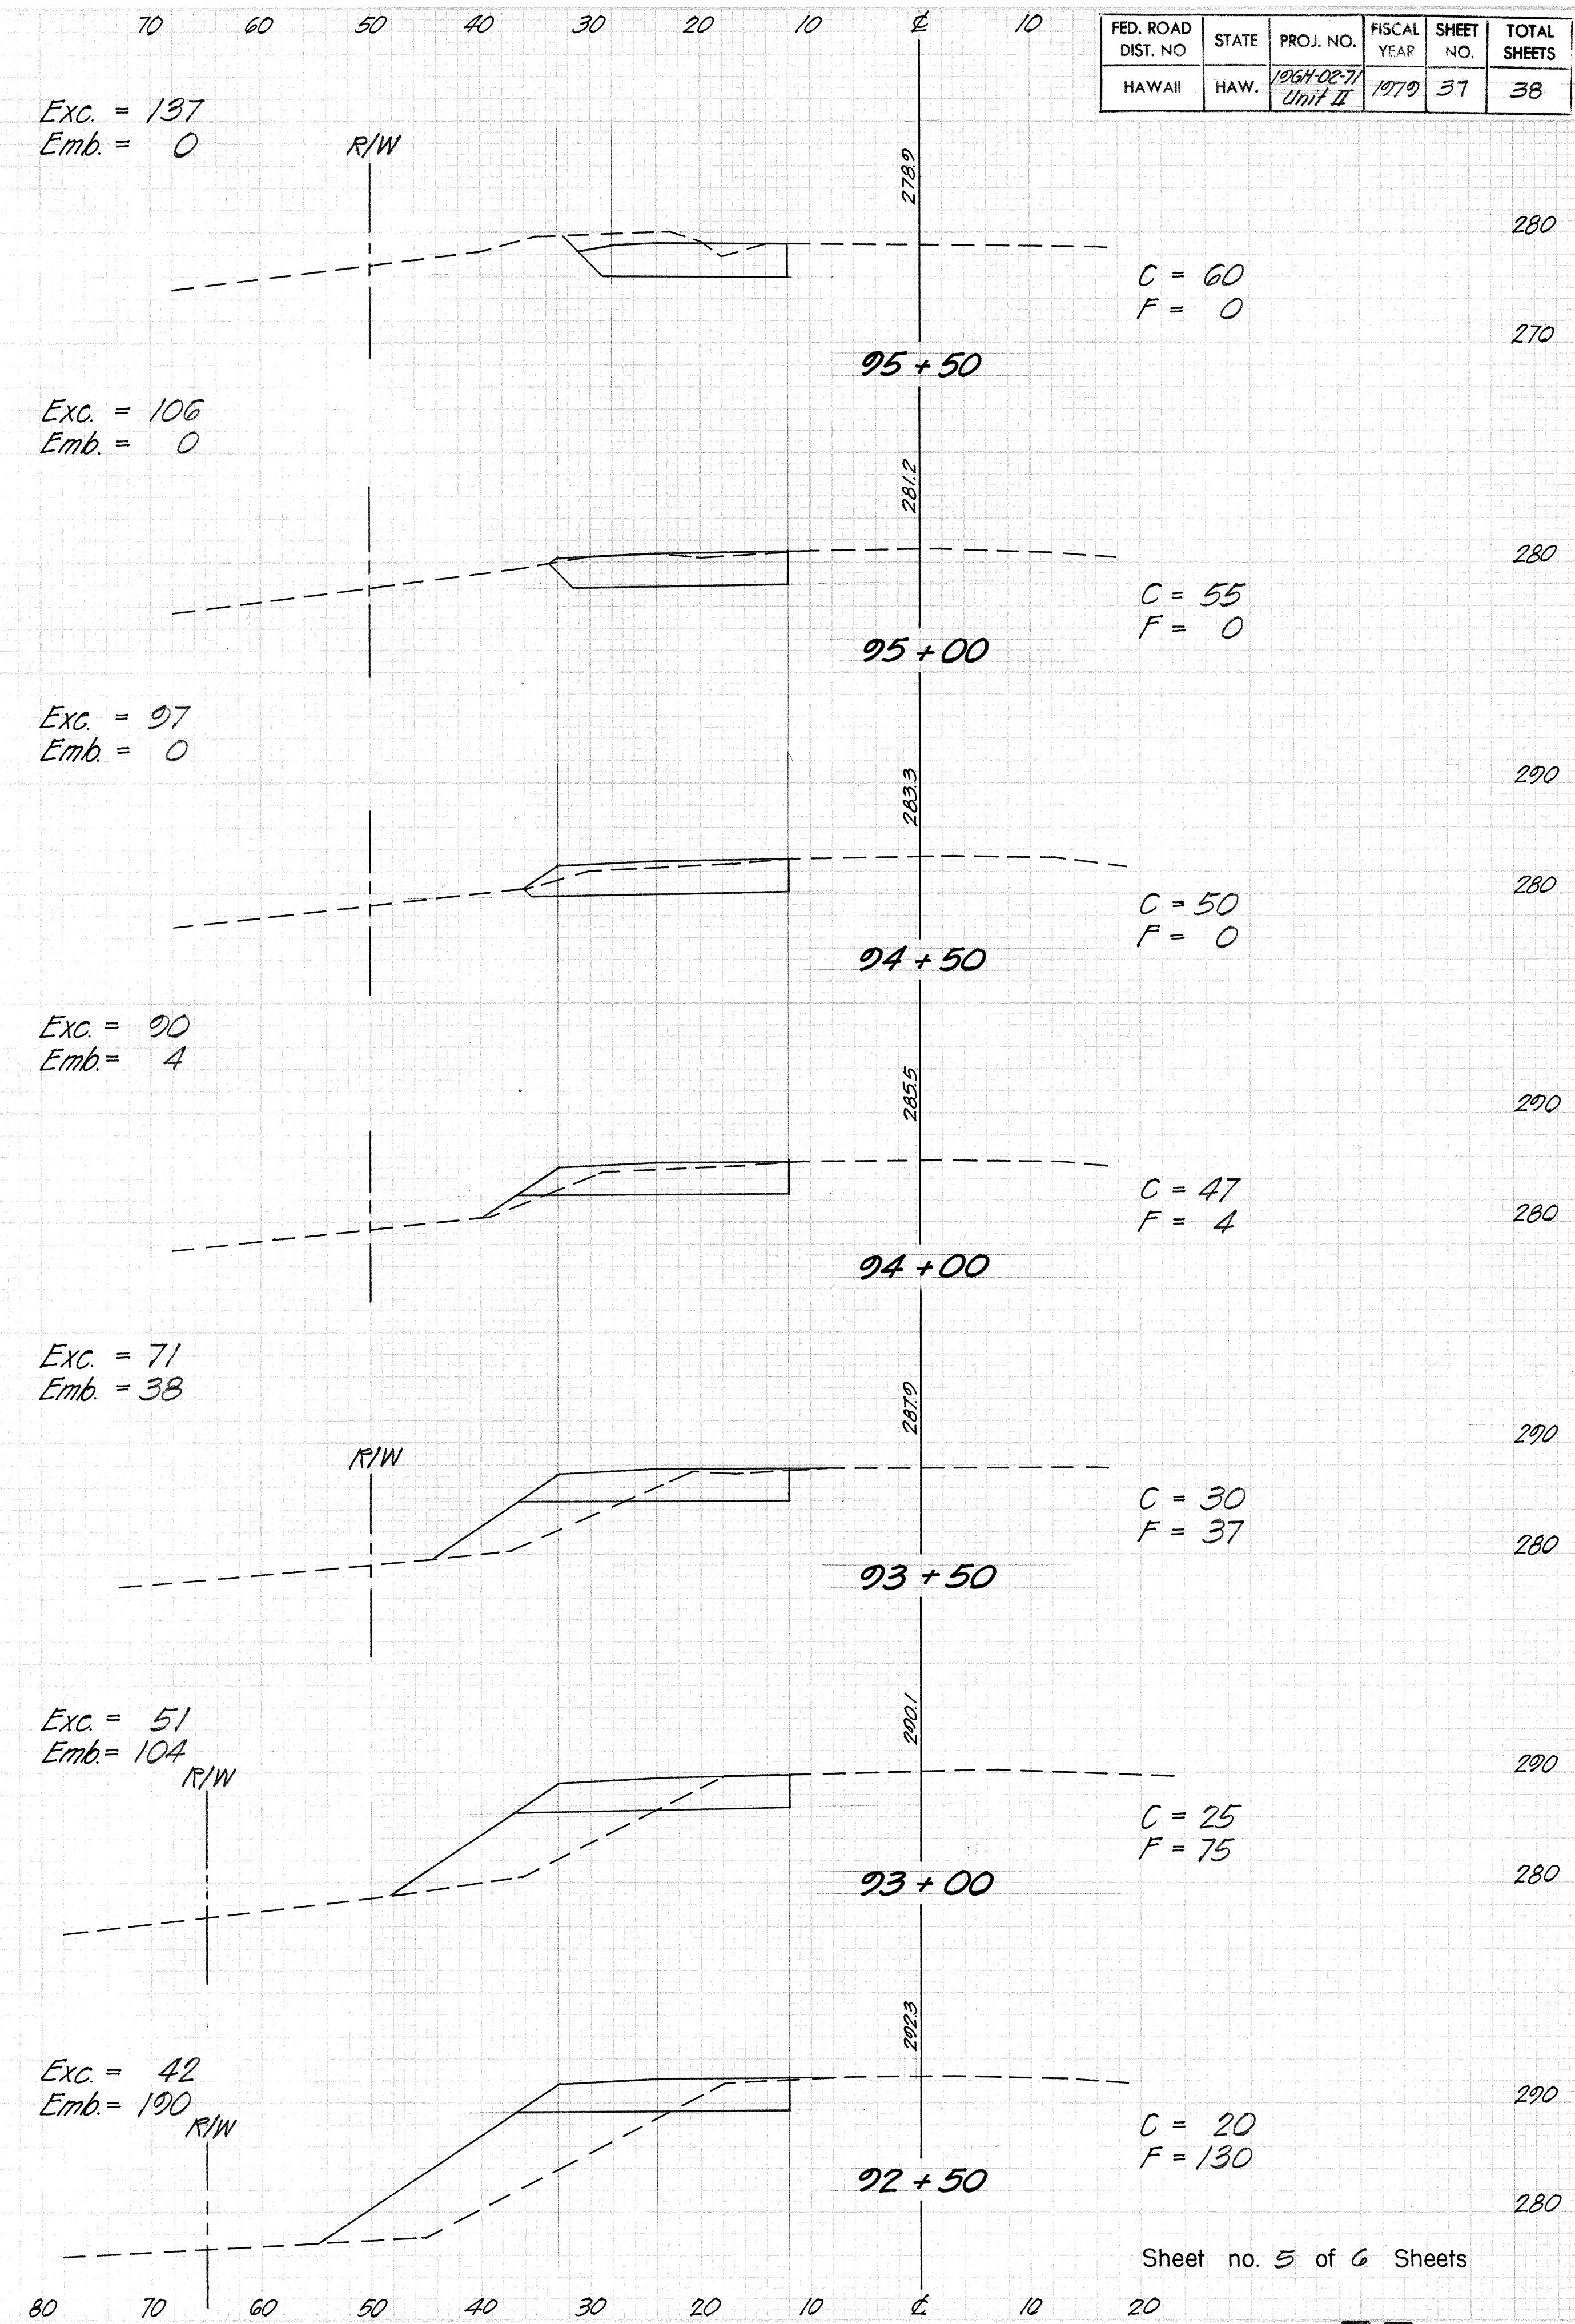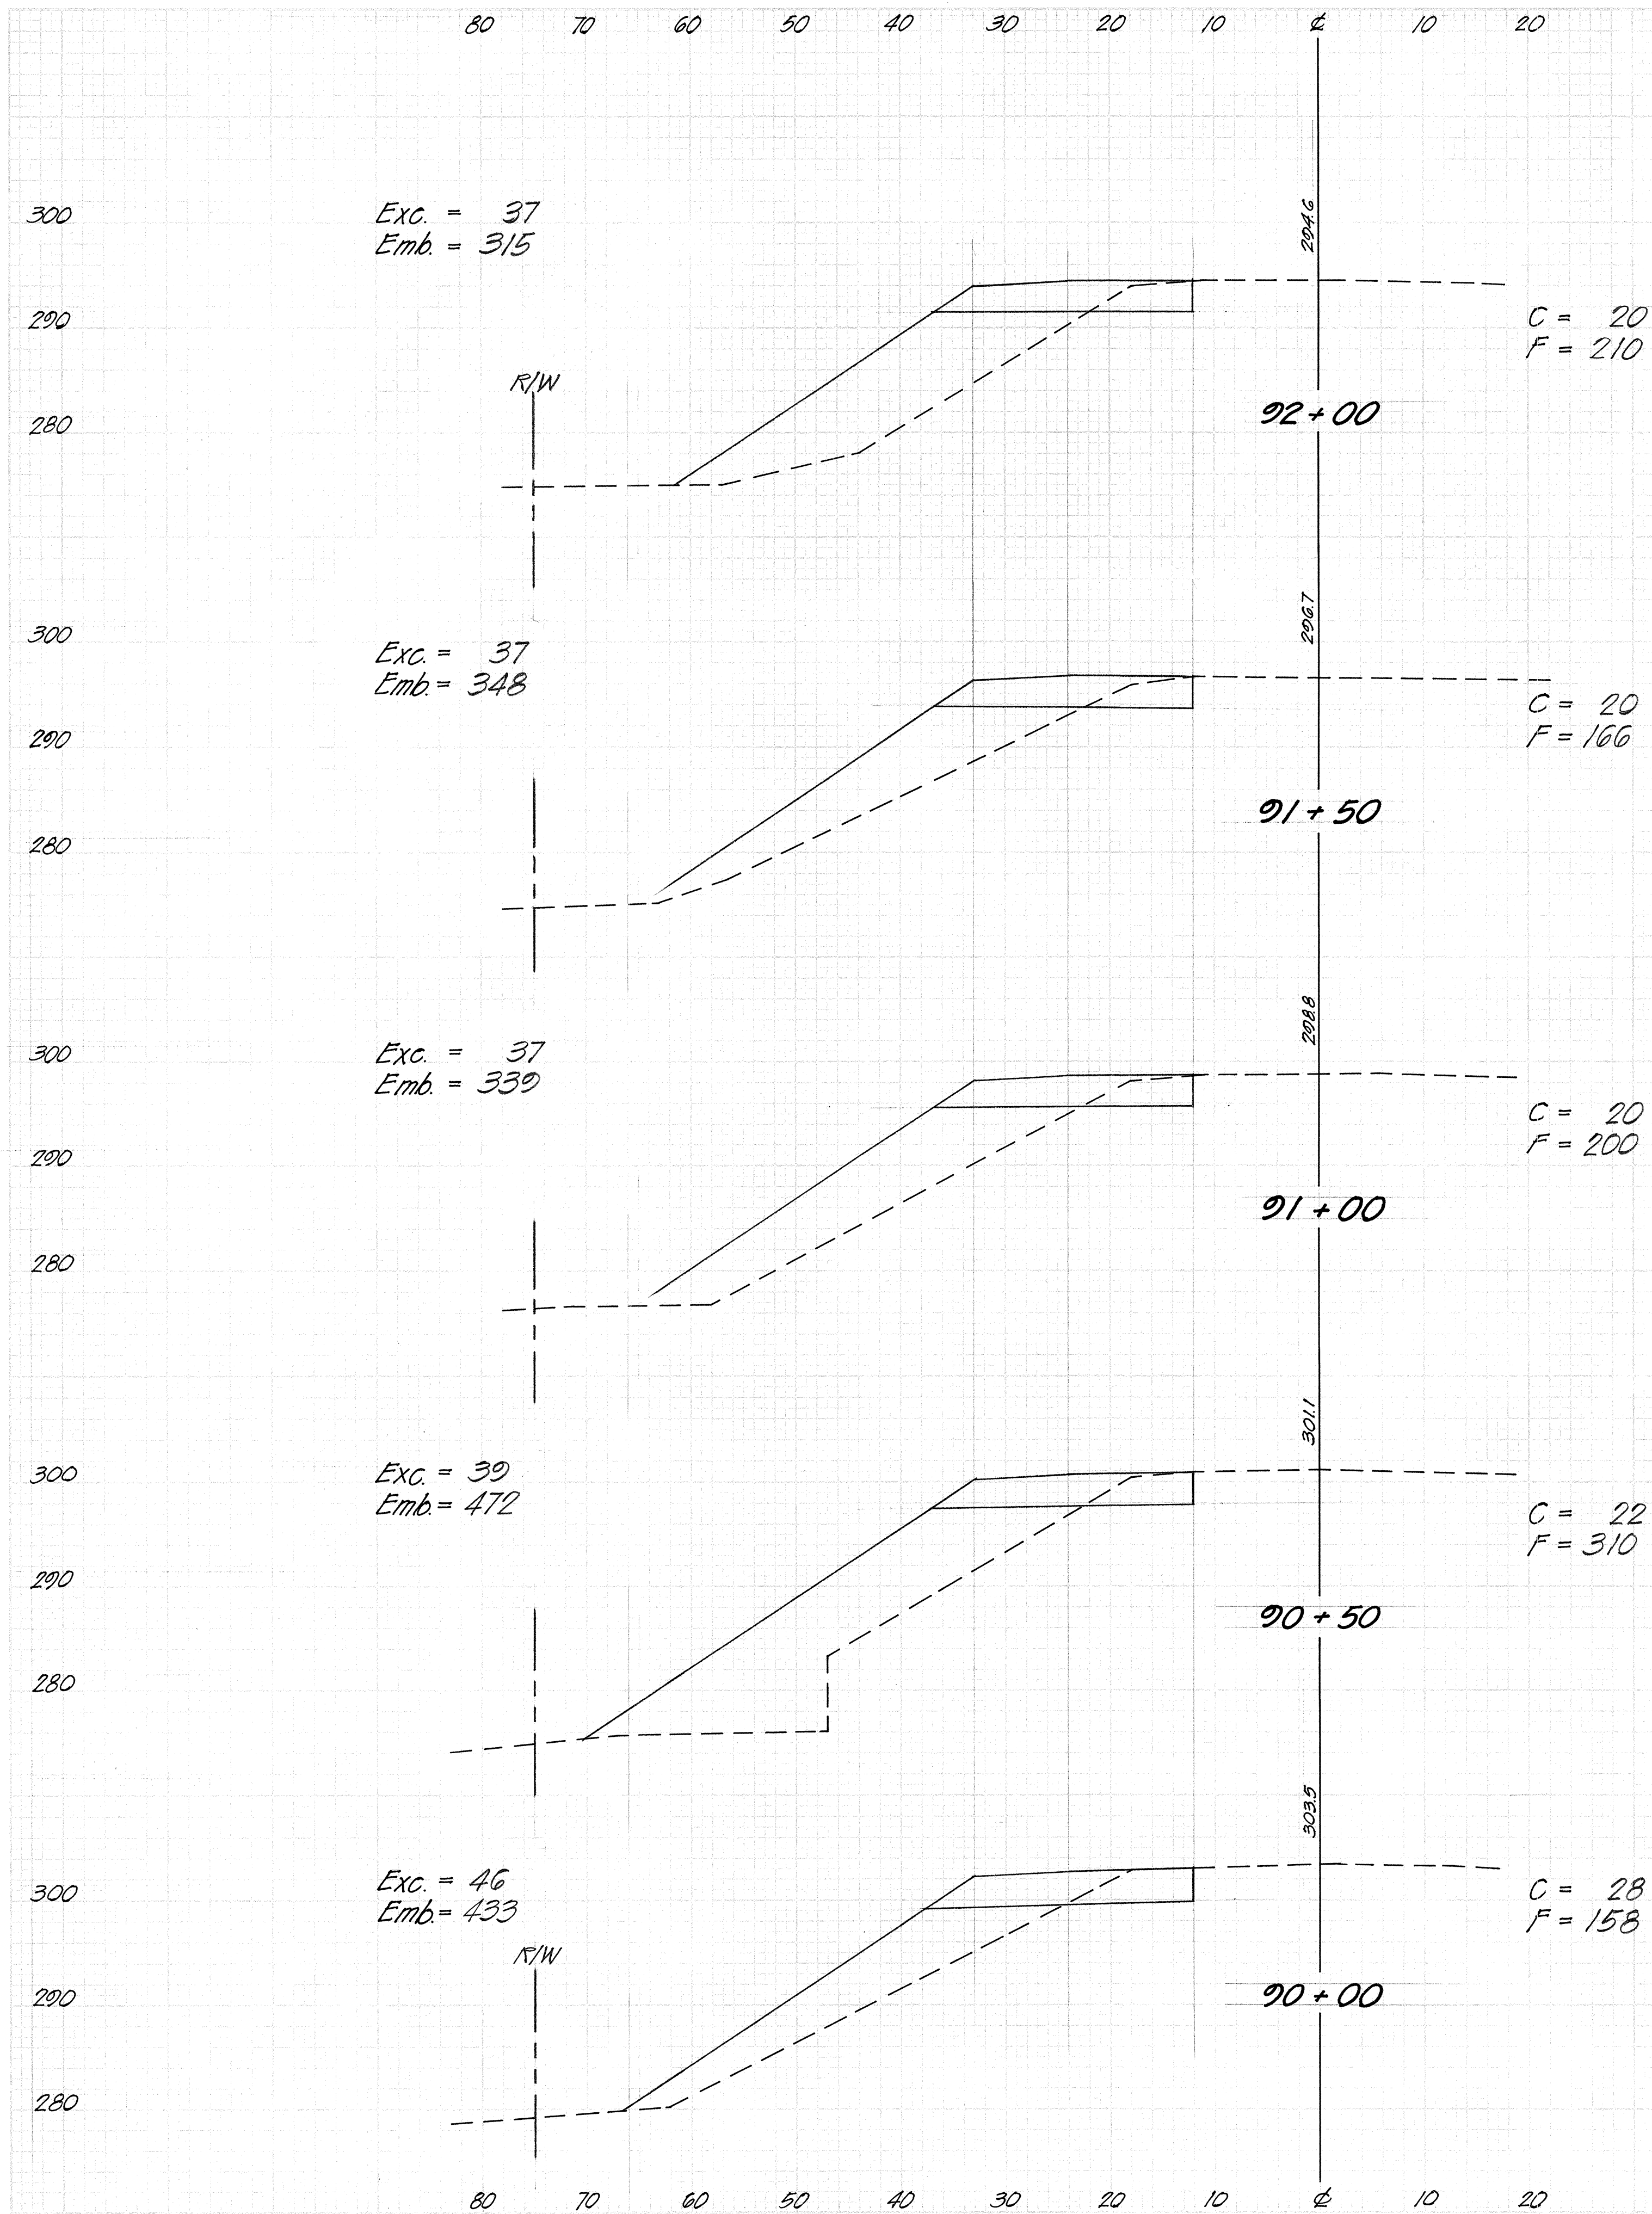



Sheet no. 5 of 6 Sheets



| FED. ROAD DIST. NO. | STATE | PROJ. NO.            | FISCAL YEAR | SHEET NO. | TOTAL SHEETS |
|---------------------|-------|----------------------|-------------|-----------|--------------|
| HAWAII              | HAW.  | 199H-0271<br>Unit II | 1979        | 38        | 38           |

|      |      |          |      |
|------|------|----------|------|
| DATE | BY   | REVIEWED | DATE |
|      |      |          |      |
| NO.  | DATE | NO.      | DATE |

|      |      |          |      |
|------|------|----------|------|
| DATE | BY   | REVIEWED | DATE |
|      |      |          |      |
| NO.  | DATE | NO.      | DATE |

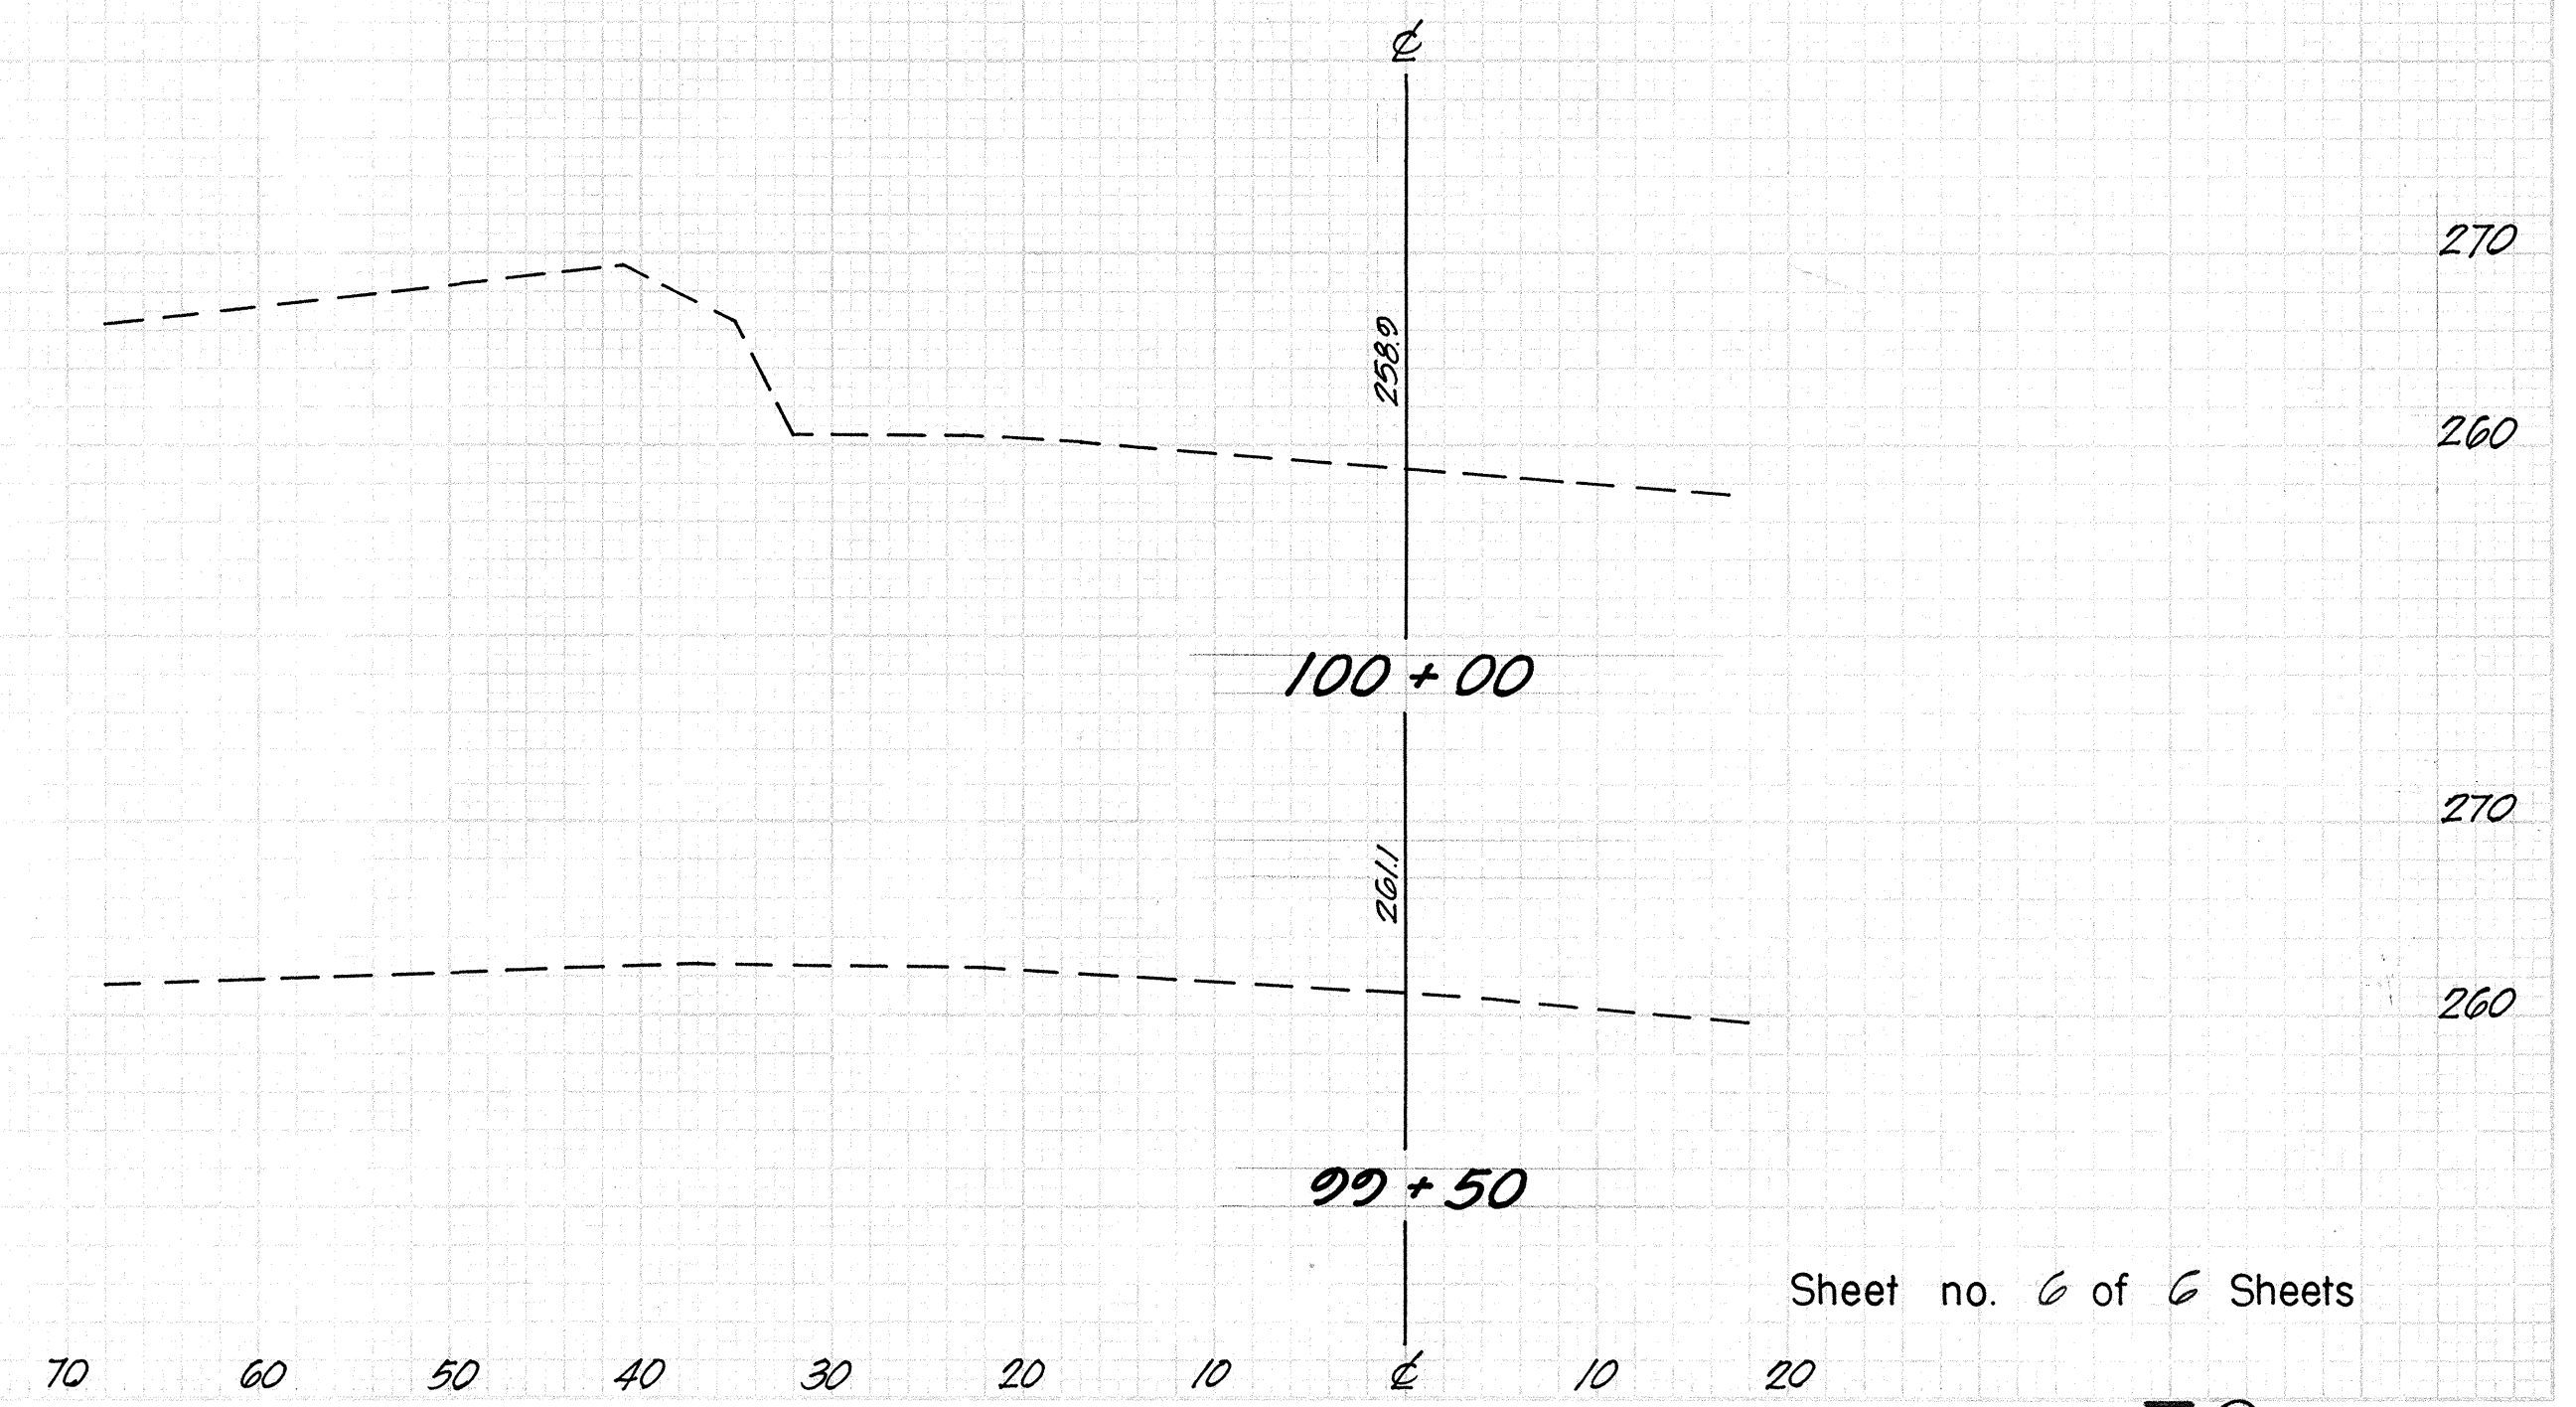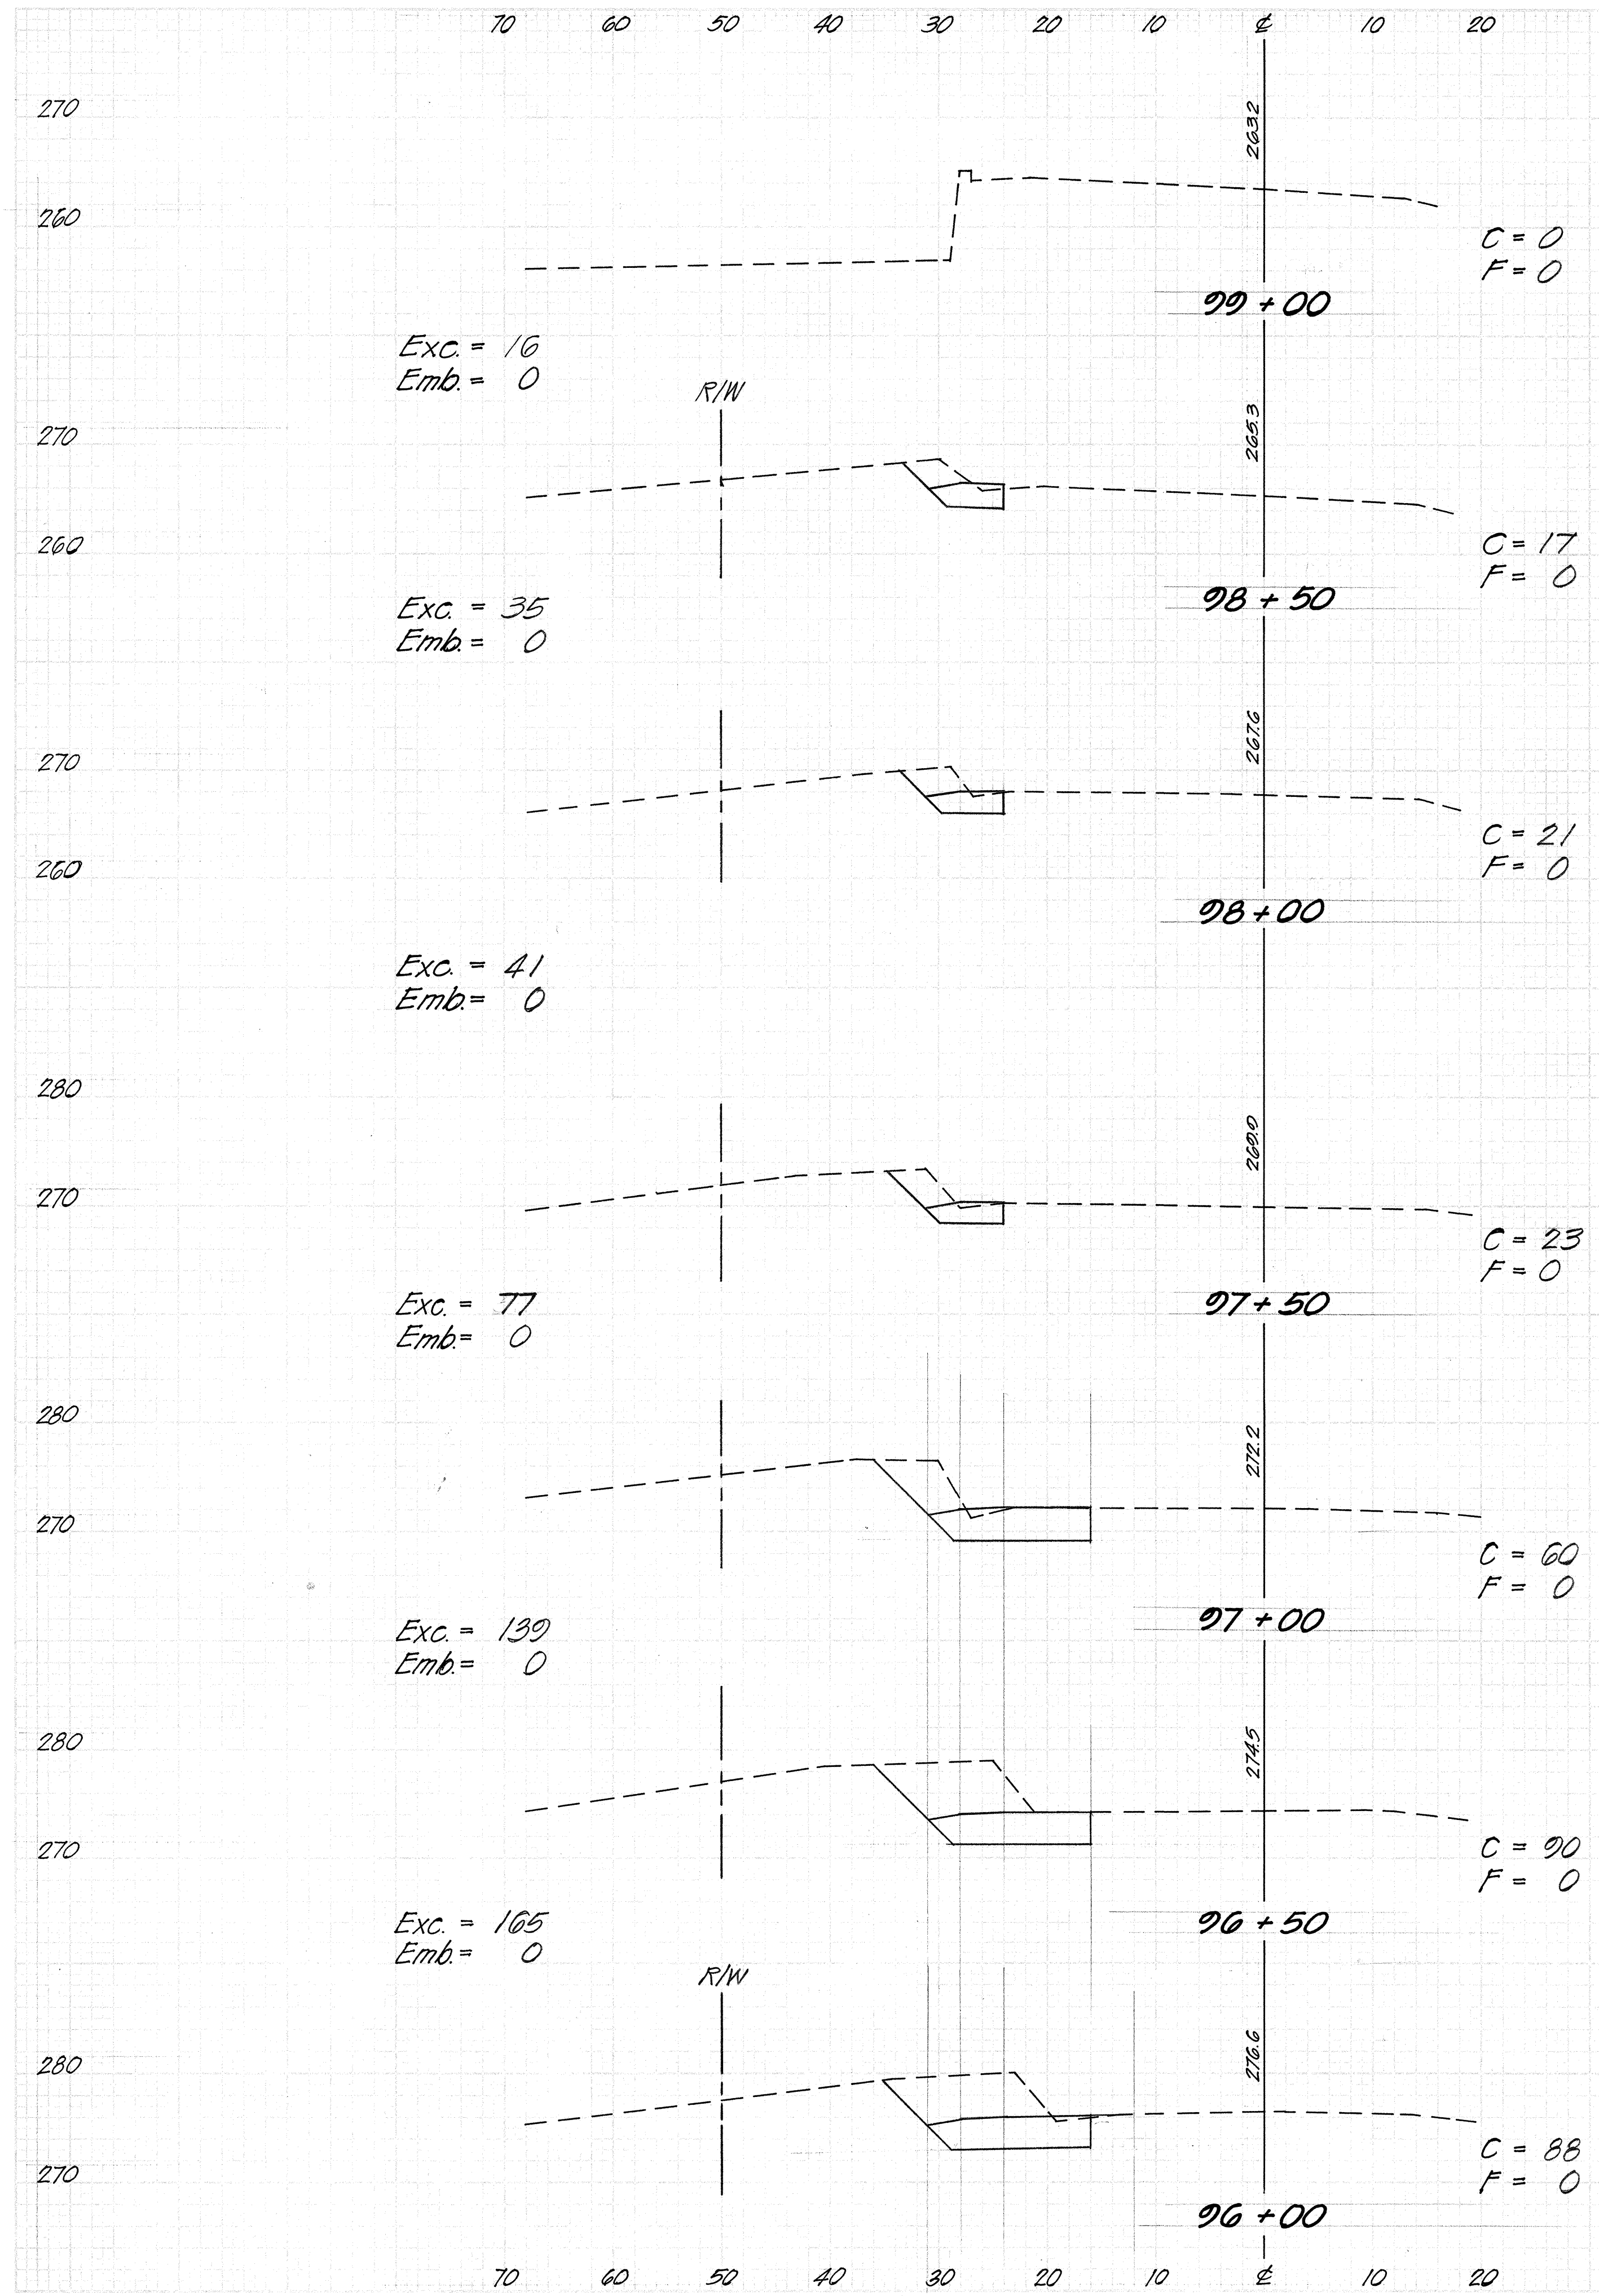

Sheet no. 6 of 6 Sheets