



INDEX TO DRAWINGS	
SHEET NO.	DESCRIPTION
1	TITLE SHEET
2	TYPICAL SECTIONS
3+5	PLAN & PROFILE
6	SIDE ROAD CONNECTION DET
7-10	DRAINAGE DETAILS
11	TRAFFIC SIGNS, STRIPING, & PAVEMENT MARKERS
12+32	MISC. & STANDARD DETAILS
33-38	CROSS SECTIONS

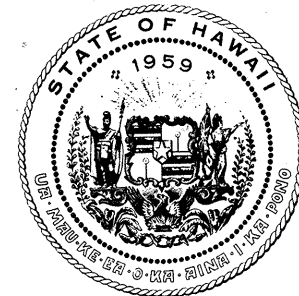

STATE OF HAWAII
DEPARTMENT OF TRANSPORTATION
LAND TRANSPORTATION FACILITIES DIVISION
"AS - BUILT"
PLANS FOR
CONSTRUCTION OF

FED. ROAD DIST. NO.	STATE	PROJ. NO.	FISCAL YEAR	SHEET NO.	TOTAL SHEET
HAWAII	HAW.	106H-02-71, Unit II	1979	1	38

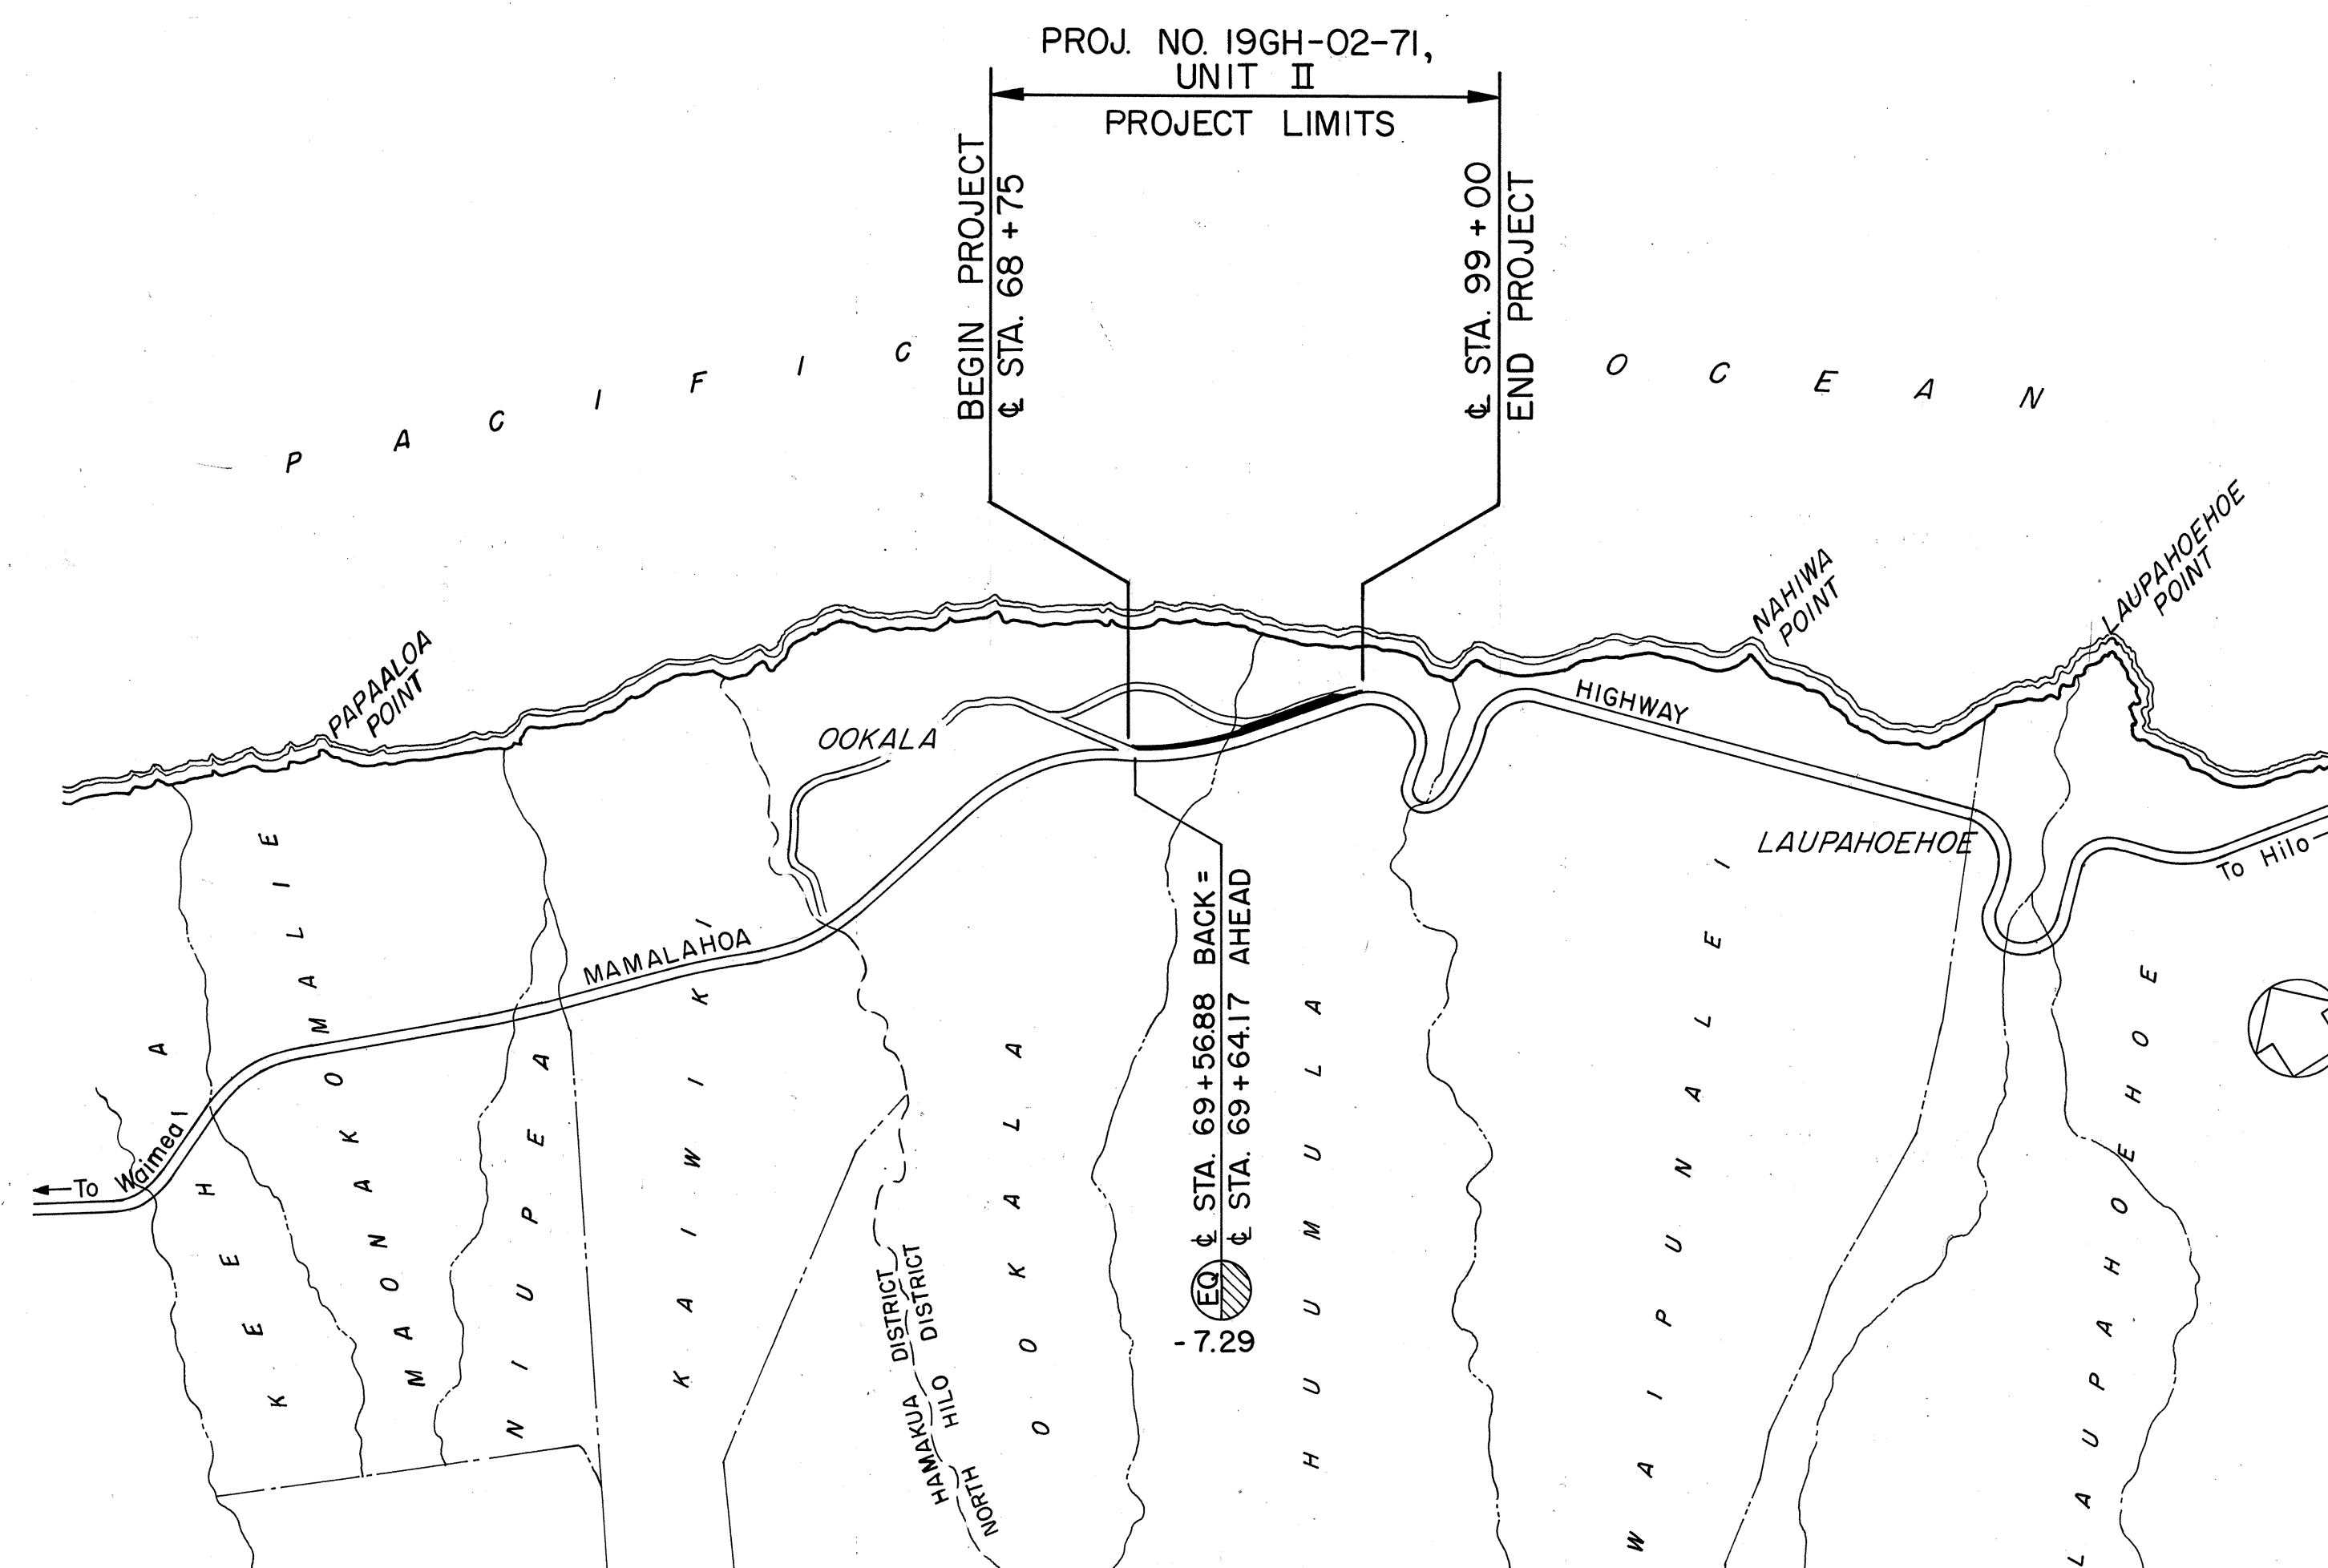

Federal Aid Projects Previously Constructed or Under Construction

Melvin Santar 10/1/79
RESIDENT ENGINEER DATE

CURRENT ADT (1978)	3,500
DESIGN ADT (1998)	6,100
DHV	550
D	50/50
T	12%
T ₂₄	12%

GROSS & NET LENGTH OF PROJECT. . . . 0.572 Mi.

DEPARTMENT OF TRANSPORTATION STATE OF HAWAII	
APPROVED: <u>Ryobichi Higashionna</u> 8/21/	
DIR. OF TRANSPORTATION	DATE