


FED. ROAD DIST. NO.	STATE	PROJ. NO.	FISCAL YEAR	SHEET NO.	TOTAL SHEETS
HAWAII	HAW.	101-0875 UNIT I	1979	34	42

FINAL SURVEY
BY: _____
DATE: _____
NOTE BOOK NO. _____
AREAS CHECKED: _____


ORIGINAL SURVEY
BY: _____
DATE: _____
NOTE BOOK NO. _____
AREAS CHECKED: _____

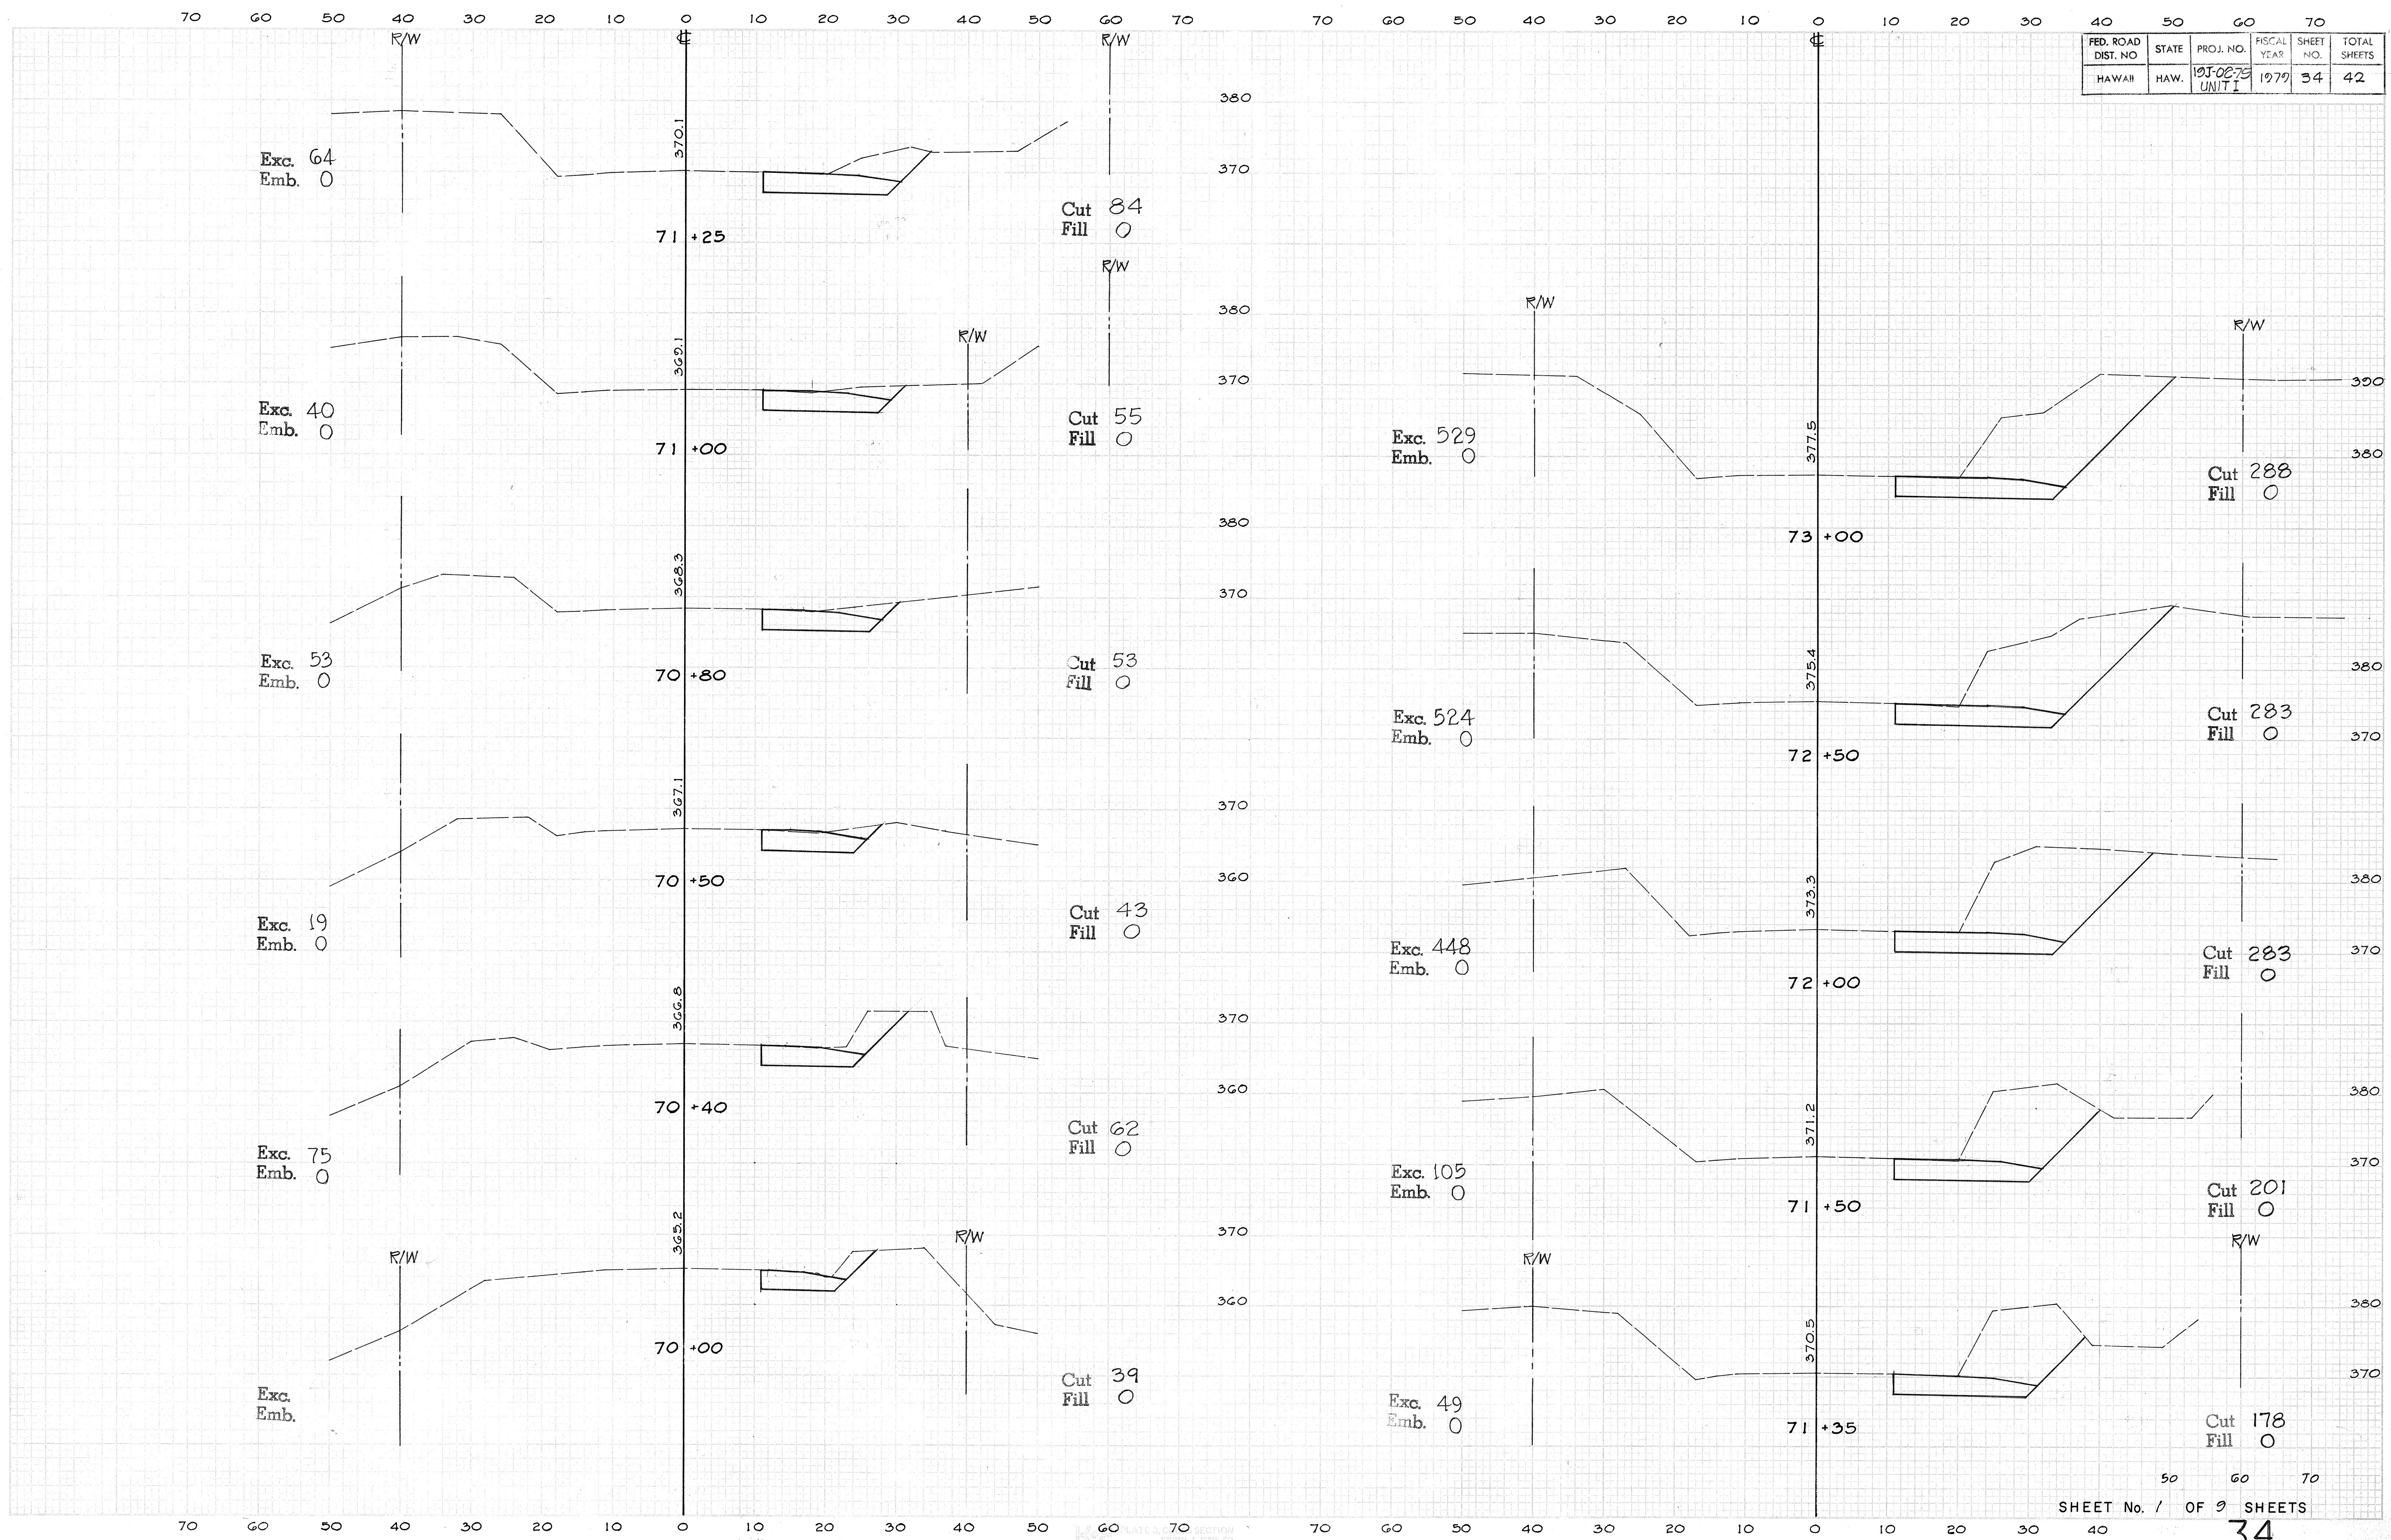

FED. ROAD DIST. NO.	STATE	PROJ. NO.	FISCAL YEAR	SHEET NO.	TOTAL SHEETS
HAWAII	HAW.	10T-0275 UNIT I	1970	35	42

ORIGINAL SURVEY
 DATE: _____
 BY: _____
 CHECKED: _____
 APPROVED: _____
 NO. _____



ORIGINAL SURVEY
 DATE: _____
 BY: _____
 CHECKED: _____
 APPROVED: _____
 NO. _____

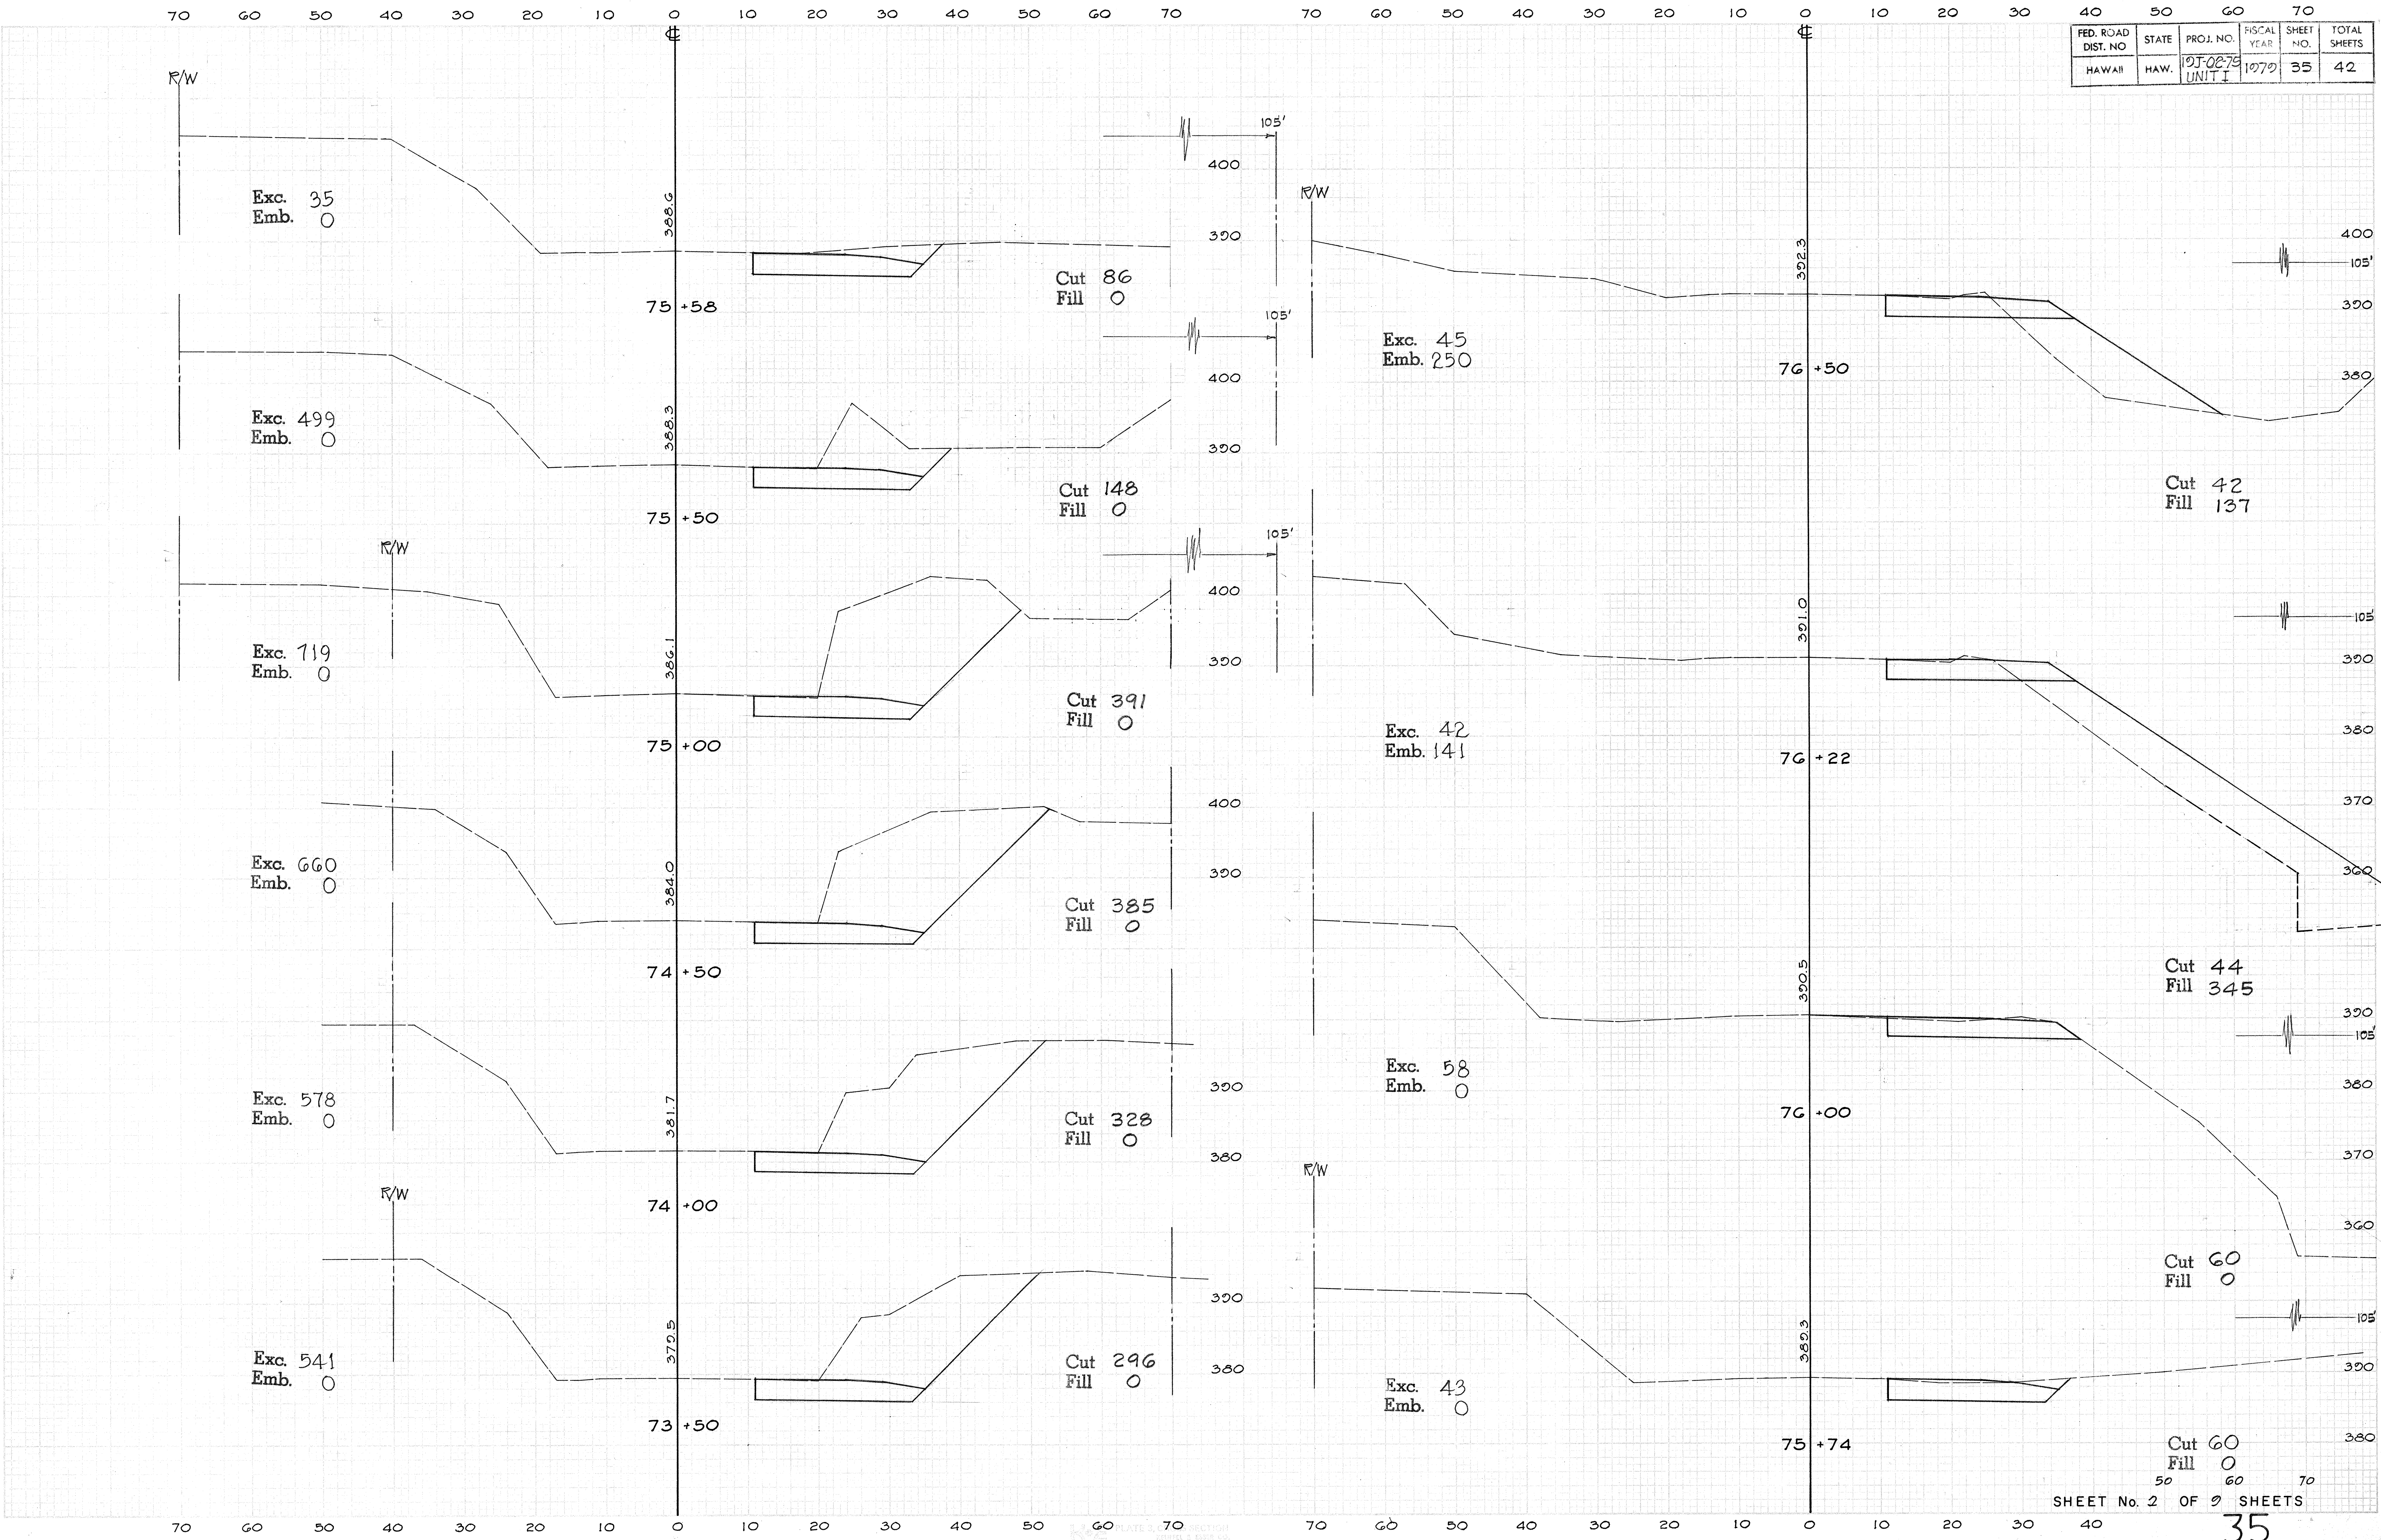

FED. ROAD DIST. NO.	STATE	PROJ. NO.	FISCAL YEAR	SHEET NO.	TOTAL SHEETS
HAWAII	HAW.	101-02-79 UNIT I	1979	37	42

FINAL SURVEY
 SURVEYED BY
 DATE
 CHECKED BY
 DATE
 NOTE: ROAD DIST. NO. 101-02-79 UNIT I
 AREA: 101-02-79 UNIT I
 SCALE: 1" = 40'


ORIGINAL SURVEY
 SURVEYED BY
 DATE
 CHECKED BY
 DATE
 NOTE: ROAD DIST. NO. 101-02-79 UNIT I
 AREA: 101-02-79 UNIT I
 SCALE: 1" = 40'

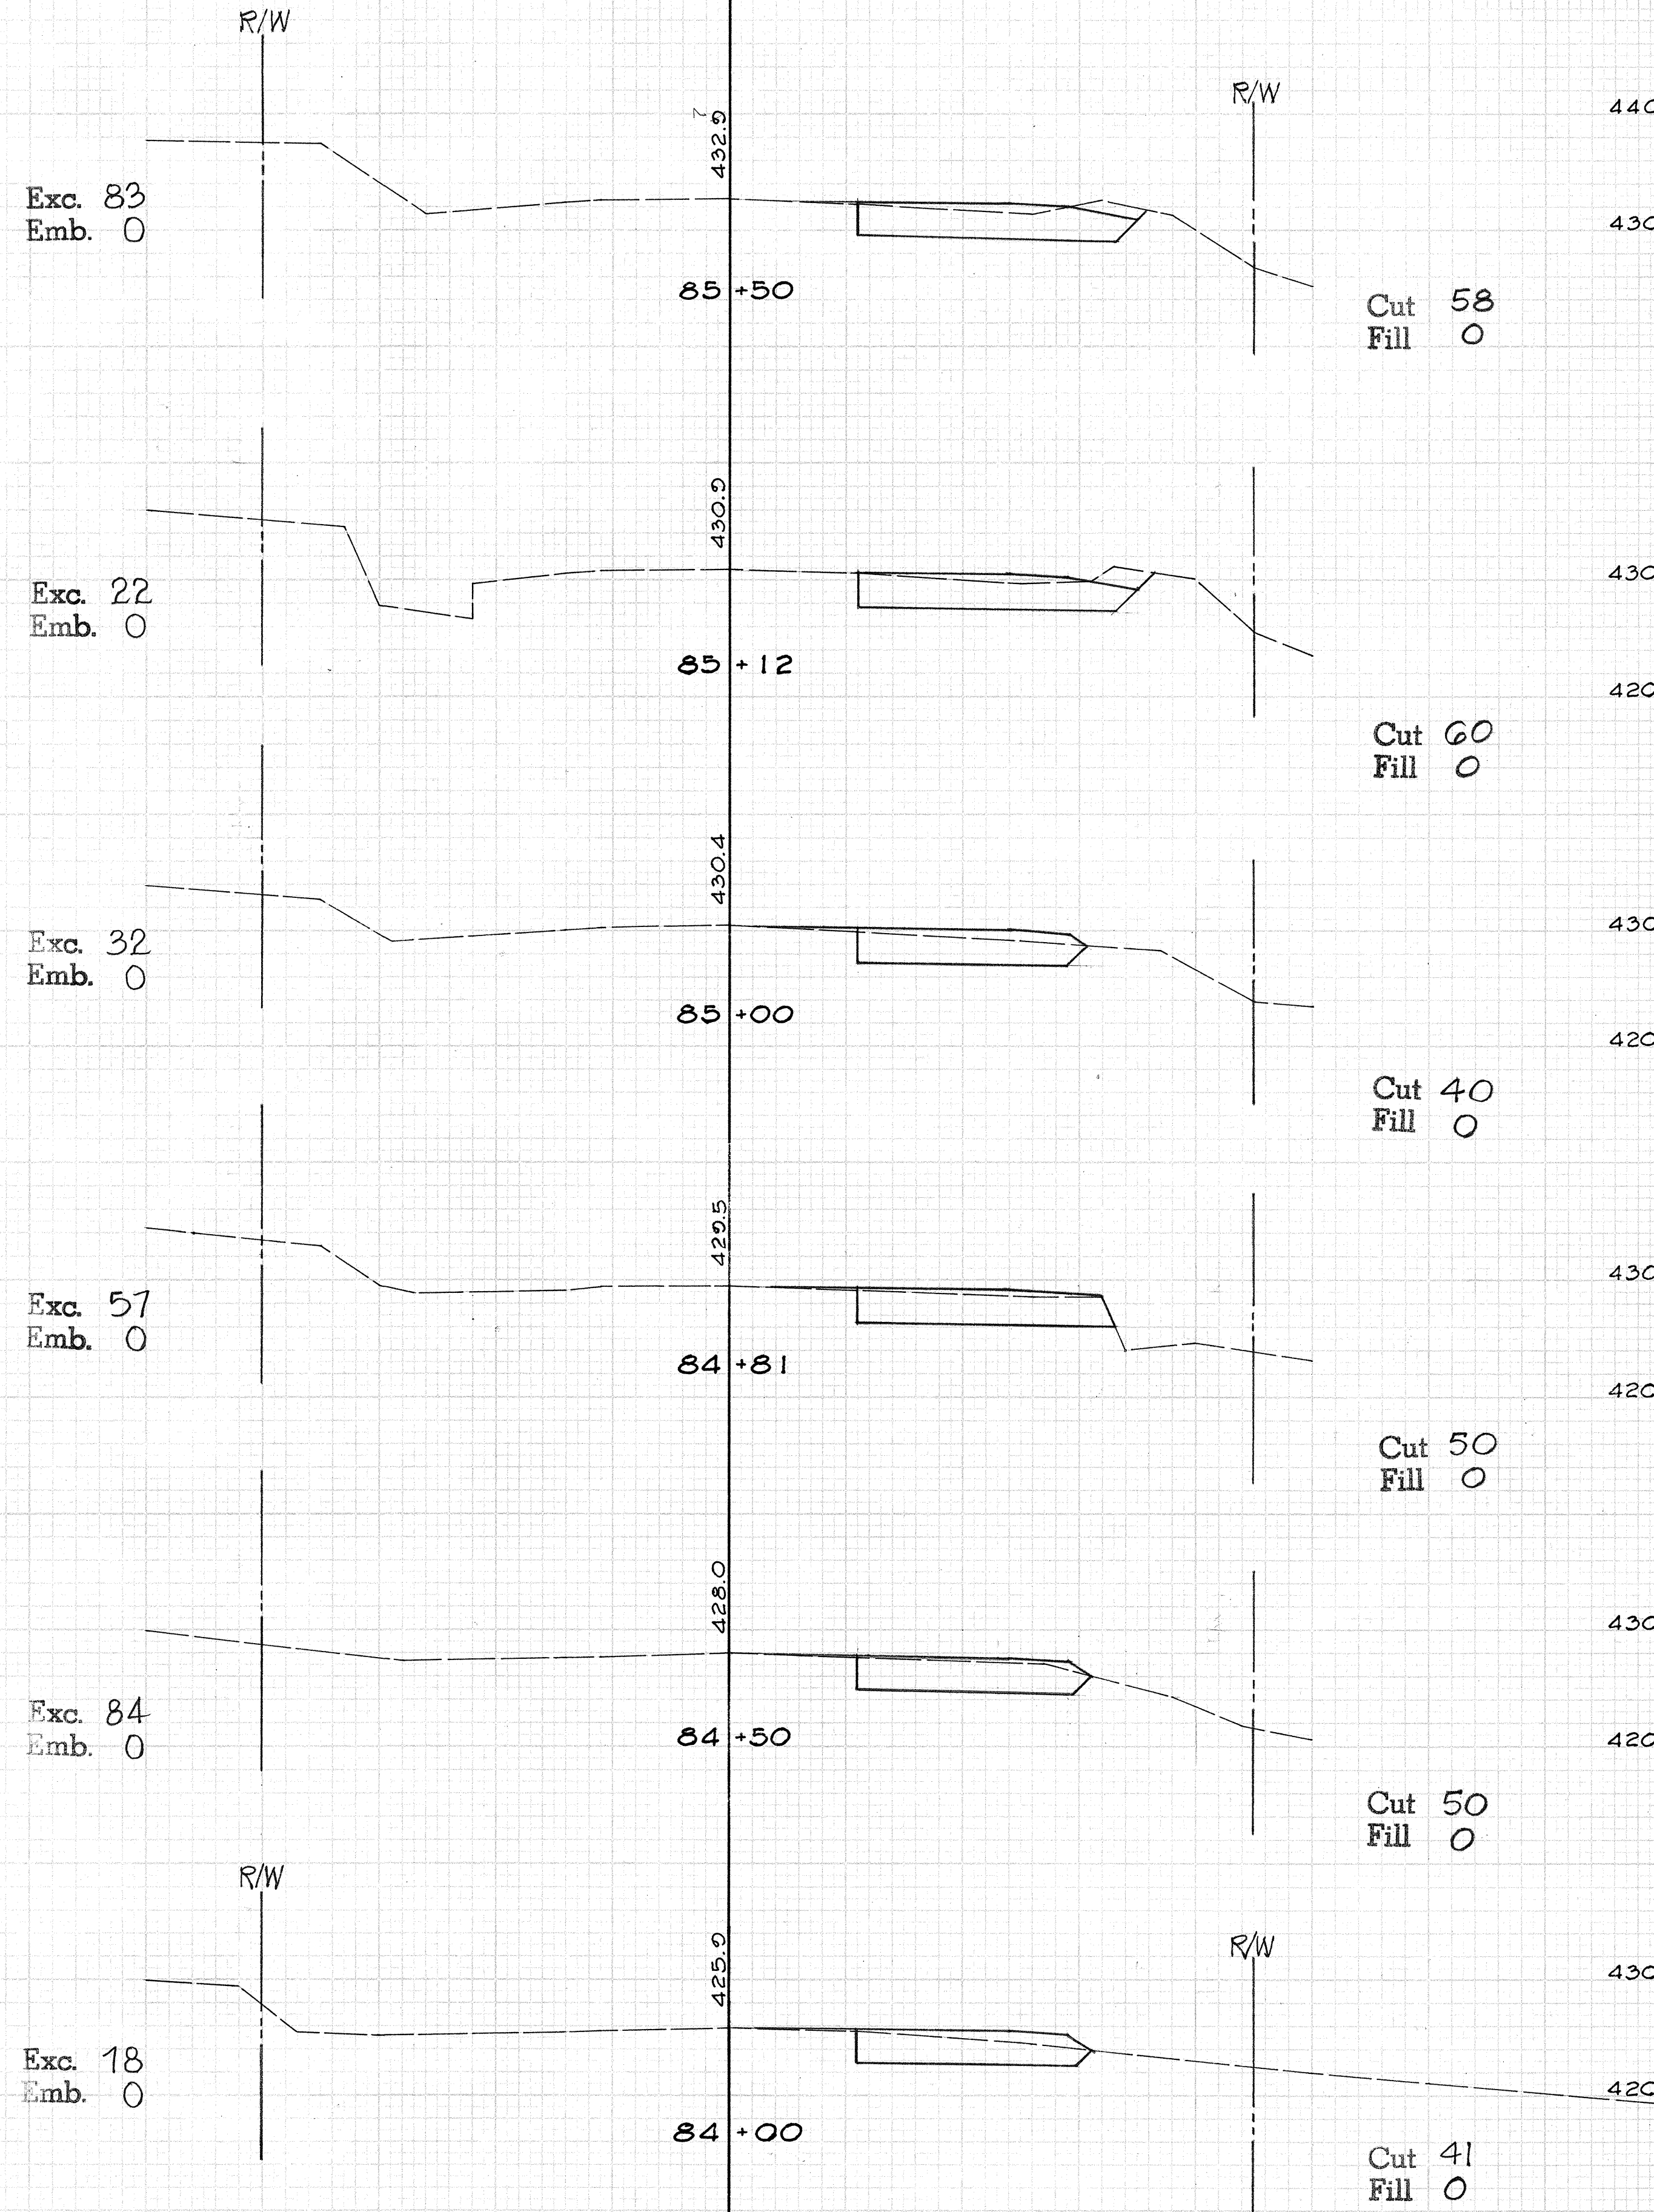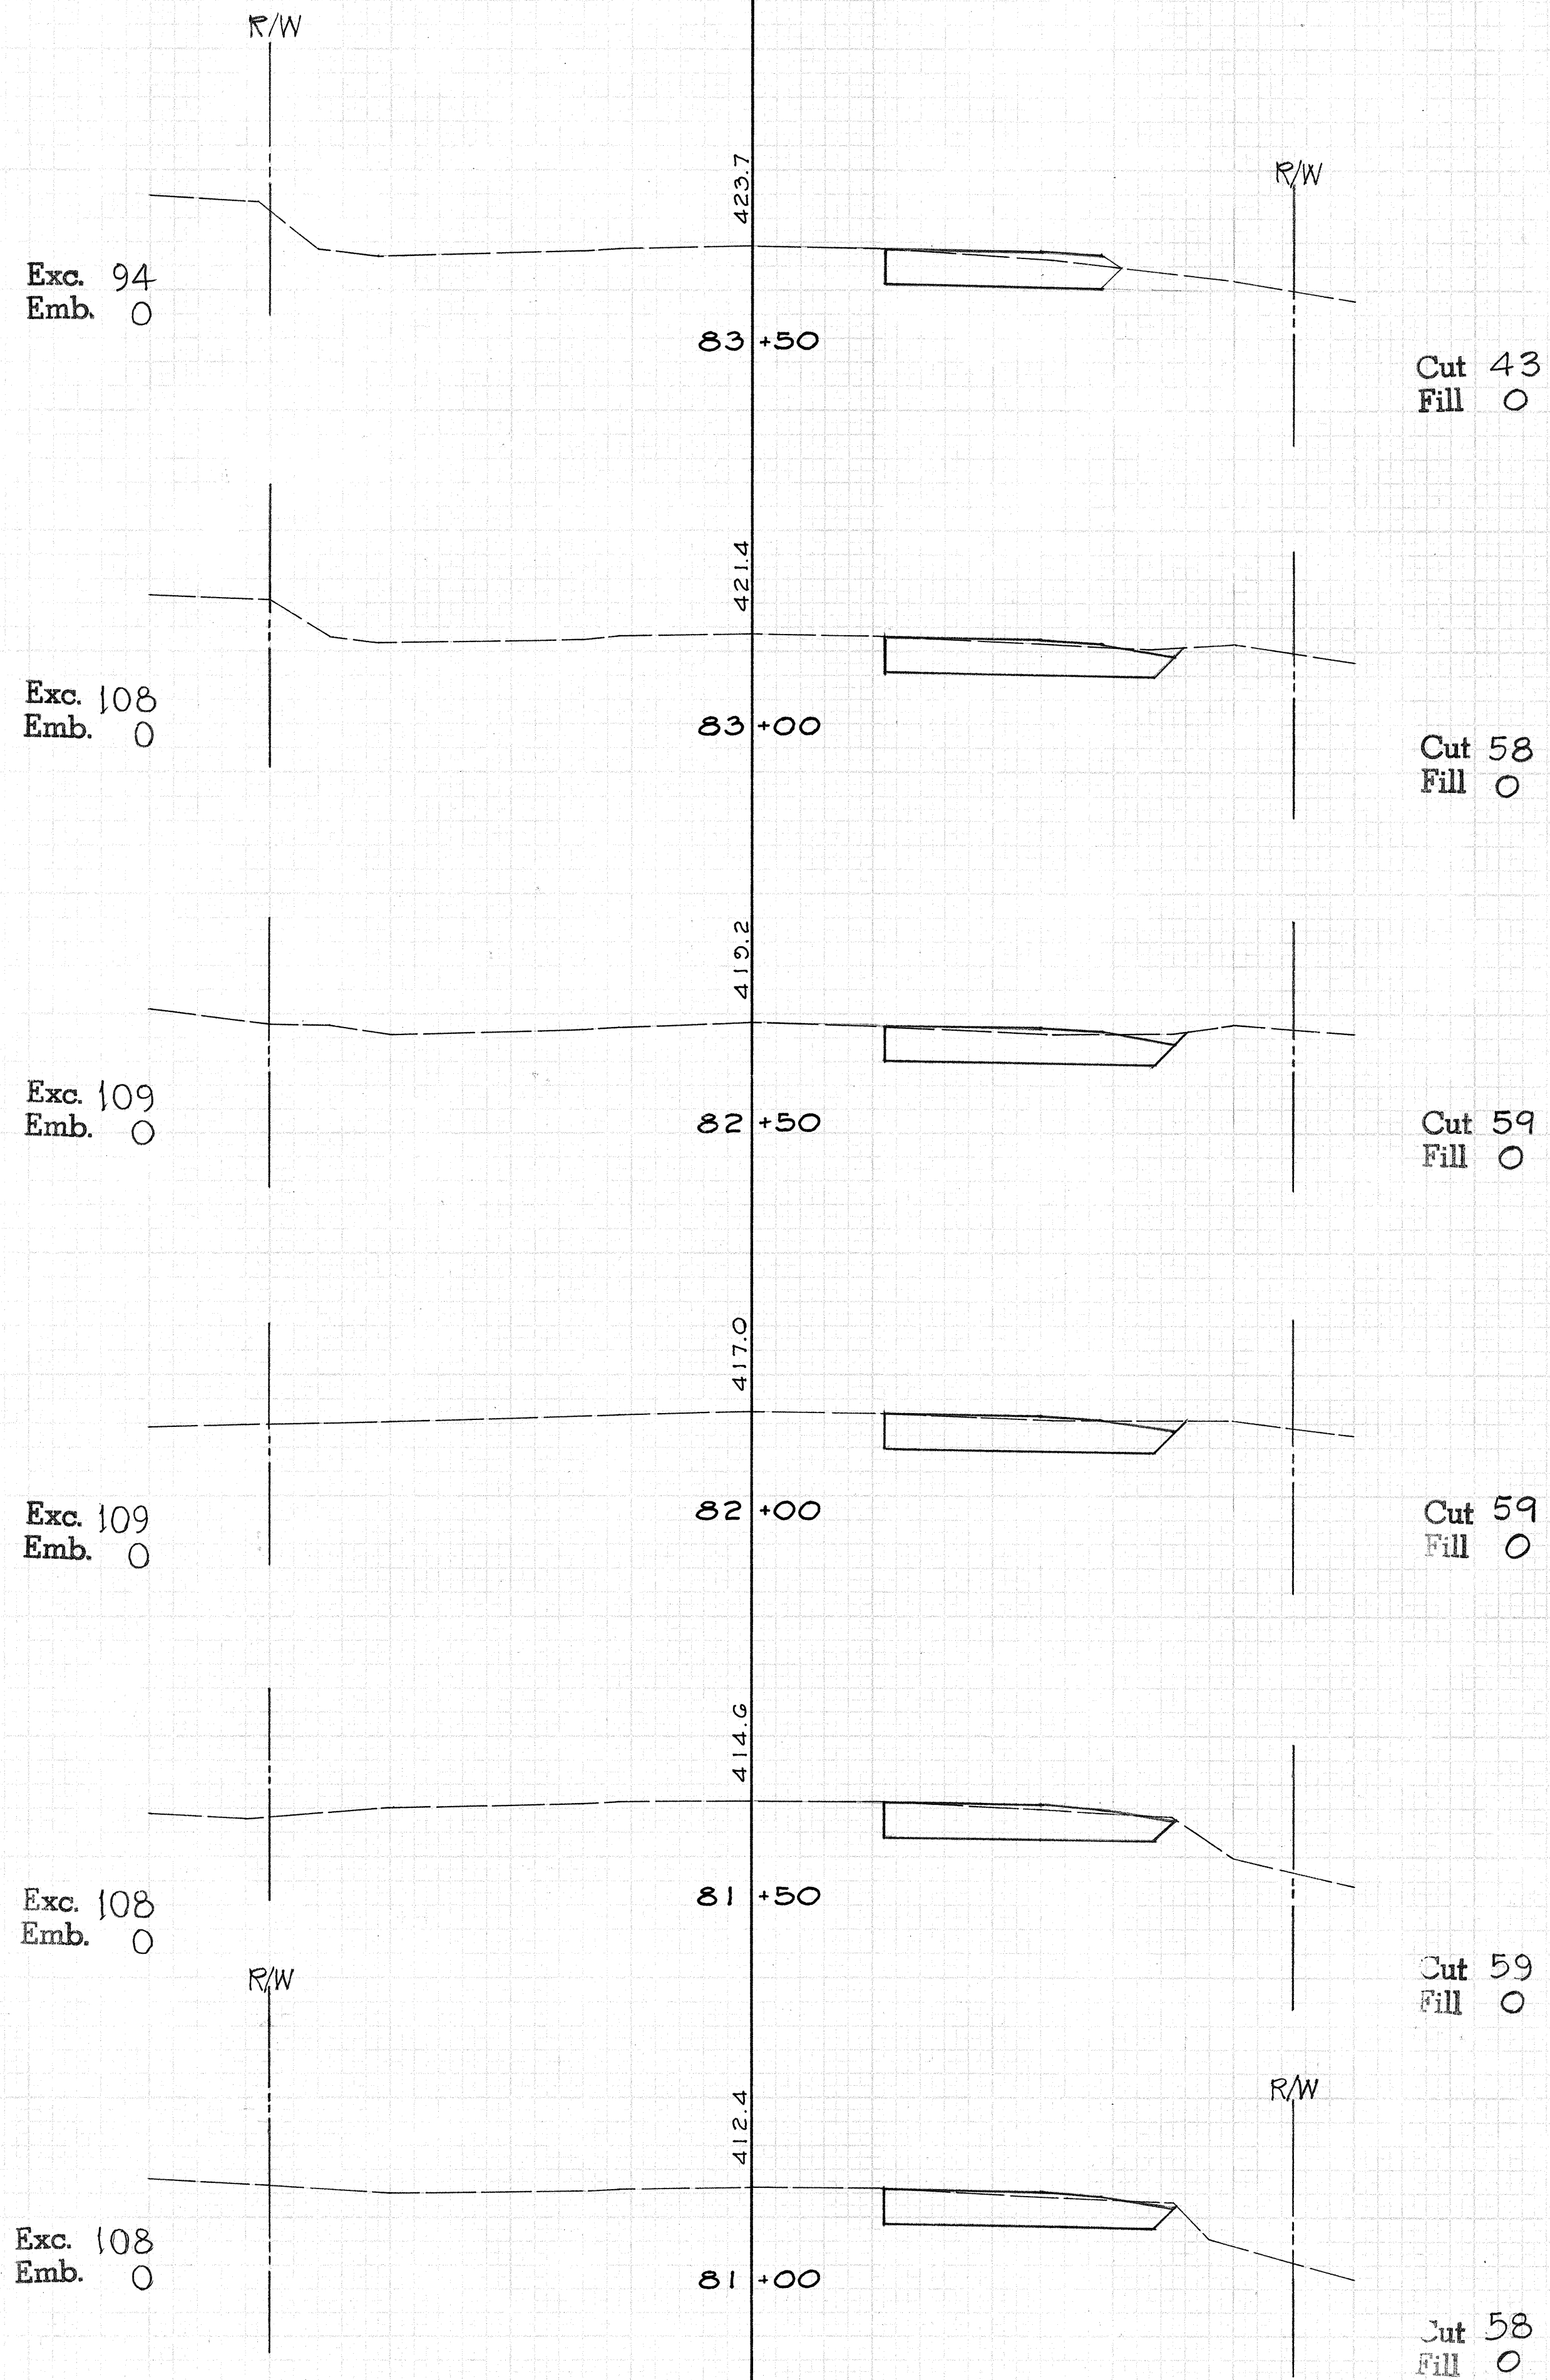

FED. ROAD DIST. NO.	STATE	PROJ. NO.	FISCAL YEAR	SHEET NO.	TOTAL SHEETS
HAWAII	HAW.	197-0275 UNIT I	1970	38	42

DATE: _____
BY: _____
SURVEY: _____
NOTE BOOK: _____
AREAS: _____



DATE: _____
BY: _____
SURVEY: _____
NOTE BOOK: _____
AREAS: _____

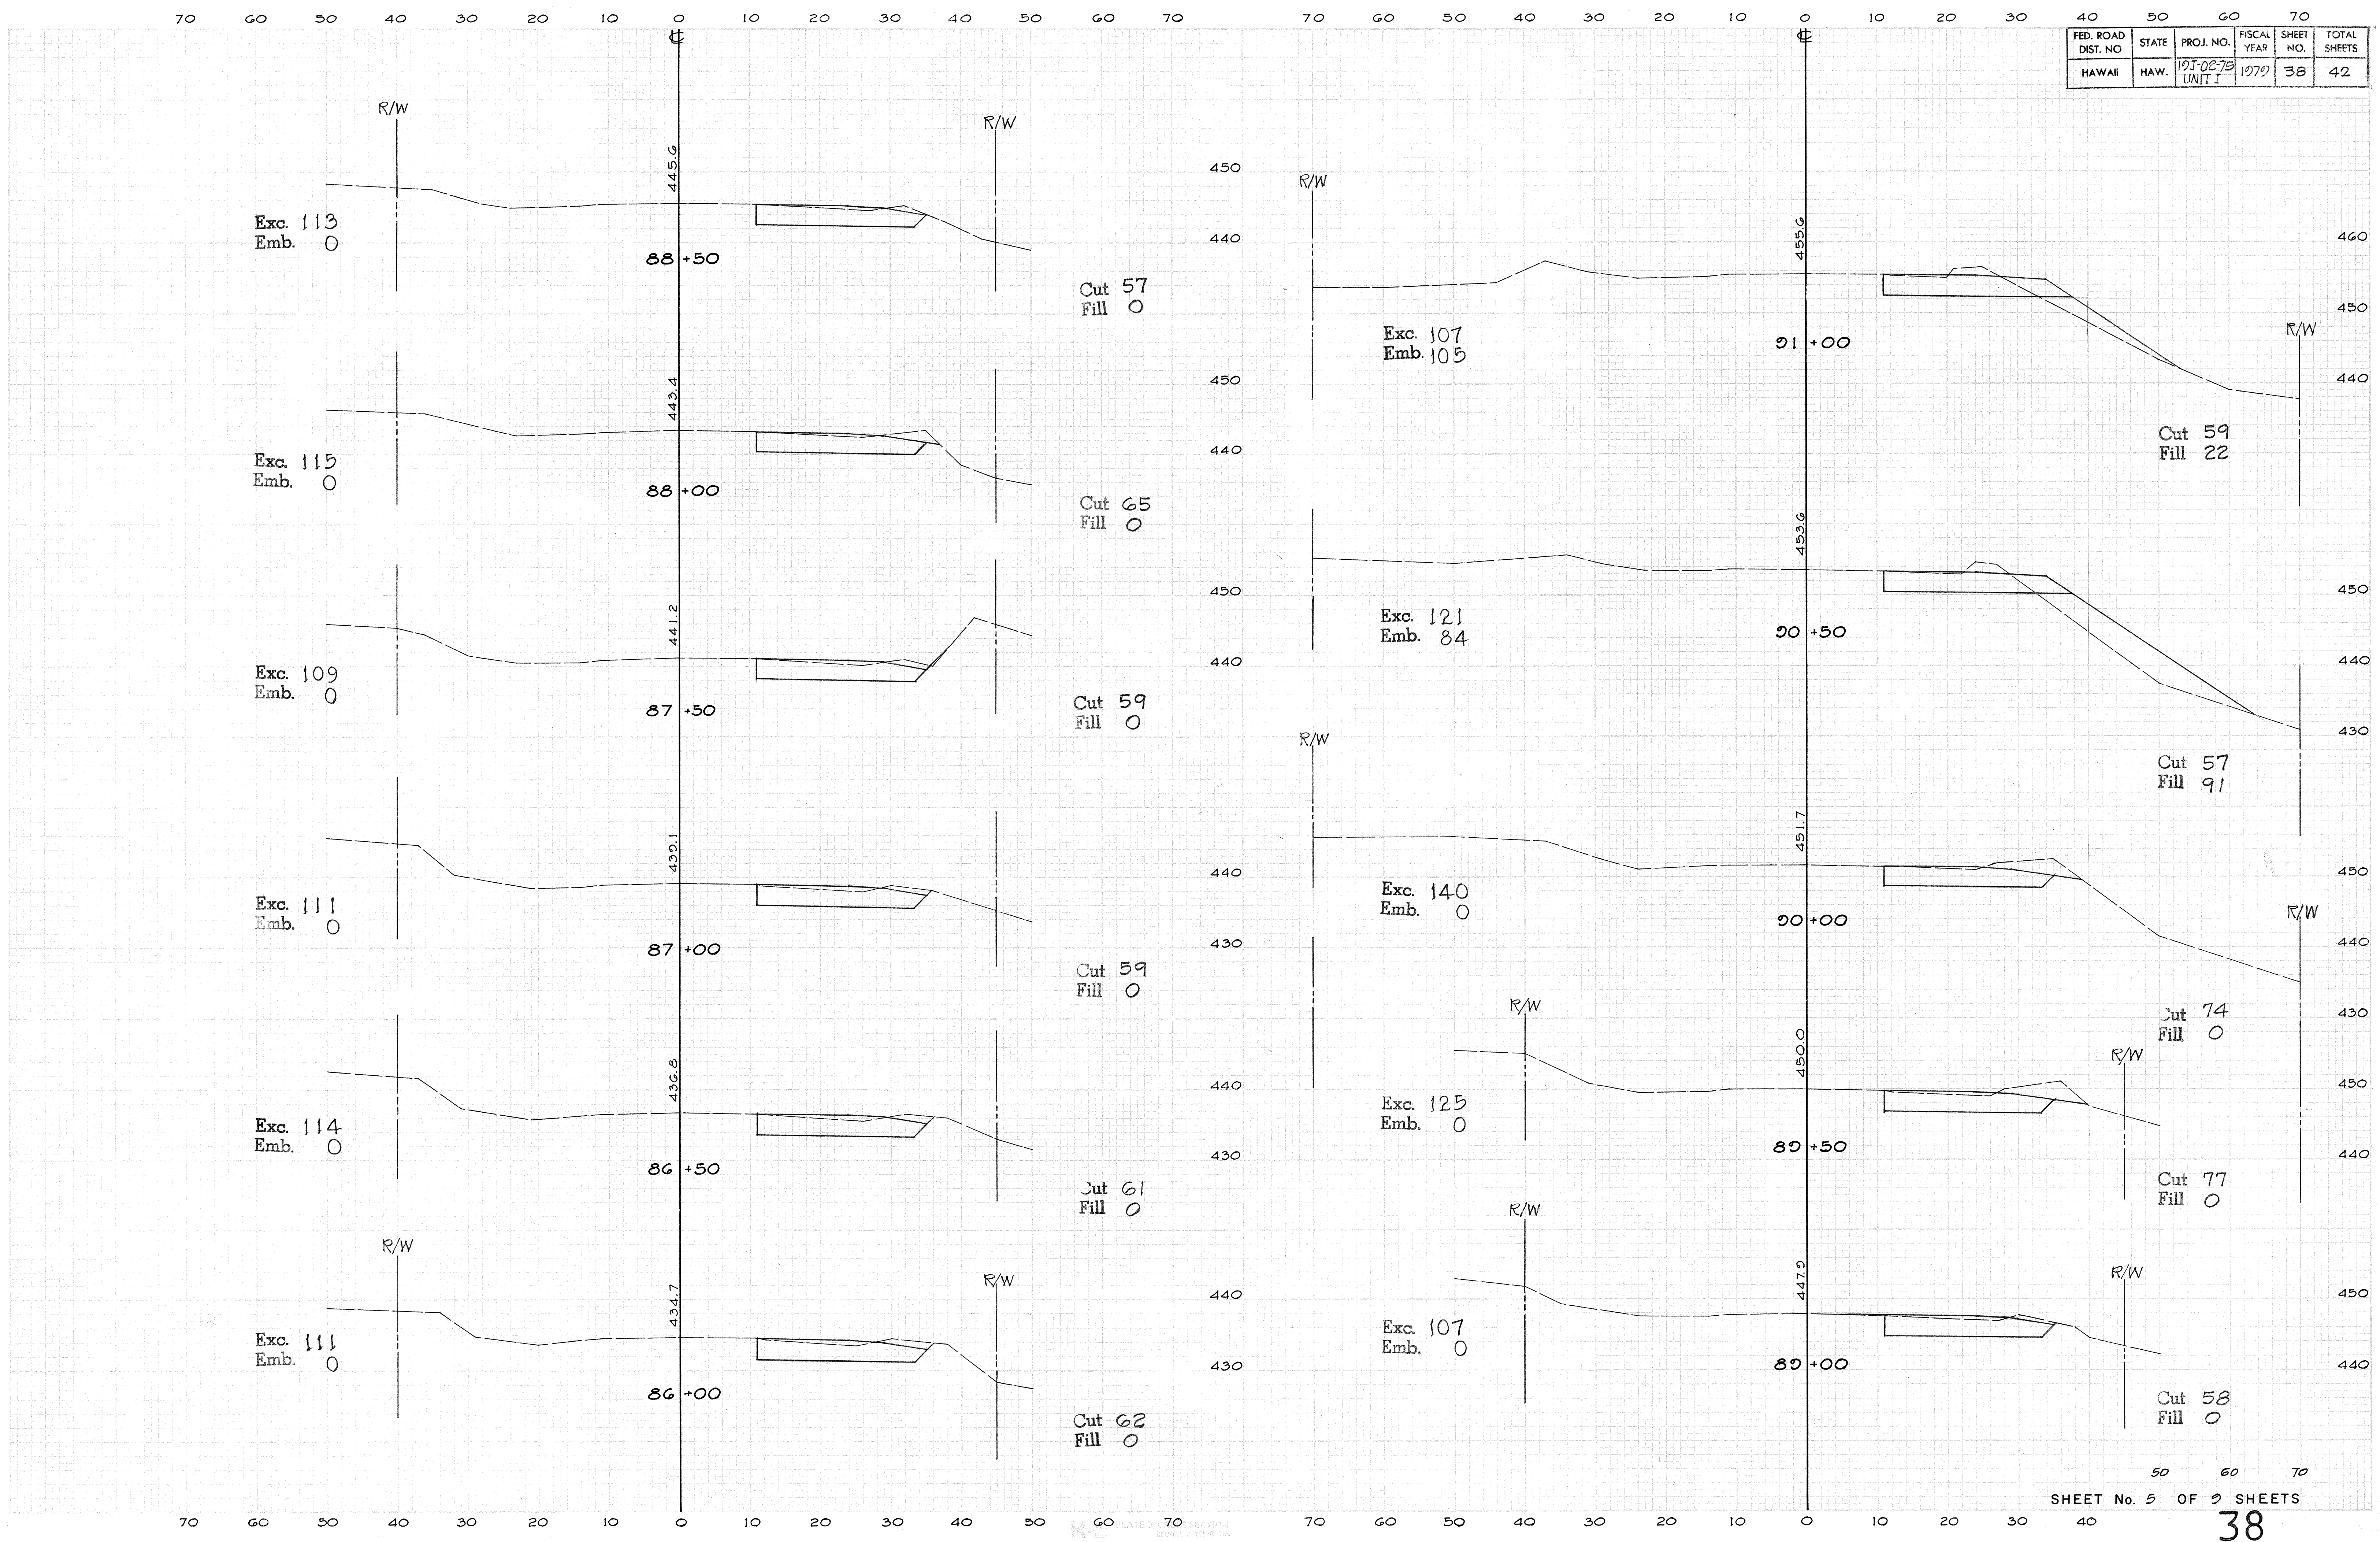

FED. ROAD DIST. NO.	STATE	PROJ. NO.	FISCAL YEAR	SHEET NO.	TOTAL SHEETS
HAWAII	HAW.	10T-02-75 UNIT I	1970	40	42

DATE: _____
 SURVEYED: _____
 SURVEY: _____
 NOTE BOOK: _____
 AREA: _____
 NO. _____

DATE: _____
 SURVEYED: _____
 SURVEY: _____
 NOTE BOOK: _____
 AREA: _____
 NO. _____

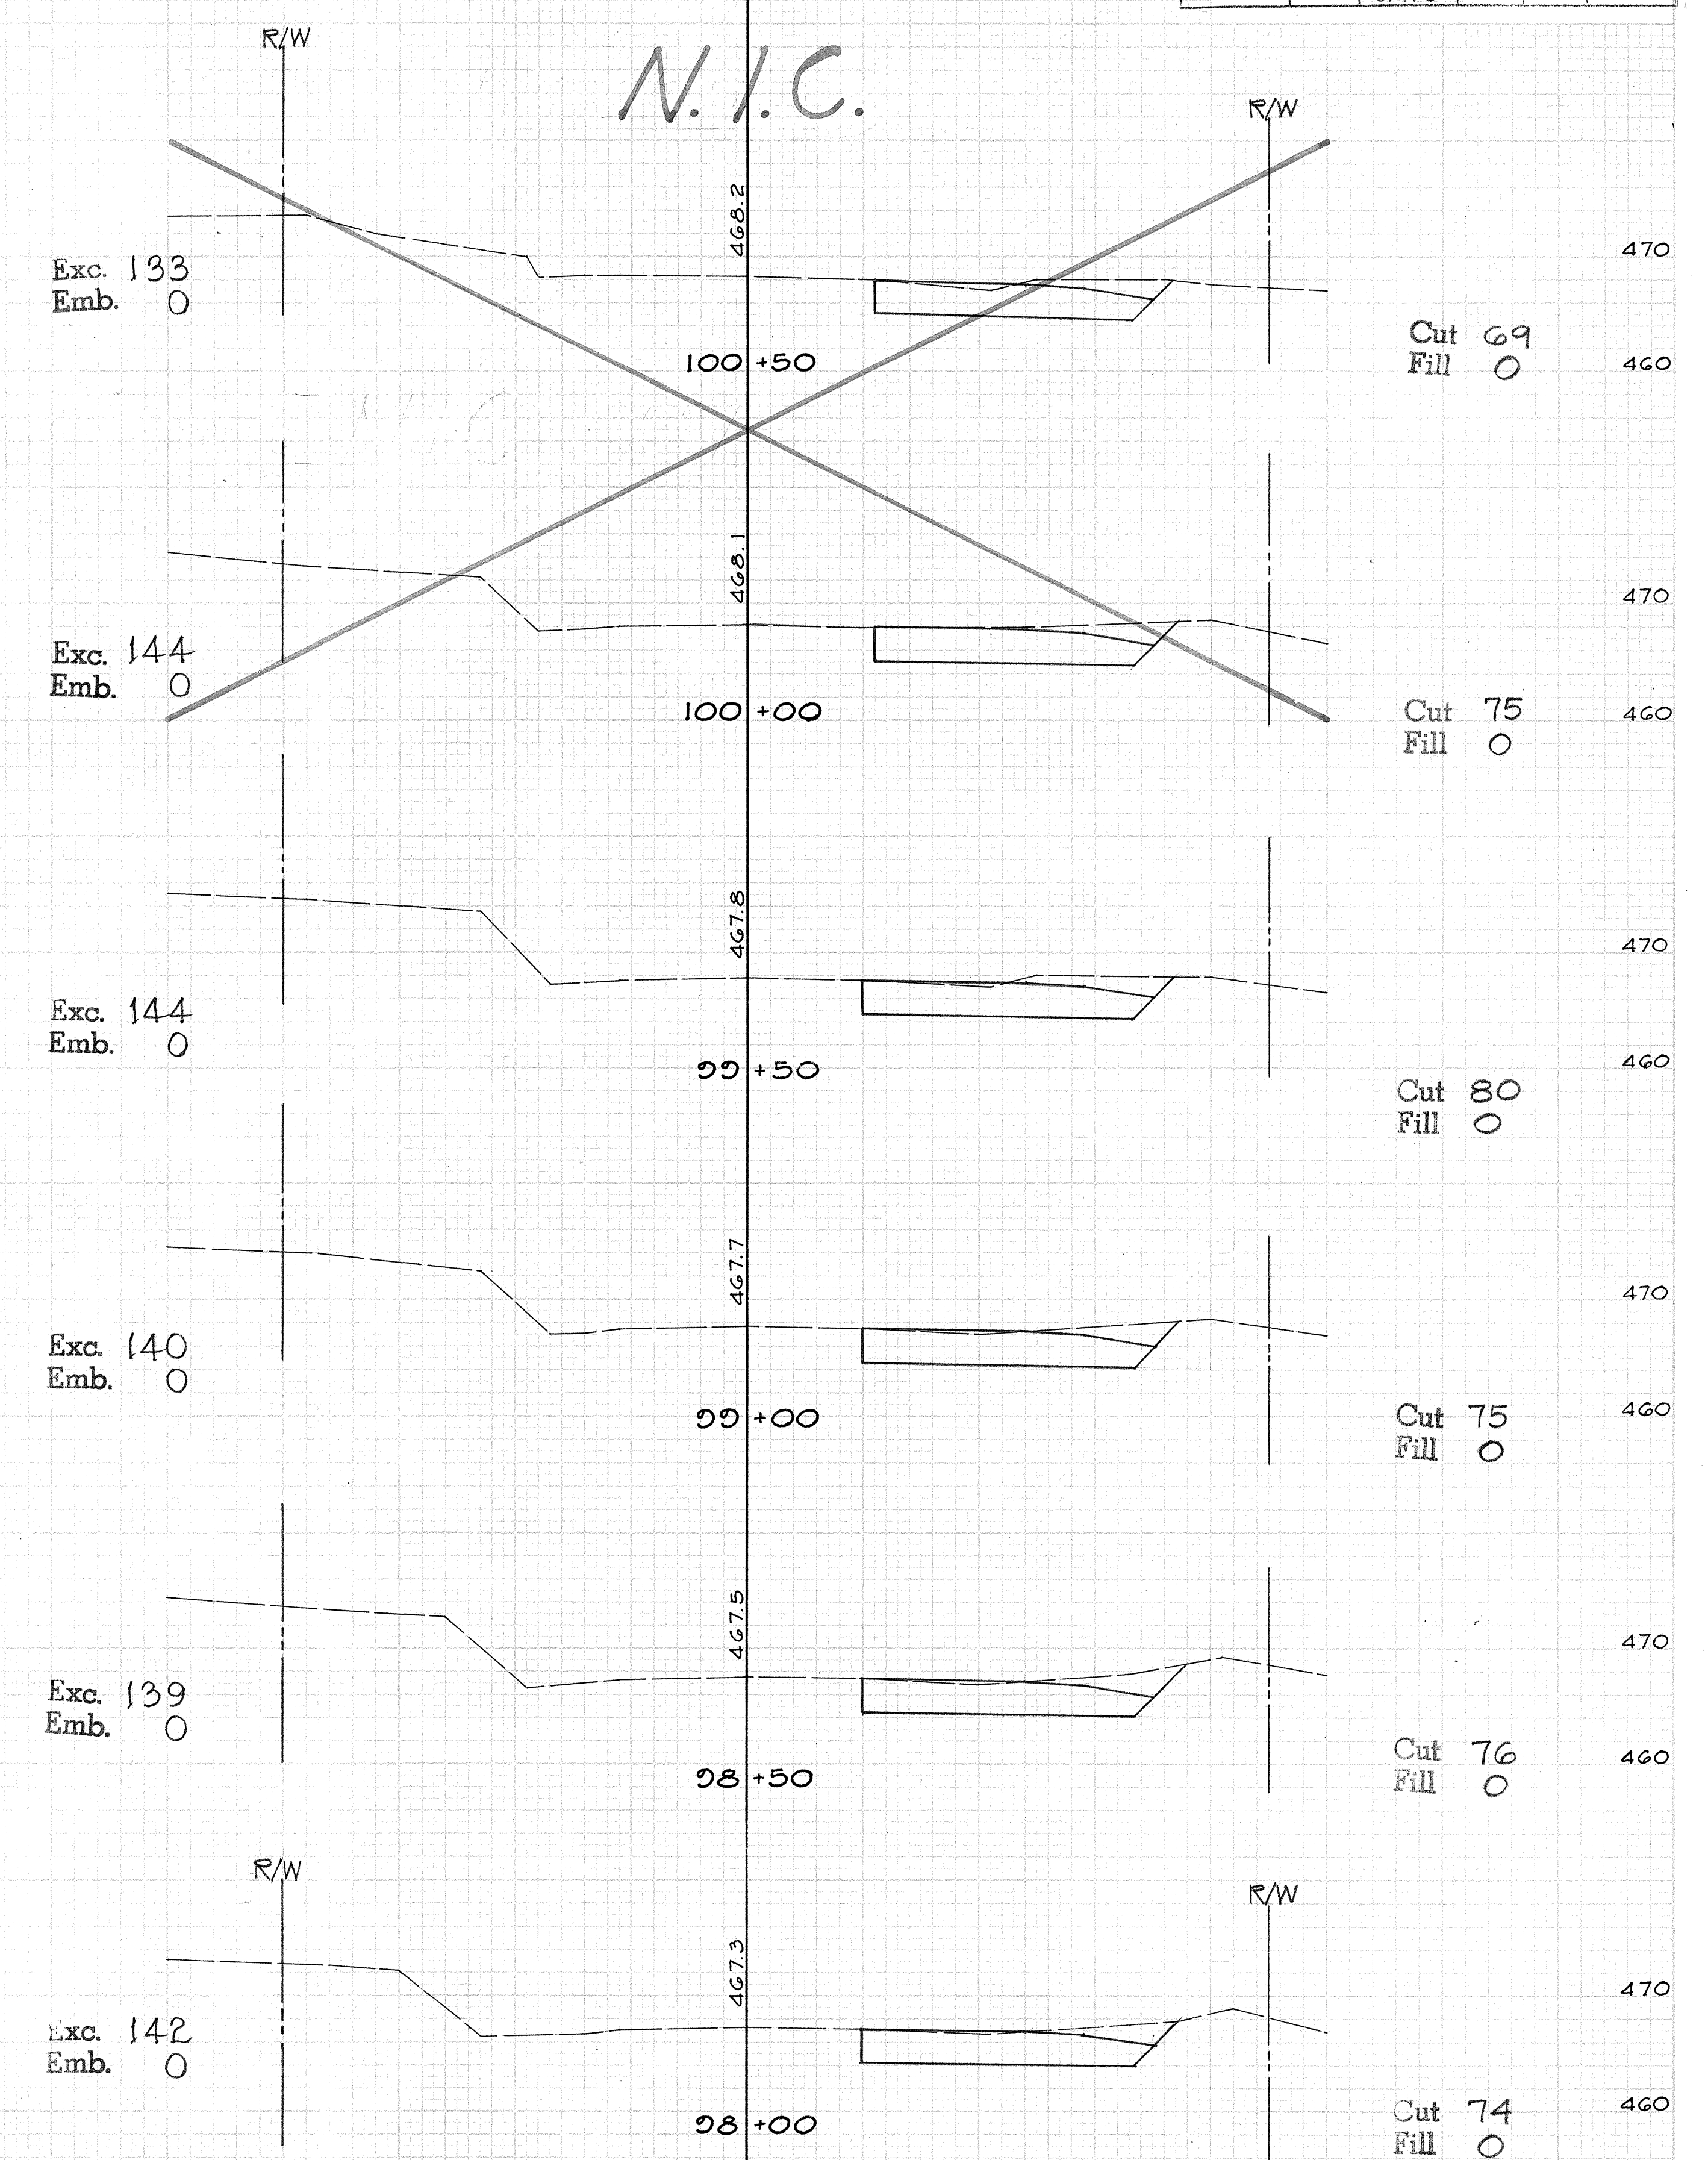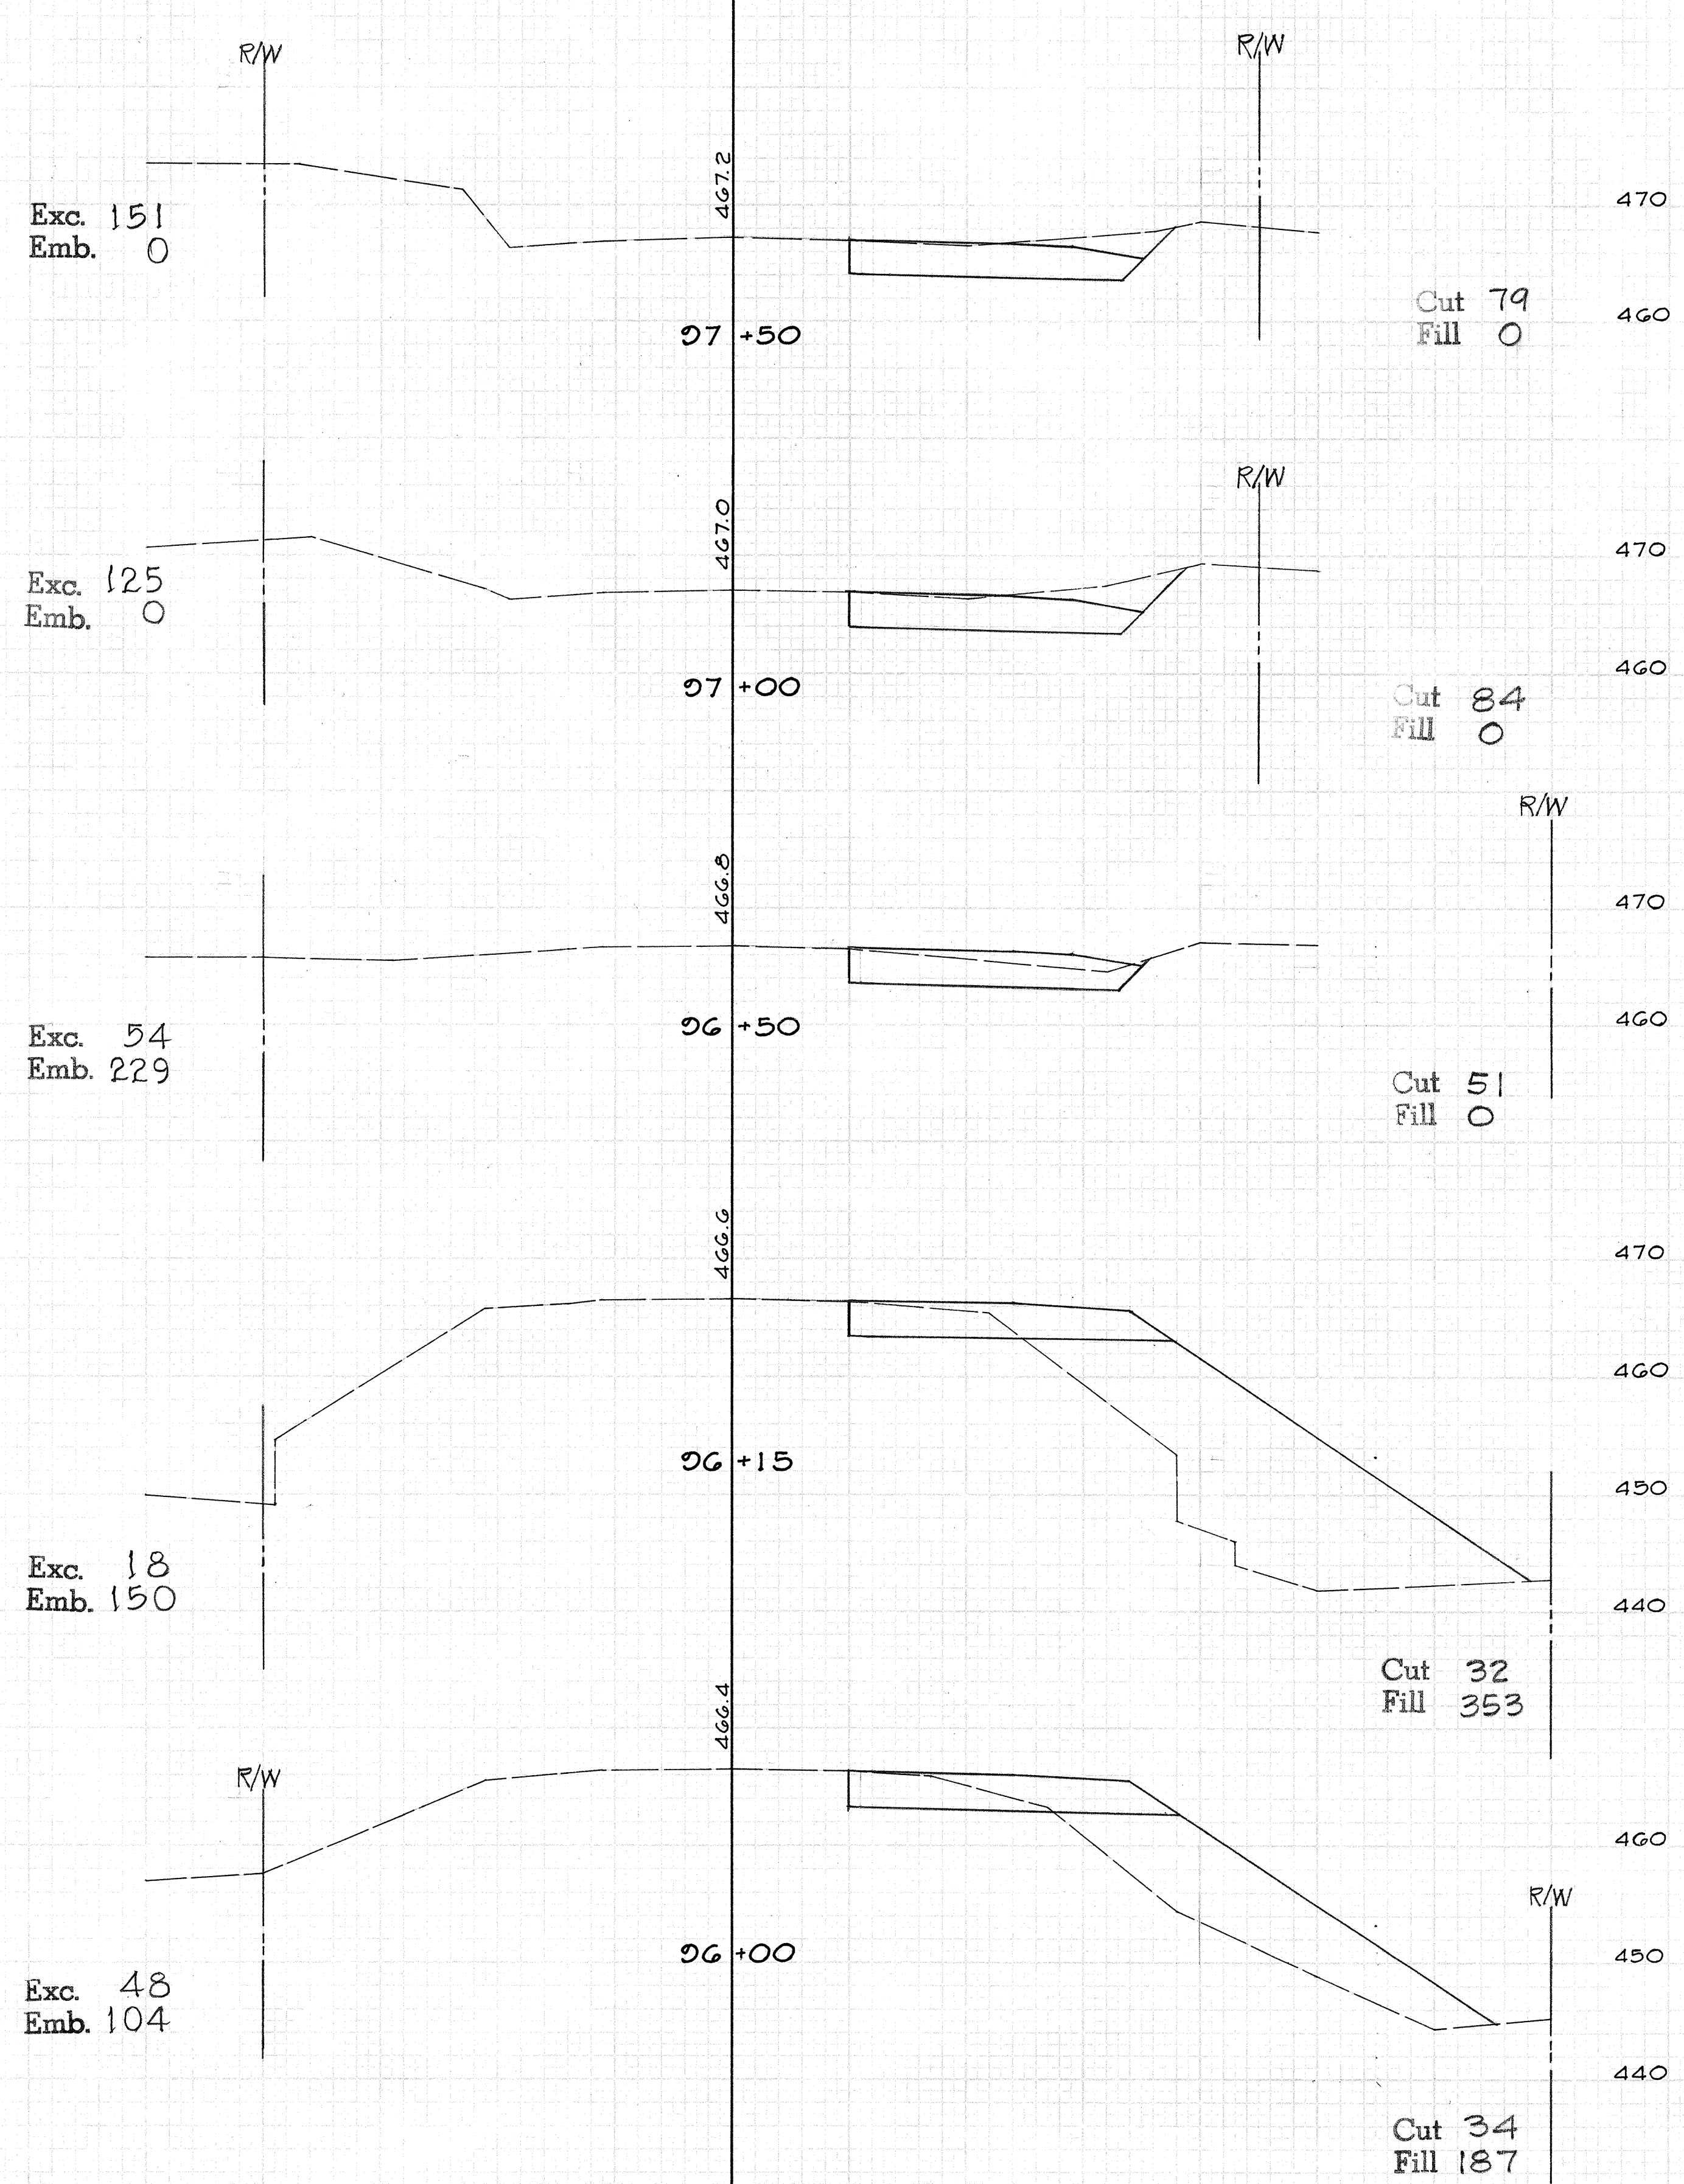

N.I.C.

FED. ROAD DIST. NO.	STATE	PROJ. NO.	FISCAL YEAR	SHEET NO.	TOTAL SHEETS
HAWAII	HAW.	101-02-75 UNIT I	1270	41	42

N.I.C.

Exc. 112
Emb. 0

103+50
469.7

Cut 65
Fill 0

Exc. 118
Emb. 0

105+50
472.7

Cut 65
Fill 0

Exc. 114
Emb. 0

103+00
469.1

Cut 56
Fill 0

Exc. 69
Emb. 105

105+00
471.7

Cut 62
Fill 0

Exc. 127
Emb. 0

102+50
468.8

Cut 67
Fill 0

Exc. 24
Emb. 41

104+64
470.9

Cut 41
Fill 158

Exc. 129
Emb. 0

102+00
468.5

Cut 70
Fill 0

Exc. 84
Emb. 0

104+50
470.8

Cut 51
Fill 0

Exc. 129
Emb. 0

101+50
468.3

Cut 69
Fill 0

Exc. 23
Emb. 0

104+10
470.1

Cut 62
Fill 0

Exc. 129
Emb. 0

101+00
468.3

Cut 70
Fill 0

Exc. 116
Emb. 0


104+00
470.0

Cut 60
Fill 0

SHEET No. 41 OF 9 SHEETS

41

FED. ROAD DIST. NO.	STATE	PROJ. NO.	FISCAL YEAR	SHEET NO.	TOTAL SHEETS
HAWAII	HAW.	101-02-75 UNIT I	1970	42	42

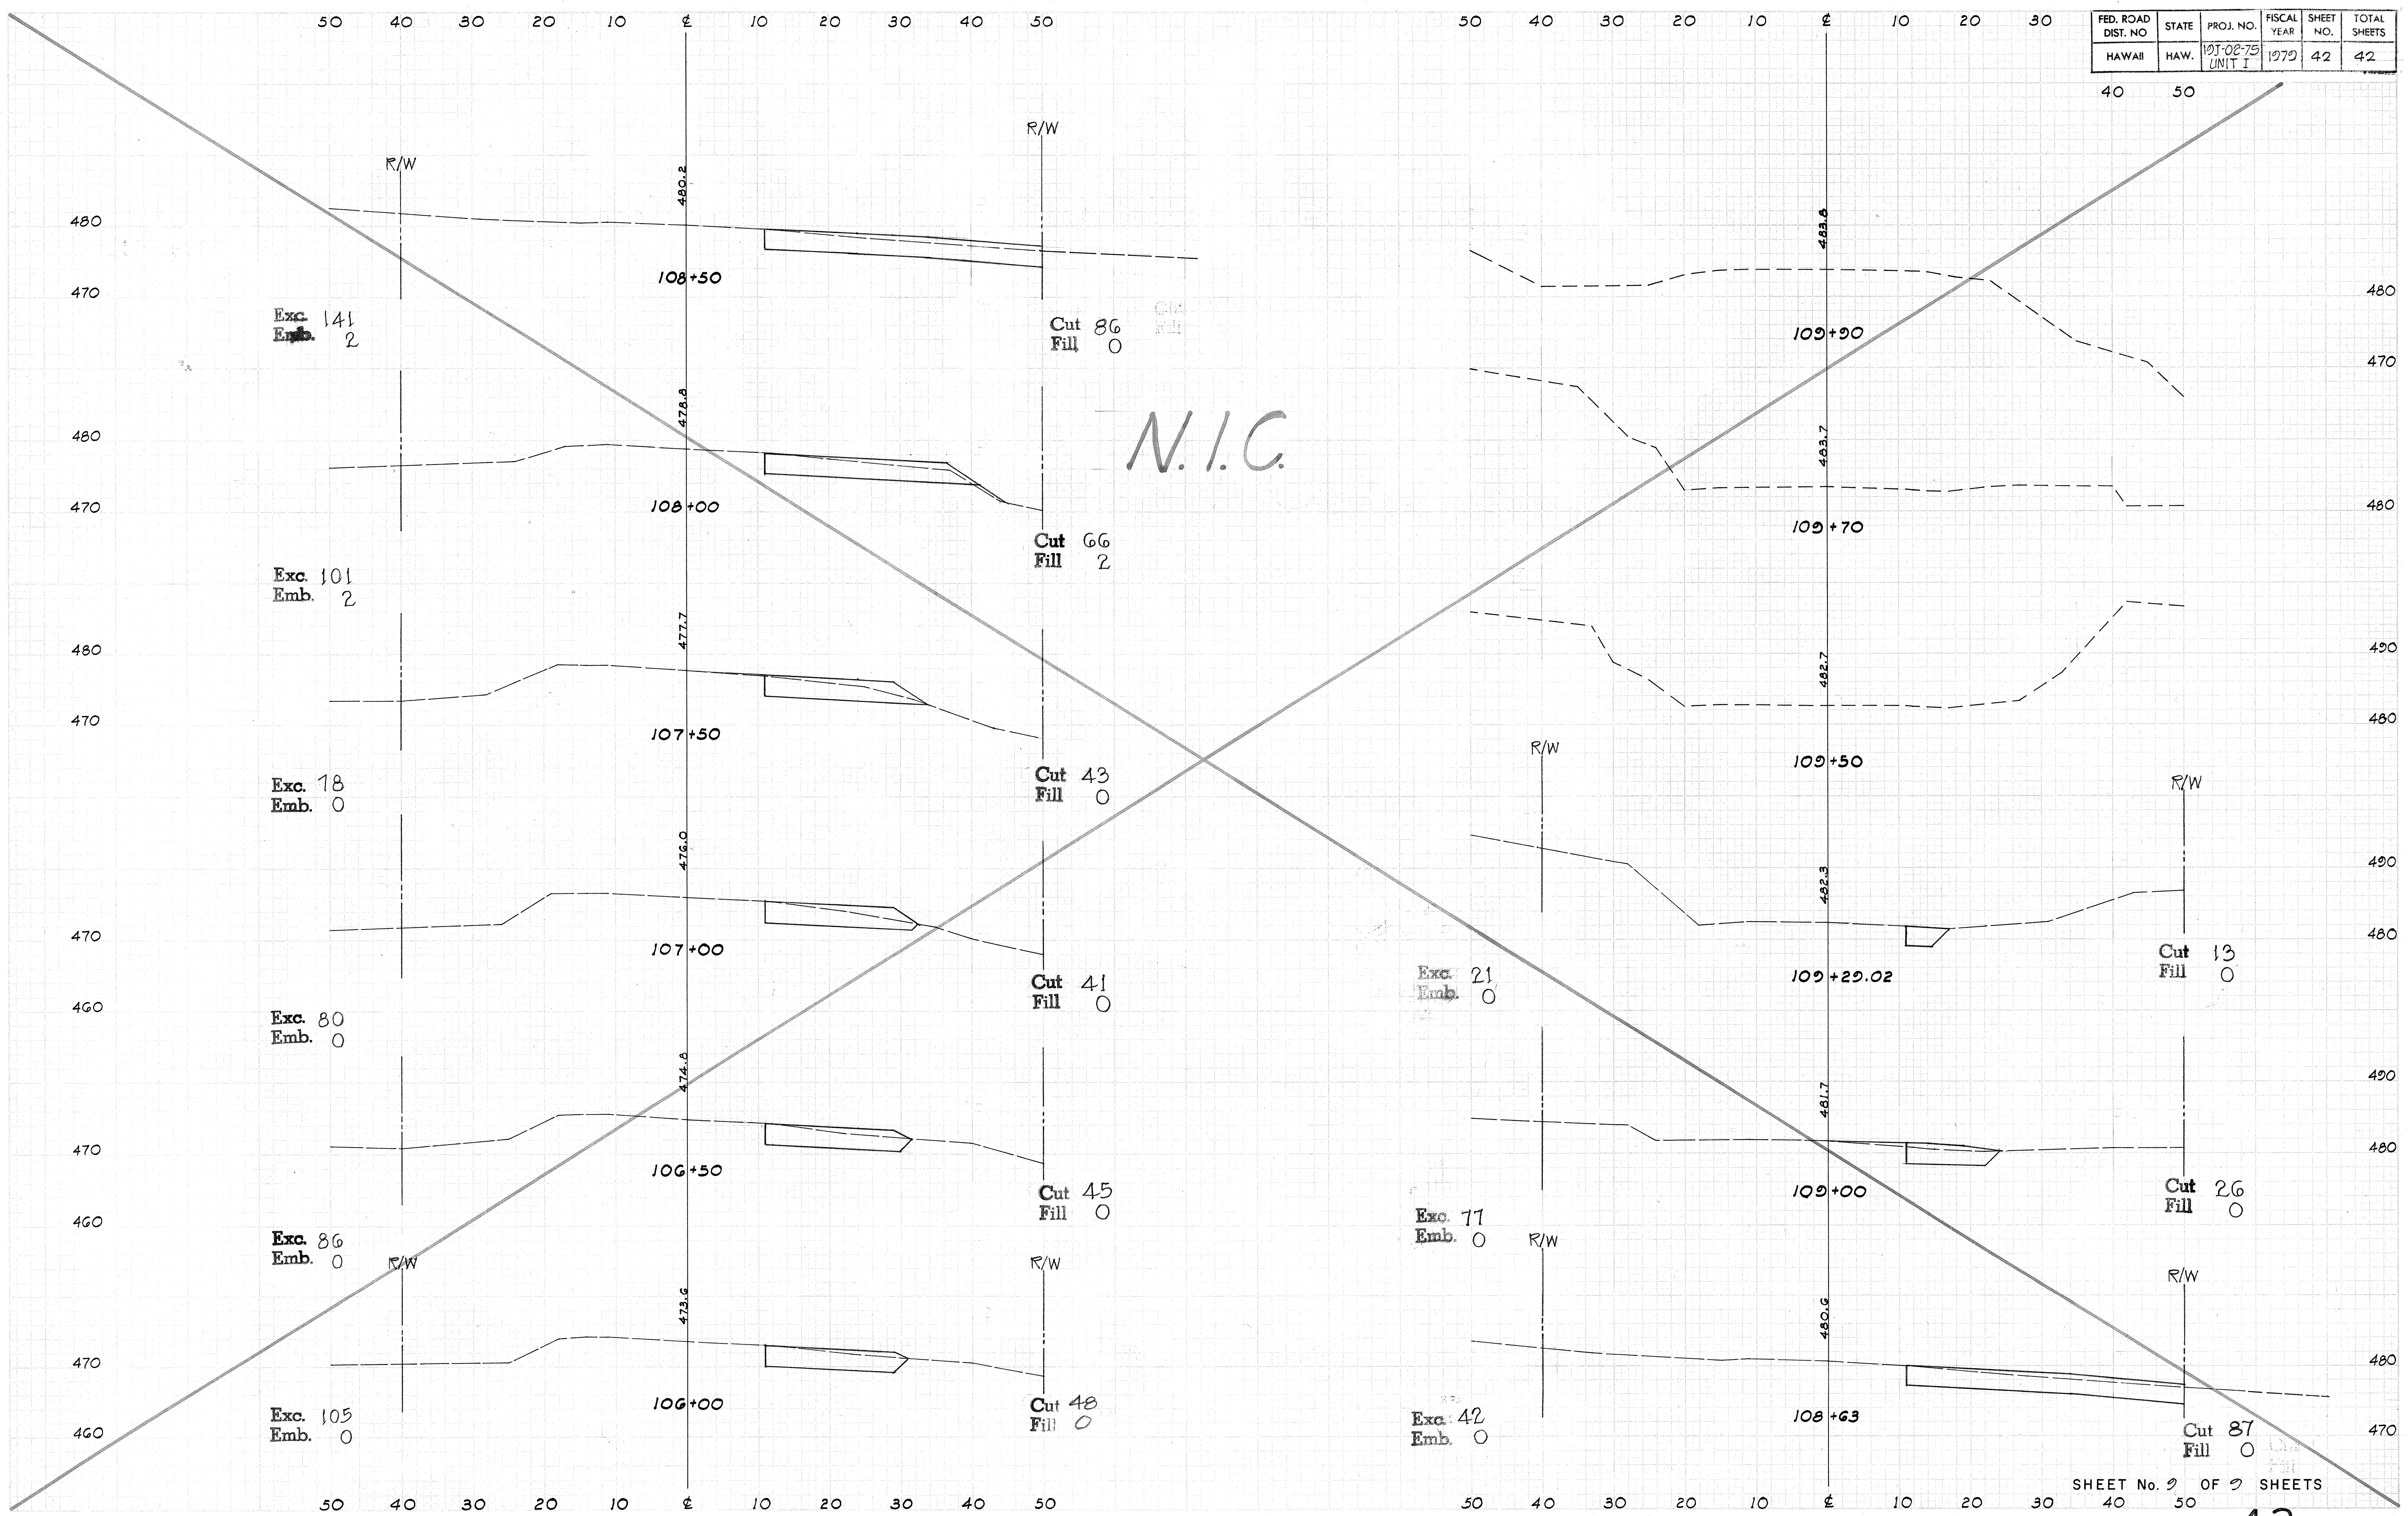

SHEET No. 42 OF 42 SHEETS