


FED. ROAD DIST. NO.	STATE	PROJ. NO.	FISCAL YEAR	SHEET NO.	TOTAL SHEETS
HAWAII	HAW.	10J-02-75 UNIT I	1979	7	42

CURVE DATA				
	3	4	5	6
Δ	39°00'	141°00'	39°00'	15°00'
R	100.00	15.00	80.00	115.00
T	35.41	42.36	28.33	15.14
C	66.76	28.28	53.41	30.02
Lc	68.07	36.91	54.45	30.11

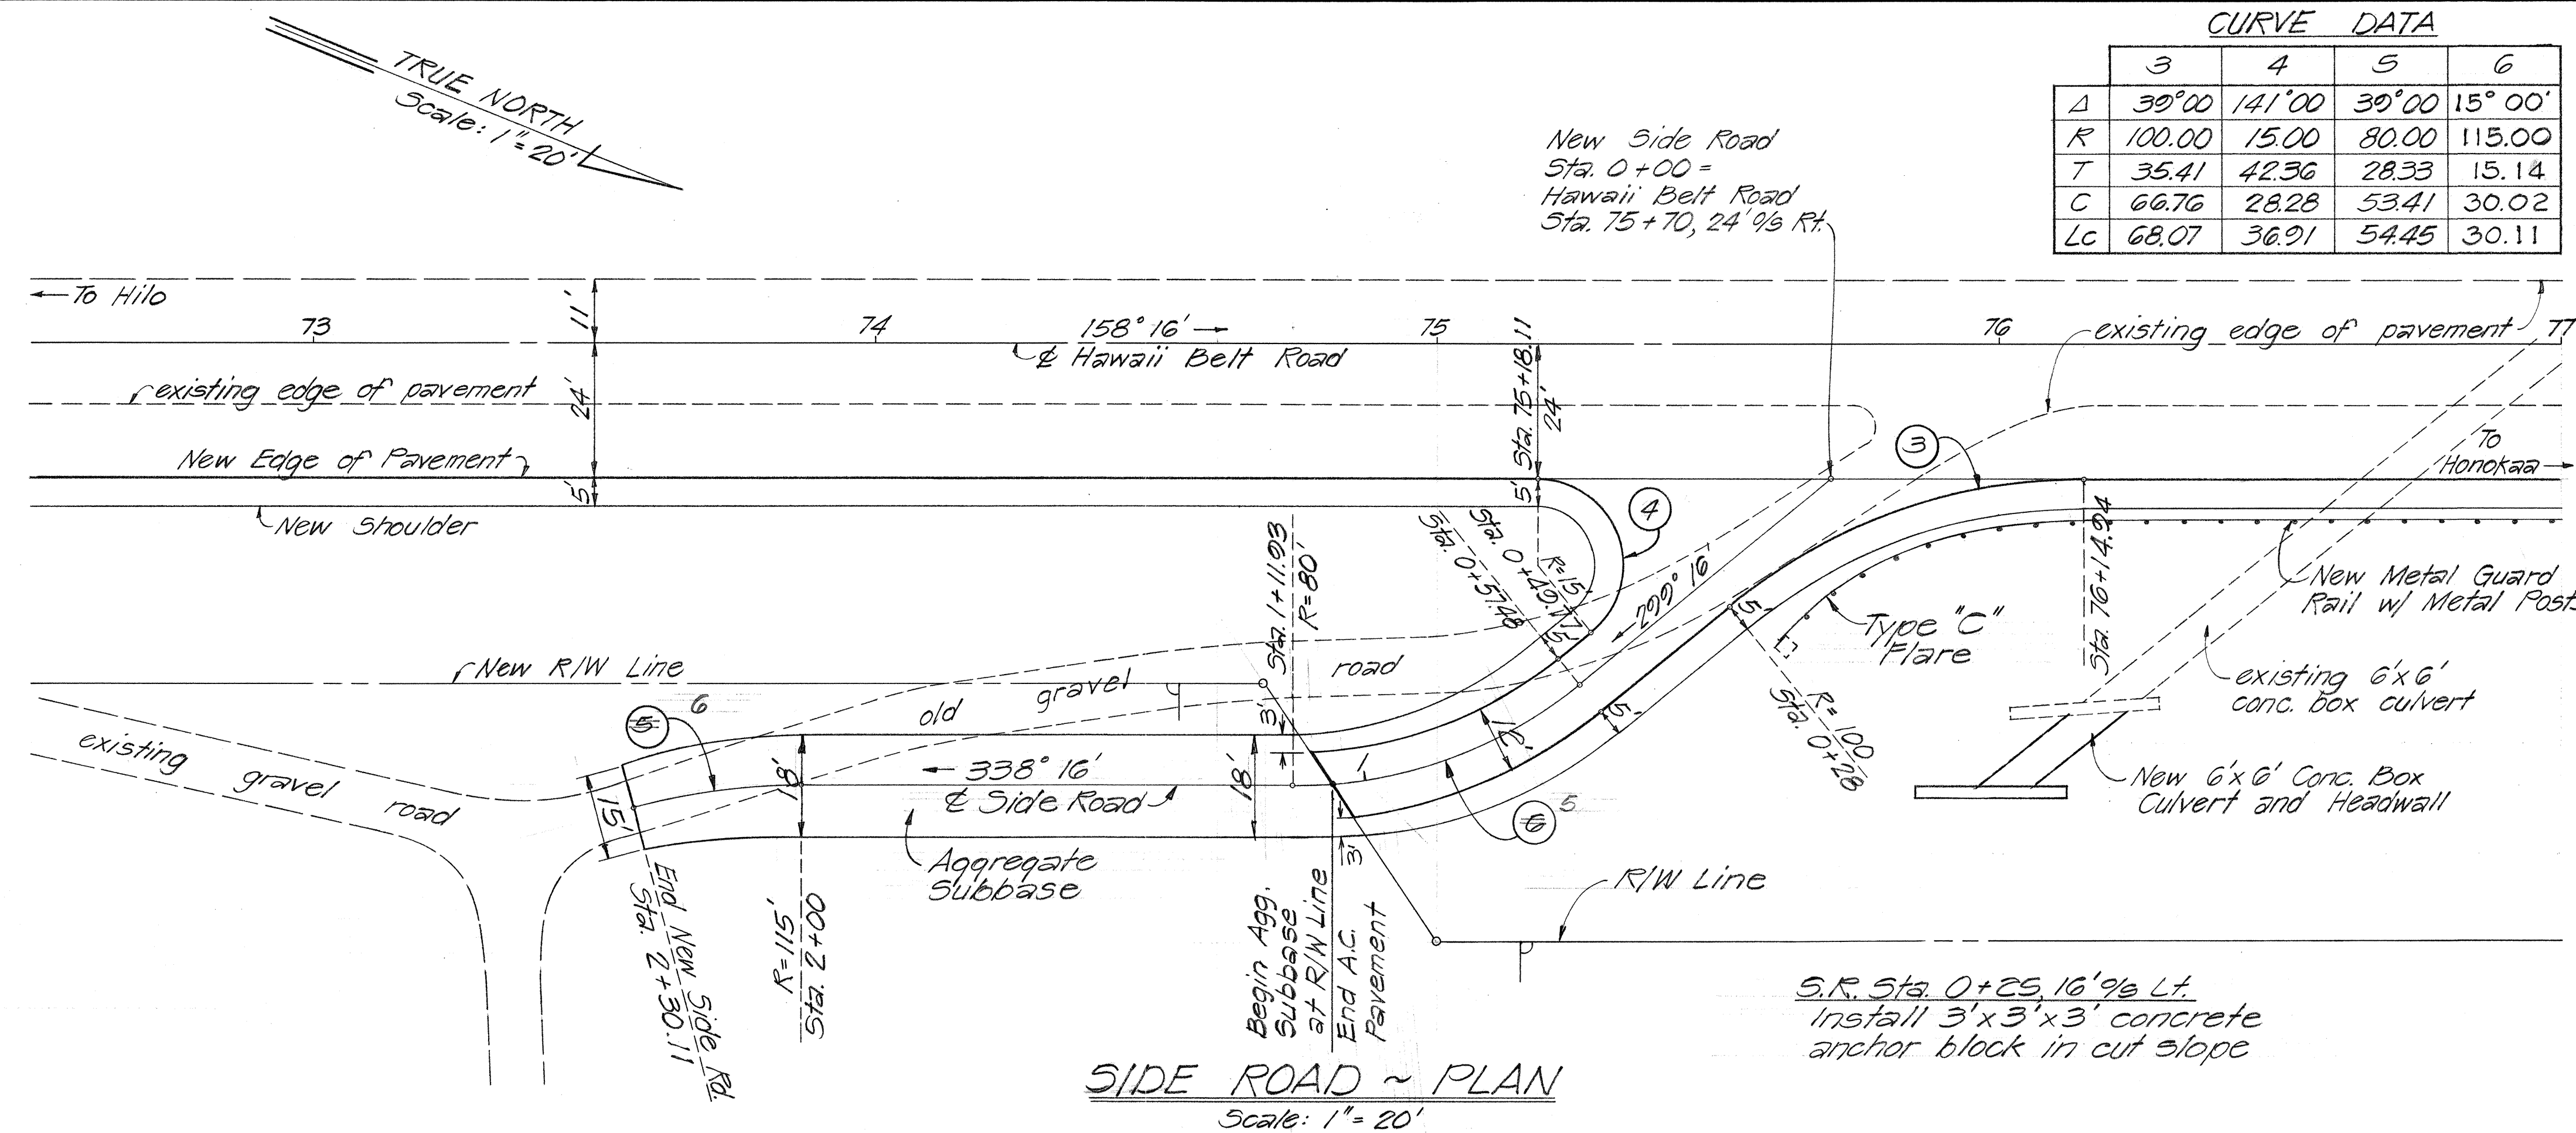


ESTIMATED QUANTITIES

PAYEMENT AREA: (STA. 0+00 TO 1+05)

Excavation	475 C.Y.
Aggregate Subbase	188 C.Y.
Aggregate Base	49 C.Y.
Prime Coat	77 Gal.
A.C. Pavement, Mix III	26 Tons
A.C. Pavement, Mix V	22 Tons

GRAVEL AREA: (STA. 1+05 TO 2+30.11)

Excavation	187 C.Y.
Aggregate Subbase	137 C.Y.

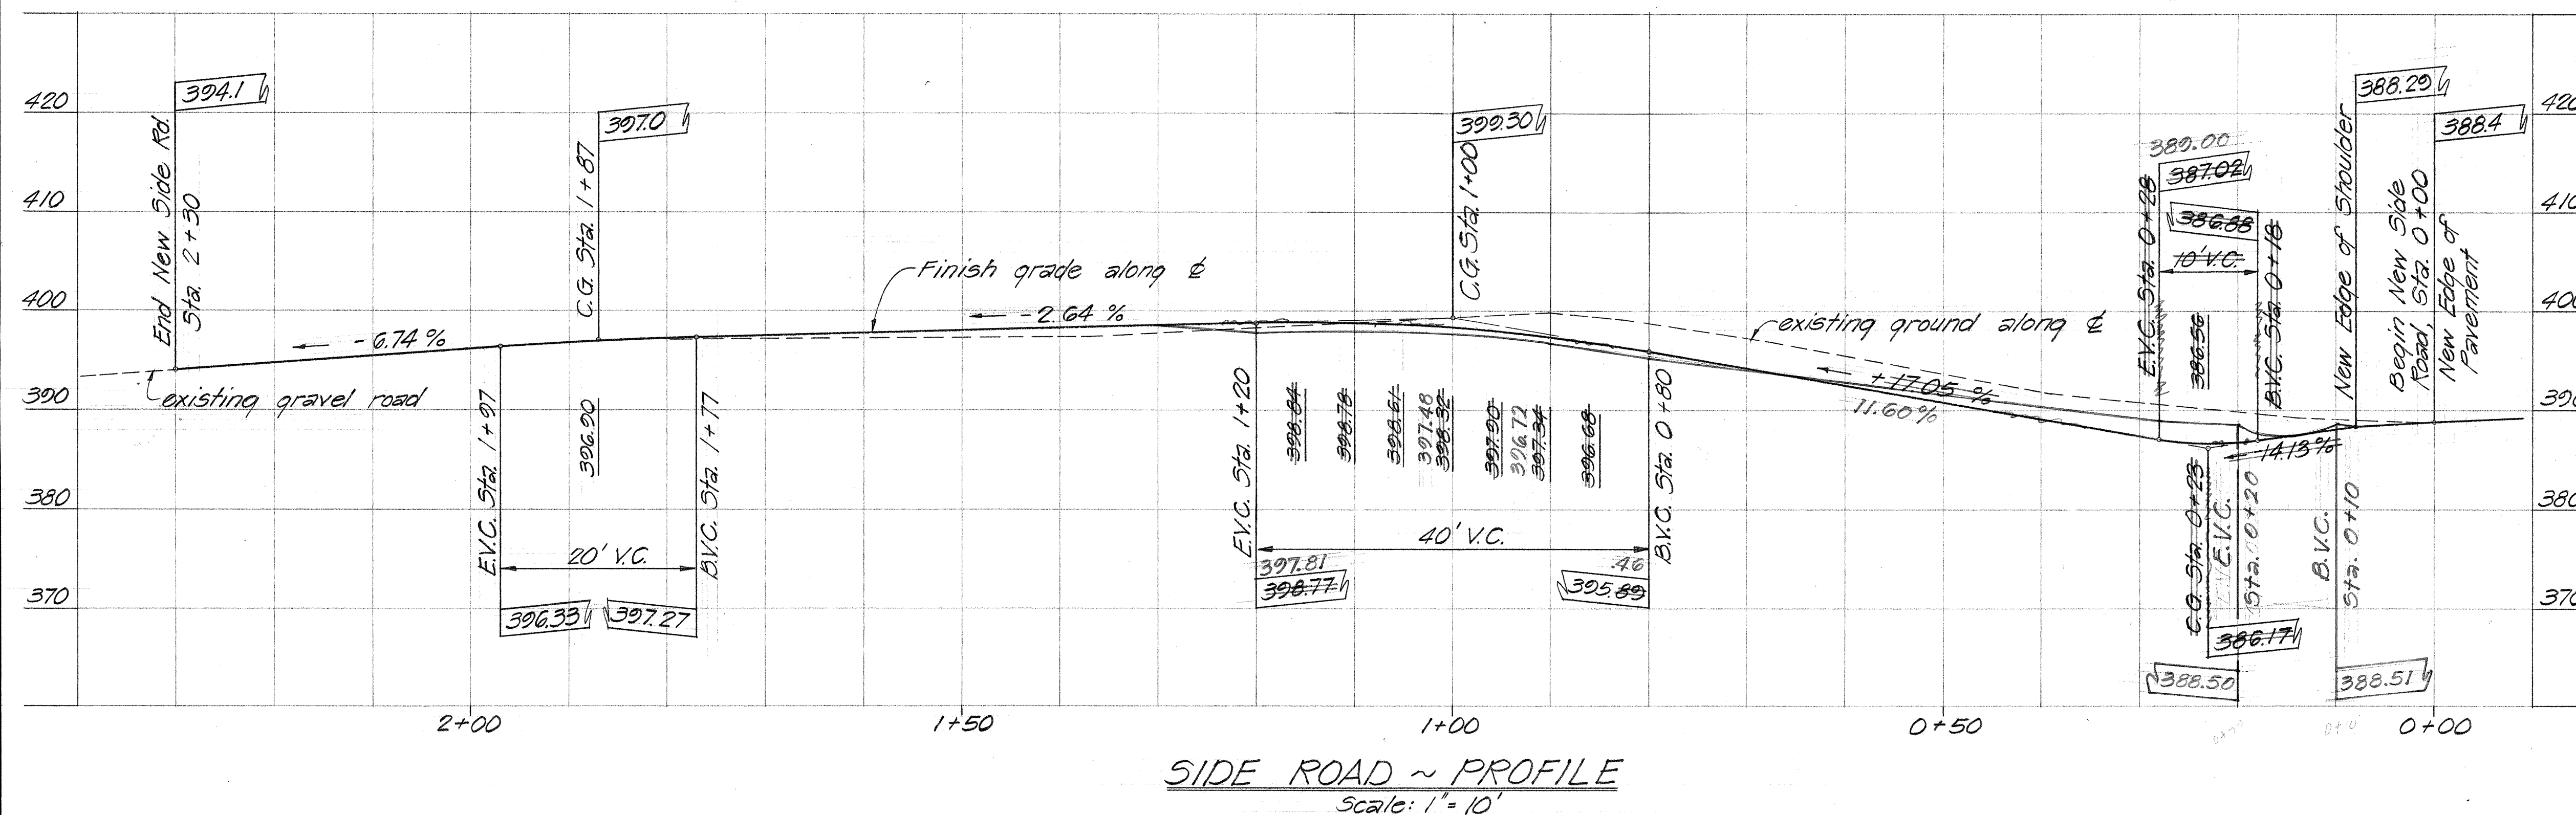

STATE OF HAWAII
DEPARTMENT OF TRANSPORTATION
HIGHWAYS DIVISION

**SIDE ROAD
CONNECTION DETAILS
STATION 75+70 RT.**

HAWAII BELT ROAD
TRUCK CLIMBING LANE
AT PEPEKEO

PROJ. NO. 10J-02-75, UNIT I
Scale: As Shown Date: Sept. 1978

SHEET No. 1 OF 1 SHEETS