
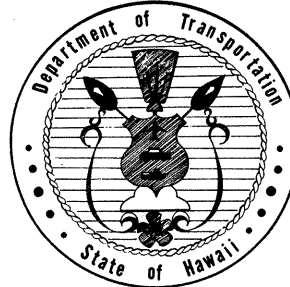


INDEX TO DRAWINGS	
SHEET NO.	DESCRIPTION
1	TITLE SHEET
2	TYPICAL SECTIONS
3-6	PLAN & PROFILE
7	SIDEROAD CONNECTION DETAIL
8-13	DRAINAGE DETAILS
14-15	TRAFFIC SIGNS, STRIPING AND PAVEMENT MARKERS
16-33	MISC. & STANDARD DETAILS
34-42	CROSS SECTIONS

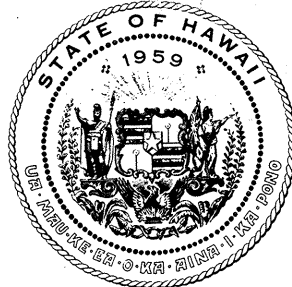


STATE OF HAWAII
DEPARTMENT OF TRANSPORTATION
LAND TRANSPORTATION FACILITIES DIVISION
"AS BUILT"
PLANS FOR
CONSTRUCTION OF

HAWAII BELT ROAD
TRUCK CLIMBING LANE AT PEPEEKEO
(Hanawi Stream Bridge to Kawainui Stream Bridge)
PROJ. NO. 19J-02-75, UNIT I

DISTRICT OF SOUTH HILO
ISLAND OF HAWAII

FED. ROAD DIST. NO.	STATE	PROJ. NO.	FISCAL YEAR	SHEET NO.	TOTAL SHEETS
HAWAII	HAW.	19J-02-75 UNIT I	1979	1	42

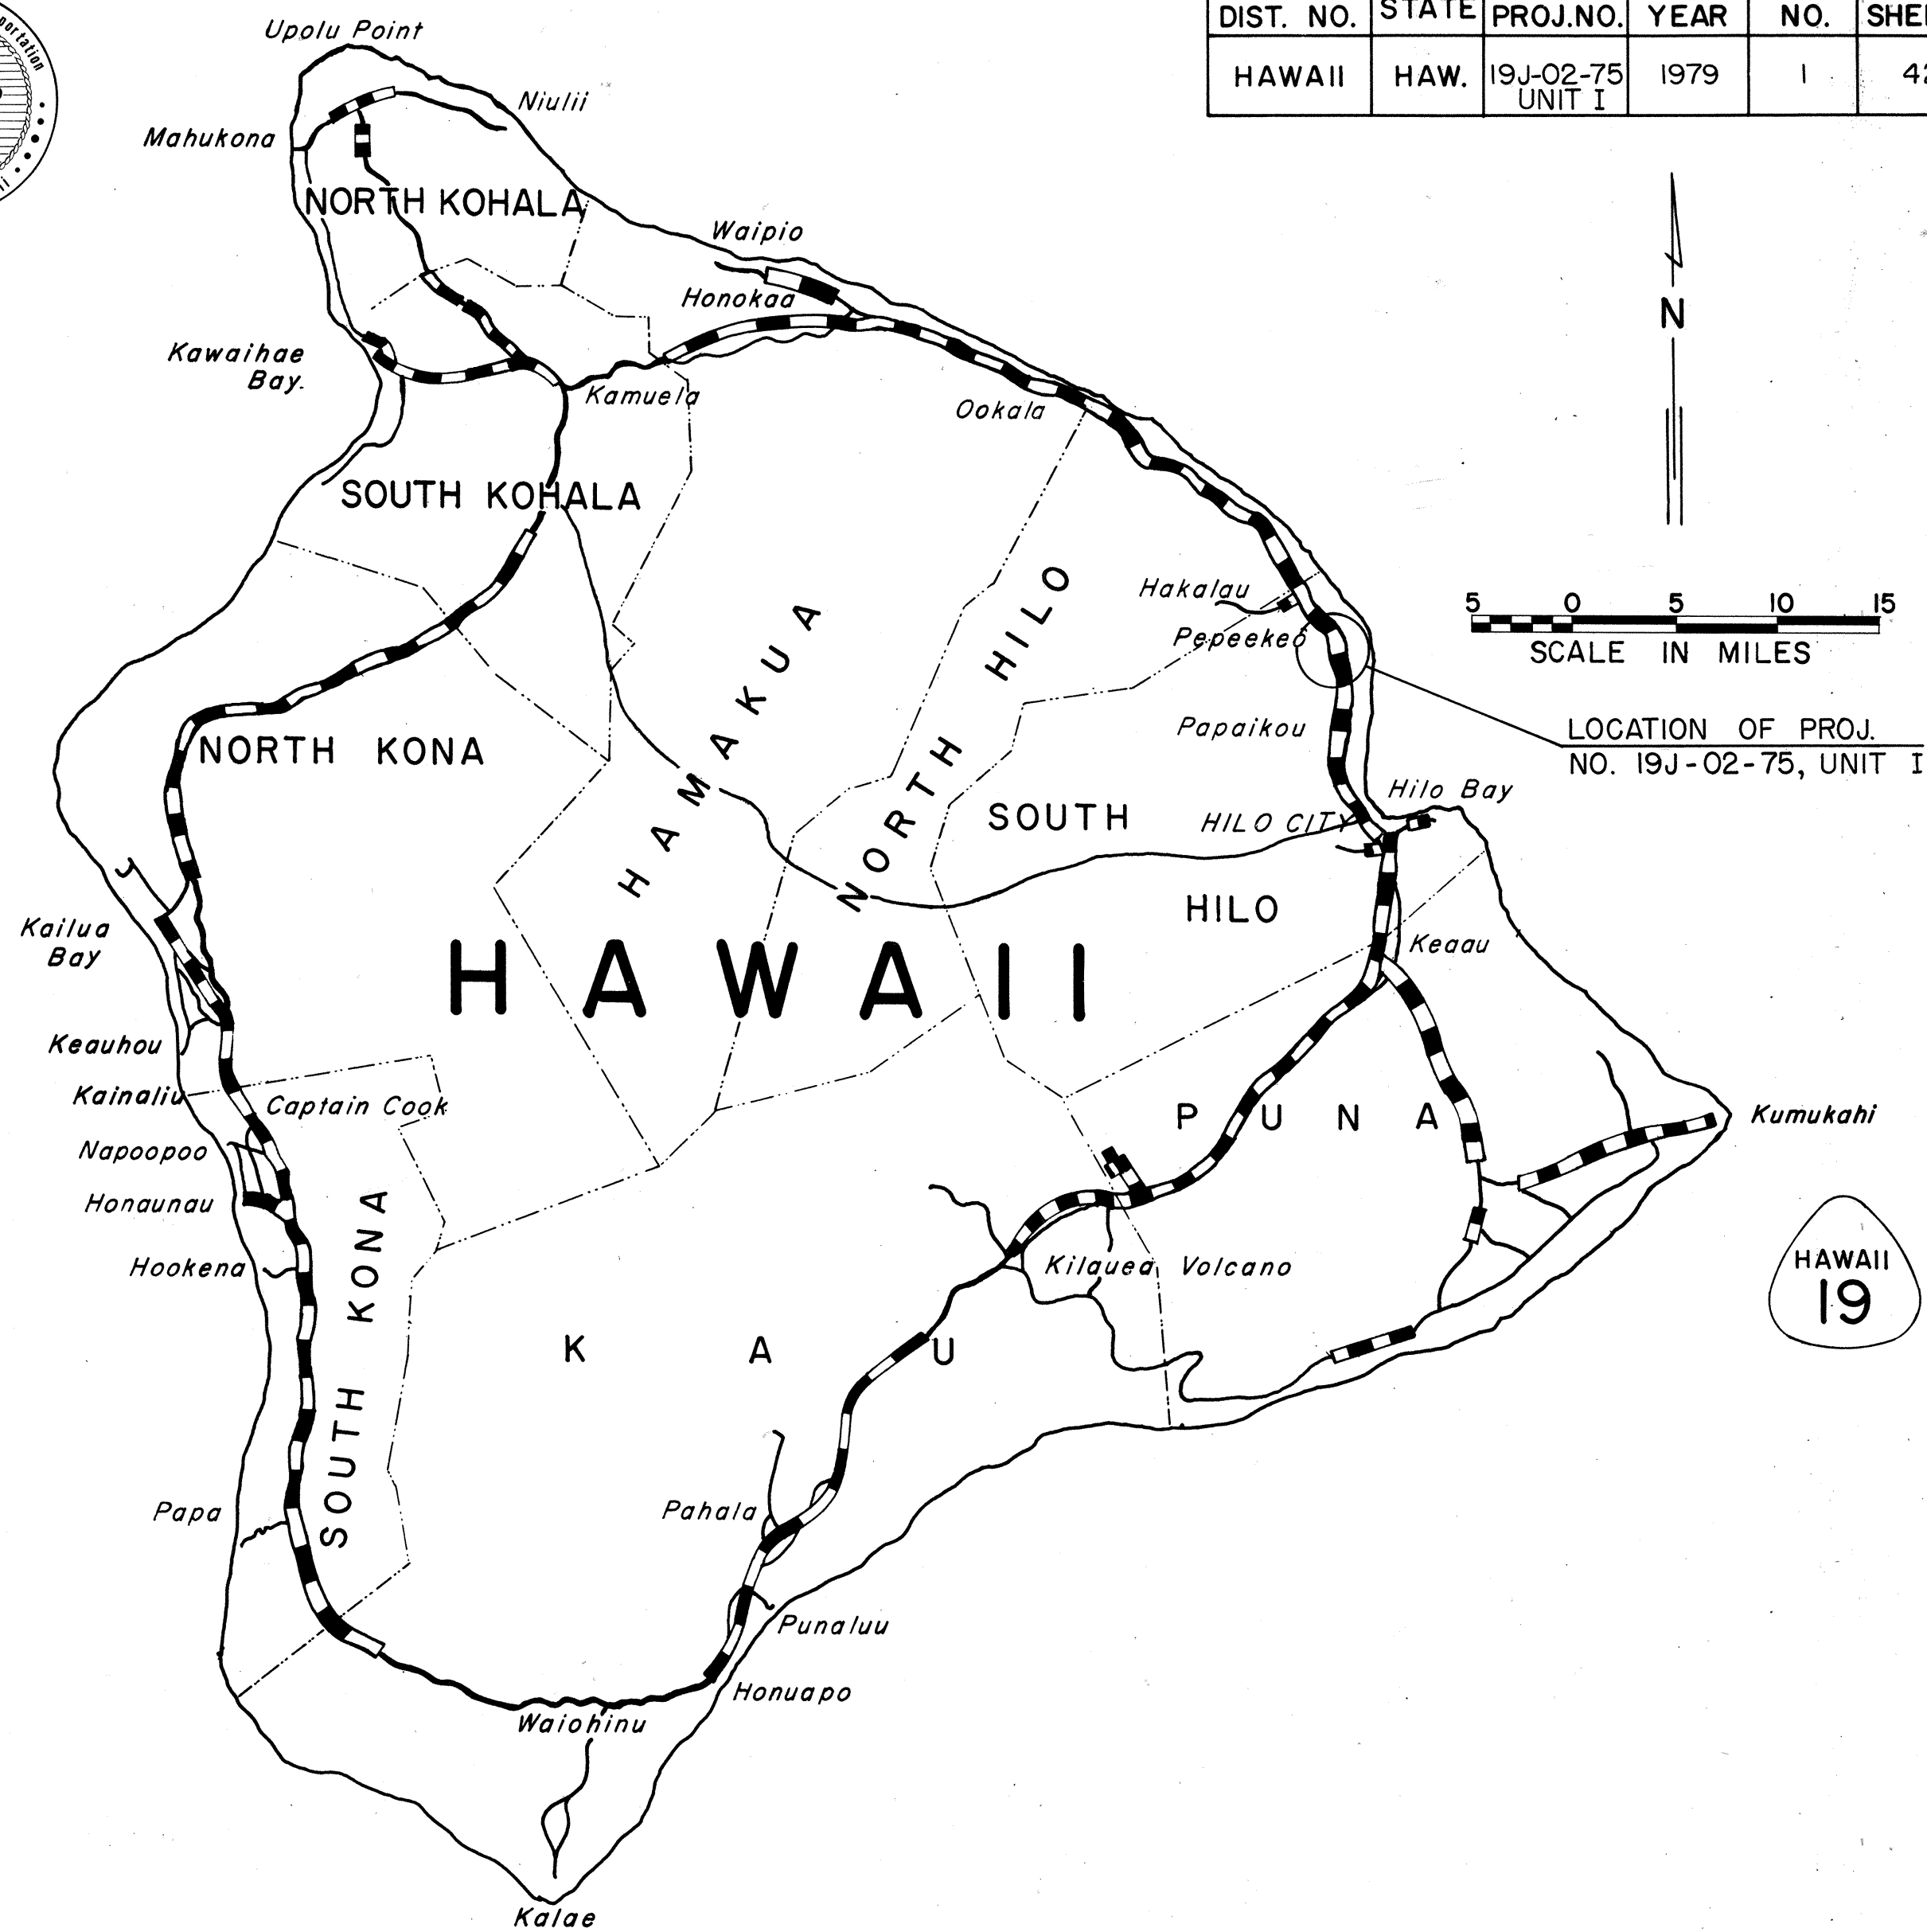

Federal Aid Projects Previously Constructed Or Under Construction

ALL CHANGES MADE DURING CONSTRUCTION HAVE BEEN INCORPORATED ON THESE PLANS IN RED EXCEPT CHANGES IN THE ORIGINAL THEORETICAL QUANTITIES. FOR ACTUAL QUANTITIES, REFER TO PROJECT LEDGER AND/OR COMPUTATION BOOK.

Anthony J. Vincent
RESIDENT ENGINEER

5/16/80
DATE

DESIGN CLASSIFICATION


CURRENT ADT (1979) 8,600
DESIGN ADT (1999) 15,100
DHV 1,300
D 60/40

T₂₄ 5.5%
V 60 MPH

CONTRACT NO.: 10,447
UTILITY AGREEMENT NO.: 686 (TELEPHONE)
CONTRACTOR: JAS. W. GLOVER, LTD.

DEPARTMENT OF TRANSPORTATION STATE OF HAWAII	
APPROVED:	
<i>Ryokichi Higashionna</i>	4/27/79
DIR. OF TRANSPORTATION	DATE

HAWAII DISTRICT
DESIGNED BY
M. MIURA
P. S. & E. BY
548-7490
APRIL 1979
DATE
PHONE

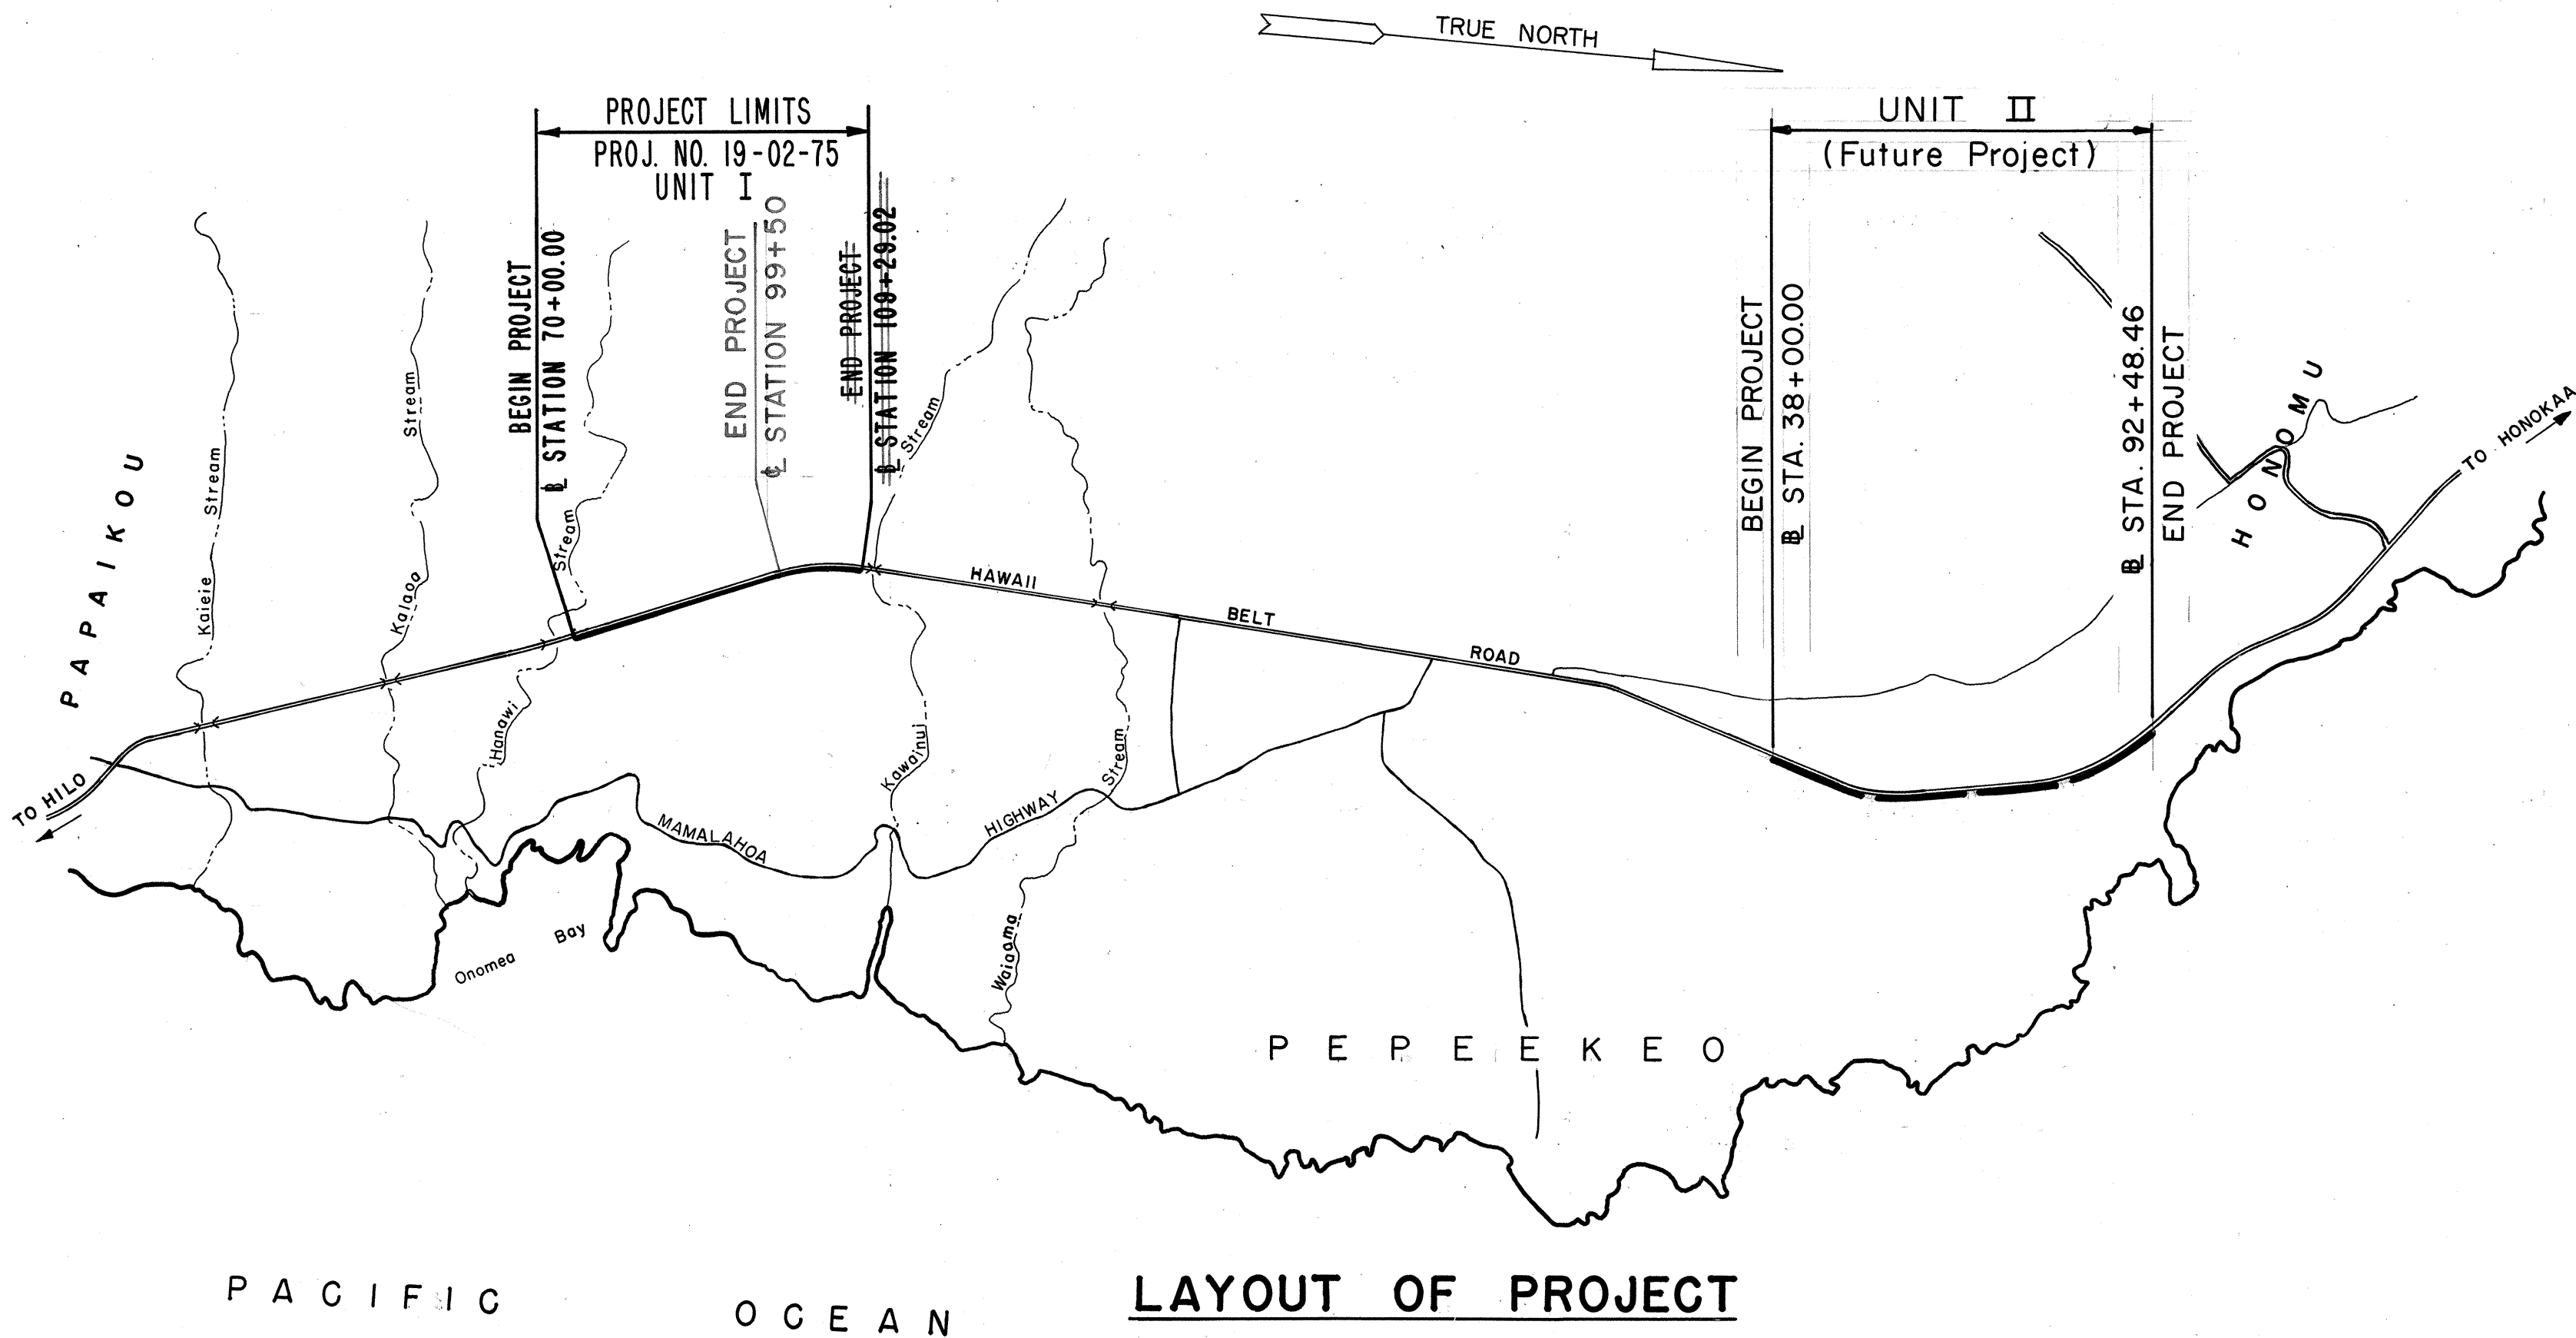

LAYOUT OF PROJECT
SCALE: 1" = 2000'

GROSS LENGTH OF PROJECT 0.744 Mi.