


FED. ROAD DIST. NO.	STATE	PROJ. NO.	FISCAL YEAR	SHEET NO.	TOTAL SHEETS
HAWAII	HAW.	19J-02-75 UNIT I	1979	14	42

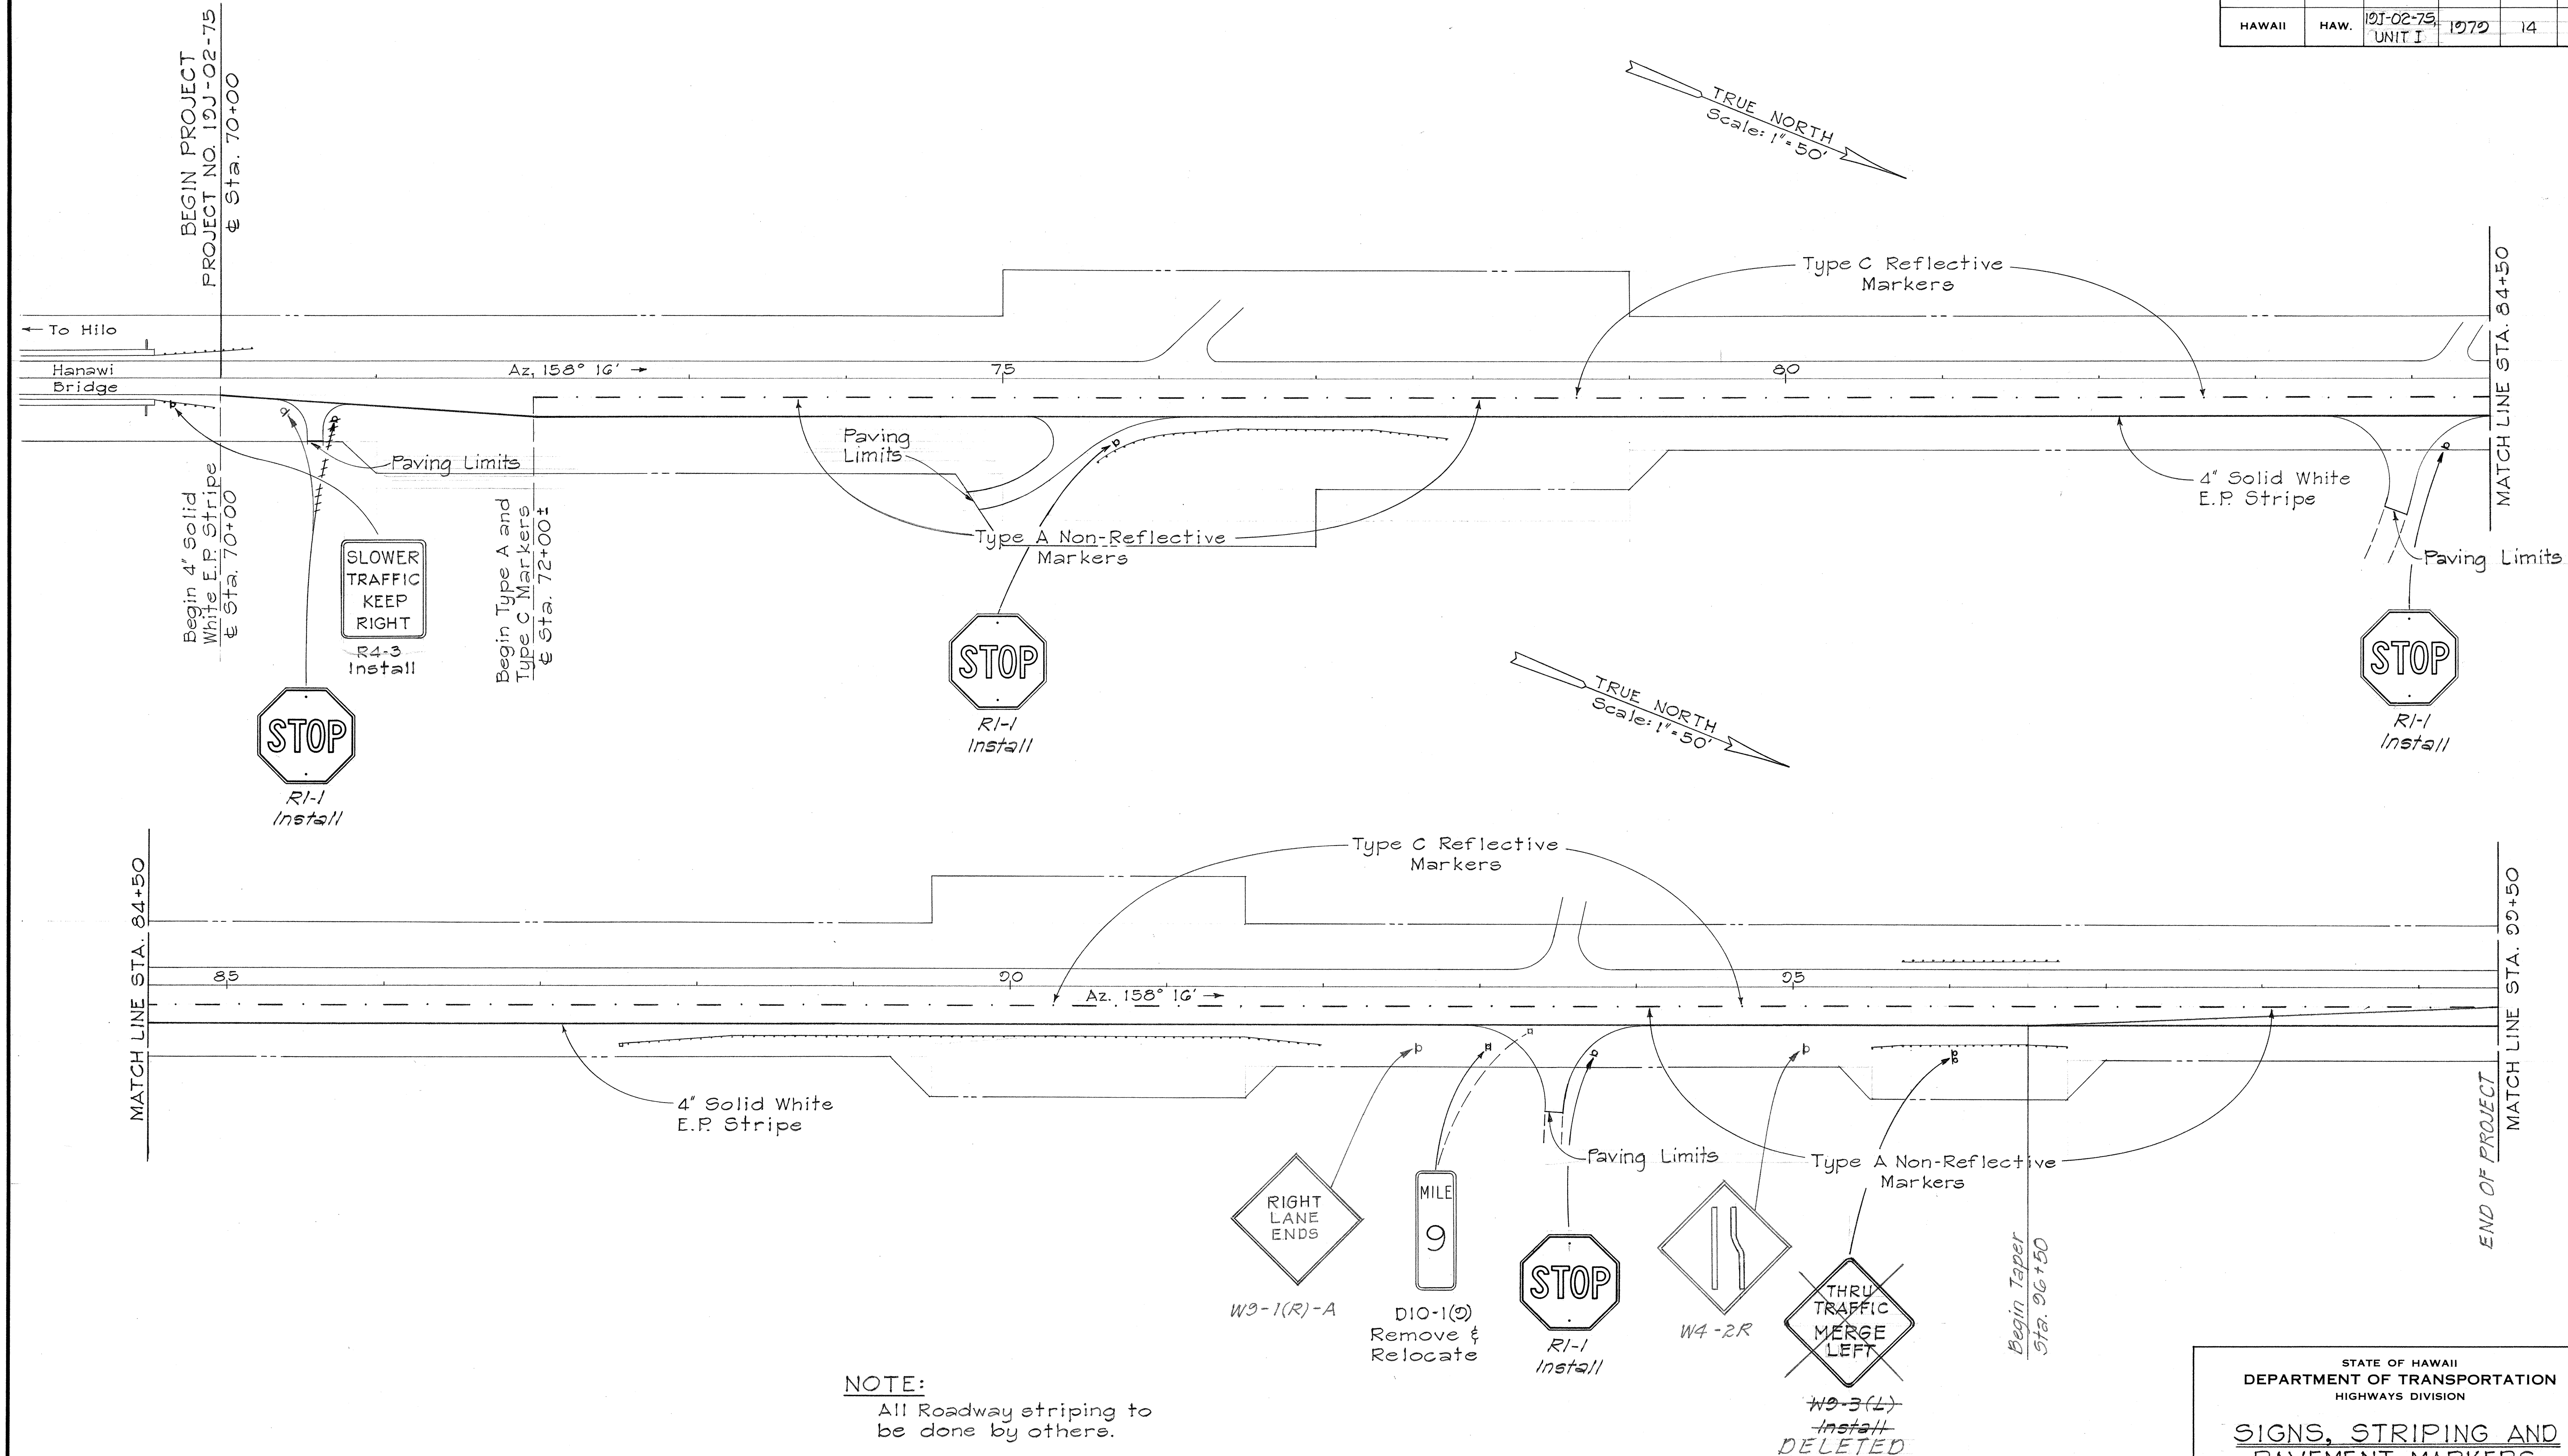


STATE OF HAWAII
DEPARTMENT OF TRANSPORTATION
HIGHWAYS DIVISION

**SIGNS, STRIPING AND
PAVEMENT MARKERS**

HAWAII BELT ROAD
TRUCK CLIMBING LANE
AT PEPEKEO
PROJ. NO. 19J-02-75, UNIT I

Scale: As Shown Date: Sept. 1978
SHEET NO. 1 OF 2 SHEETS

FED. ROAD DIST. NO.	STATE	PROJ. NO.	FISCAL YEAR	SHEET NO.	TOTAL SHEETS
HAWAII	HAW.	19J-02-75 UNIT I	1975	15	42

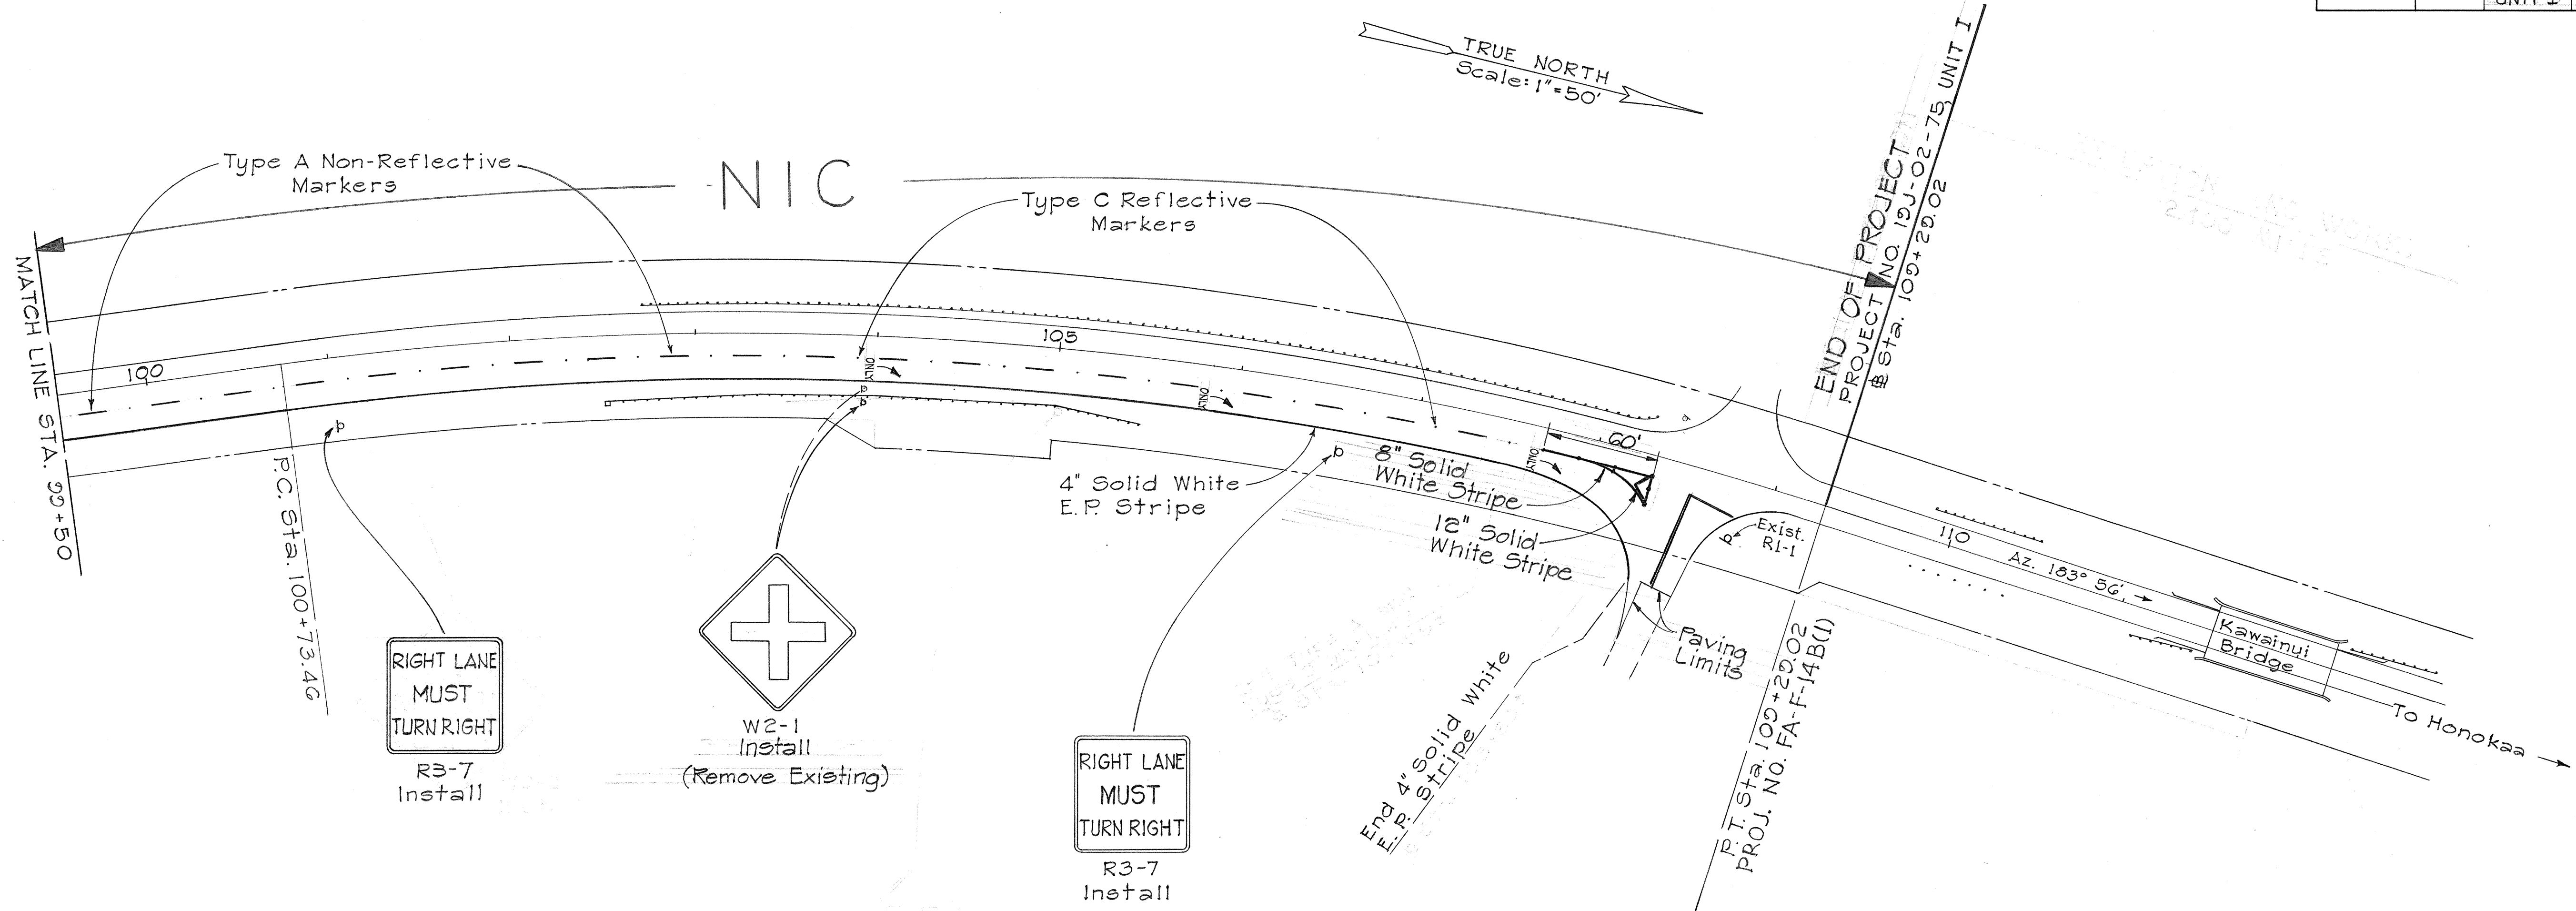

SUMMARY ~ TRAFFIC SIGNS				
TYPE	DESCRIPTION	NEW W/POST	REMOVE	RELOCATE
R4-3	Slower Traffic Keep Right Sign	1		
D10-1	Metal Mile Post Sign		1	1
W3-3(L)	Thru Traffic Merge Left	+		
W2-1	Cross Road Sign	+	+	
R1-1	Stop	4		
R3-7	Right Lane Must Turn Right Sign	2		
W4-2R	Right Lane Ends	1		
W3-1(R)	Right Lane Ends			
SUMMARY ~ RAISED PAVEMENT MARKERS				
TYPE	DESCRIPTION			
A	Non-Reflective White	356		
C	Red-Clear Reflective	96		

NOTE:
All roadway striping to be done by others.

STATE OF HAWAII
DEPARTMENT OF TRANSPORTATION
HIGHWAYS DIVISION

SIGNALS, STRIPING AND
PAVEMENT MARKERS

HAWAII BELT ROAD
TRUCK CLIMBING LANE
AT PEPEKEO
PROJ. NO. 19J-02-75, UNIT I

Scale: As Shown Date: Sept. 1978
SHEET NO. 2 OF 2 SHEETS

DATE

SURVEY PLOTTED BY

DRAWN BY

DESIGNED BY

CHECKED BY

ORIGINAL PLAN

NOTE BOOK