




FED. ROAD DIST. NO.	STATE	PROJ. NO.	FISCAL YEAR	SHEET NO.	TOTAL SHEETS
HAWAII	HAW.	19J-02-75 UNIT I	1979	2	42

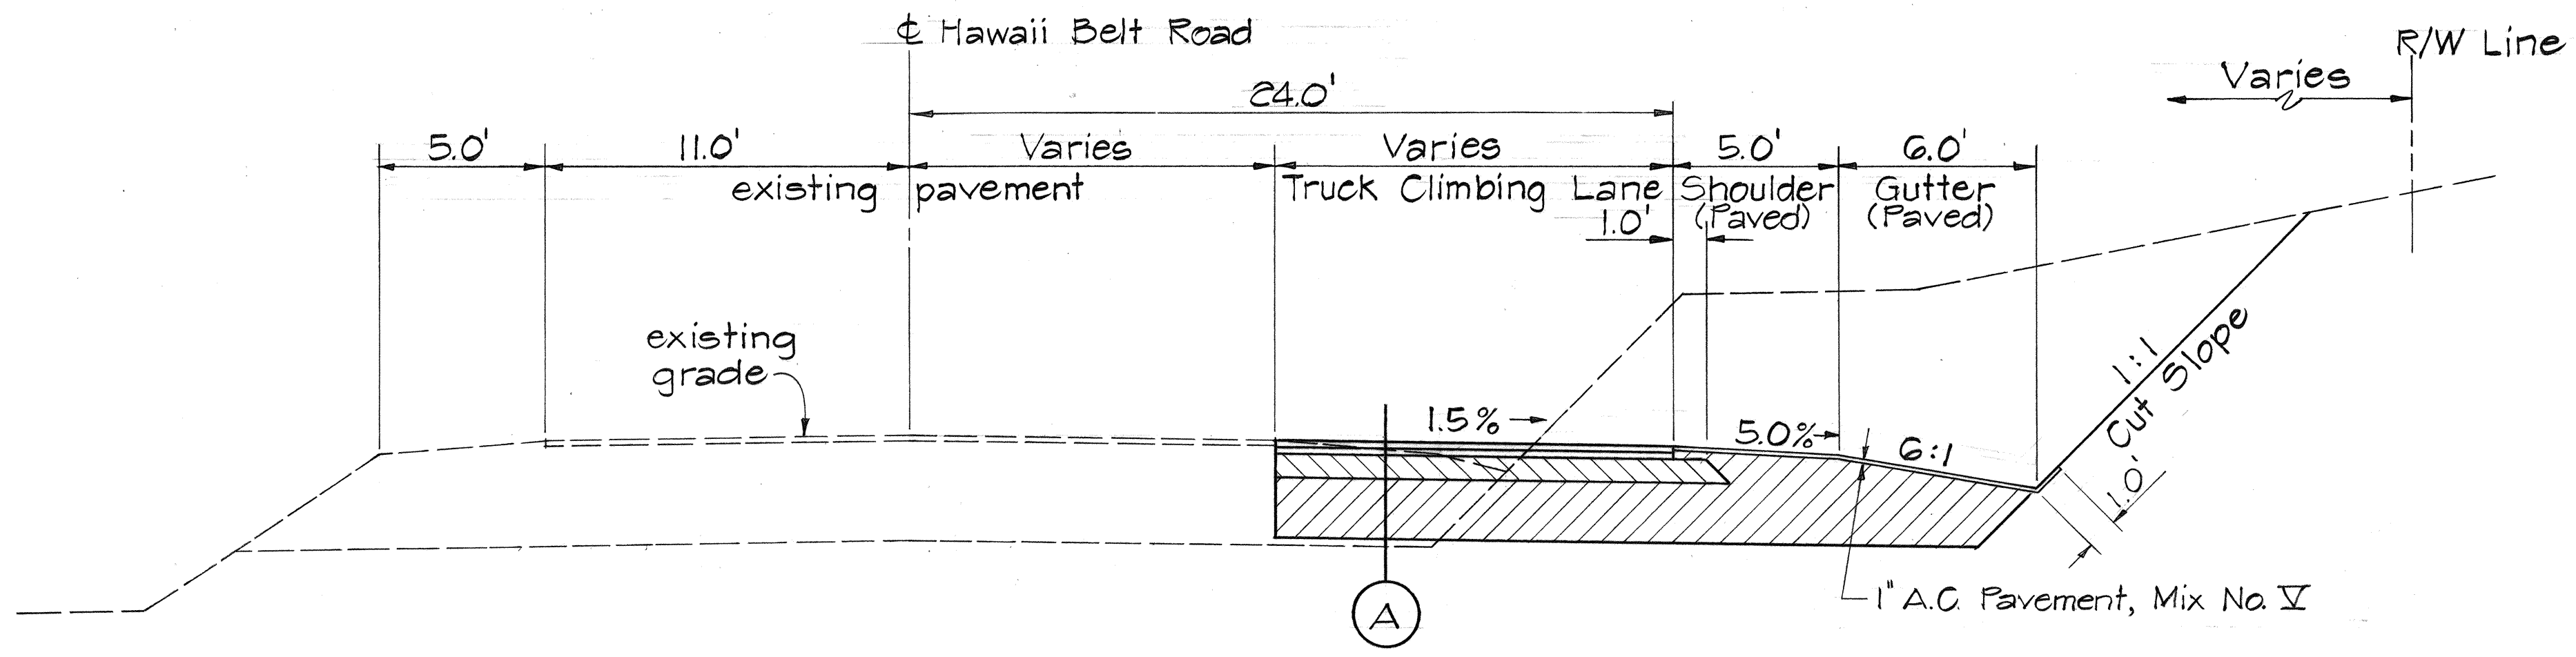


**TYPICAL TANGENT SECTION**  
Scale: 1/4" = 1'-0"

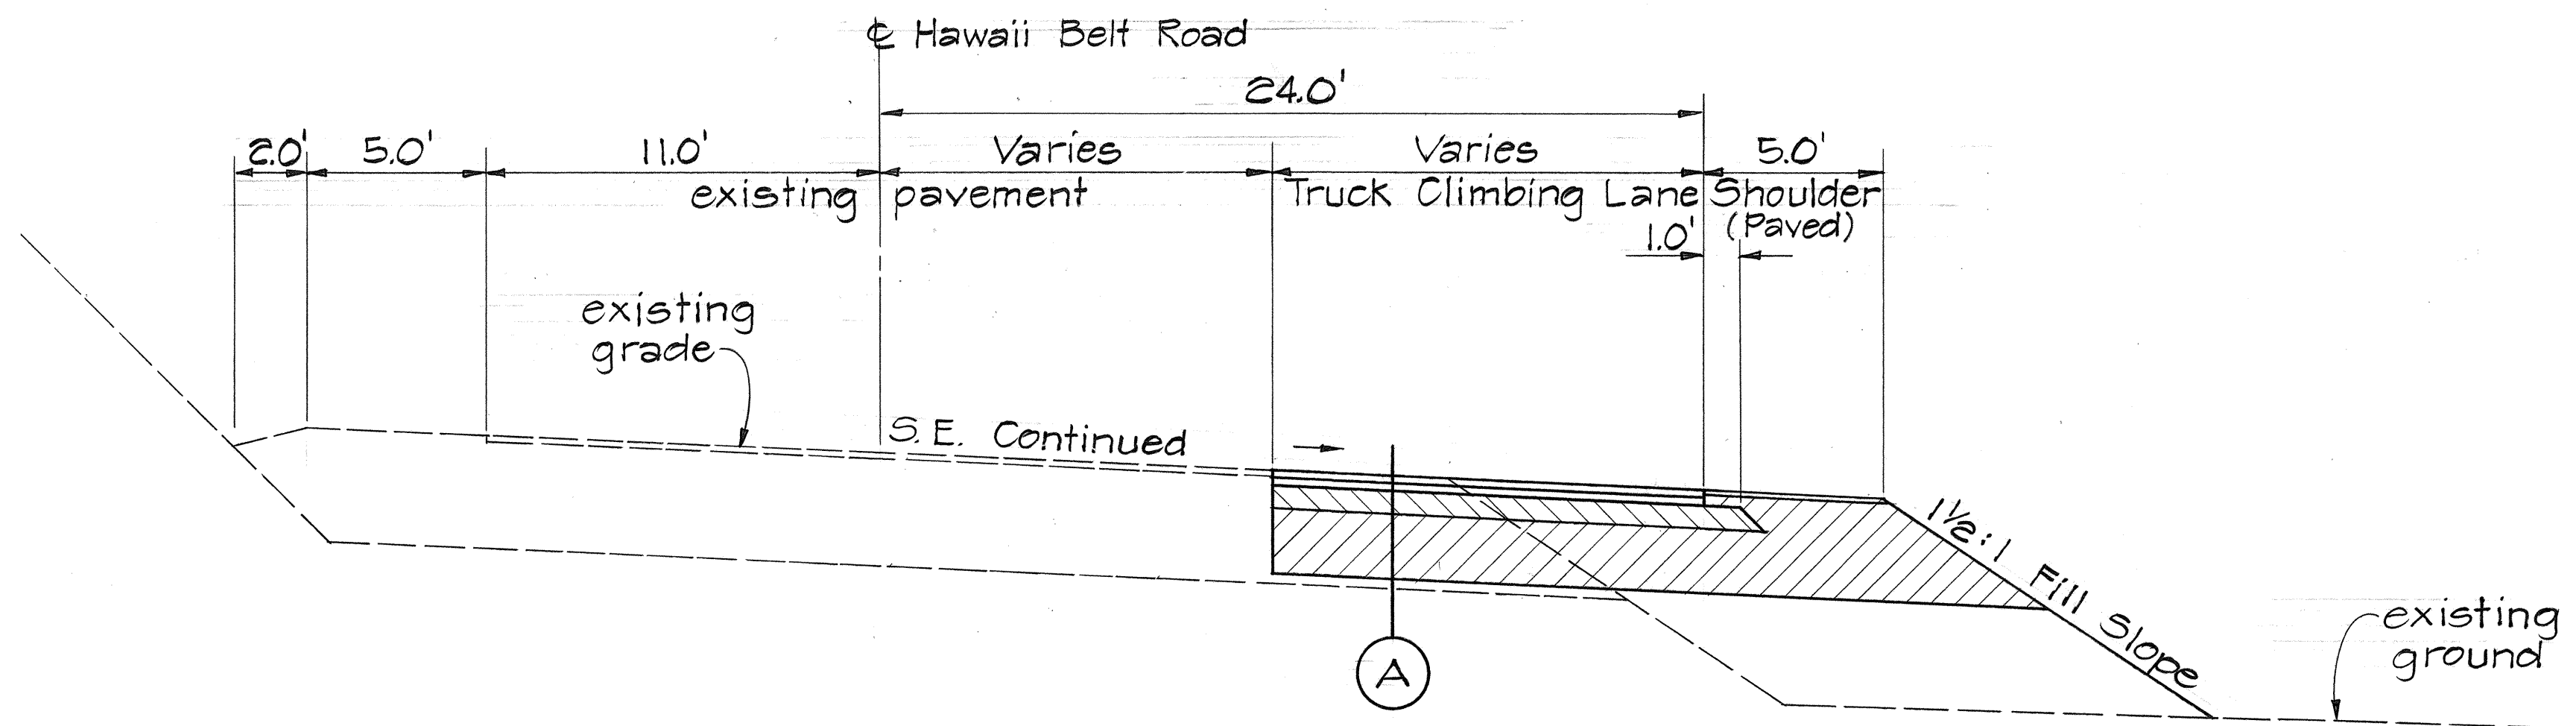


**TYPICAL SUPERELEVATED SECTION**  
Scale: 1/4" = 1'-0"

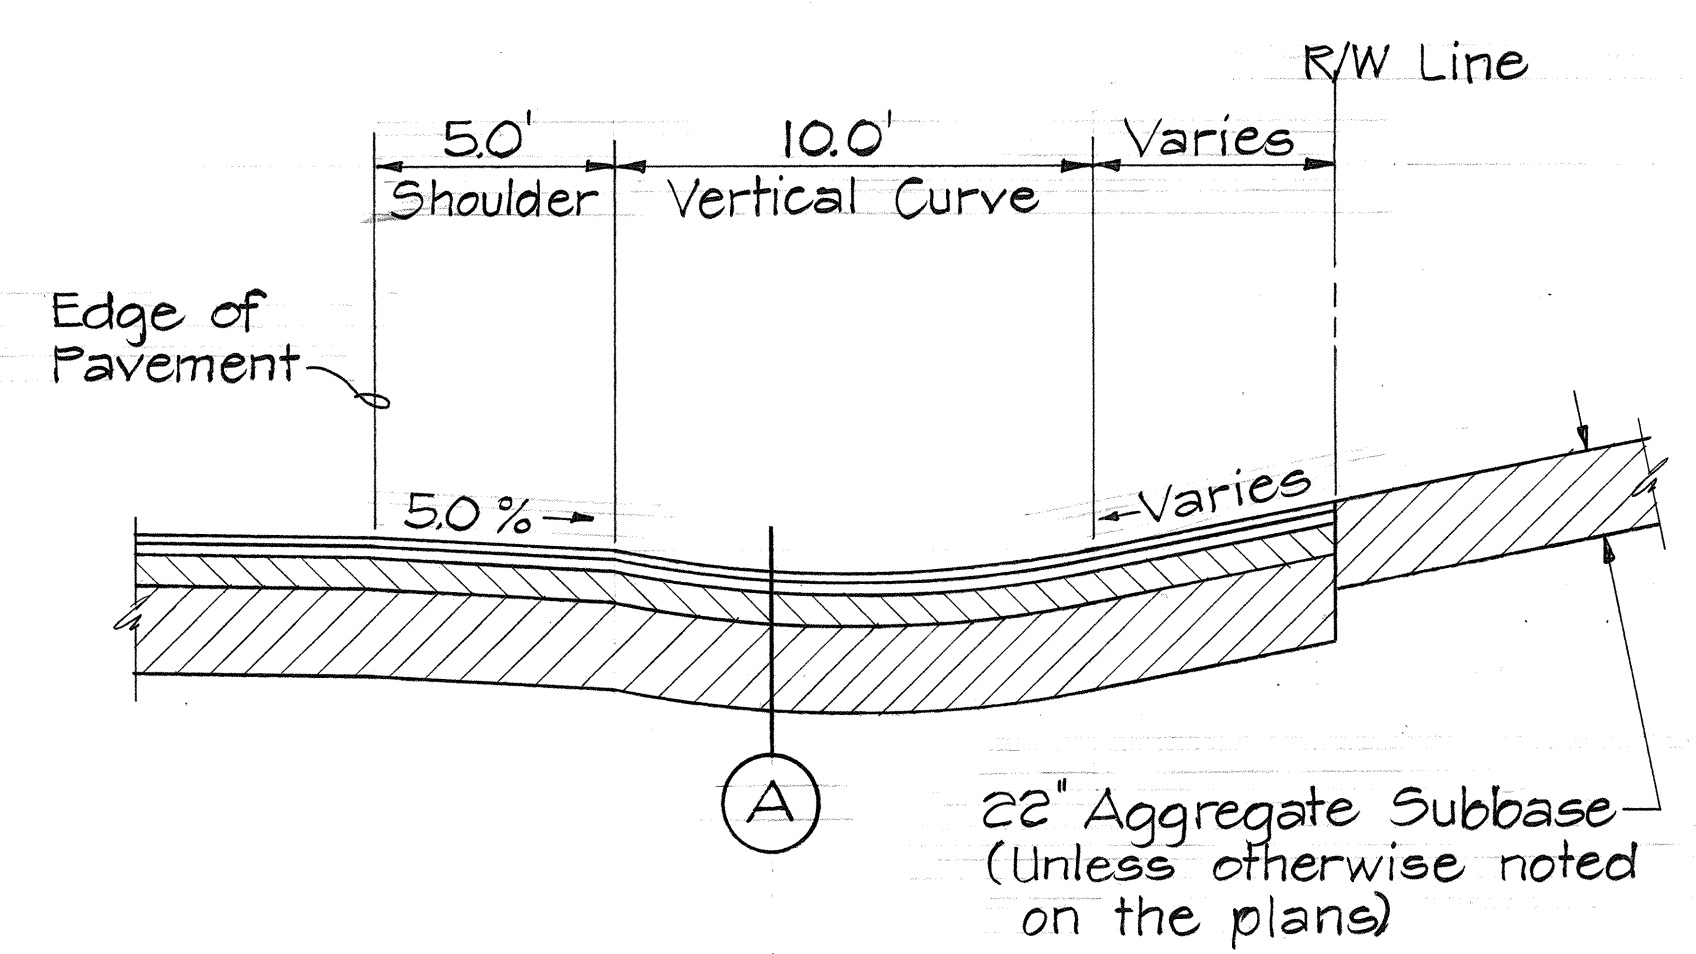


**TYPICAL SECTION OF SIDEROAD APPROACHES**  
Scale: 1/4" = 1'-0"

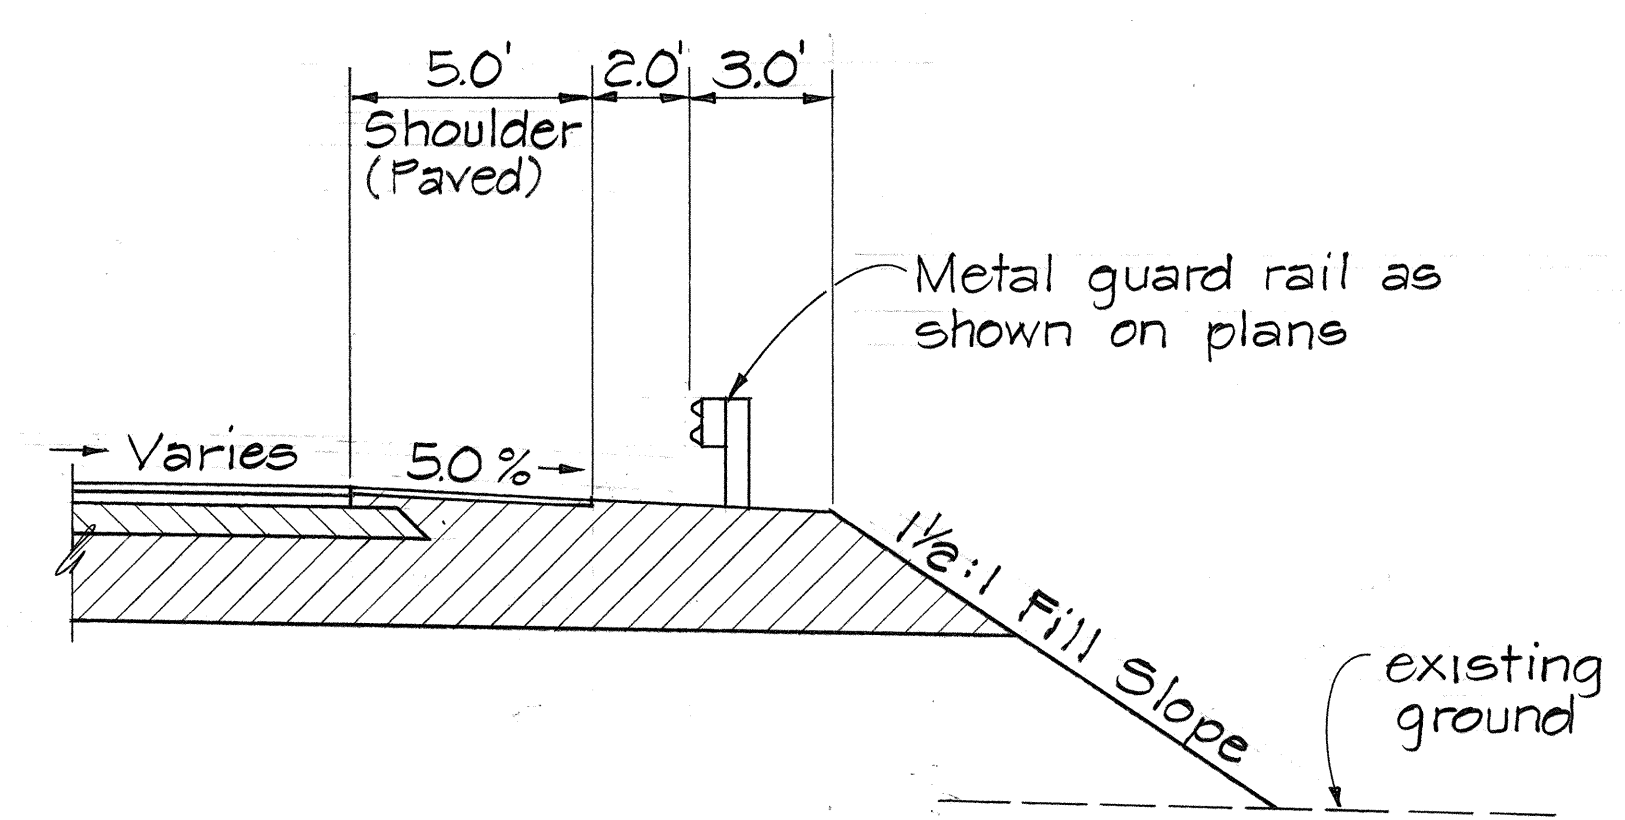

**TYPICAL FILL SECTION AT GUARD RAIL**  
Scale: 1/4" = 1'-0"

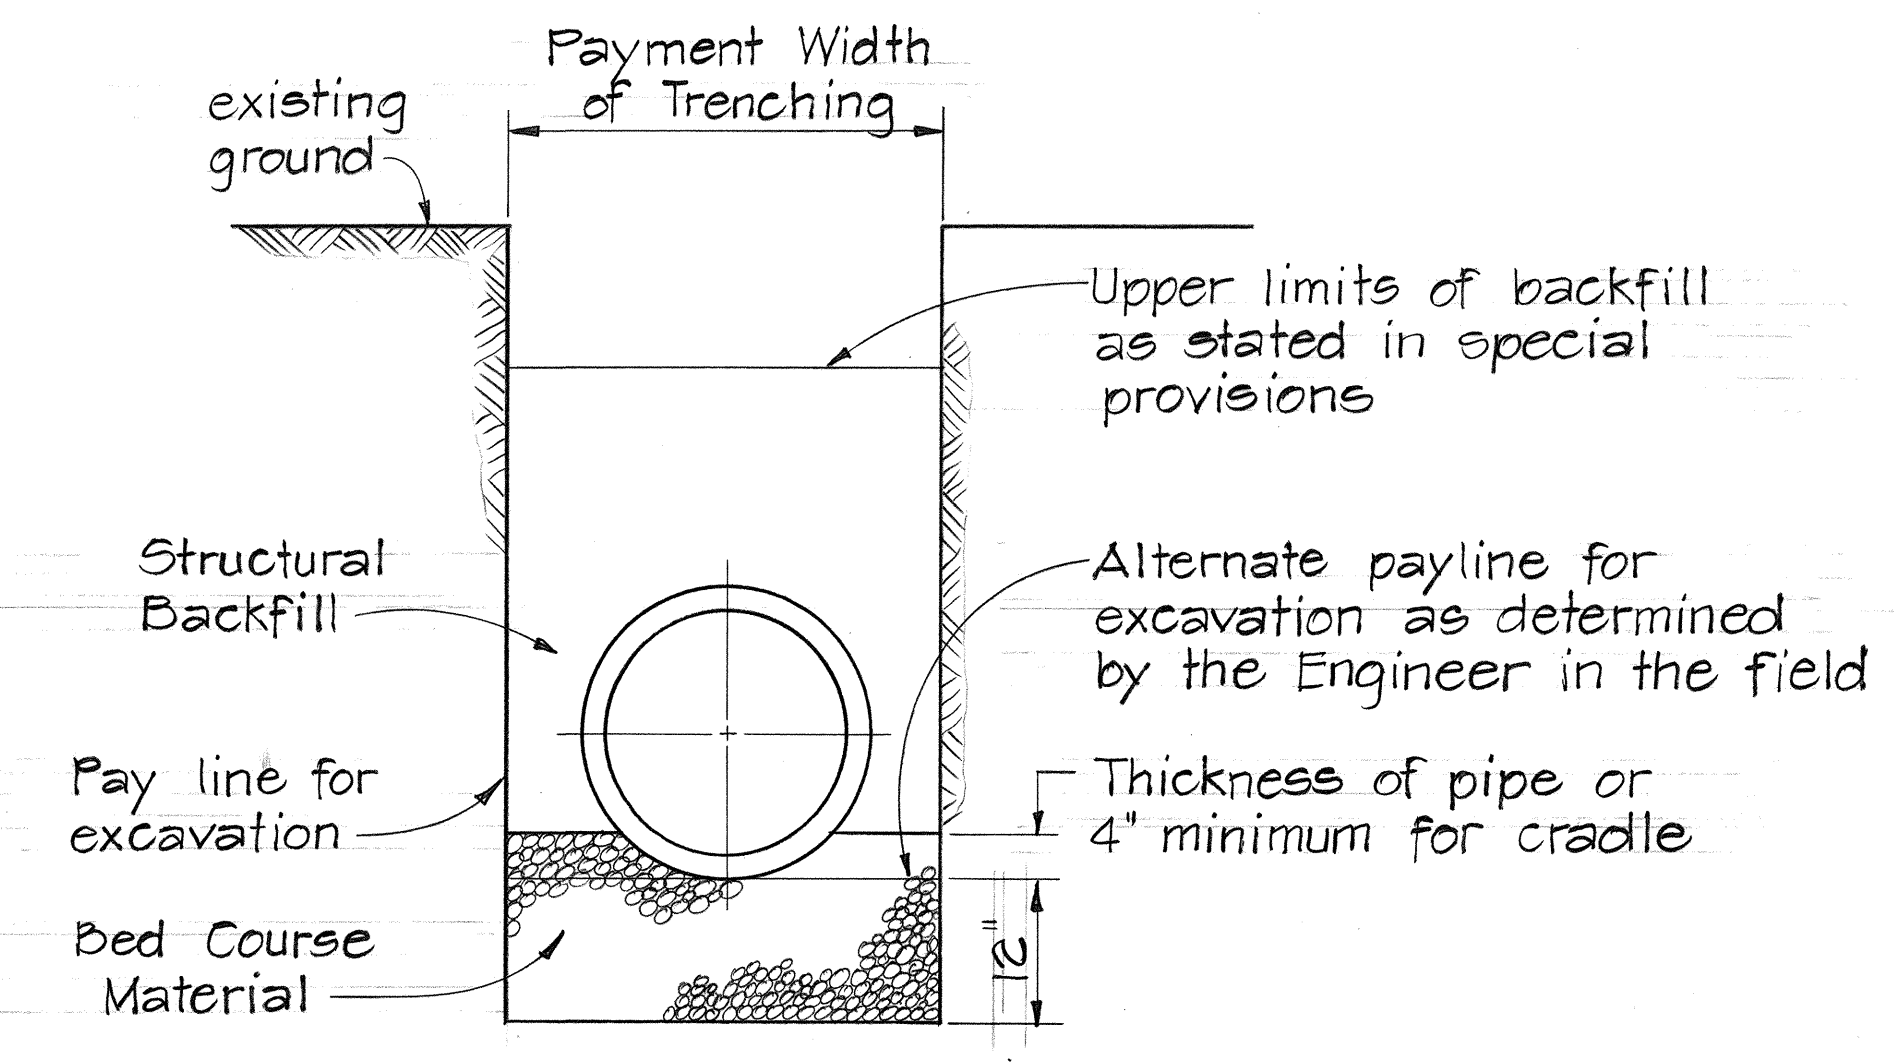

**TYPICAL TRENCH SECTION FOR CULVERTS**  
Not to Scale

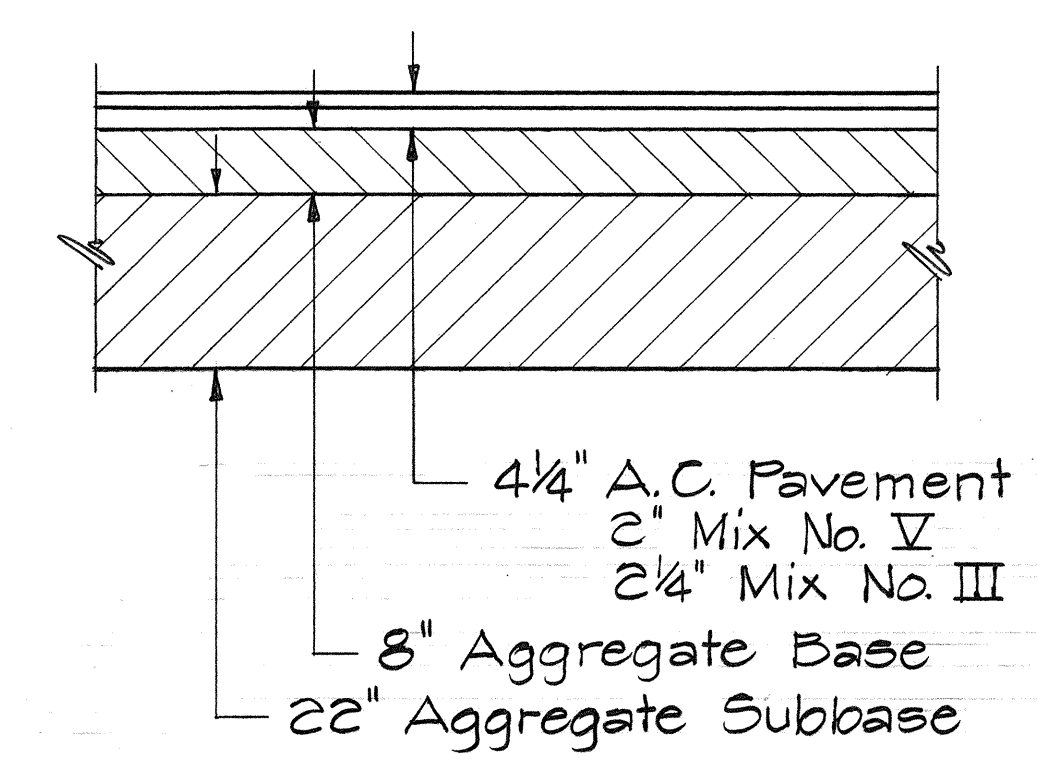

**TYPICAL PAVEMENT DETAIL**  
Scale: 1/2" = 1'-0"

**GENERAL NOTES**

1. Pavement striping shall be done by others.
2. Utility poles to be relocated by others.
3. Saw cutting of existing pavement shall be considered incidental to contract payment items and no payment shall be made.
4. Access from existing sideroad/drive-ways shall be provided by Contractor at all times unless otherwise directed.

STATE OF HAWAII  
DEPARTMENT OF TRANSPORTATION  
LAND TRANSPORTATION FACILITIES DIVISION

**TYPICAL SECTIONS**

HAWAII BELT ROAD  
TRUCK CLIMBING LANE AT PEPEKEO  
PROJ. NO. 19J-02-75, UNIT I

Scale: As Noted Date: Sept. 1978  
SHEET NO. 1 OF 1 SHEETS