

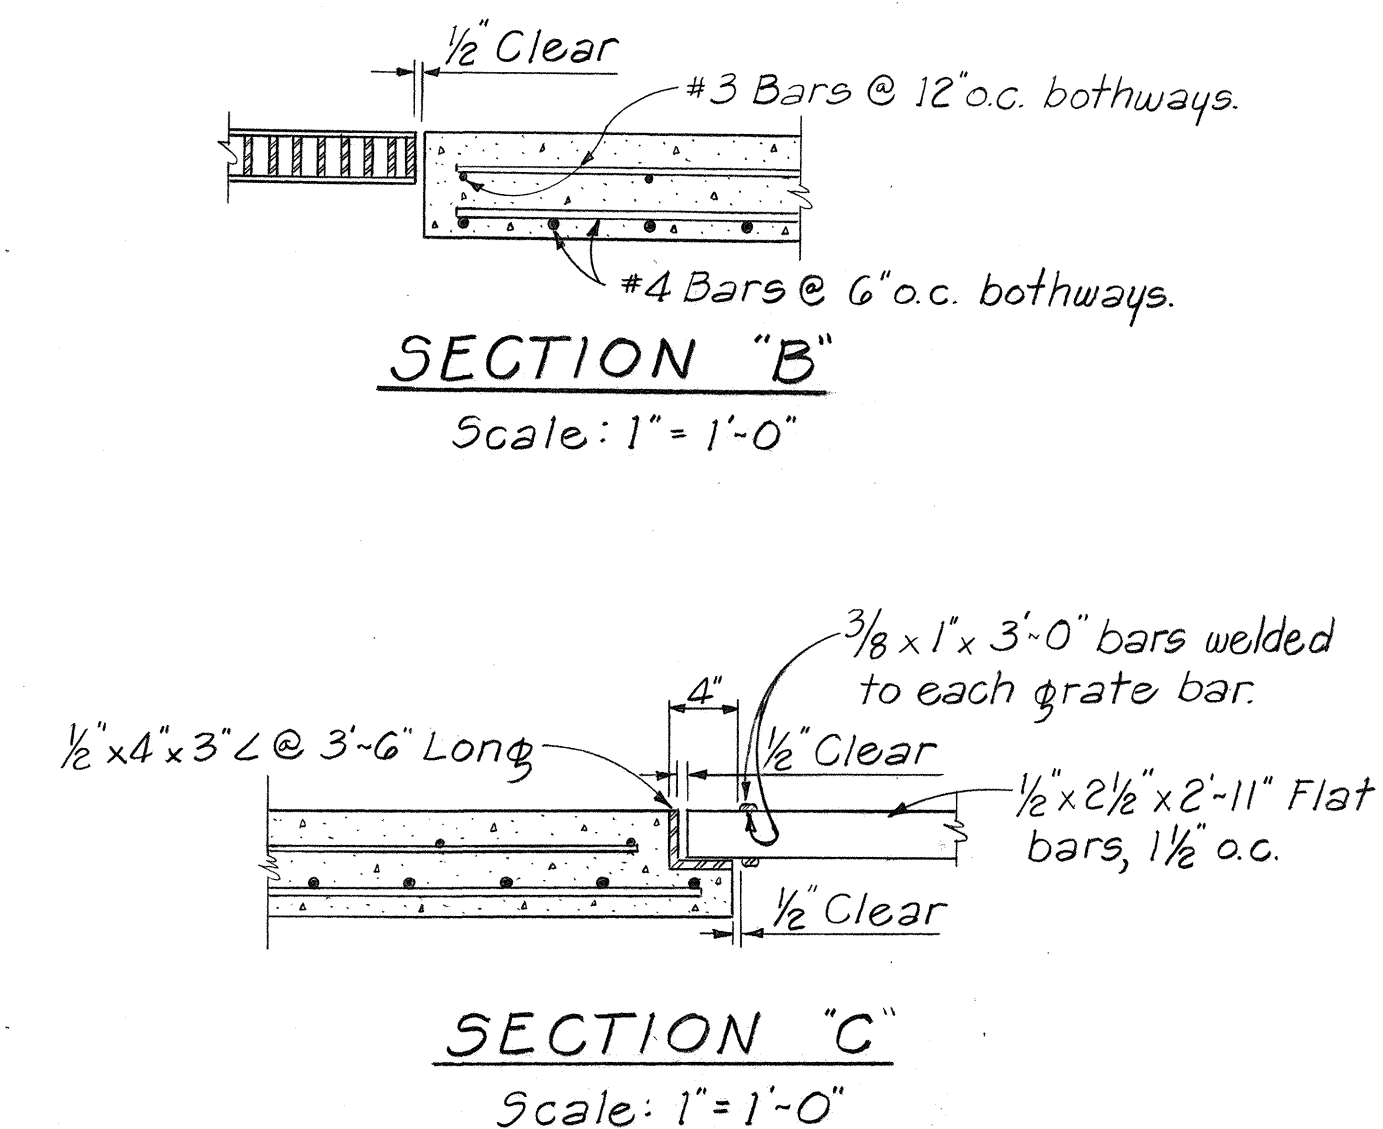
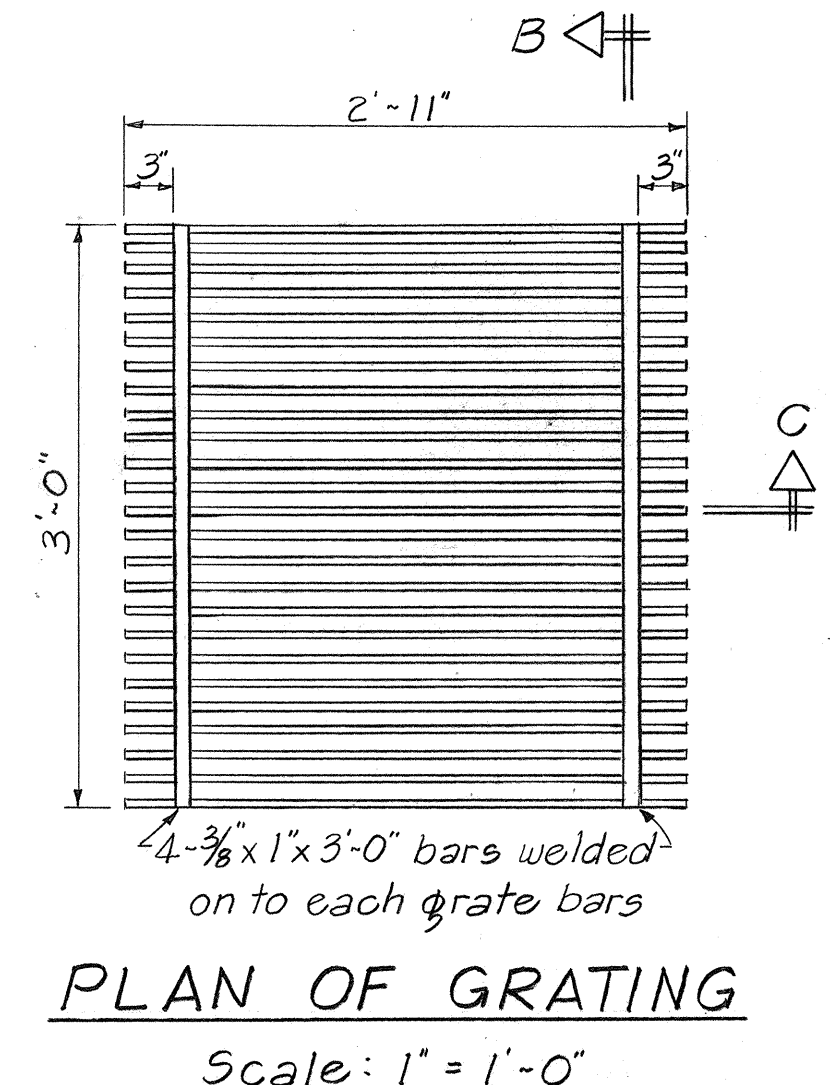


FED. ROAD DIST. NO.	STATE	FED. AID PROJ. NO.	FISCAL YEAR	SHEET NO.	TOTAL SHEETS
HAWAII	HAW.	19L-05-79	1979	2	4

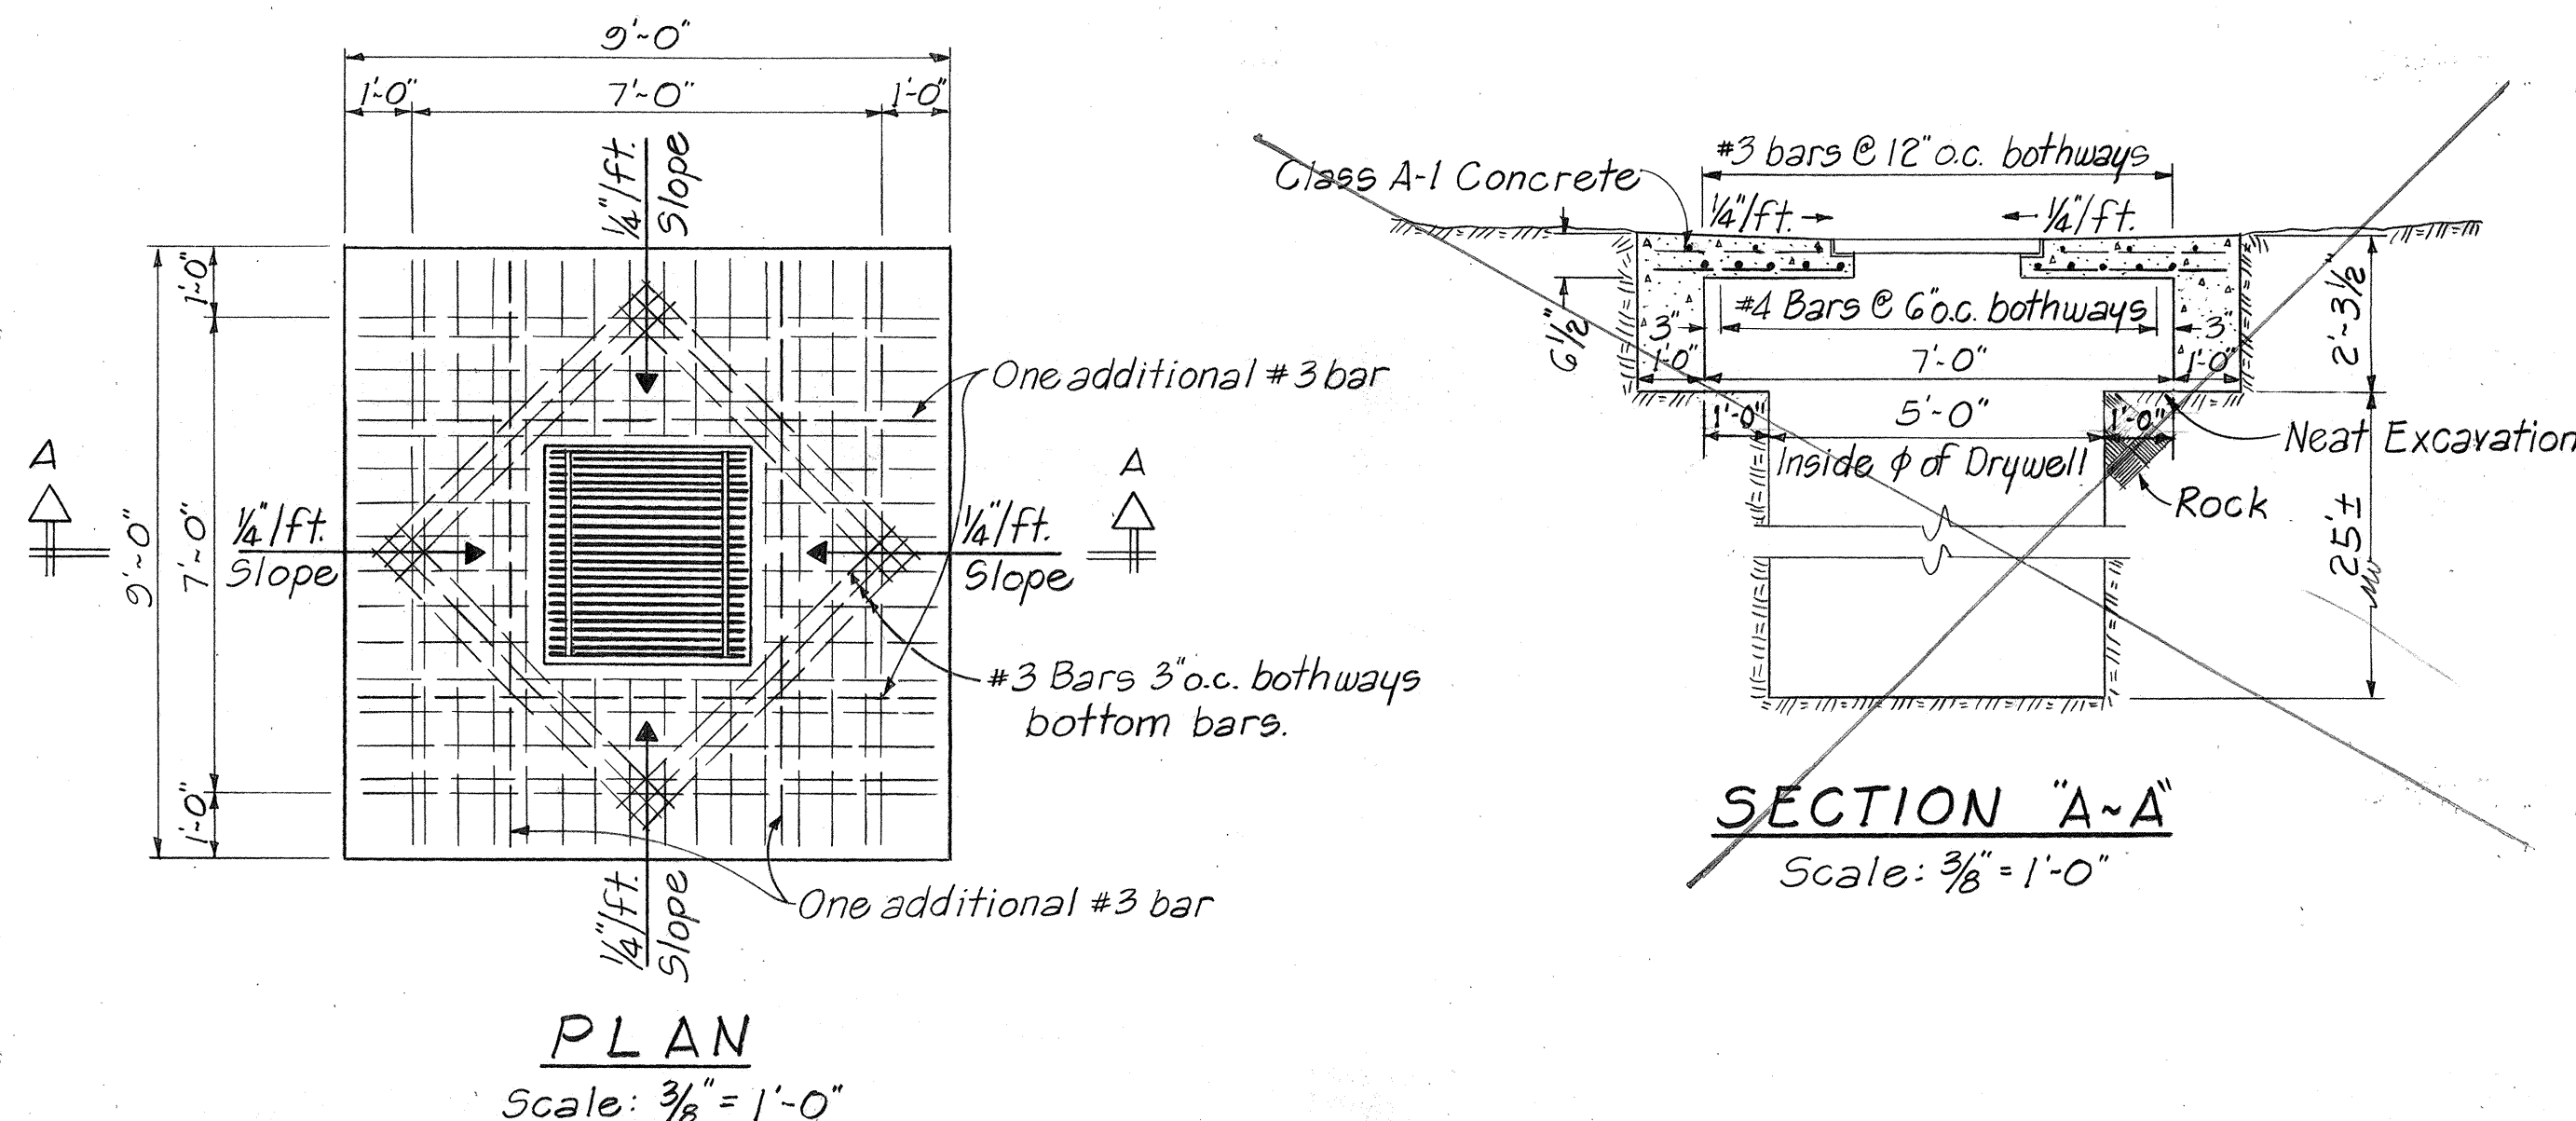


NOTES FOR GRATES & FRAMES

1. All weld $\frac{5}{16}$ "
2. Grates and Frame $\angle$ s shall be Structural Steel and shall be hot dip galvanized.

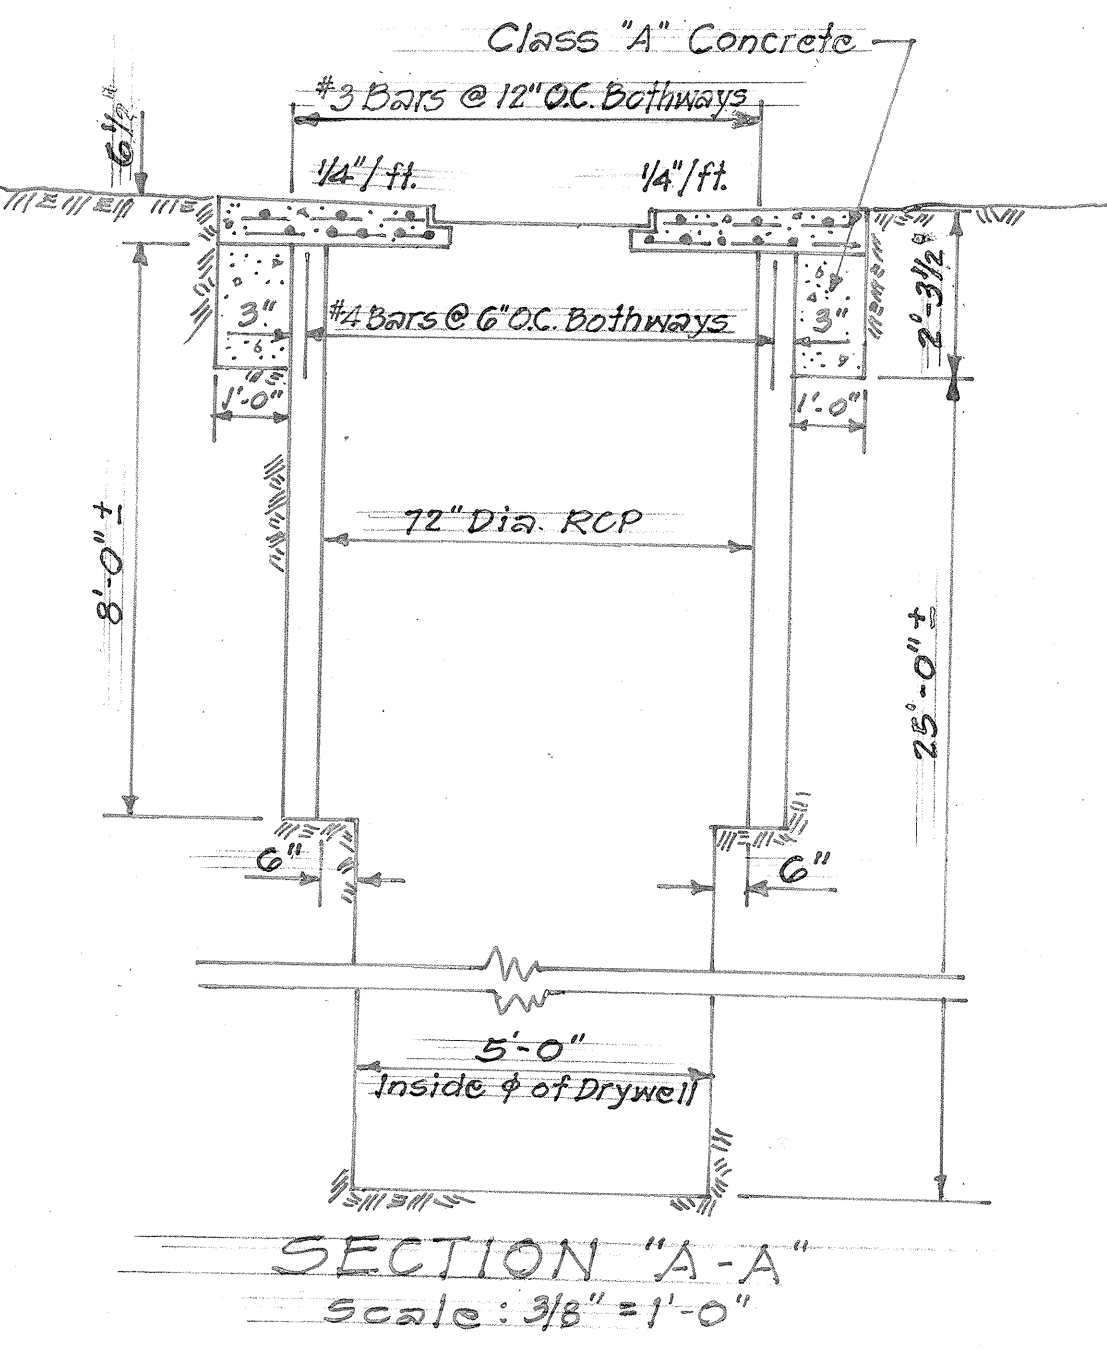

DETAILS OF DRYWELL COVER Scale: As Noted

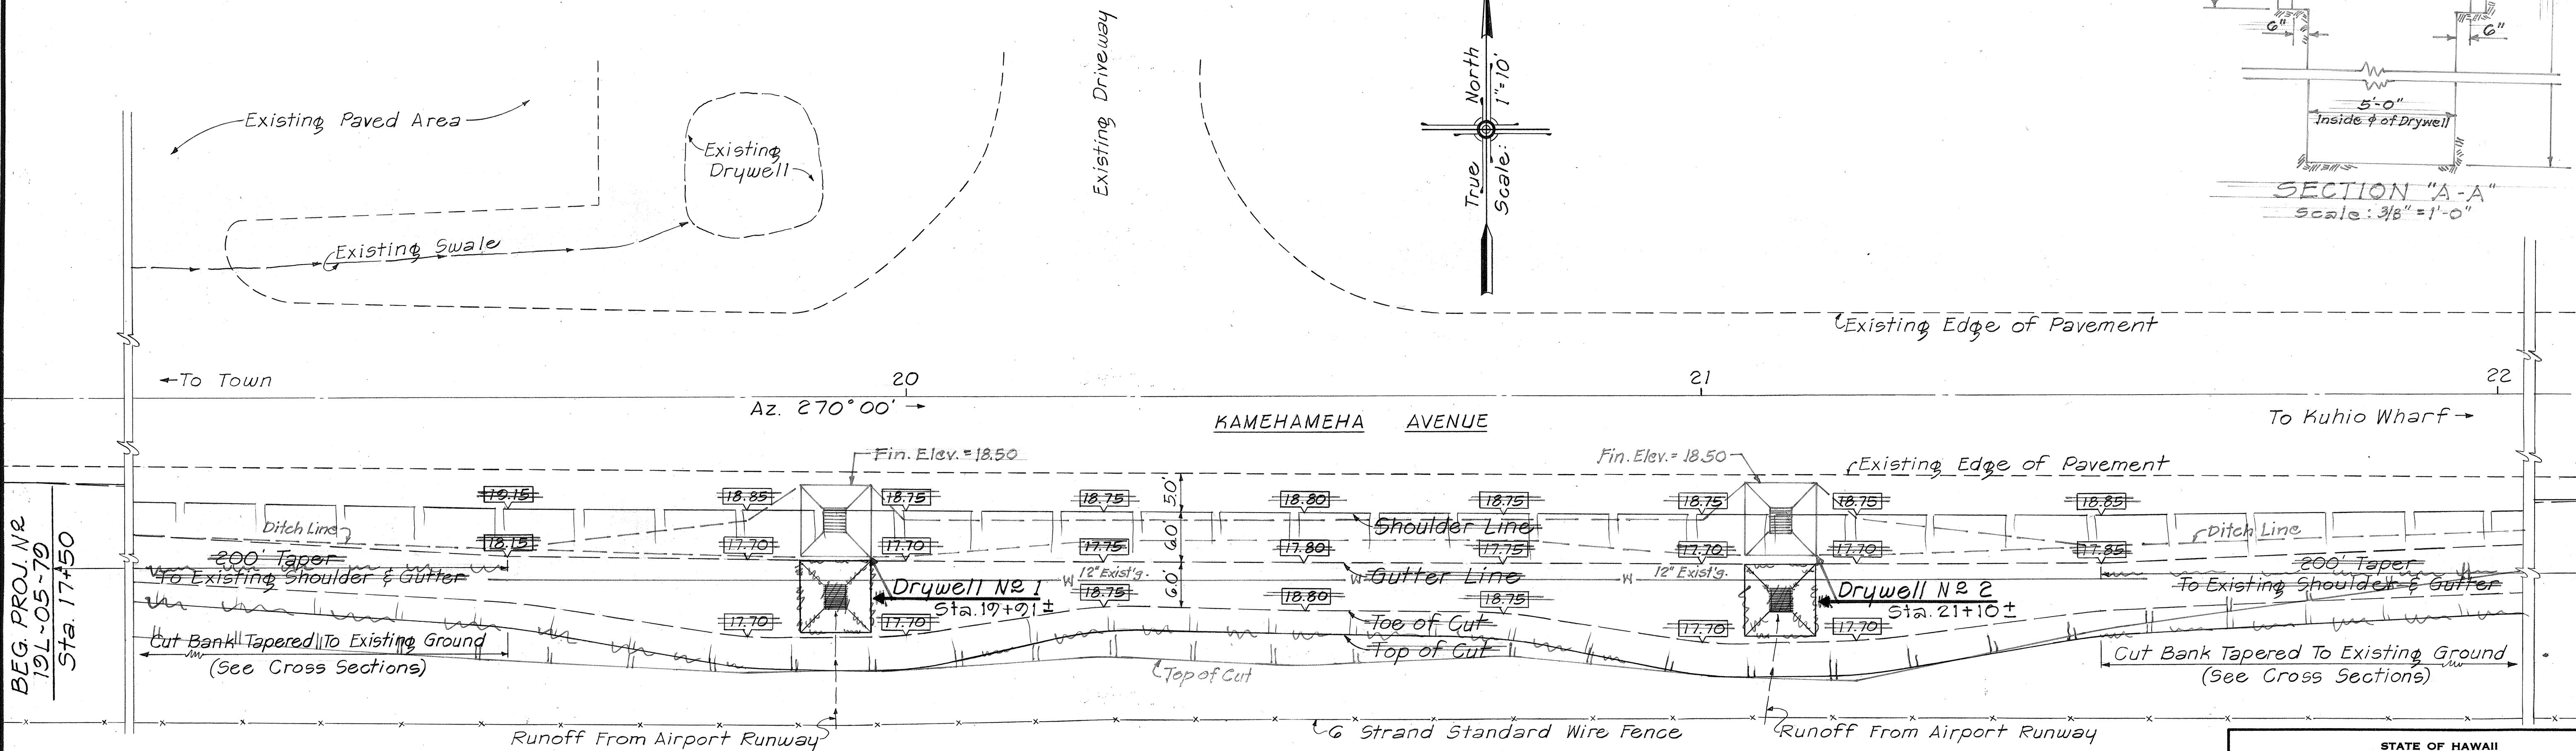

LEGEND

$\overline{17.70}$ Denotes finish grade

See Cross Sections for finish ditch line grades

DRYWELL LOCATION PLAN Scale: 1" = 10'

STATE OF HAWAII

DEPARTMENT OF TRANSPORTATION

HIGHWAYS DIVISION

DRAINAGE IMPROVEMENTS

KAMEHAMEHA AVENUE

PROJECT NO. 19L-05-79

South Hilo, Hawaii

SCALE: AS NOTED

DATE: MAY, 1979

SHEET No. 1 OF 1 SHEETS

SURVEY PLOTTED BY	DATE
DRAWN BY	
DESIGNED BY	
NOTE BOOK	
QUANTITIES BY	
CHECKED BY	
No.	