

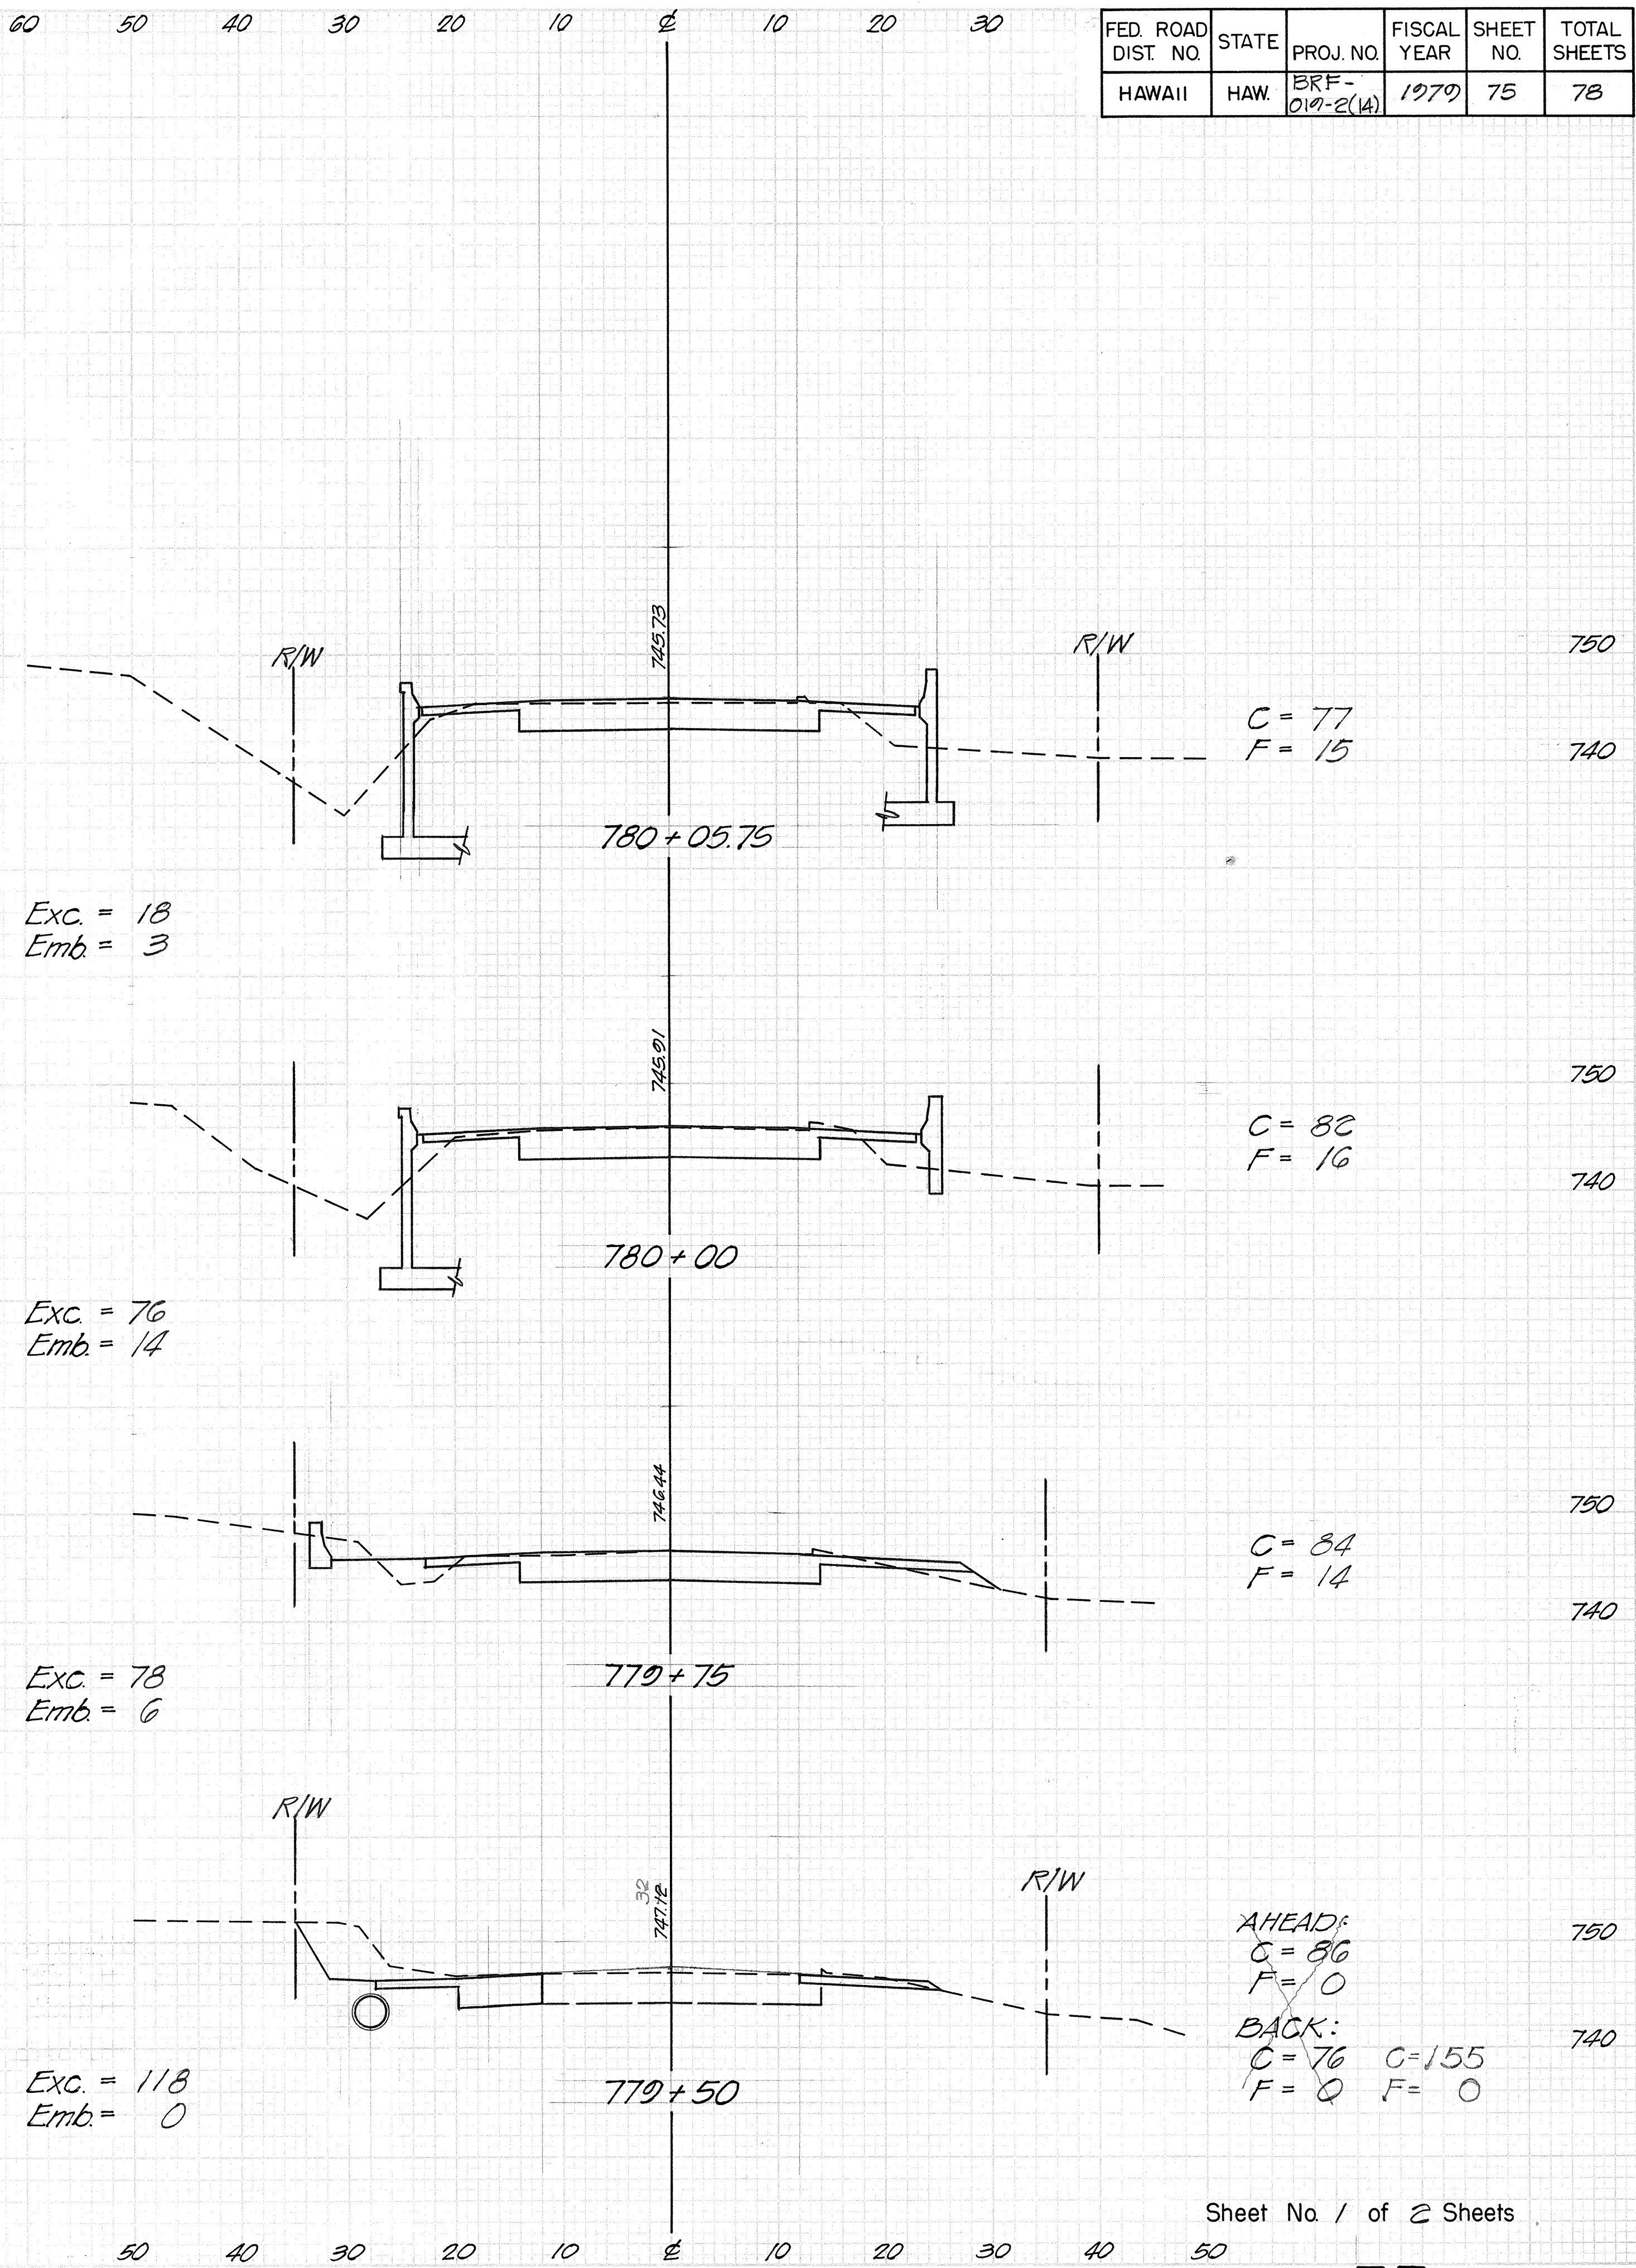
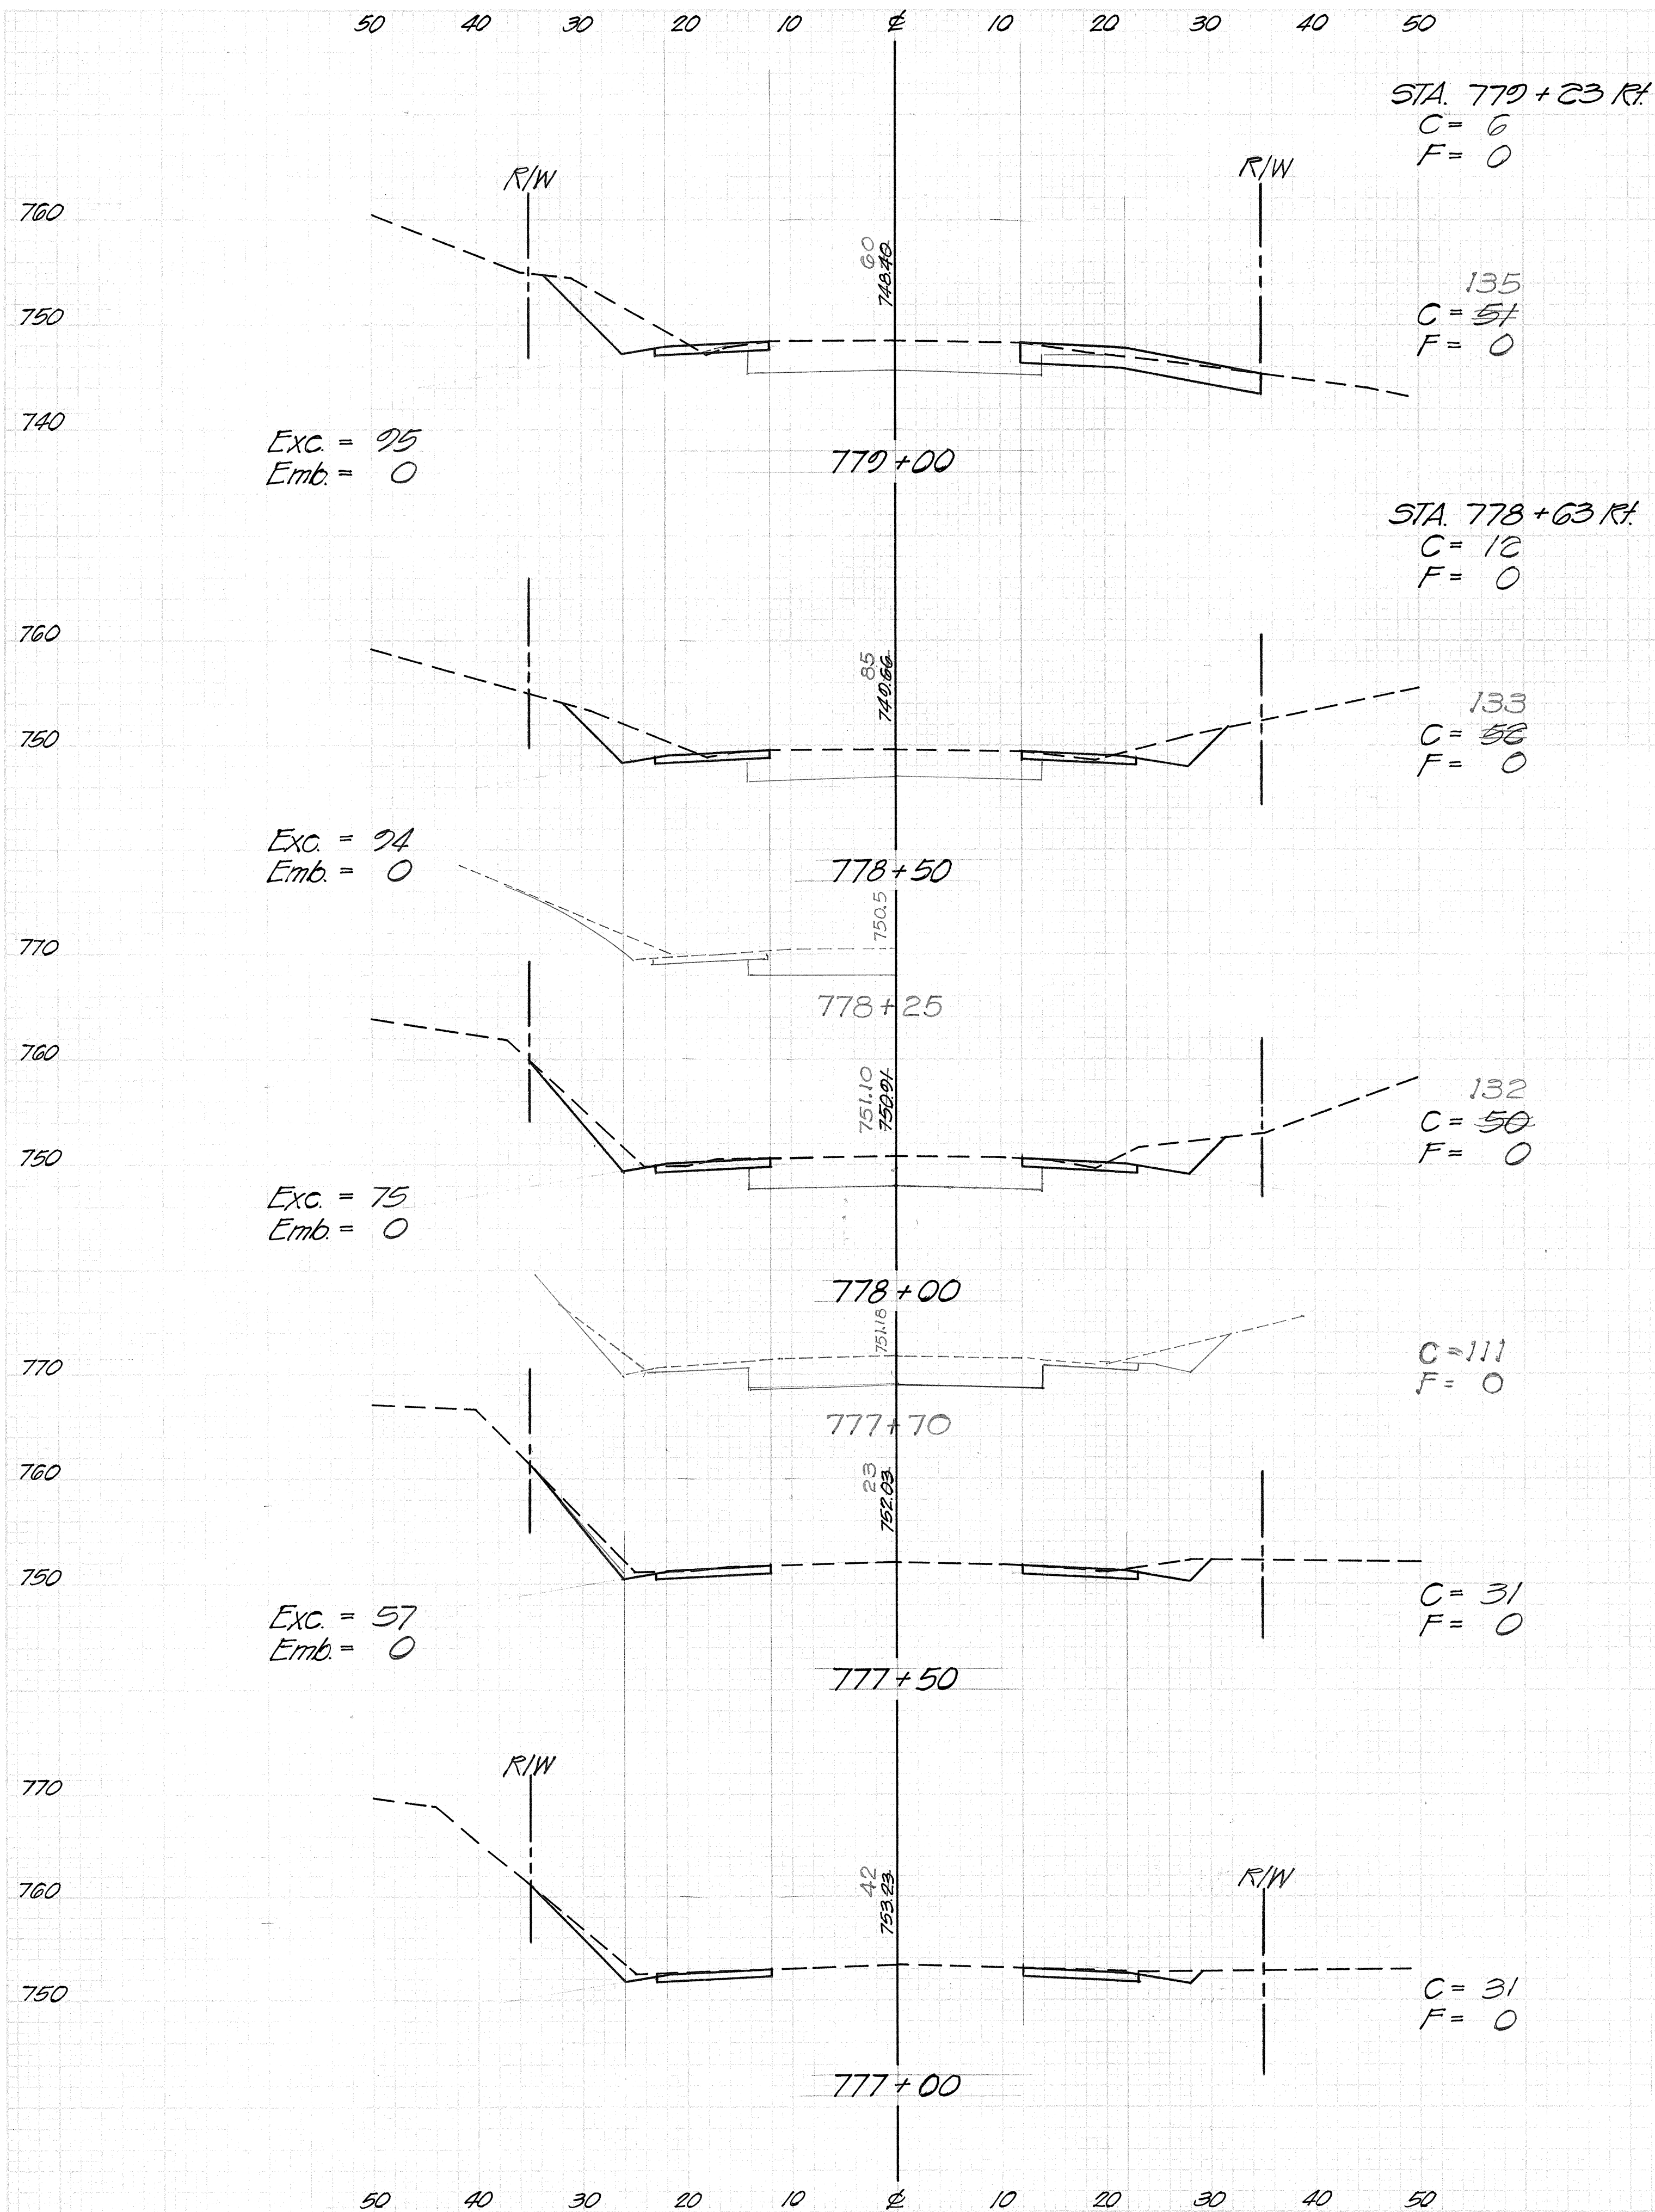


FED. ROAD DIST. NO.	STATE	PROJ. NO.	FISCAL YEAR	SHEET NO.	TOTAL SHEETS
HAWAII	HAW.	BRF-017-2(14)	1970	75	78

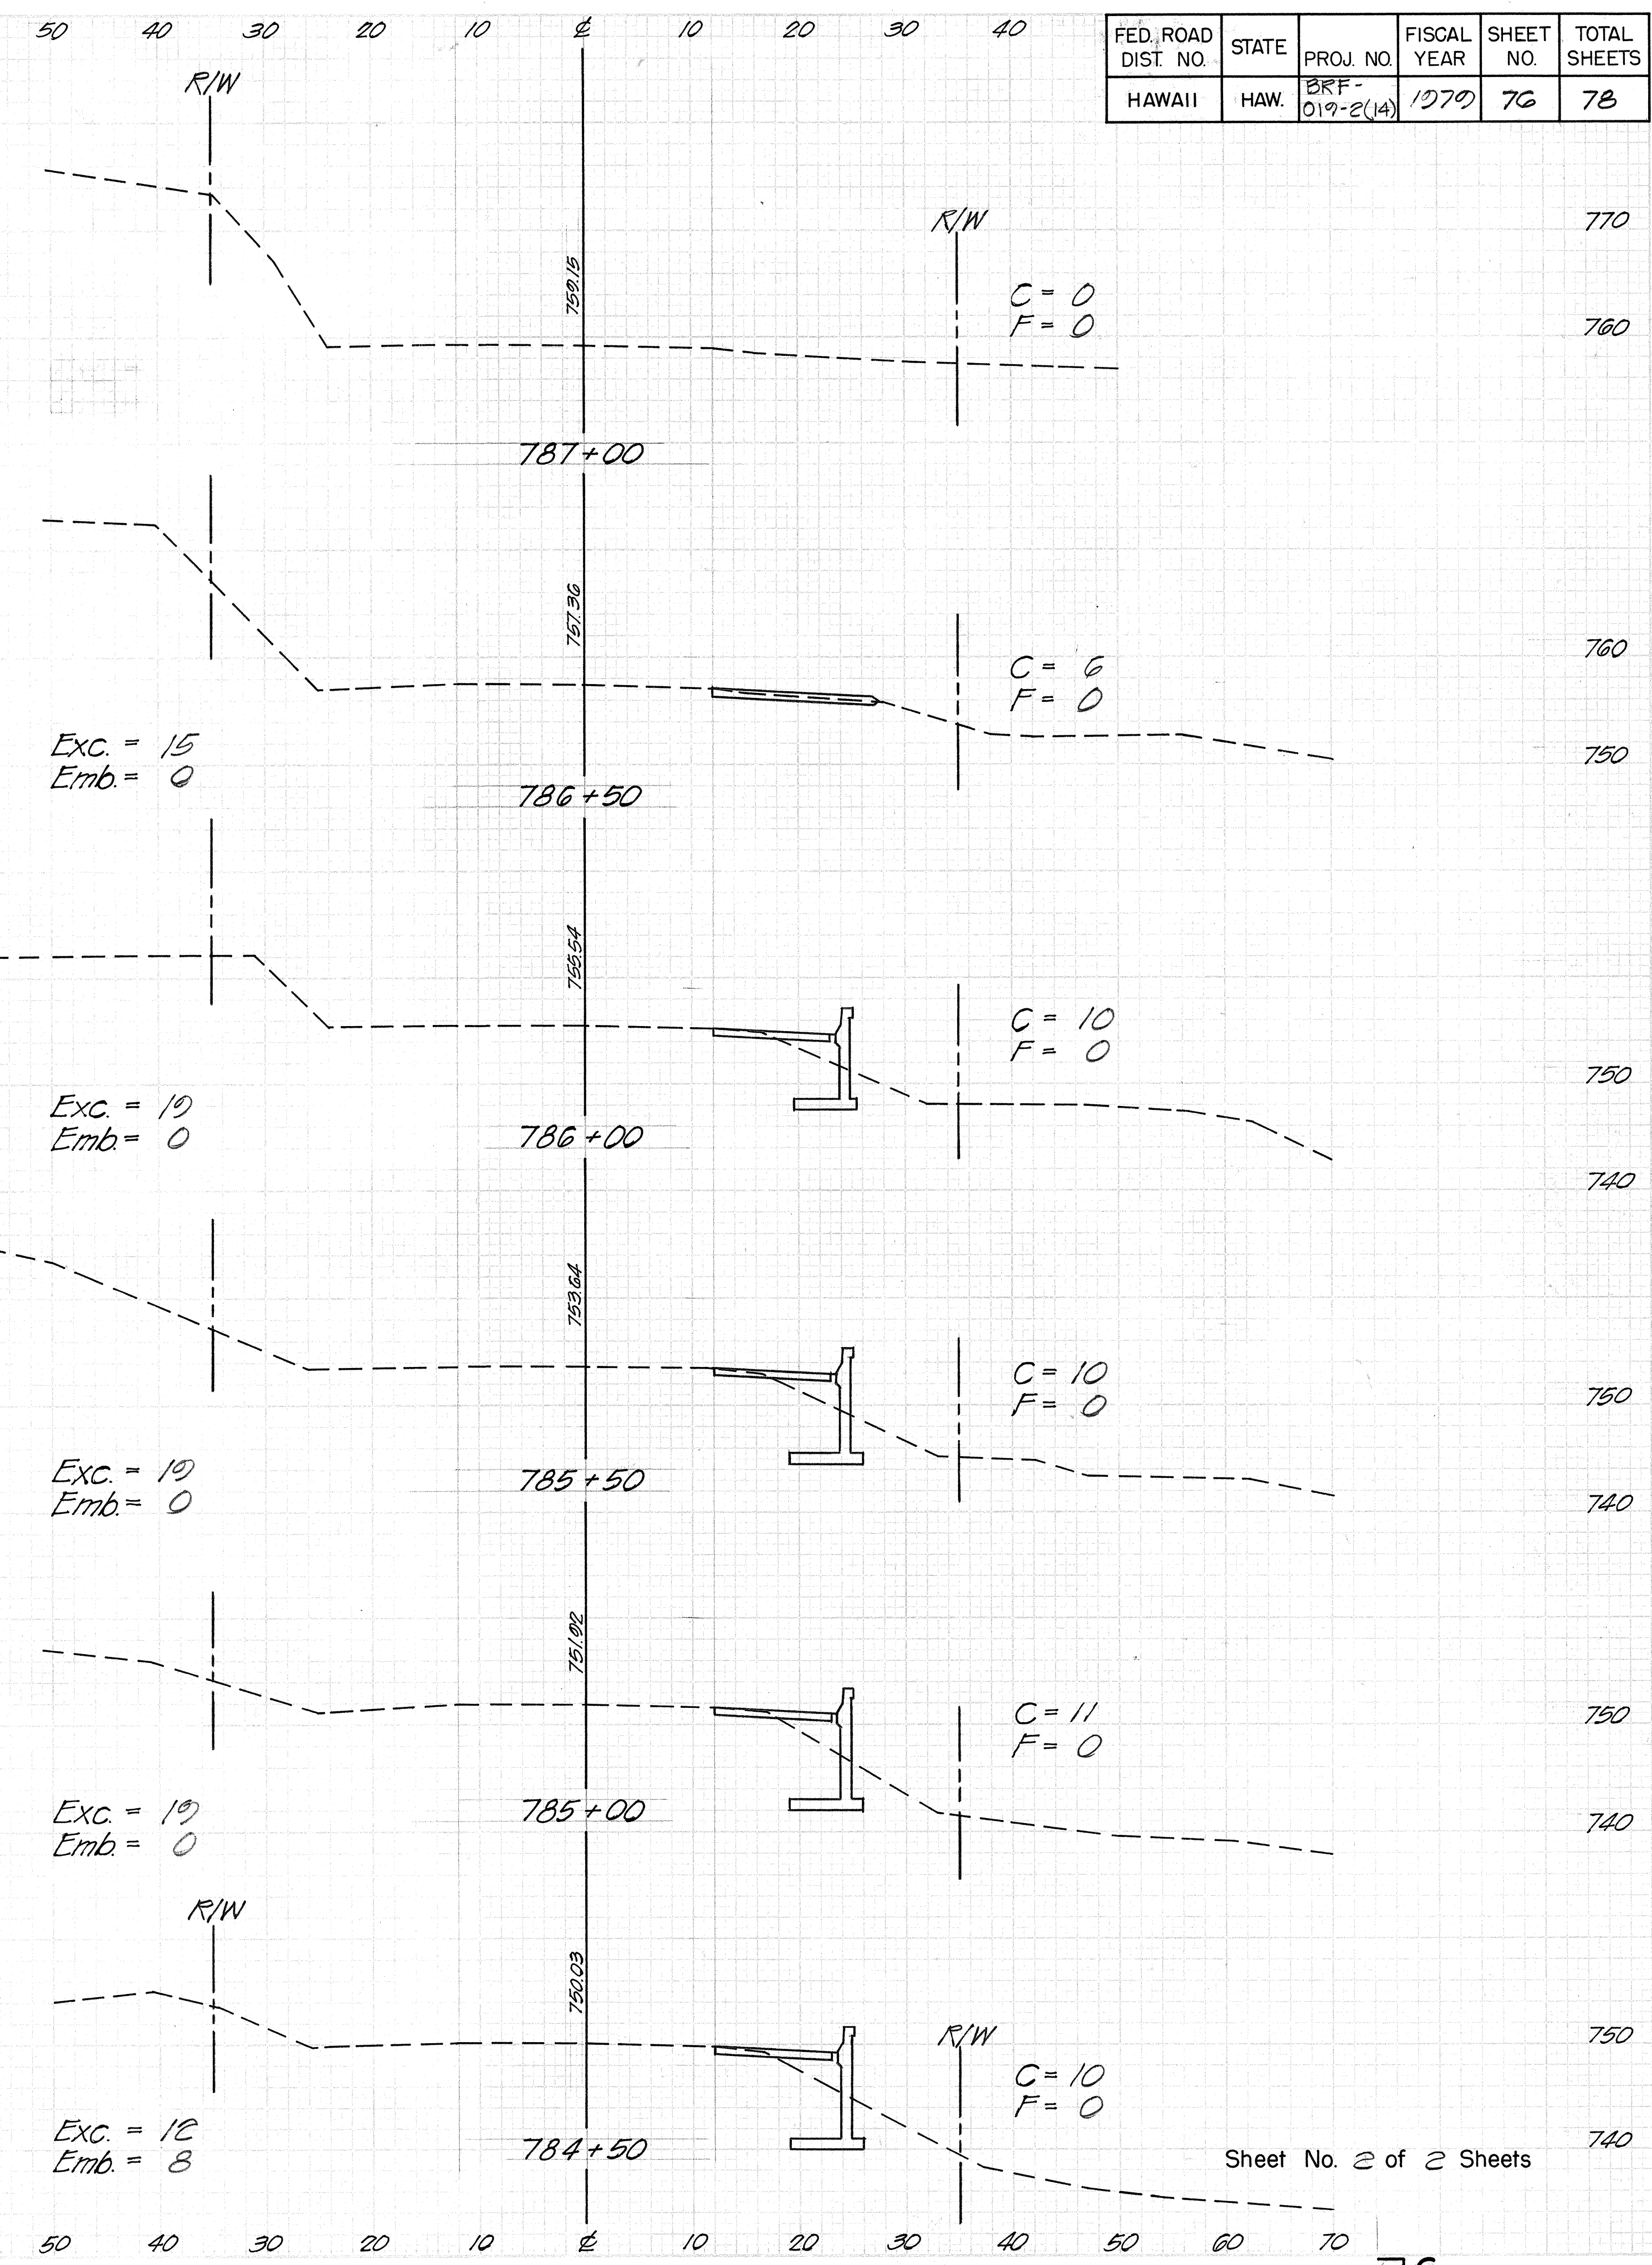

FED. ROAD DIST. NO.	STATE	PROJ. NO.	FISCAL YEAR	SHEET NO.	TOTAL SHEETS
HAWAII	HAW.	BRF-019-2(14)	1970	76	78

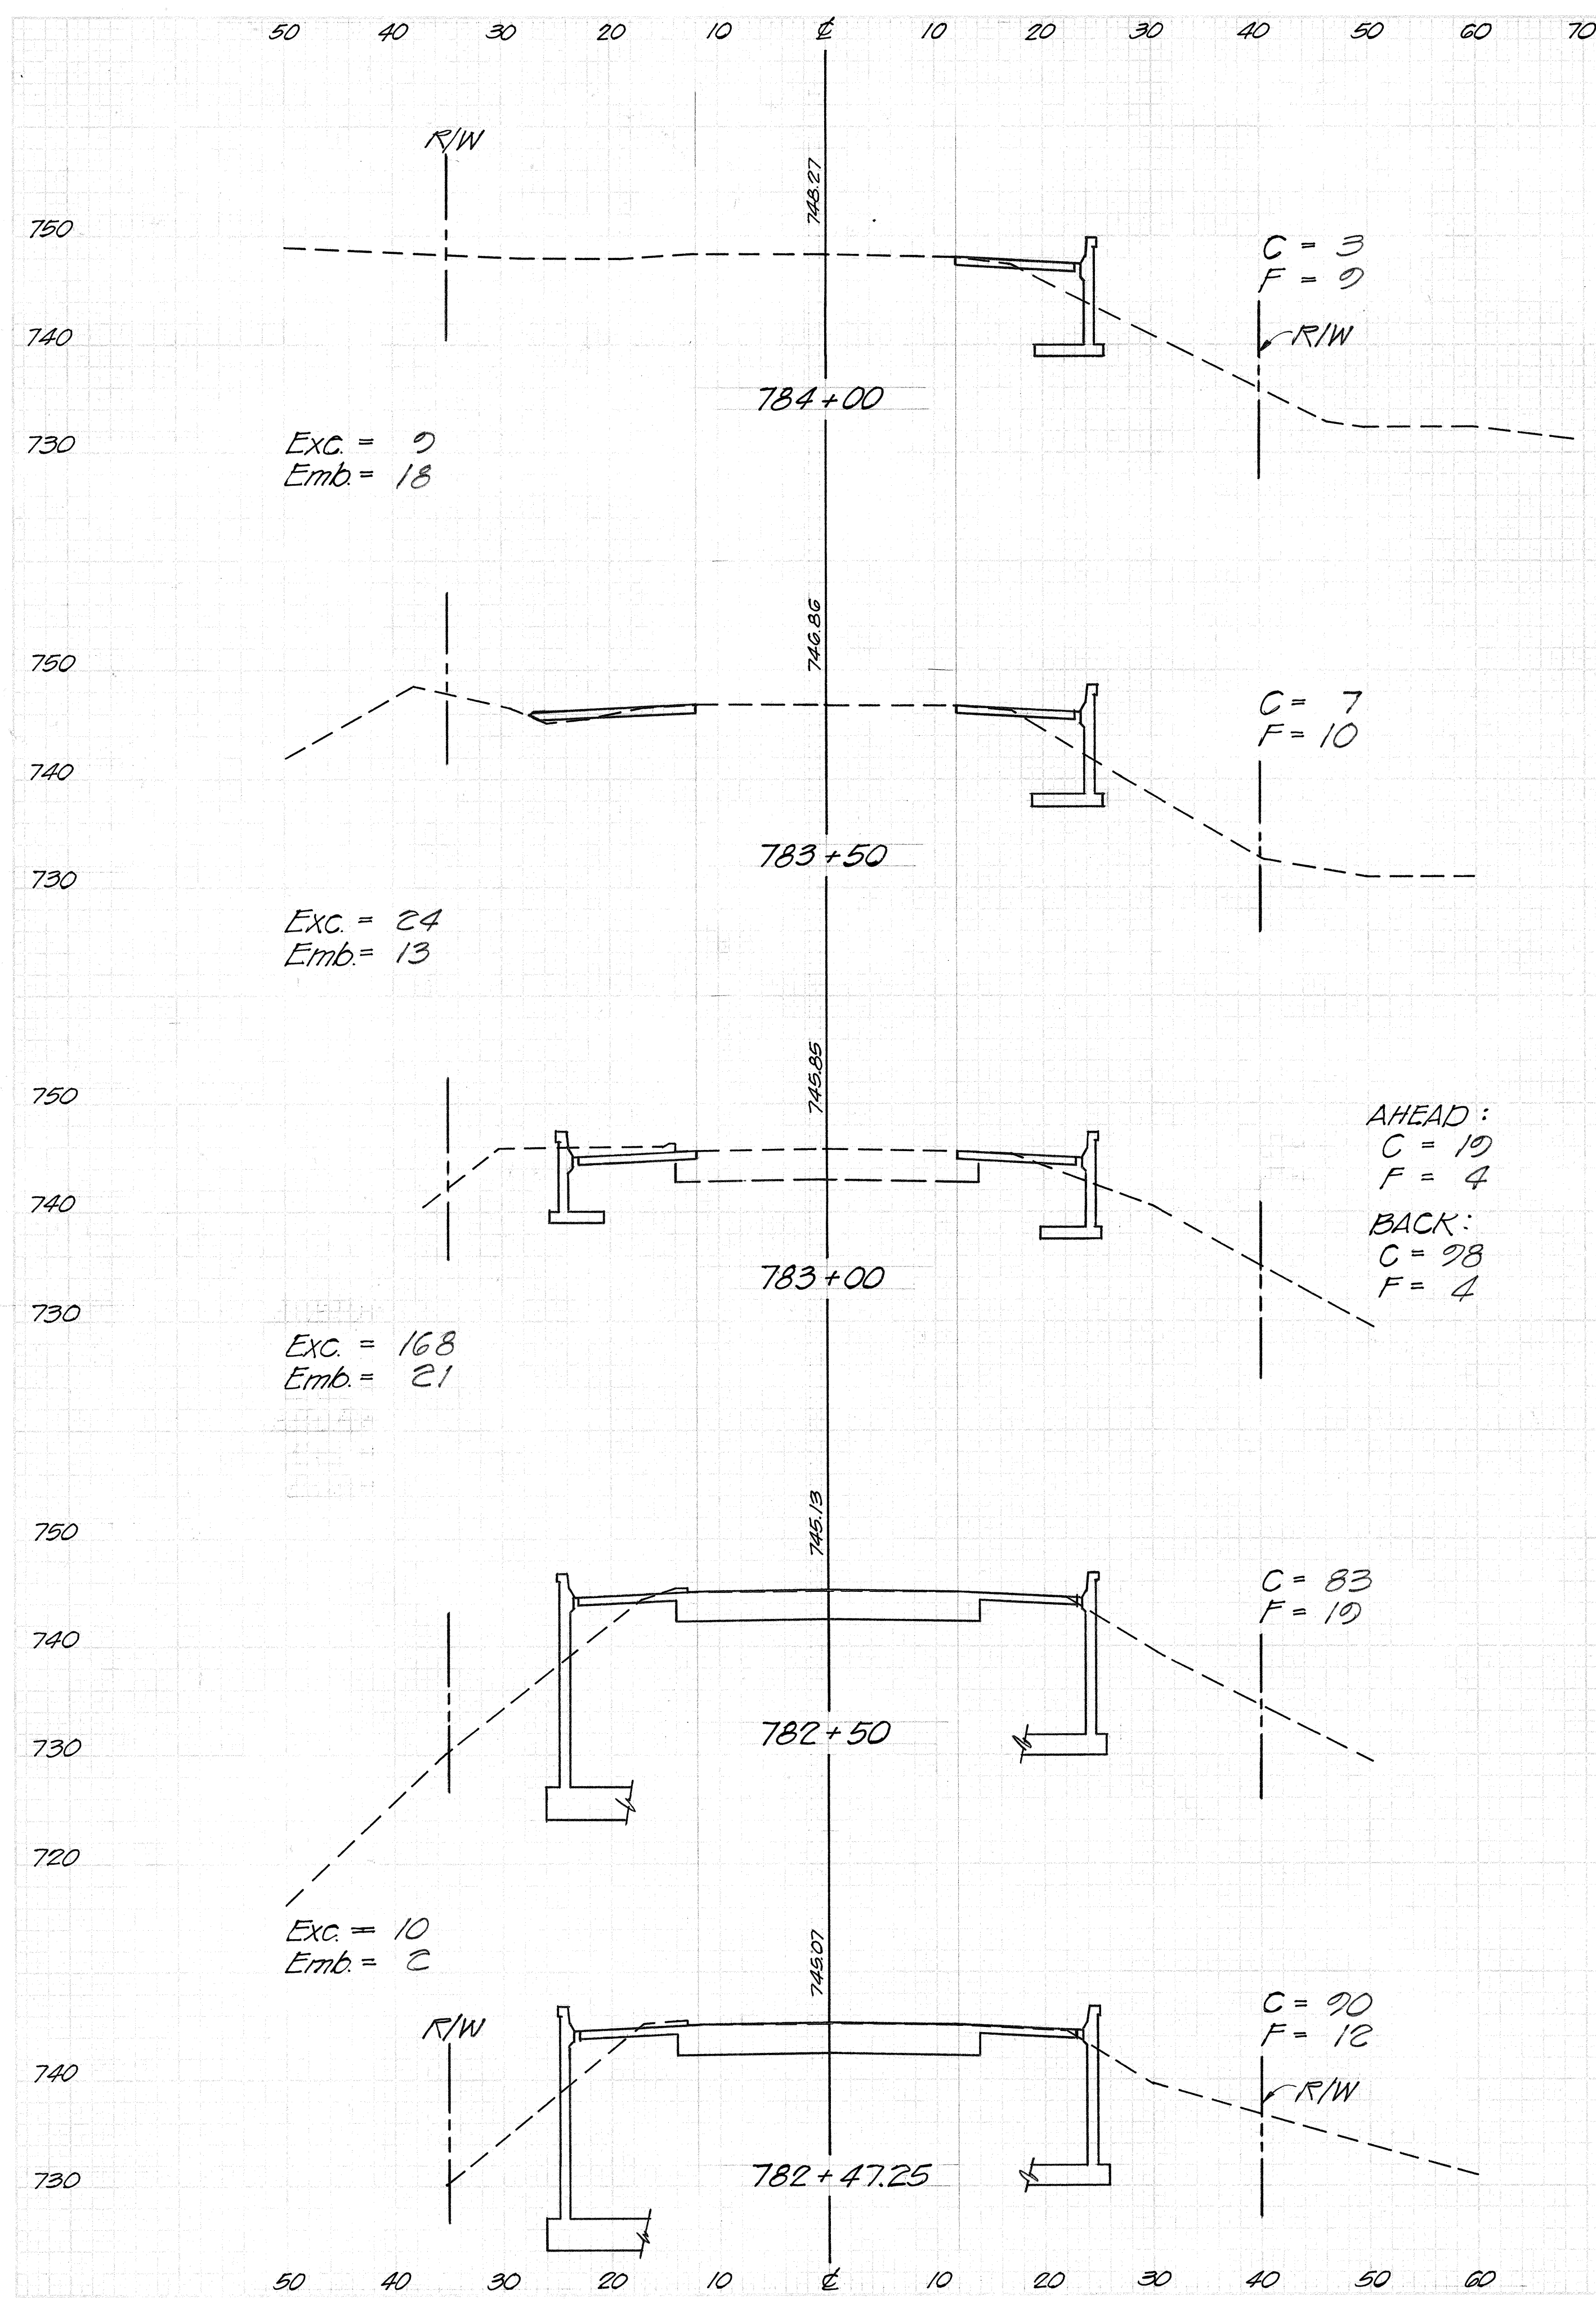

Sheet No. 2 of 2 Sheets

FED. ROAD DIST. NO.	STATE	FED. AID PROJ. NO.	FISCAL YEAR	SHEET NO.	TOTAL SHEETS
HAWAII	HAW.	BKF-019-2(14)	1979	77	78

DATE	BY	REVISION	REVISION	REVISION
		1	2	3

DATE	BY	REVISION	REVISION	REVISION
2/79		1	2	3

