

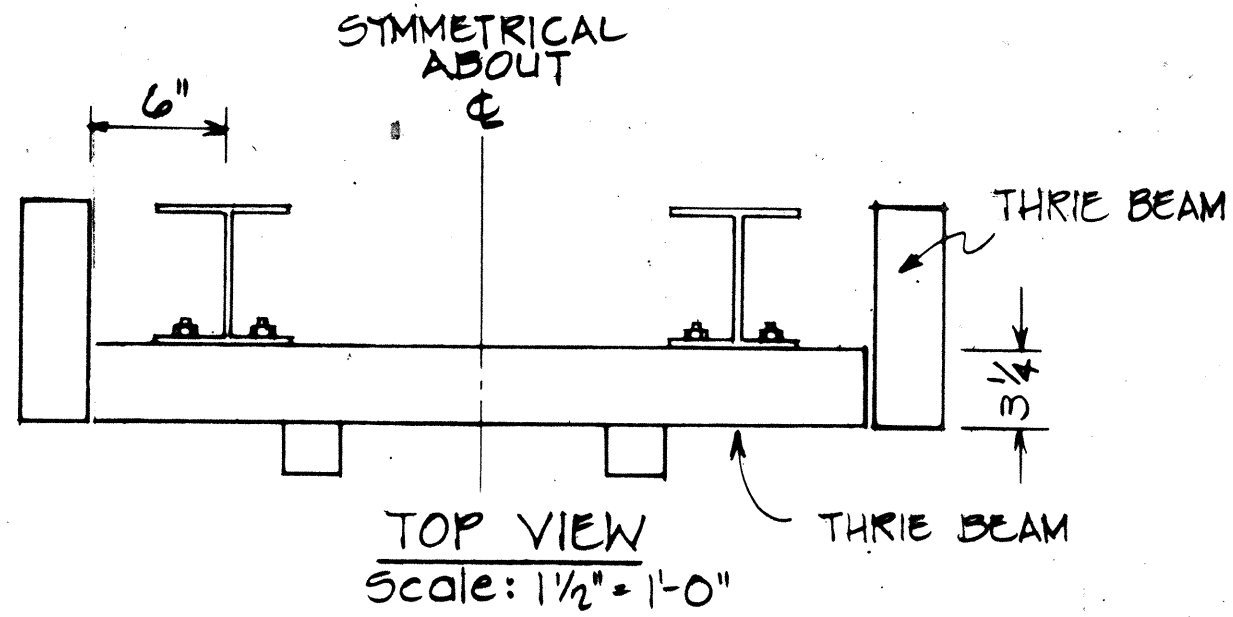
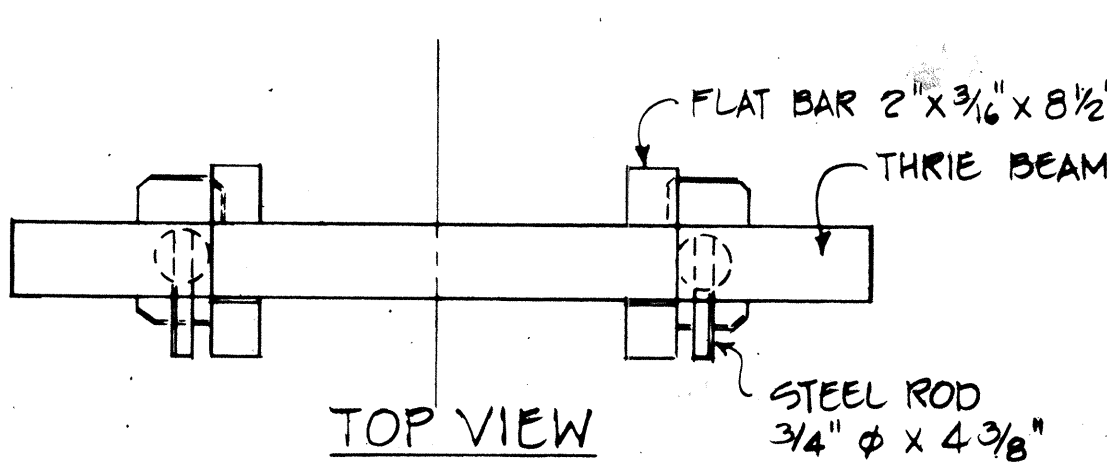
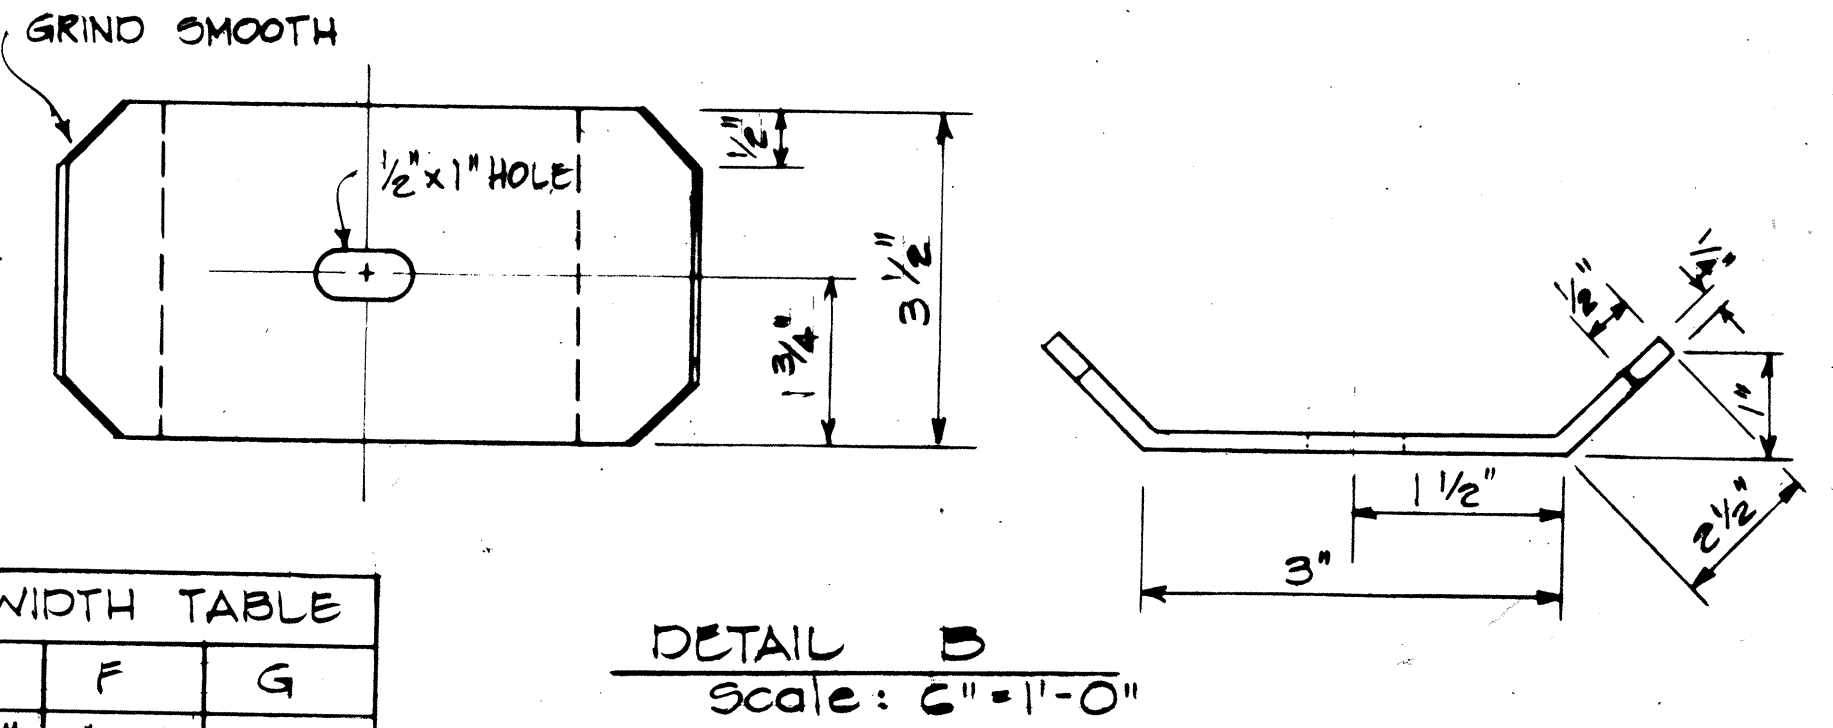
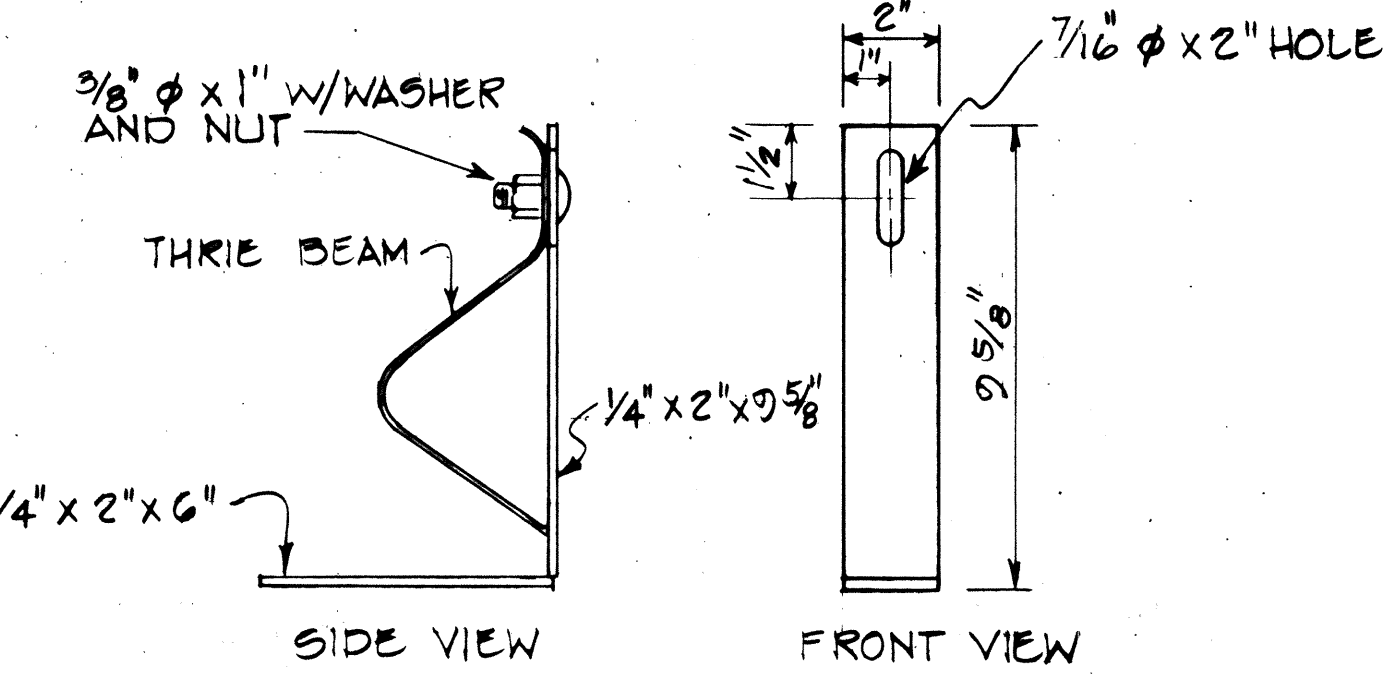
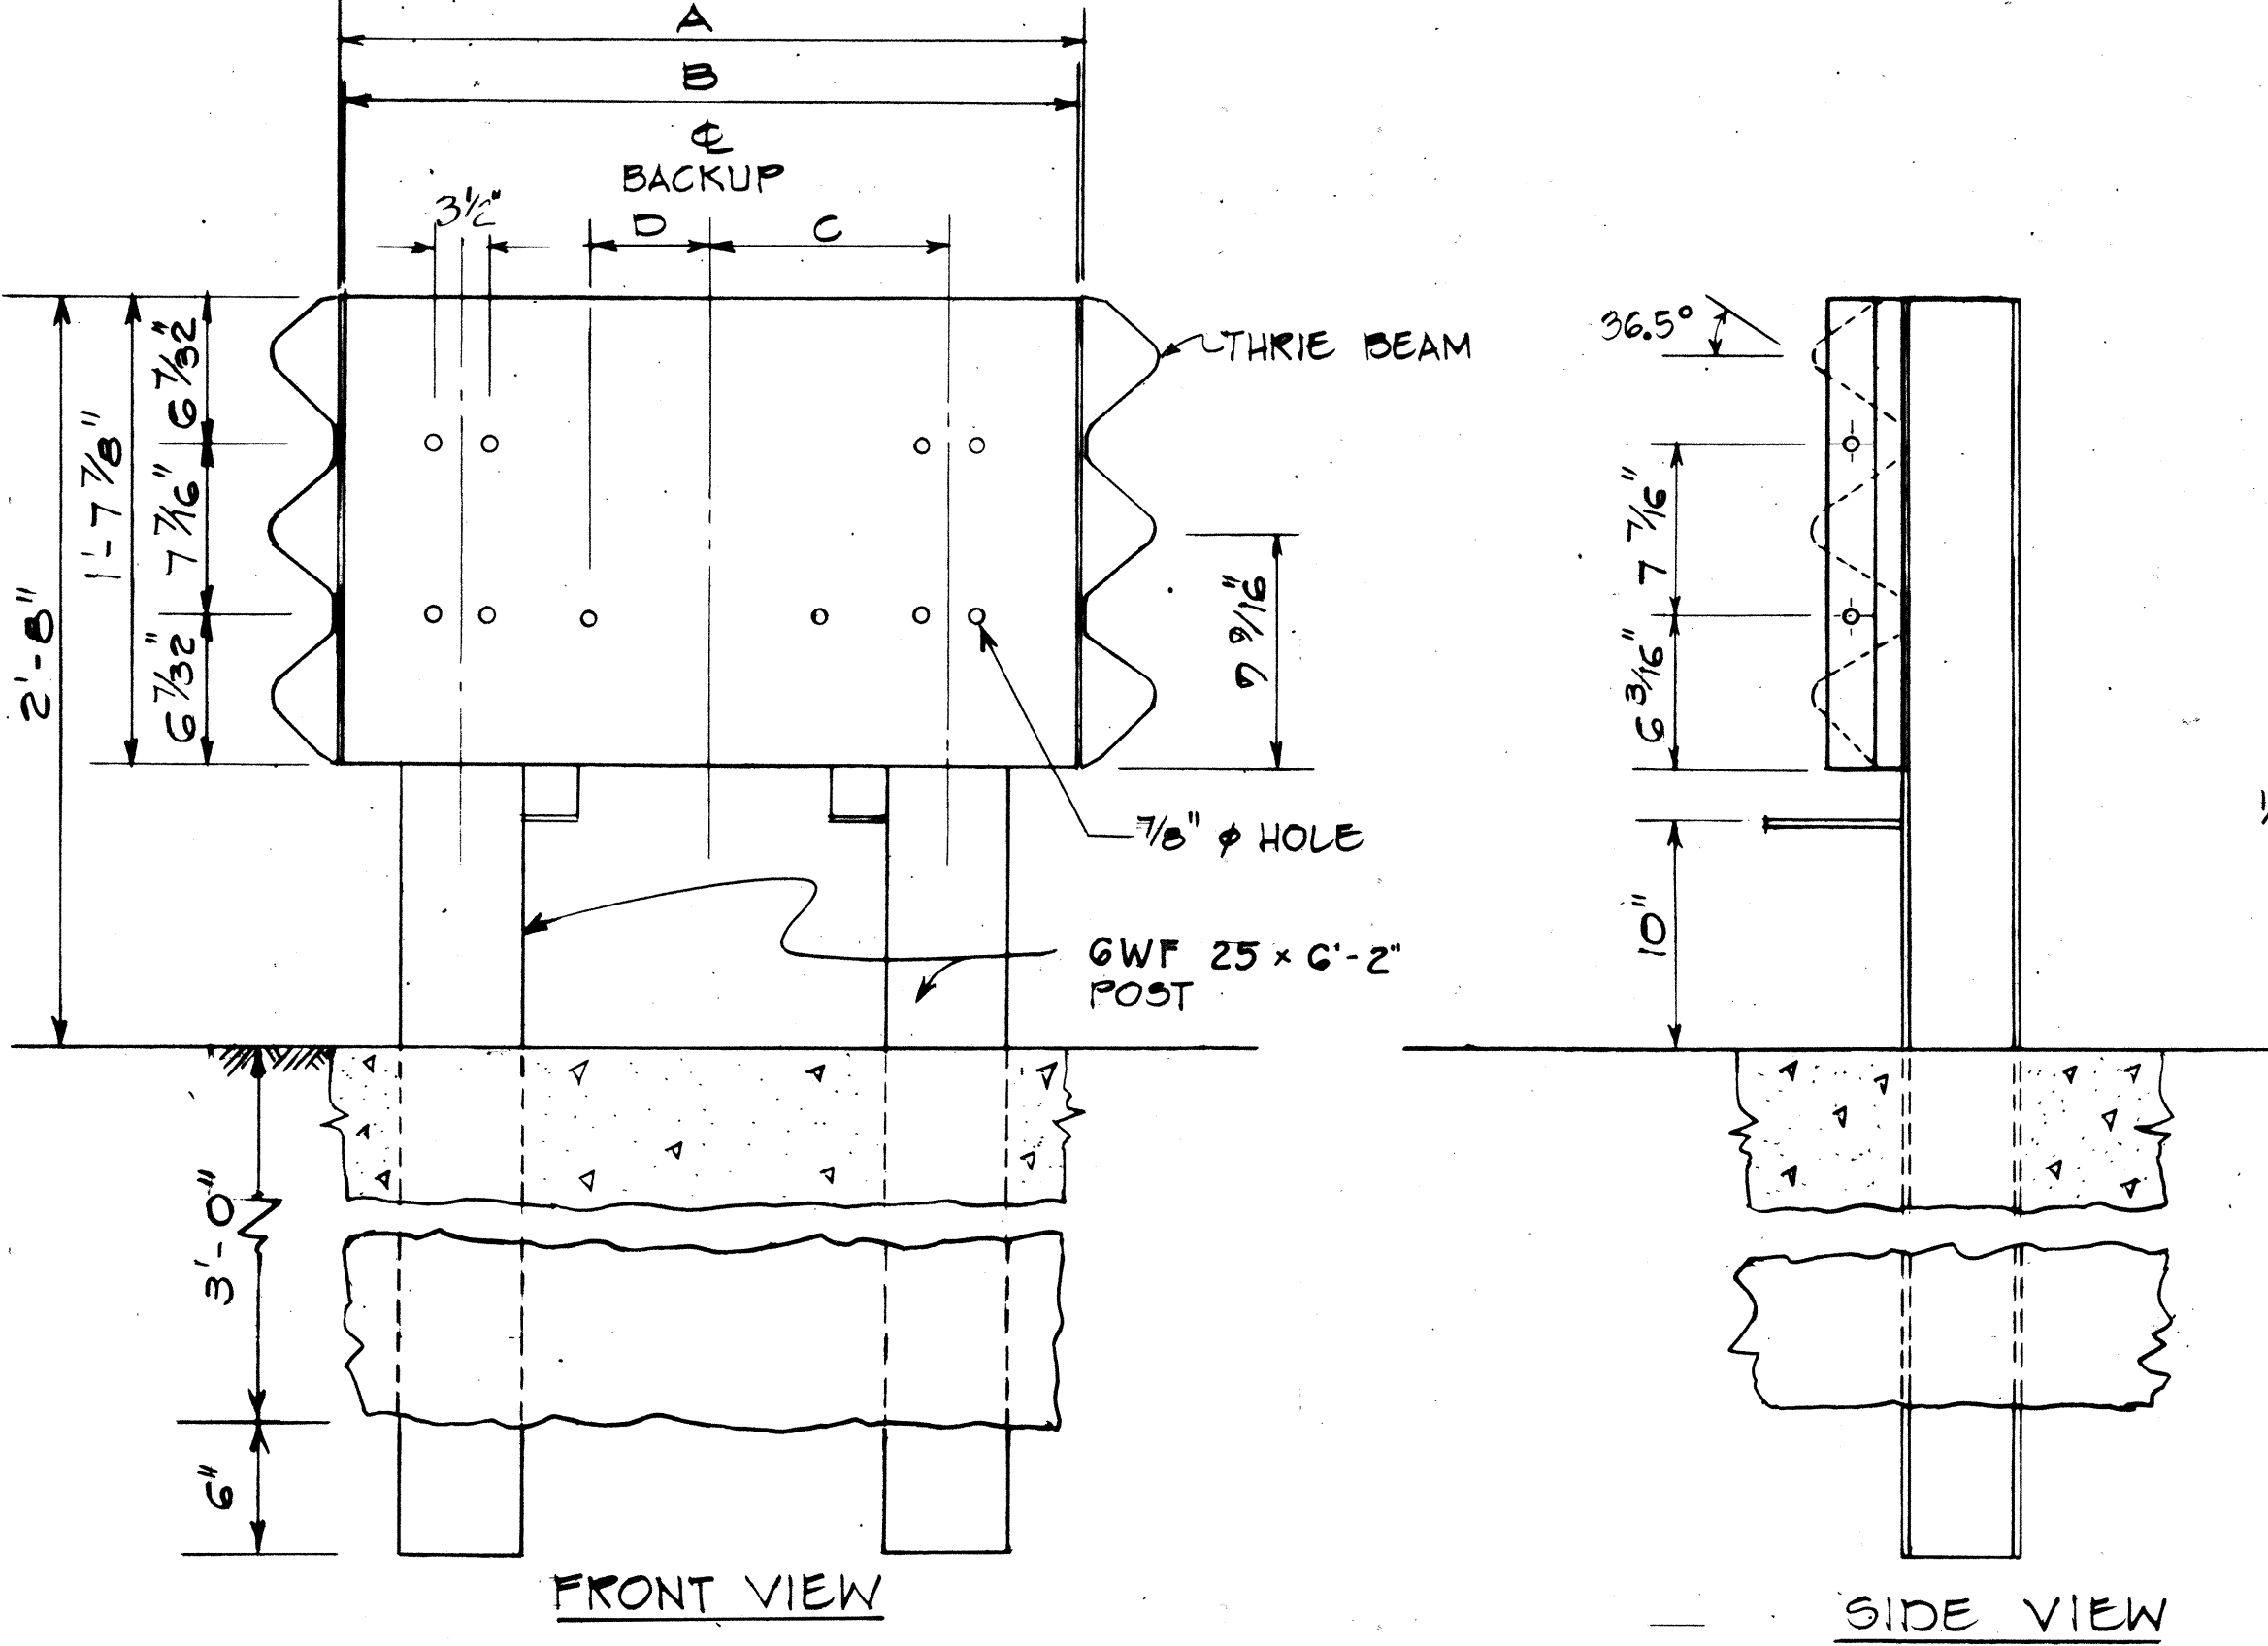





FED. ROAD DIST. NO.	STATE	FED. AID PROJ. NO.	FISCAL YEAR	SHEET NO.	TOTAL SHEETS
HAWAII	HAW.	DRF-012-2(14)	1979	74	78

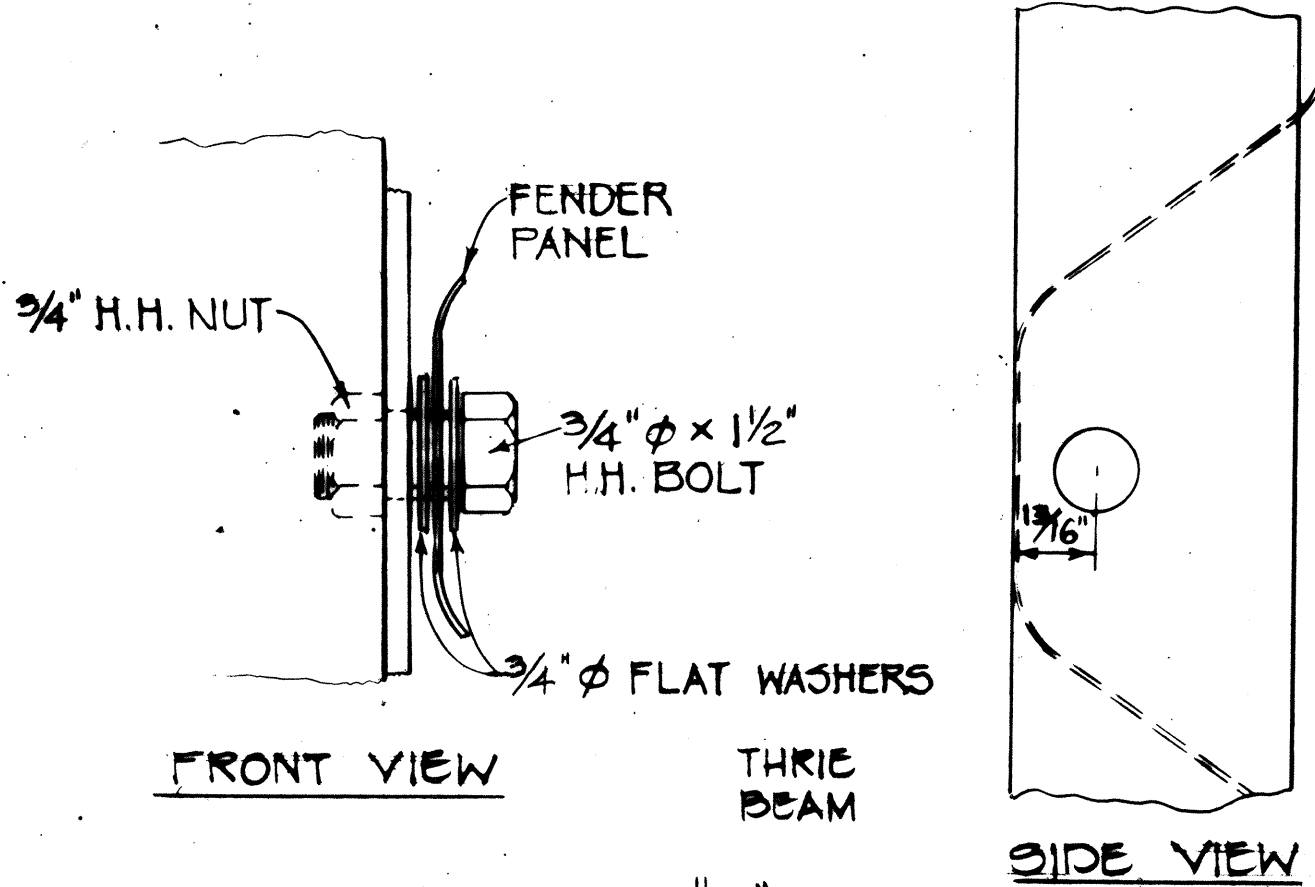

UNIT WIDTH	A	B	C	D
2'-0"	2'-0"	1'-11 1/2"	0'-6"	2"
2'-6"	2'-6"	2'-5 1/2"	0'-9"	5"
3'-0"	3'-0"	2'-11 1/2"	1'-0"	8"

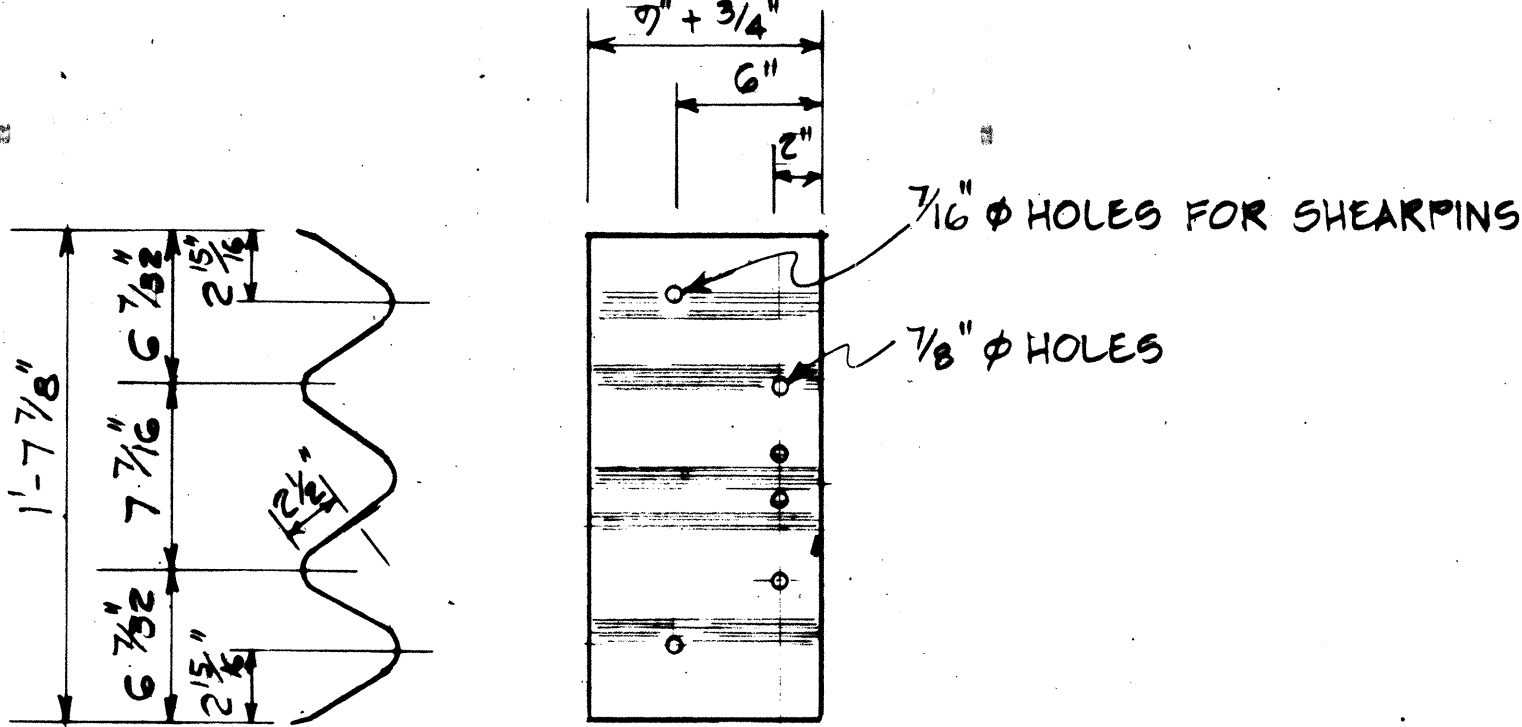

MODEL NO	E	F	G
2002005	2'-0"	1'-0"	
2062069	2'-6"	1'-3"	3 3/4"
3003005	3'-0"	1'-6"	8 3/4"

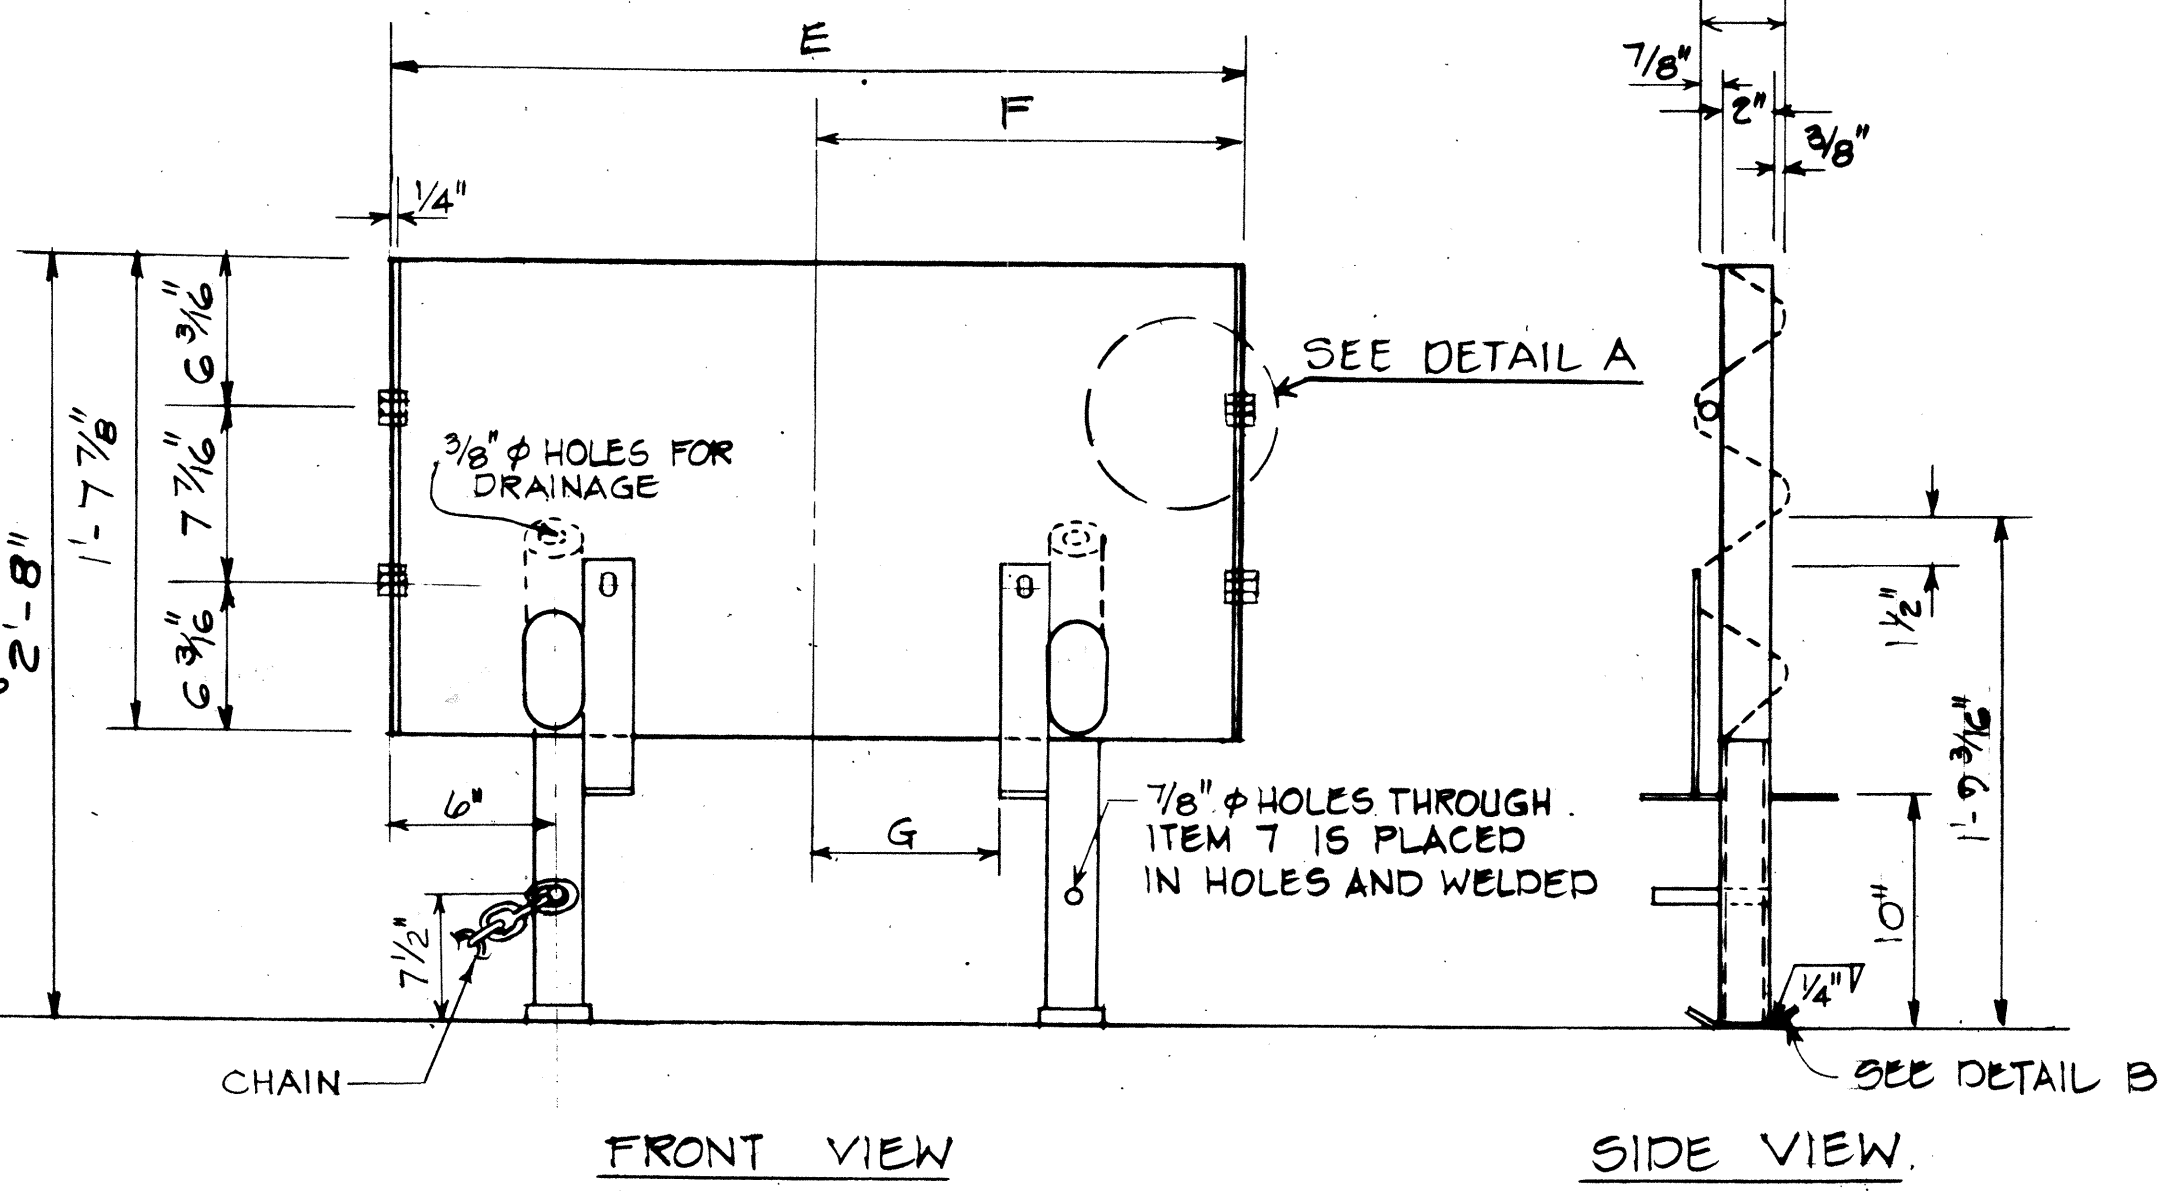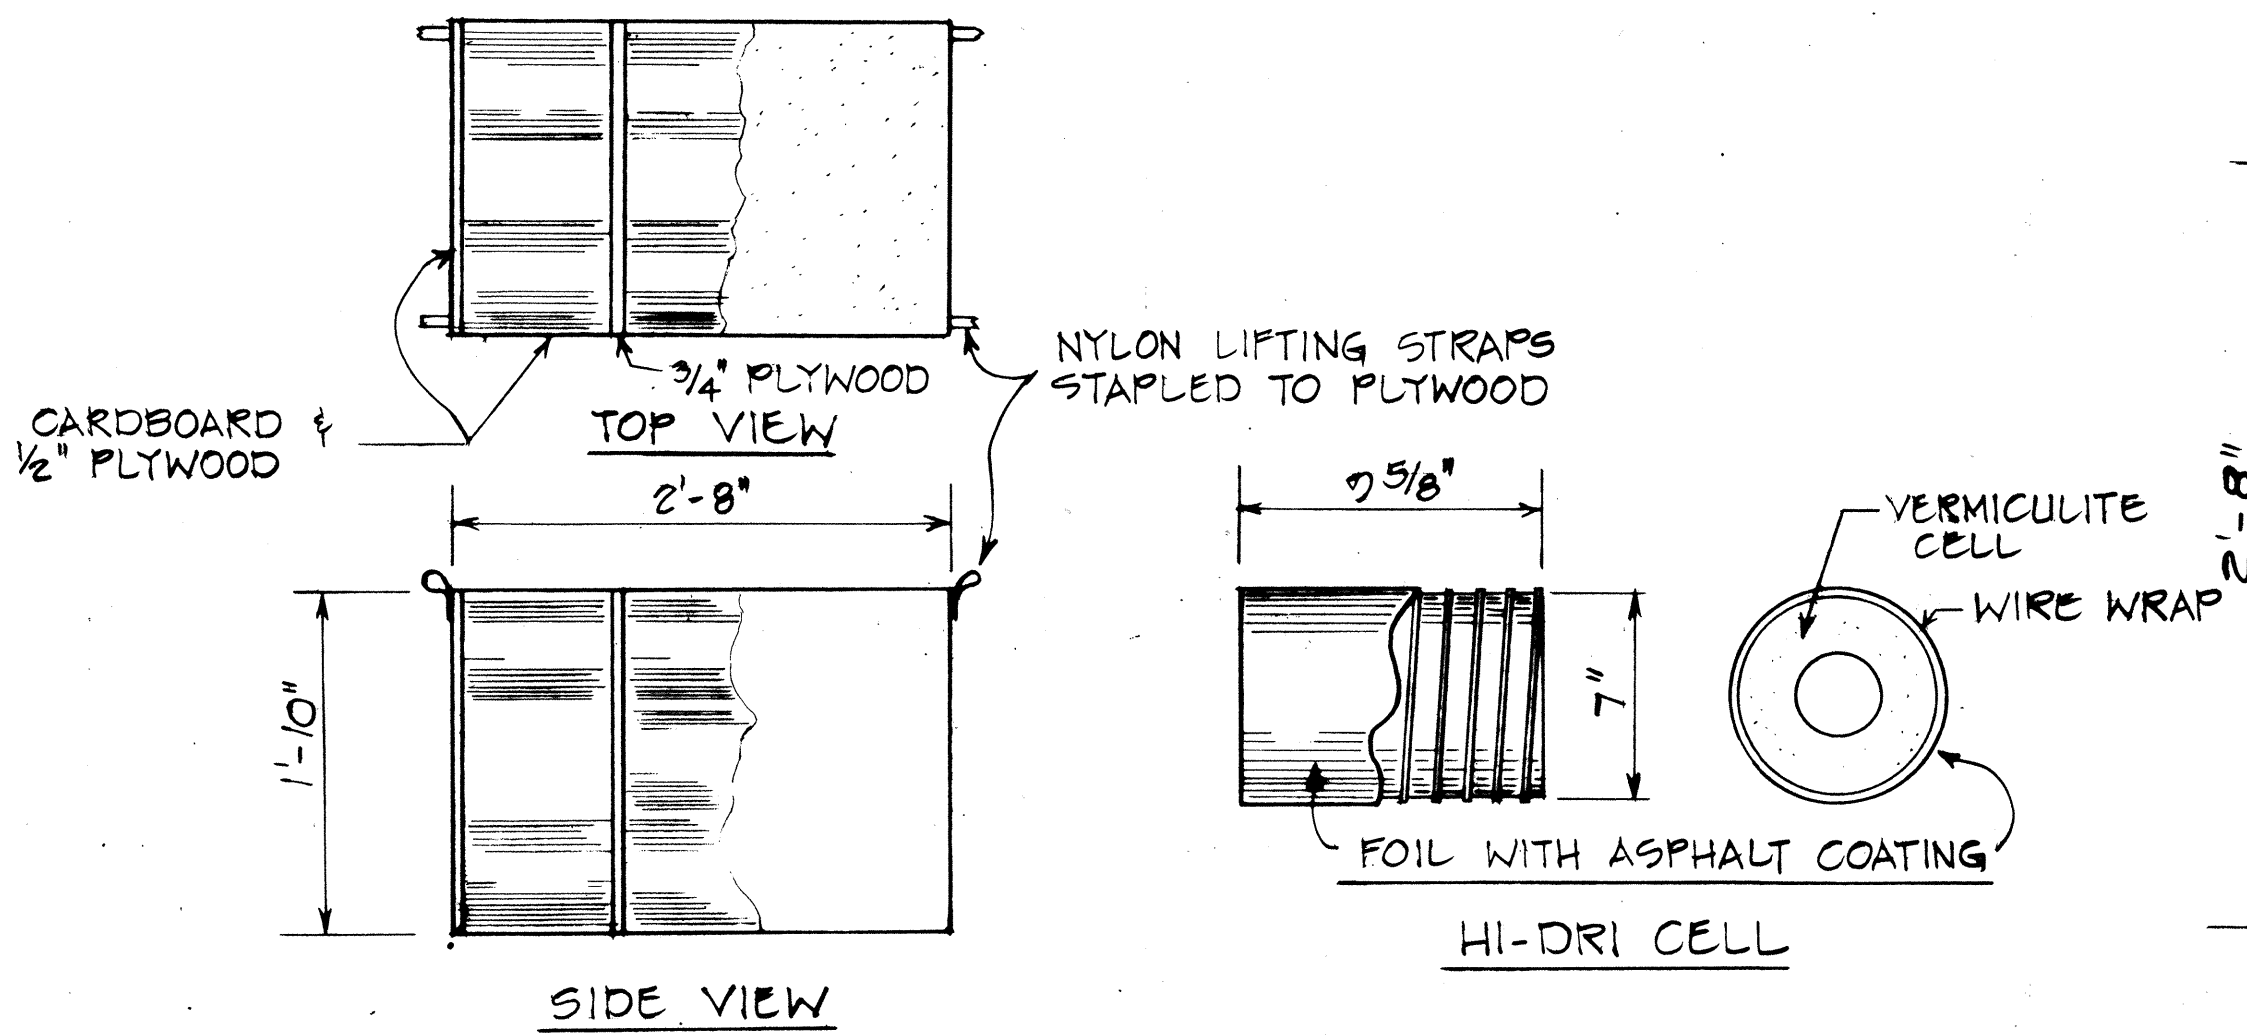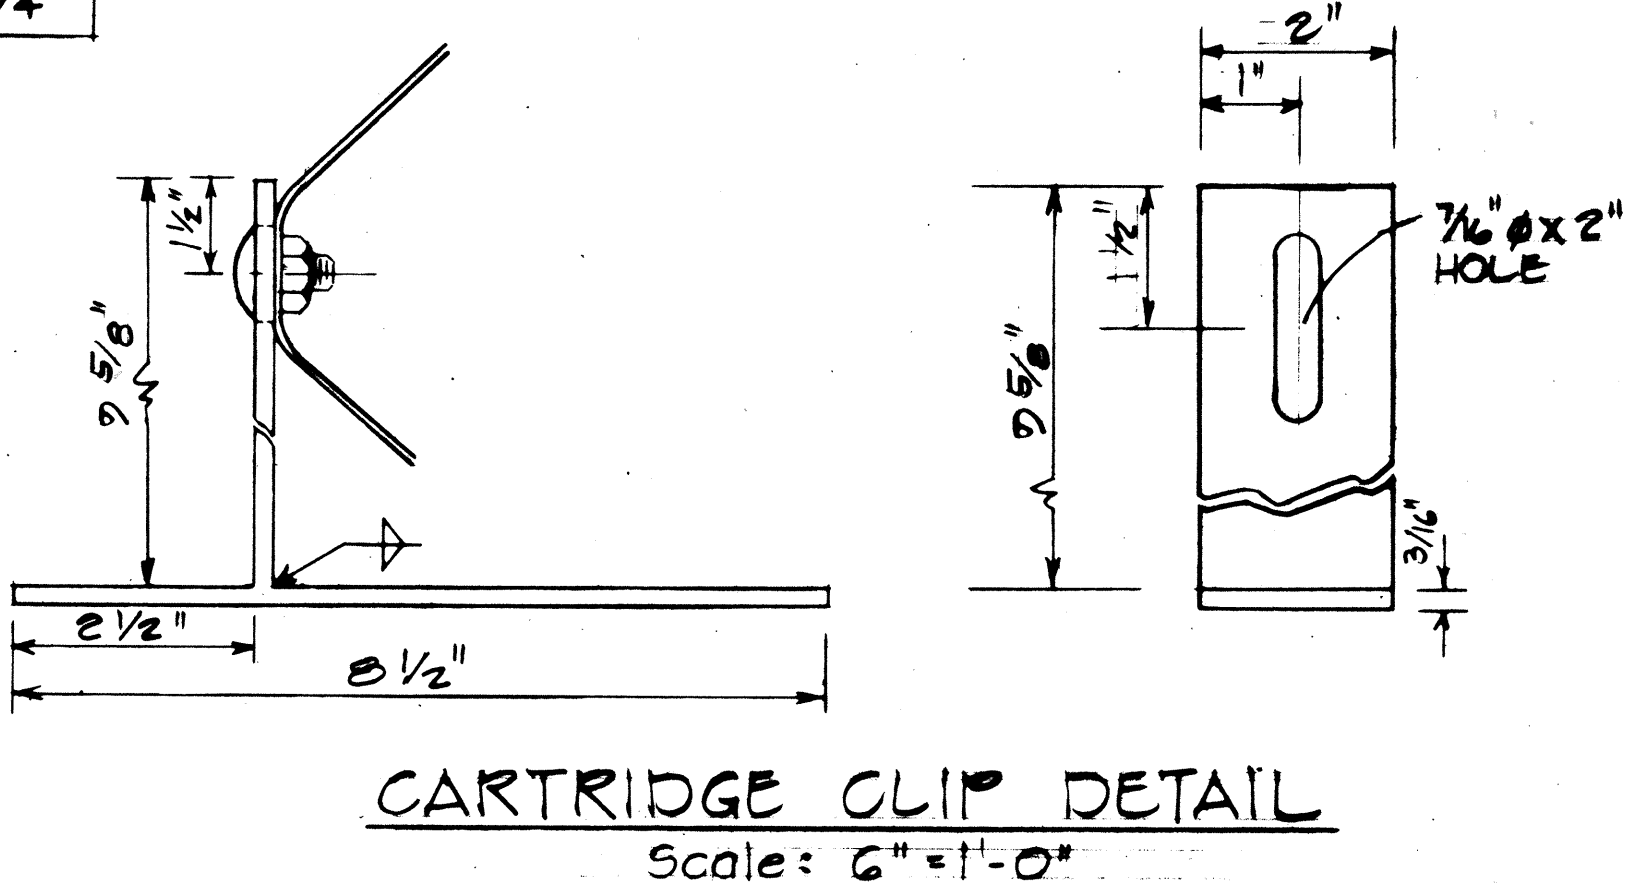

STATE OF HAWAII
DEPARTMENT OF TRANSPORTATION
LAND TRANSPORTATION DIVISION

DETAILS OF GUARD RAIL
ENERGY ABSORBING TERMINAL

Scale: As Shown Date: 1978

SHEET NO. 2 OF 2 SHEETS

SURVEY PLOTTED BY	DATE
DRAWN BY	
DESIGNED BY	
NOTED BY	
CHECKED BY	
NO.	