
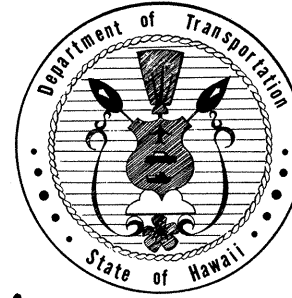


INDEX TO DRAWINGS	
SHEET NO.	DESCRIPTION
1	TITLE SHEET
2	TYPICAL SECTIONS
3	PLAN & PROFILE
4	DRIVEWAY CONNECTION DET.
5	NEW 8" WATERLINE DETAILS
6 - 15	MAKAI DETOUR RD. DETAILS
16 - 19	TRAFFIC SIGNS, STRIPING, AND PAVEMENT MARKERS
20 - 51	EAST PAAUILO BRIDGE PLANS
52 - 54	STANDARD DETAILS (BRIDGE)
55 - 57	EXISTING EAST PAAUILO BRIDGE
58 - 72	STANDARD DETAILS
73 - 74	GUARD RAIL ENERGY ABSORBING TERMINAL
75 - 78	CROSS SECTIONS

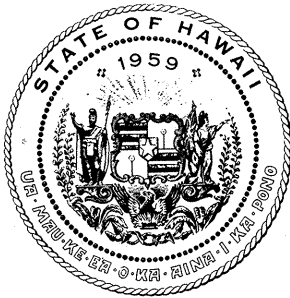

STATE OF HAWAII

DEPARTMENT OF TRANSPORTATION

HIGHWAYS DIVISION

"AS BUILT"

PLANS FOR

CONSTRUCTION OF

HAWAII BELT ROAD

EAST PAAUILO BRIDGE REPLACEMENT

FEDERAL AID PROJECT NO. BRF-019-2(14)



DISTRICT OF HAMAKUA

ISLAND OF HAWAII

CONTRACTOR: JAS. W. GLOVER, LTD.

CONTRACT NO. 11626

FED. ROAD DIST. NO.	STATE	FED. AID PROJ. NO.	FISCAL YEAR	SHEET NO.	TOTAL SHEETS
HAWAII	HAW.	BRF-019-2(14)	1979	1	78

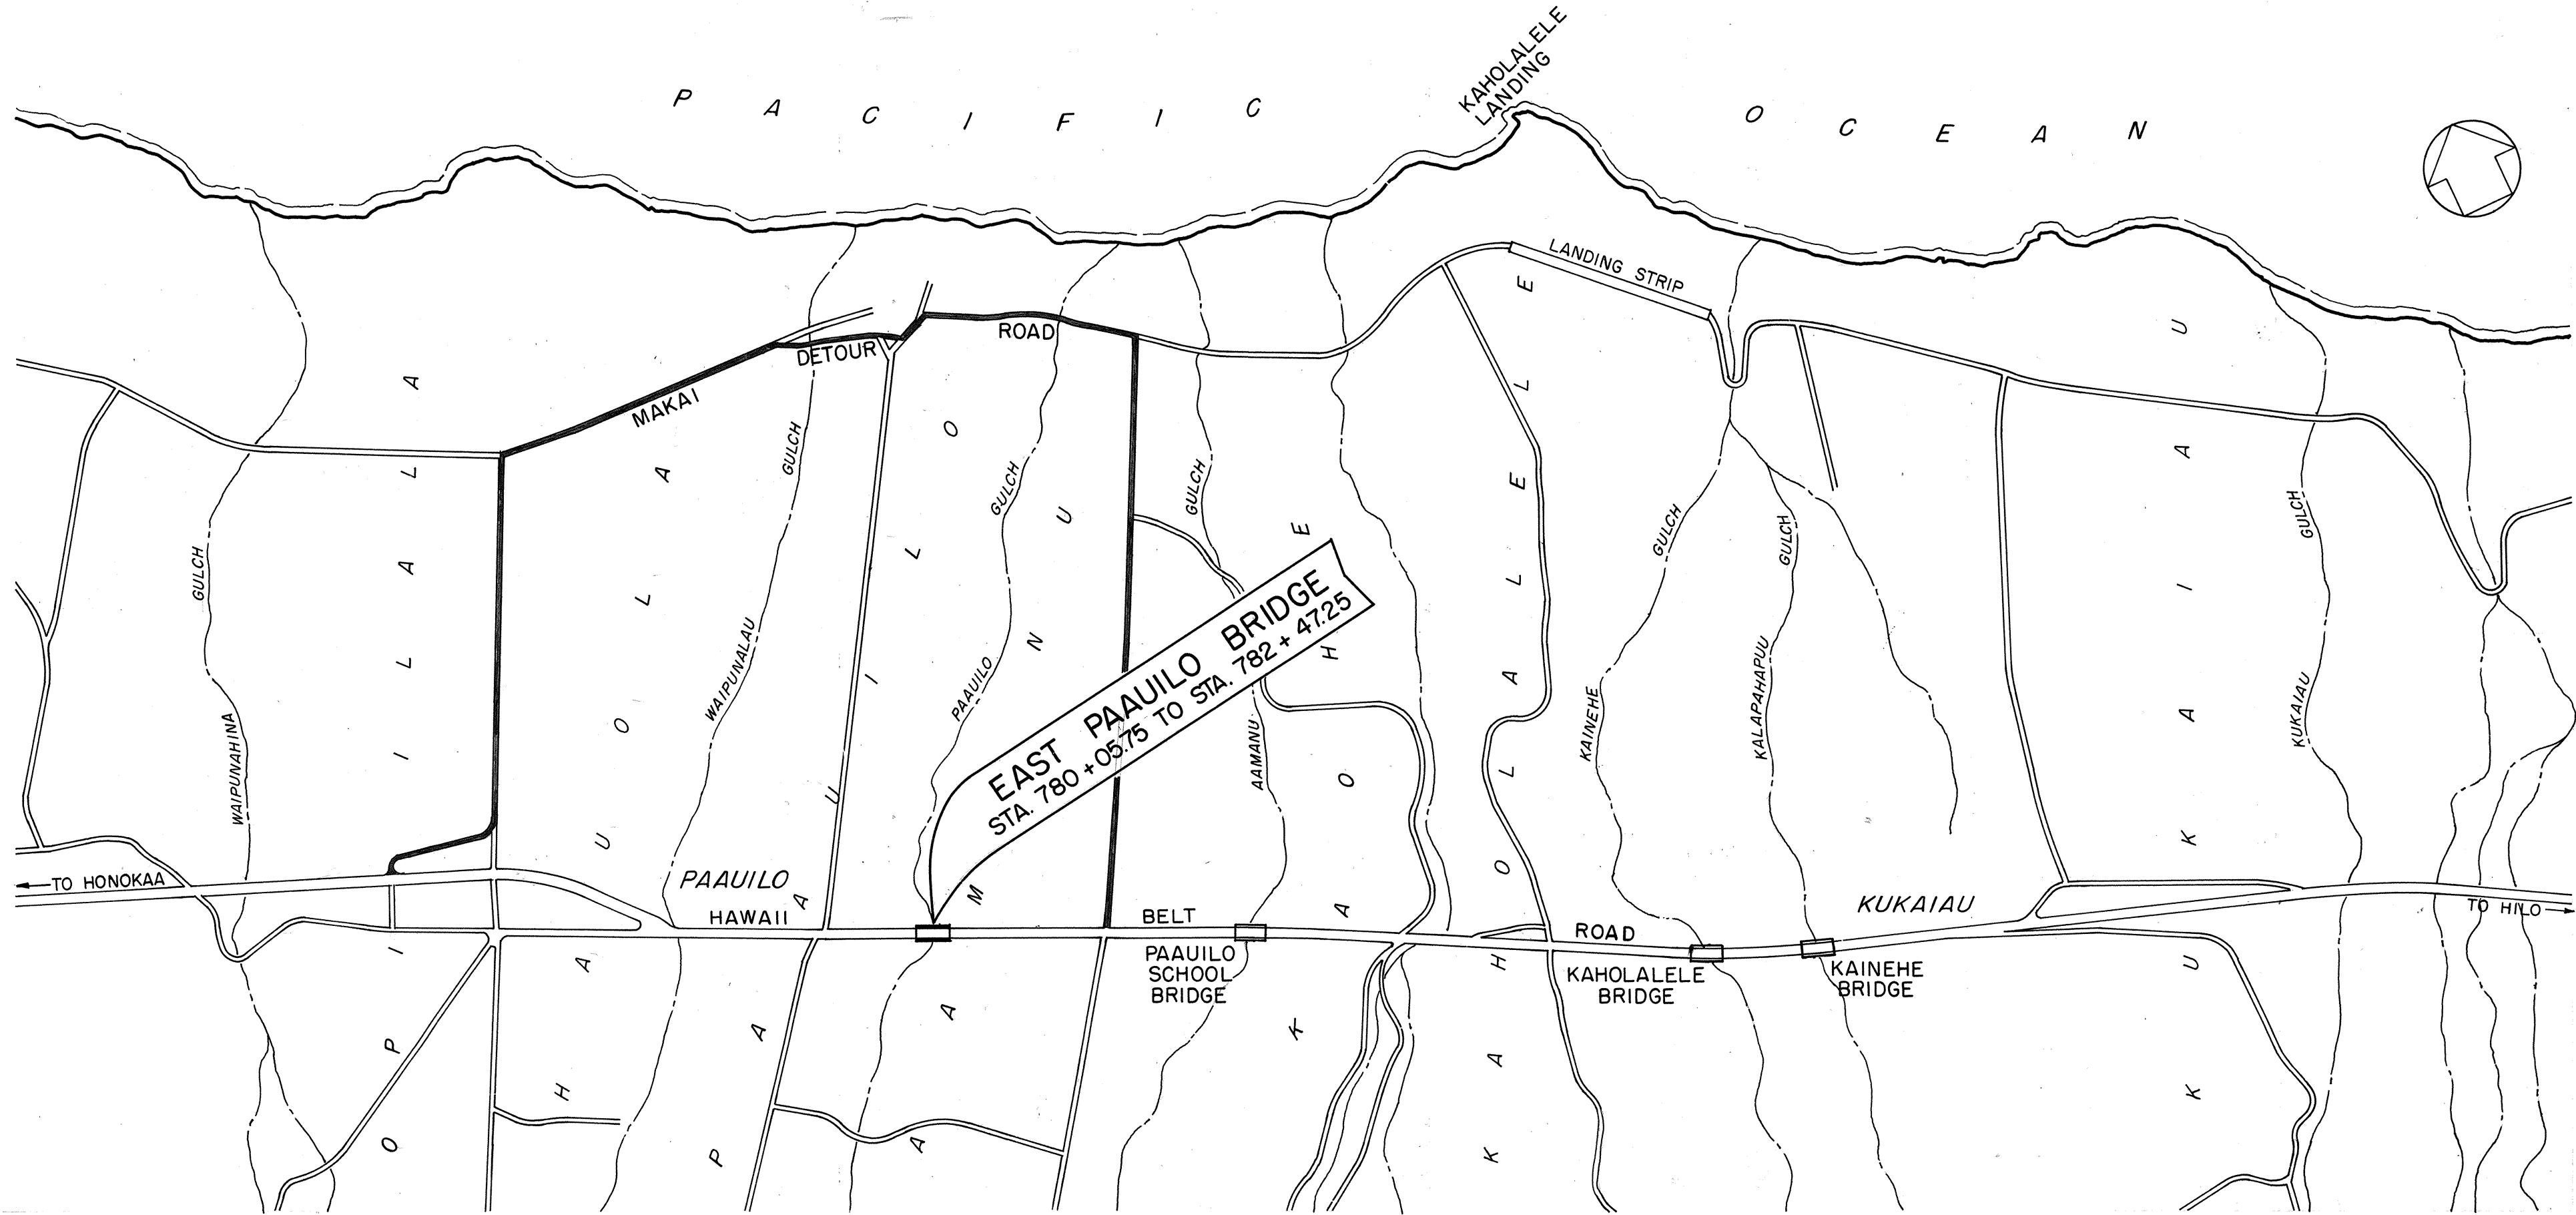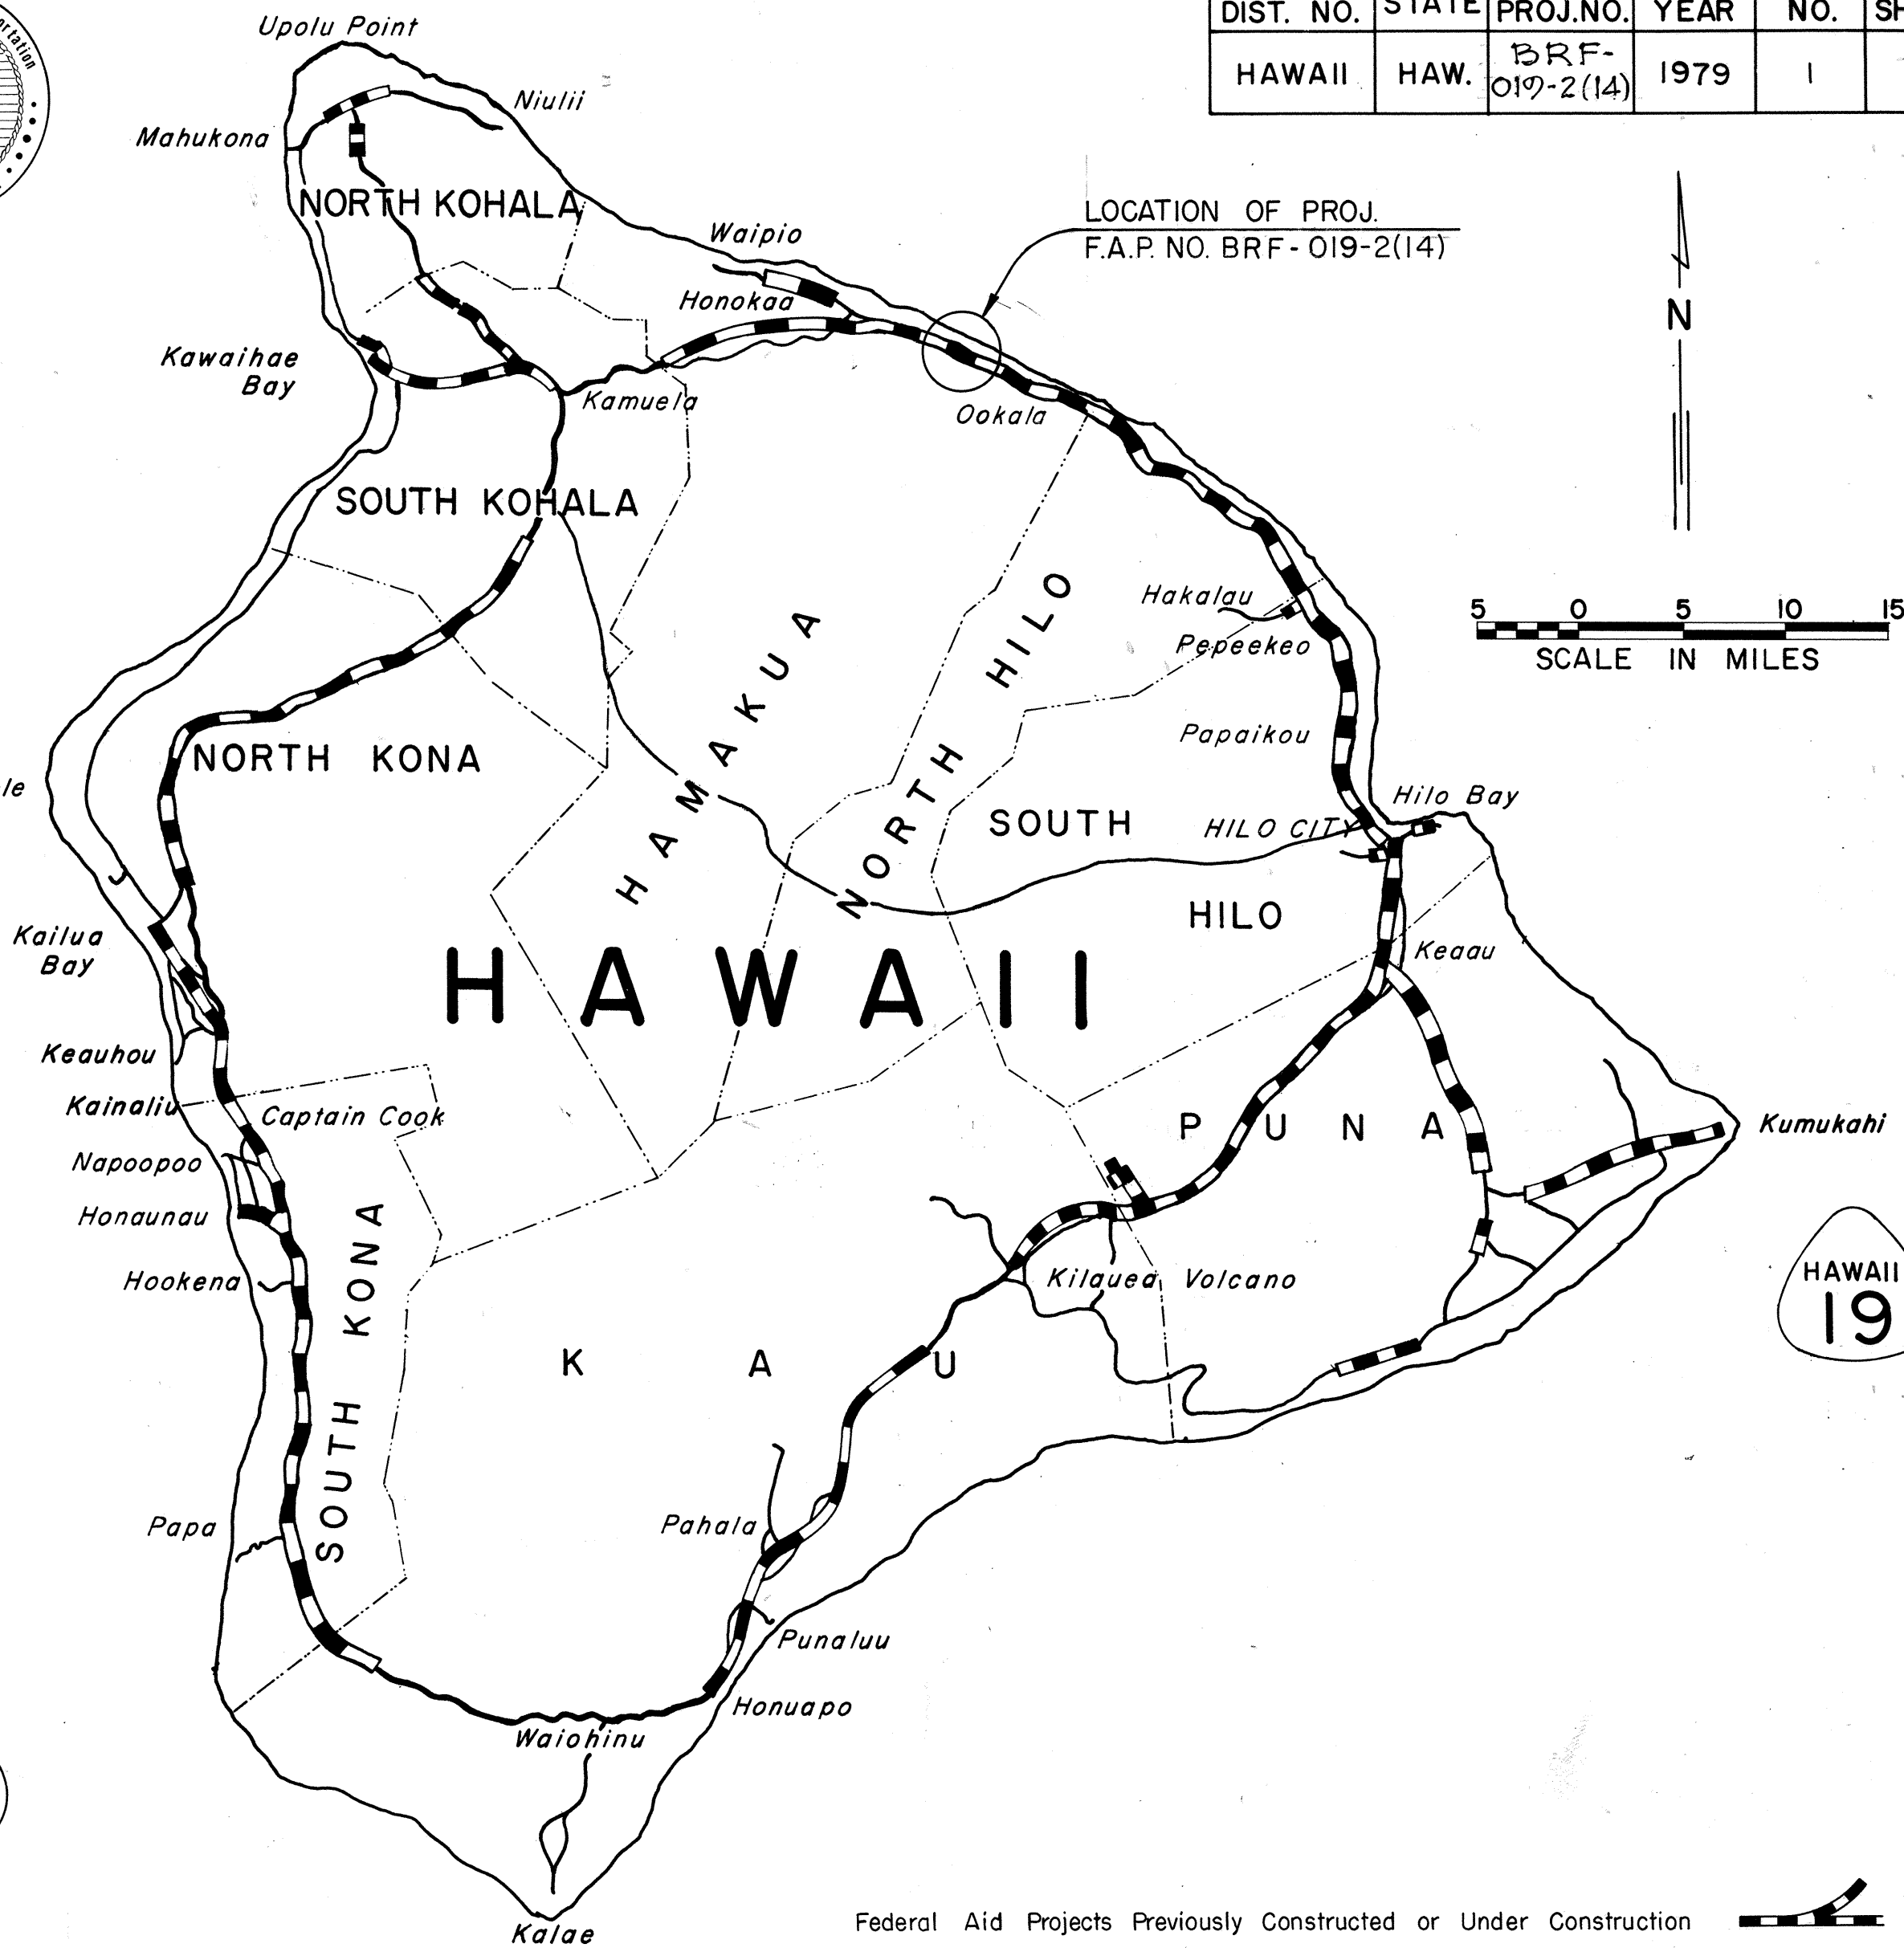

NOTE:

ALL CHANGES MADE DURING CONSTRUCTION HAVE BEEN NOTED IN RED ON THESE TRACINGS AND CHECKED BY

Anthony J. Vincent
RESIDENT ENGINEER

Nov 24 1981
DATE

DESIGN DESIGNATION

CURRENT ADT (1978)	3,600
DESIGN ADT (1998)	6,400
DHV	600
D	50/50
T	8.0 %
K	9.5 %

DEPARTMENT OF TRANSPORTATION
FEDERAL HIGHWAY ADMINISTRATION

APPROVED:

[Signature]
DIVISION ADMINISTRATOR

11-13-79
DATE

DEPARTMENT OF TRANSPORTATION
STATE OF HAWAII

APPROVED:

Propicki Higashionna
DIR. OF TRANSPORTATION

10/31/78
DATE

TOTAL LENGTH OF BRIDGE0457 Mi.

HAWAII DISTRICT
DESIGNED BY
A. YAMAGUCHI
P. S. & E. BY
548-7537
OCT. 31, 1978
DATE