


[illegible]

TOTAL SHEET COUNT AFTER "AS-BUILT"
POSTING: 20 SHEETS

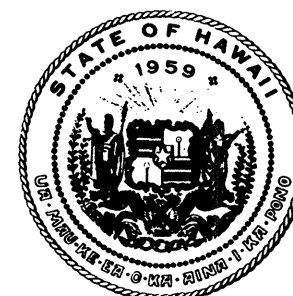

STATE OF HAWAII
DEPARTMENT OF TRANSPORTATION
HIGHWAYS DIVISION
"AS - BUILT" PLANS FOR
HAWAII BELT ROAD
INSTALLATION OF CULVERT
SECTION 19H, PHASE I
PROJECT NO. 19H-01-80

LENGTH OF PROJECT: 0.077 Miles

PLAN	-----	1 INCH = 20 FT.
PROFILE	-----	HOR. 1 INCH = 25 FT.
		VER. 1 INCH = 2 FT.
CROSS SECTION	-----	HOR. 1 INCH = 10 FT.
		VER. 1 INCH = 10 FT.



GENERAL LOCATION OF PROJECT



FEDERAL AID PROJECTS PREVIOUSLY CONSTRUCTED
OR UNDER CONSTRUCTION

Bruce C. McClure
RESIDENT ENGINEER

CONTRACTOR: HIRAHARA, INC.
CONTRACT NO.: 11671