


FED. ROAD DIST. NO.	STATE	PROJ. NO.	FISCAL YEAR	SHEET NO.	TOTAL SHEETS
HAWAII	HAW.	BRF-019-2(18)	1981	C.O.17	



FED. ROAD DIST. NO.	STATE	PROJ. NO.	FISCAL YEAR	SHEET NO.	TOTAL SHEETS
HAWAII	HAW	BRE-019-2(18)	1981	18	63

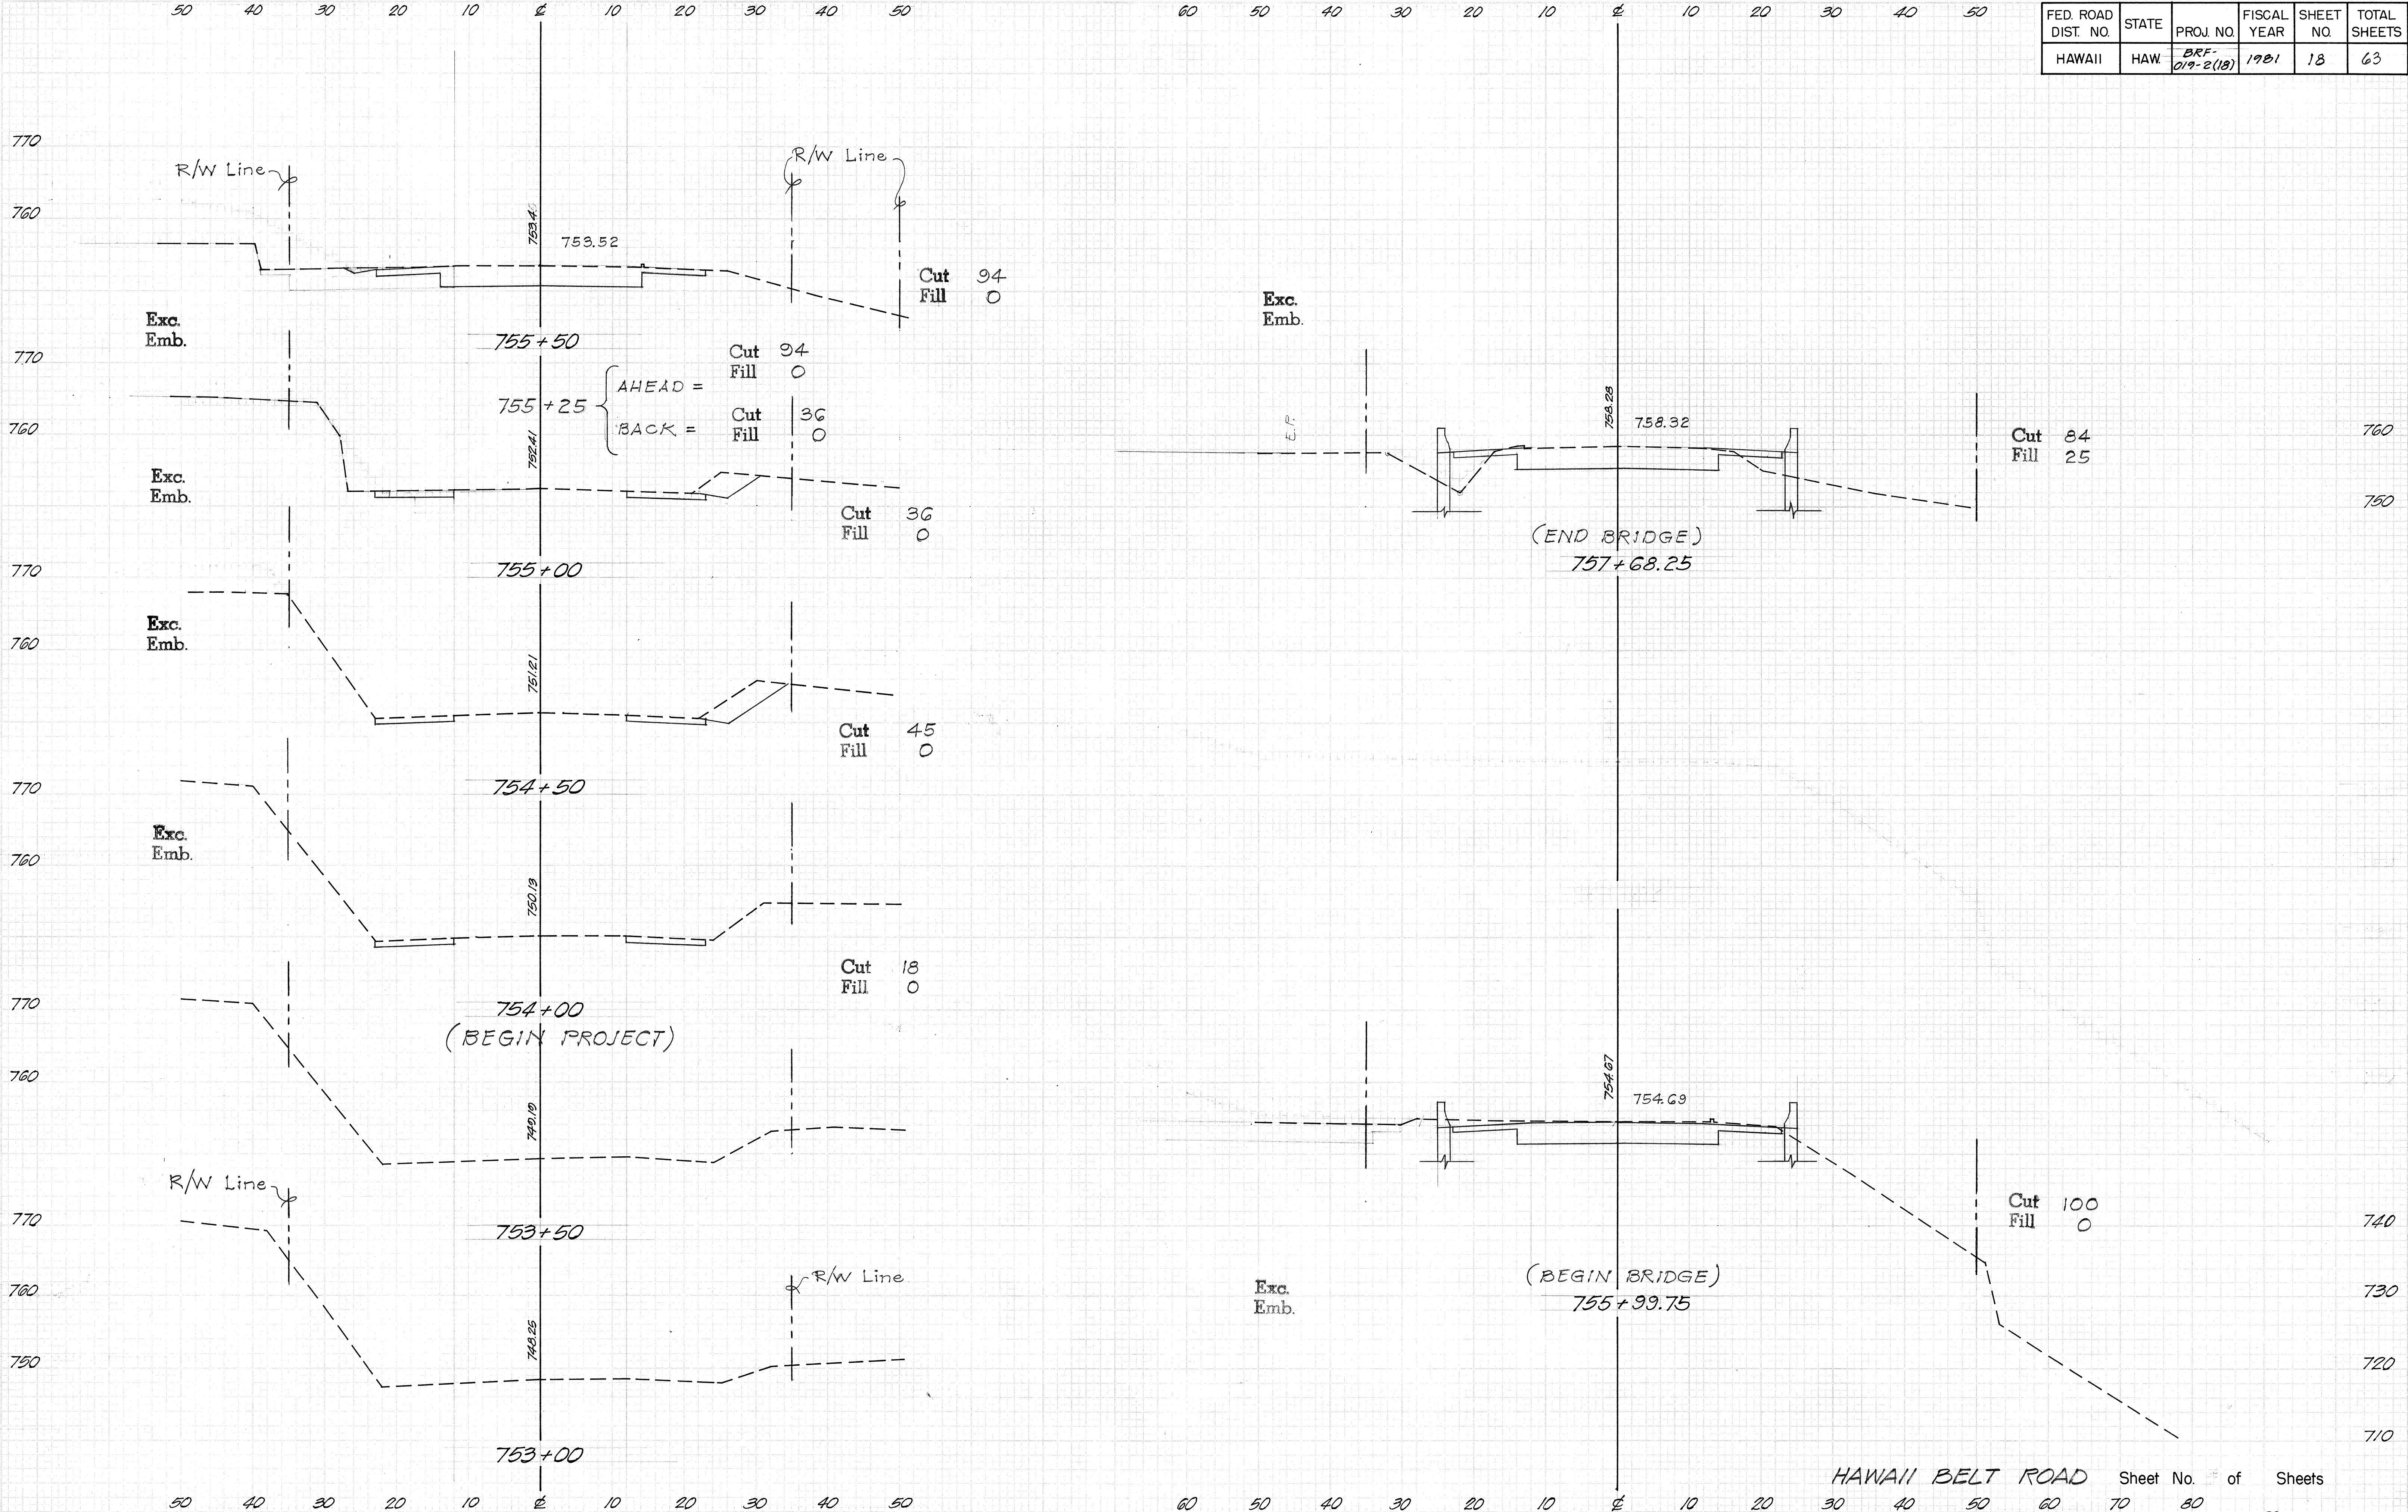

FED. ROAD DIST. NO.	STATE	PROJ. NO.	FISCAL YEAR	SHEET NO.	TOTAL SHEETS
HAWAII	HAW	BRF-019-2(18)	1981	19	63

DATE	BY	DATE	BY
ORIGINAL SURVEY	DATE	BY	DATE
NOTE BOOK	DATE	BY	DATE
TEMPLATE	DATE	BY	DATE
AREAS	DATE	BY	DATE
CHECKED	DATE	BY	DATE

DATE	BY	DATE	BY
ORIGINAL SURVEY	DATE	BY	DATE
NOTE BOOK	DATE	BY	DATE
TEMPLATE	DATE	BY	DATE
AREAS	DATE	BY	DATE
CHECKED	DATE	BY	DATE

