
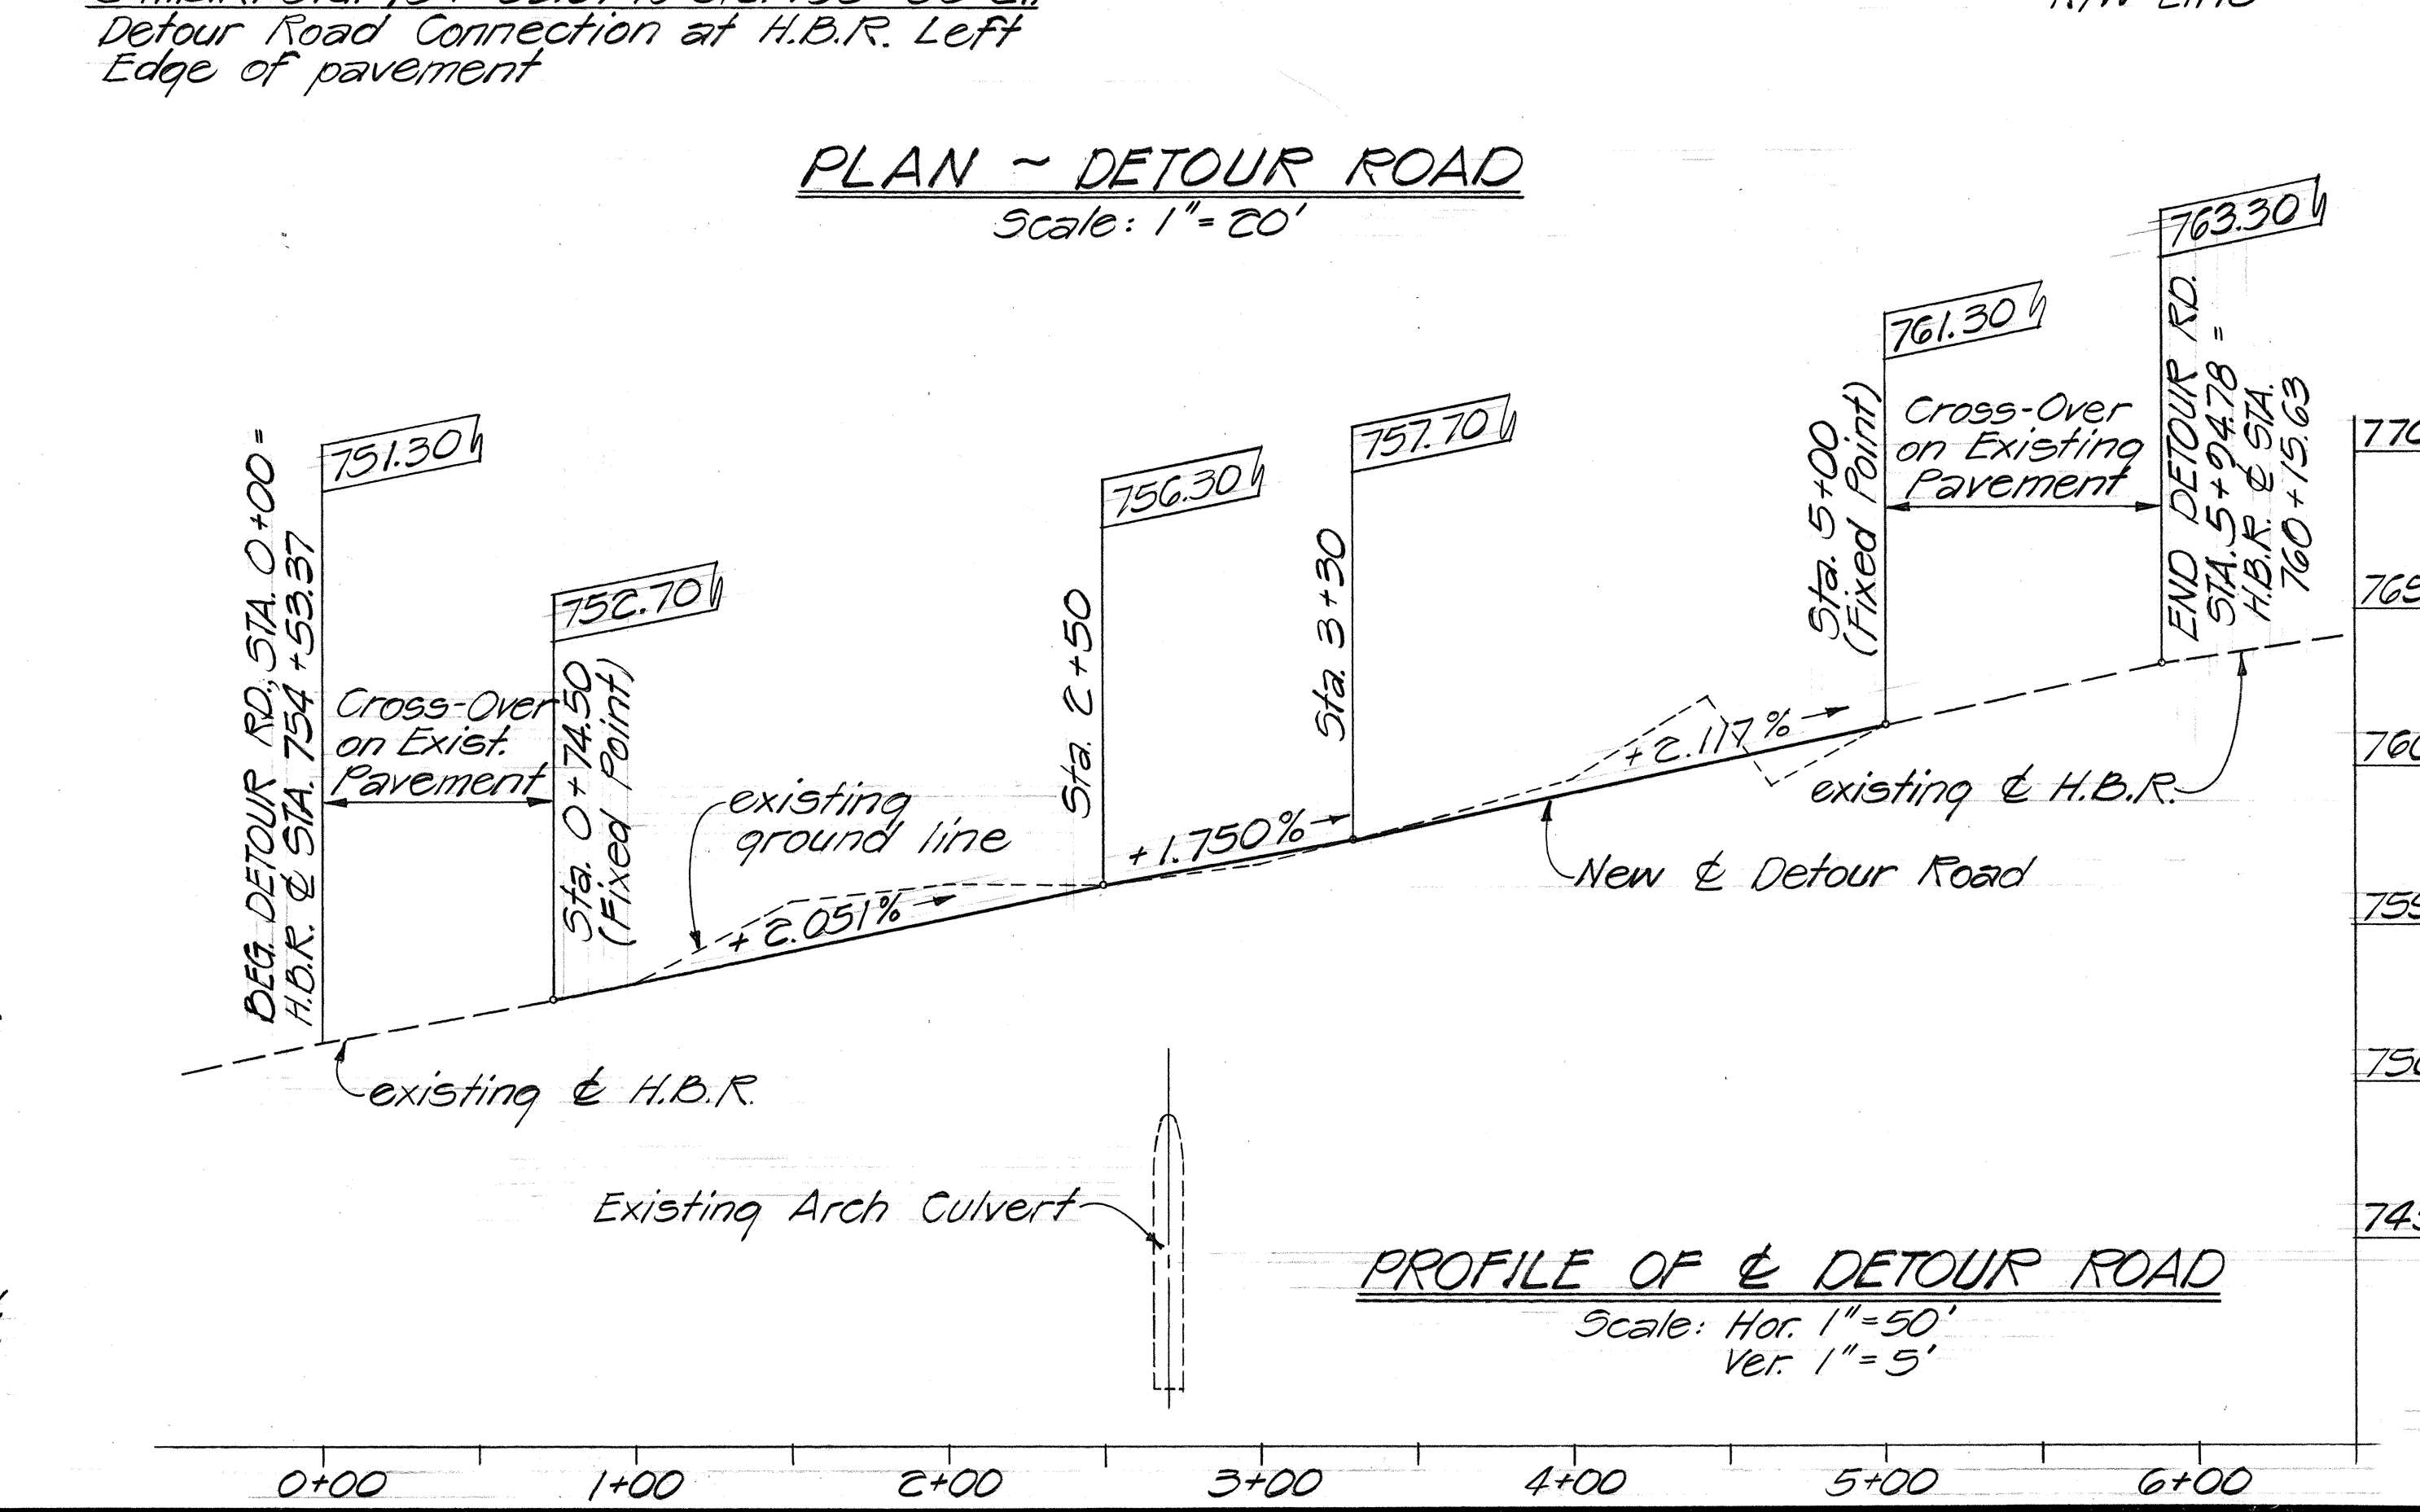
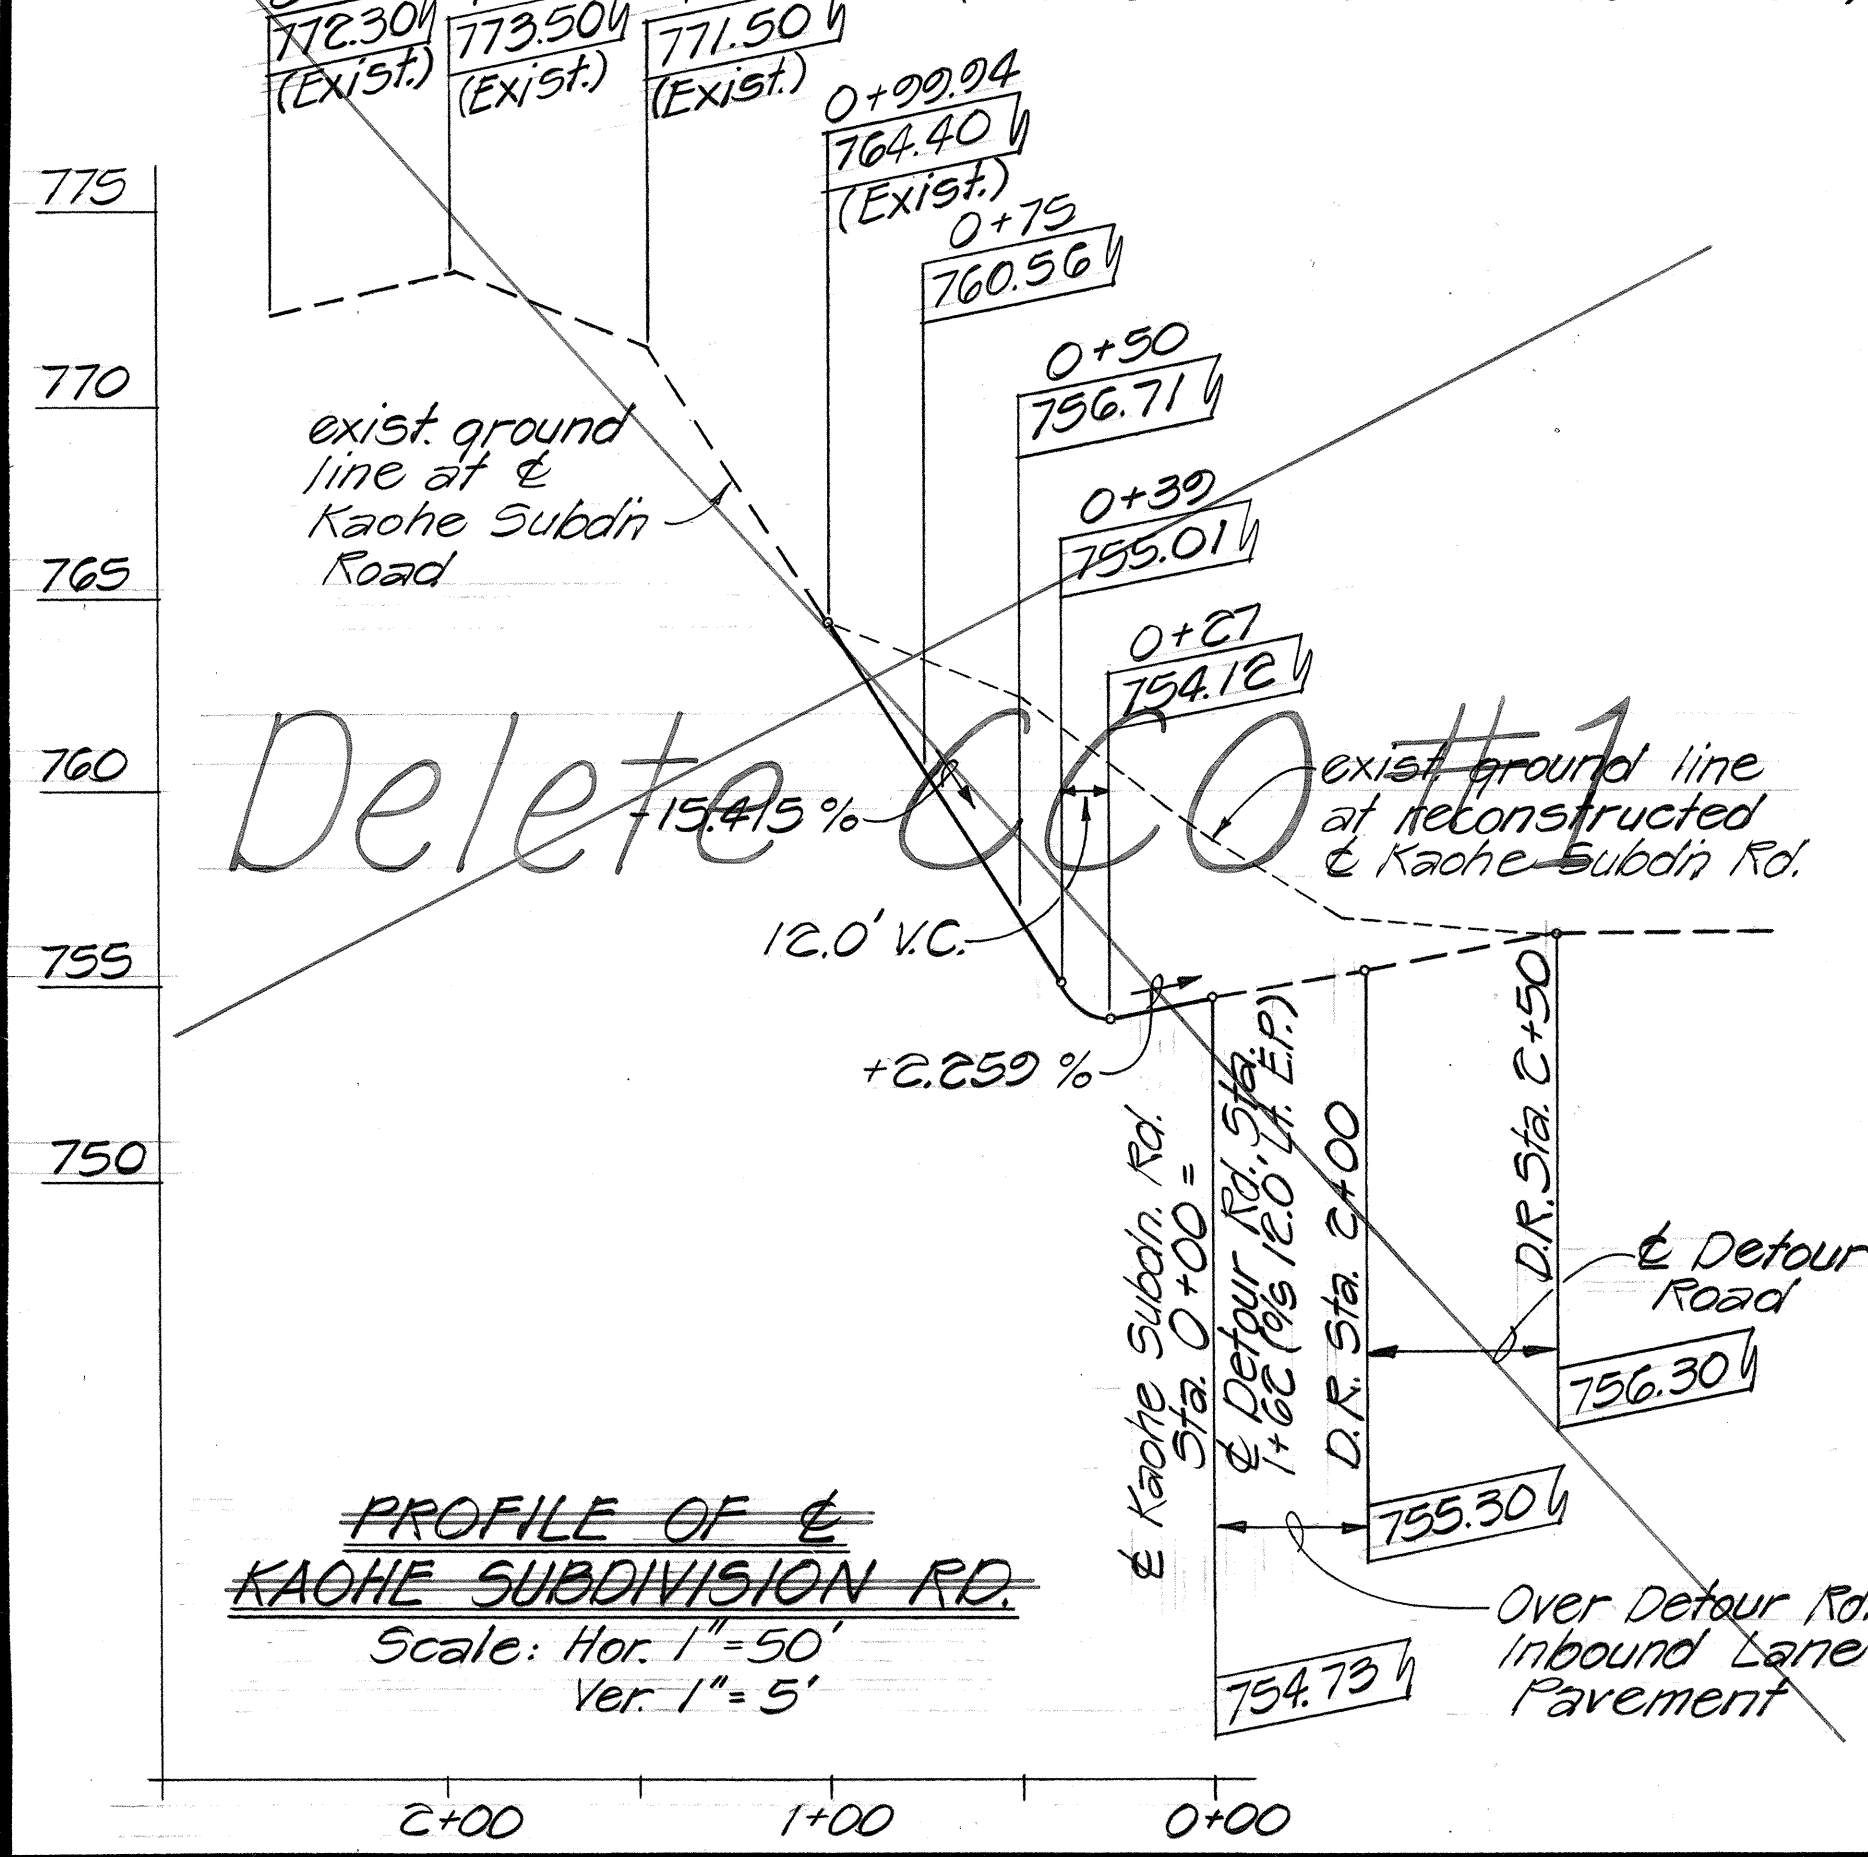


FED. ROAD DIST. NO.	STATE	PROJ. NO.	FISCAL YEAR	SHEET NO.	TOTAL SHEETS
HAWAII	HAW.	BRF-019-2(18)	1981	4	63

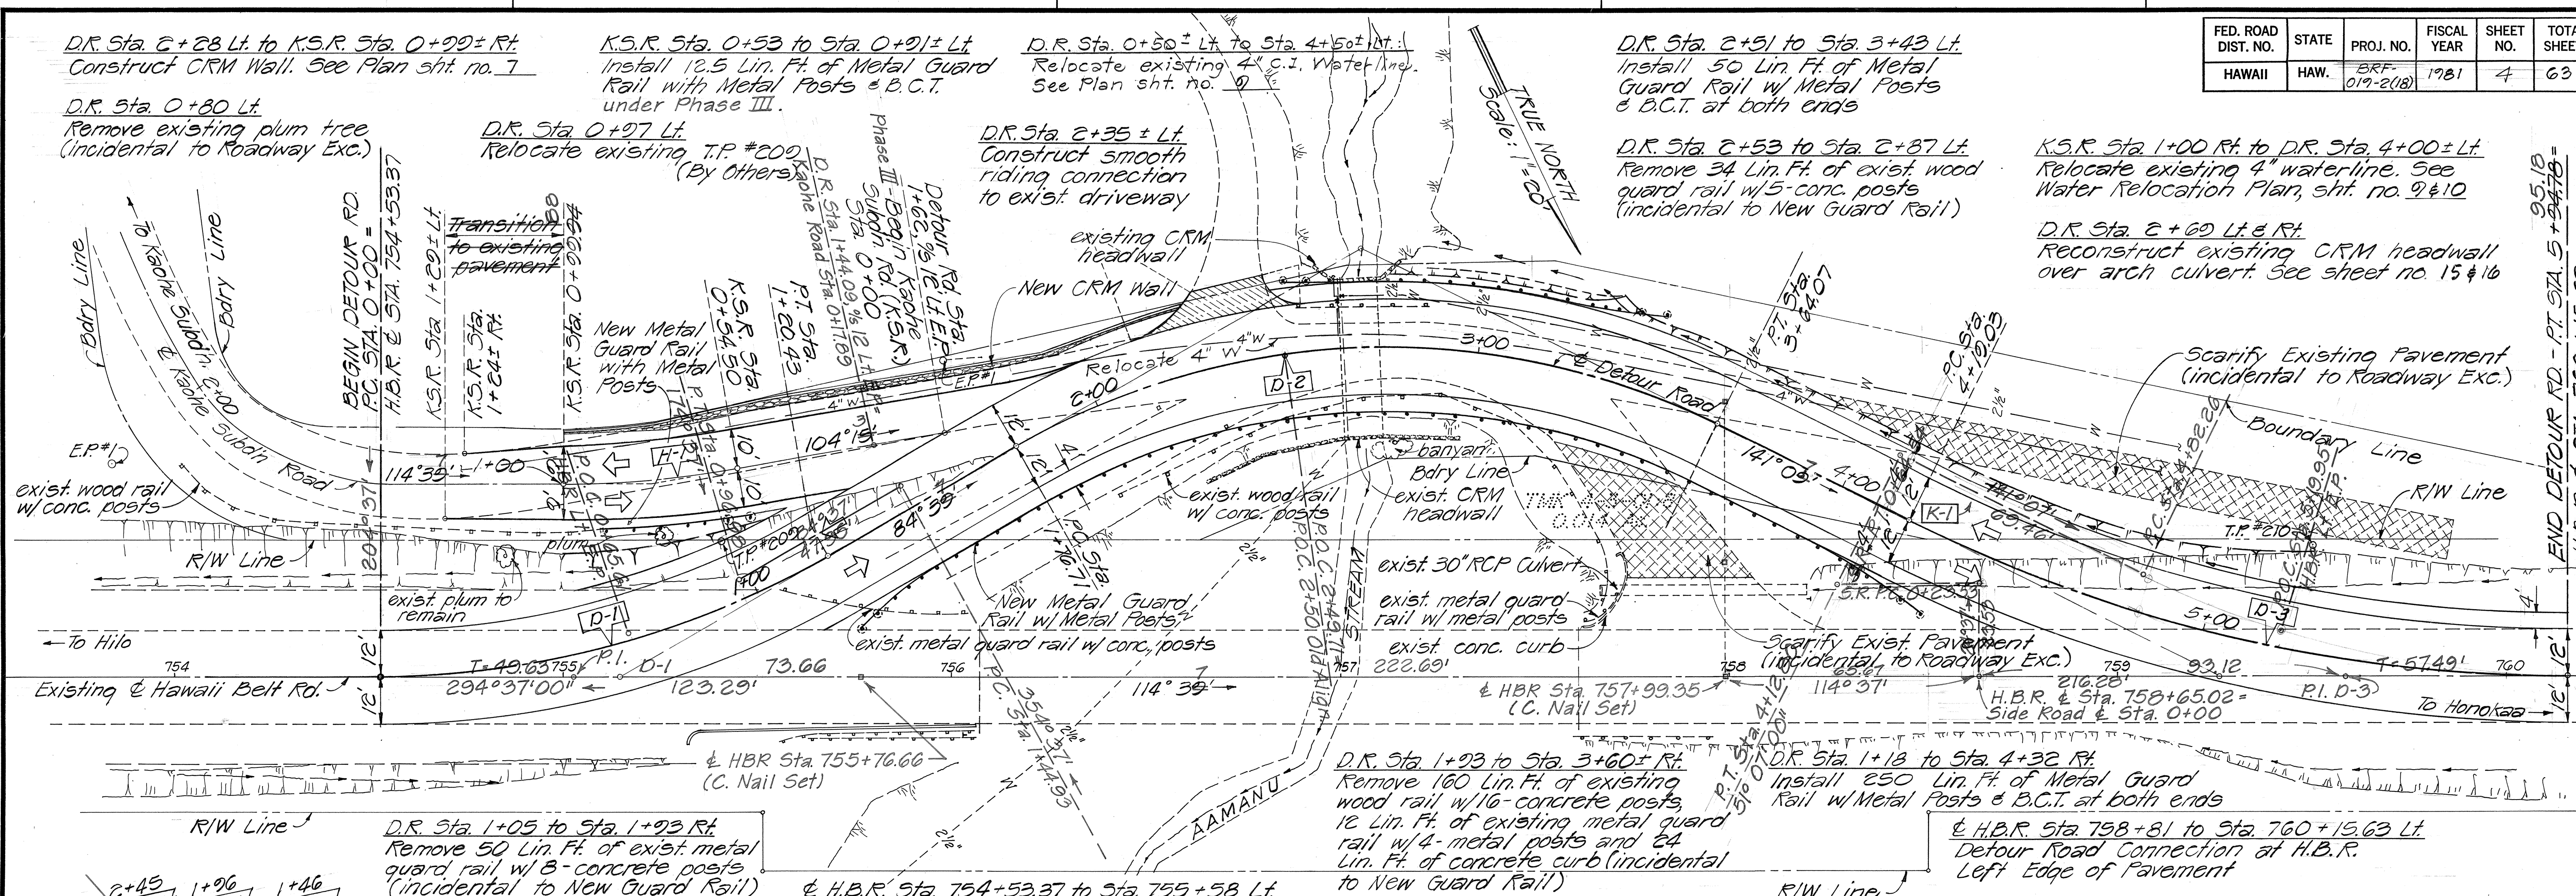

Curve Data

	D-1	D-2	D-3	H-1
Δ	30°00'	56°30'	26°30'	10°24'
4/2	15°00'	28°15'	13°15'	5°12'
D	24°59'22"	31°05'33"	23°08'09"	22°55'06"
R	230.66'	192.66'	380.00'	250.00'
T	49.03'	145.96'	53.43'	32.75'
LC	128.33'	98.53'	112.38'	45.44'
C	39.81'	38.35'	56.35'	45.32'
E	6.4'	25.69'	16.35'	1.03'

ABBREVIATION LEGEND:
D.R. = Detour Road
K.S.R. = Kahohe Subdivision Road
H.B.R. = Hawaii Belt Road
B.C.T. = Breakaway Cable Terminal

STATE OF HAWAII
DEPARTMENT OF TRANSPORTATION
HIGHWAYS DIVISION

**DETOUR ROAD
PLAN AND PROFILE**
Hawaii Belt Road
Aamanu Stream Bridge Replacement
F.A. Proj. No. BRF-019-2(18)
Scale: As Noted Date: Oct. 1978
SHEET NO. 1 OF 1 SHEETS

PHASE I