
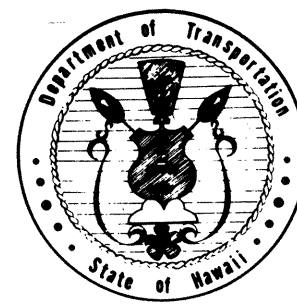


INDEX TO DRAWINGS	
SHEET NO.	DESCRIPTION
1	TITLE SHEET
2,3	TYPICAL SECTIONS AND SUPERELEVATED TRANSITION
4	PHASE I - PLAN AND PROFILE
5	PHASE II - PLAN AND PROFILE
①6	PHASE III - SIDE ROAD CONNECTION
7	CRM WALL DETAILS
②8	DRAINAGE STRUCTURES
C.O.9,10	WATERLINE RELOCATION
11-13	TRAFFIC SIGNS, STRIPING AND PAVEMENT MARKERS
14	LANDSCAPE PLAN
15,16	GRAVITY WALL DETAILS
C.O.17-19	CROSS SECTIONS
③20+36	AAMANU STREAM BRIDGE PLANS
37,38	EXISTING AAMANU STREAM
	BRIDGE PLAN, FAP 26-A
39-62	STANDARD DETAILS
63	TYPE 61614 & 61616 GRATED DROP INTAKES

① C.O.6S-I, ② C.O.8S-I, ③ ADD 28S-I


NEW TOTAL: 66 SHEETS

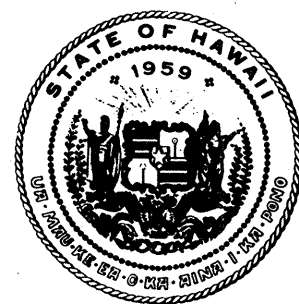

STATE OF HAWAII
DEPARTMENT OF TRANSPORTATION
HIGHWAYS DIVISION
HONOLULU, HAWAII
"AS BUILT"
PLANS FOR
CONSTRUCTION OF
HAWAII BELT ROAD
AAMANU STREAM BRIDGE REPLACEMENT
FEDERAL AID PROJECT NO. BRF-019-2(18)

DISTRICT OF HAMAKUA
ISLAND OF HAWAII




Contractor: *Jas. W. Glover, Ltd.*
Contract No.: *13356*
DWS Utility Agreement No.: *755*

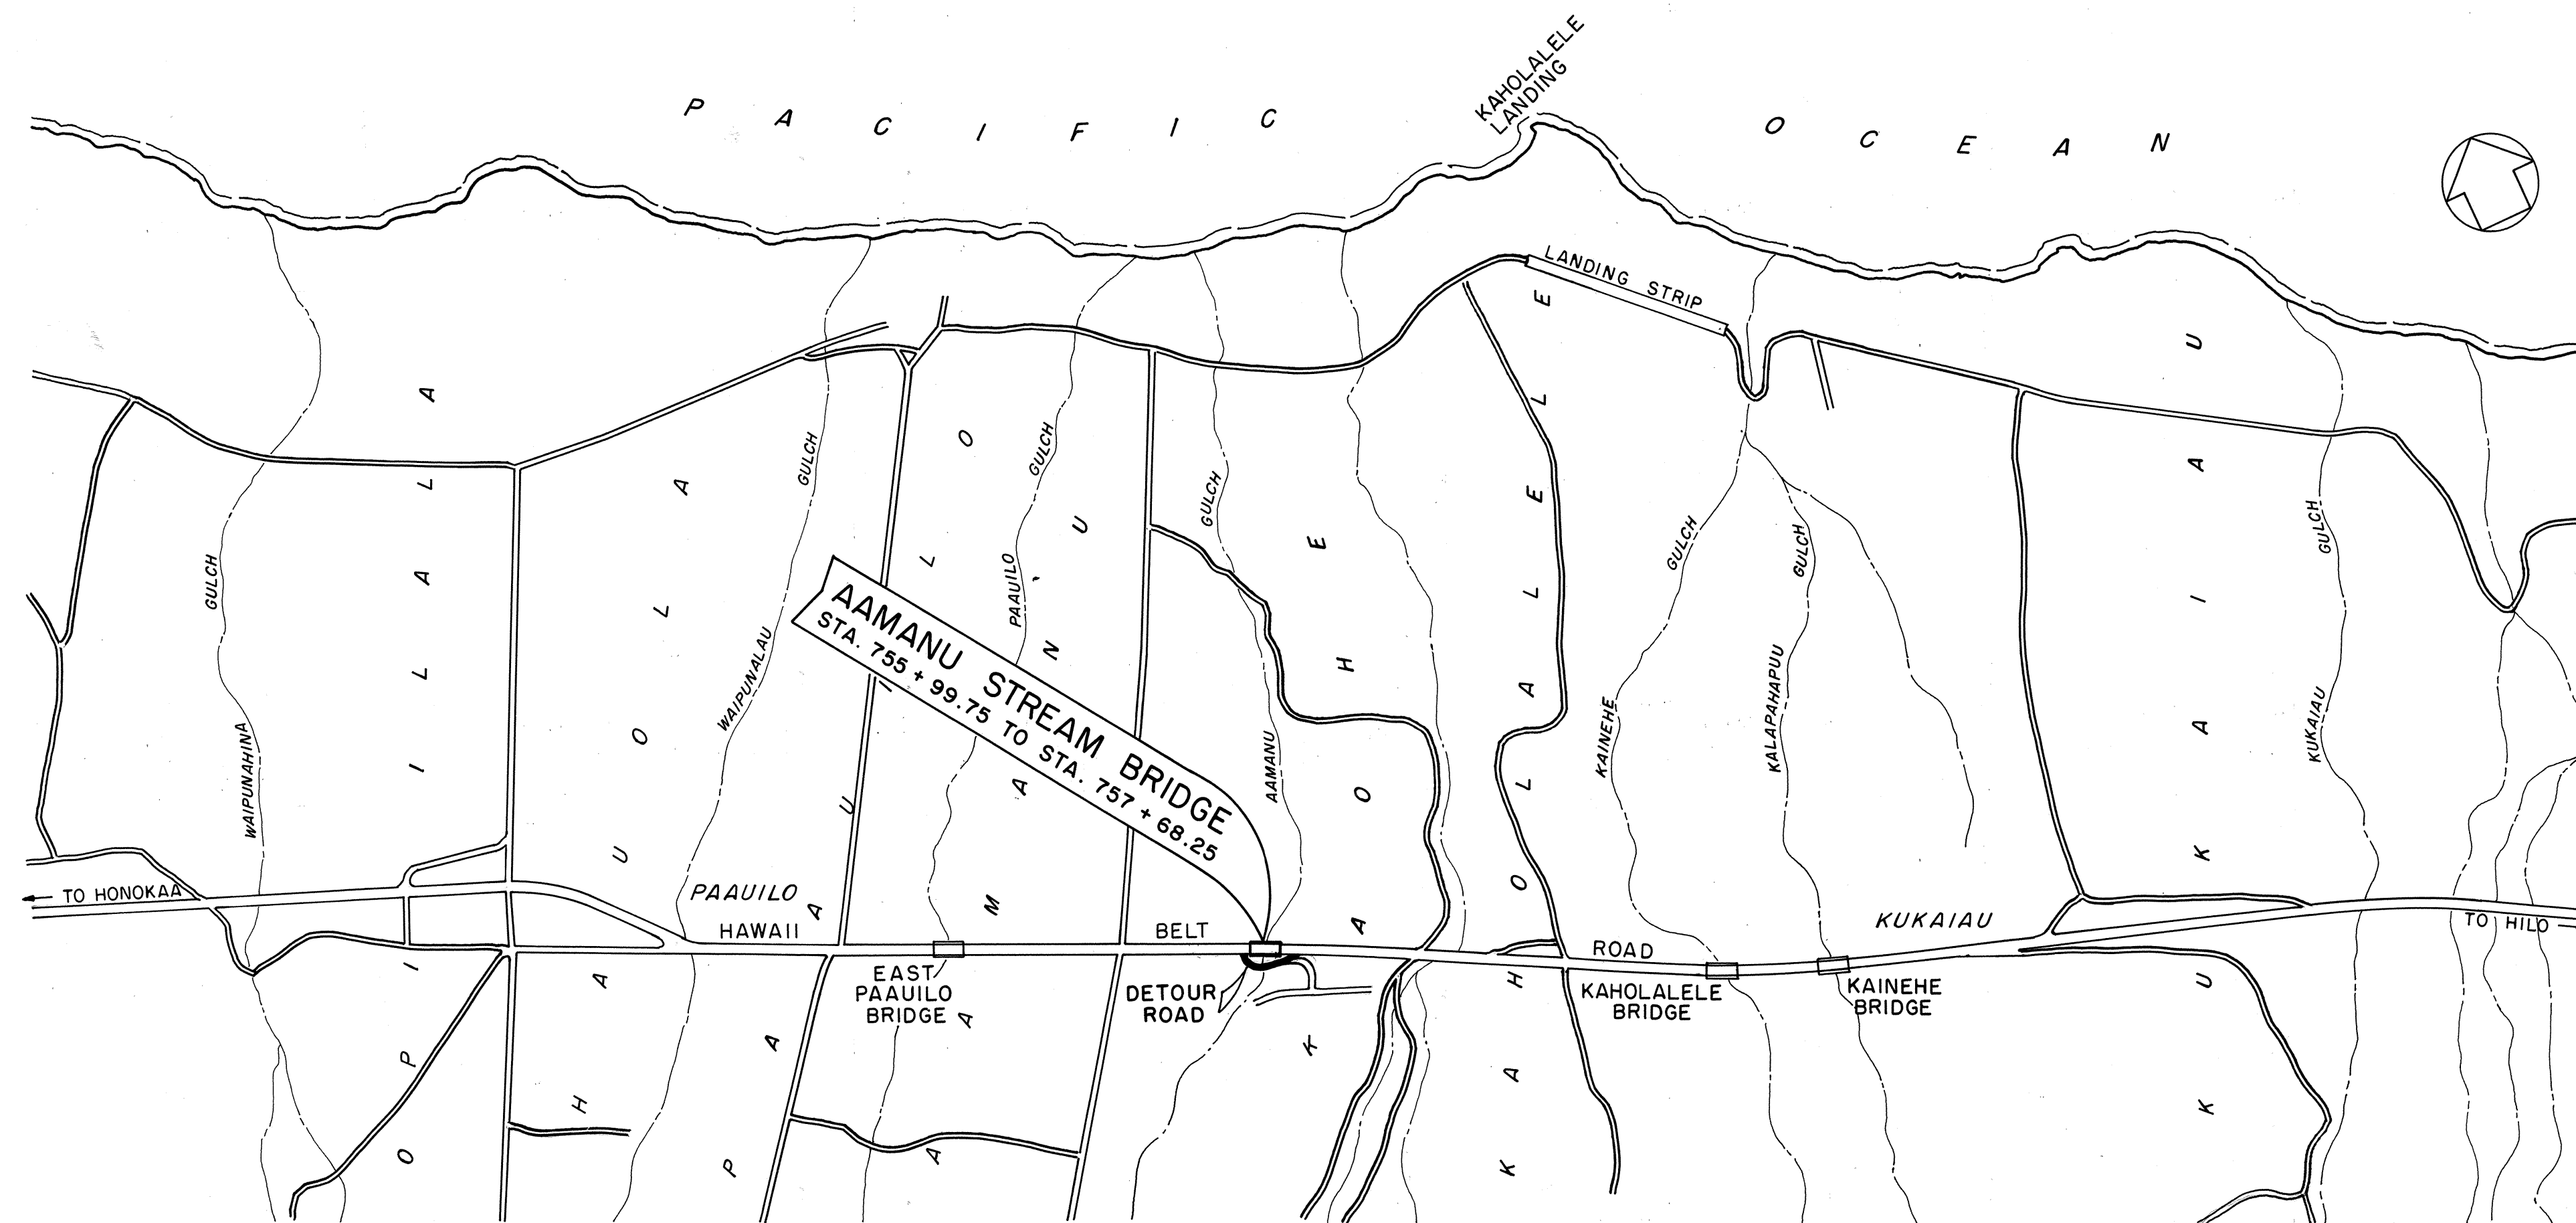

GENERAL LAYOUT PLAN
SCALE IN THOUSAND FEET

TOTAL LENGTH OF BRIDGE 0.032 Mi.

FED. ROAD DIST. NO.	STATE	PROJ. NO.	FISCAL YEAR	SHEET NO.	TOTAL SHEETS
HAWAII	HAW.	BRF-019-2(18)	1981	1	6366

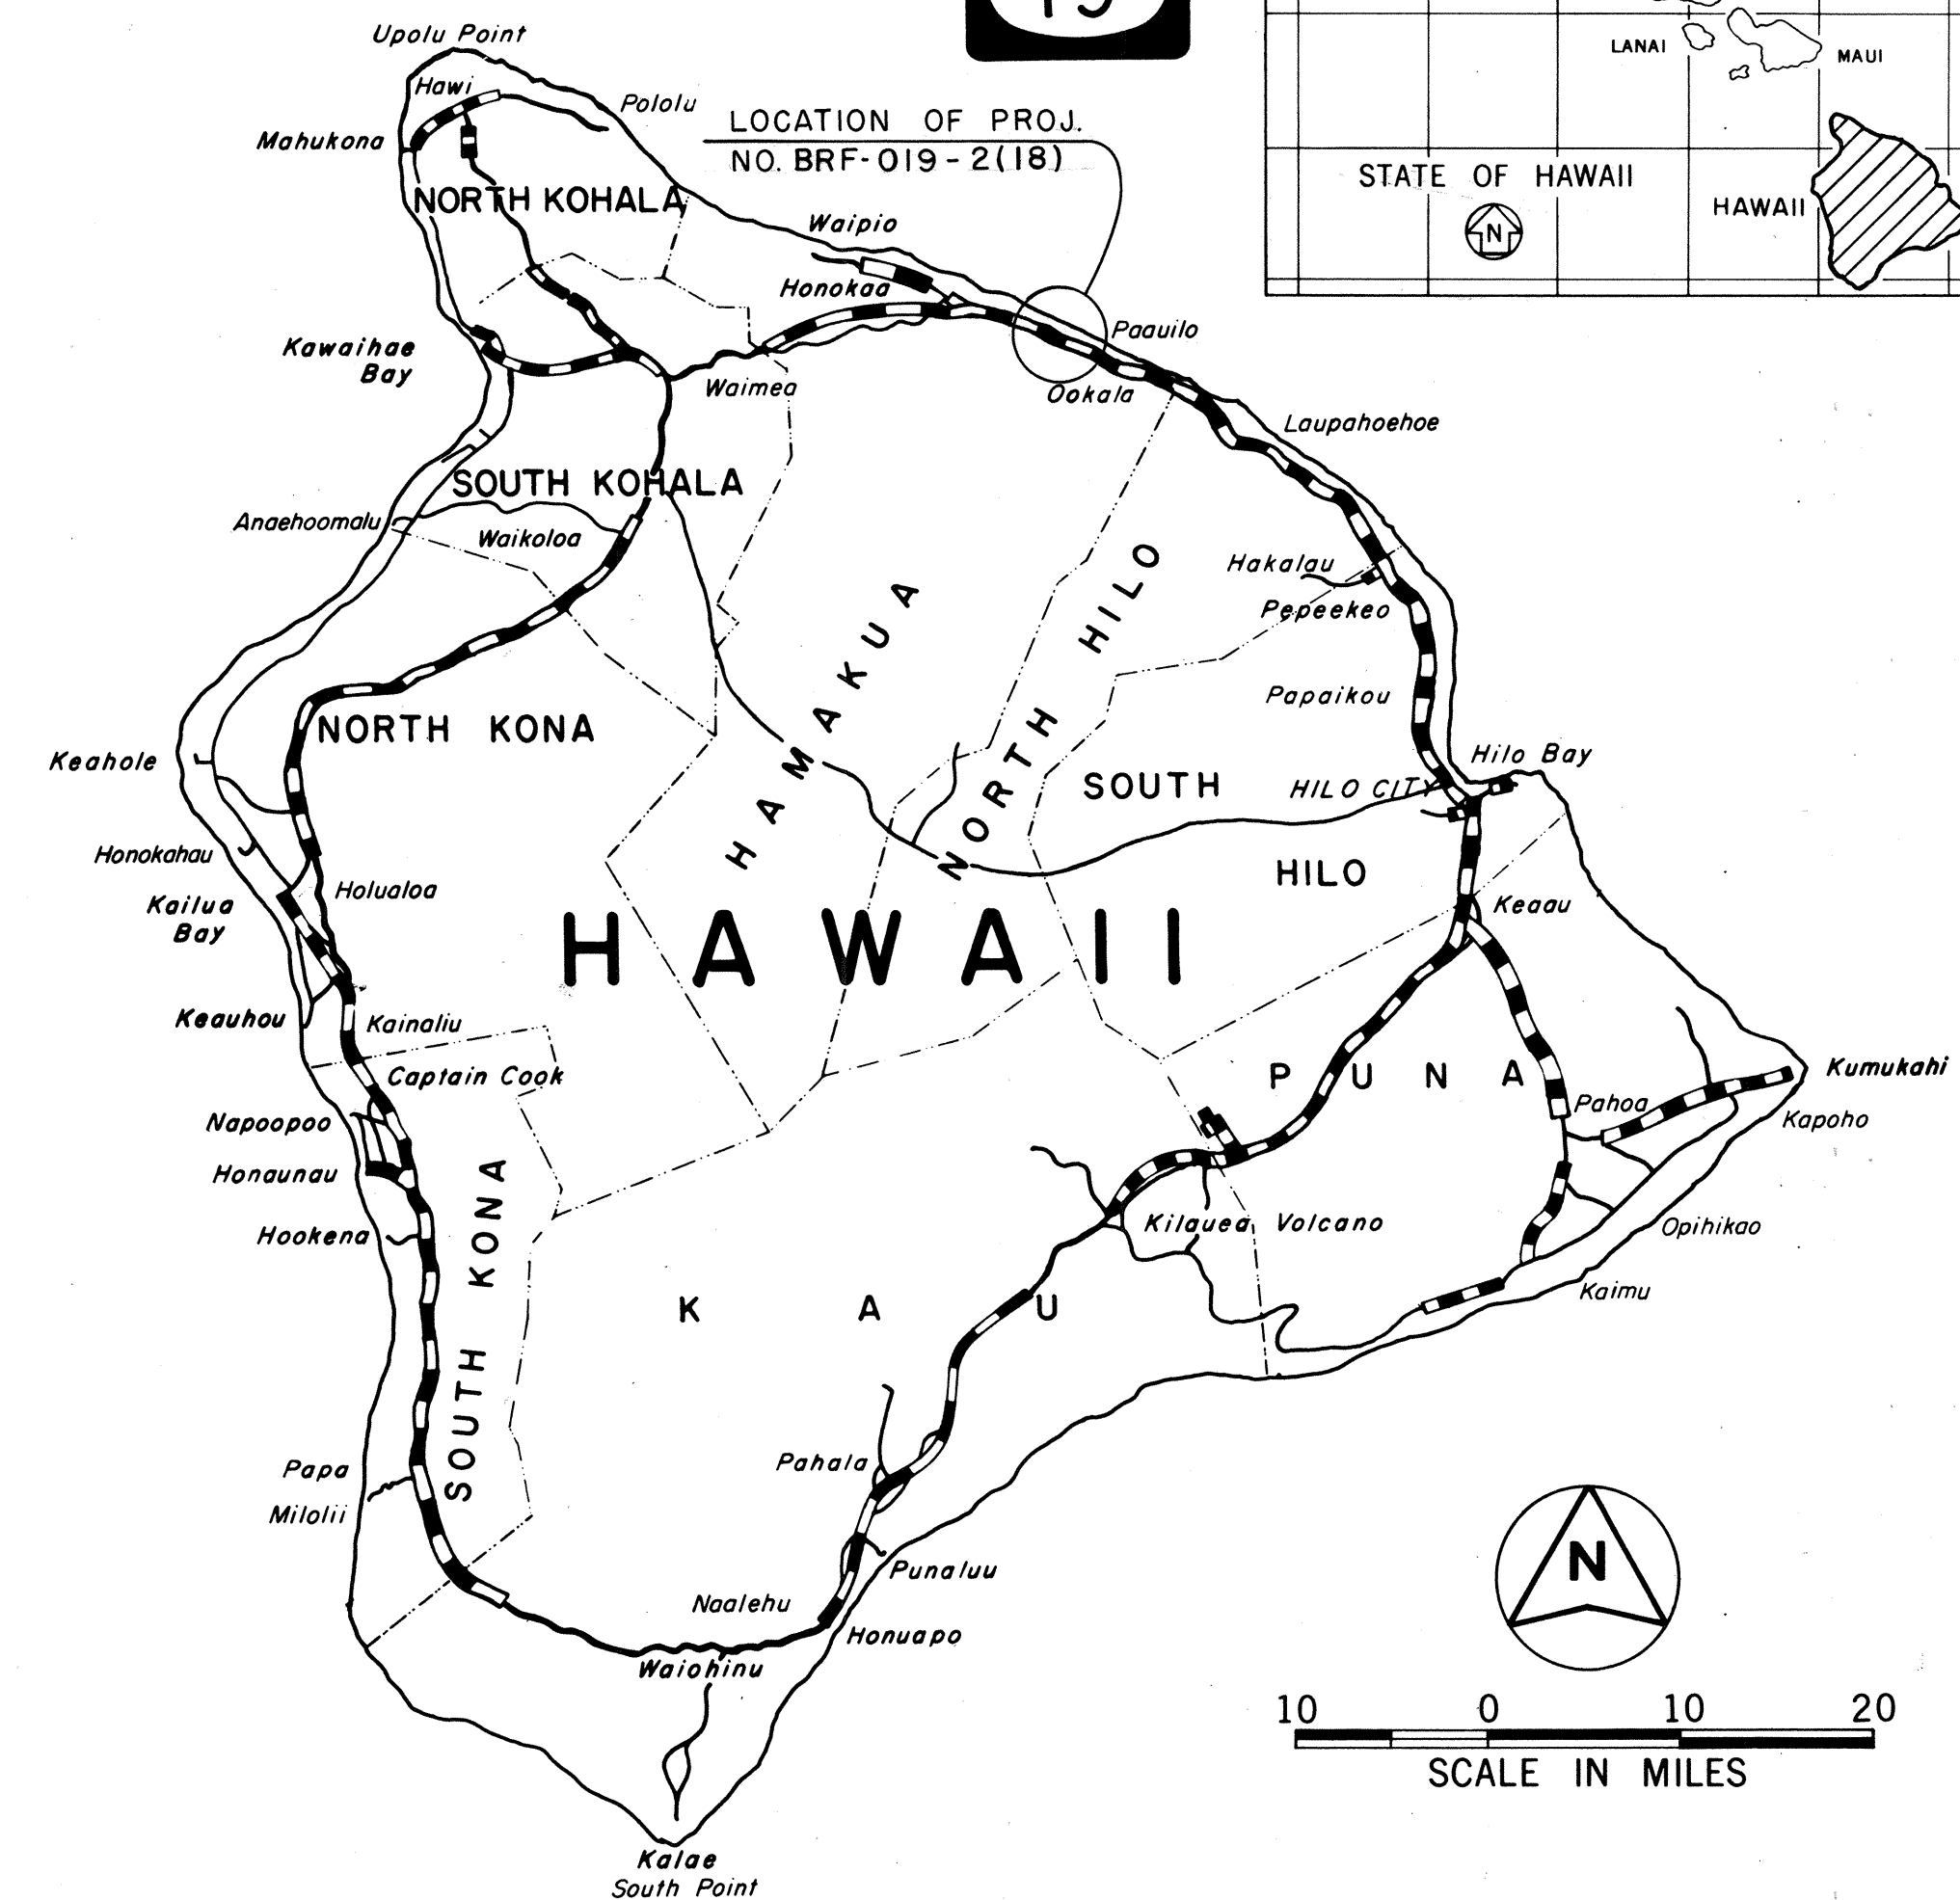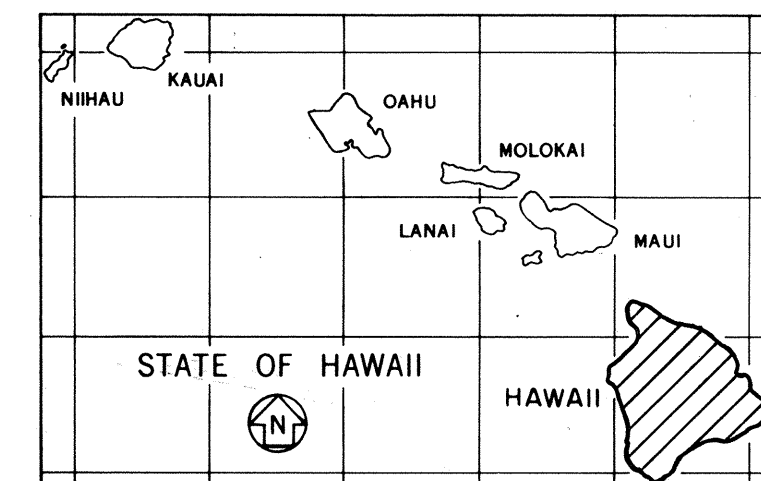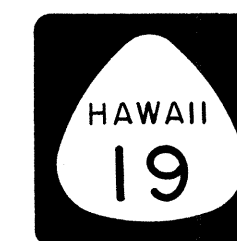

— FEDERAL AID PROJECTS PREVIOUSLY CONSTRUCTED OR UNDER CONSTRUCTION

ALL CHANGES MADE DURING CONSTRUCTION HAVE BEEN NOTED IN RED ON THESE TRACINGS AND CHECKED BY:

Anthony J. Vincent
RESIDENT ENGINEER

5/9/83
DATE

DEPARTMENT OF TRANSPORTATION FEDERAL HIGHWAY ADMINISTRATION	
APPROVED:	DATE
<i>[Signature]</i>	<i>7-24-81</i>
DIVISION ADMINISTRATOR	DATE

DEPARTMENT OF TRANSPORTATION STATE OF HAWAII	
APPROVED:	DATE
<i>[Signature]</i>	<i>5/29/81</i>
DIR. OF TRANSPORTATION	DATE

DESIGN CLASSIFICATION

CURRENT ADT (1981) 3,600
DESIGN ADT (2001) 6,400
DHV 600
D 50/50
T 8.0 %
T24 9.5 %