
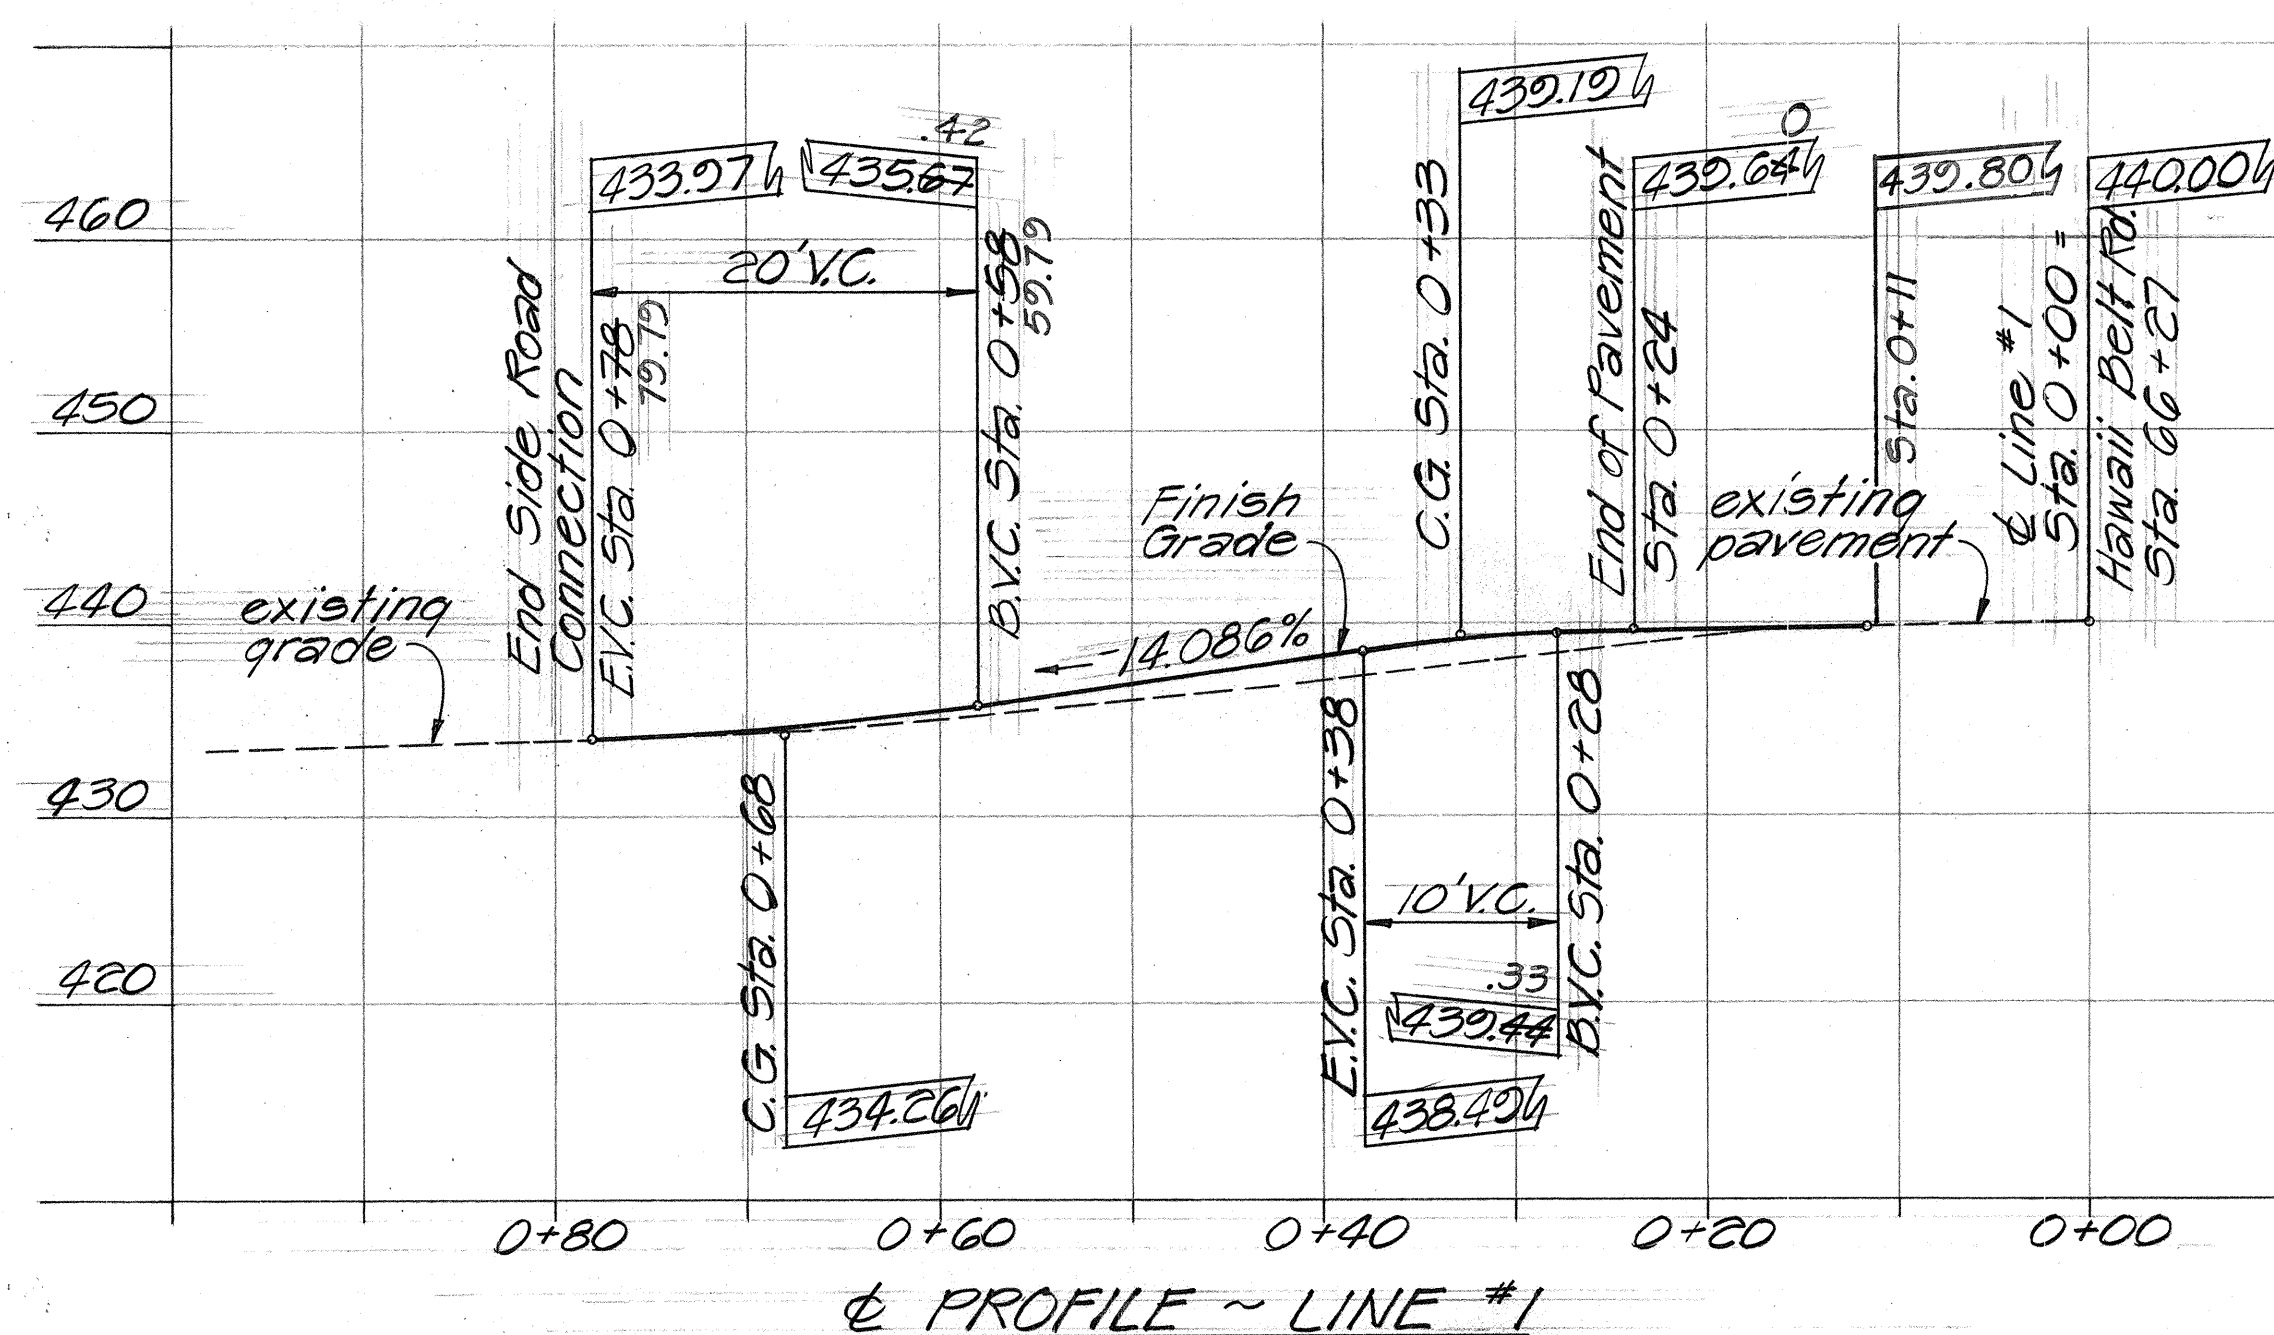



FED. ROAD DIST. NO.	STATE	PROJ. NO.	FISCAL YEAR	SHEET NO.	TOTAL SHEETS
HAWAII	HAW.	19GH-02-71 UNIT I	1982	5	32

CURVE (A)
 $\Delta = 29^{\circ}00'$
 $R = 120.00'$
 $T = 31.03'$
 $L = 60.74'$

CURVE (B)
 $\Delta = 101^{\circ}30'$
 $R = 20.00'$
 $T = 24.48'$
 $L = 35.43'$

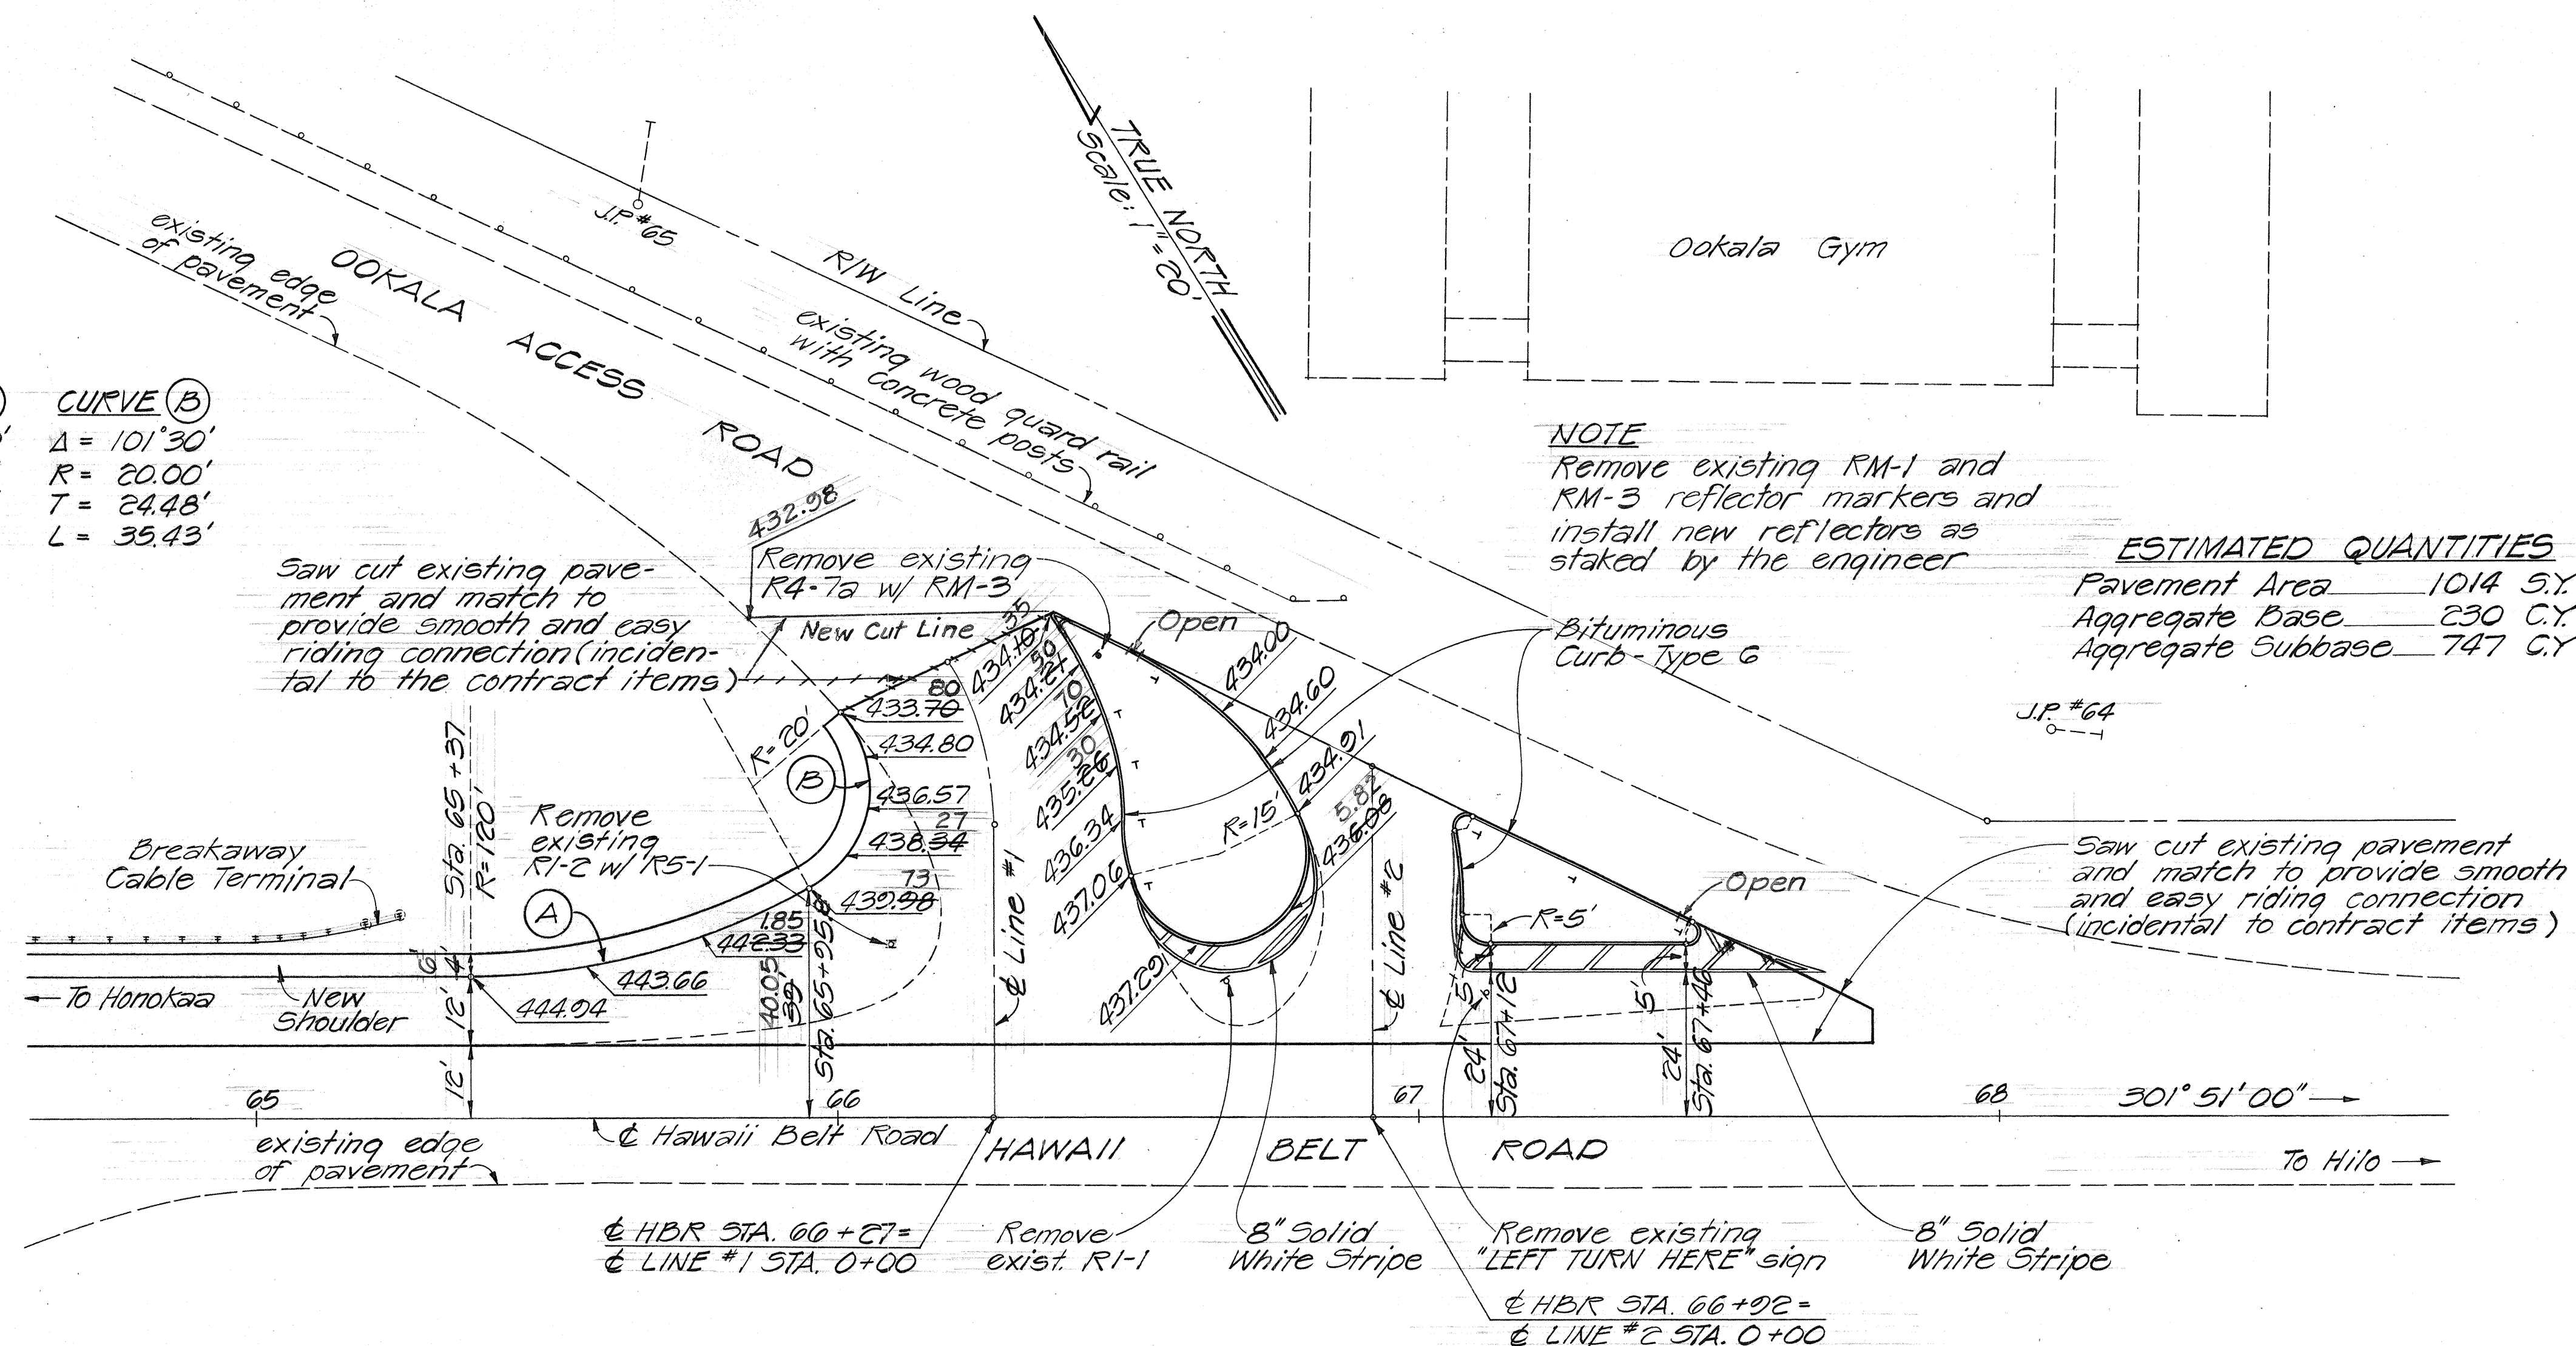

SIDE ROAD CONNECTION @ STA 66+27, LT.
 Scale: 1" = 10'

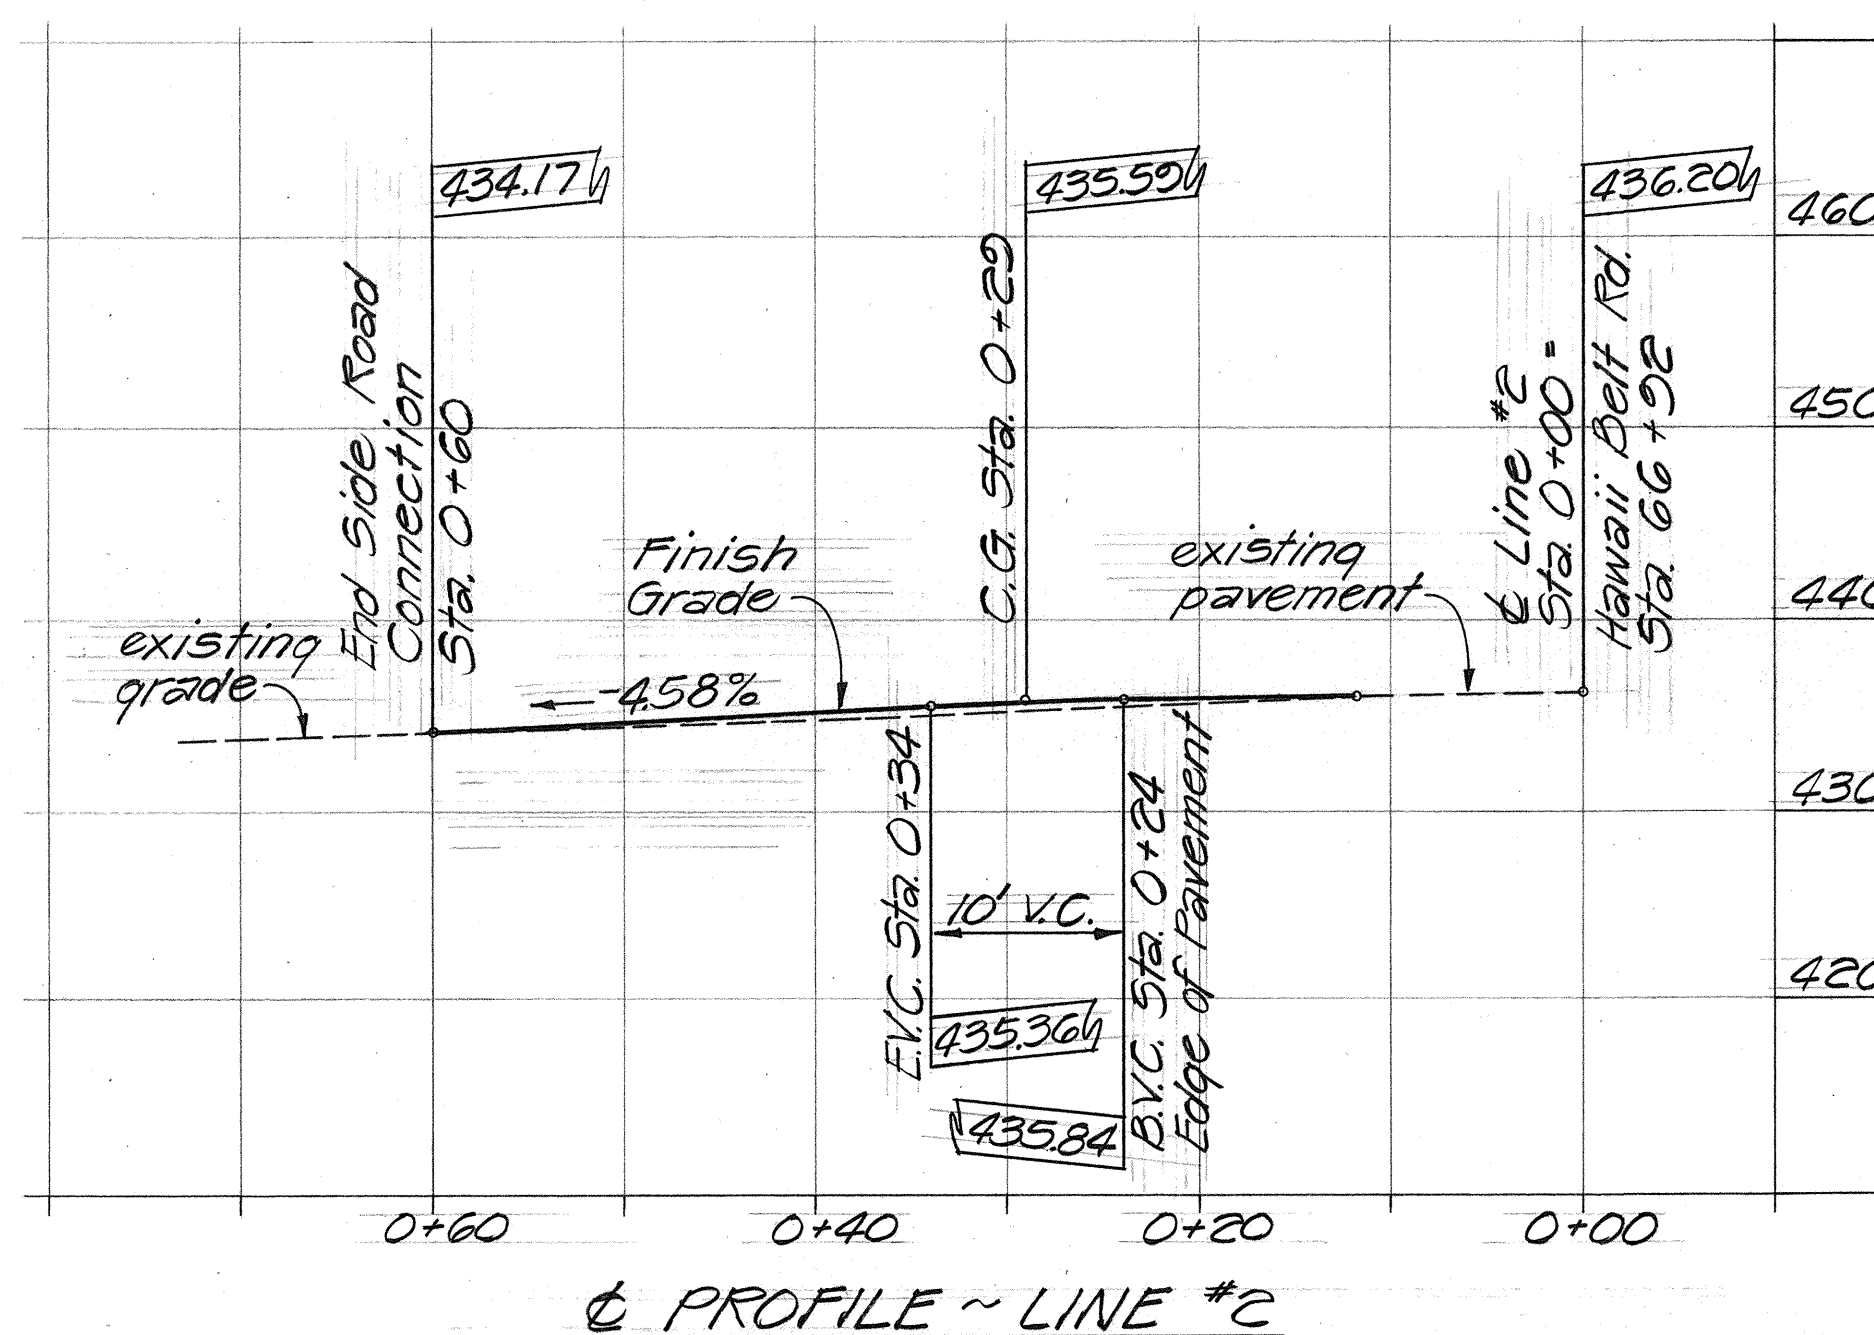

SIDE ROAD CONNECTION @ STA 66+92, LT.
 Scale: 1" = 10'

STATE OF HAWAII
 DEPARTMENT OF TRANSPORTATION
 LAND TRANSPORTATION FACILITIES DIVISION

OOKALA ACCESS RD. DETAILS

HAWAII BELT ROAD
 Truck Climbing Lane
 Proj. No. 19GH-02-71, Unit I

Scale: As Shown Date: Nov. 1981
 SHEET No. 1 OF 1 SHEETS