
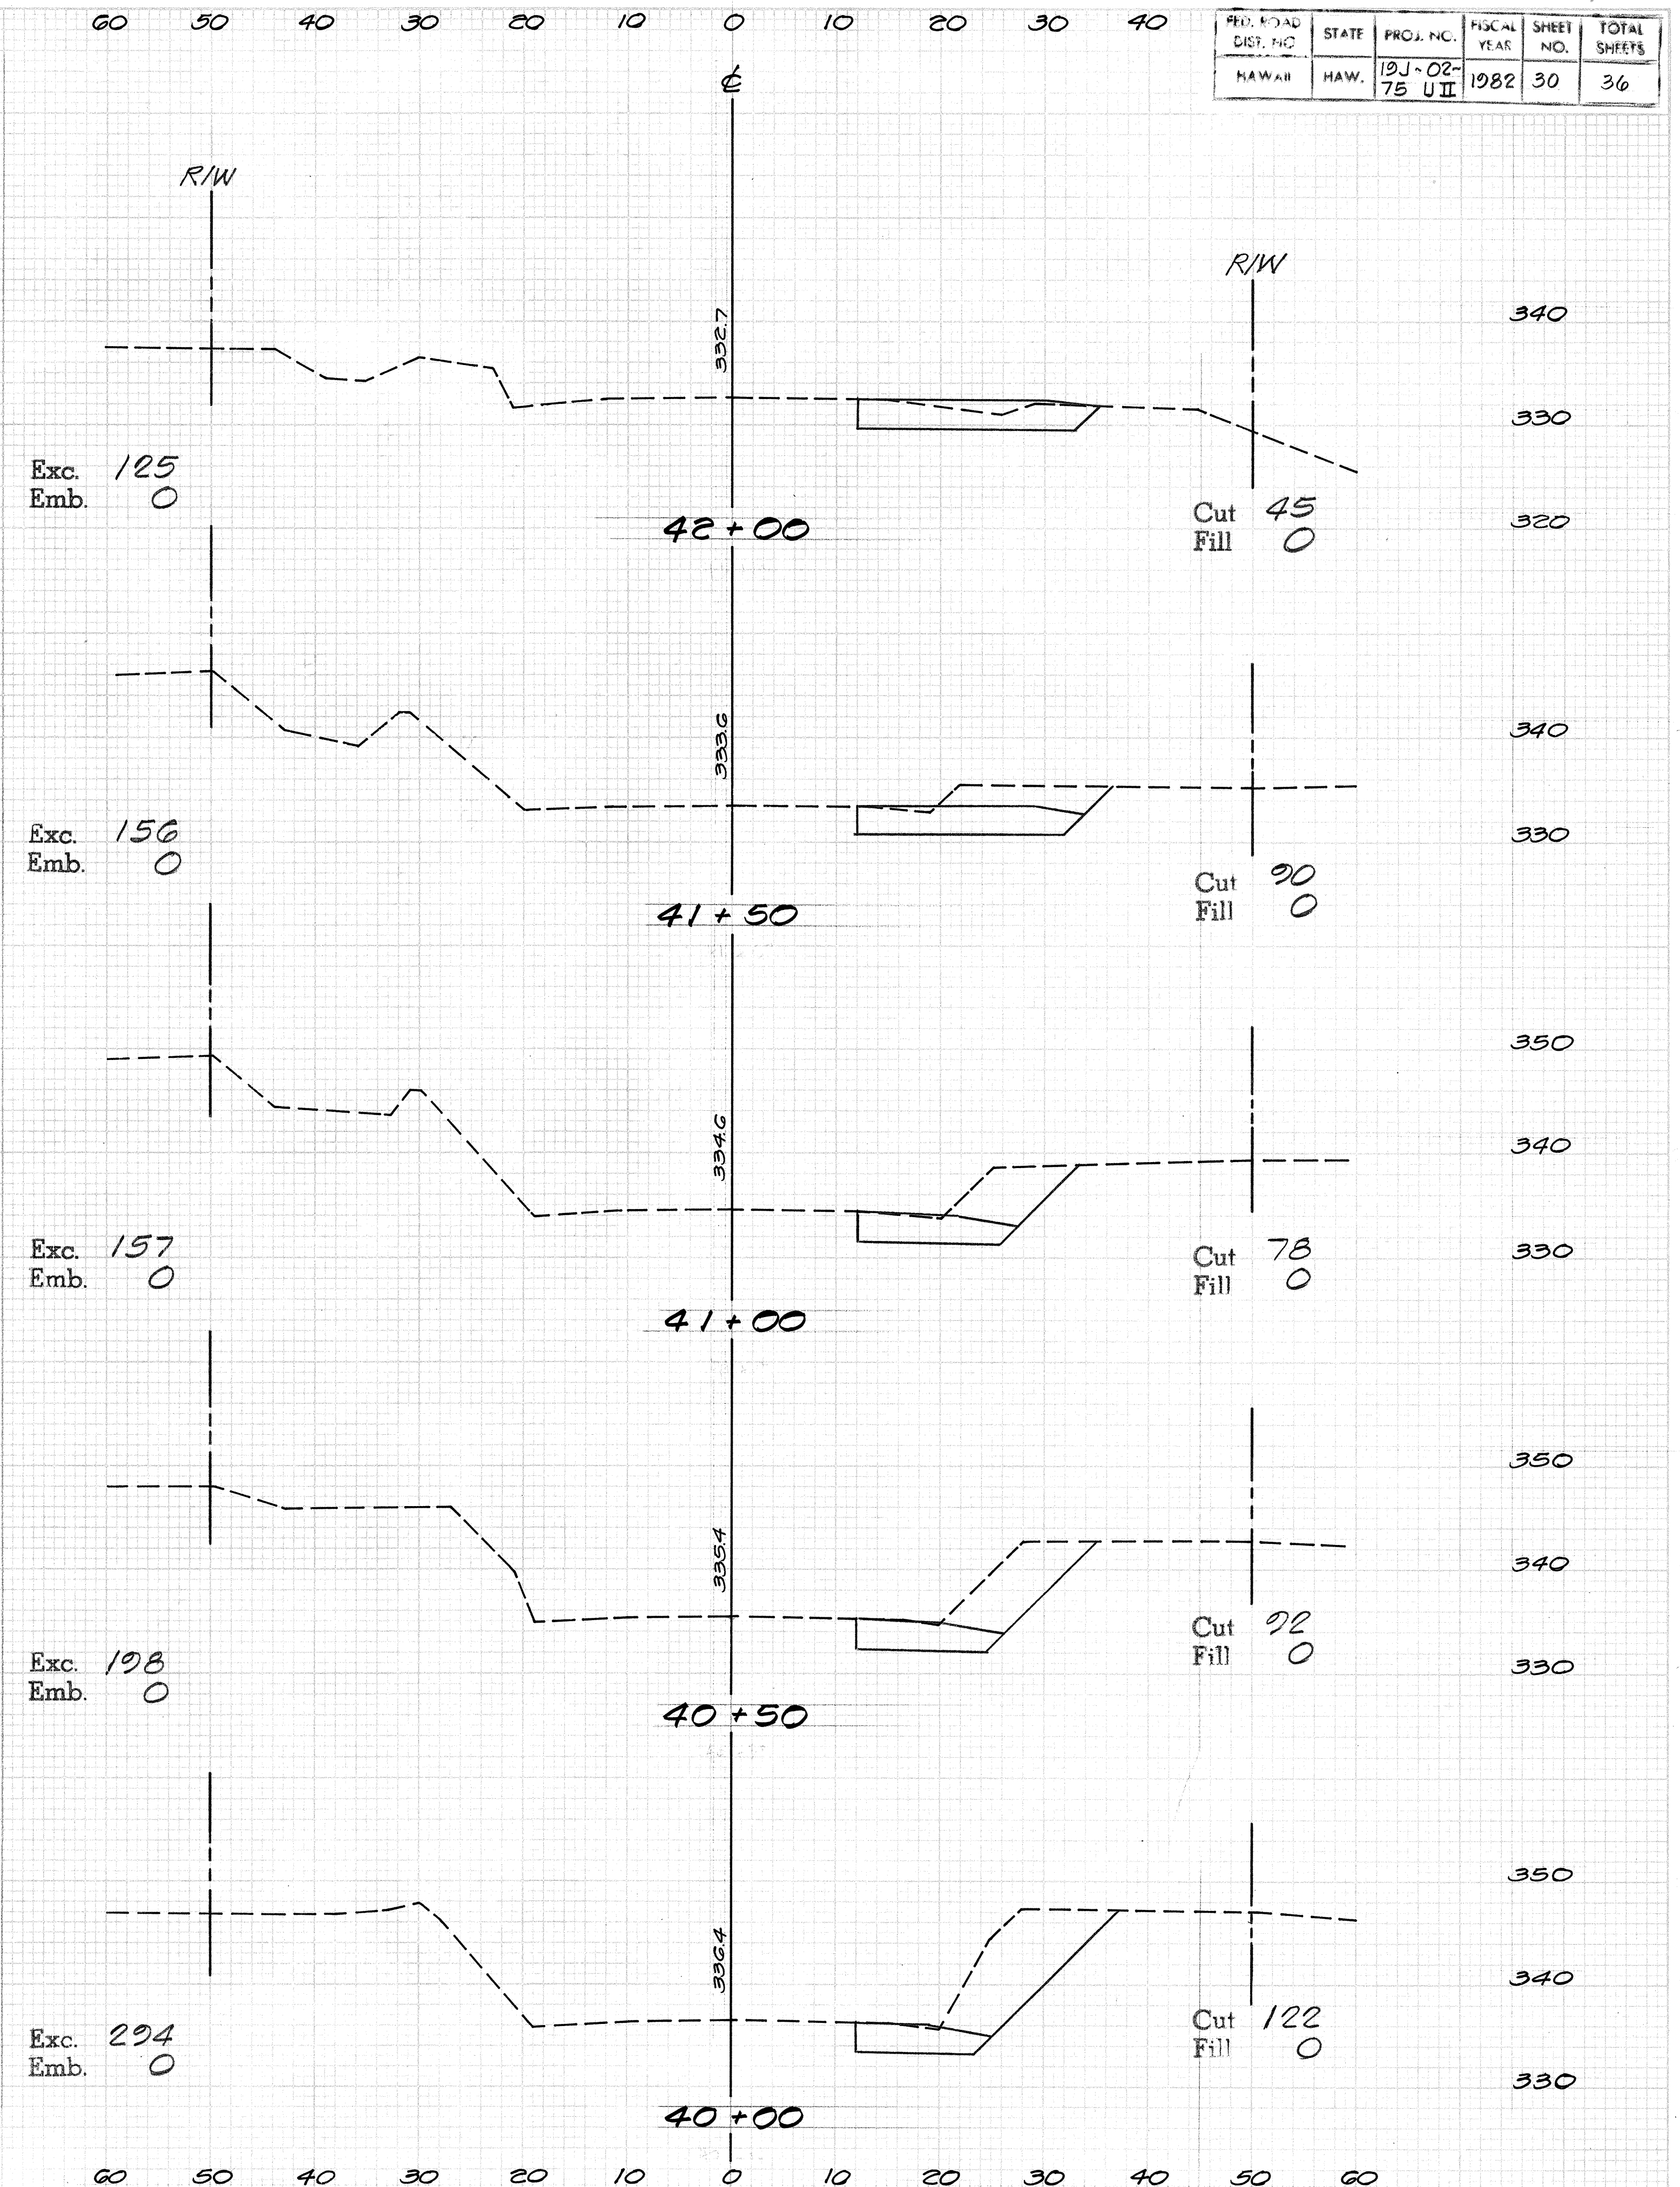


PROJ. ROAD DIST. NO.	STATE	PROJ. NO.	FISCAL YEAR	SHEET NO.	TOTAL SHEETS
HAWAII	HAW.	19J-02-75 U II	1982	30	36


DATE	BY	FINAL SURVEY	PLATTED	NOTED	AREAS CHECKED

DATE	BY	ORIGINAL SURVEY	PLATTED	NOTED	AREAS CHECKED
10-9-81	AK				
FB #144					

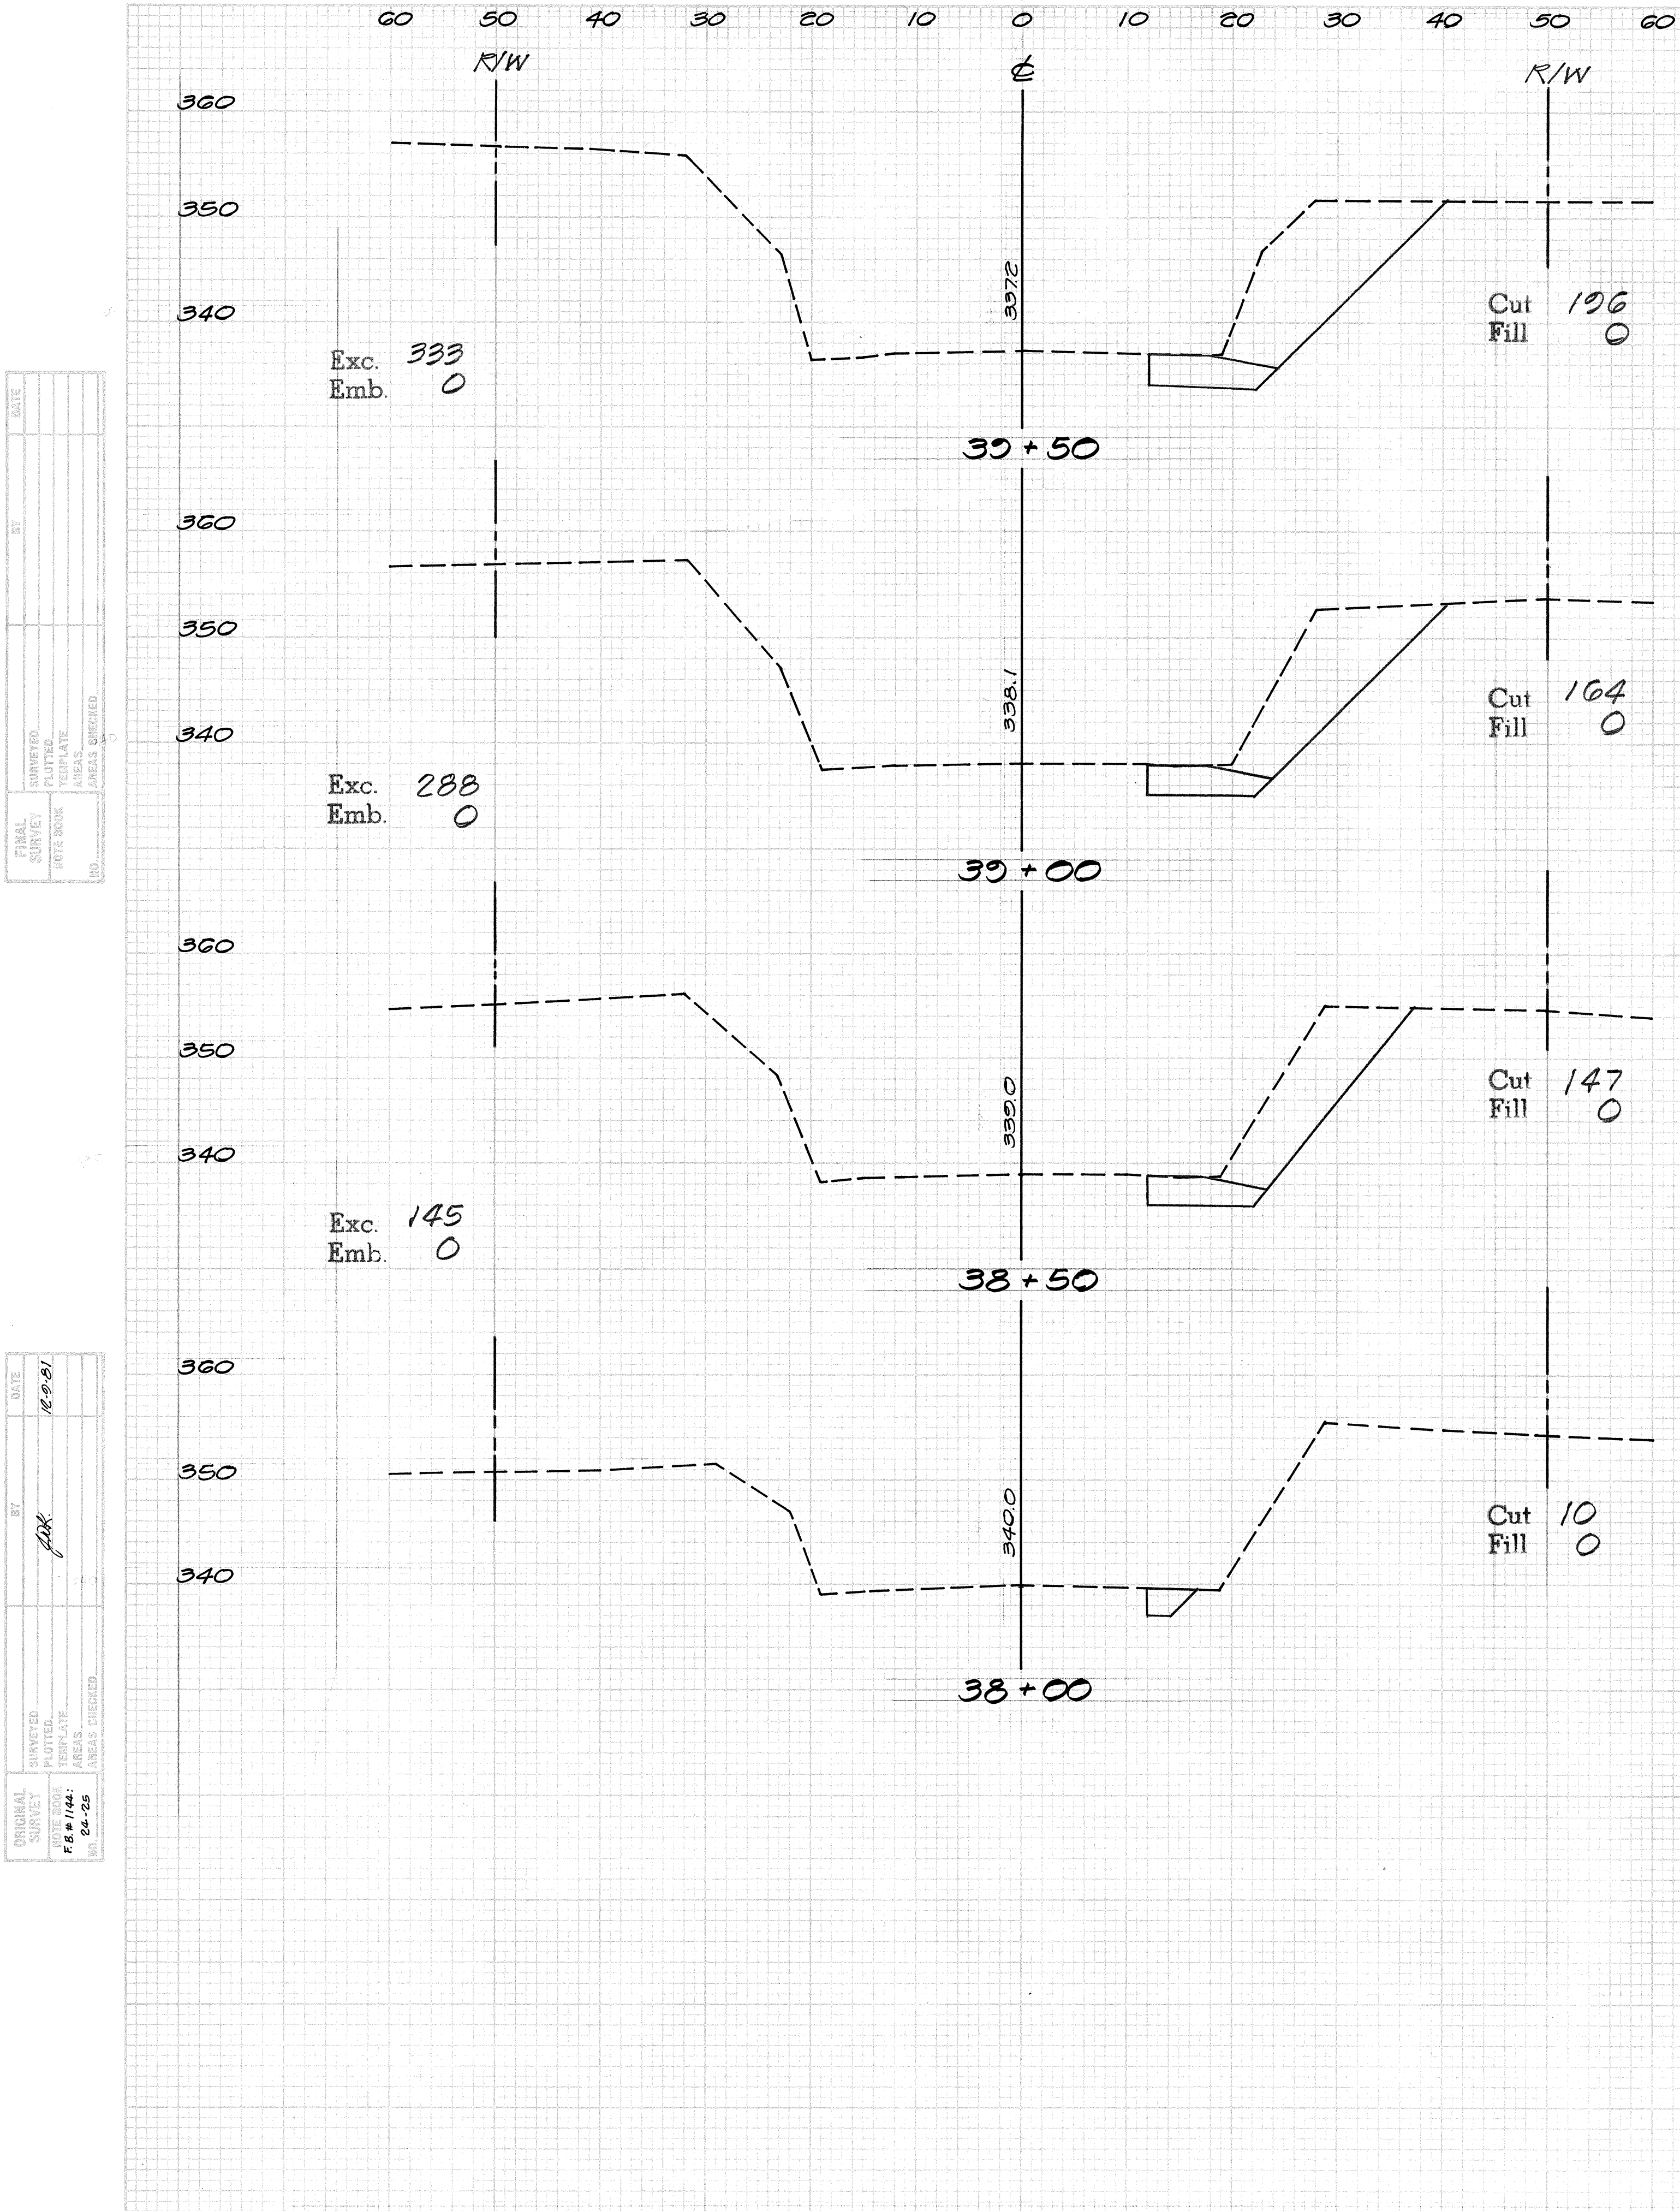



FED. ROAD DIST. NO.	STATE	PROJ. NO.	FISCAL YEAR	SHEET NO.	TOTAL SHEETS
HAWAII	HAW.	19J-02- 75 VII	1982	31	36

ORIGINAL SURVEY	SURVEYED	BY	DATE
NOTE BOOK	PLOTTED	<i>gsk</i>	12-9-81
F8 # 144	TEMPLATE		
25-27	AREAS		
	AREAS CHECKED		

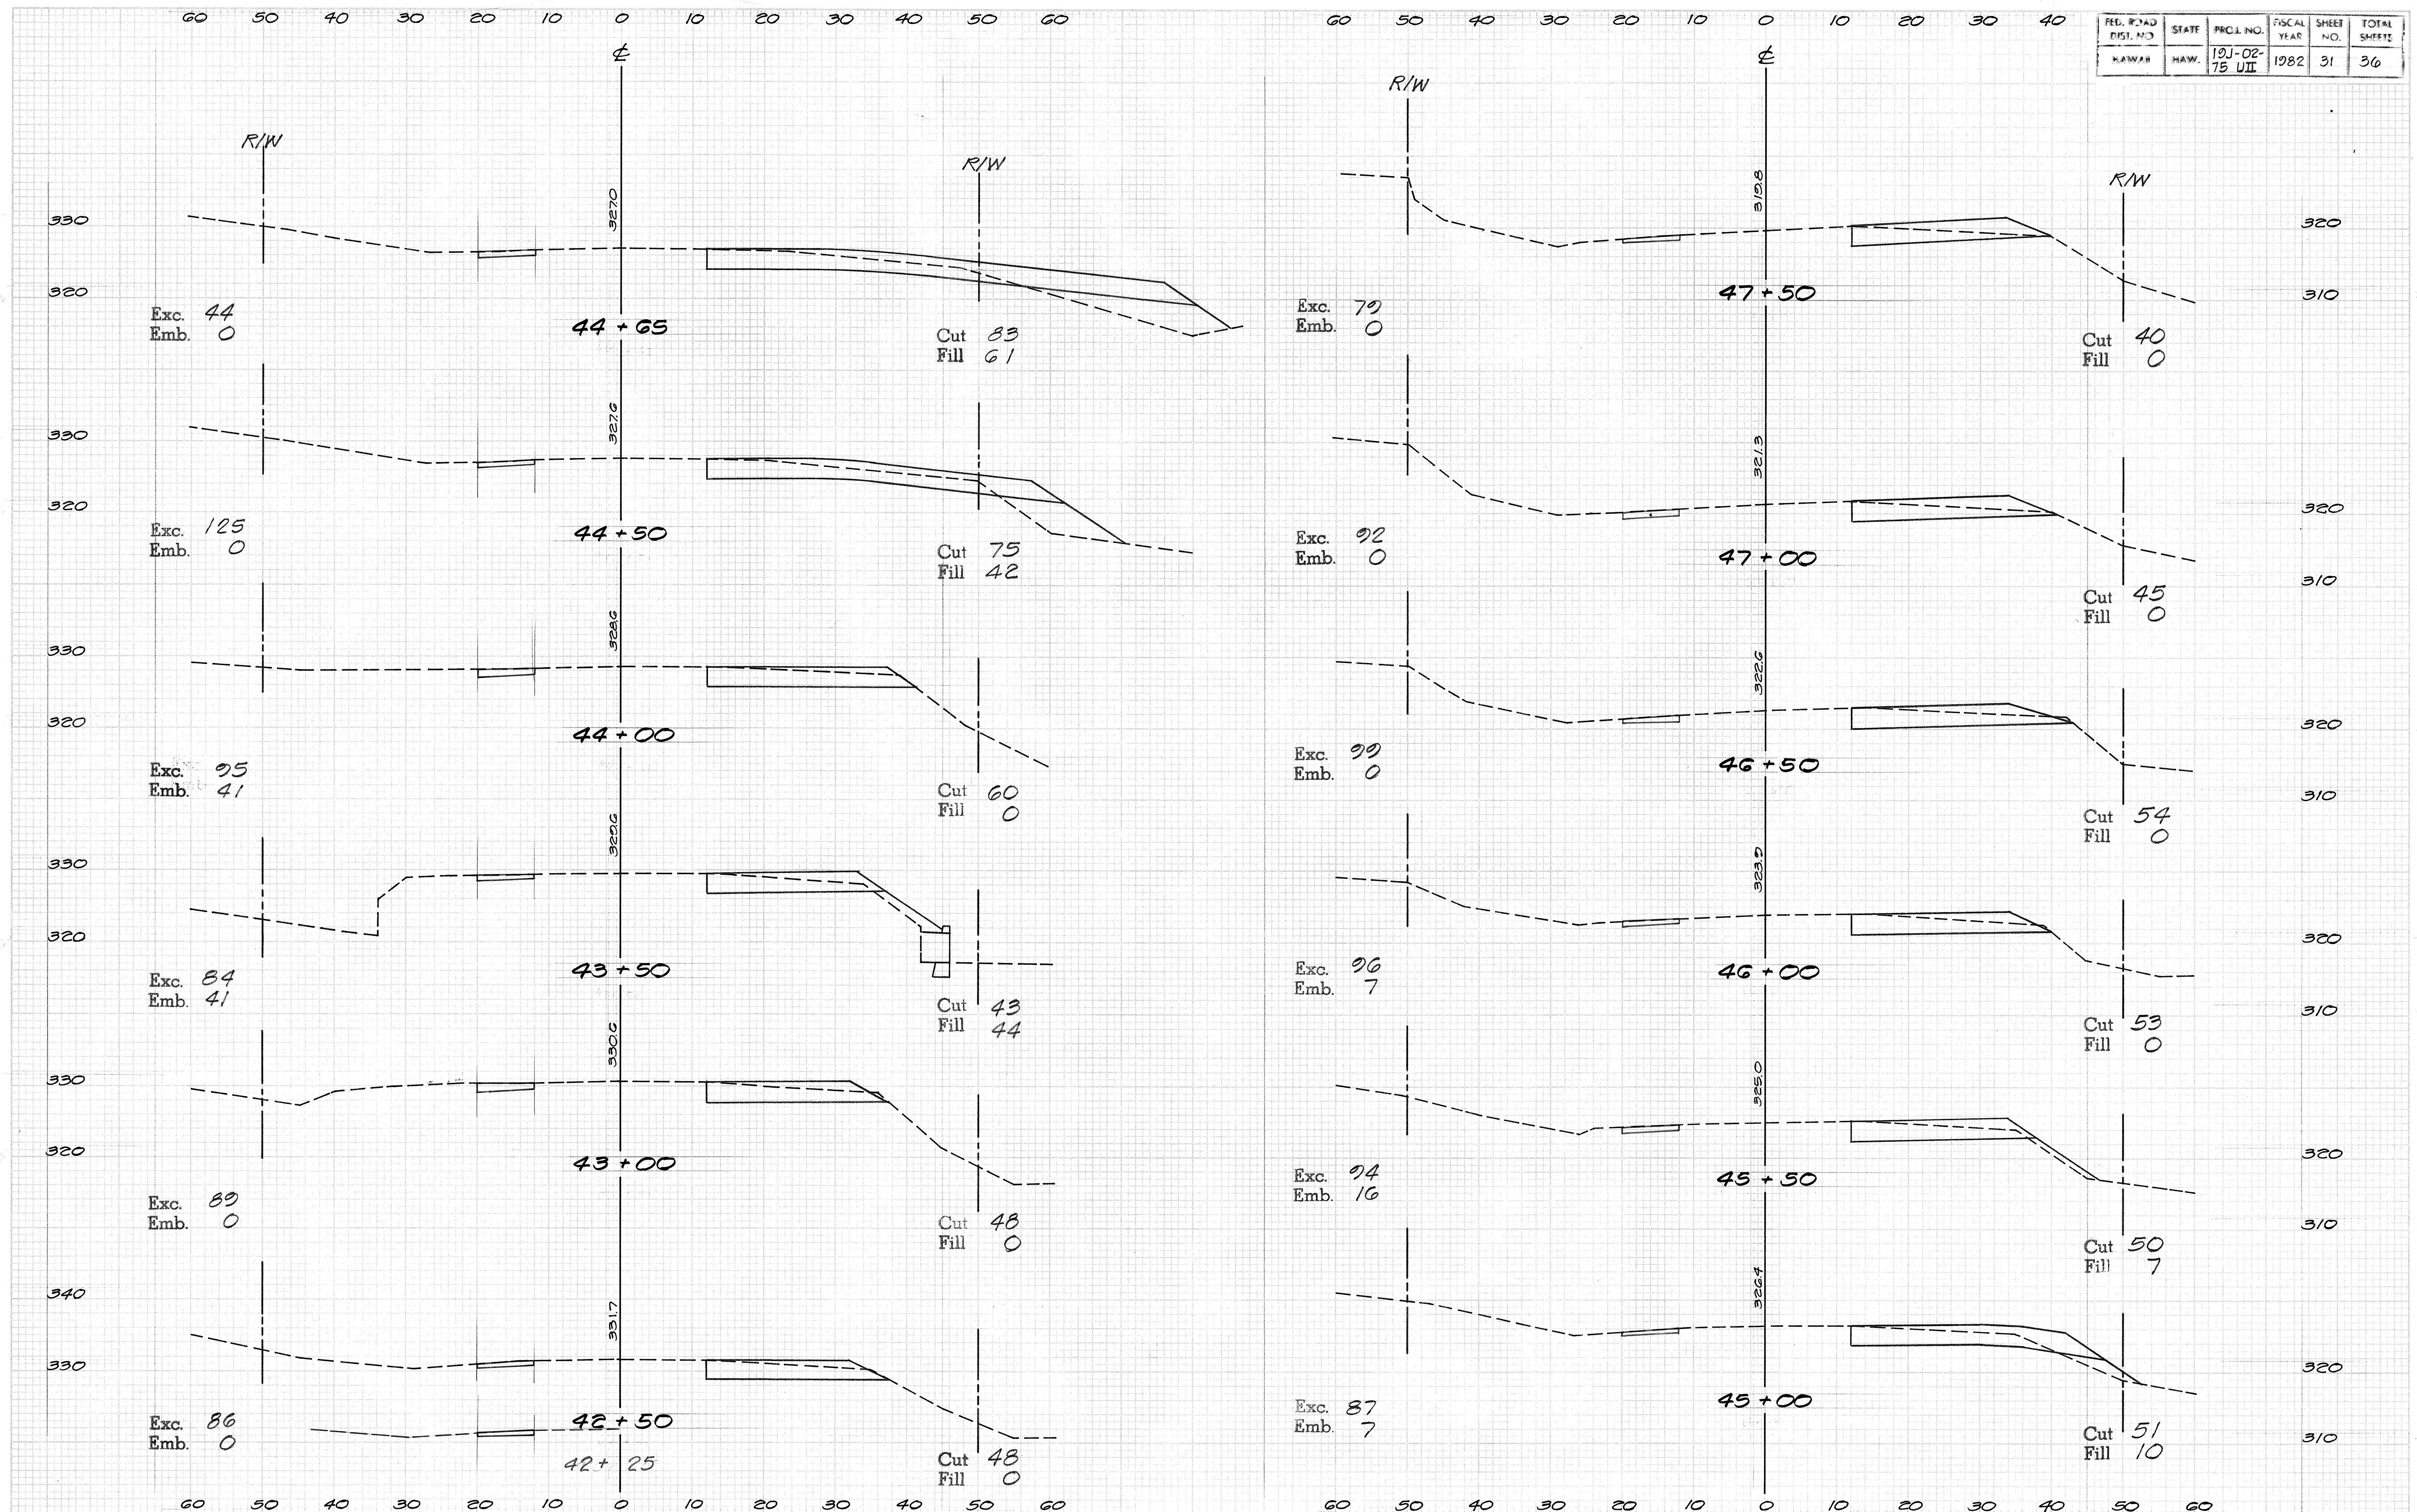

DATE	BY
SURVEYED	
PLOTTED	
CHECKED	
AREAS CHECKED	



DATE	BY
12-2-81	gdk
SURVEYED	
PLOTTED	
CHECKED	
AREAS CHECKED	

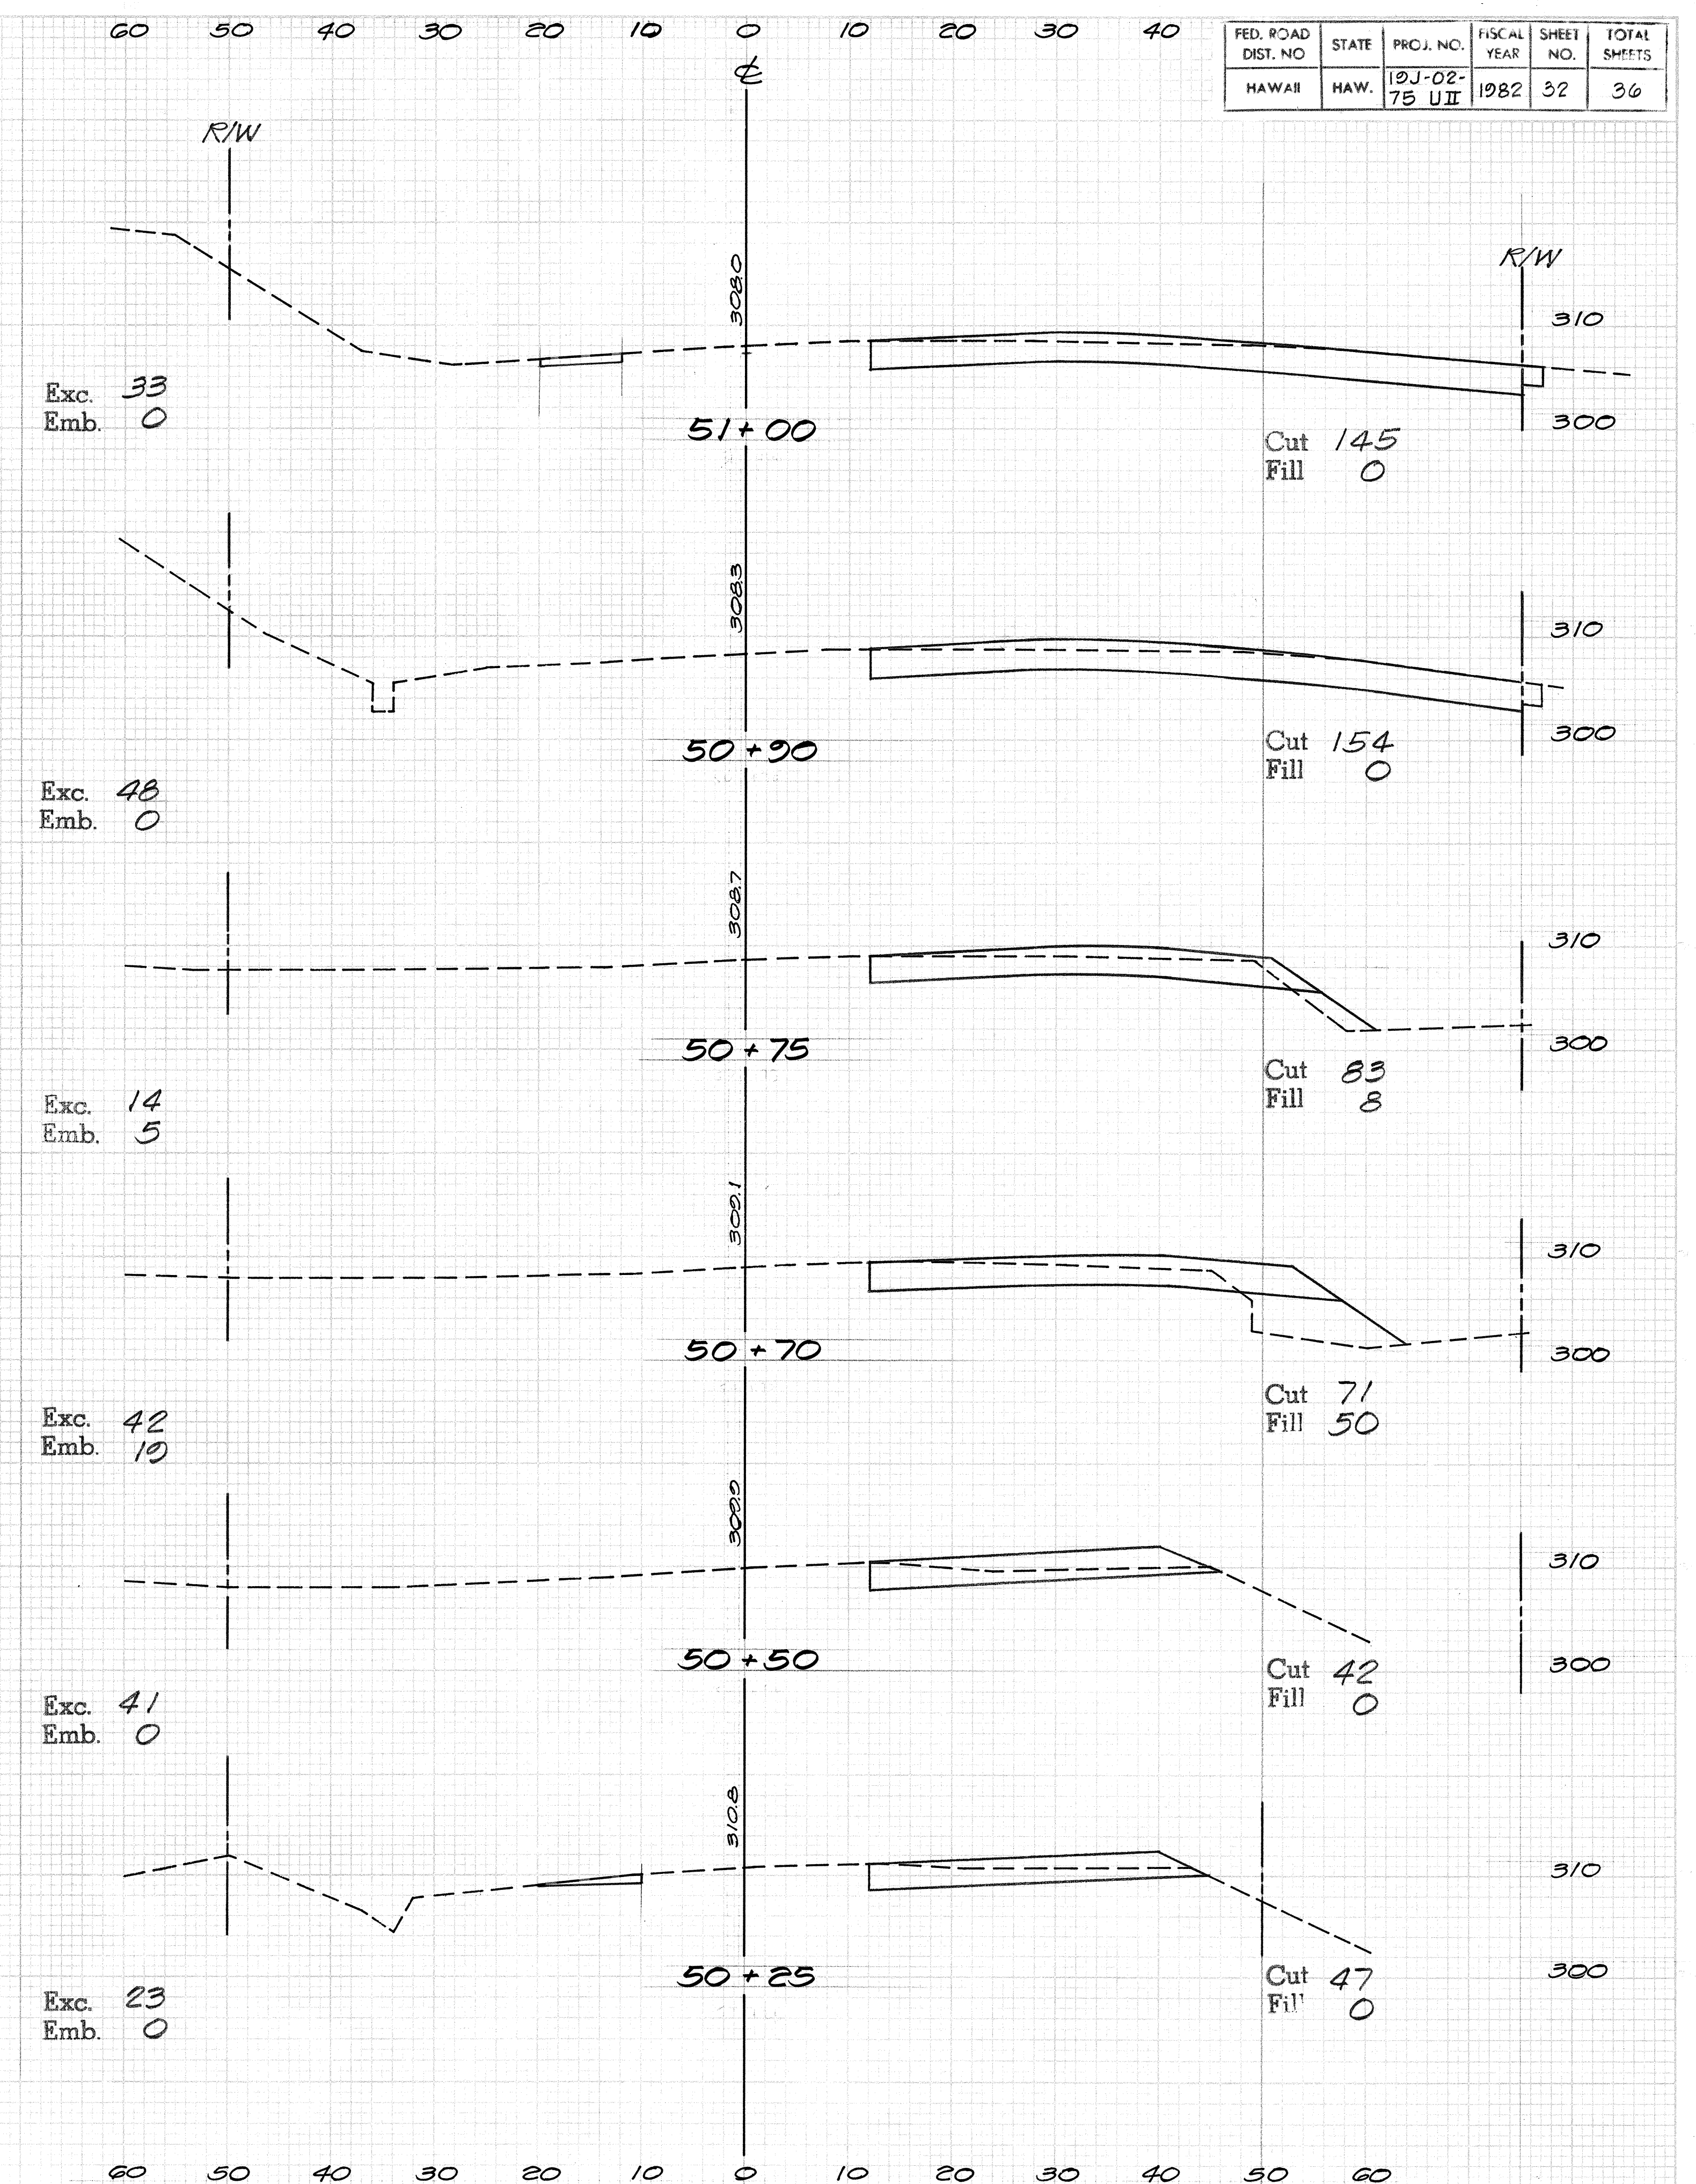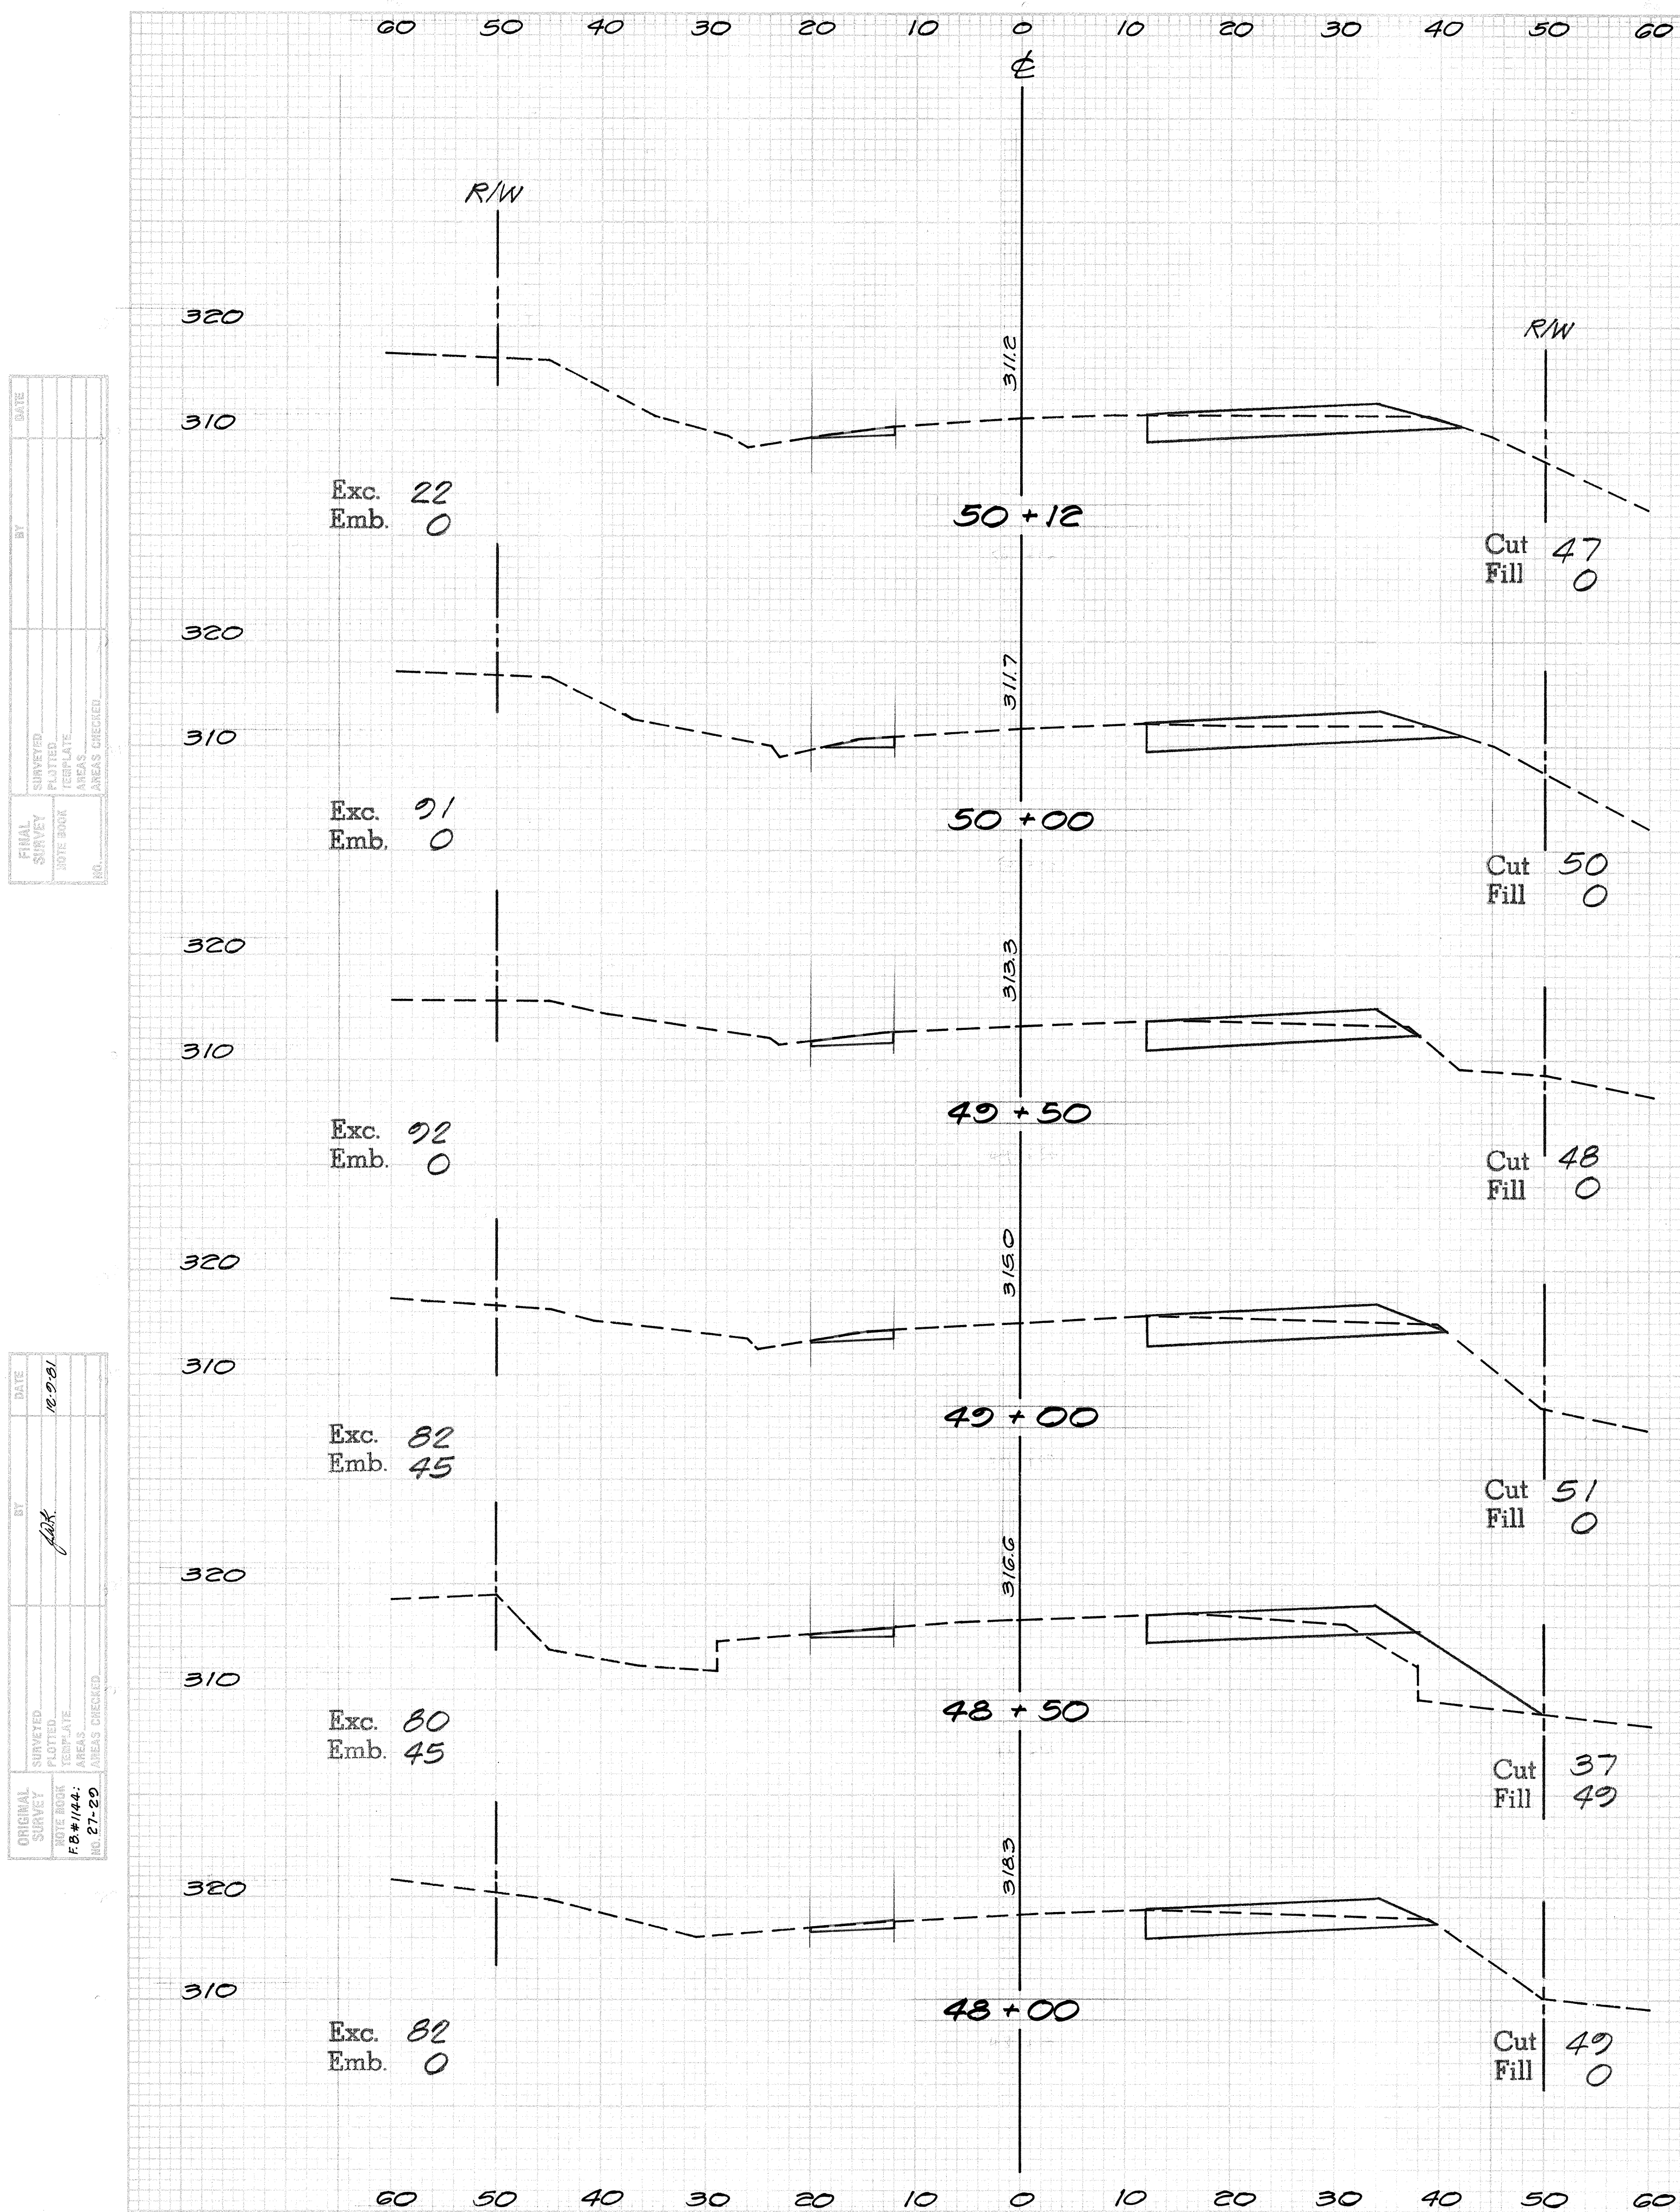

FED. ROAD DIST. NO.	STATE	PROJ. NO.	FISCAL YEAR	SHEET NO.	TOTAL SHEETS
HAWAII	HAW.	10J-02-75 U II	1982	32	36

DATE:
 BY:
 SURVEYED:
 PLOTTED:
 CHECKED:
 REVISIONS:
 NO. 22-32

DATE: 12-91
 BY: JAK
 SURVEYED:
 PLOTTED:
 CHECKED:
 REVISIONS:
 NO. 22-32

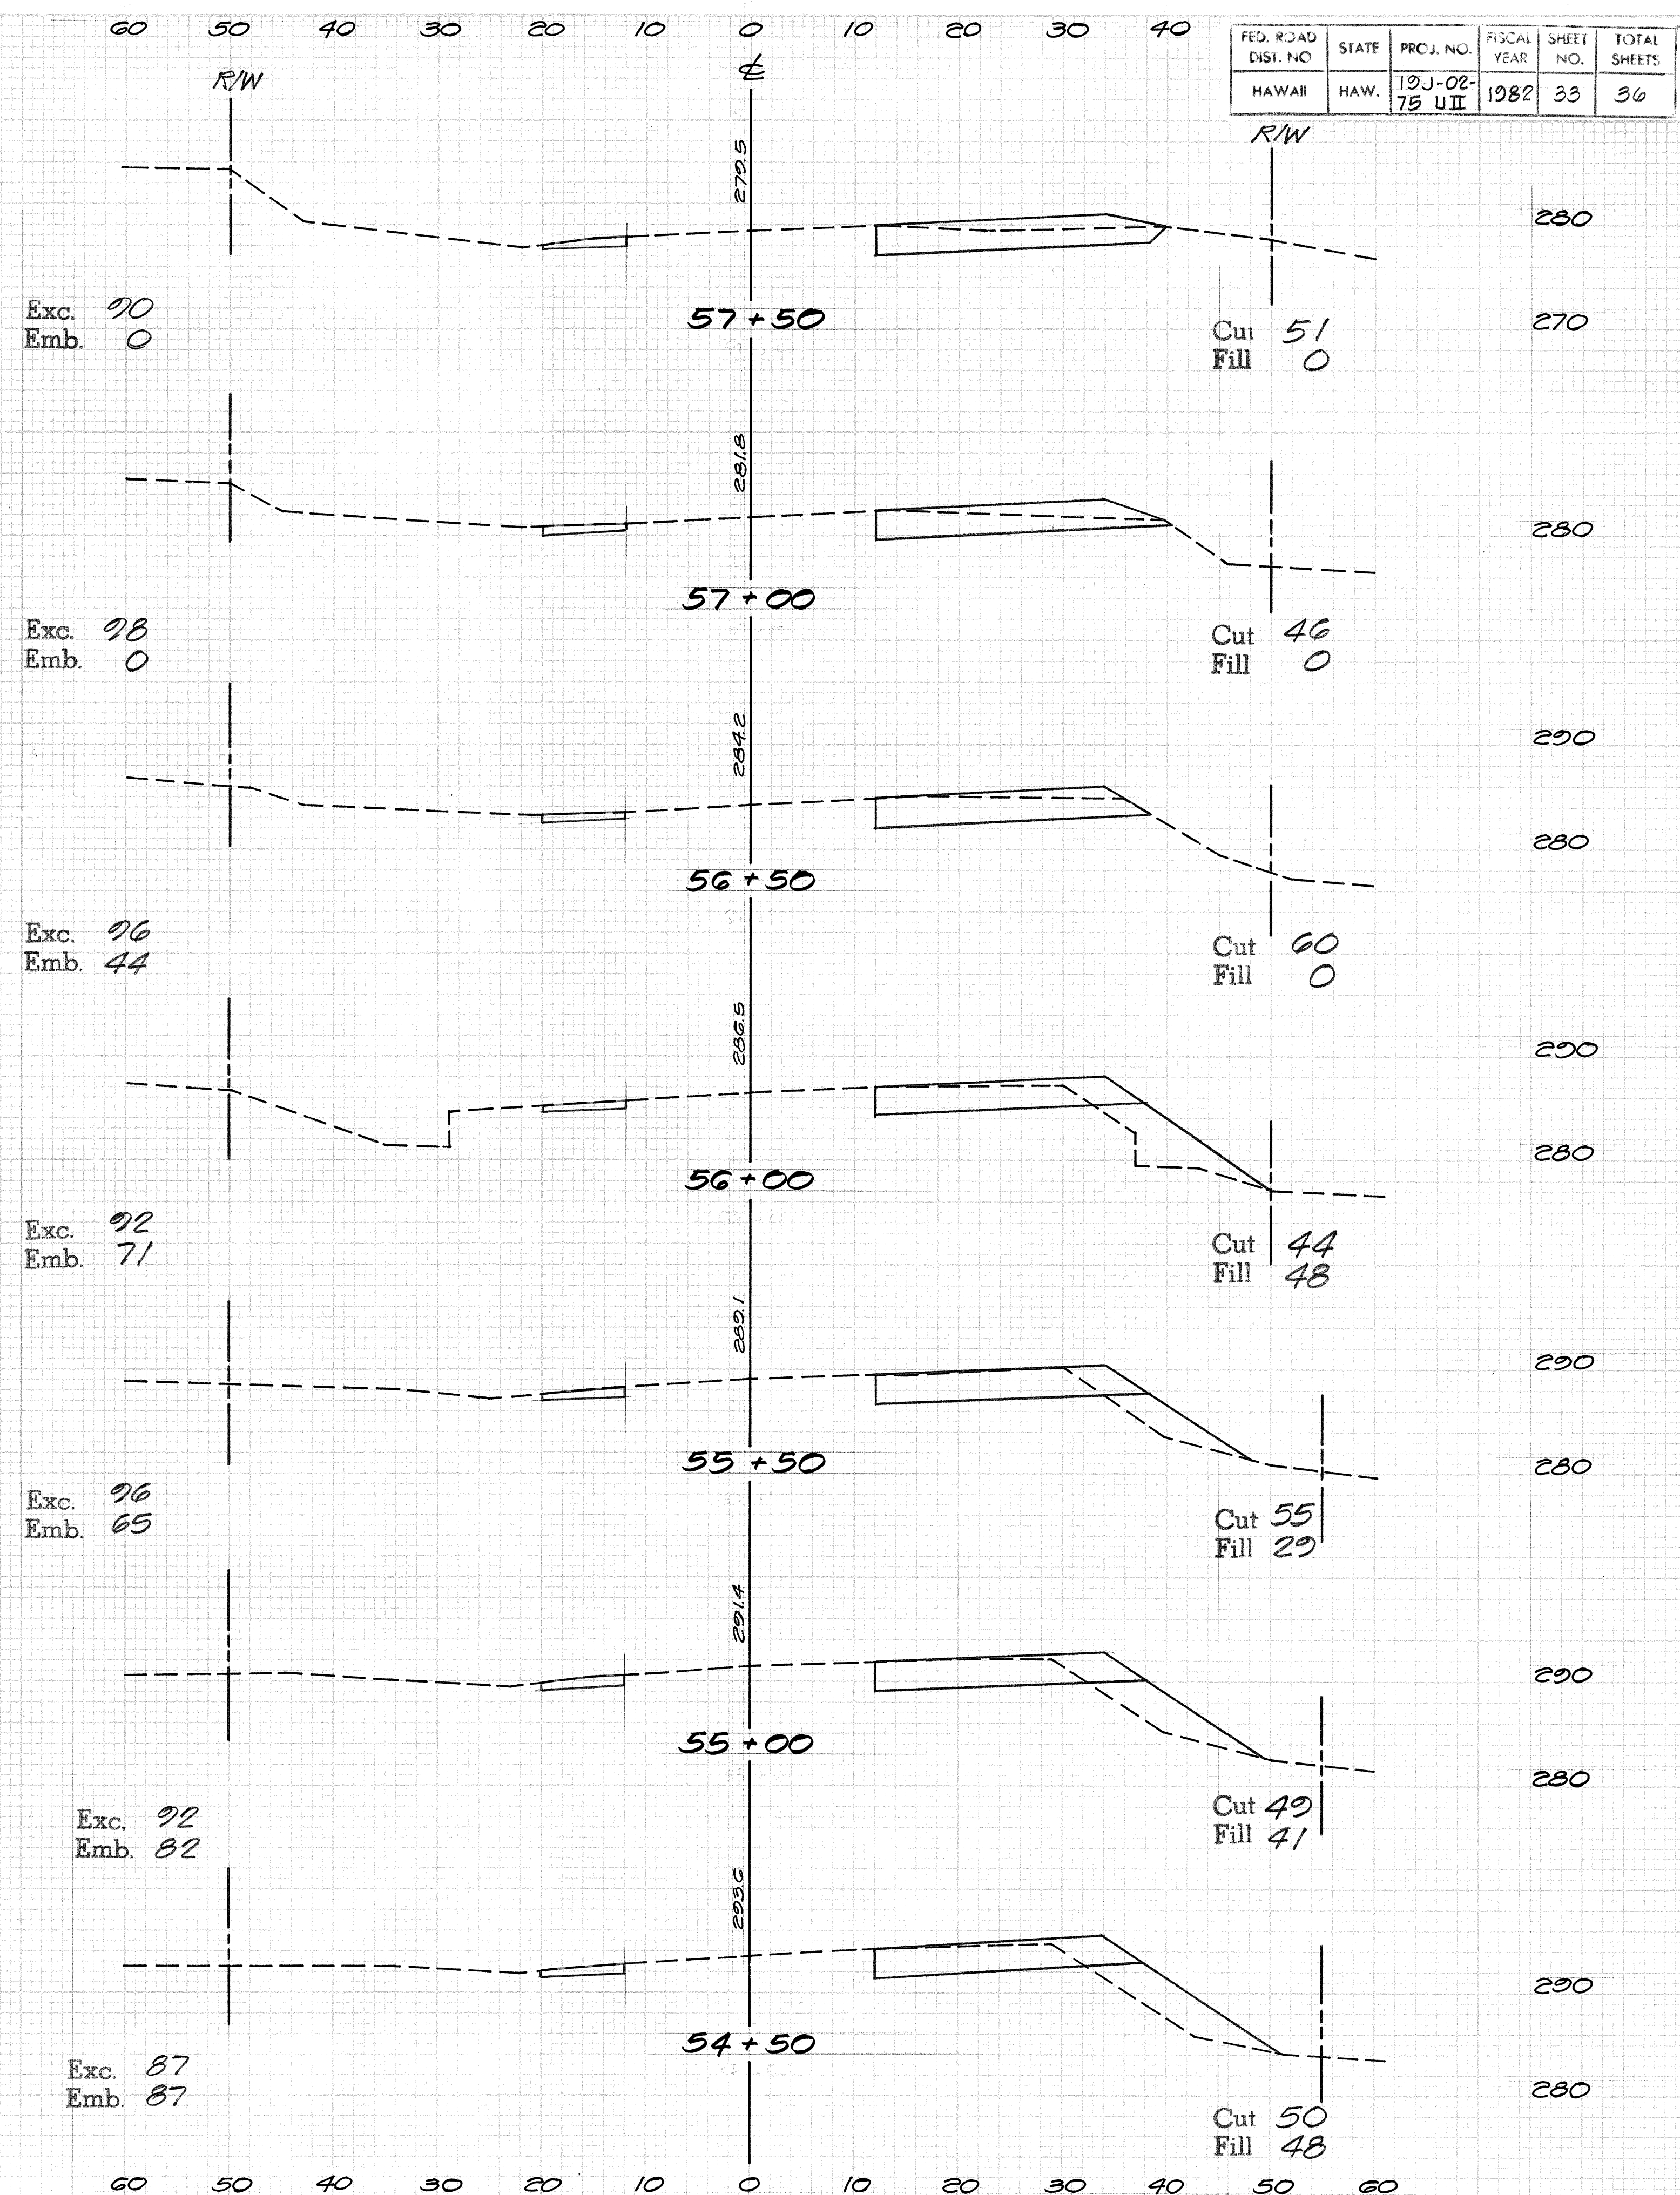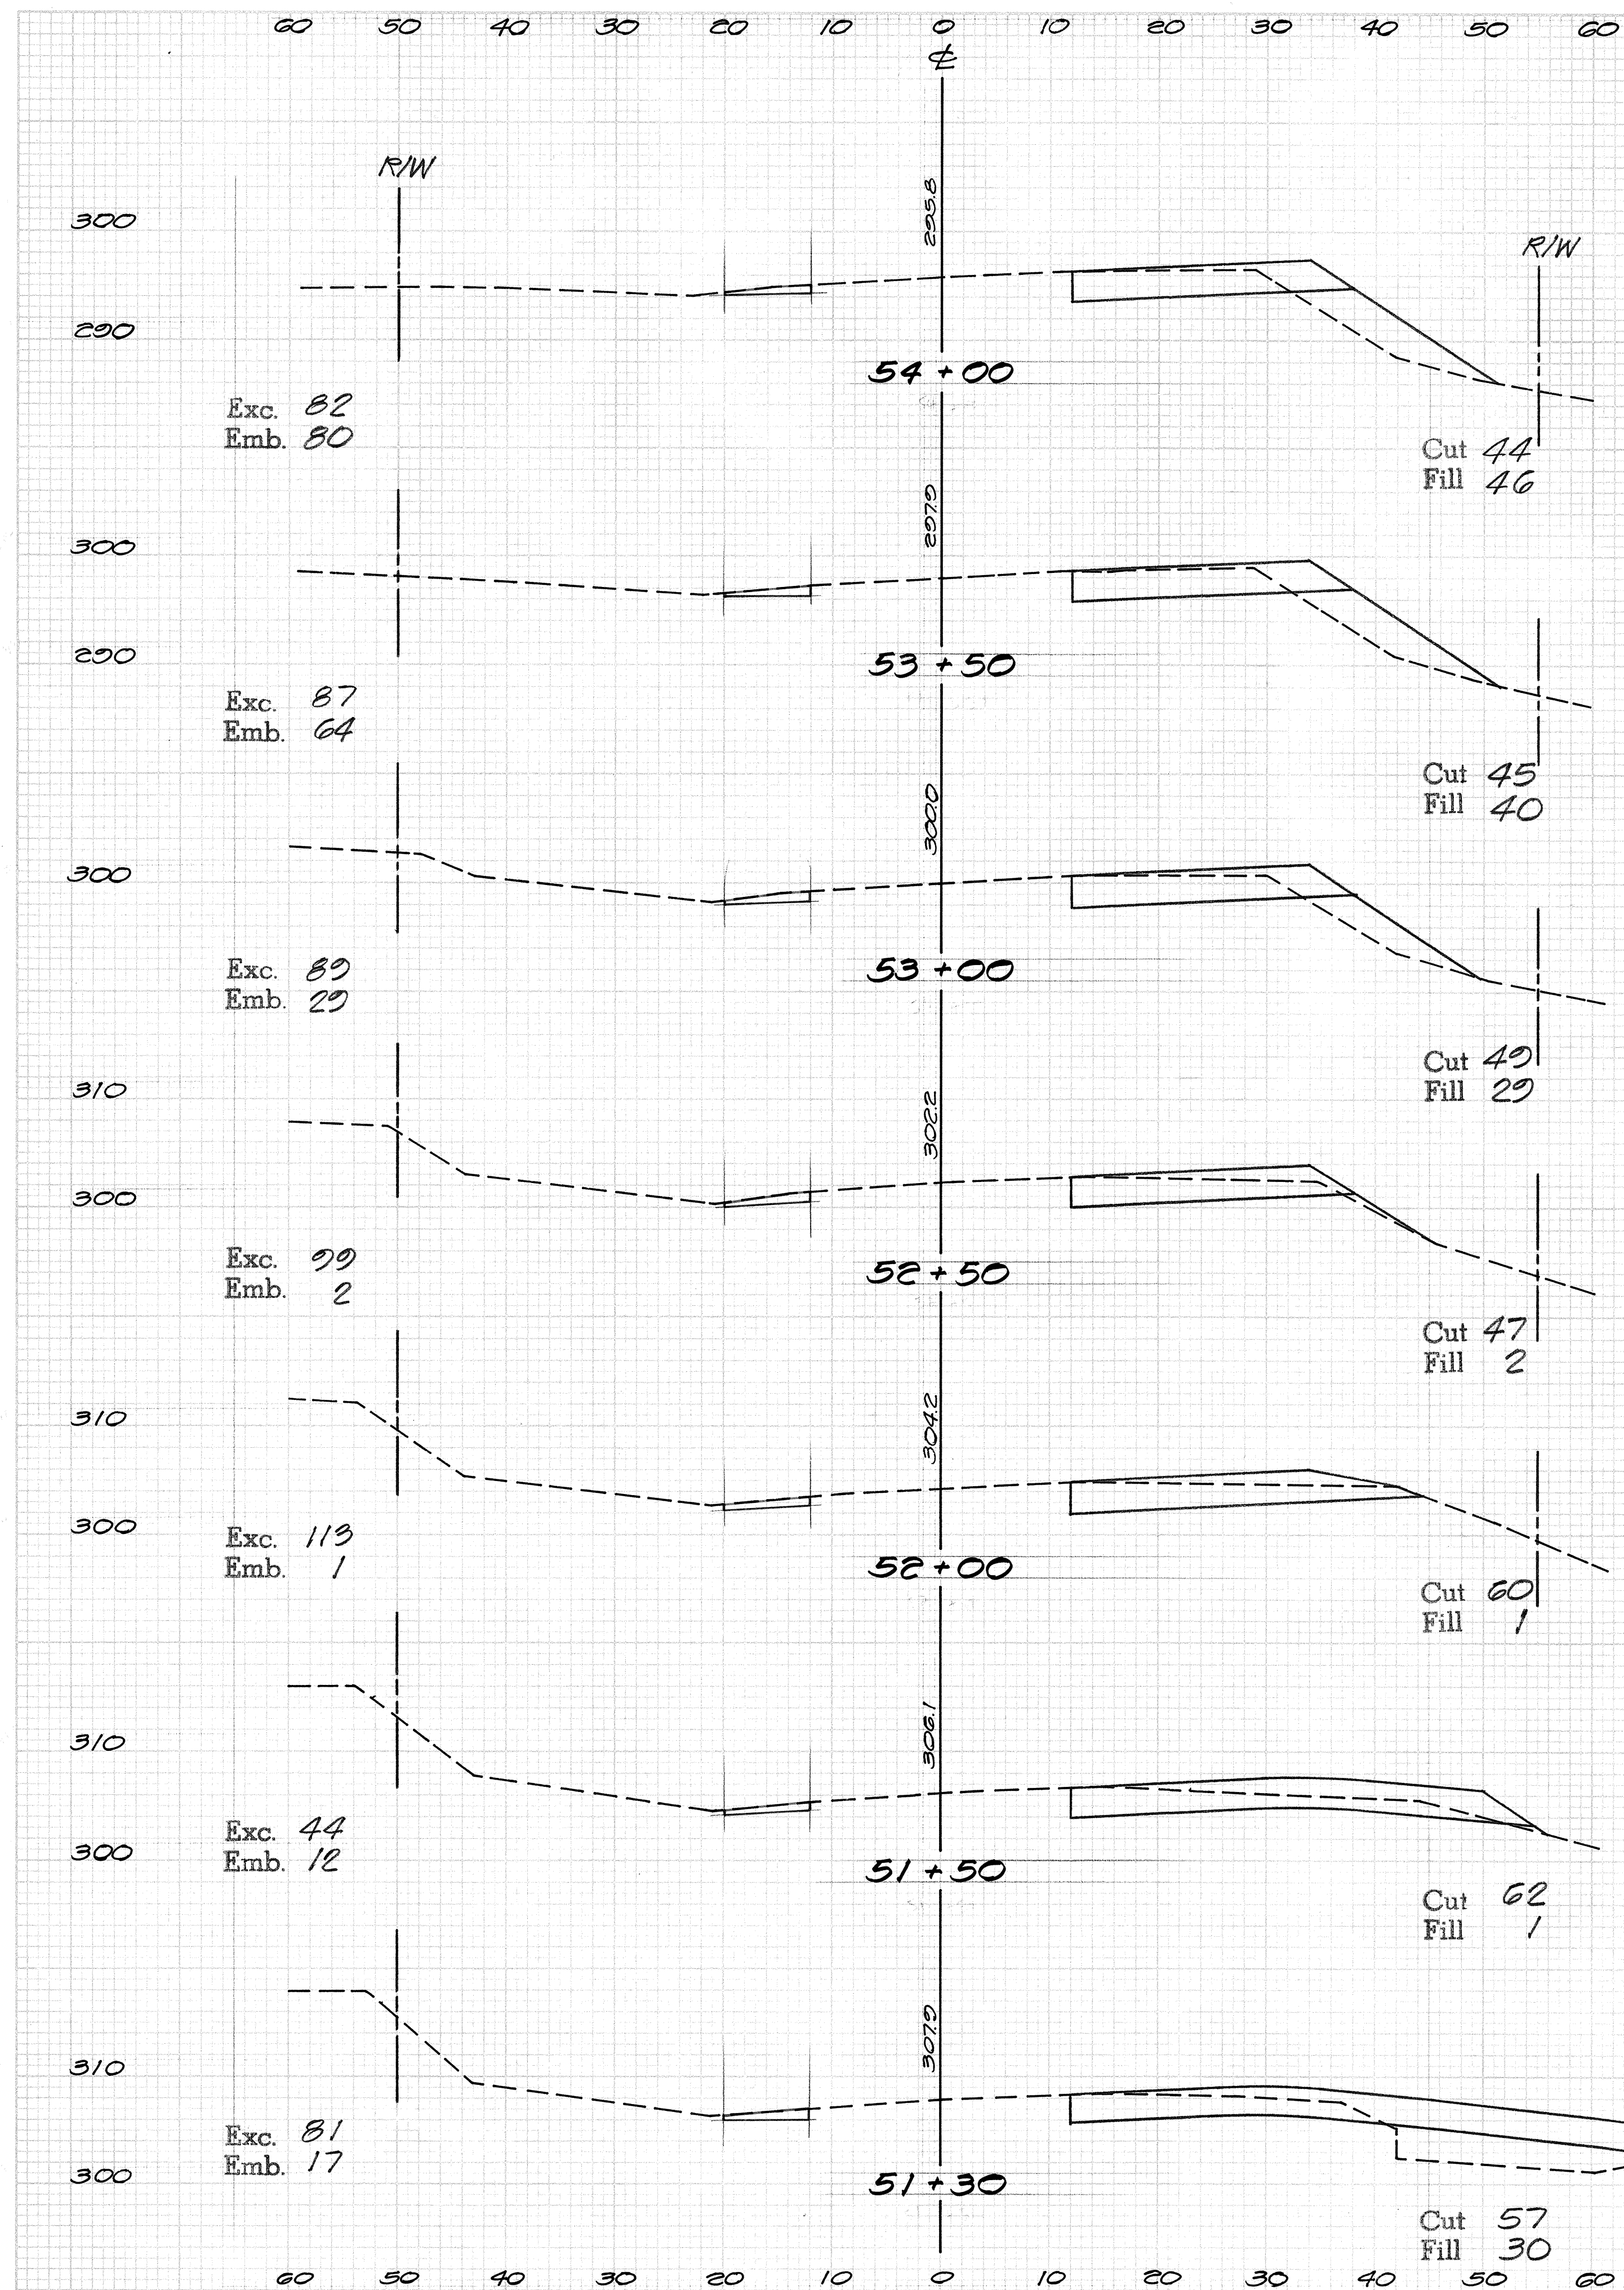


FED. ROAD DIST. NO.	STATE	PROJ. NO.	FISCAL YEAR	SHEET NO.	TOTAL SHEETS
HAWAII	HAW.	19J-02-75 U.II	1982	33	36

FED. ROAD DIST. NO.	STATE	PROJ. NO.	FISCAL YEAR	SHEET NO.	TOTAL SHEETS
HAWAII	HAW.	19J-02-75 UII	1982	34	36

DATE	BY
SURVEYED	PLOTTED
NOTE BOOK	AREAS CHECKED
NO.	

DATE	BY
10-29-82	AK
SURVEYED	PLOTTED
NOTE BOOK	AREAS CHECKED
NO.	

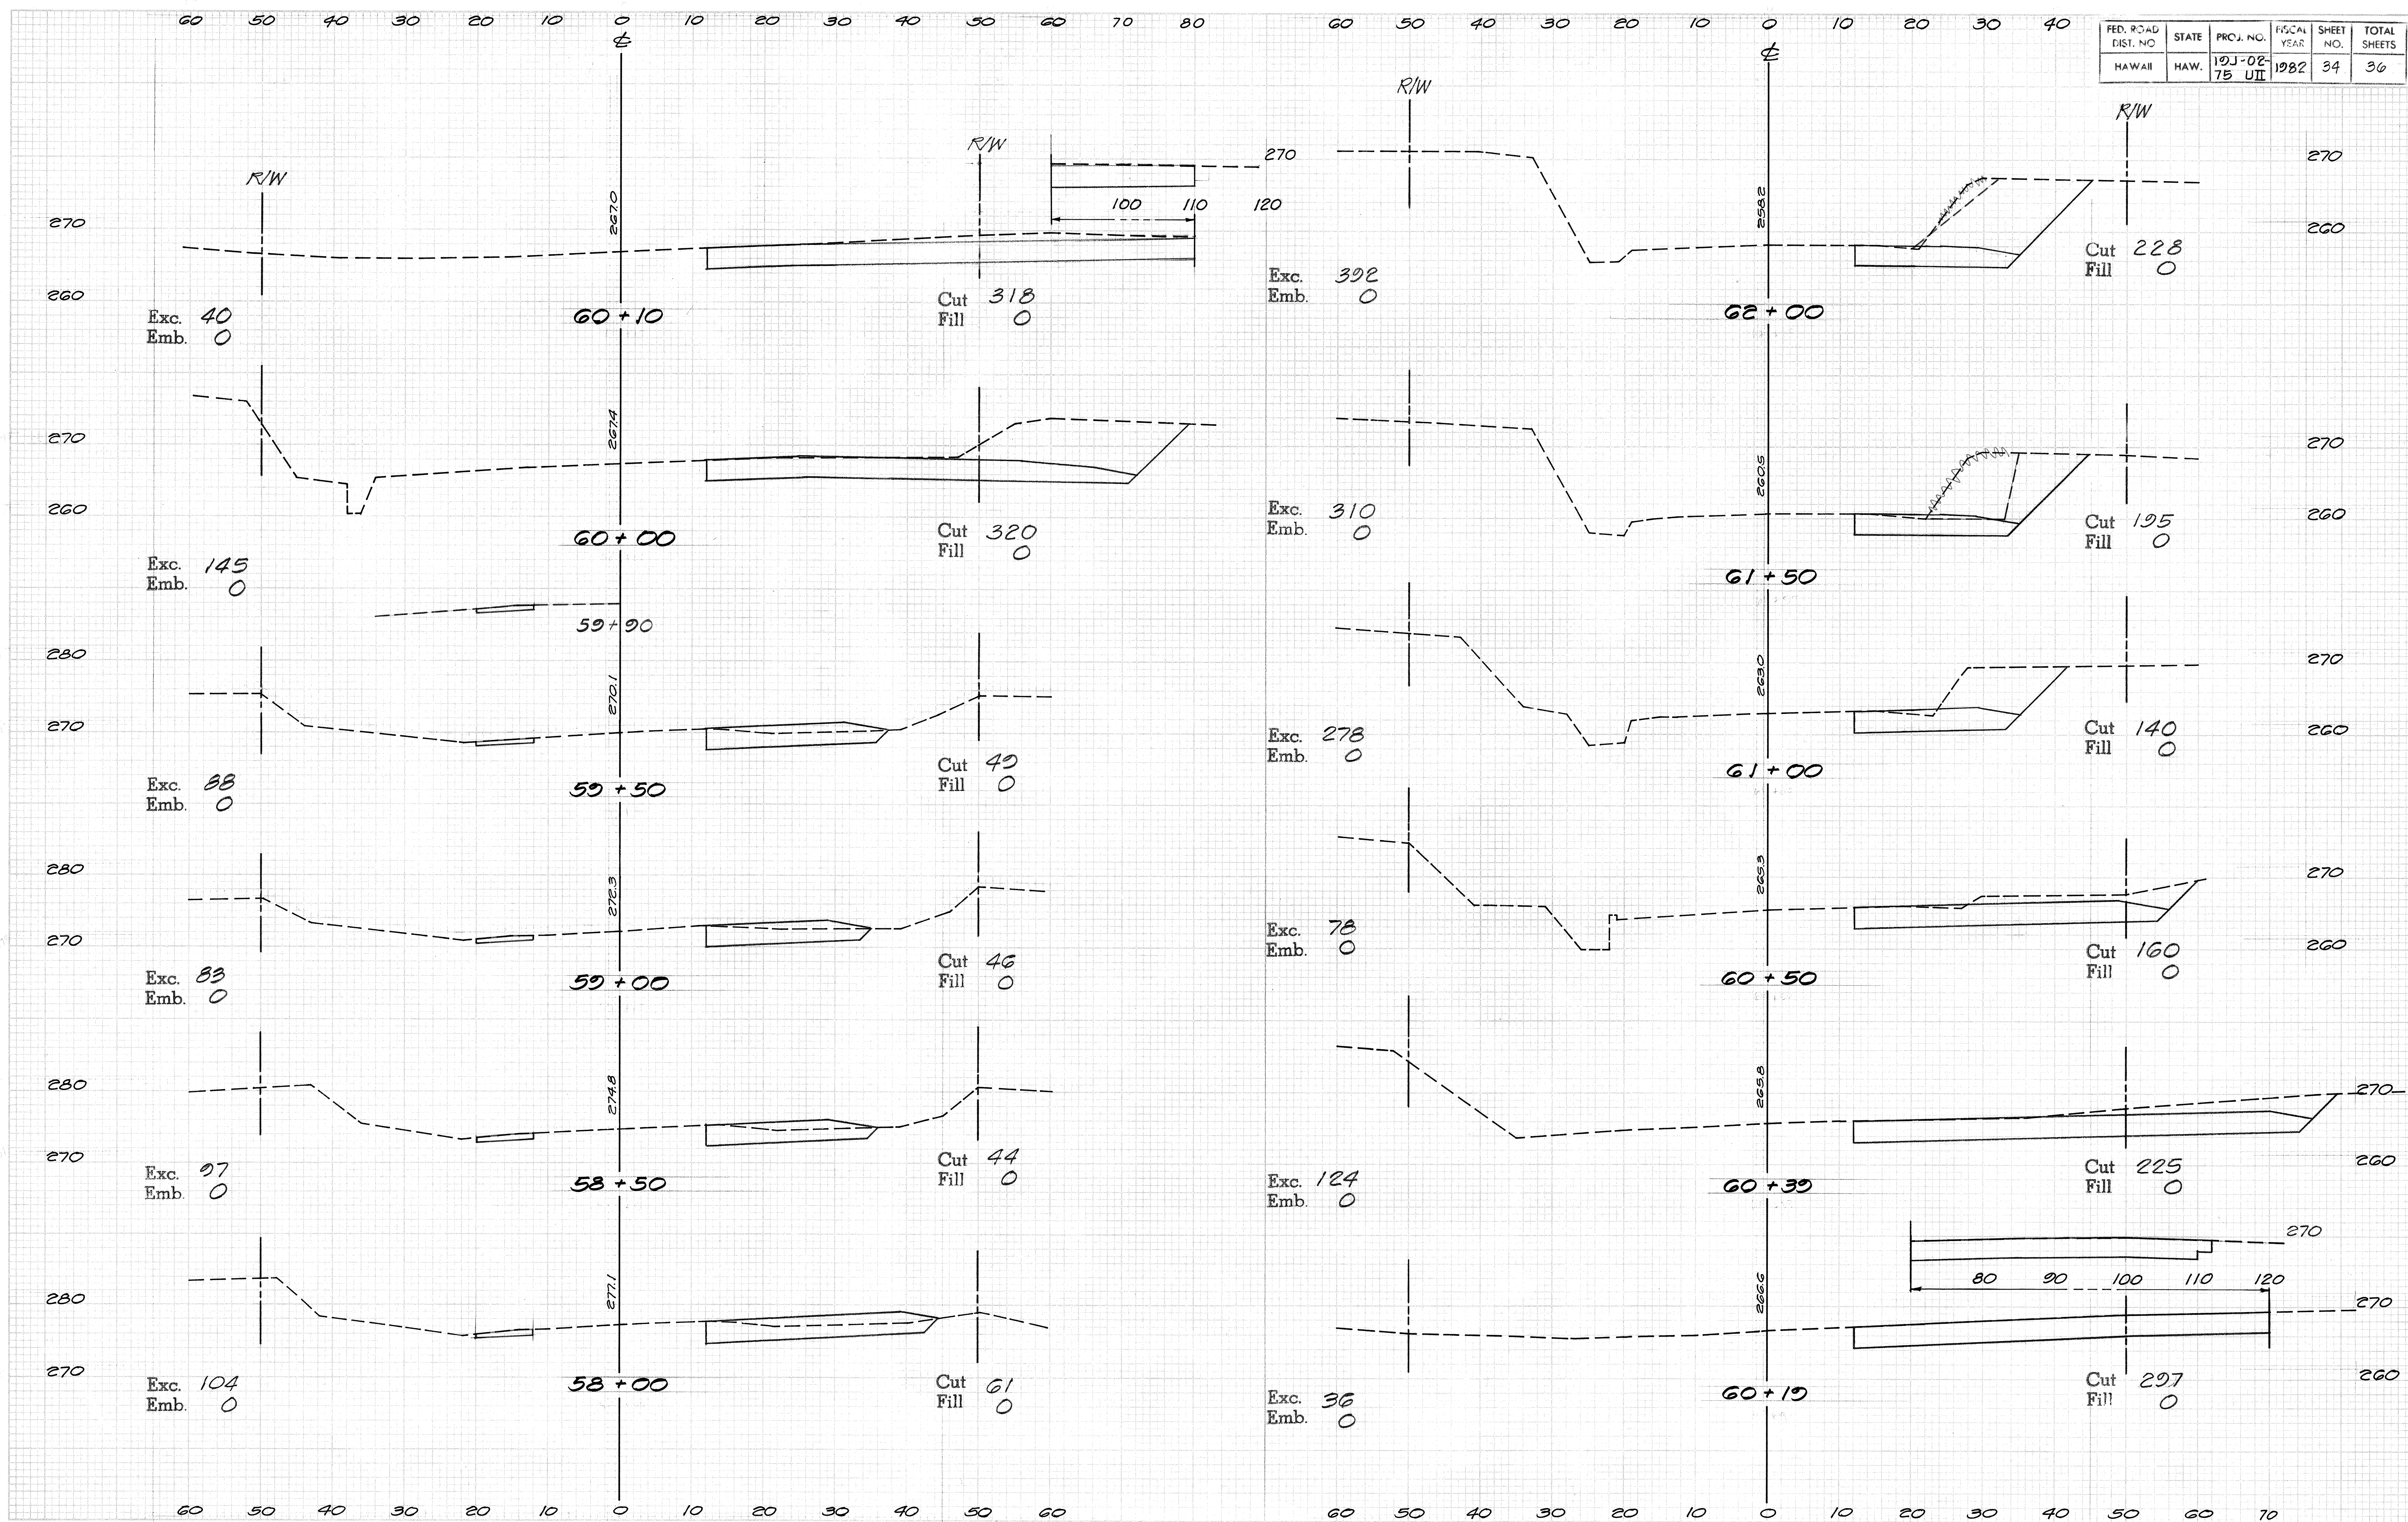

FED. ROAD DIST. NO.	STATE	PROJ. NO.	FISCAL YEAR	SHEET NO.	TOTAL SHEETS
HAWAII	HAW.	19J-02-75 VII	1982	35	36

DATE	BY
10-9-81	fax

DATE	BY
10-9-81	fax

