


FED. ROAD DIST. NO.	STATE	PROJ. NO.	FISCAL YEAR	SHEET NO.	TOTAL SHEETS
HAWAII	HAW.	19J-02-75 U II	1982	5	36

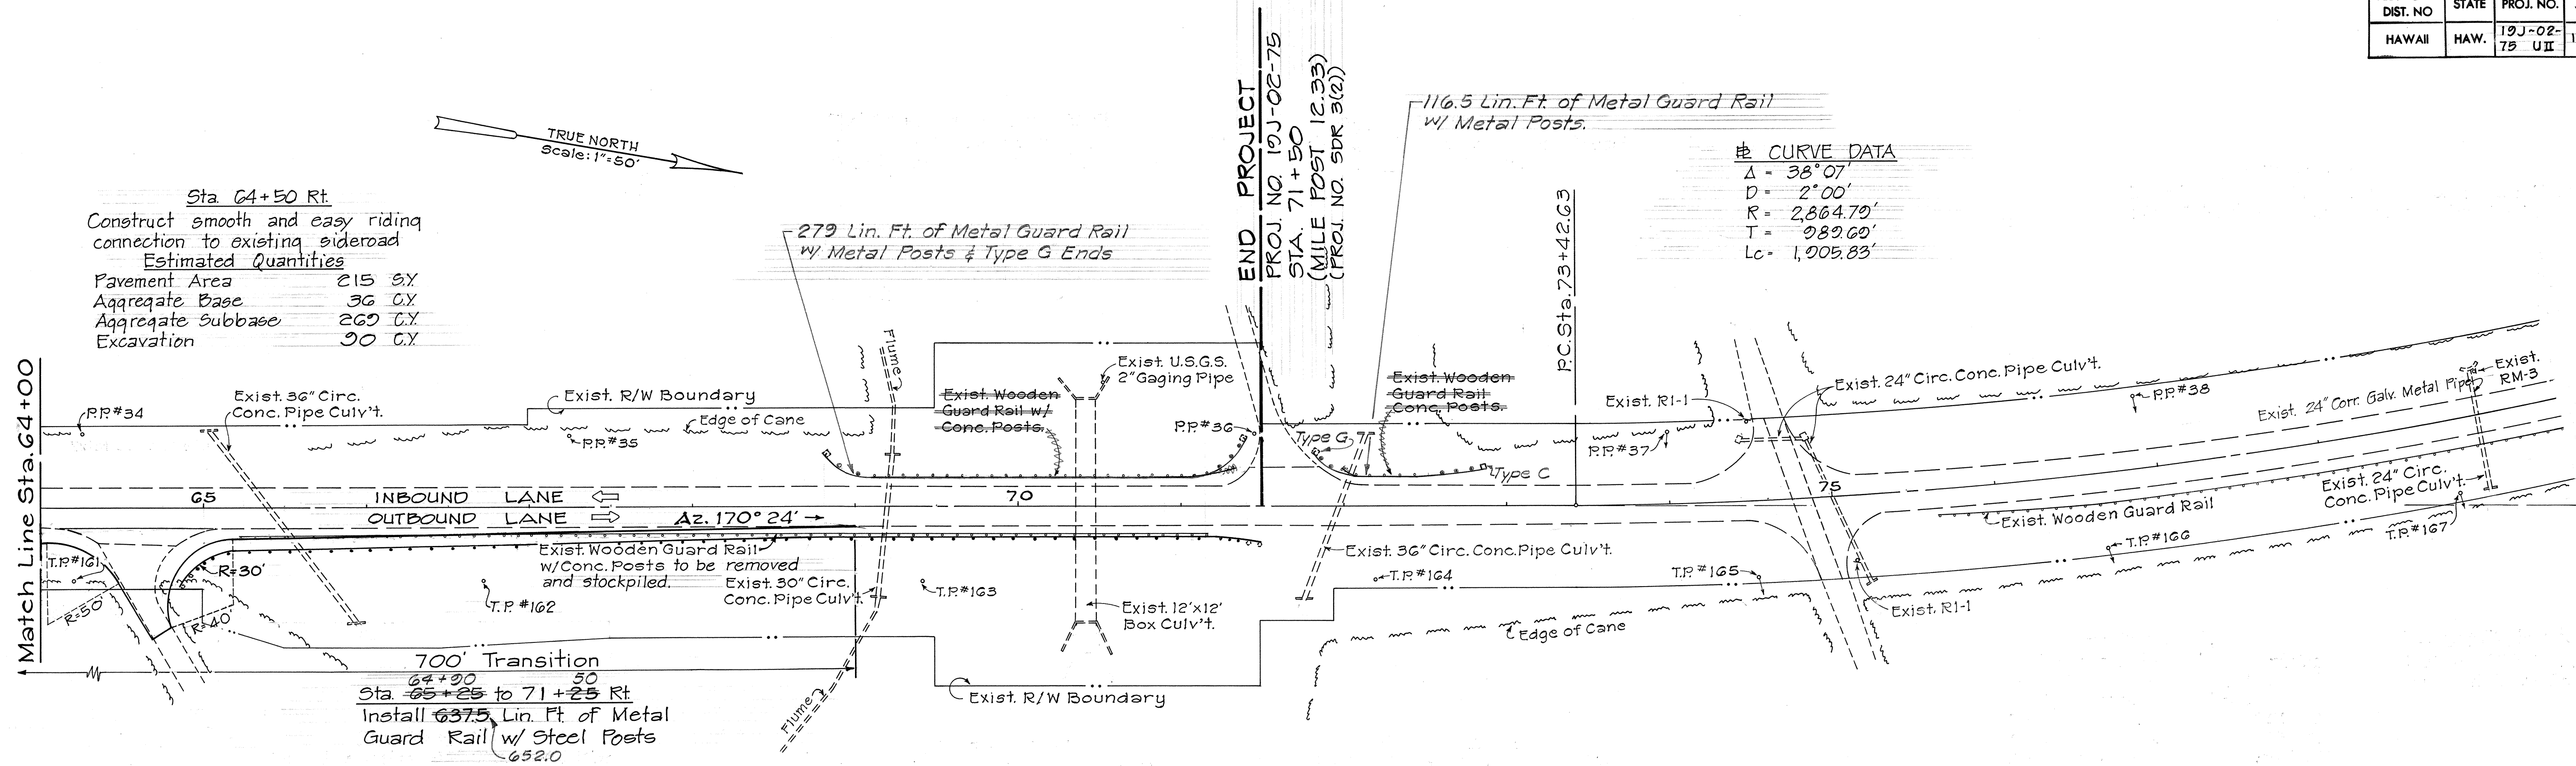

T. M. K. : 2 - 8 - 09
Pepeekeo Sugar Co.

T. M. K. : 2 - 8 - 12 : 1
Pepeekeo Sugar Co.

T. M. K. : 2 - 8 - 12 : 26
B. P. Bishop Estate

