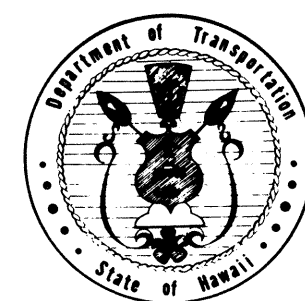


[illegible]

STATE OF HAWAII

DEPARTMENT OF TRANSPORTATION

HIGHWAYS DIVISION

"AS-BUILT"

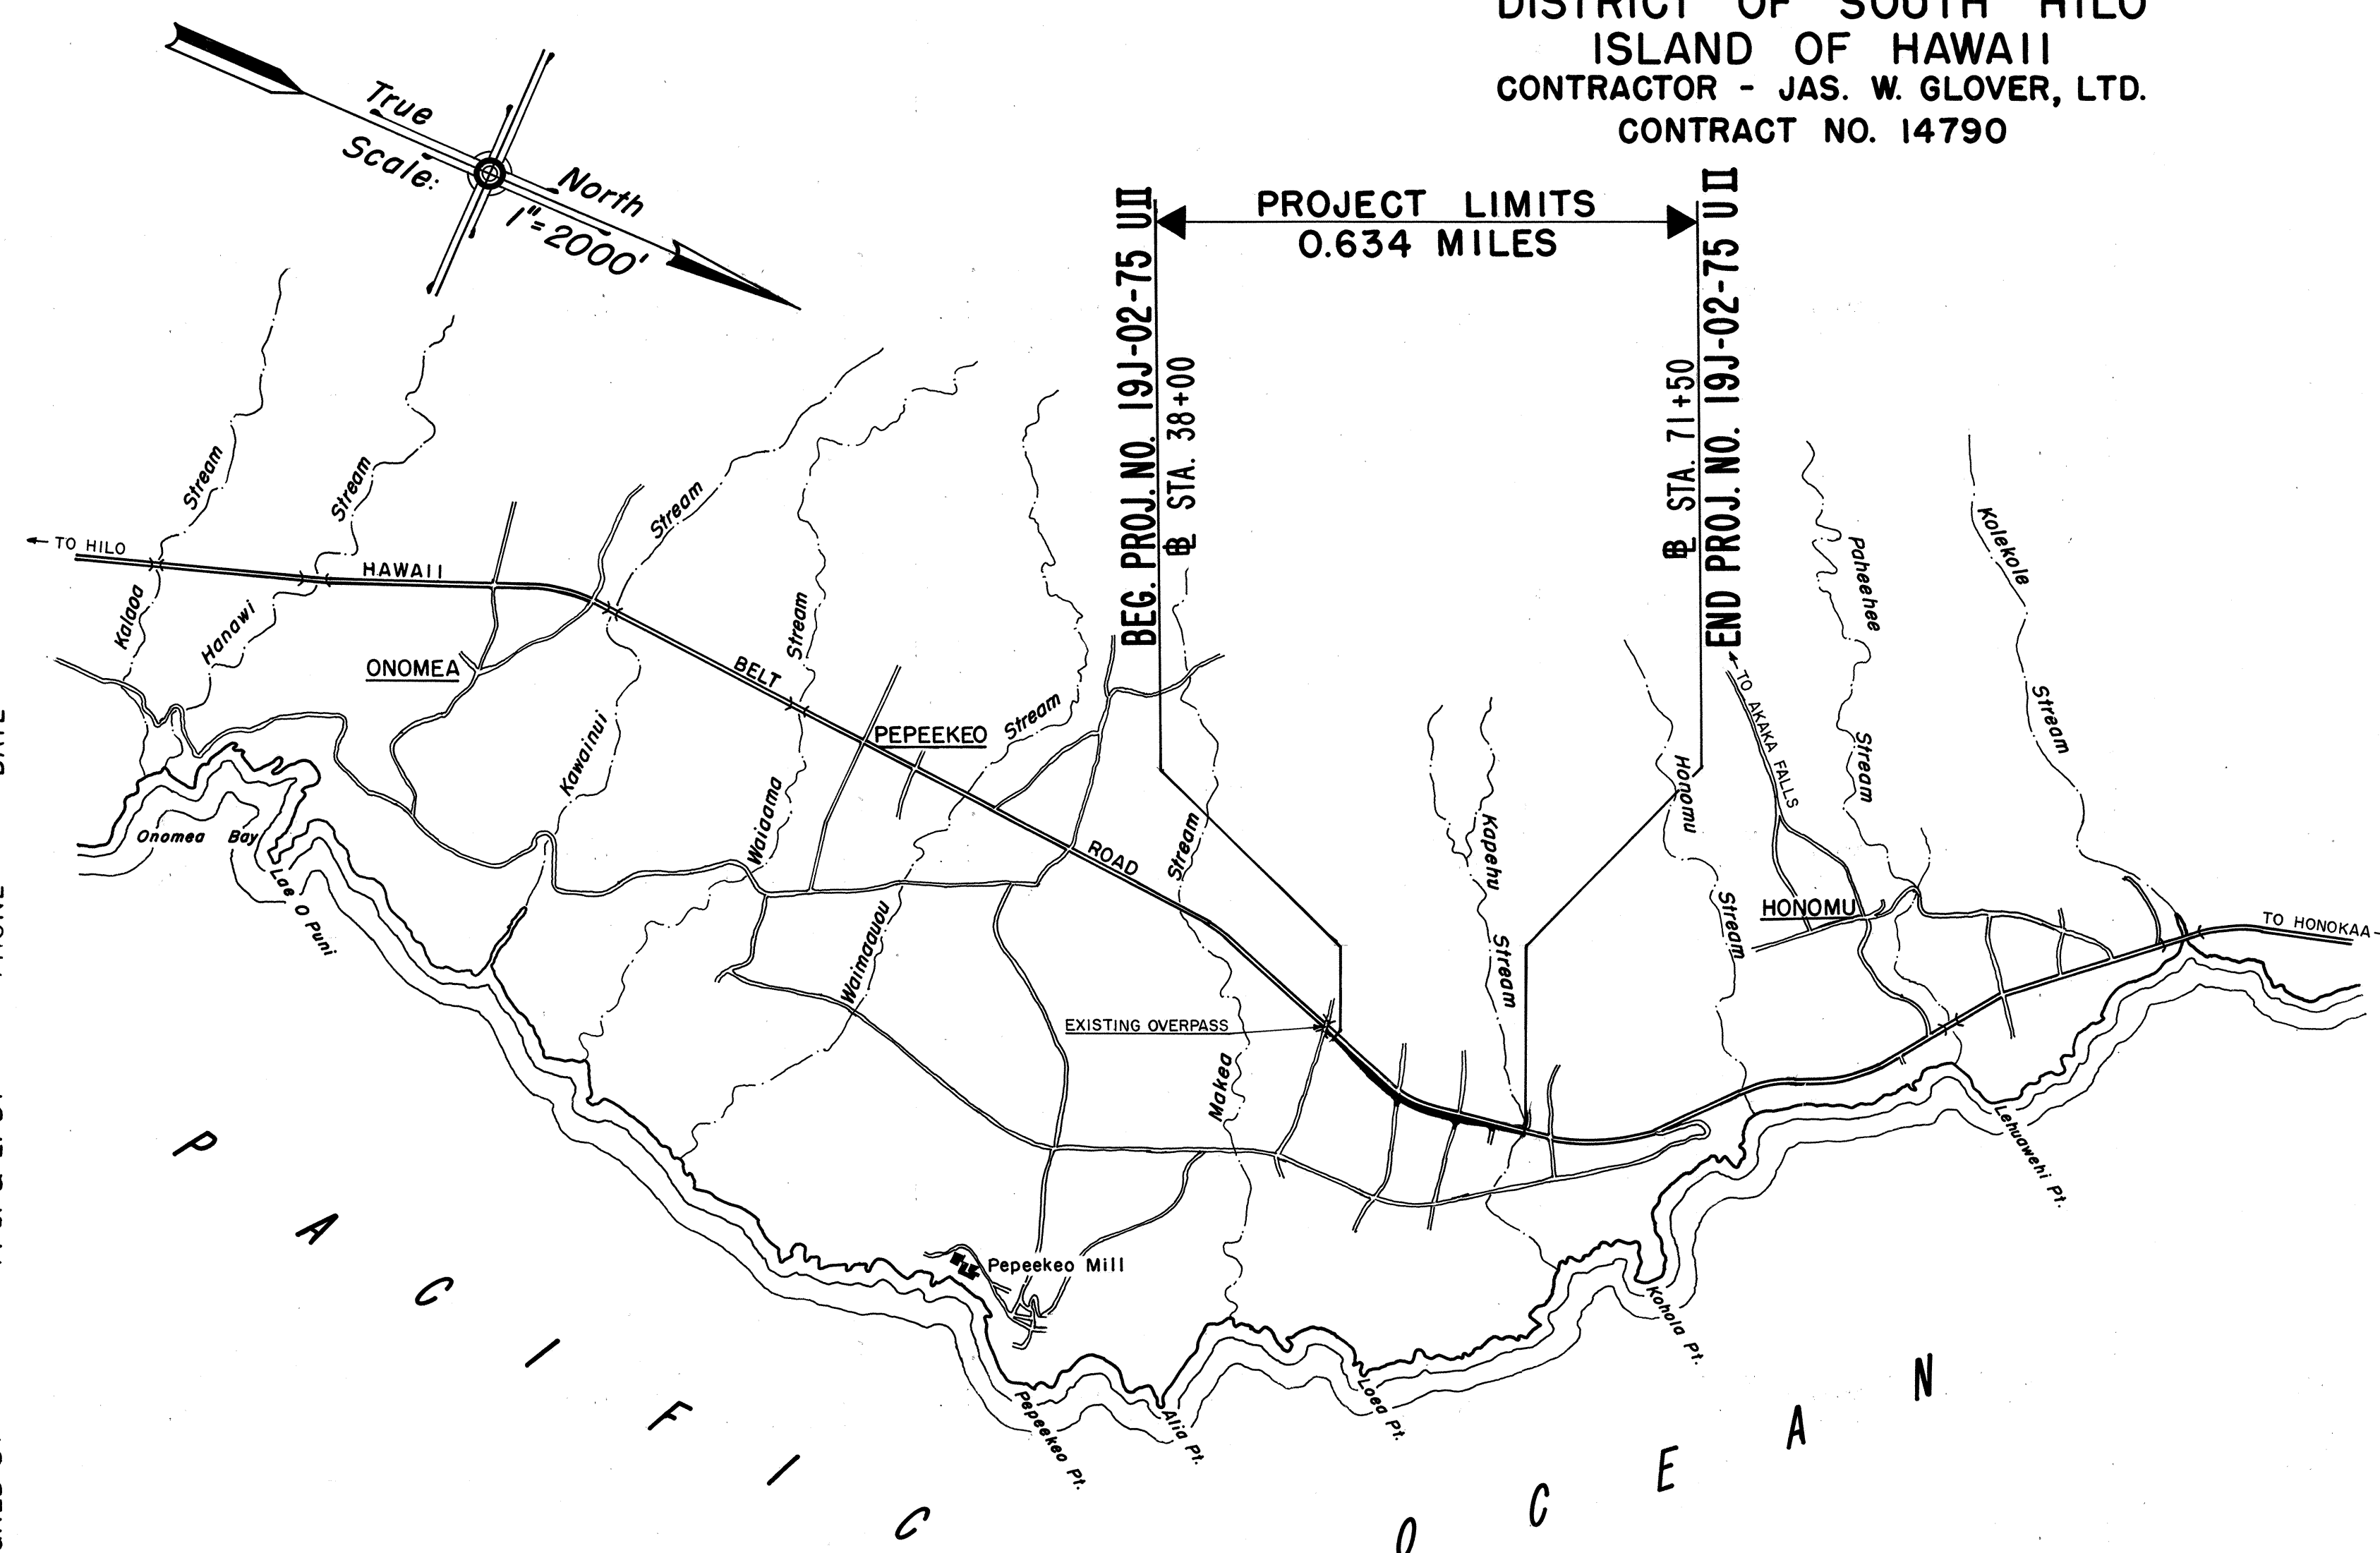
PLANS FOR
CONSTRUCTION OF

HAWAII BELT ROAD

TRUCK CLIMBING LANE AT PEPEEKEO
(Pepeekeo Truck Overpass To Kapehu Stream)

PROJ. NO. 19J-02-75, UNIT II

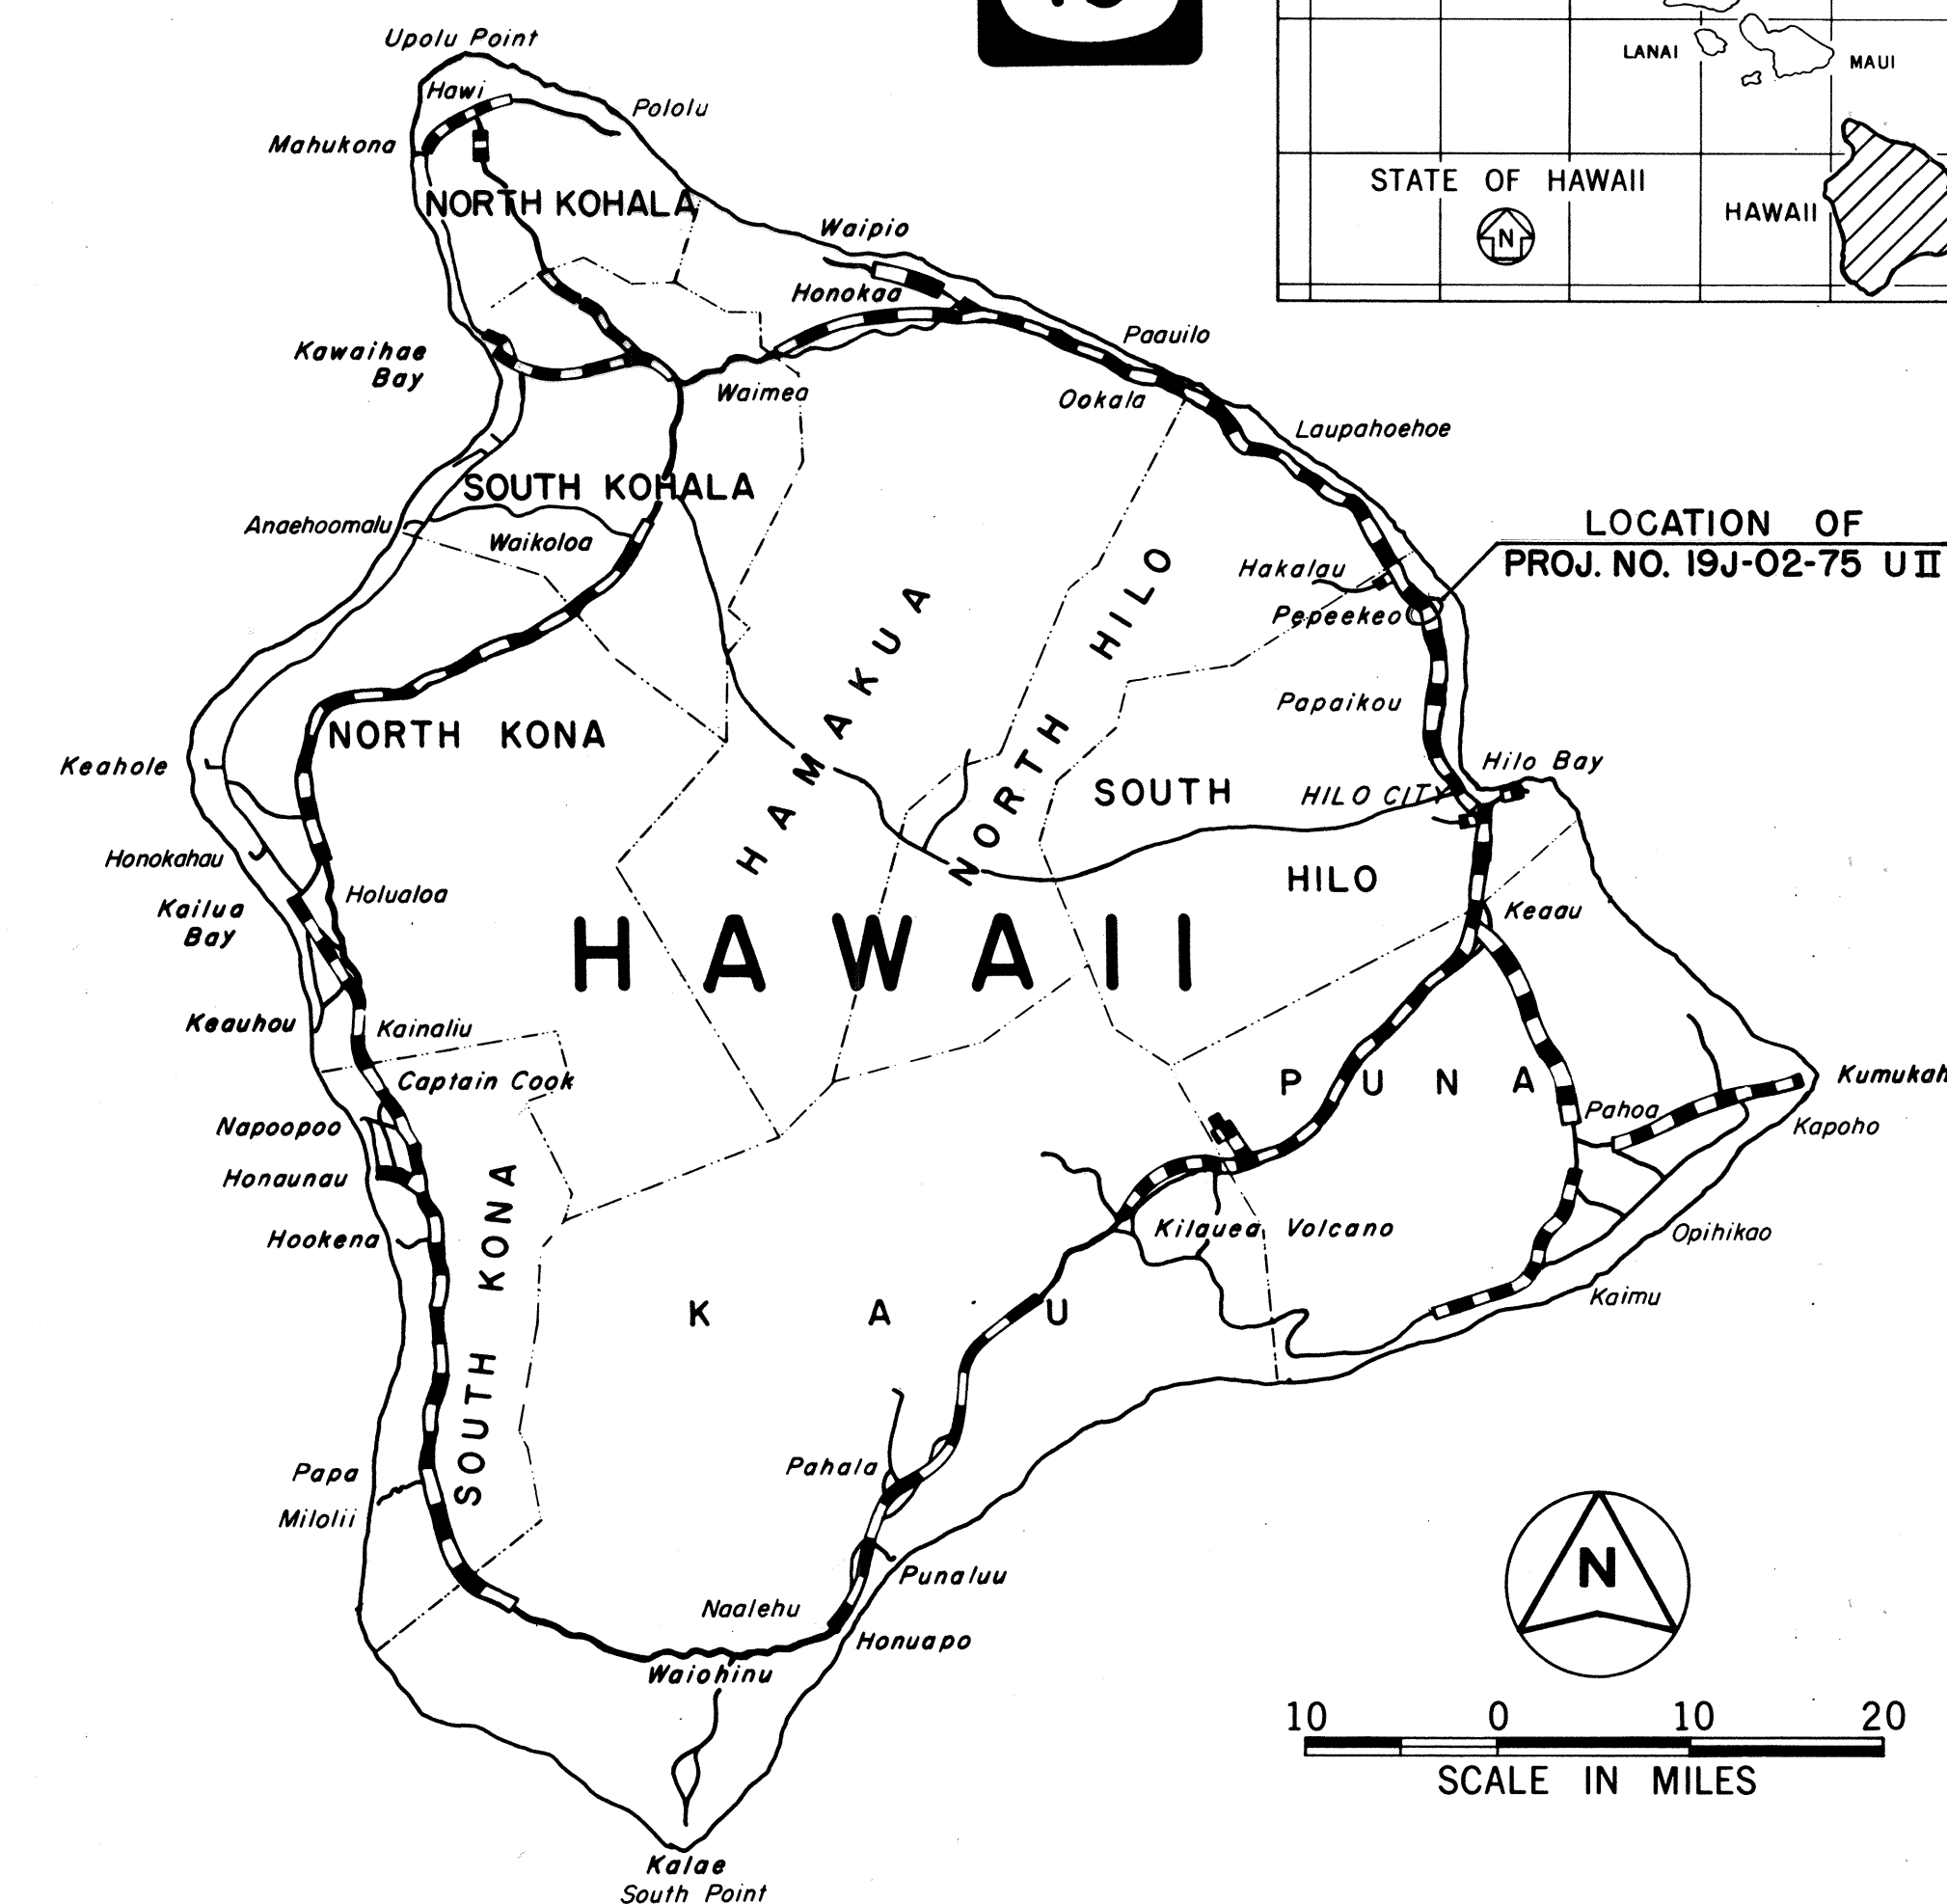
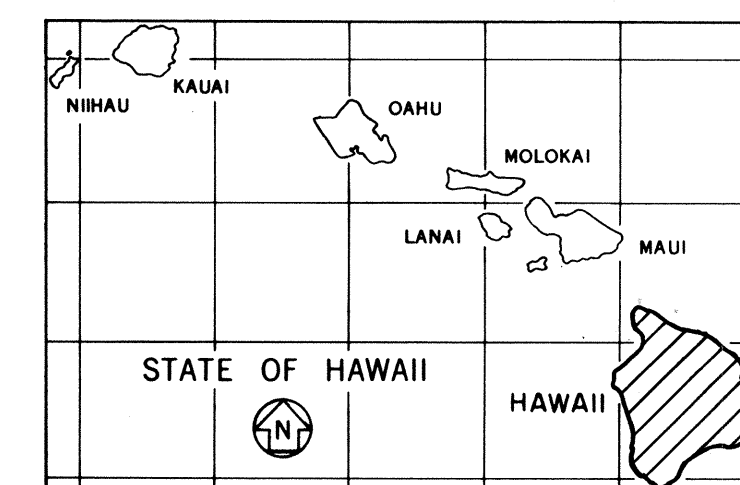
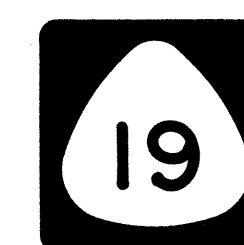
DISTRICT OF SOUTH HILO
ISLAND OF HAWAII
CONTRACTOR - JAS. W. GLOVER, LTD.
CONTRACT NO. 14790



LAYOUT OF PROJECT

SCALE: 1" = 2000'

FED. ROAD DIST. NO.	STATE	PROJ. NO.	FISCAL YEAR	SHEET NO.	TOTAL SHEET
HAWAII	HAW.	19J-02-75 UNIT II	1982	1	36

 FEDERAL AID PROJECTS PREVIOUSLY CONSTRUCTED OR UNDER CONSTRUCTION

ALL CHANGES MADE DURING CONSTRUCTION HAVE
BEEN INCORPORATED ON THESE PLANS IN RED
EXCEPT CHANGES IN THE ORIGINAL THEORETICAL
QUANTITIES. FOR ACTUAL QUANTITIES, REFER TO
PROJECT LEDGER AND/OR COMPUTATION BOOK.

Stanley Takemura
RESIDENT ENGINEER

5/23/83
DATE

DEPARTMENT OF TRANSPORTATION
STATE OF HAWAII

APPROVED:

James R. Carnas 5/26/81
DIR. OF TRANSPORTATION DATE