	INDEX TO DRAWINGS
SHEET NO.	DESCRIPTION
	TITLE SHEET
2	TYPICAL SECTIONS, ROADWAY
	PLAN & GENERAL NOTES
3	DRAINAGE DETAILS
4 - 5	STANDARD DETAILS



STATE OF

HAWAII

DEPARTMENT OF TRANSPORTATION

HIGHWAYS DIVISION "AS-BUILT" PLANS FOR

CONSTRUCTION OF


HAWAII BELT ROAD

DRAINAGE IMPROVEMENTS AT KULAIMANO ROAD


PROJECT NO. 19J-01-82

DISTRICT OF SOUTH HILO ISLAND OF HAWAII

Contractor: Isemoto Contracting Co., Ltd. Contract No: 14797

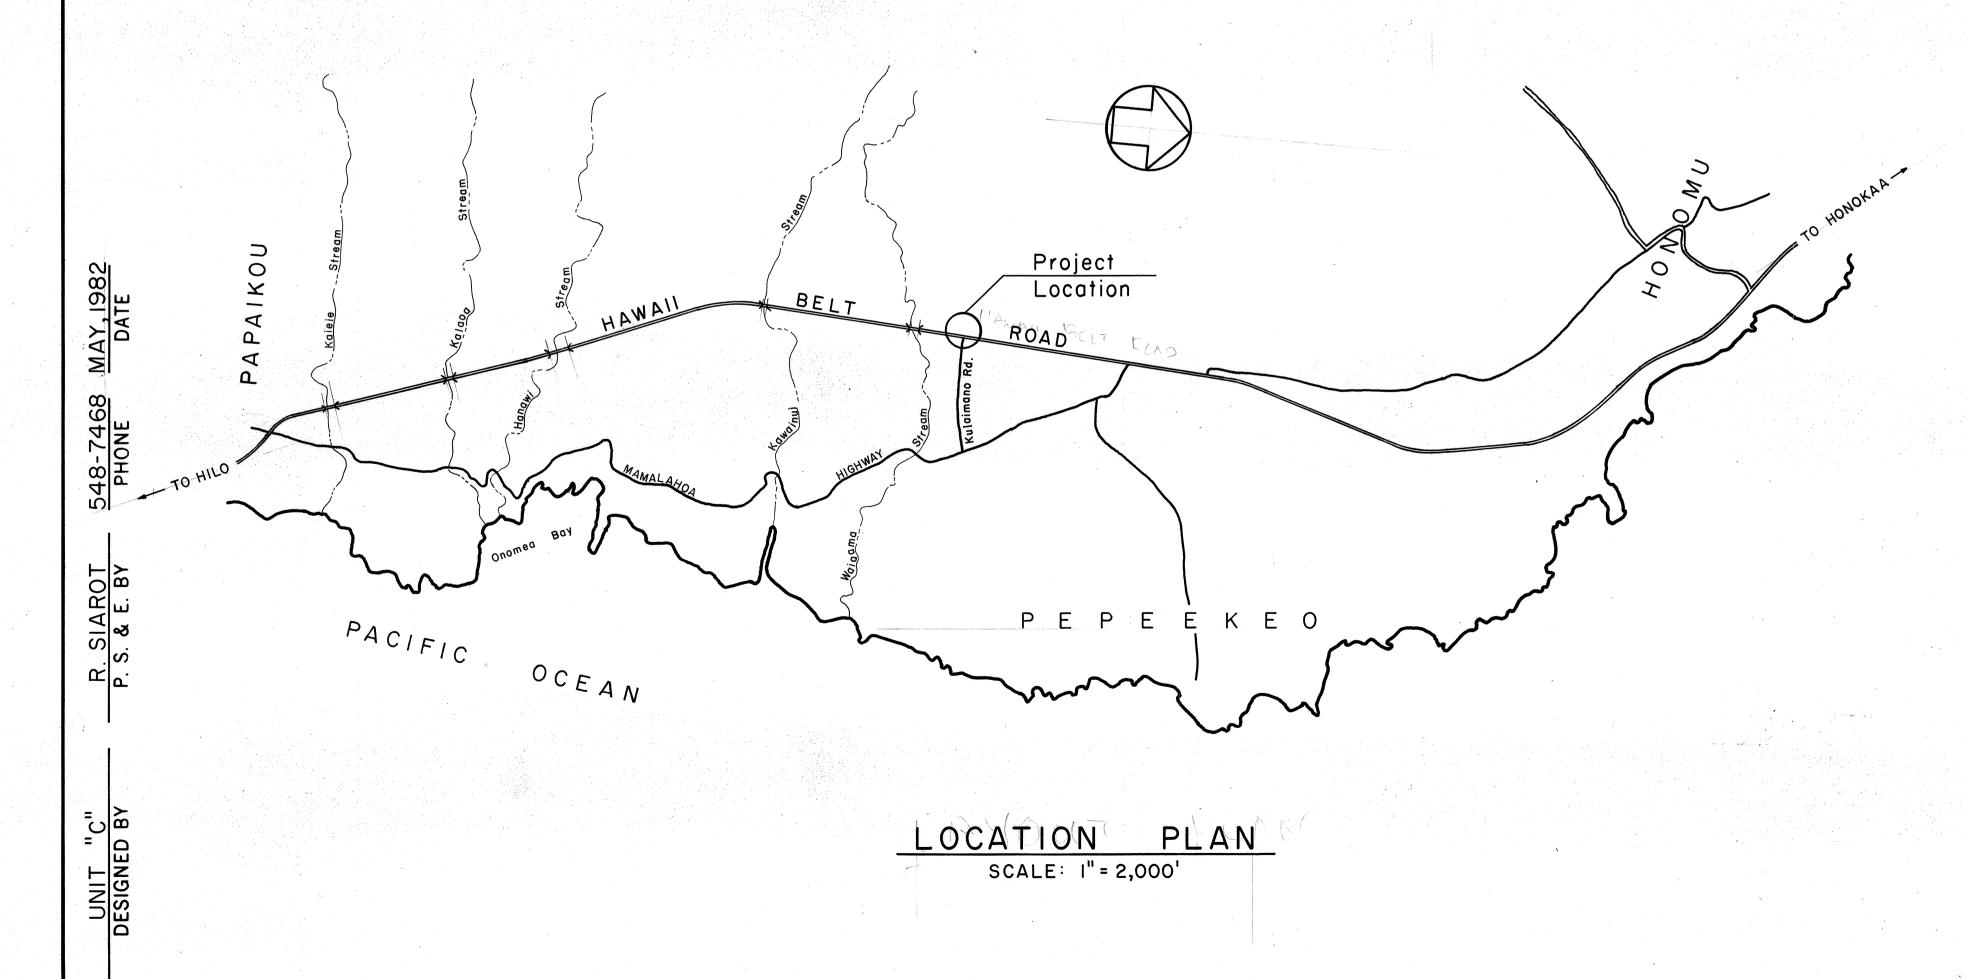

FISCAL SHEET TOTAL YEAR NO. SHEETS FED. ROAD DIST. NO. STATE PROJ. NO. 19J-01-82 1982

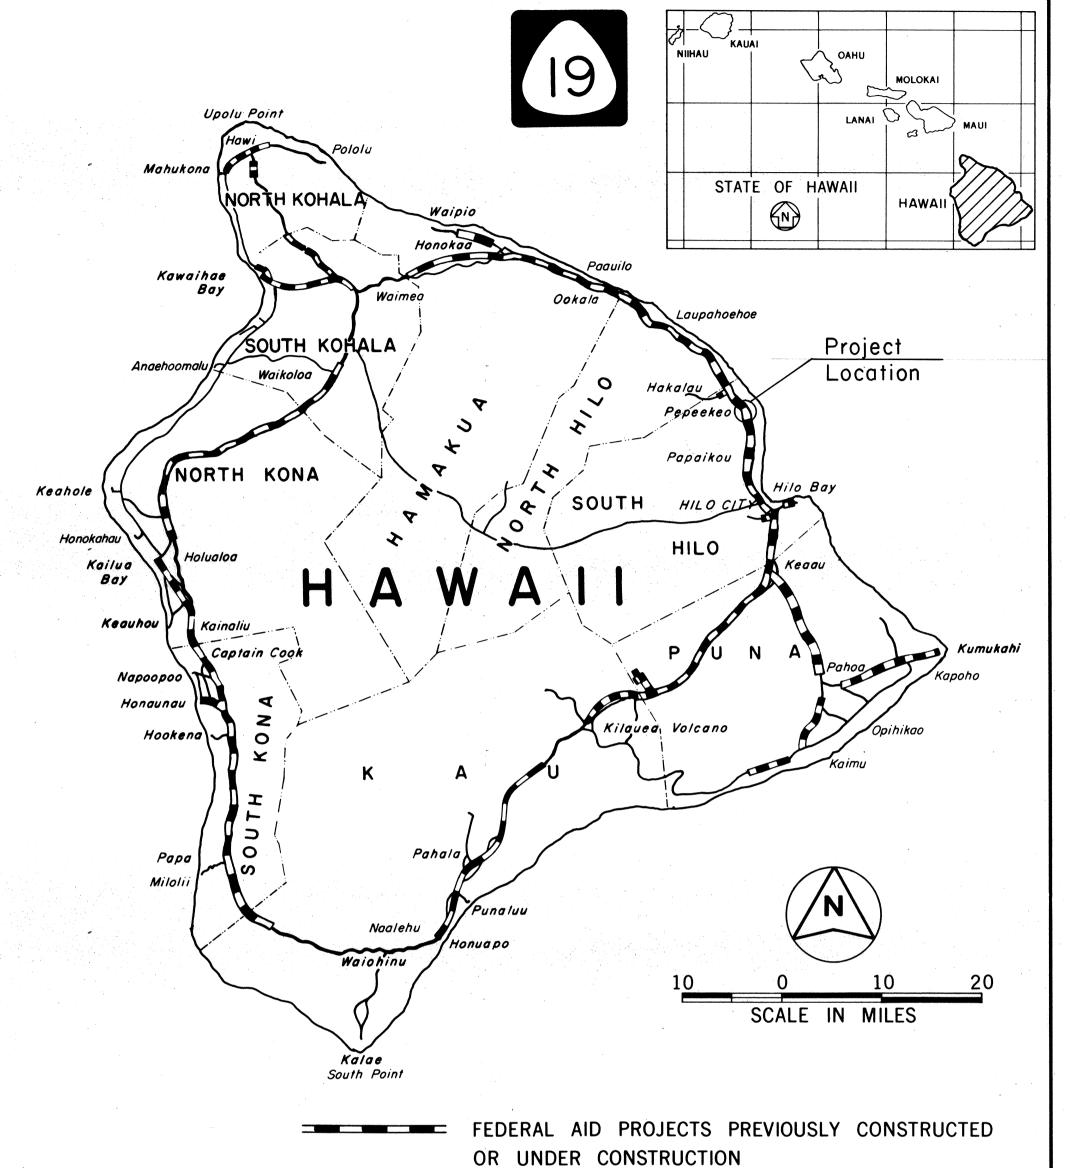

ALL CHANGES MADE DURING CONSTRUCTION HAVE BEEN INCORPORATED ON THESE PLANS IN RED

EXCEPT CHANGES IN THE ORIGINAL THEORETICAL QUANTITIES. FOR ACTUAL QUANTITIES, REFER TO PROJECT LEDGER AND/OR COMPUTATION BOOK.

Benge Krdani RESIDENT ENGINEER

5-13-83 DATE

DEPARTMENT OF TRANSPORTATION STATE OF HAWAII ames R. Carros 5/26/82