


FED. ROAD DIST. NO.	STATE	FED. AID PROJ. NO.	FISCAL YEAR	SHEET NO.	TOTAL SHEETS
HAWAII	HAW.	19J-01-82	1982	2	5

GENERAL NOTES


- The Project is located at the Hawaii Belt Road and Kuaimano Road intersection. Improvements consist of extending the 4x3' Reinforced Concrete Box Culvert, constructing a CRP-GRP Drainage Outlet, grading, paving, Relocating an Existing Sign and Striping (State Forces).
- The Contractor shall notify the Department of Water Supply, County of Hawaii, at least 5 working days prior to commencing work to verify the locations of water lines within the work area.
- The Contractor shall keep all existing lanes open to public traffic during non-work hours and for the following peak traffic hours:
Morning peak hours, 6:00 a.m. to 8:30 a.m.,
Afternoon peak hours, 3:30 p.m. to 6:00 p.m.
The peak hours are subject to change by the Engineer. Change of peak hours shall be made in writing.

STRIPING DETAIL

Scale: 1"=10'

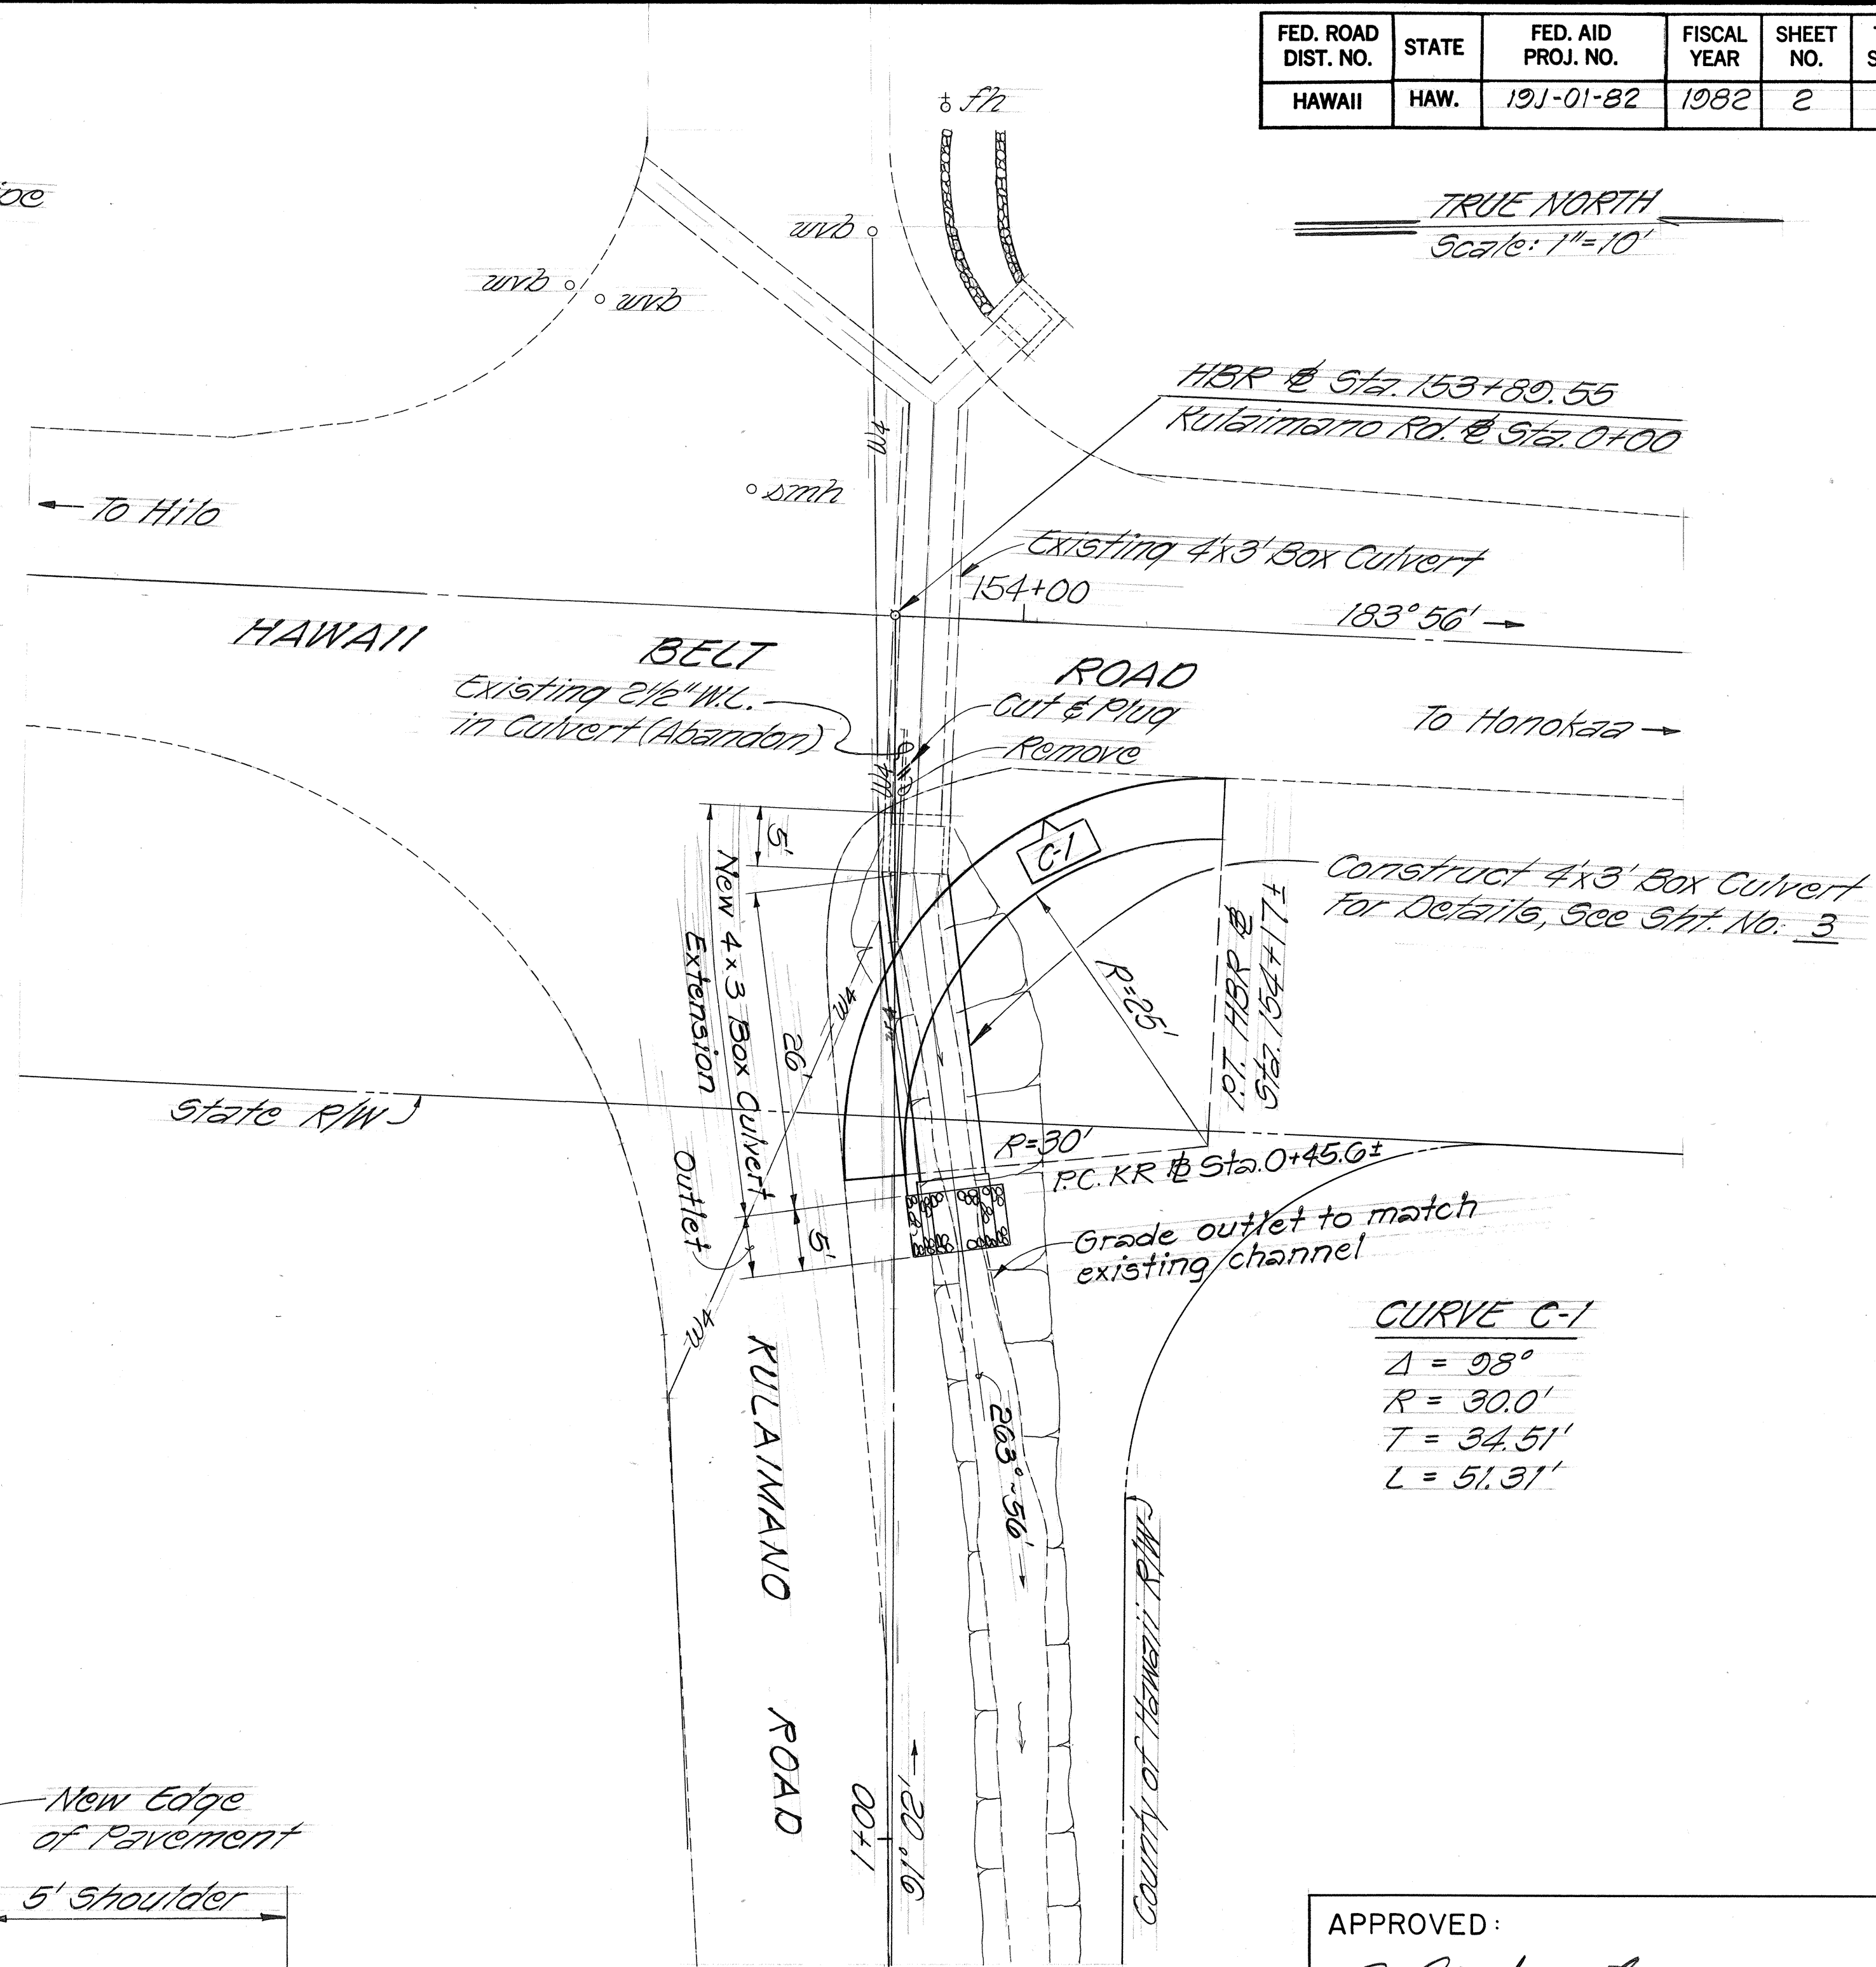


CURVE C-1
 $\Delta = 98^\circ$
 $R = 30.0'$
 $T = 34.51'$
 $L = 51.31'$

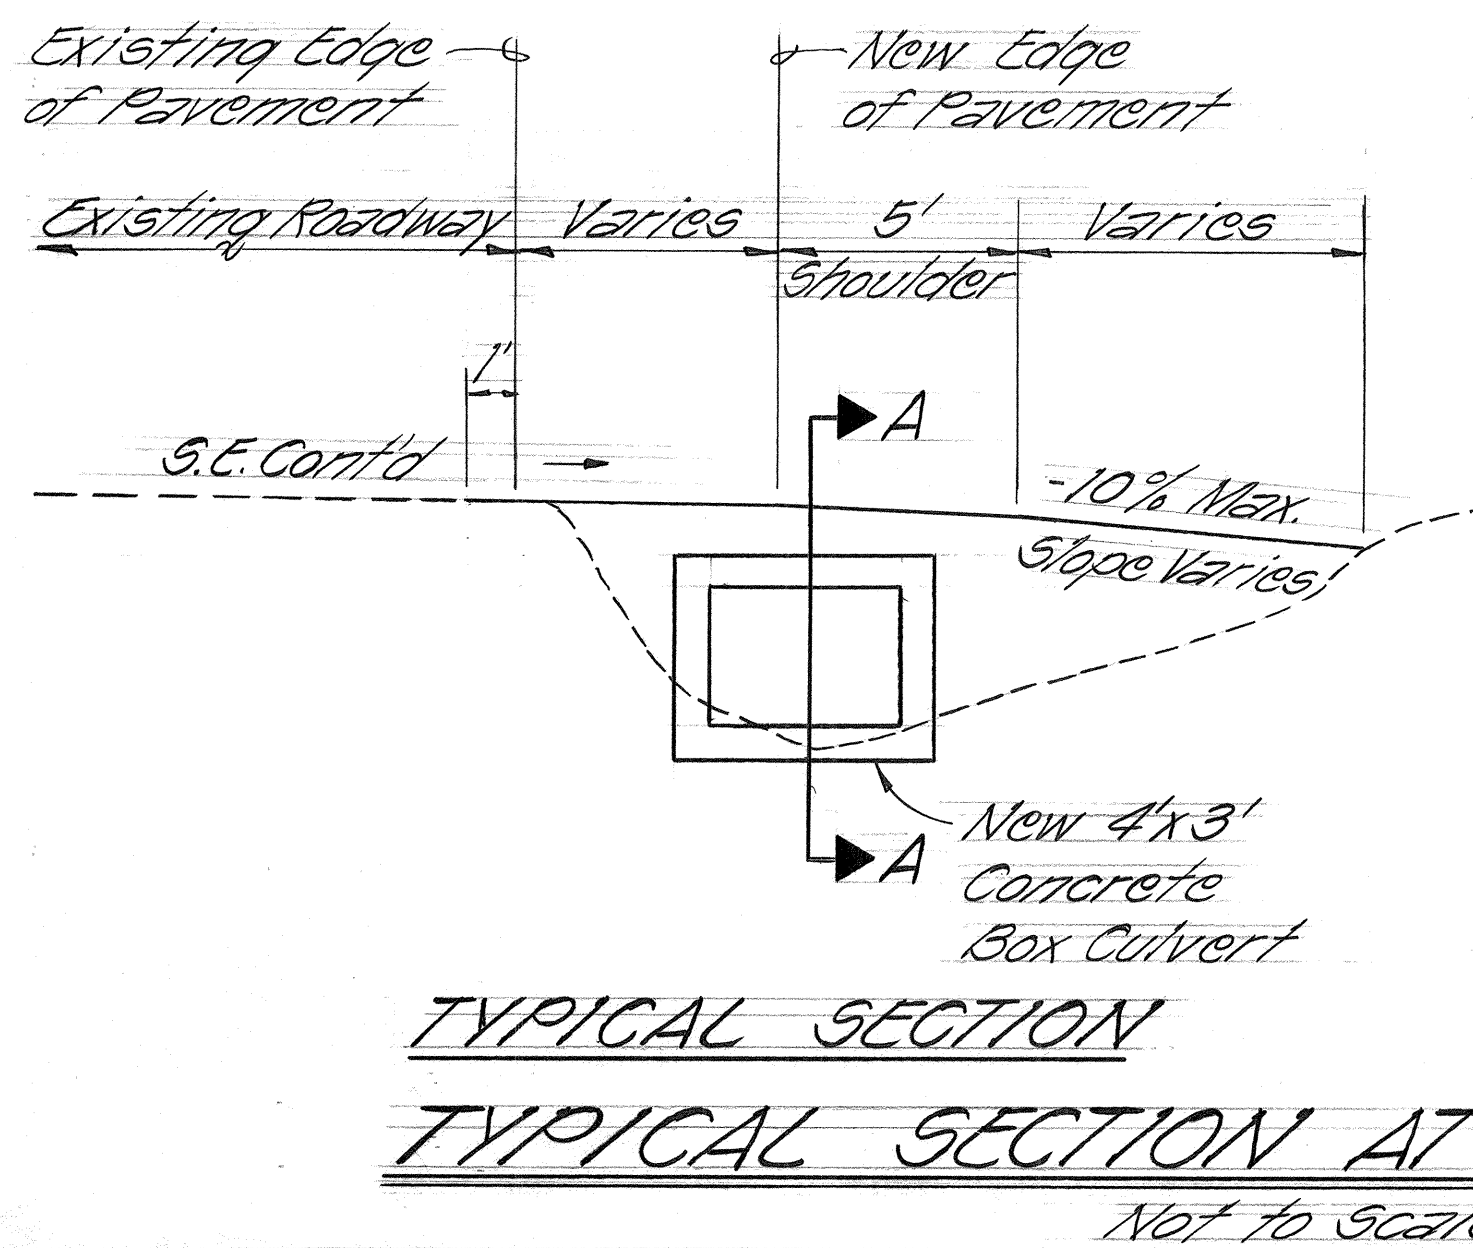

TYPICAL SECTION

TYPICAL SECTION AT BOX CULVERT
Not to Scale

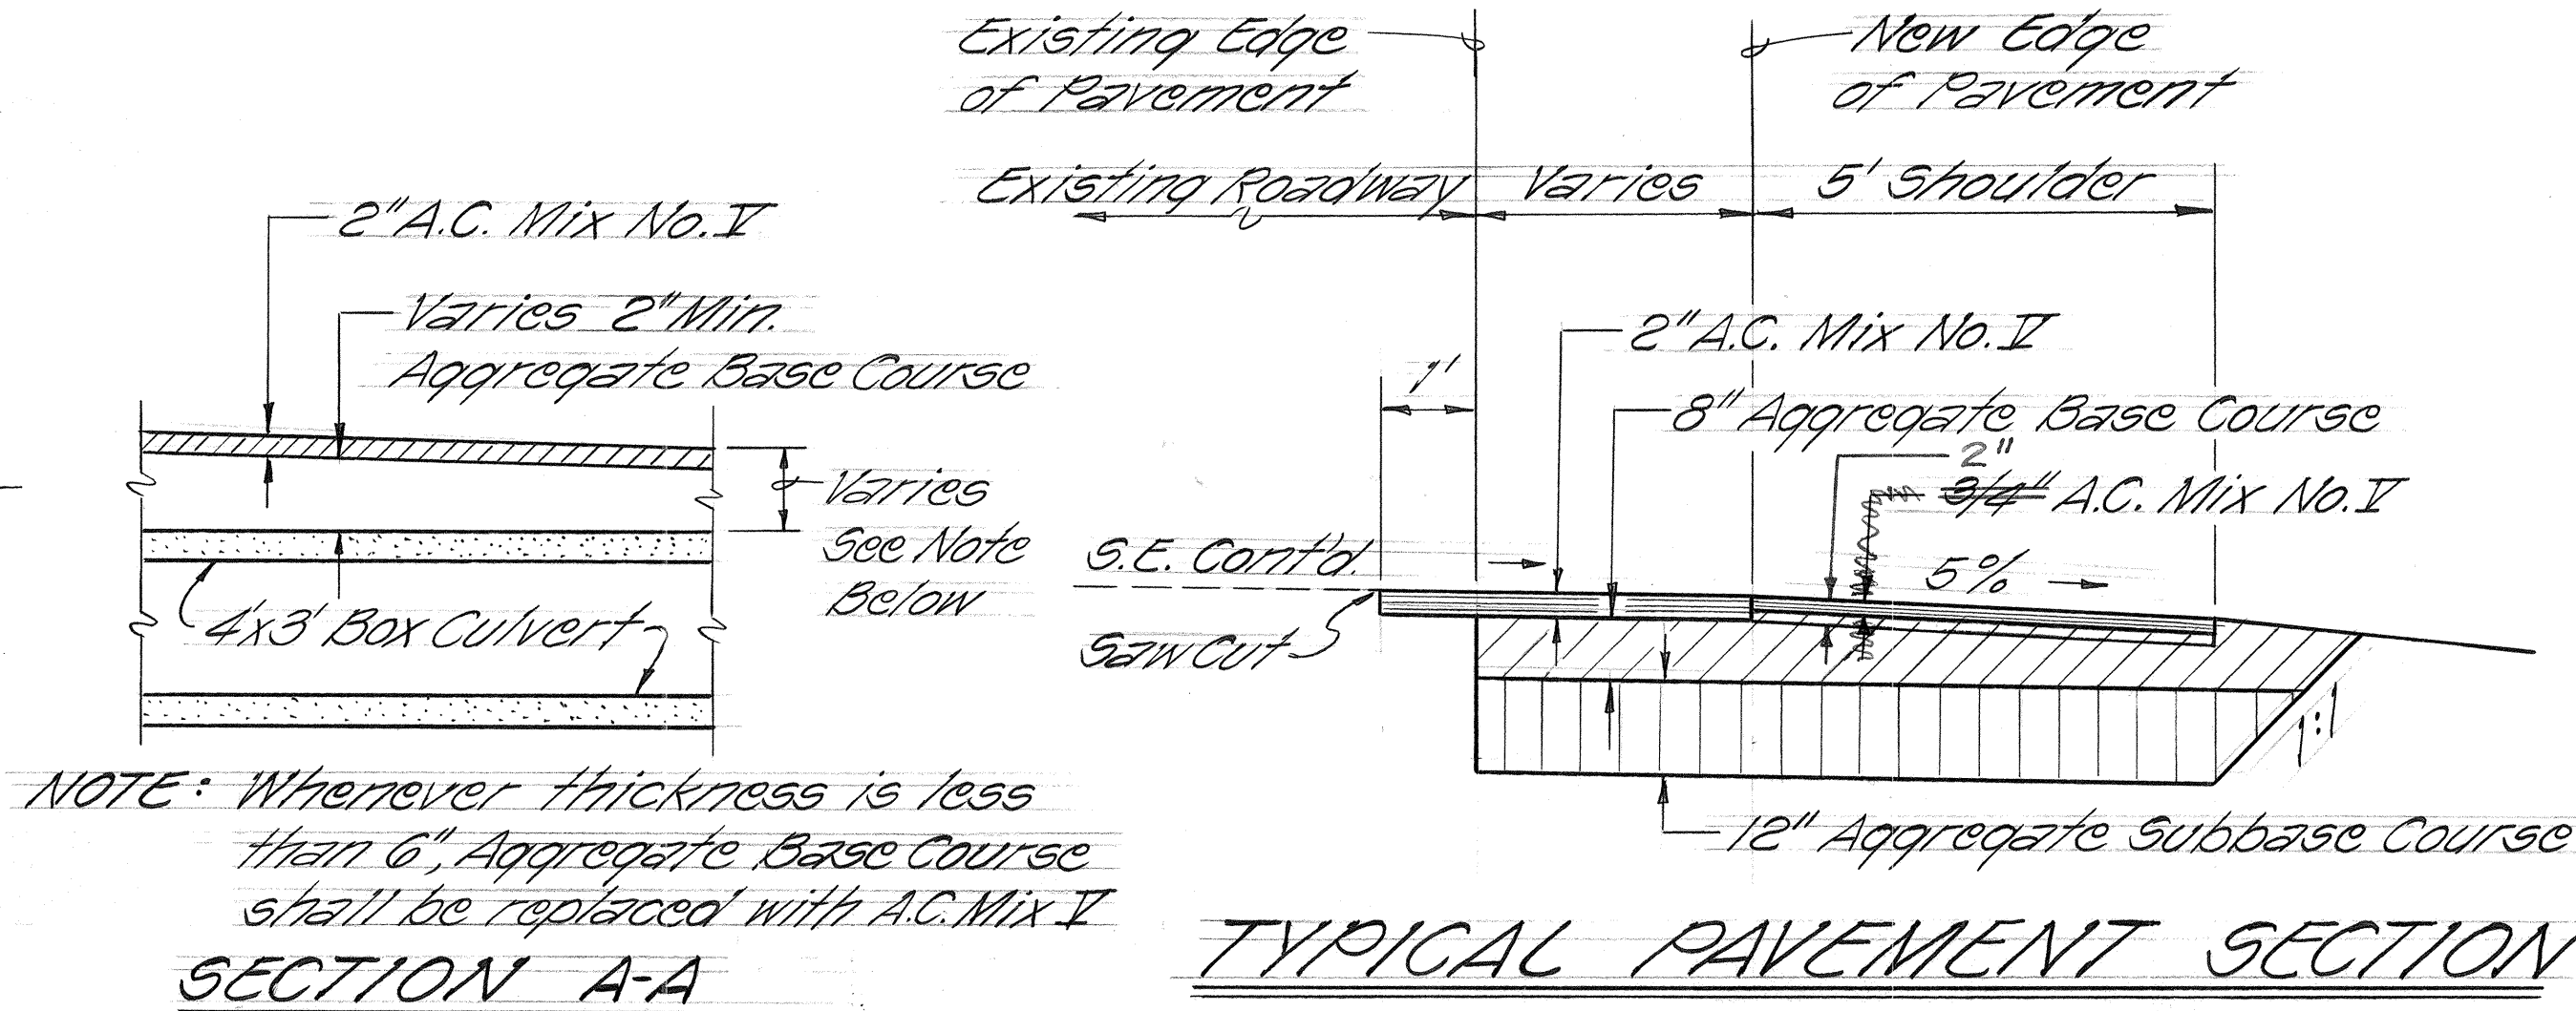

TYPICAL PAVEMENT SECTION
Not to Scale

APPROVED:
Arthur J. Leggett 5-14-82
Chief Engineer, D.P.W., County of Hawaii Date
APPROVAL GIVEN FOR WORK WITHIN COUNTY OF HAWAII RIGHT-OF-WAY ONLY

STATE OF HAWAII
DEPARTMENT OF TRANSPORTATION
HIGHWAYS DIVISION
TYPICAL SECTIONS
ROADWAY PLAN & NOTES
HAWAII BELT ROAD
Drainage Improvements at Kuaimano Rd.
PROJECT NO. 19J-01-82
Scale as Shown Date: Feb. 1982
SHEET NO. OF SHEETS