





FED. ROAD DIST. NO.	STATE	PROJ. NO.	FISCAL YEAR	SHEET NO.	TOTAL SHEETS
HAWAII	HAW.	19J-02-82	1982	2	3

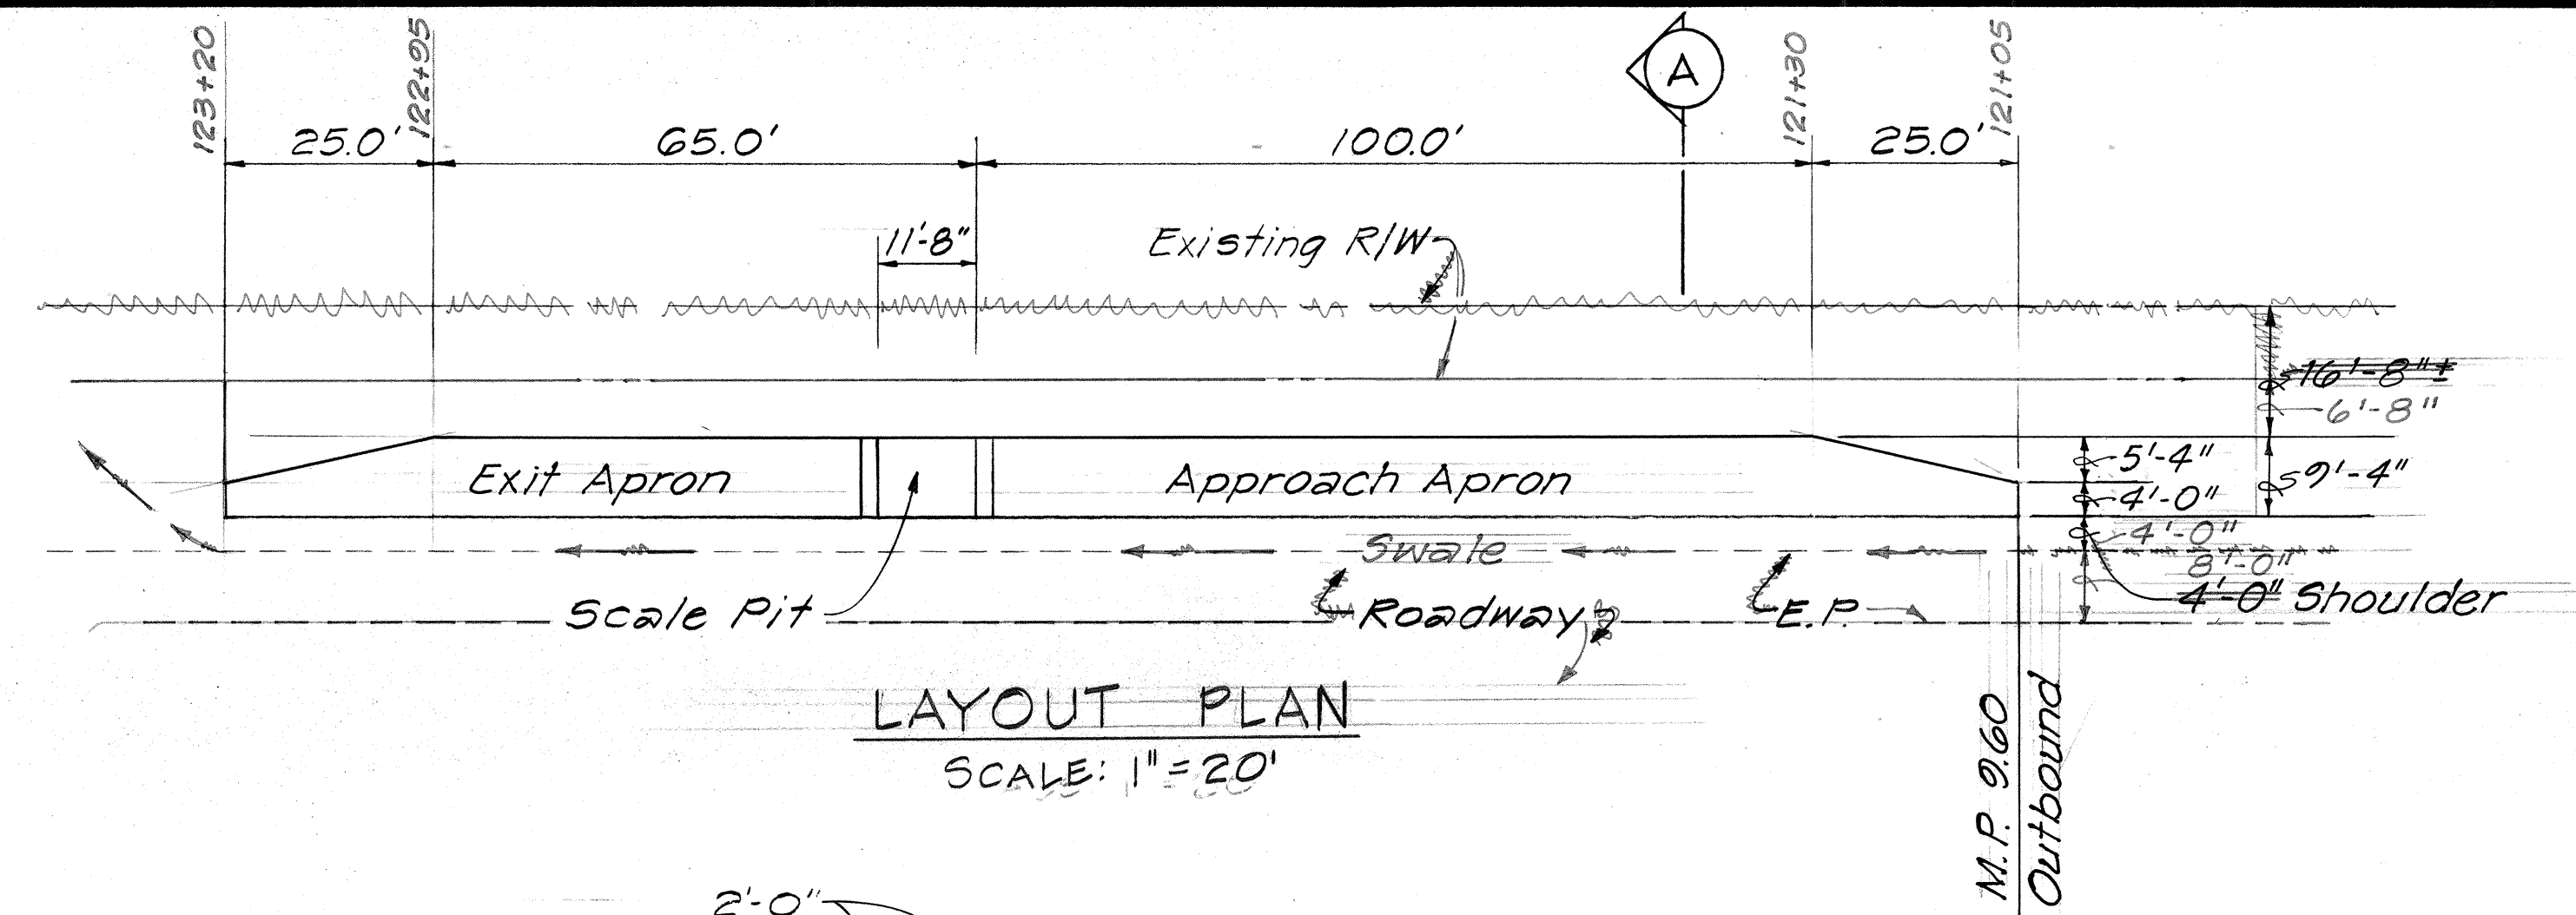

VEHICLE SIZE AND WEIGHT ENFORCEMENT STATION

GENERAL NOTES:

- The project site is located on Hawaii Belt Road at Pepeekeo, Milepost 9.60, Outbound. Improvements consist of grading the shoulder, constructing base course, paving, and constructing a reinforced concrete pad.
- The exact location of the vehicle size and weight enforcement station shall be determined by the Engineer.
- The Contractor shall keep at least one lane open to traffic in any direction during his working hours, and all lanes open to traffic during his non-working hours as specified in the Special Provisions.

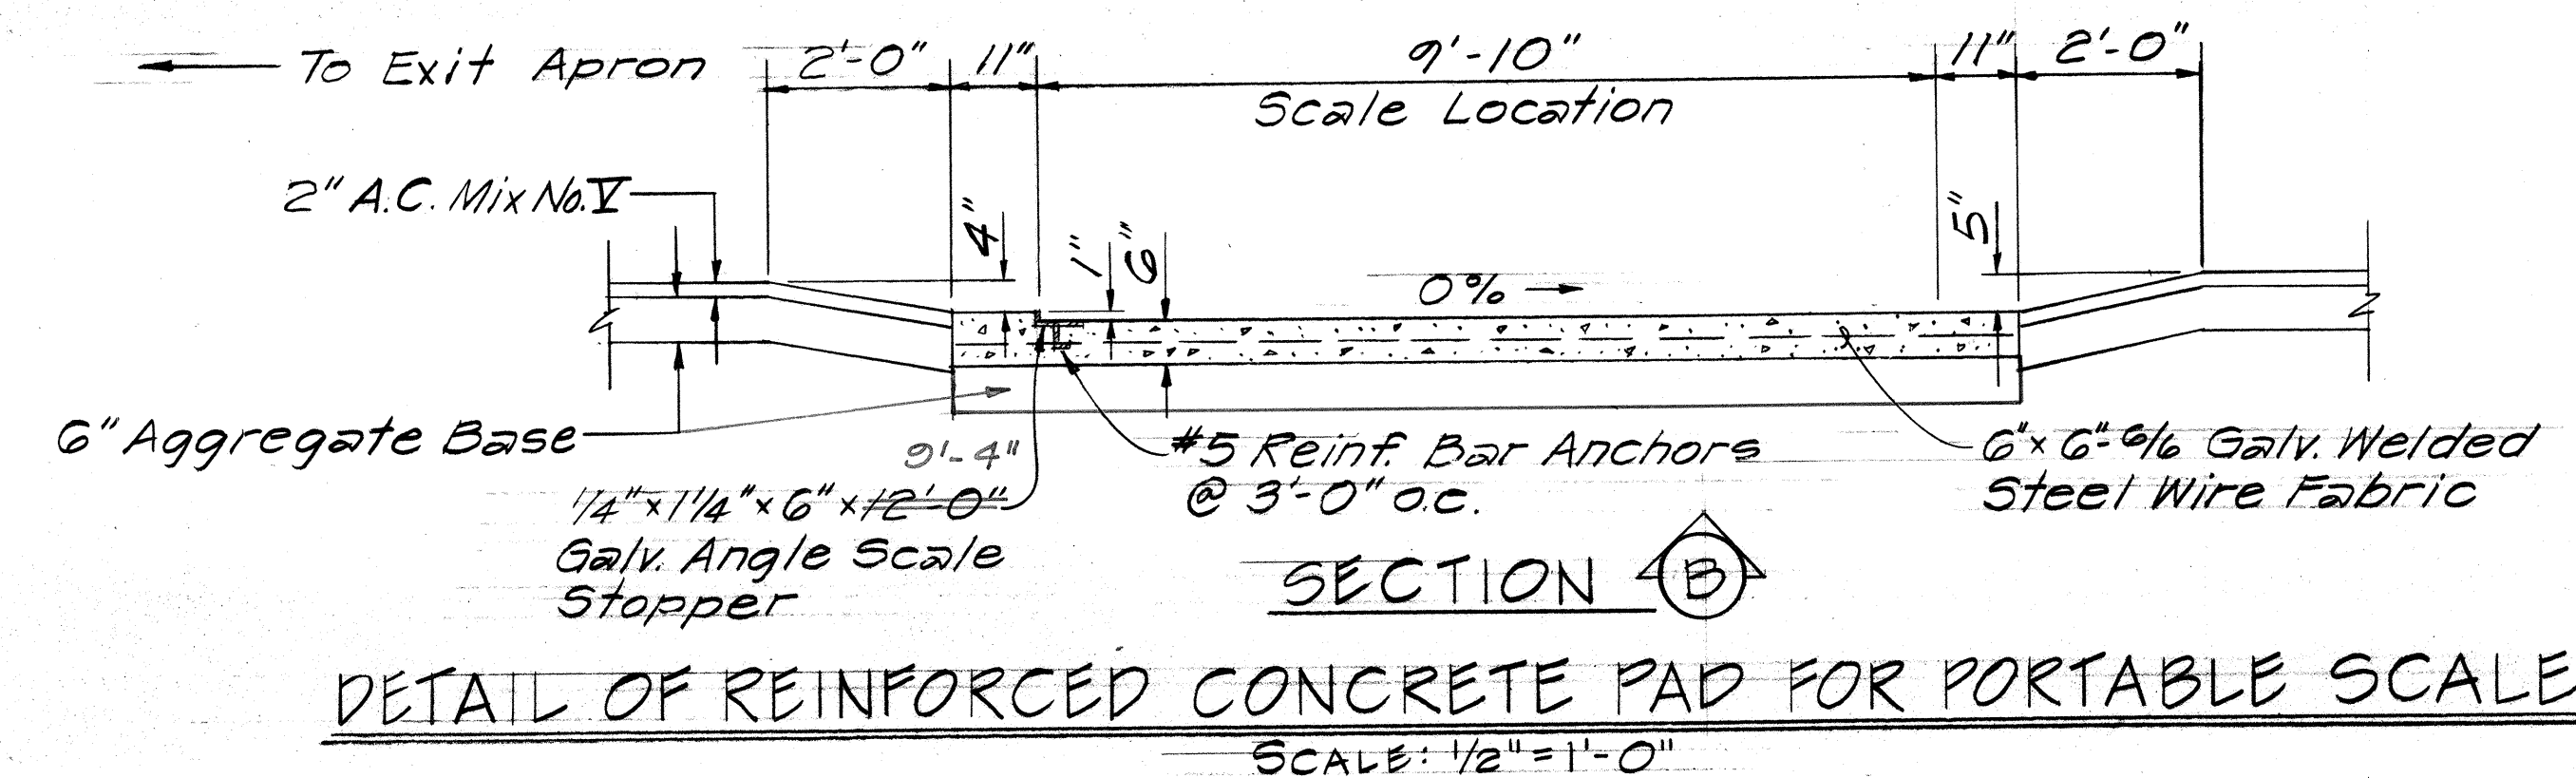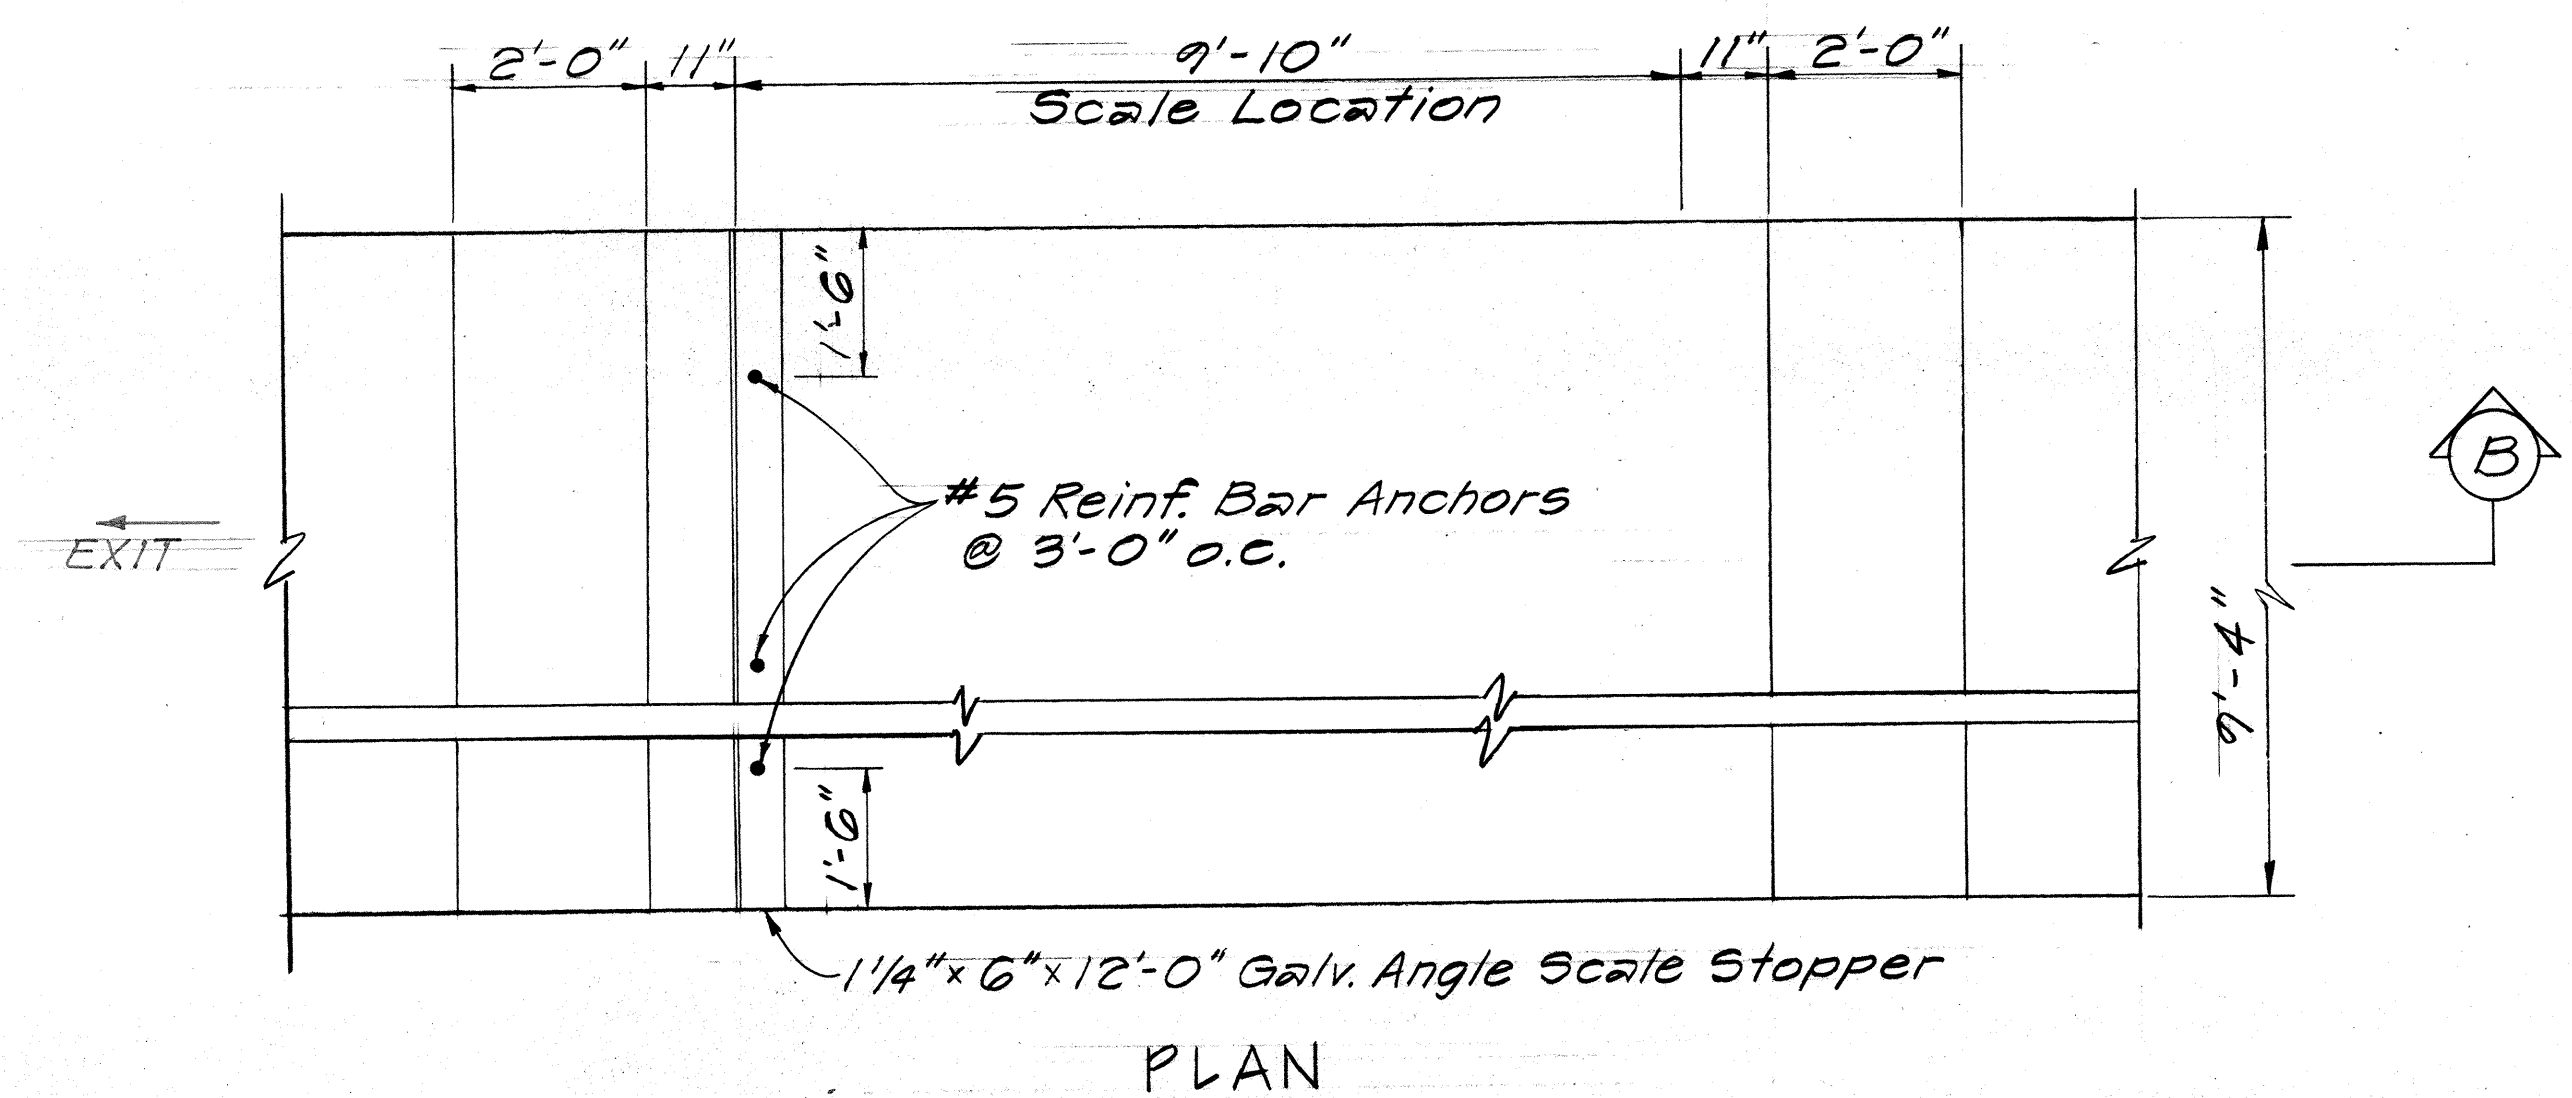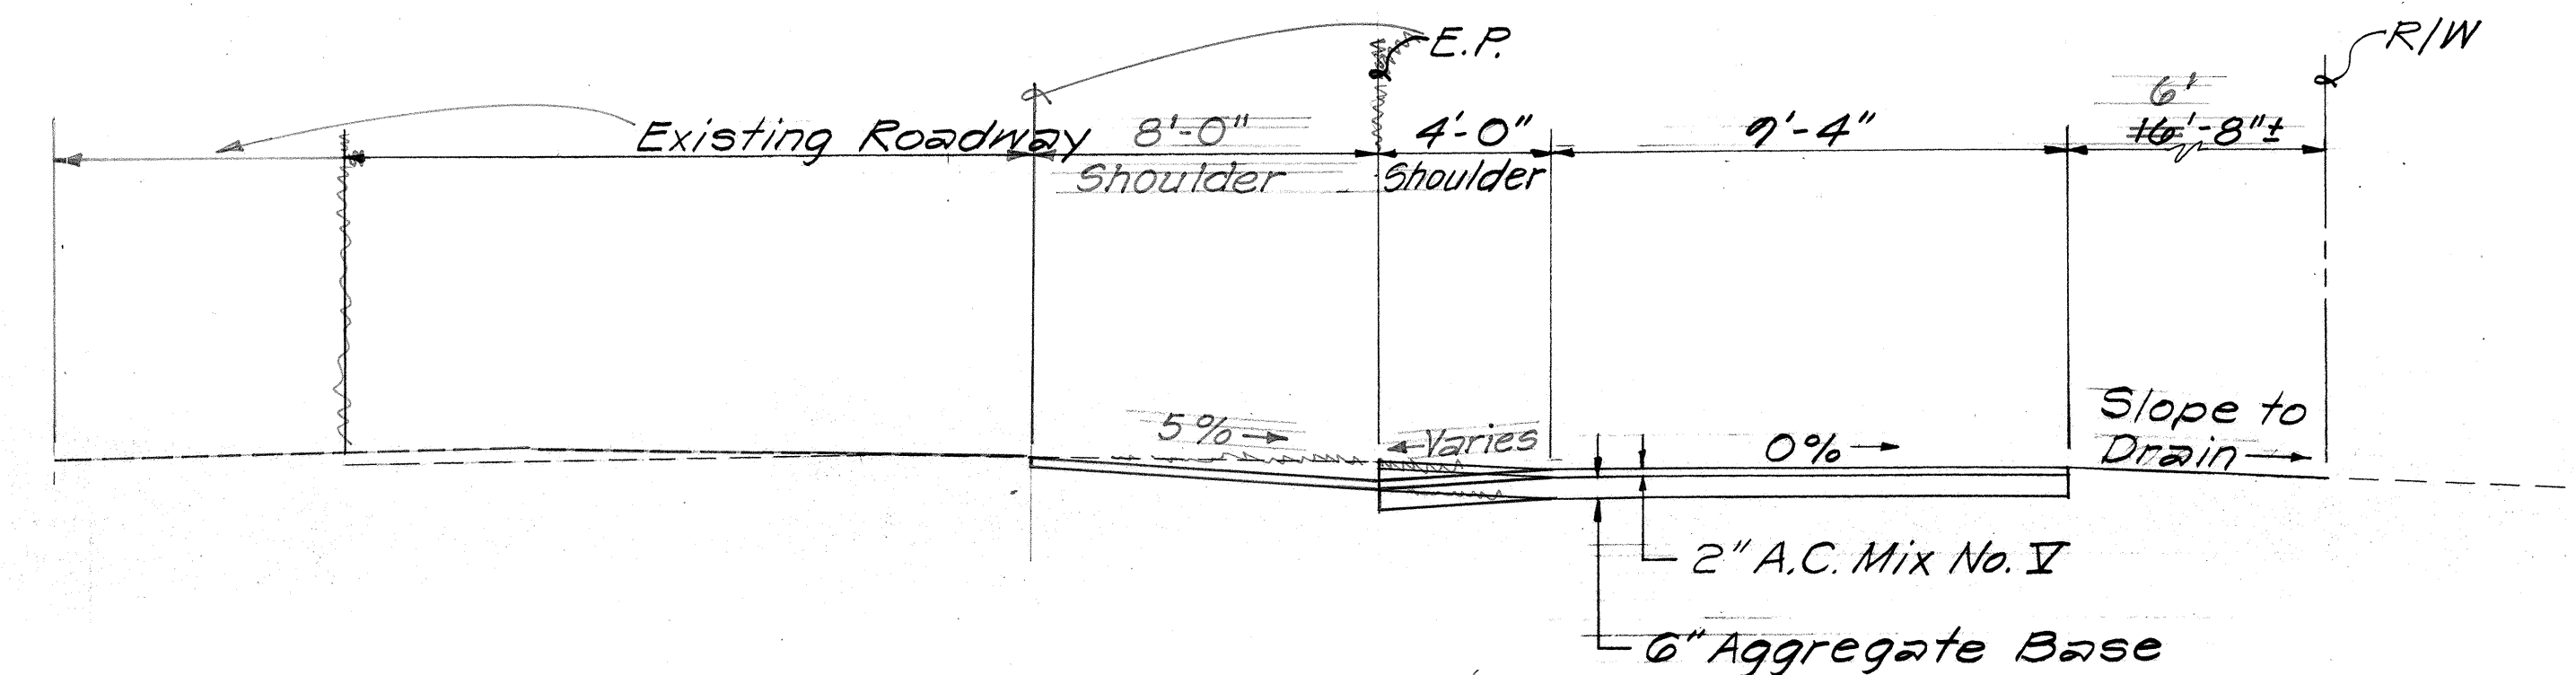

ESTIMATED QUANTITIES	
DESCRIPTION	QUANTITY
Aggregate Base Course	52.0 50.0 C.Y.
Asphalt Concrete Pavement, Mix No. V	33.0 Tons
55-1 Emulsified Asphalt for Bituminous Tack Coat	44.0 Gals.
Reinforced Concrete Pad	2.1 C.Y.
Excavation	68.0 66.0 C.Y.

STATE OF HAWAII DEPARTMENT OF TRANSPORTATION LAND TRANSPORTATION FACILITIES DIVISION	
LAYOUT PLAN & SCALE PAD DETAIL	
VEHICLE SIZE & WEIGHT ENFORCEMENT STATION AT PEPEKEO	
Proj. No. 19J-02-82	
Scale: As Shown	Date: May, 1982
SHEET NO. 1 OF 1 SHEETS	