	INDEX TO DRAWINGS
SHEET NO.	DESCRIPTION
l ·	TITLE SHEET
. 2	PLAN
3	TYPICAL SECTIONS AND DETAILS
and the construction of th	PAVEMENT & SHOULDER RECONSTR. DETAILS AND SCHEDULE
5-8	STANDARD DETAILS
	Spr. y
·	



STATE OF HAWAII

DEPARTMENT OF TRANSPORTATION

HIGHWAYS DIVISION


"AS - BUILT" PLANS FOR

HAWAII BELT ROAD RESURFACING NINOLE STREAM BRIDGE TO HAKALAU

PROJECT NO. F-FR-019-2(21)

DISTRICT OF NORTH HILO ISLAND OF HAWAII

CONTRACTOR: Yamada & Sons, Inc. CONTRACT NO. 16029

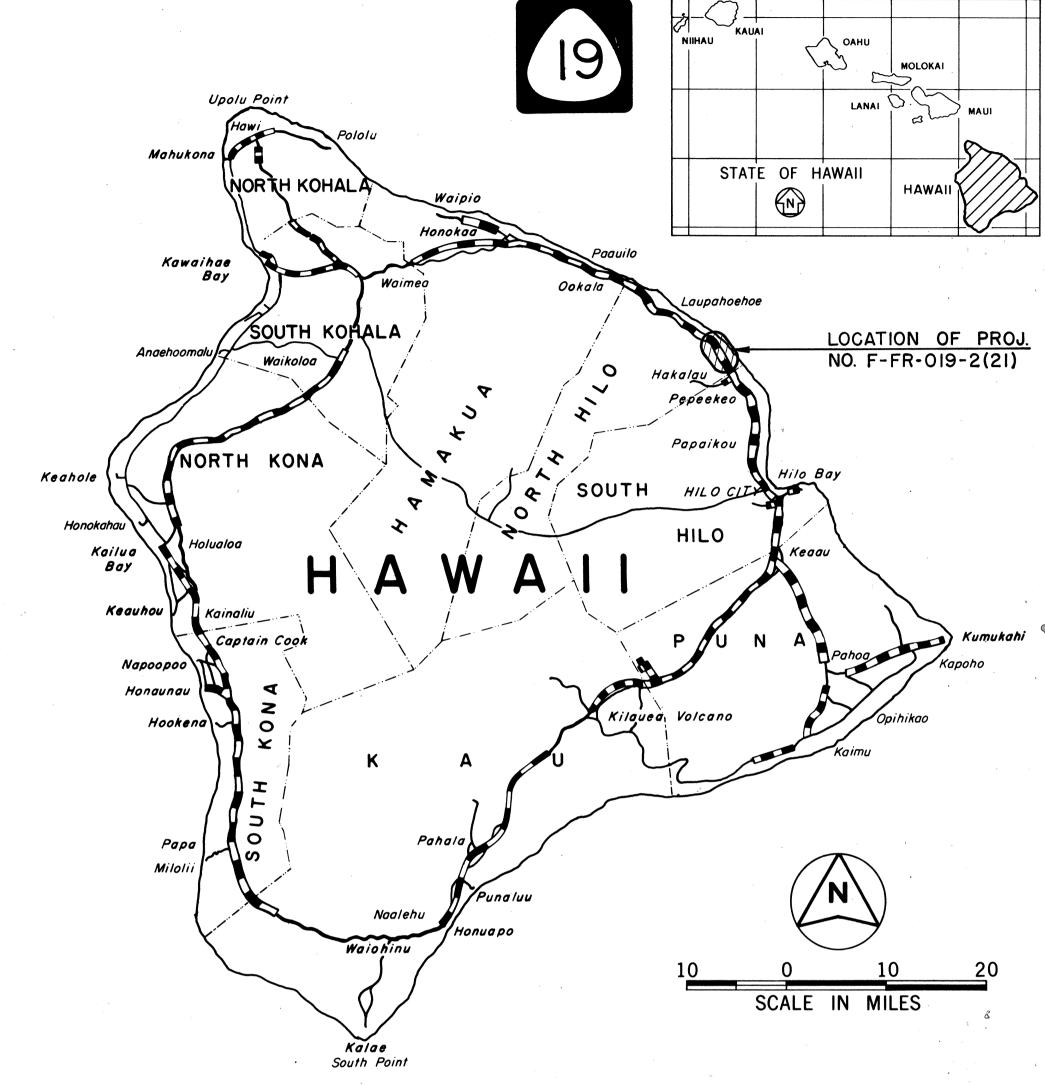

FED. ROAD DIST. NO.

FED. AID PROJ. NO.

F-FR-019-2(21) 1983

CHANGES MADE DURING CONSTRUCTION HAVE BEEN INCORPORATED ON THESE PLANS EXCEPT CHANGES IN THE ORIGINAL THEORETICAL QUANTITIES. FOR ACTUAL QUANTITIES, REFER TO PROJECT LEDGER AND/OR COMPUTATION BOOK.

berge Godani

01-30-84

PROJECT DESCRIPTION

This project begins at Station 45+88.02 of Project No. SDR 3(15) (Mile Post 19.624) and ends at Station 17+00 of Project No. SDR 3(13) (Mile Post 15.220).

Improvements consist of reconstructing and resurfacing the existing pavement, reconstructing shoulders, installing pavement markers, constructing a centerline monument and recovering and reconstructing centerline monuments.

GROSS LENGTH OF PROJECT 4.404 Miles BRIDGES OVER 20' SPAN 0.408 Mile

DESIGN CLASSIFICATION

FEDERAL AID PROJECTS PREVIOUSLY CONSTRUCTED

OR UNDER CONSTRUCTION

CURRENT ADT (1983).... 4,000 DESIGN ADT (1993).... 4,400 DHV......400 D.....60/40 T24......9.0% V..... 60 MPH.

DEPARTMENT OF TRANSPORTATION FEDERAL HIGHWAY ADMINISTRATION APPROVED: Marchen DIVISION ADMINISTRATOR

DEPARTMENT OF TRANSPORTATION STATE OF HAWAII		
APPROVED:	B	
Cheryl D. Joon FODIR. OF TRANSPORTATION	<u>5/3//83</u> DATE ·	