



FED. ROAD DIST. NO.	STATE	FED. AID PROJ. NO.	FISCAL YEAR	SHEET NO.	TOTAL SHEETS
HAWAII	HAW.	F-FR-019-2(21)	1983	3	8

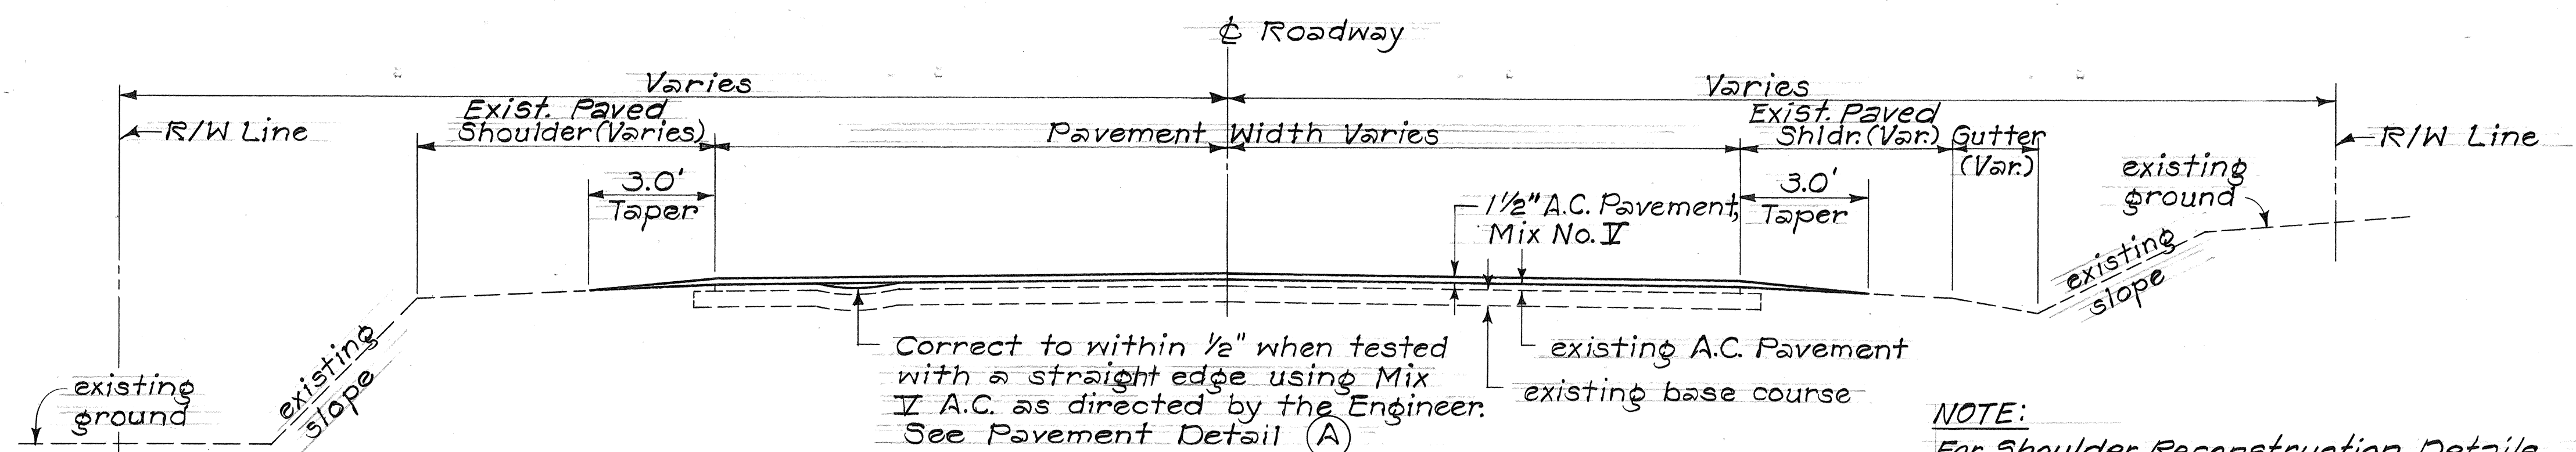


TYPICAL SECTION


NOTE:
For Shoulder Reconstruction Details and Schedule, and Pavement Reconstruction Details and Schedule, see Plan Sht. No. 4.

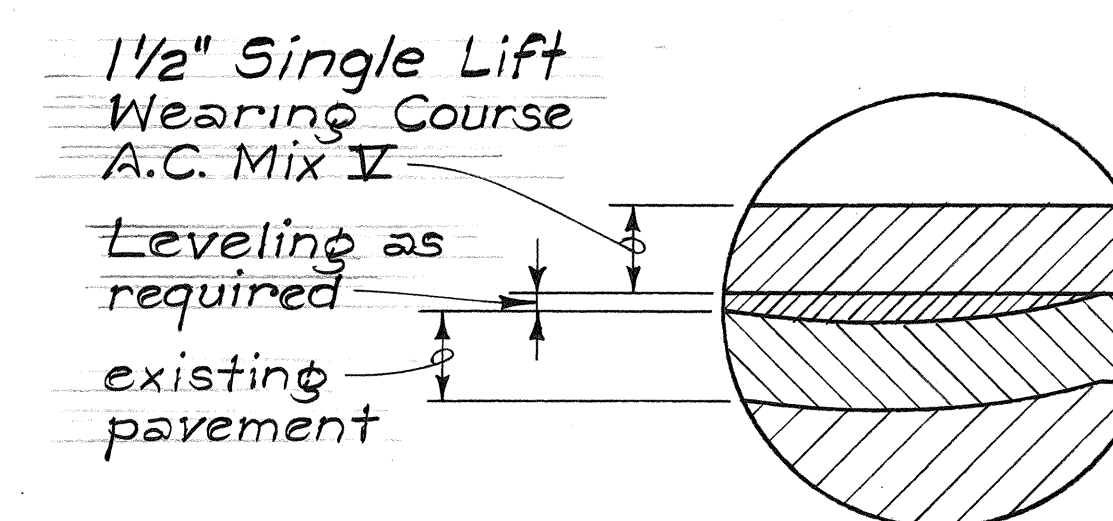


PAVEMENT DETAIL (A)

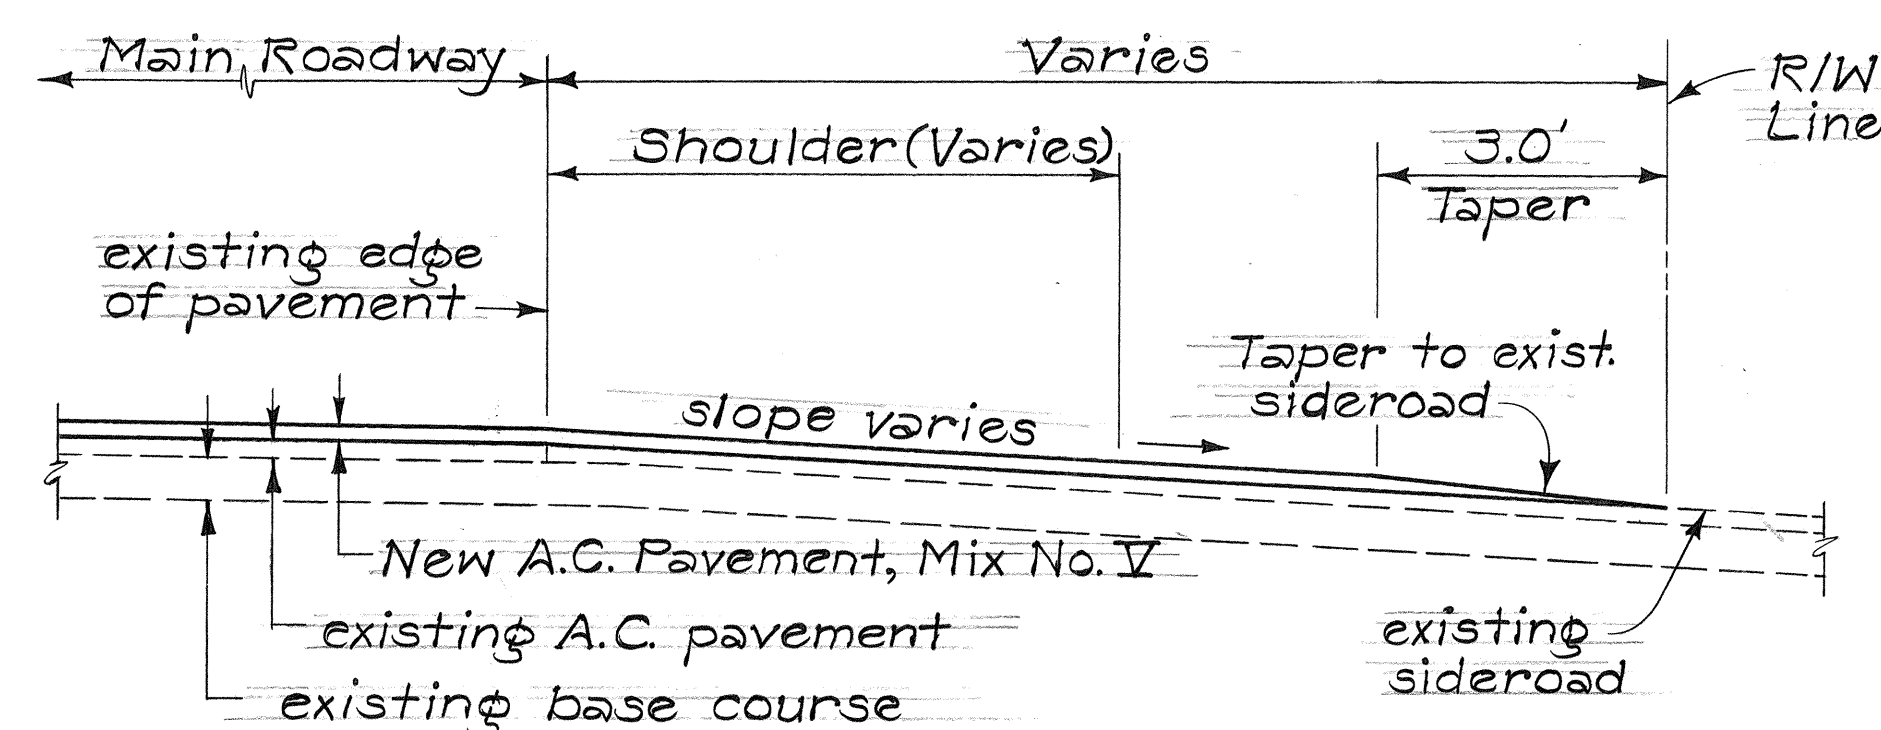


TYPICAL SECTION AT SIDEROAD CONNECTION

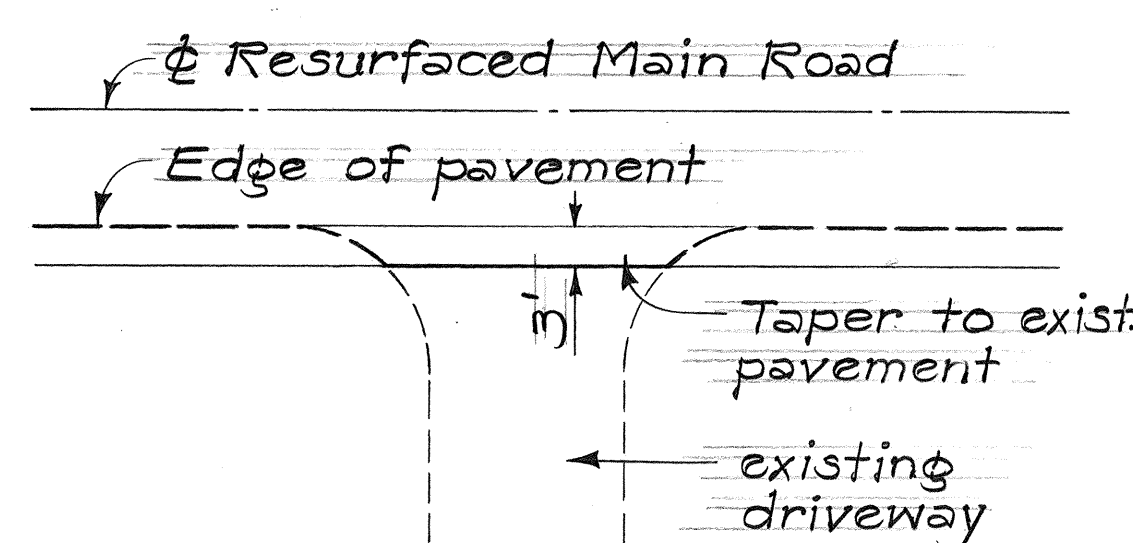

TYPICAL PLAN AT DRIVEWAY CONNECTION

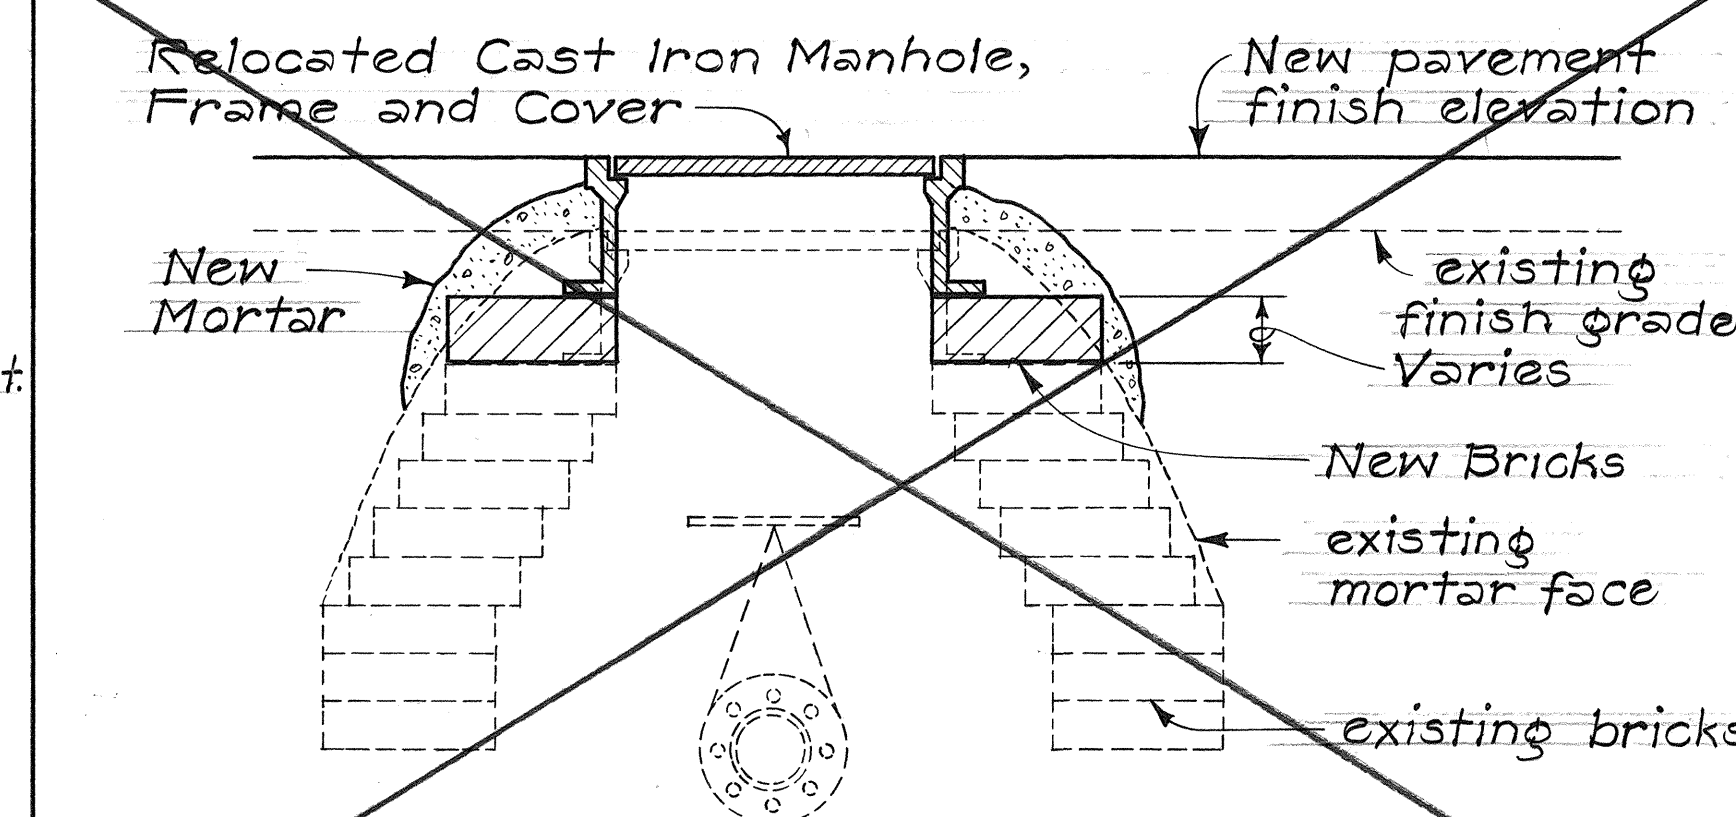

CAST IRON VALVE BOX FRAME & COVER DETAIL

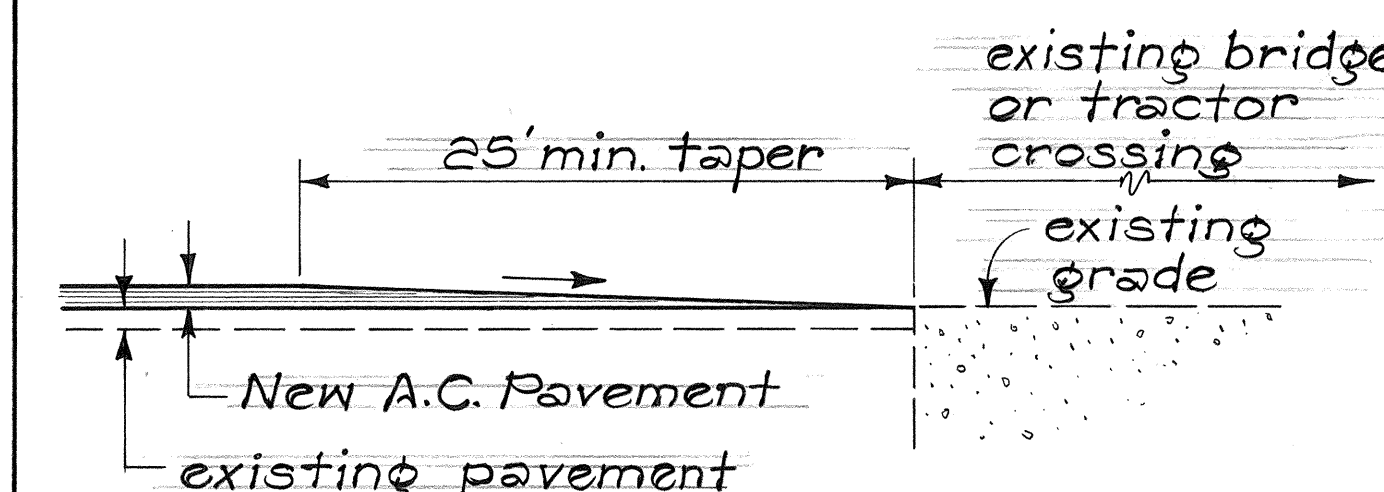

RESURFACING DETAIL AT EXISTING BRIDGE OR TRACTOR CROSSING

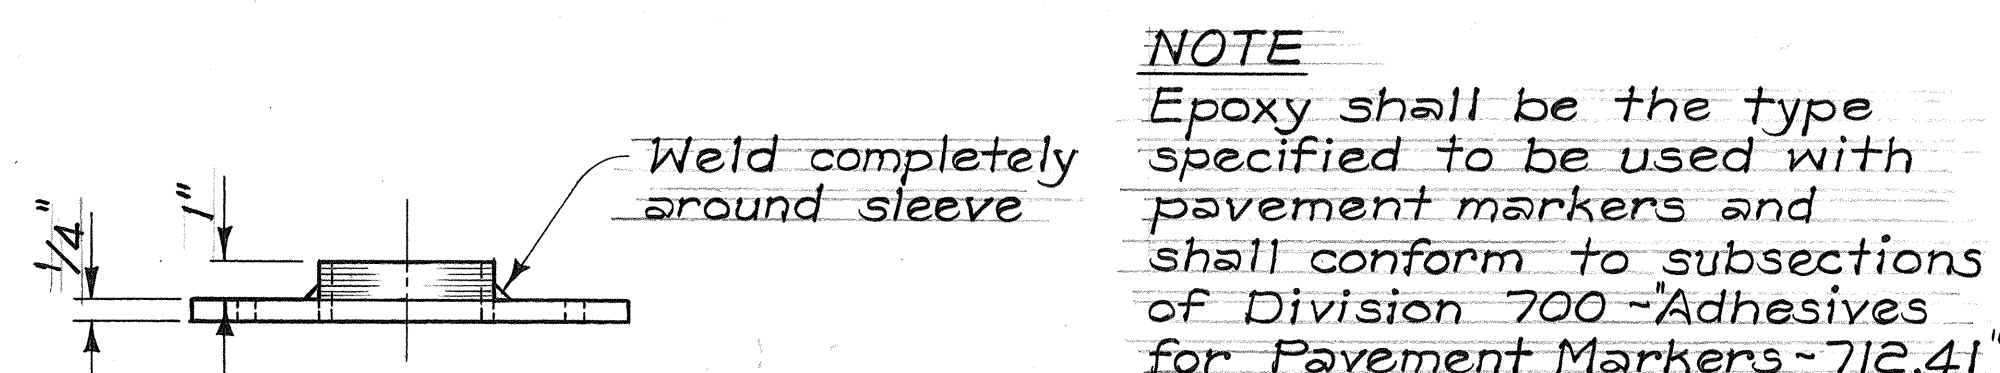


PLATE ELEVATION


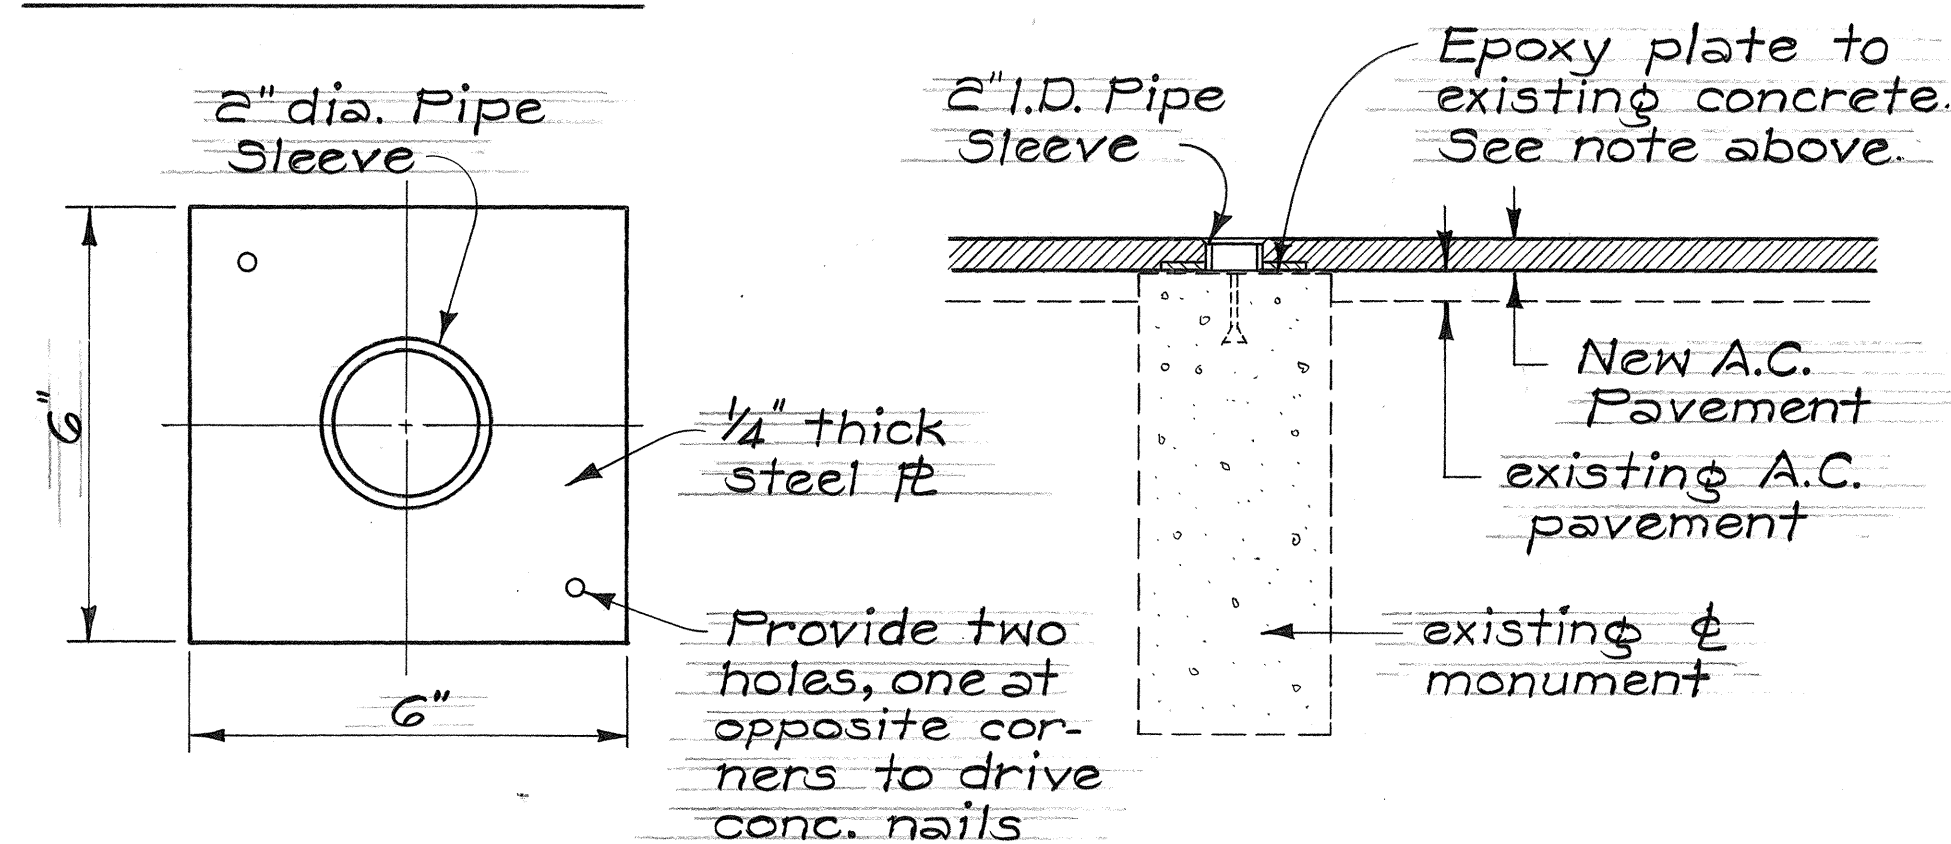



PLATE PLAN

SECTION THRU MONUMENT

DETAIL FOR RECOVERY OF ϕ AND REFERENCE SURVEY MONUMENT

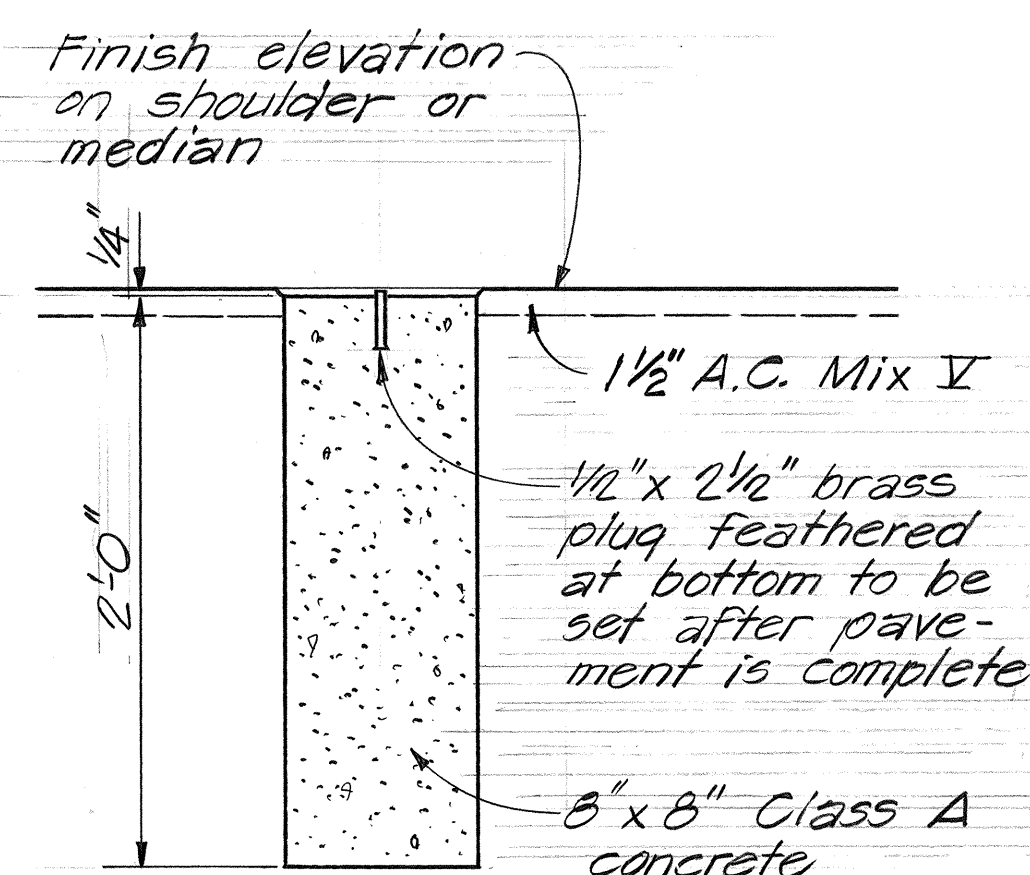

DETAIL FOR ϕ AND REFERENCE SURVEY MONUMENT

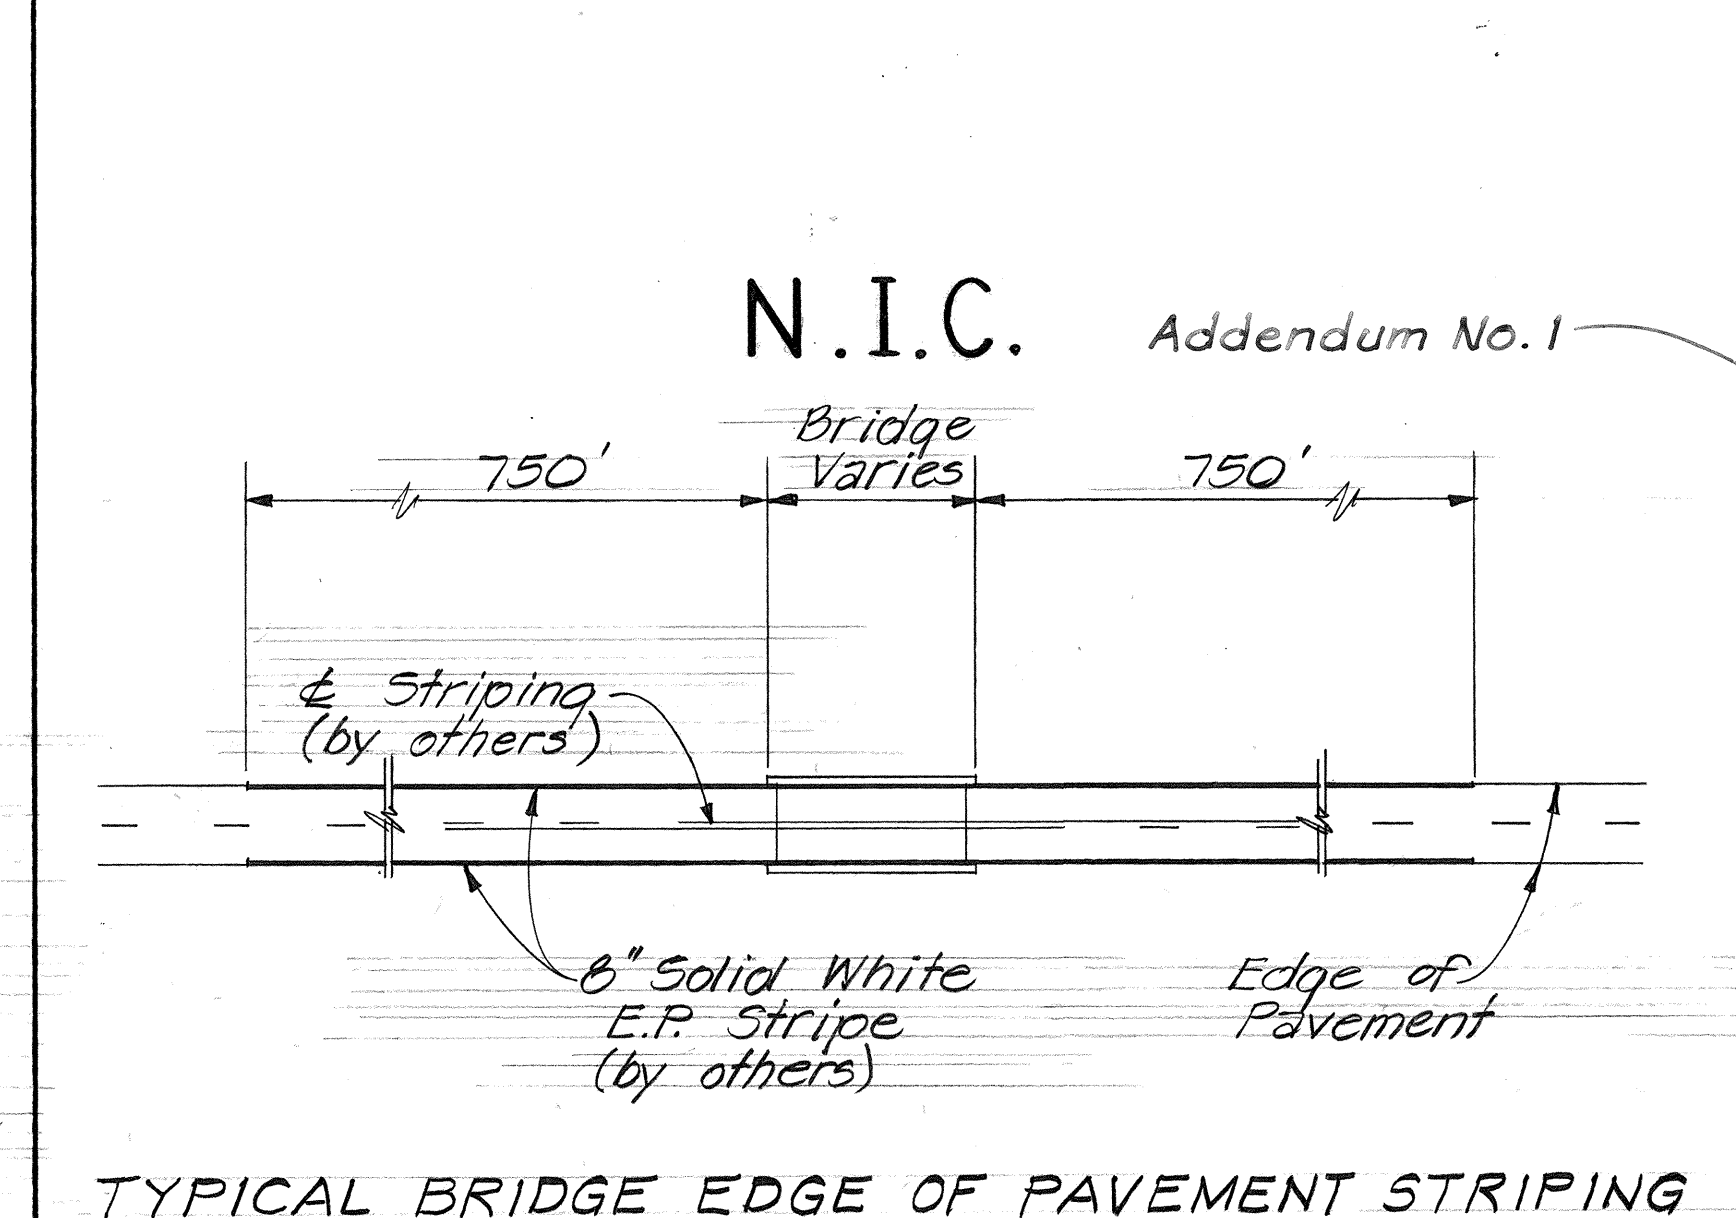

TYPICAL BRIDGE EDGE OF PAVEMENT STRIPING

7. Prior to resurfacing, all ruts and depressions within the existing roadway pavement shall be filled with a thin layer of leveling course consisting of A.C. Mix No. V. This leveling course will be considered as Asphalt Concrete Pavement, Mix No. V and shall be paid for under Item No. 401.0500.

6/30/83	See Plan Sht. No. ADD. 2 for amendment of General Note No. 3 per Addendum No. 1.
DATE	REVISION

- GENERAL NOTES**
- Existing pavement surface variable. Surface indicated here is not intended to represent any specific location.
 - Construct smooth and easy riding connections at beginning and ending of projects.
 - Centerline and edge of pavement striping to be done by others.
 - All centerline and reference monuments to be reconstructed will be referenced by others.
 - All construction signs shall be reflectorized with high intensity reflective sheeting.
 - Pavement areas where striping is to be done by others shall be broomed off by Contractor.
- See Below for Note No. 7

STATE OF HAWAII DEPARTMENT OF TRANSPORTATION HIGHWAYS DIVISION
TYPICAL SECTIONS & DETAILS
HAWAII BELT ROAD RESURFACING Ninole Stream Bridge to Haka/bu F.A. Proj. No. F-FR-019-2(21)
Not to Scale Date: May, 1983
SHEET NO. 1 OF 1 SHEETS