



FINAL SURVEY	SURVEYED _____	BY _____	DATE _____
NOTE BOOK	PLOTTED _____		
	TEMPLATE _____		
	AREAS _____		
ING.	AREAS CHECKED _____		

ORIGINAL SURVEY	SURVEYED	BY	DATE
NOTED BOOK	PLOTTED		
	TEMPLATE		
	AREAS		
	AREAS CHECKED		

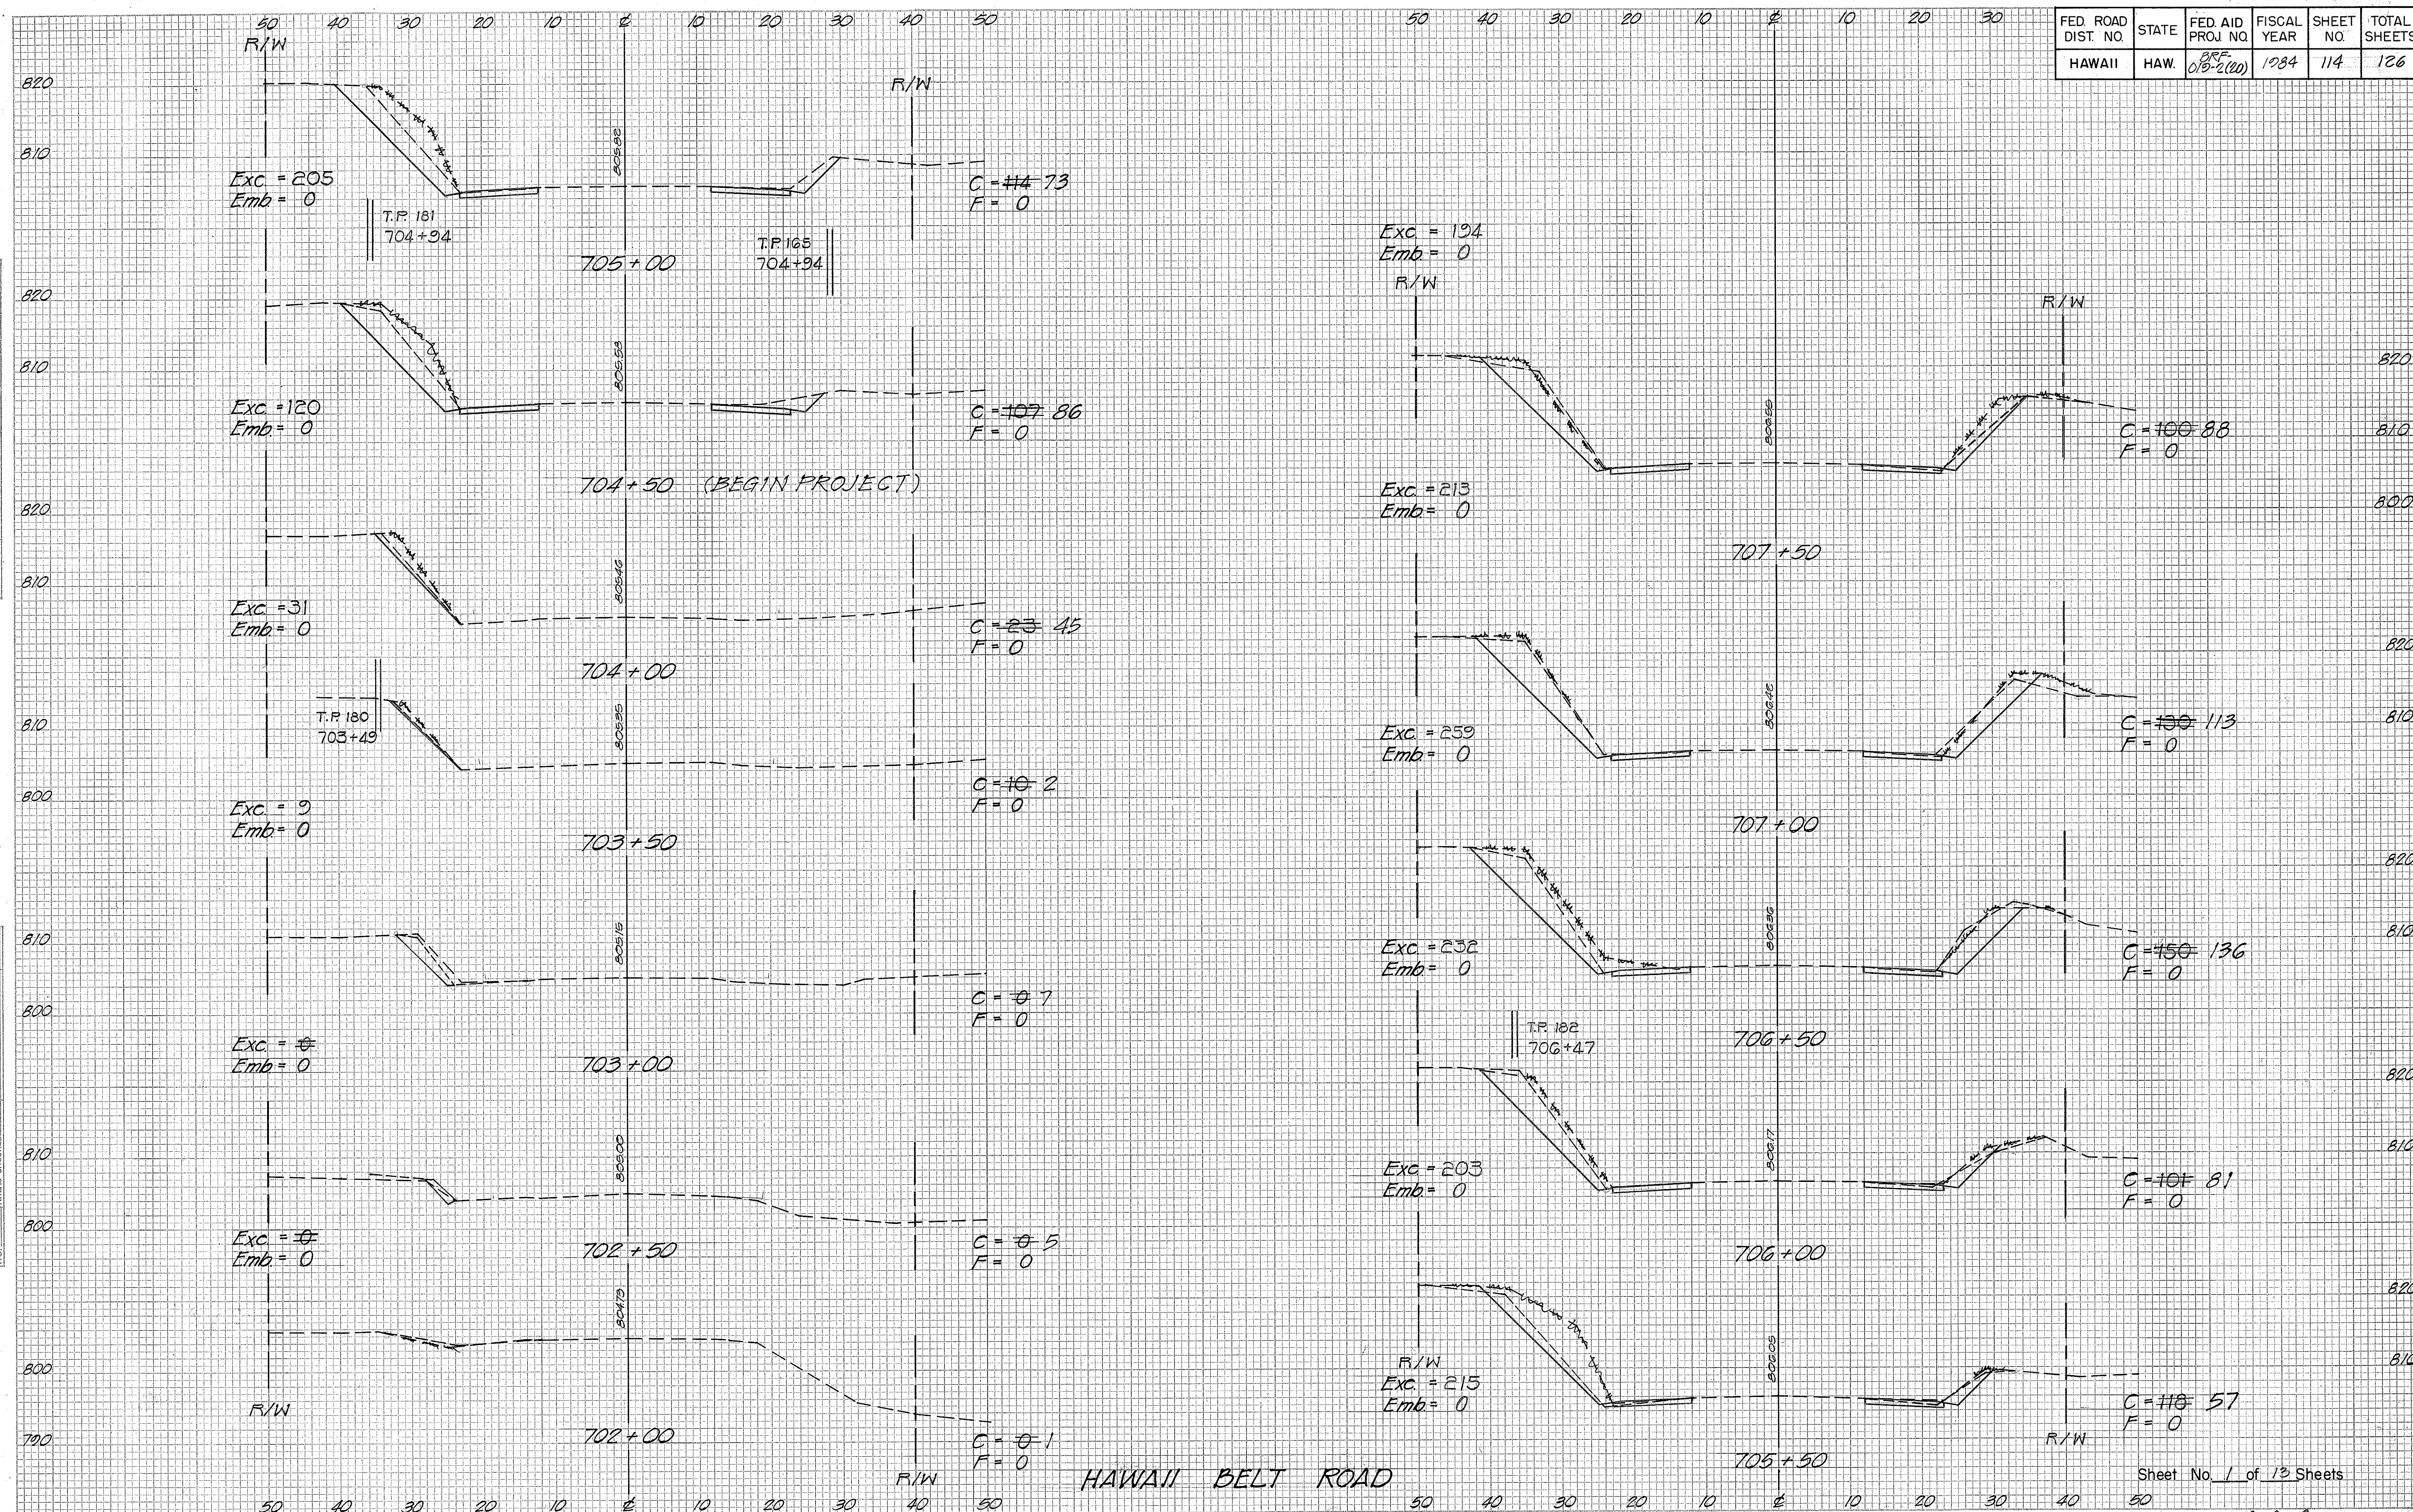

FINAL SURVEY		BY	DATE
SURVEYED			
PLOTTED			
TEMPLATE			
AREAS			
AREAS CHECKED			
N.O.			

	SURVEYED	PLOTTED	TEMPLATE AREAS	AREAS CHECKED	BY	DATE
ORIGINAL SURVEY						
NOTE BOOK						
NO.						

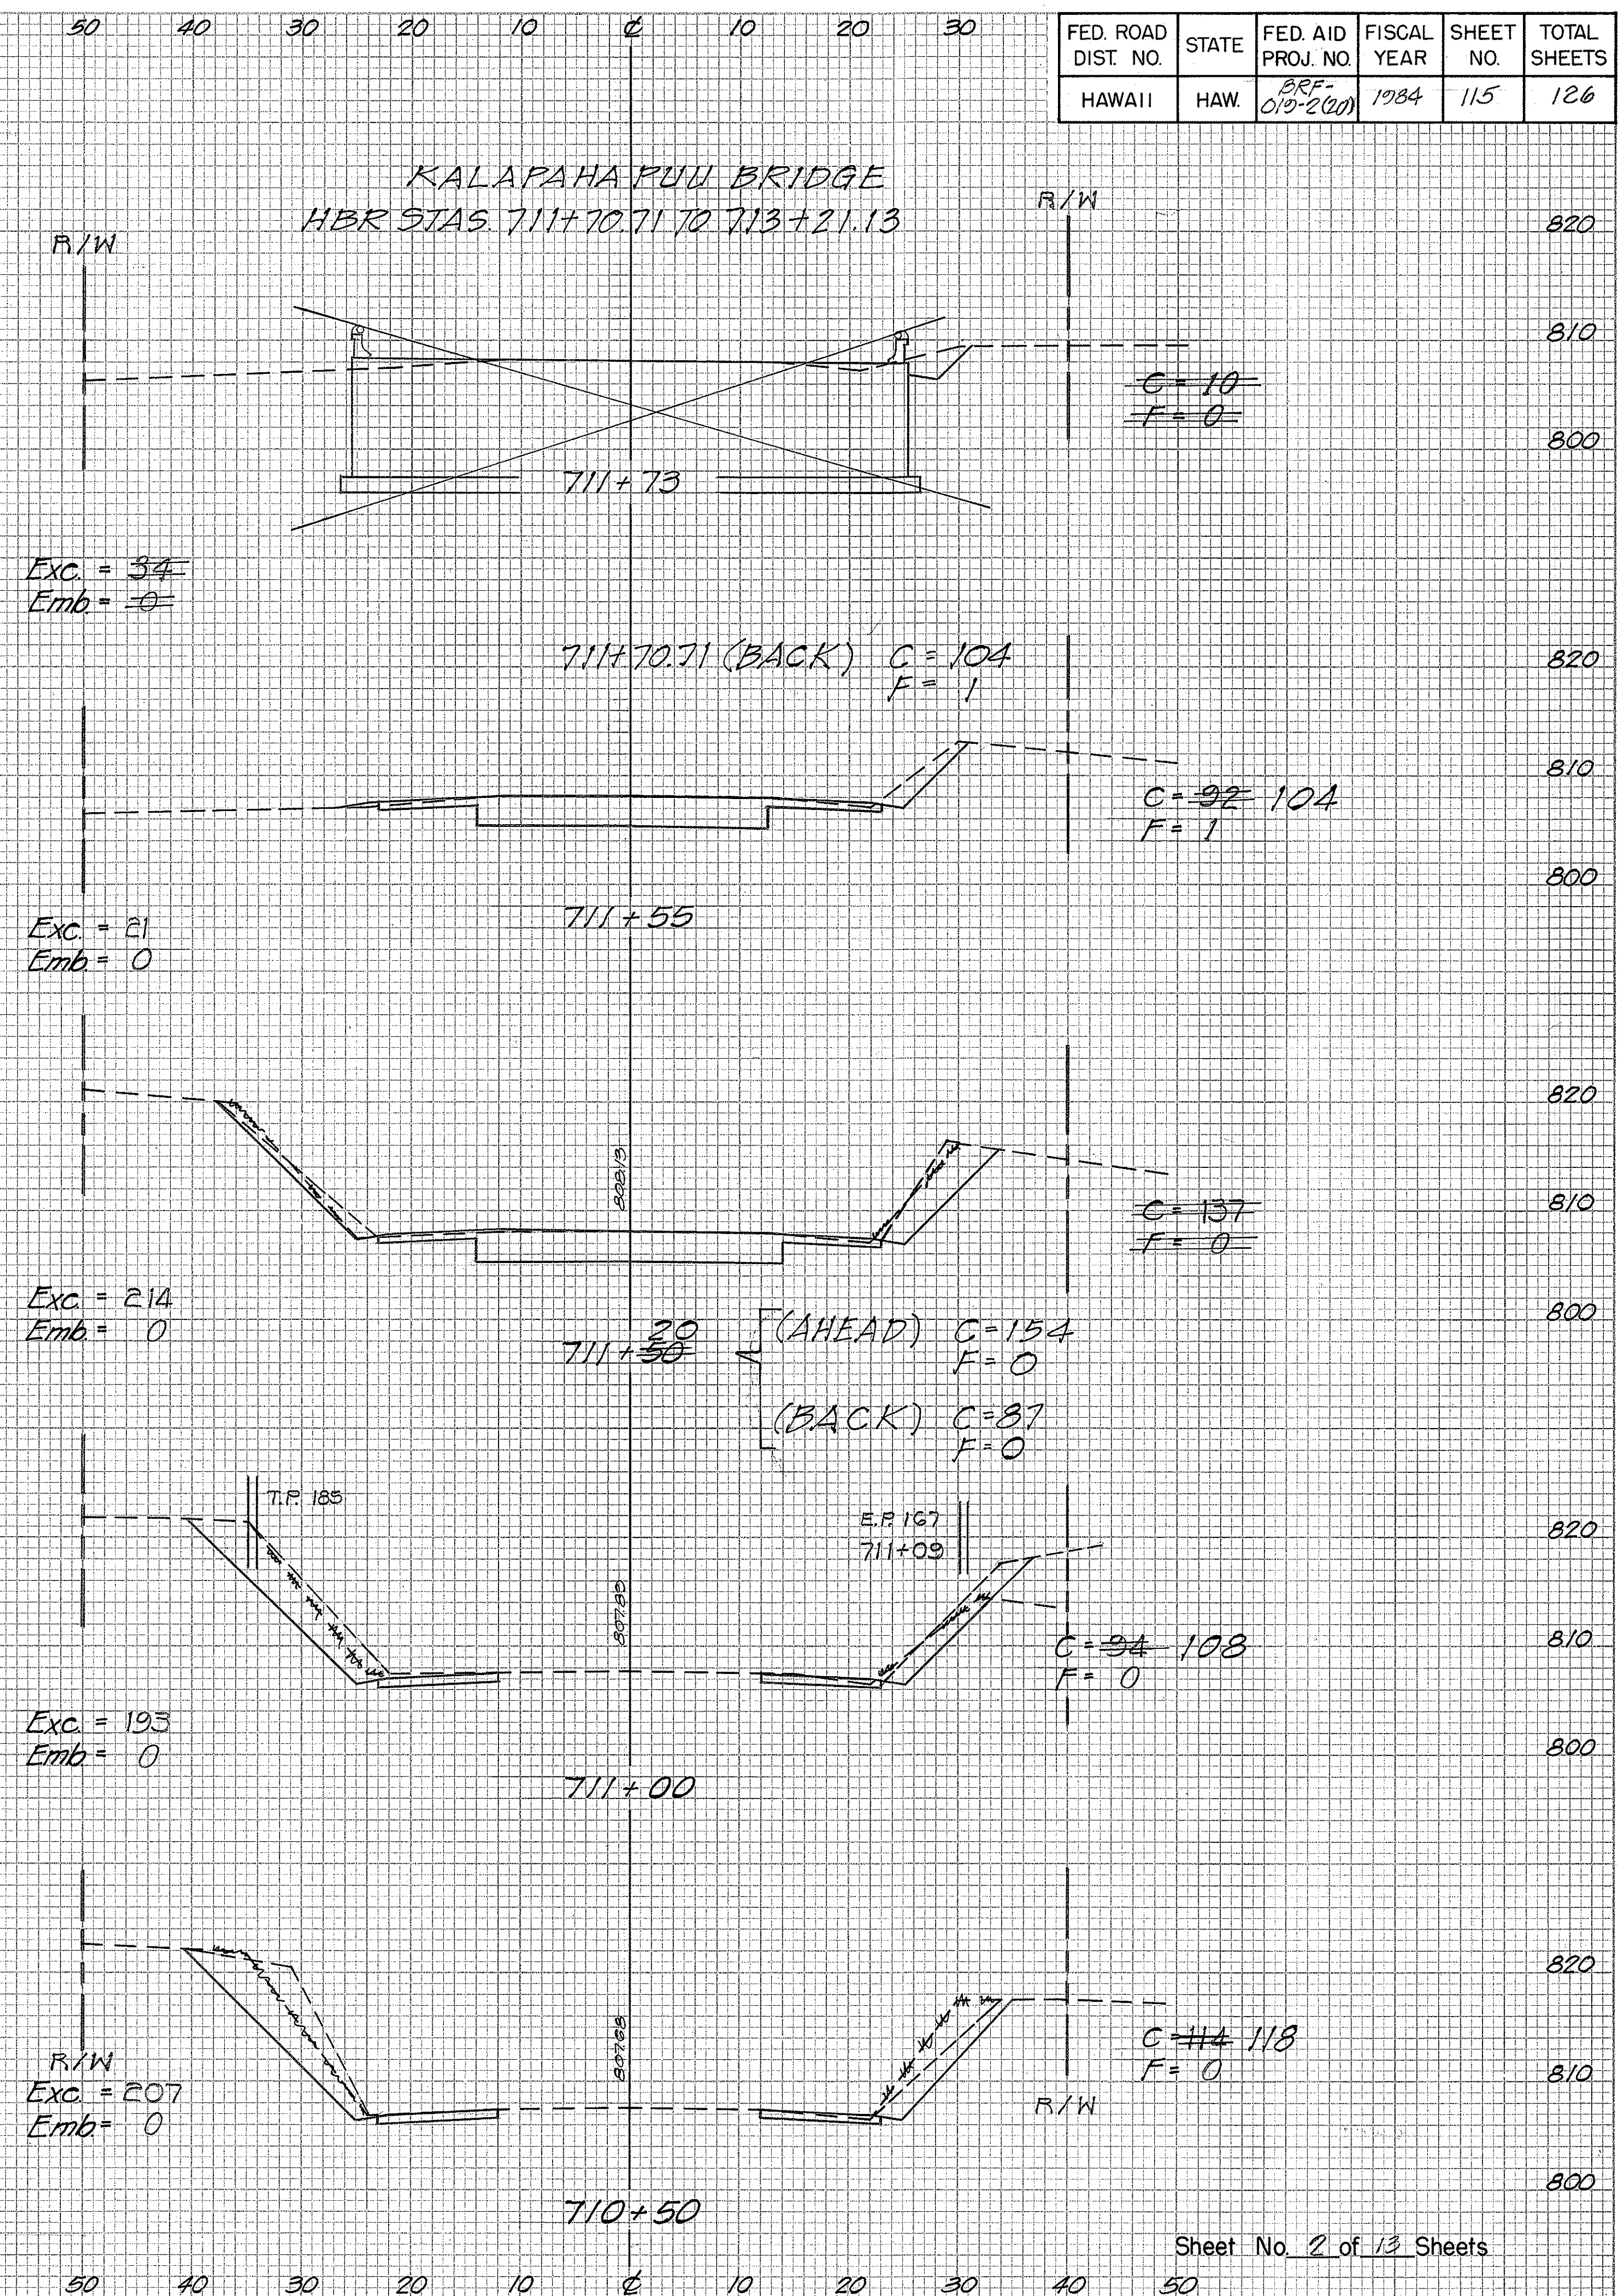


Sheet No. 2 of 13 Sheets

DATE	BY	SURVEYED	PLOTTED	NOTED	CHECKED
FINAL SURVEY BOOK NO.					

DATE	BY	ORIGINAL	SURVEYED	PLOTTED	NOTED	CHECKED
ORIGINAL SURVEY BOOK NO.						

FED. ROAD DIST. NO.	STATE	FED. AID PROJ. NO.	FISCAL YEAR	SHEET NO.	TOTAL SHEETS
HAWAII	HAW.	BRF-010-2(20)	1984	116	126

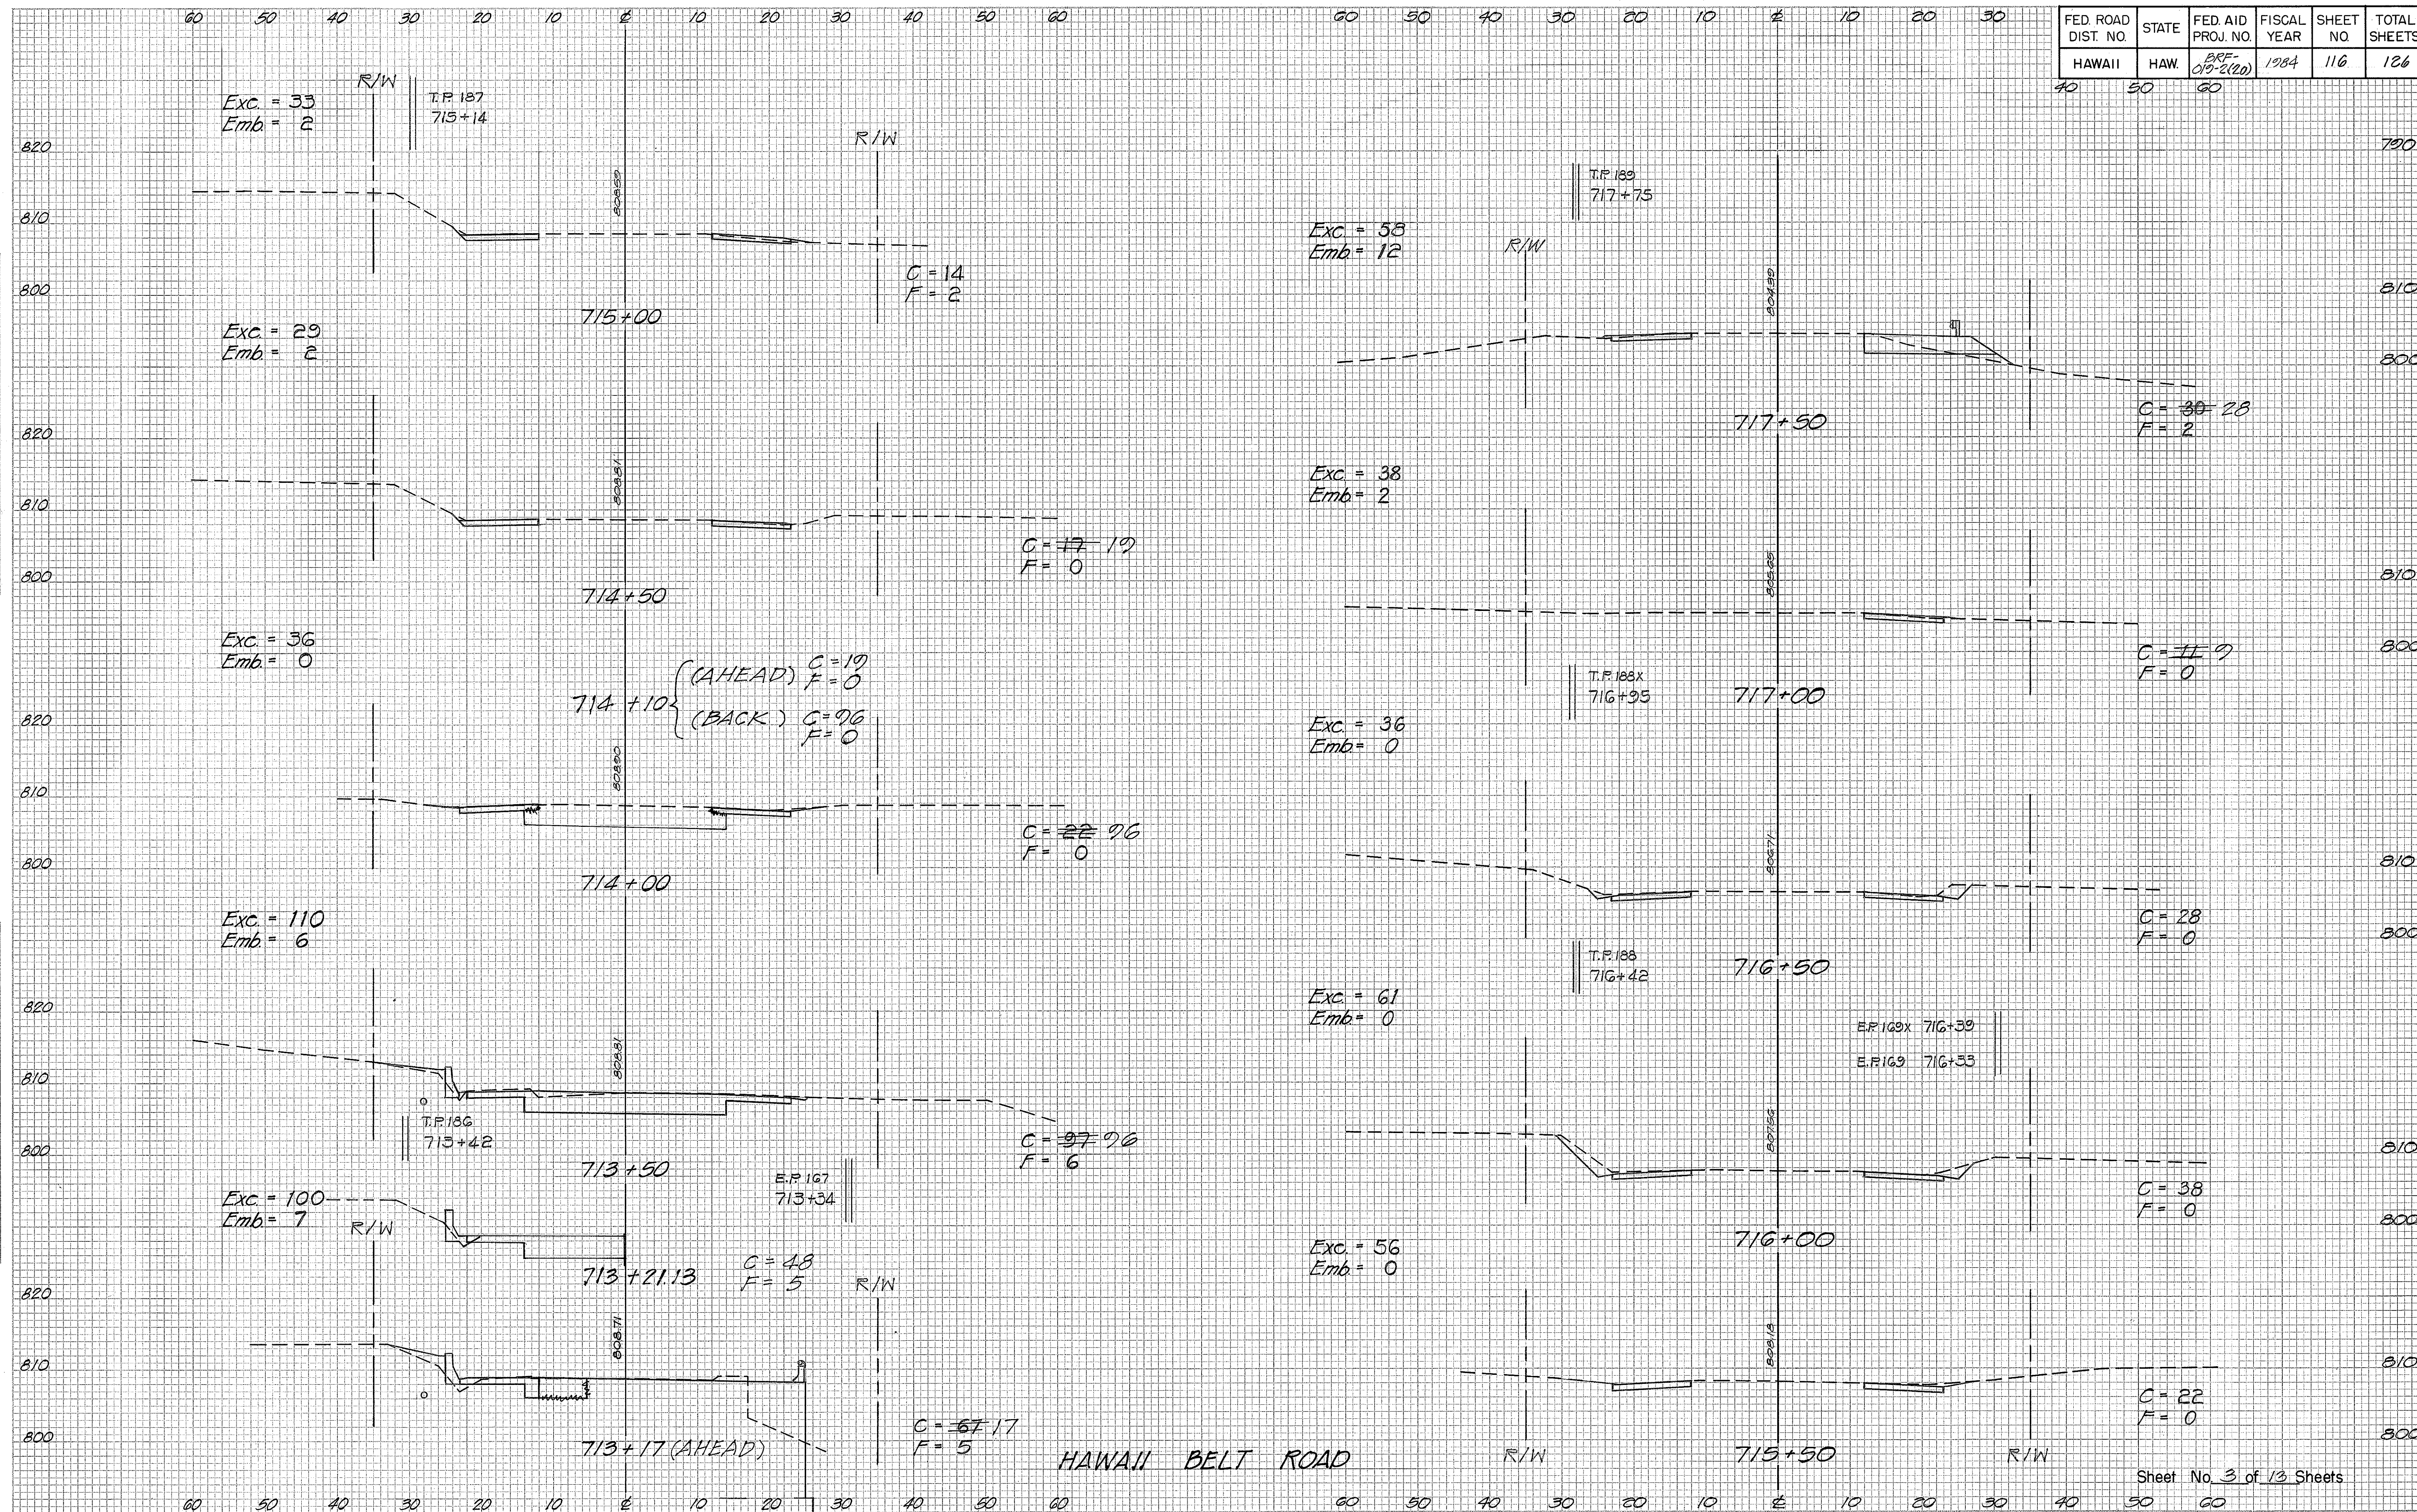


HAWAII BELT ROAD


Sheet No. 3 of 13 Sheets


FED. ROAD DIST. NO.	STATE	FED. AID PROJ. NO.	FISCAL YEAR	SHEET NO.	TOTAL SHEETS
HAWAII	HAW.	BRF-019-2(20)	1984	117	126

DATE	BY	FINAL SURVEY PLOTTED	NOTE BOOK TEMPLATE	AREAS CHECKED

DATE	BY	ORIGINAL SURVEY PLOTTED	NOTE BOOK TEMPLATE	AREAS CHECKED

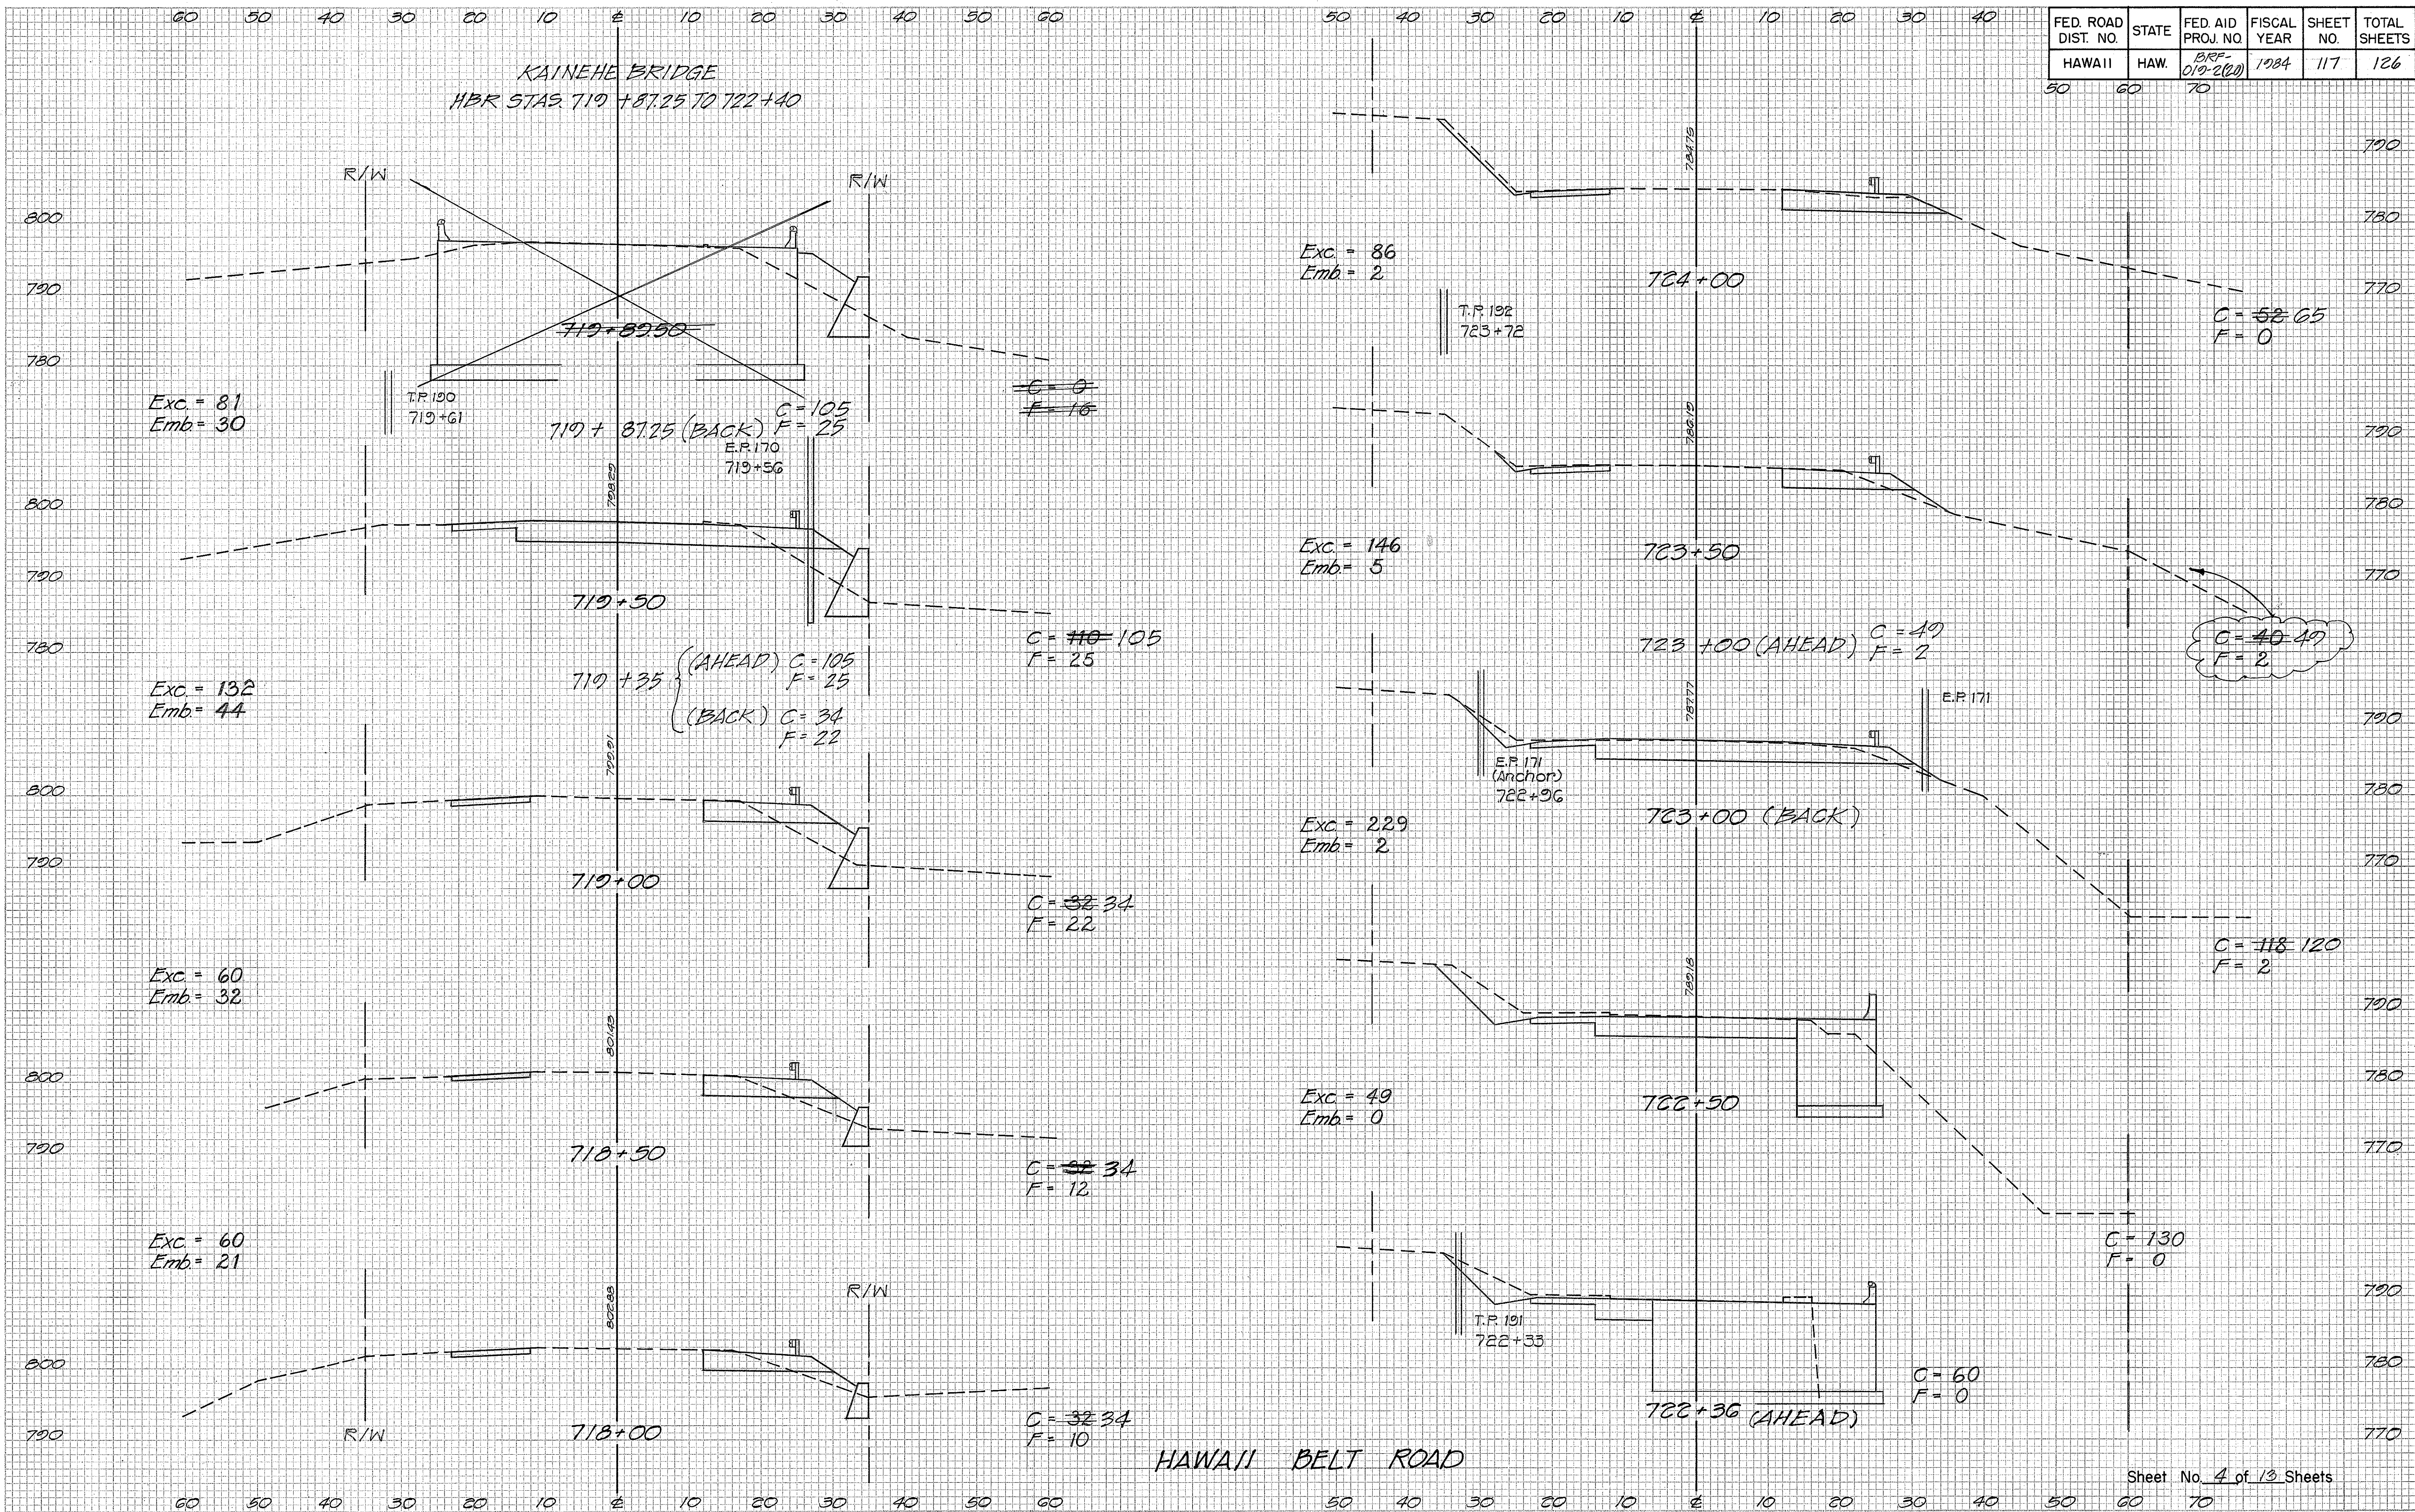

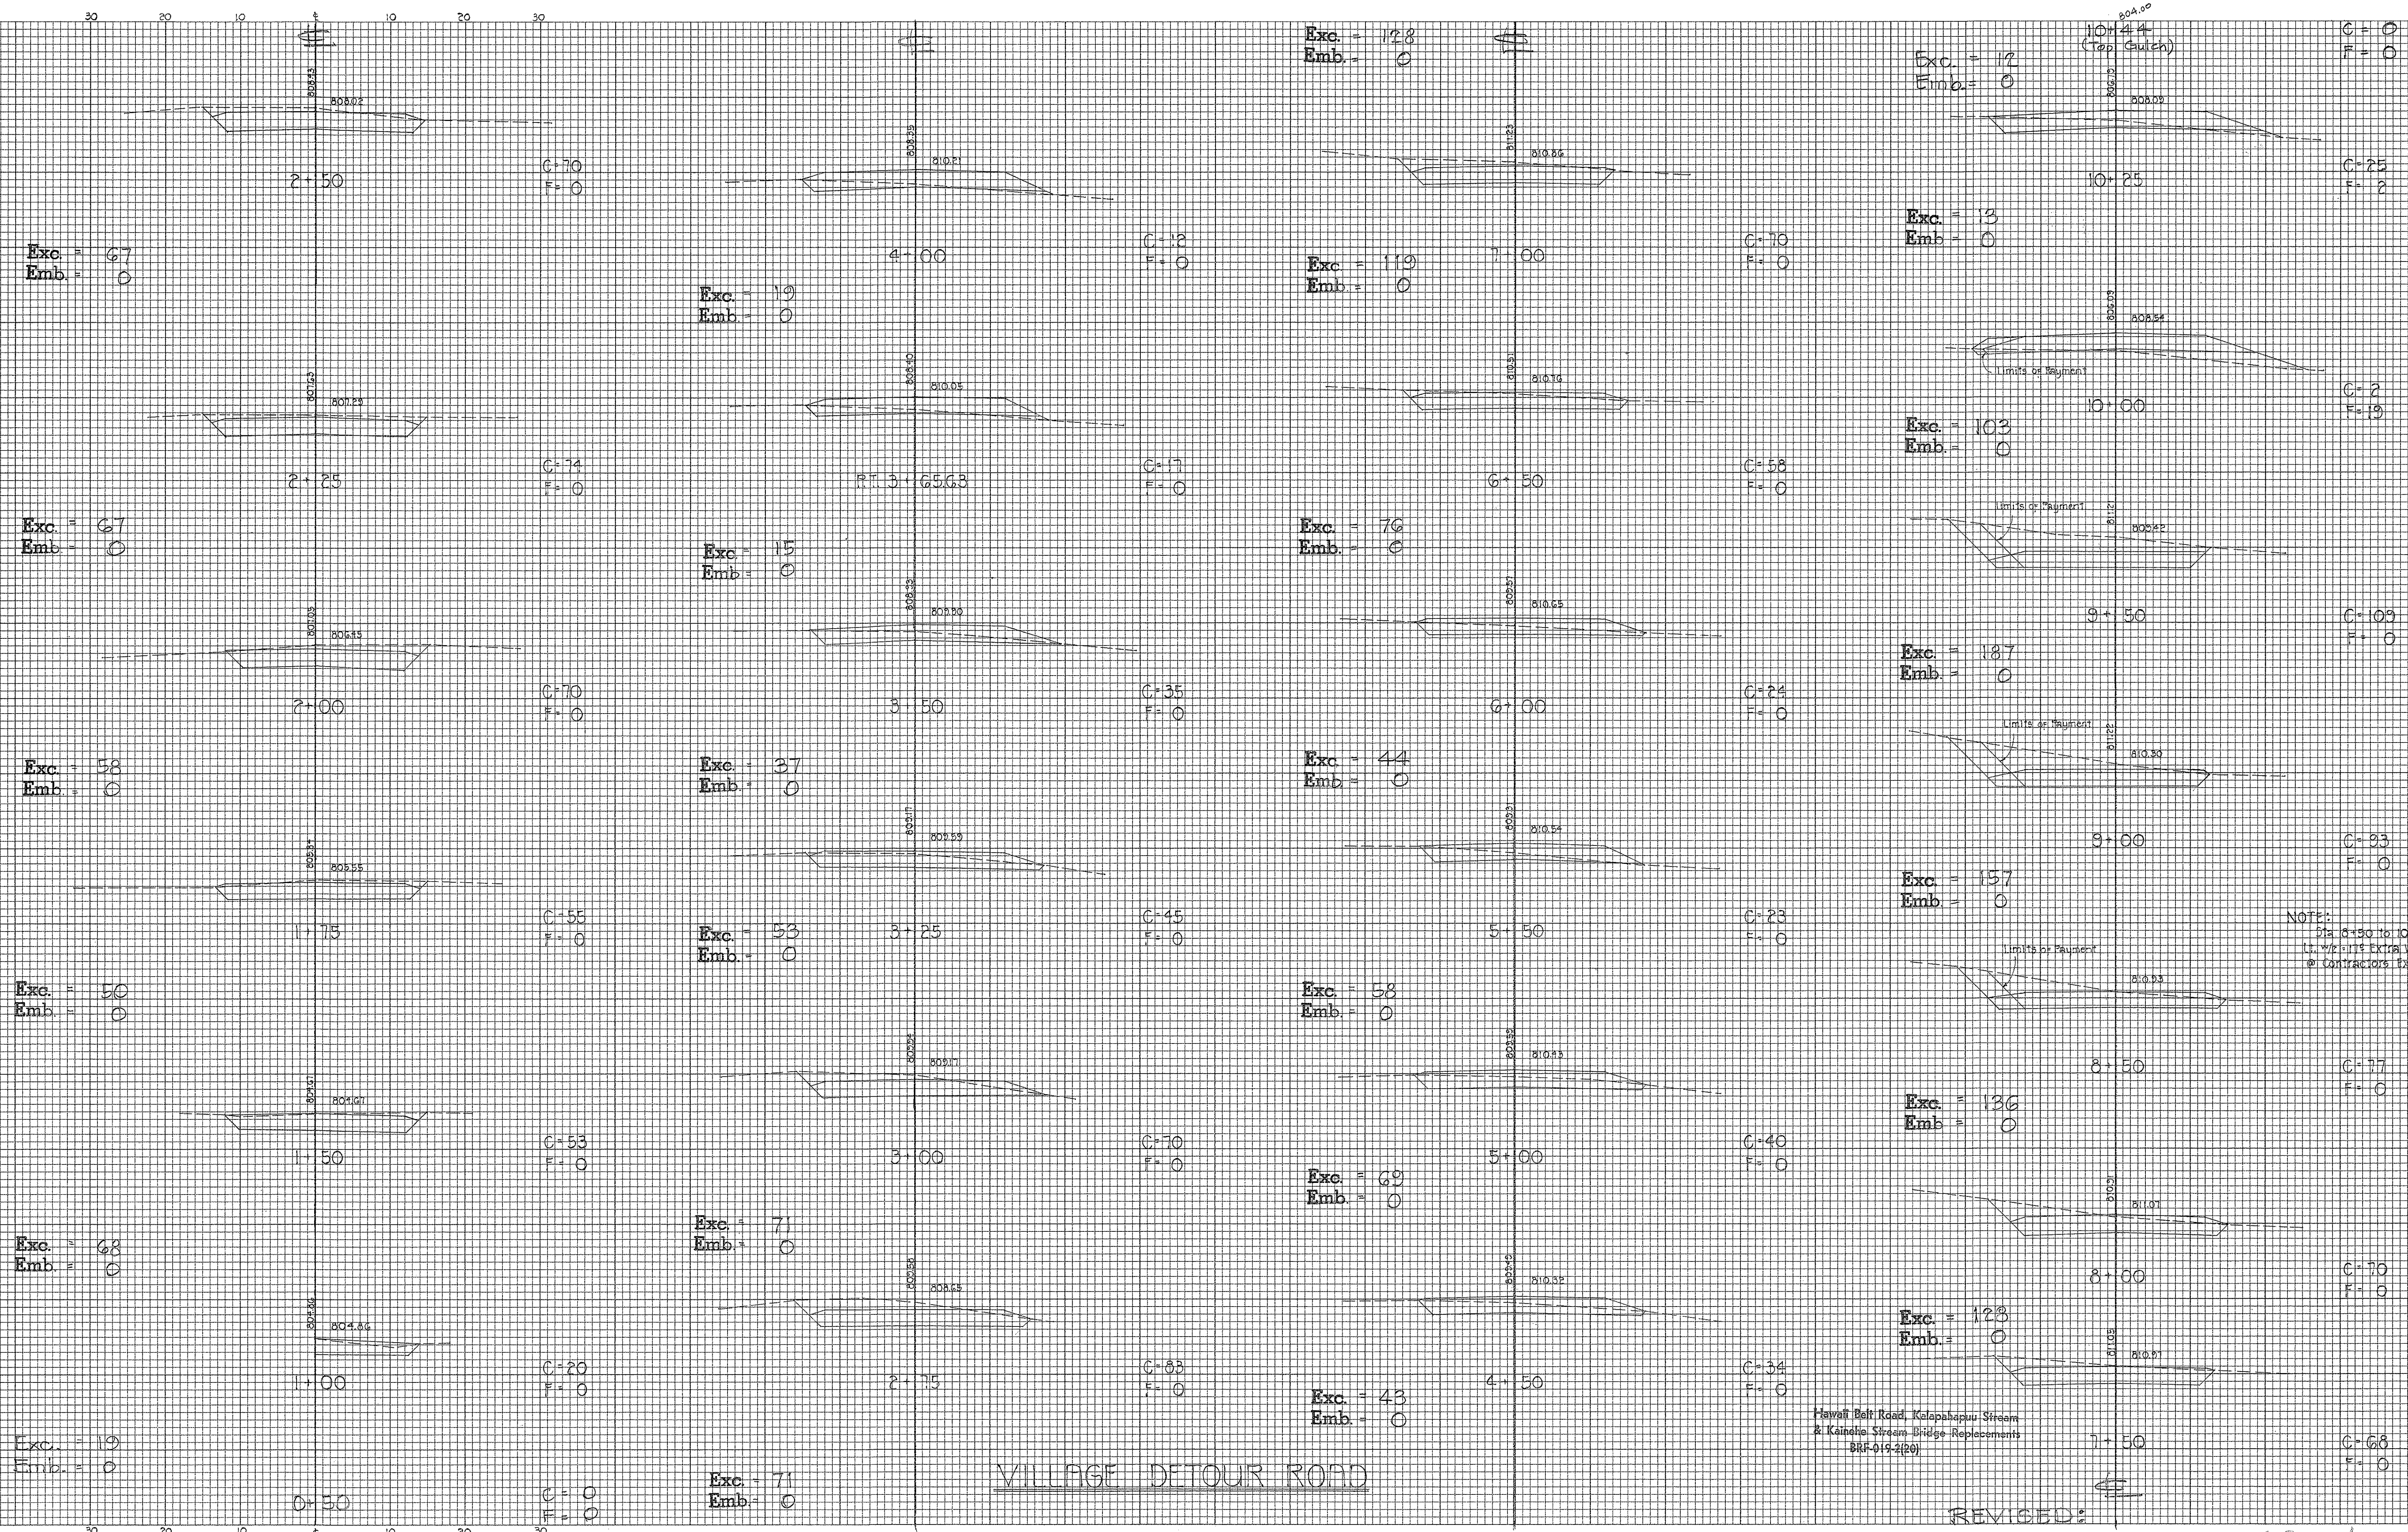

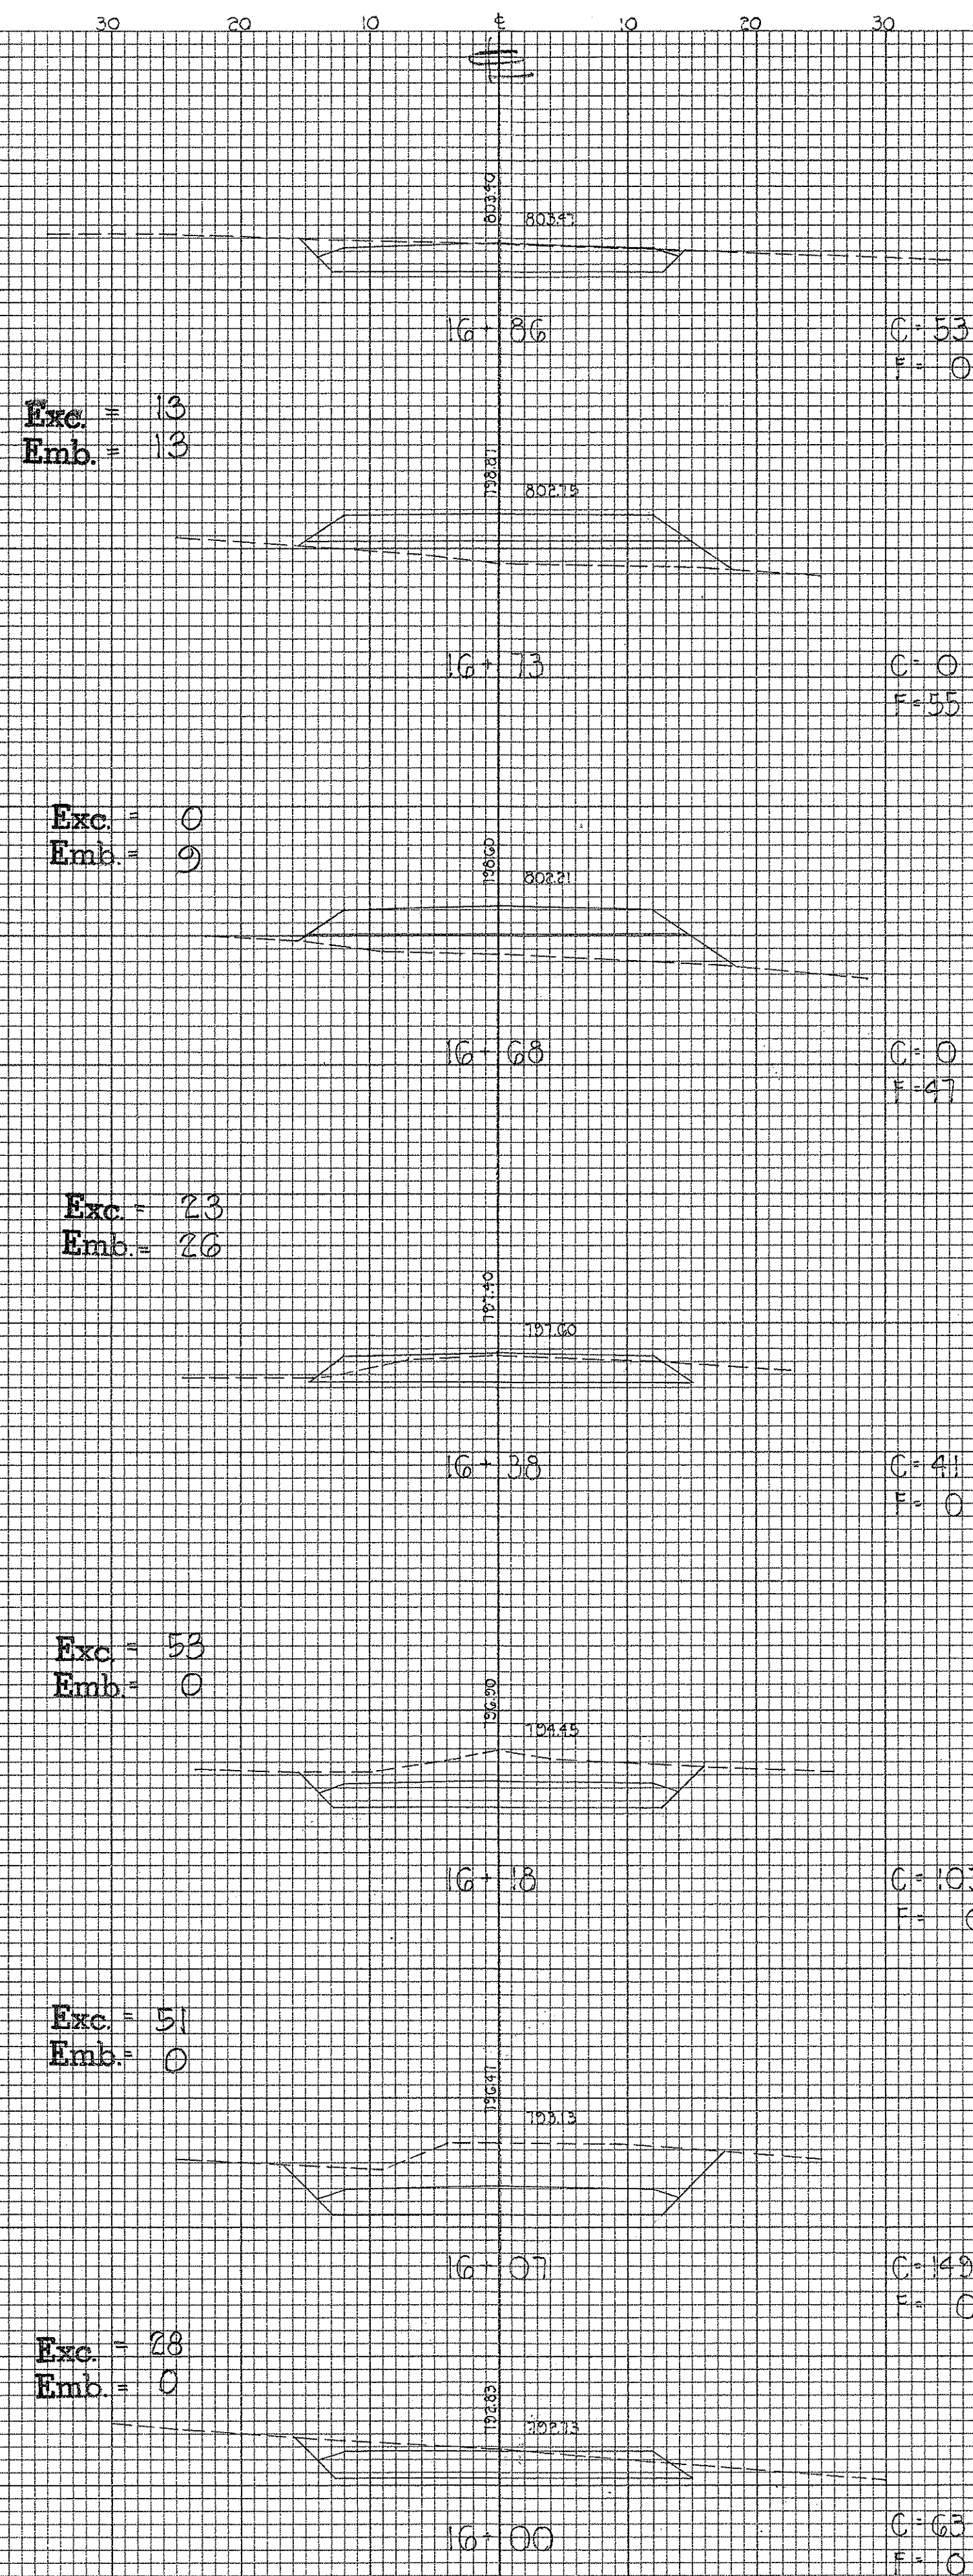

VILLAGE DETOUR ROAD

Hawai Belt Road, Kalanipapua Stream
& Kaneohe Stream Bridge Replacements
BRF 019-2(20)

REVISED:

121A

P-40-4

FINAL SURVEY	DATE	
	BY	
	SURVEYED	
	NOTE BOOK	
	AREAS CHECKED	

ORIGINAL SURVEY	DATE	
	BY	
	SURVEYED	
	NOTE BOOK	
	AREAS CHECKED	

Exc. 53
Emb. 22

137+00

Cut: 28
Fill: 0

Exc. 69
Emb. 0

0+50

Cut: 60
Fill: 0

Exc. 53
Emb. 44

136+50

Cut: 29
Fill: 24

Cut: 89
Fill: 0

0+25

Exc. 62
Emb. 26

136+00

Cut: 28
Fill: 23

0+00 SIDE RD. TOWARD HILLO
136+10.01 DETOUR RD.

Exc. 77
Emb. 5

135+50

Cut: 39
Fill: 5

Exc. 62
Emb. 0

135+00

Cut: 44
Fill: 0

P.T. 137+58.78
23+70.91 HBR

Cut: 43
Fill: 0

P.C. 134+61.24

137+50

DETOUR ROAD
(HONOKAA END)


Small Box Road, Kolohehewa Stream
& Kaimosi Stream Bridge Replacement
488-0152(20)

REVISED: 122A

P. 413-5

DATE	BY	SURVEYED	PLOTTED	RECALCULATED	AREAS CHECKED
FINAL					
NO.					


DATE	BY	SURVEYED	PLOTTED	RECALCULATED	AREAS CHECKED
ORIGINAL					
NO.					

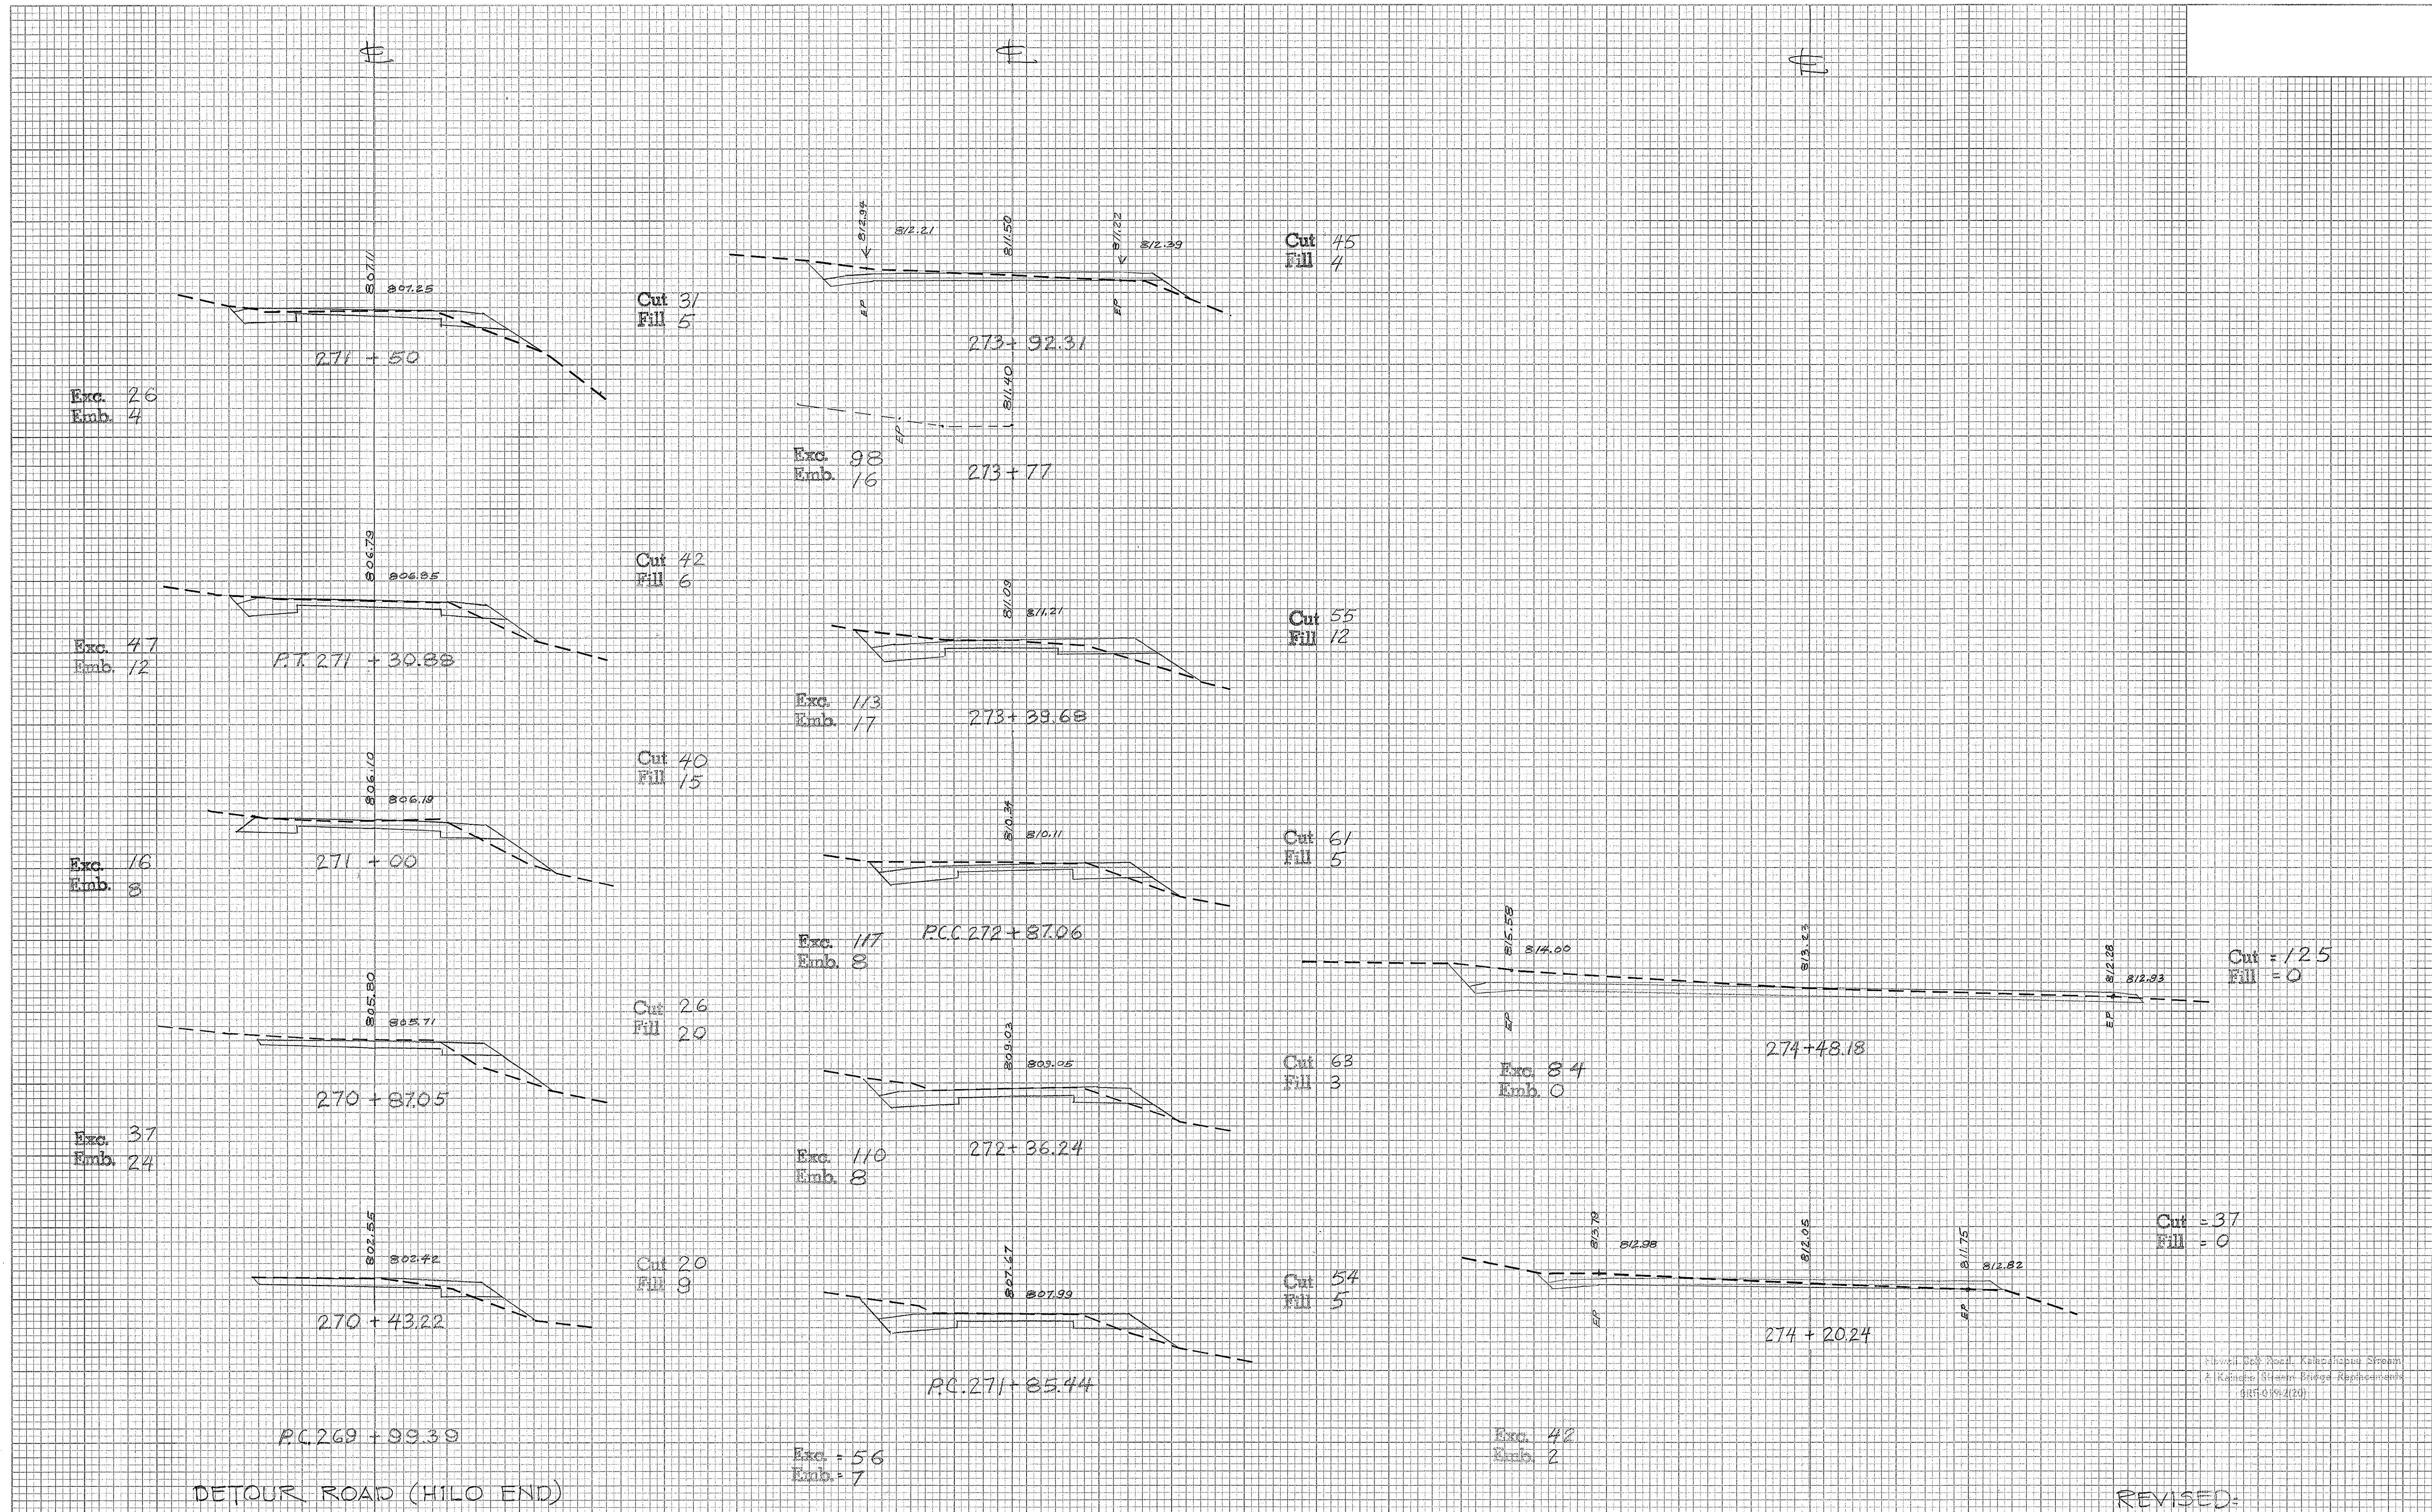

REVISED:

124 A

	DATE	BY	
ORIGINAL SURVEY			SURVEYED
			PLOTTED
NOTE BOOK			TEMPLATE
			AREAS
			AREAS, CHECKED

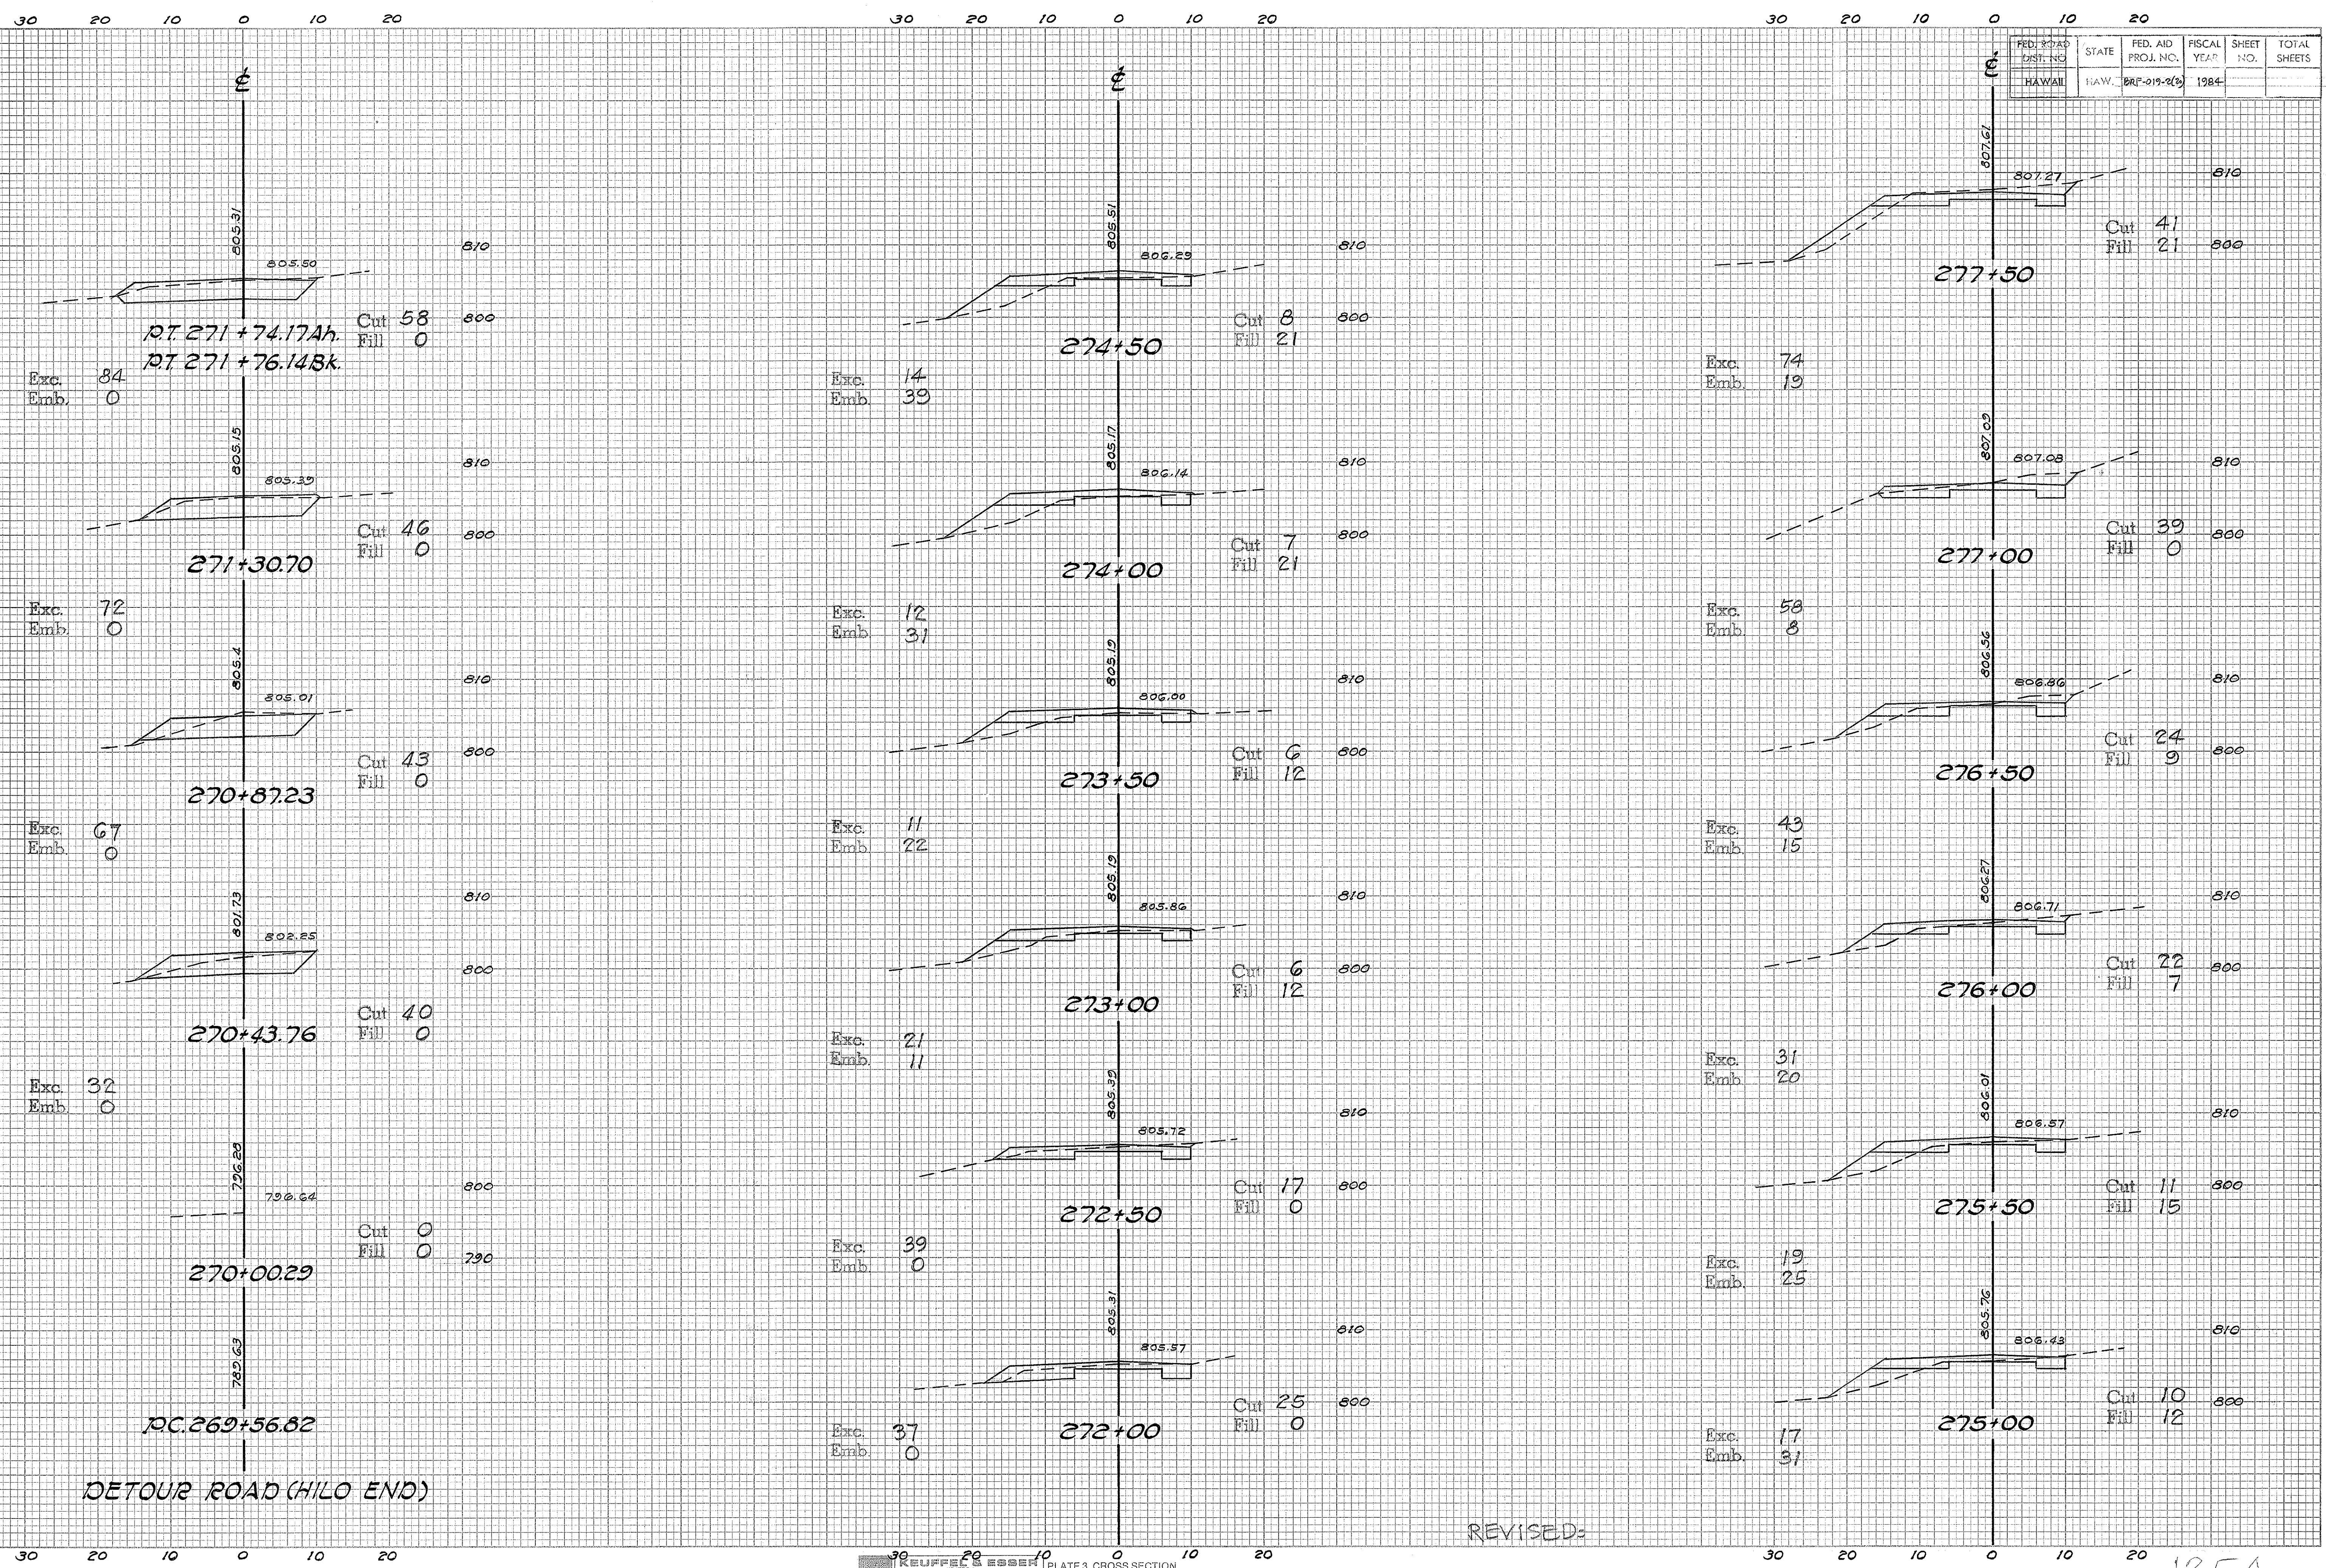


REVISED:

125A

DATE	
BY	
SURVEYED	
NOTE BOOK	
TEMPLATE	
AREAS	
CHECKED	

DATE	
BY	
SURVEYED	
NOTE BOOK	
TEMPLATE	
AREAS	
CHECKED	


FED. ROAD DIST. NO.	STATE	FED. AID PROJ. NO.	FISCAL YEAR	SHEET NO.	TOTAL SHEETS
HAWAII	HAW.	BRF-019-2(2)	1984		

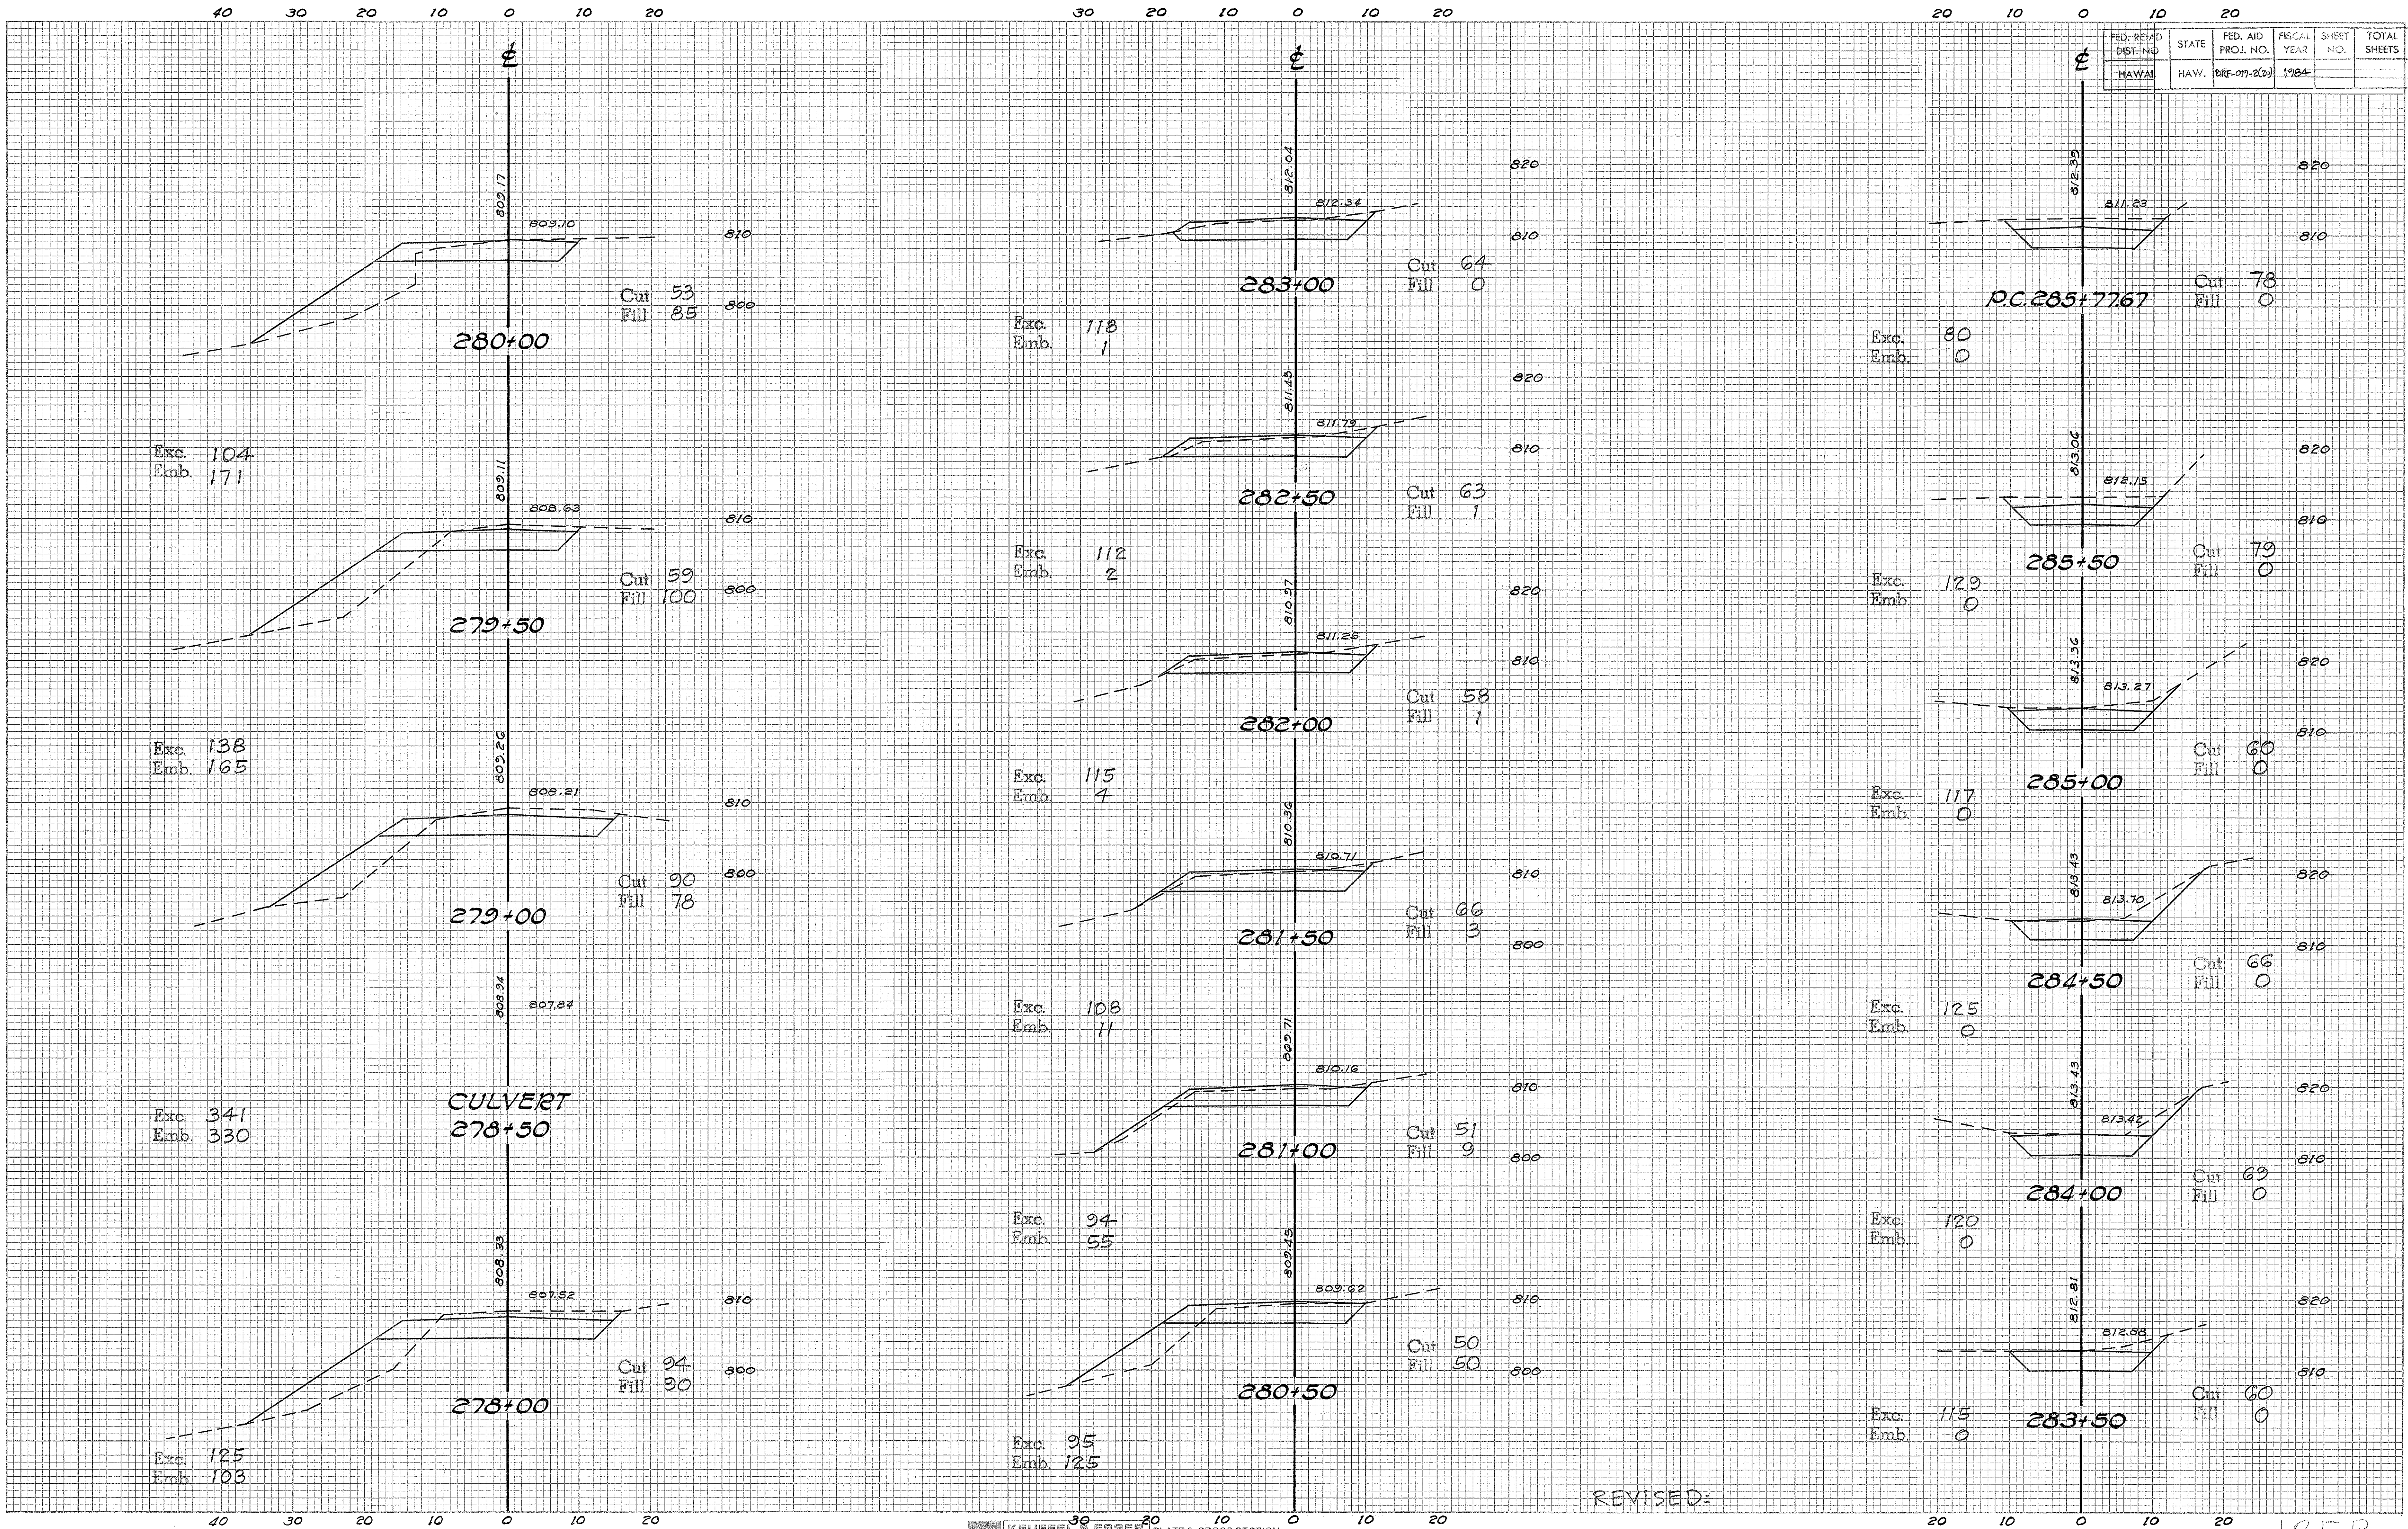

FED. ROAD DIST. NO.	STATE	FED. AID PROJ. NO.	FISCAL YEAR	SHEET NO.	TOTAL SHEETS
HAWAII	HAW.	BRF-019-2(00)	1984		

FINAL SURVEY	DATE	
	BY	
SURVEYED	PLANNED	
	NOTE BOOK	
AREAS CHECKED	AREAS	
	AREAS	

ORIGINAL SURVEY	DATE	
	BY	
SURVEYED	PLANNED	
	NOTE BOOK	
AREAS CHECKED	AREAS	
	AREAS	

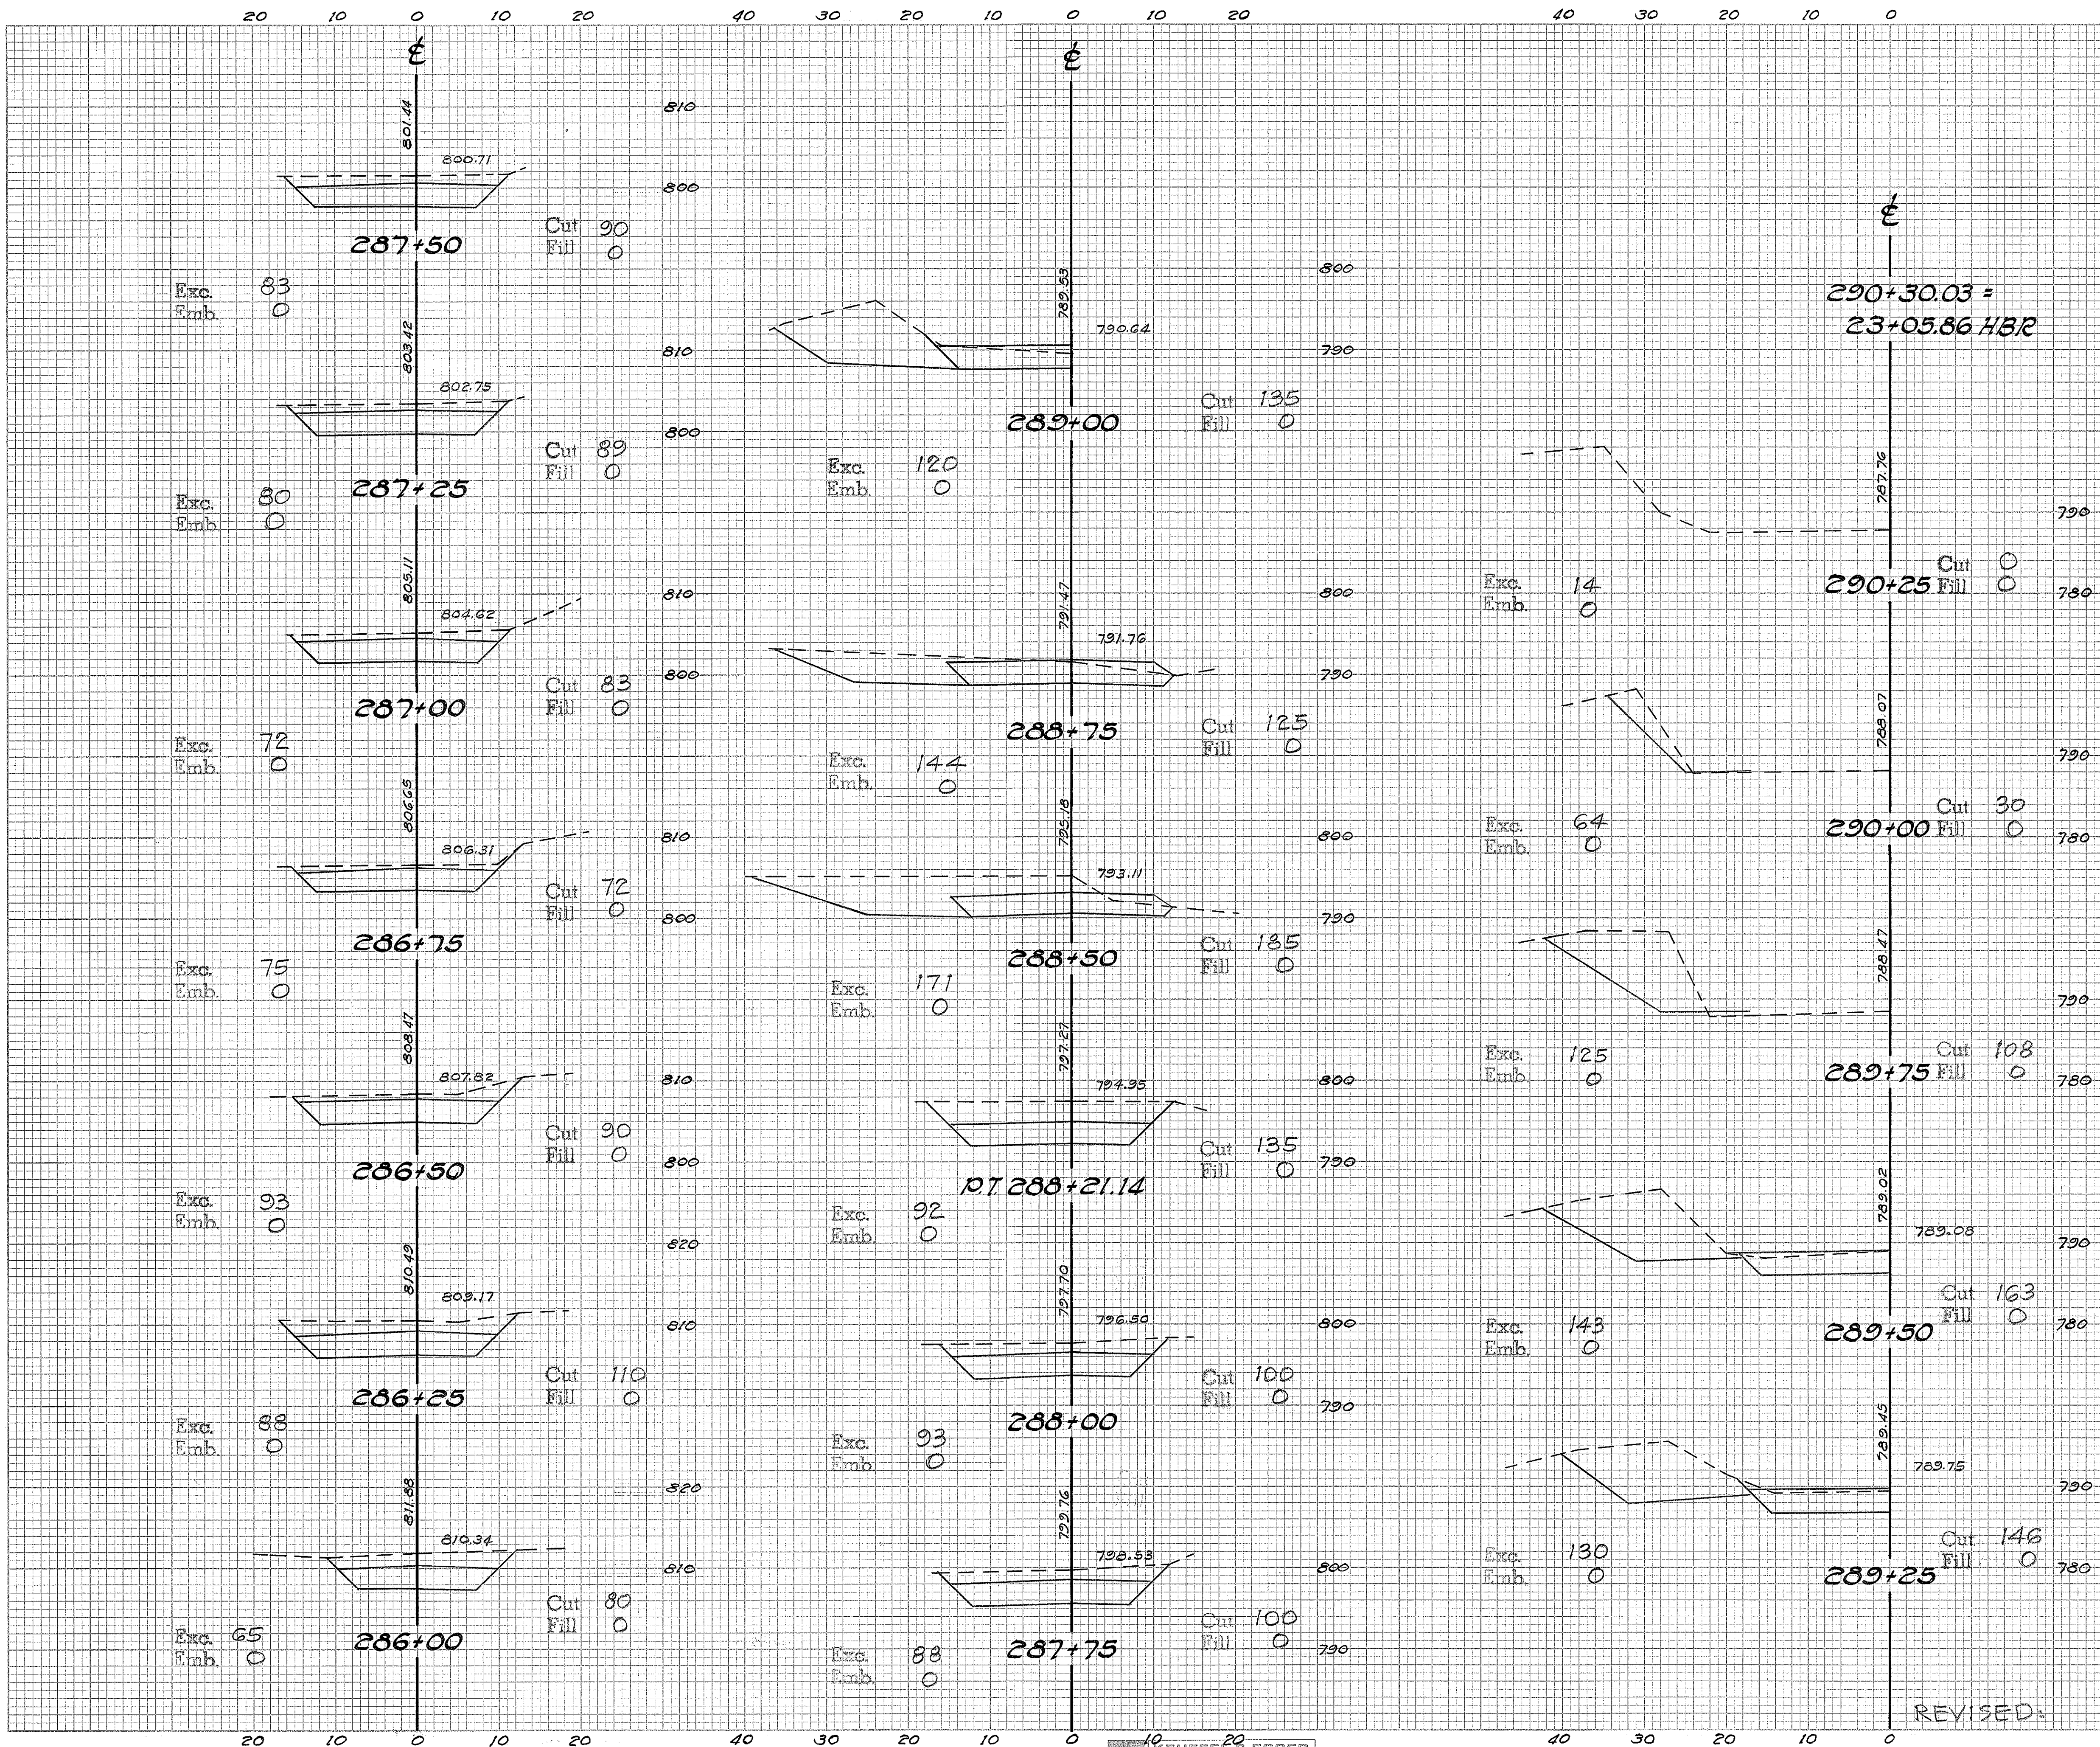

REVISED: