
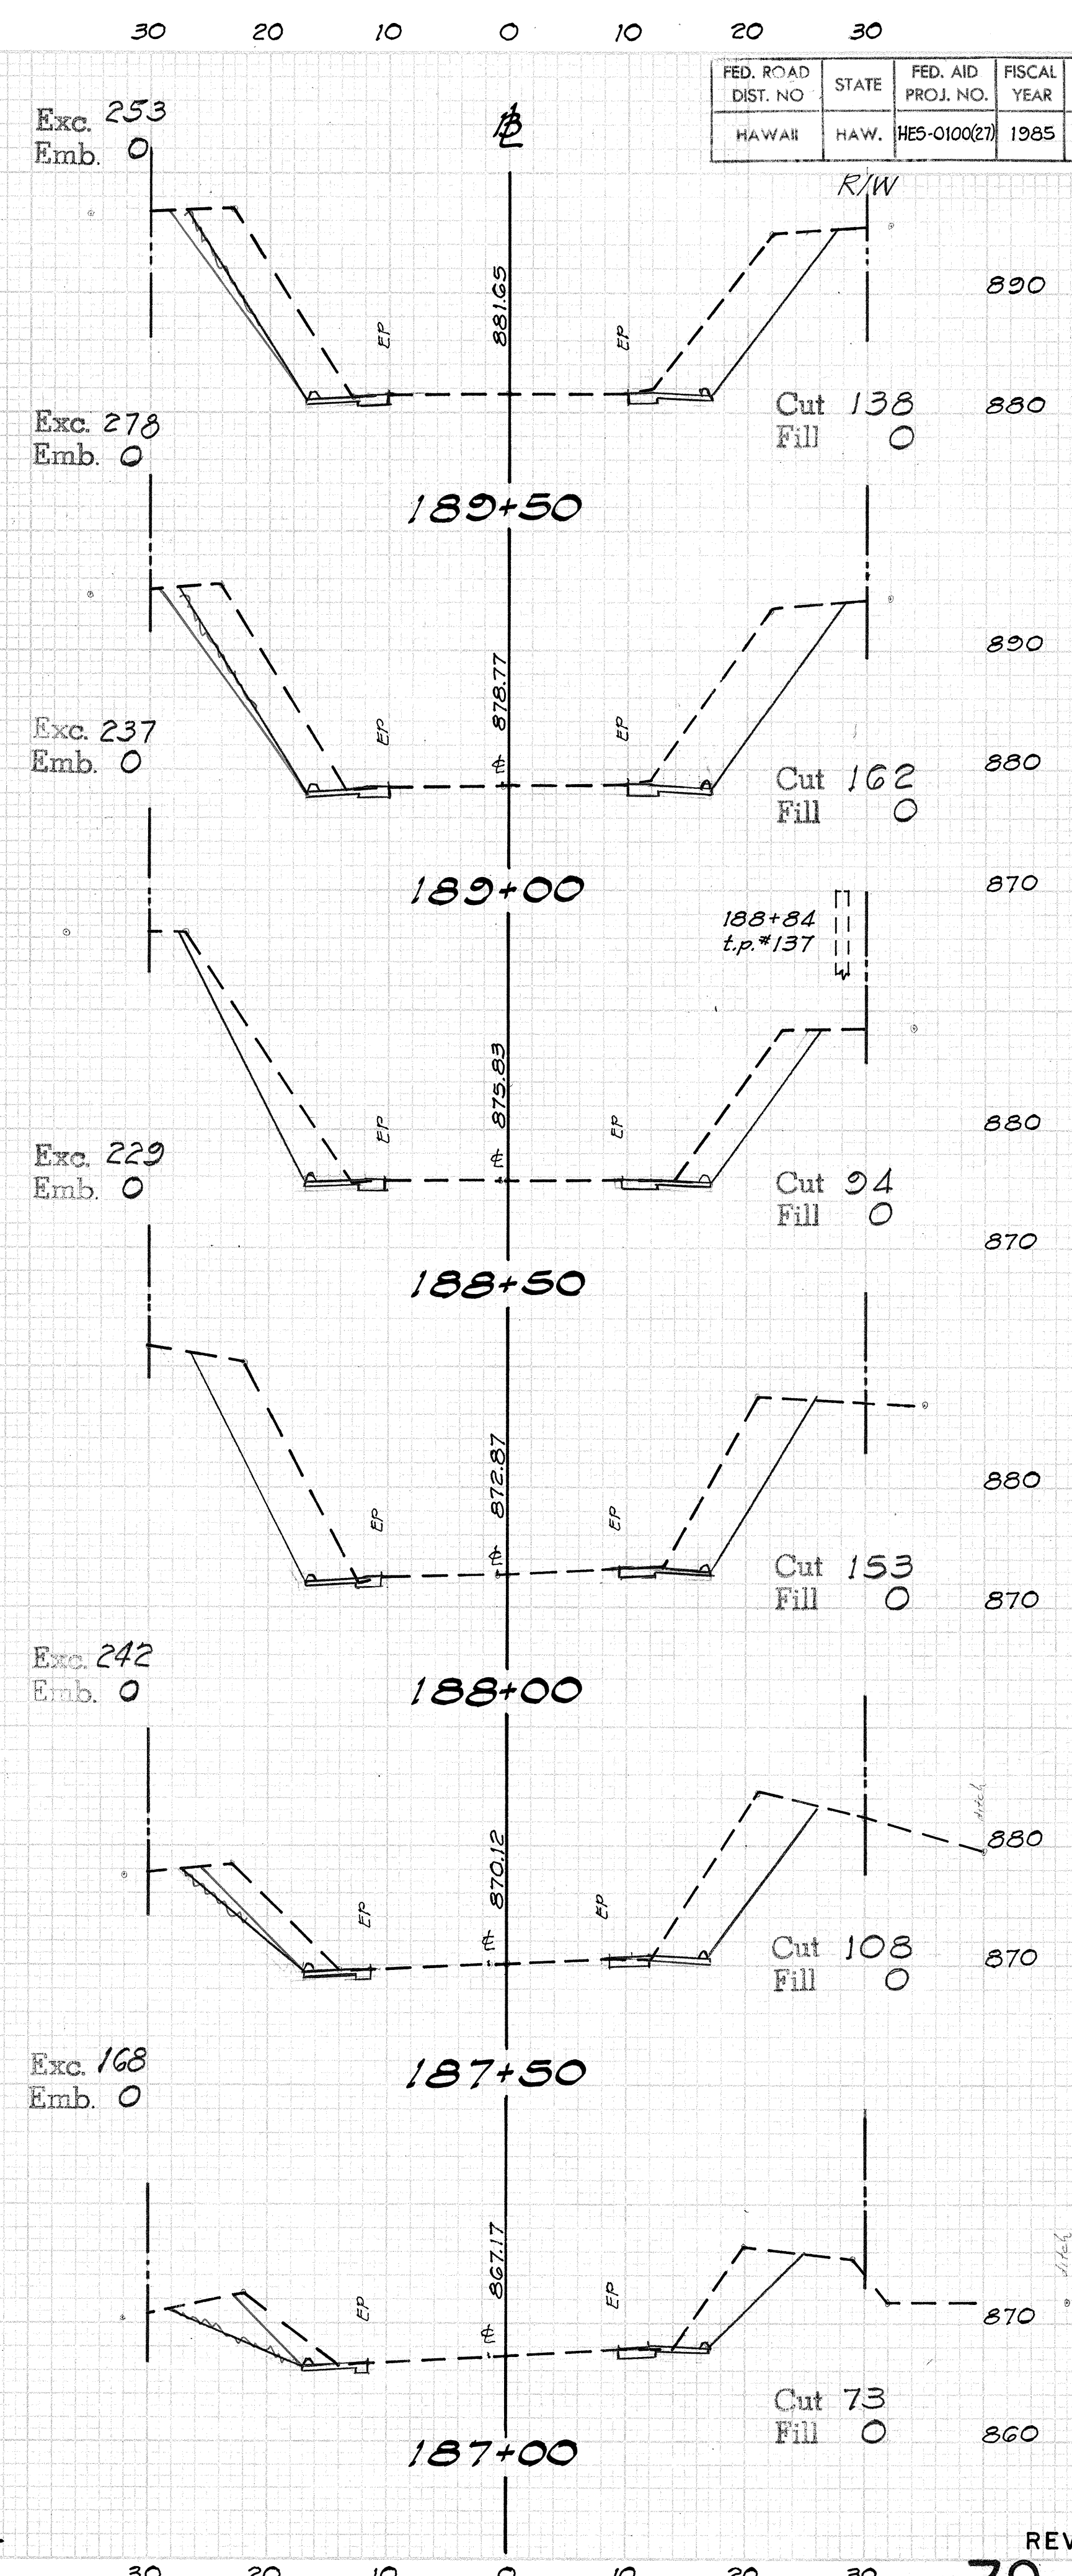
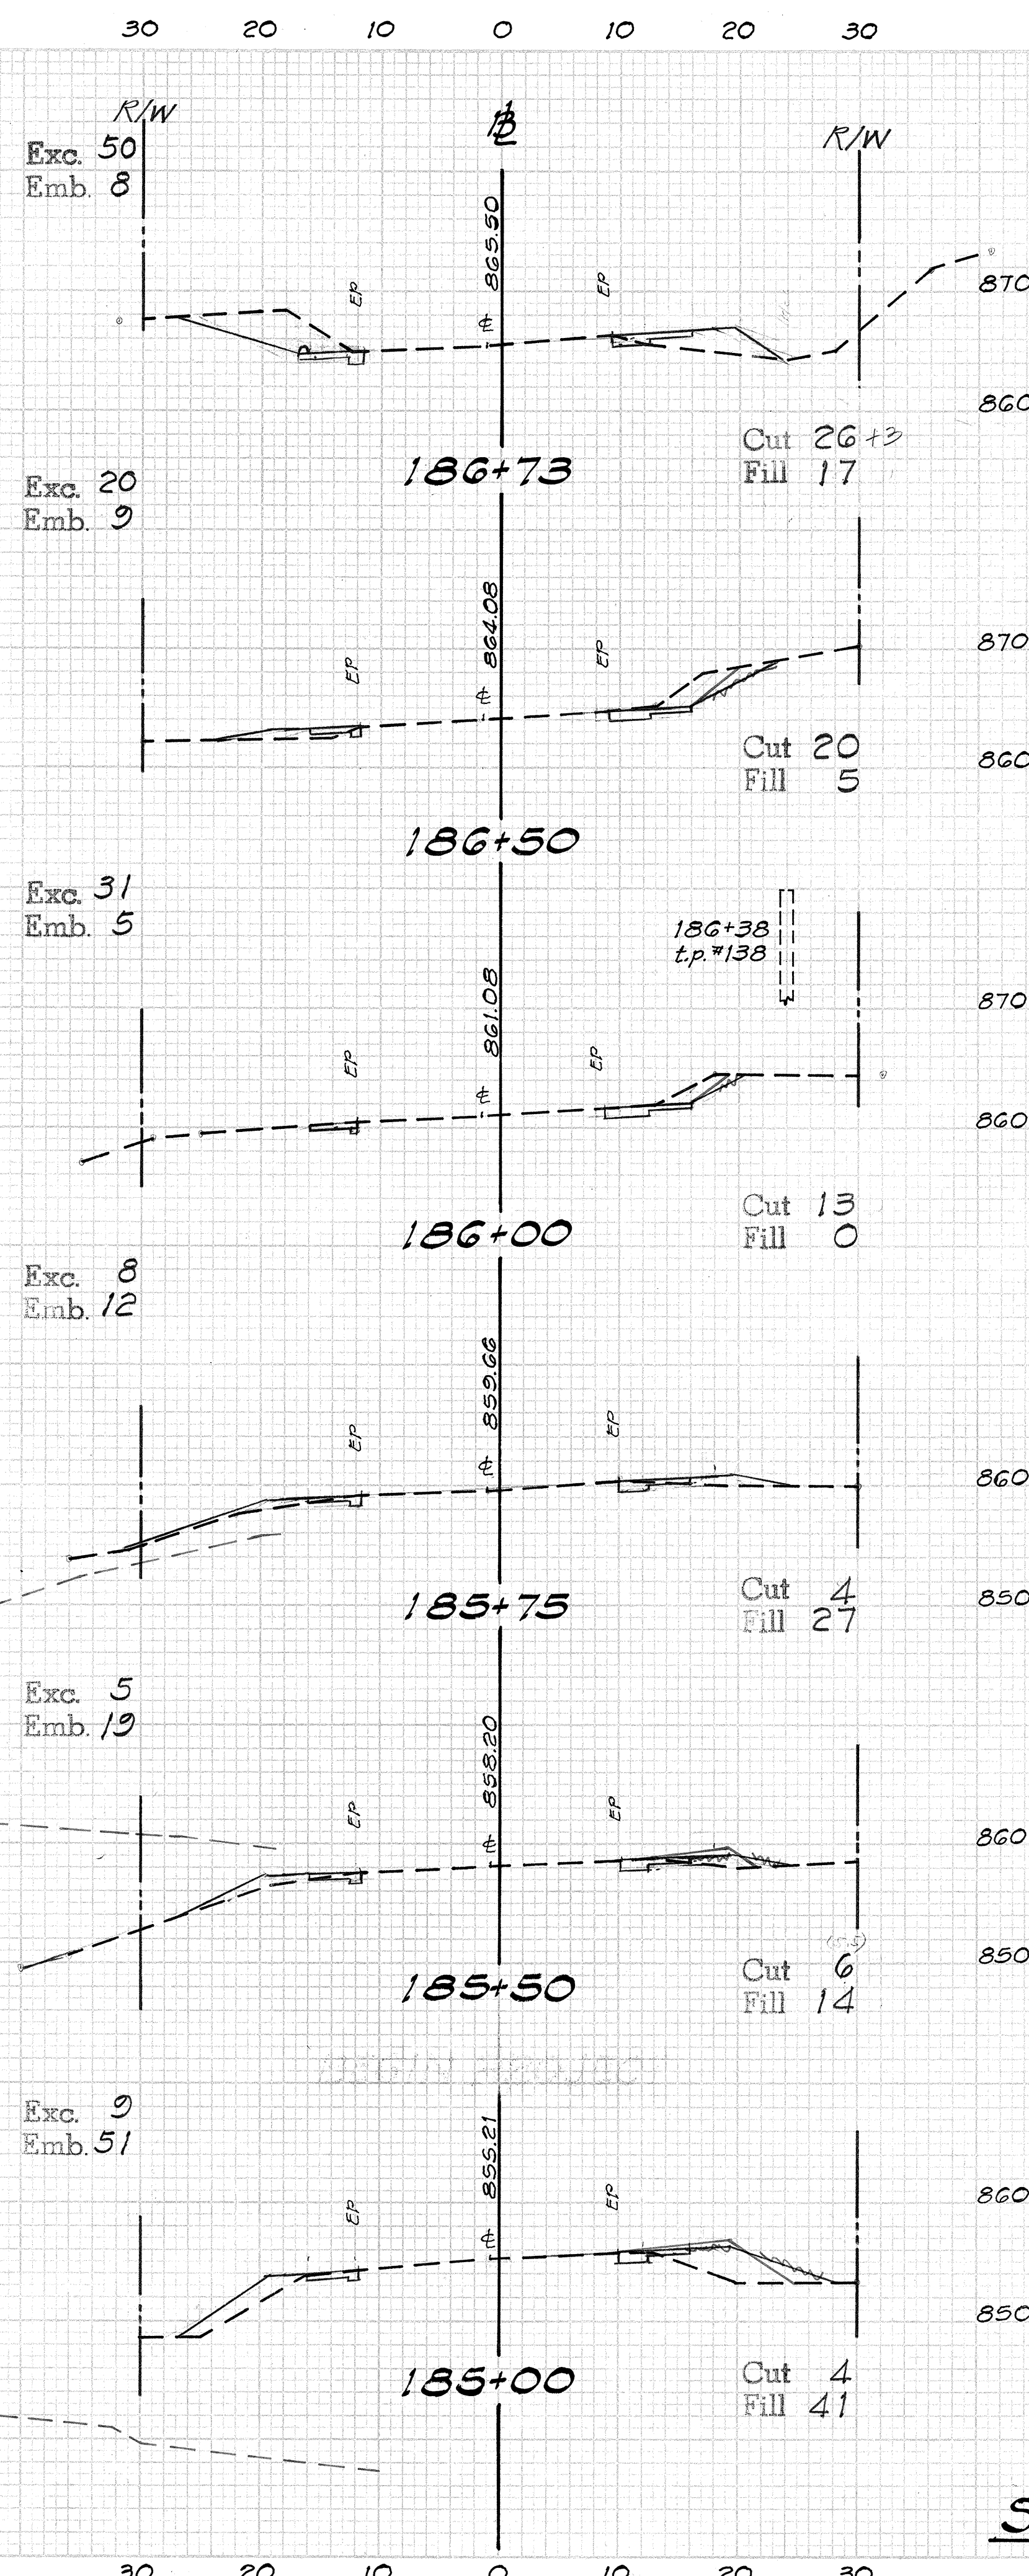


DATE	
BY	
REVIEWED	
DATE	
BY	
REVIEWED	
DATE	
BY	

DATE	Jan. 84
BY	
REVIEWED	
DATE	
BY	
REVIEWED	
DATE	
BY	

FED. ROAD DIST. NO.	STATE	FED. AID PROJ. NO.	FISCAL YEAR	SHEET NO.	TOTAL SHEETS
HAWAII	HAW.	HE5-0100(27)	1985	39	47

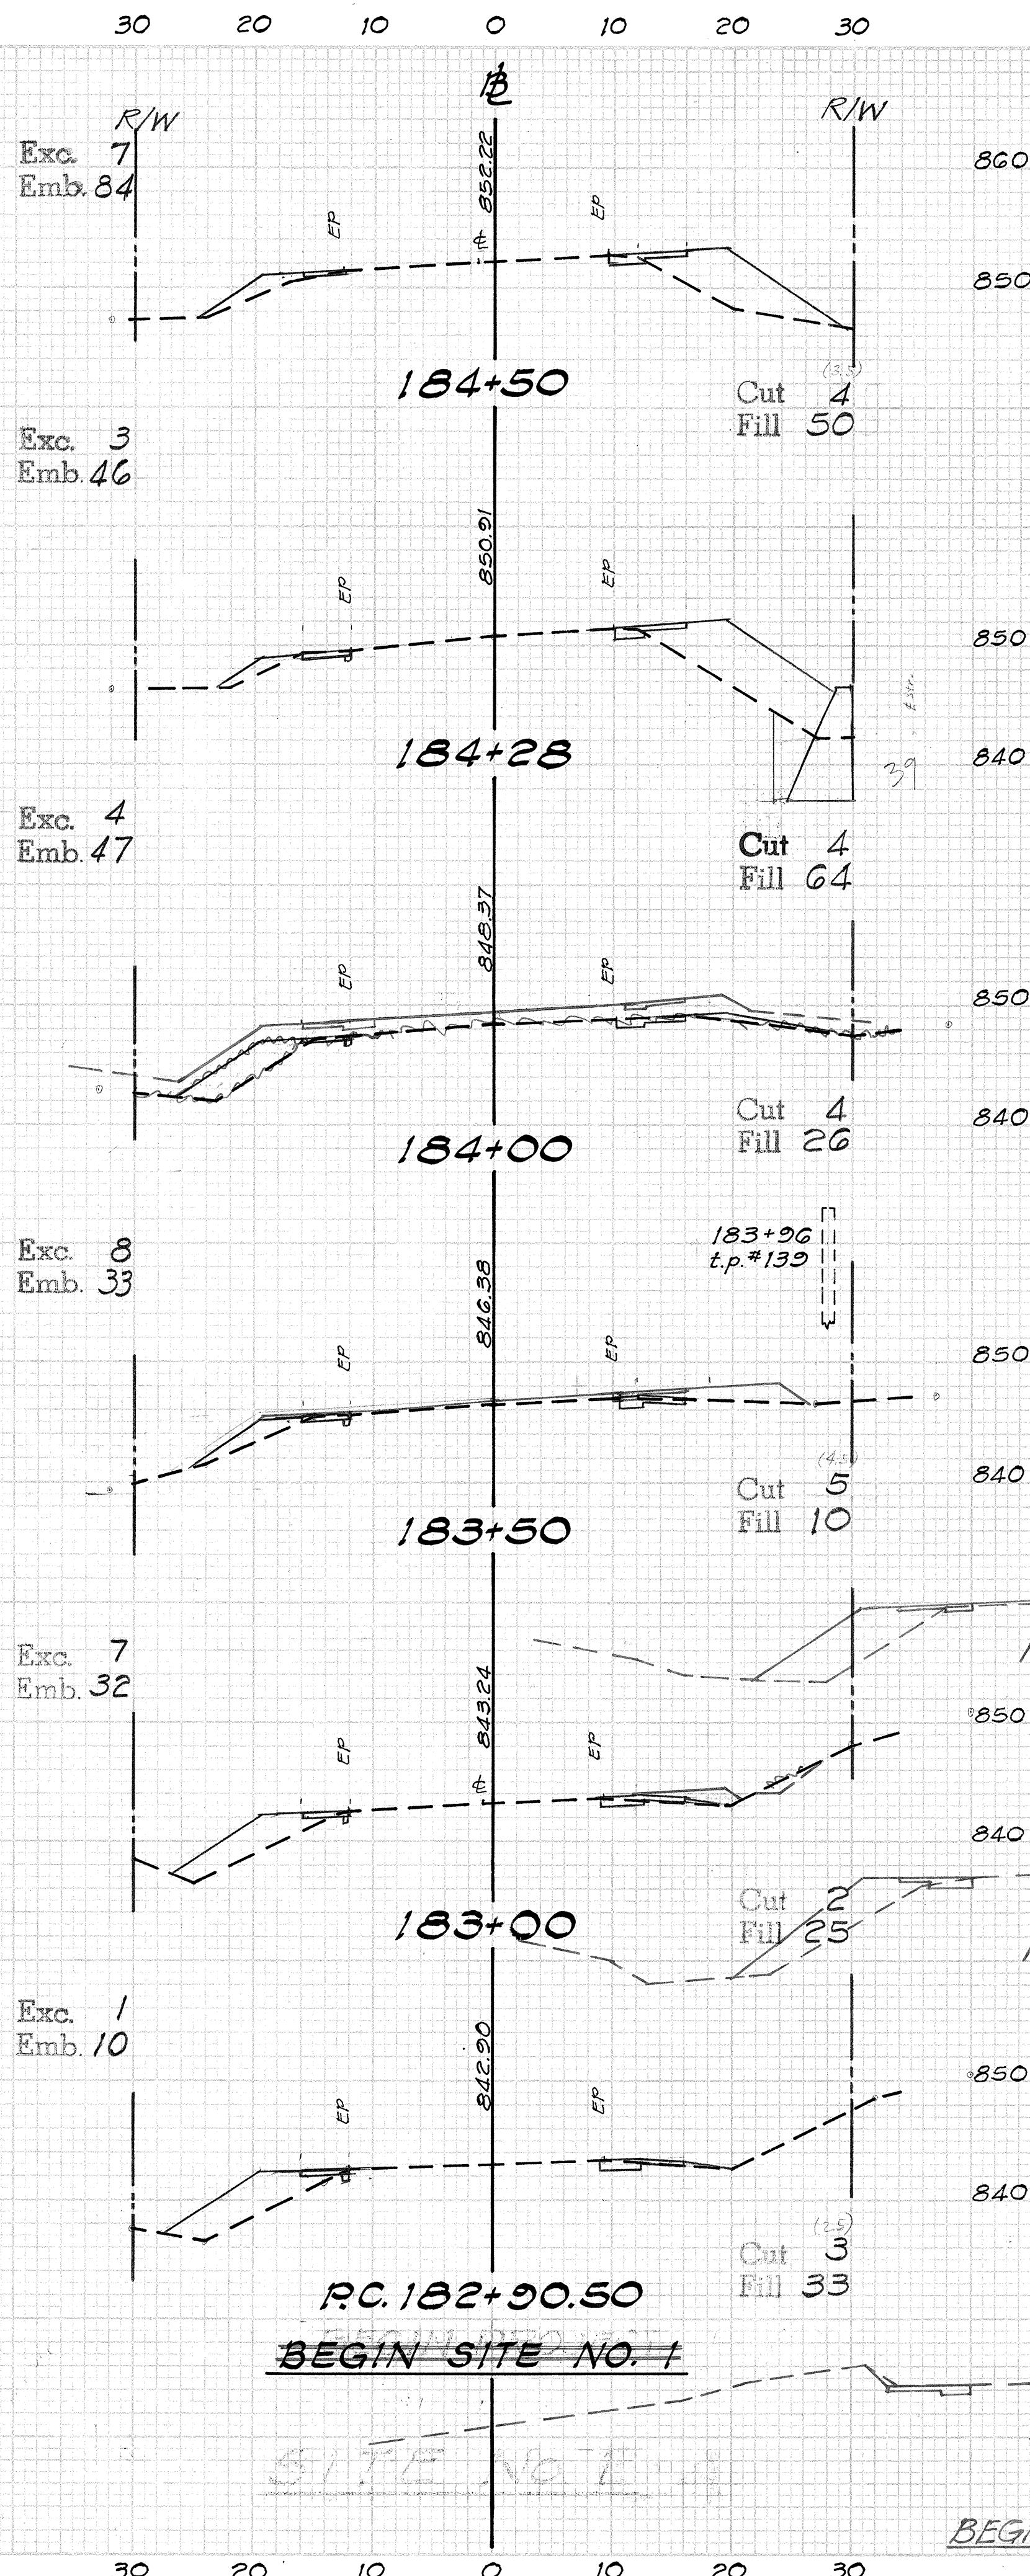


NOT ALL CHANGES POSTED ON CROSS SECTIONS. FOR MINOR REVISIONS TO CROSS SECTIONS AND REVISIONS TO THE GRADES AND QUANTITIES, REFER TO FIELD POSTED "AS-BUILT" WORK-SHEET, PROJECT LEDGER, FIELD MEASUREMENT BOOK AND/OR COMPUTATION BOOK.

SITE No. 1

REVISION I

ORIGINAL SURVEY	SURVEYED	BY	DATE
NOTE BOOK	PLOTTED		Jan. '84
TEMPLATE			
AREAS			
AREAS CHECKED			
# 1288 /			
10-14			



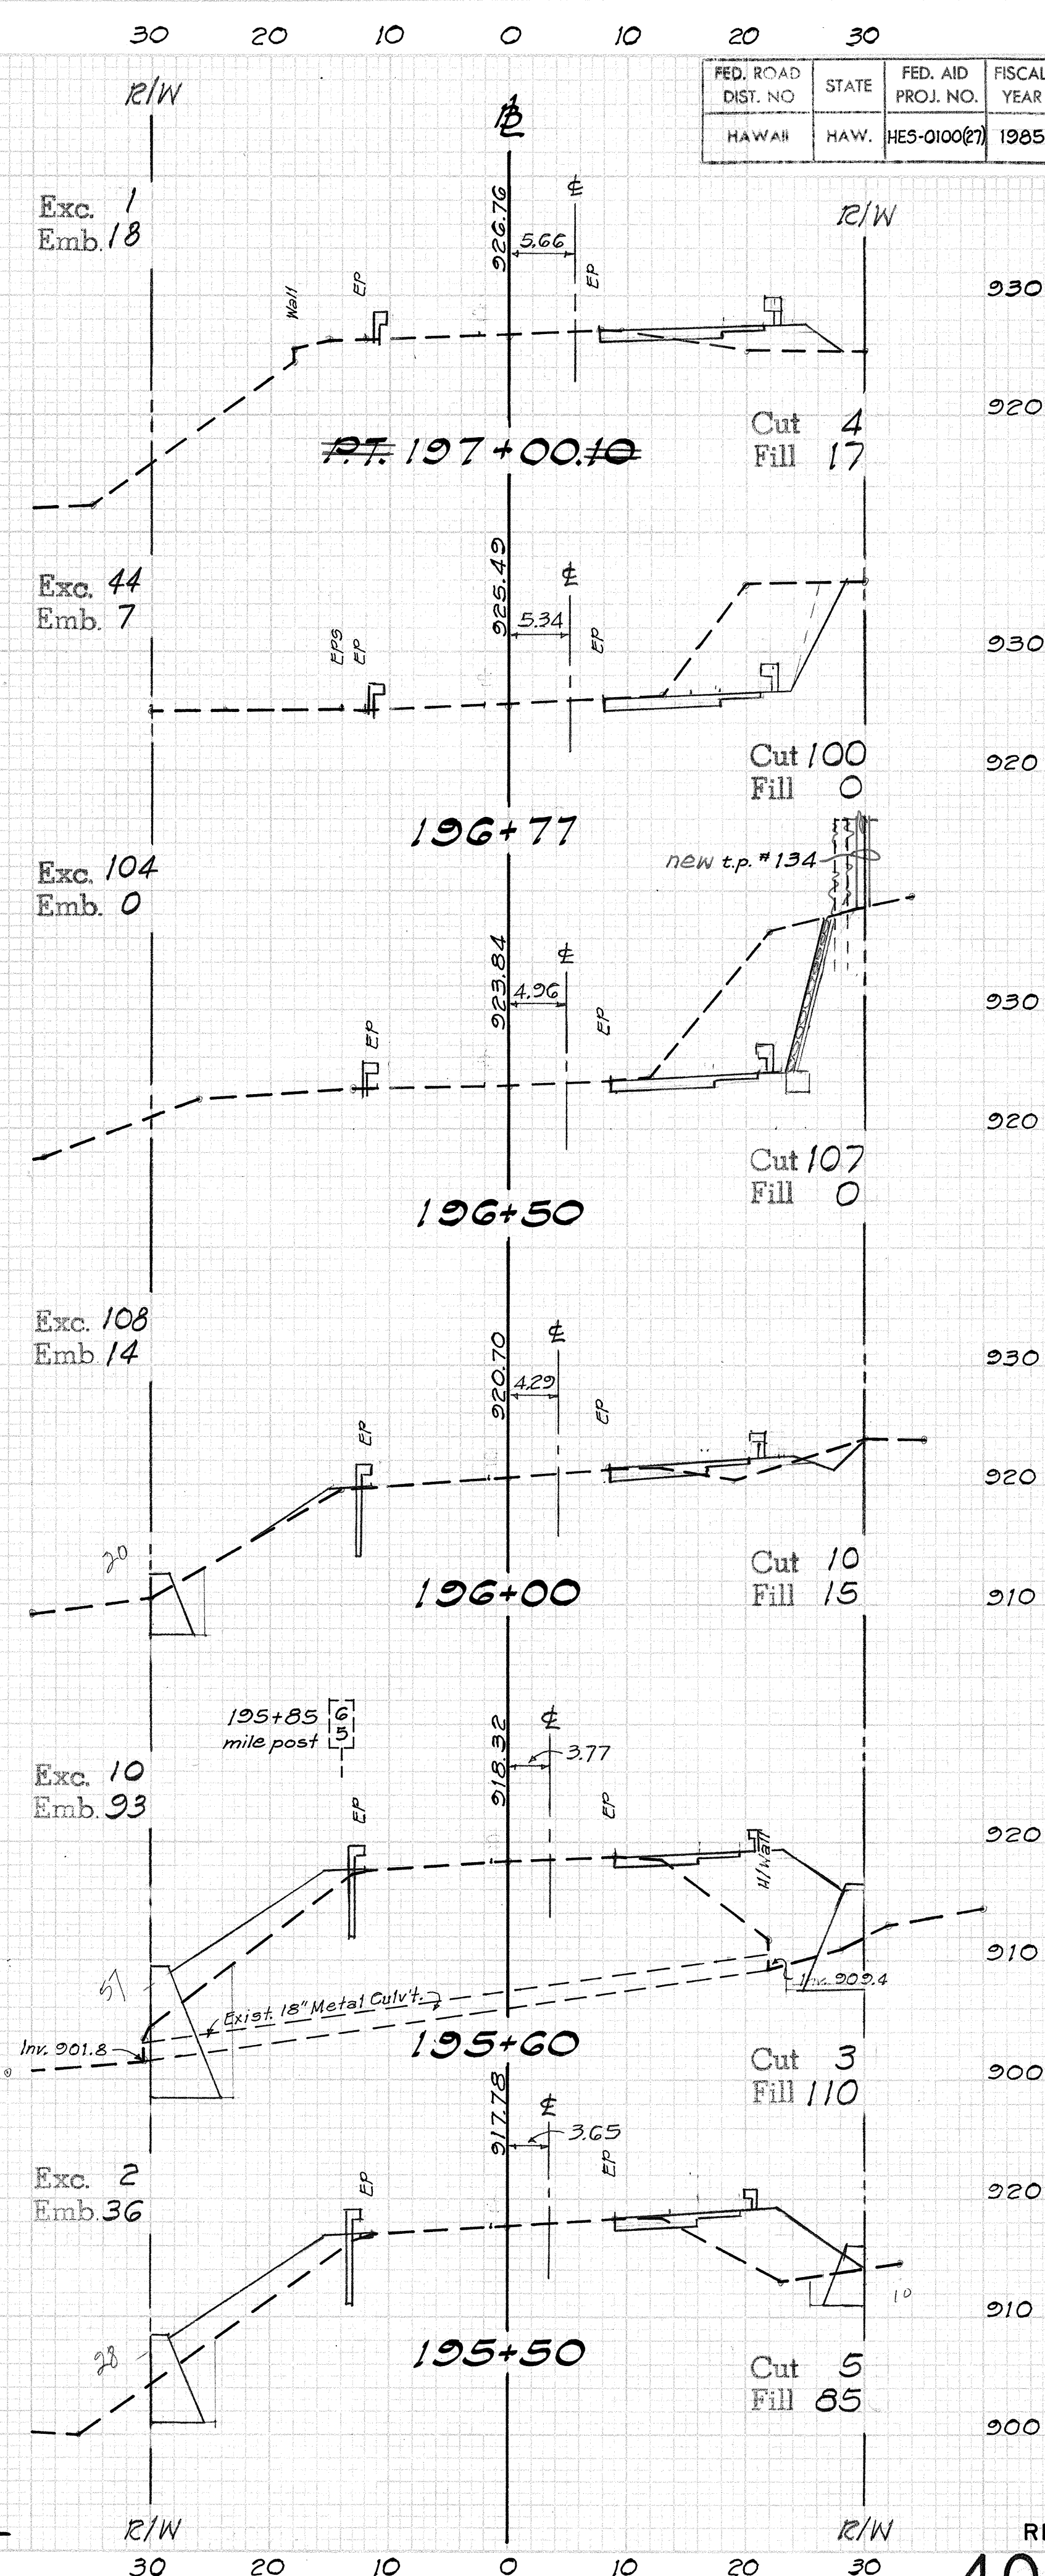


REVISION 1

DATE	
BY	
SURVEYED	
NOTED	
TEMA	
AREAS	
AREAS	
AREAS	

DATE	Jan 84
BY	
SURVEYED	
NOTED	
TEMA	
AREAS	
AREAS	
AREAS	

FED. ROAD DIST. NO.	STATE	FED. AID PROJ. NO.	FISCAL YEAR	SHEET NO.	TOTAL SHEETS
HAWAII	HAW.	HES-0100(27)	1985	41	47

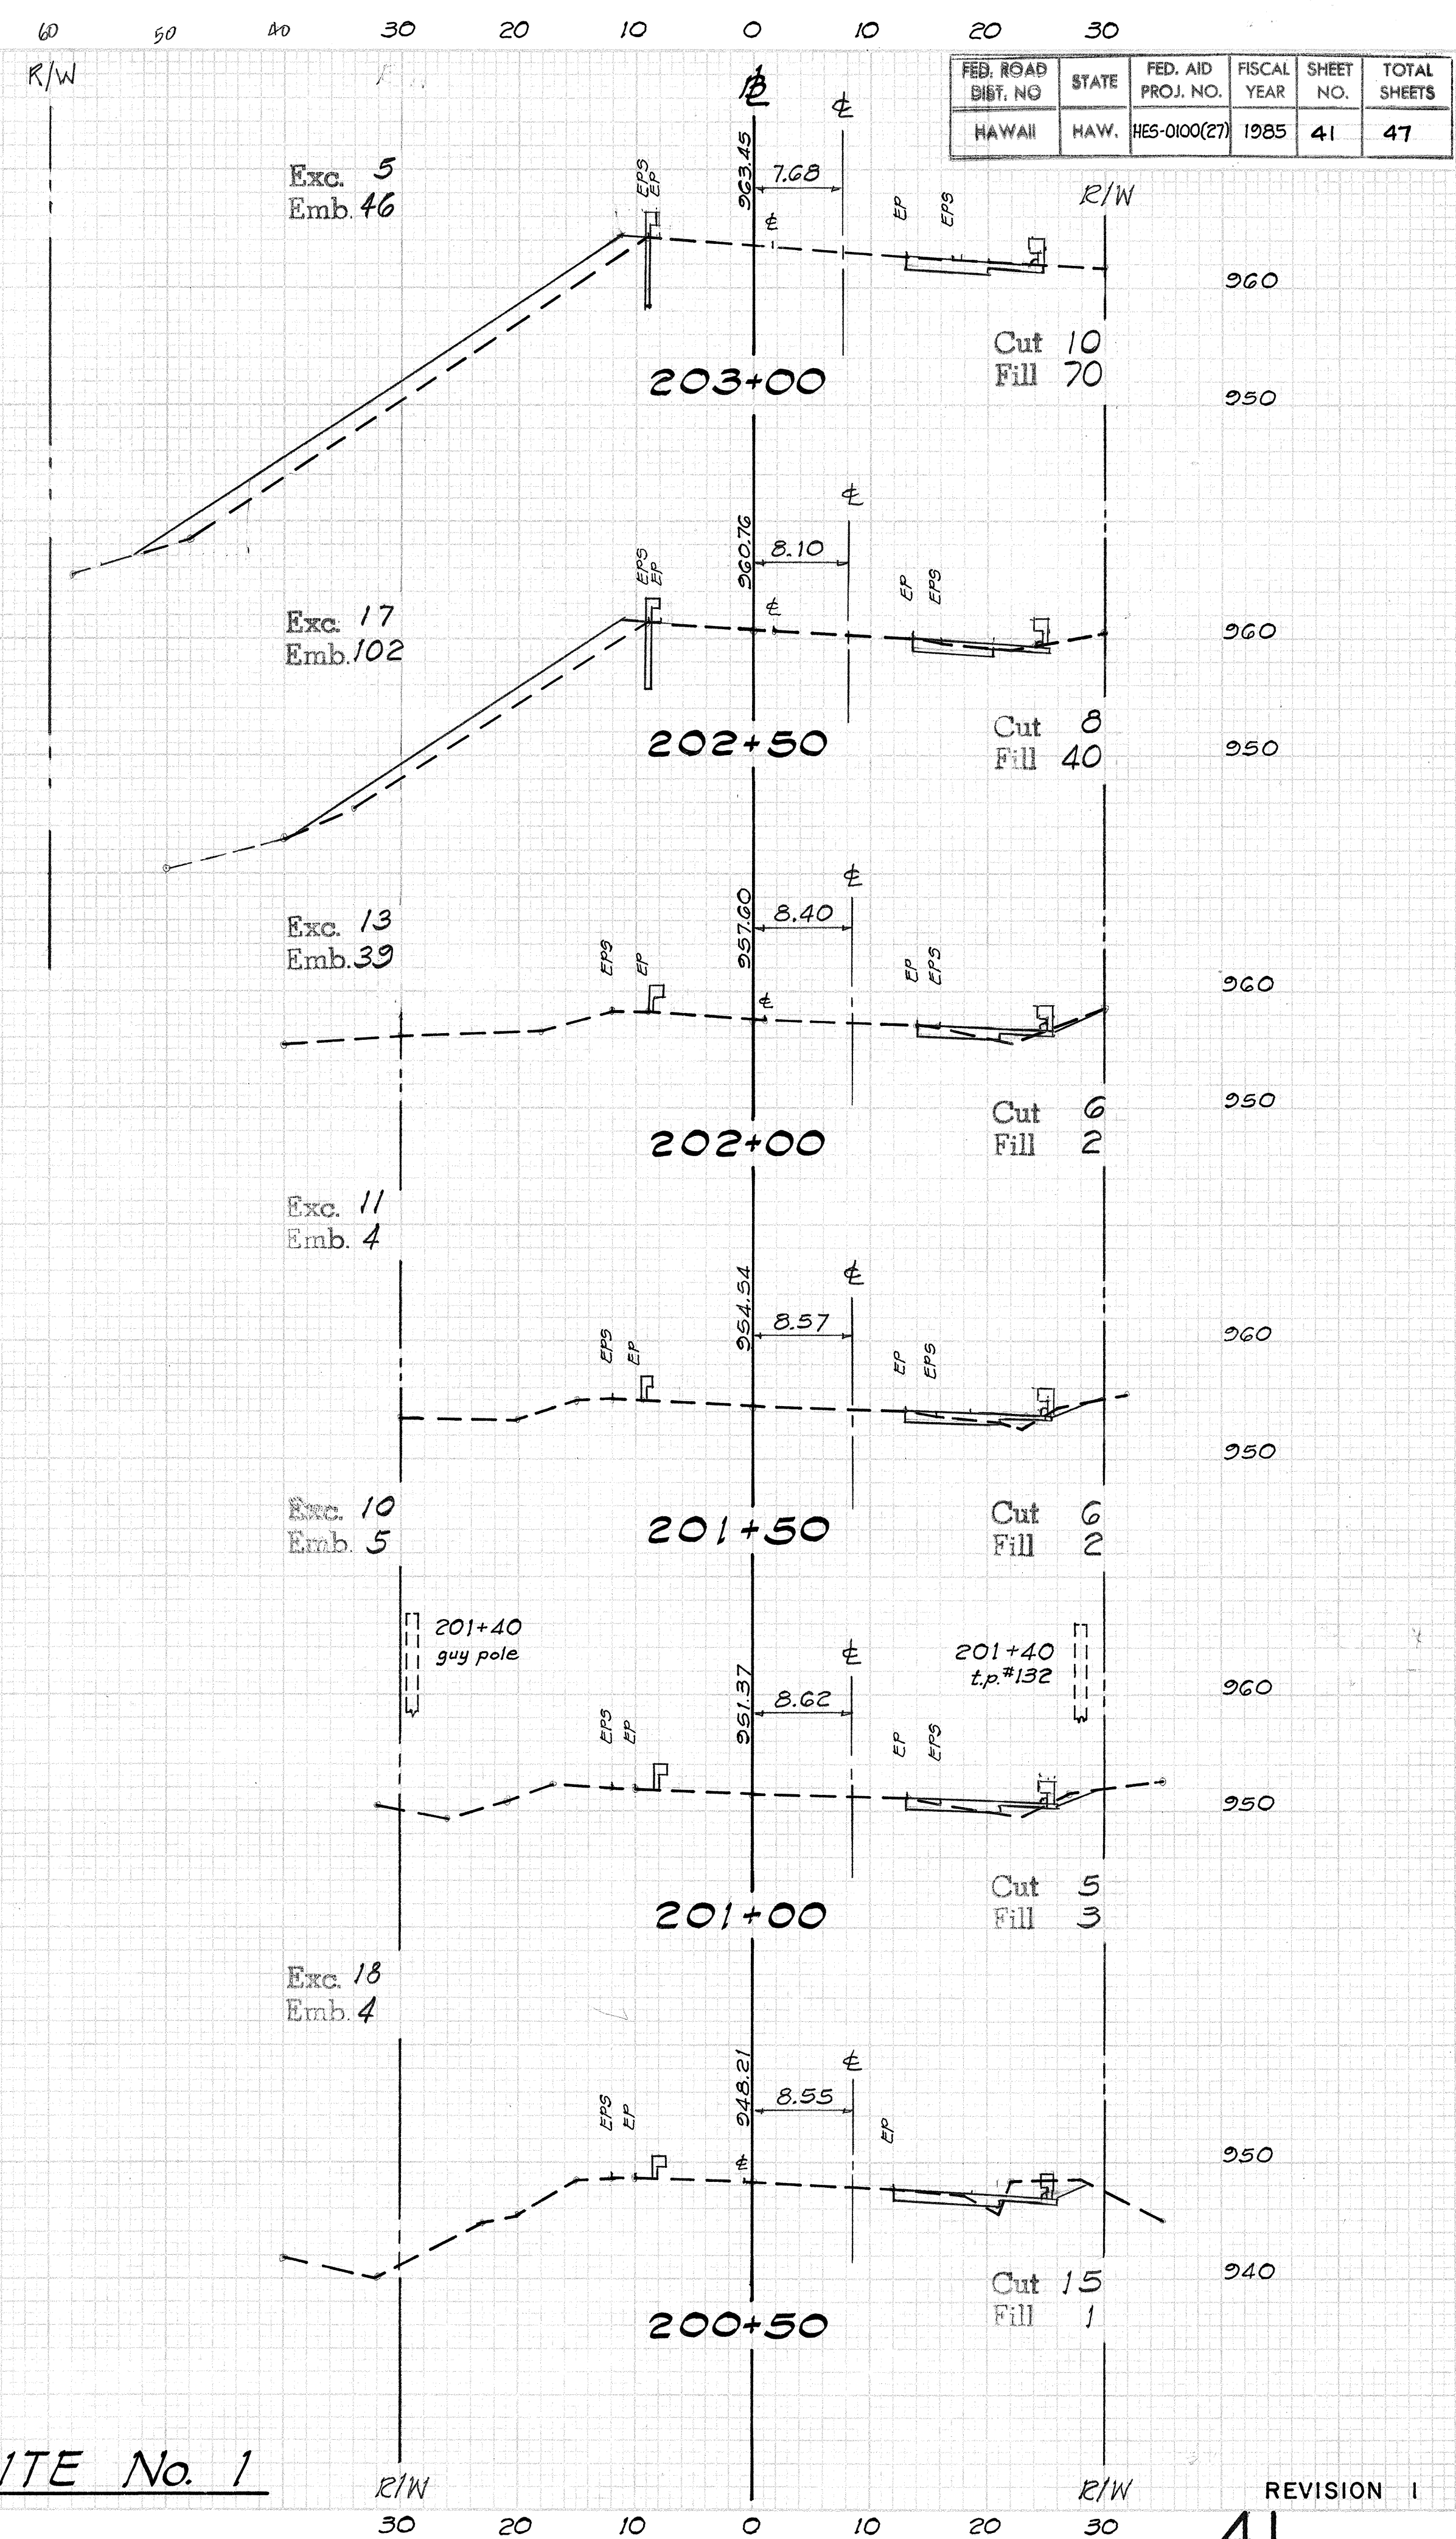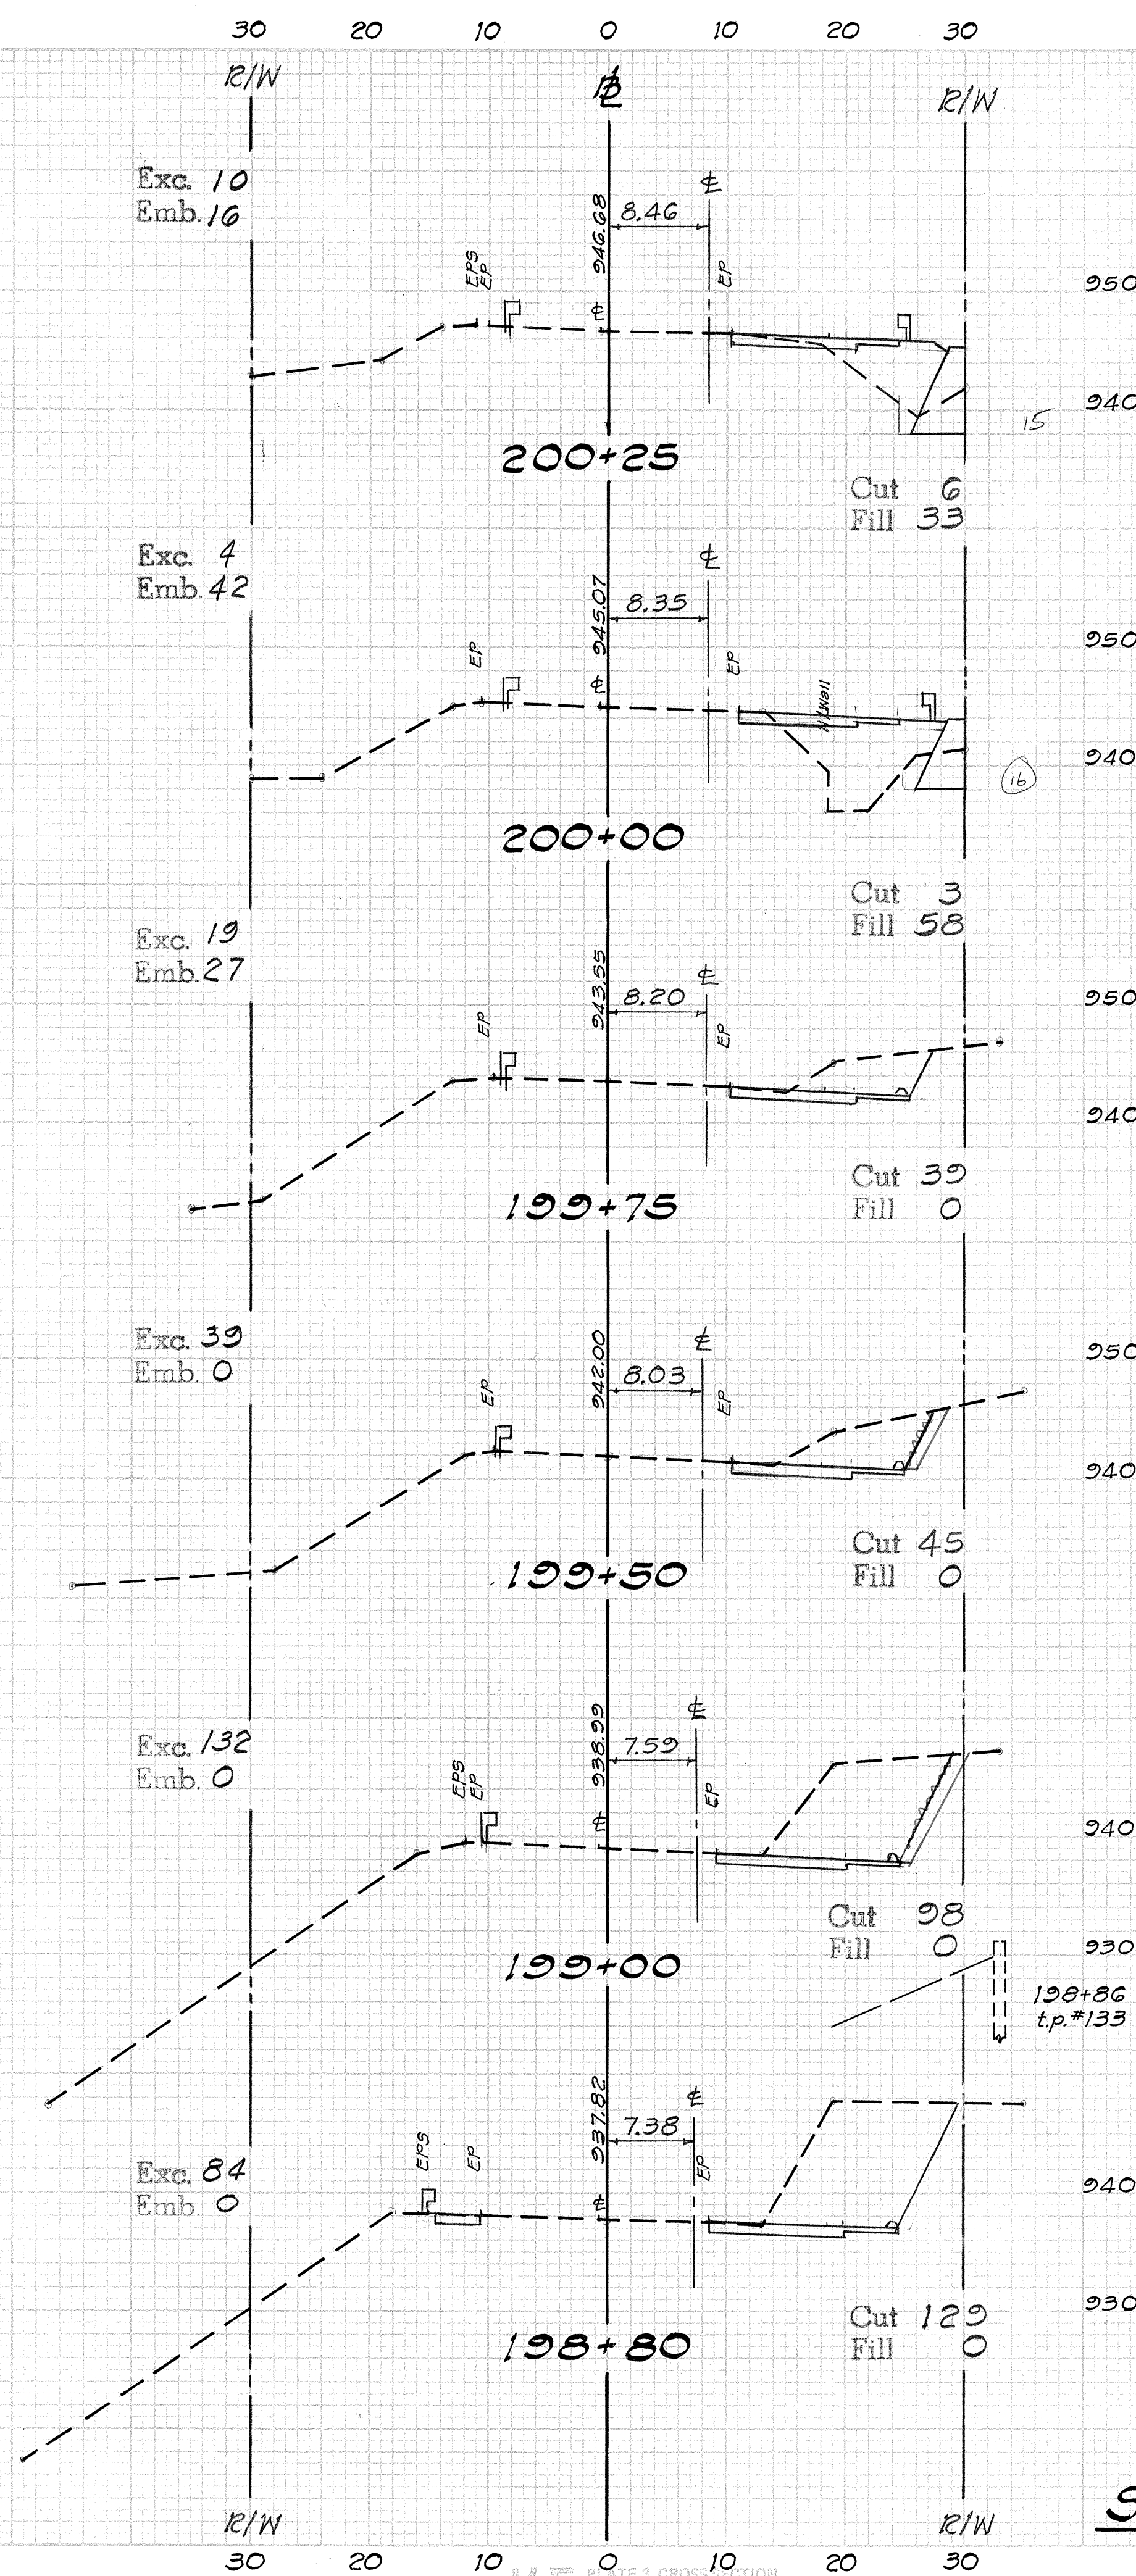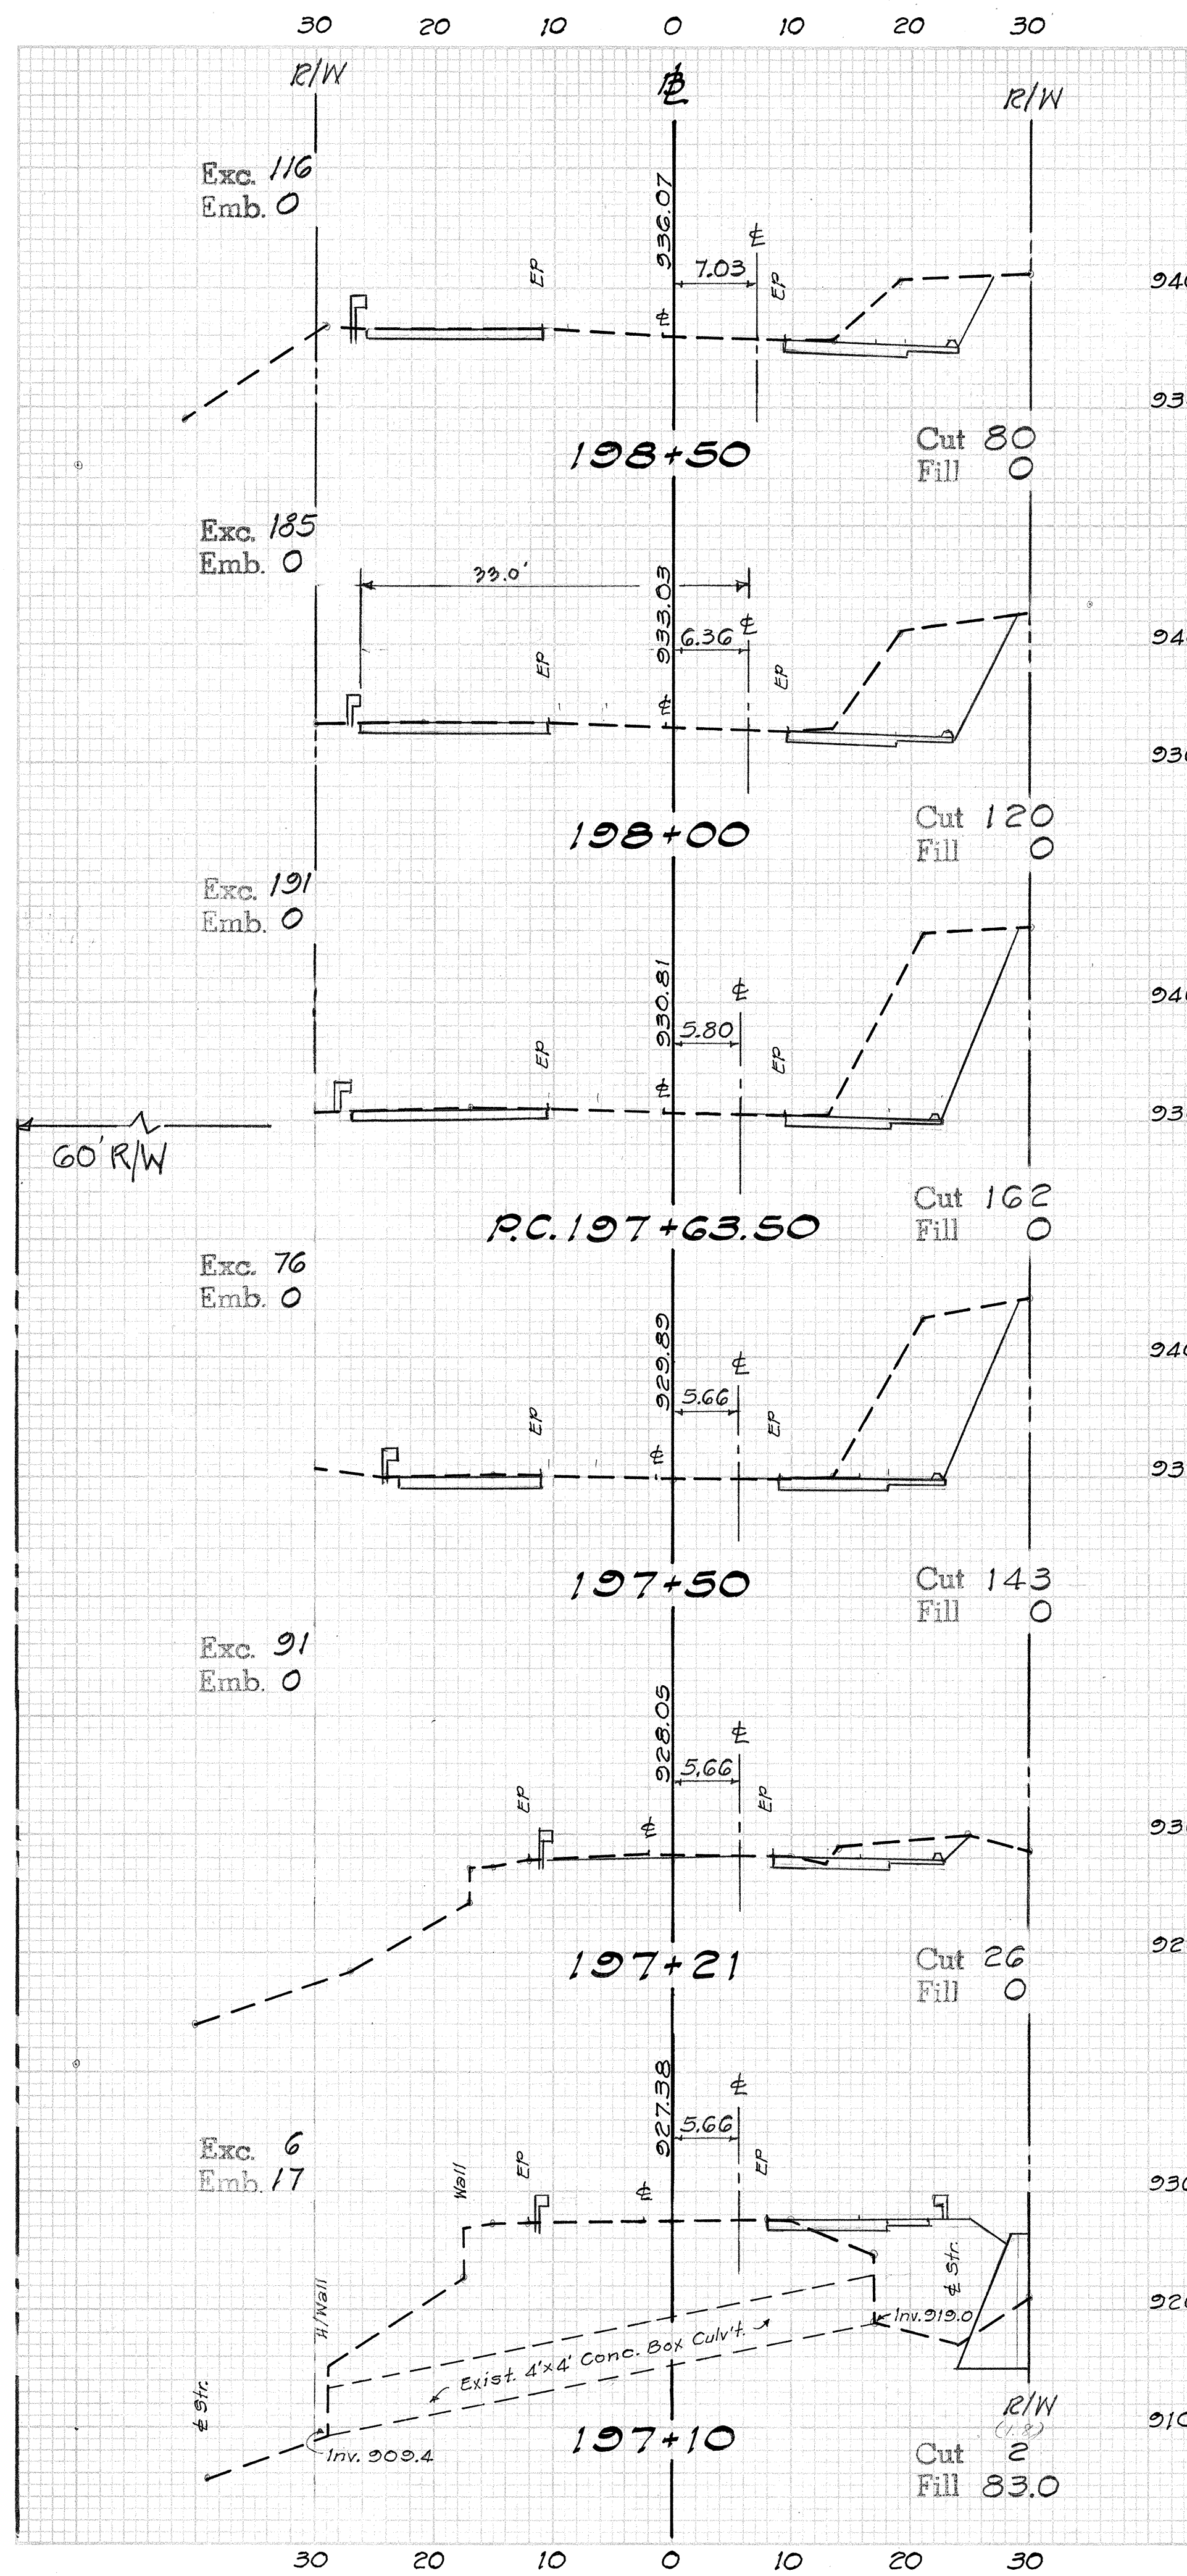


SITE No. 1

REVISION 1

41

48 7556 MADE IN U.S.A.

ORIGINAL	SURVEYED	BY	DATE
SURVEY			
NOTE BOOK	PLATTED		Jan 24
	TEMPLATE		
	AREAS		
#1298 /	AREAS CHECKED		
18-22			



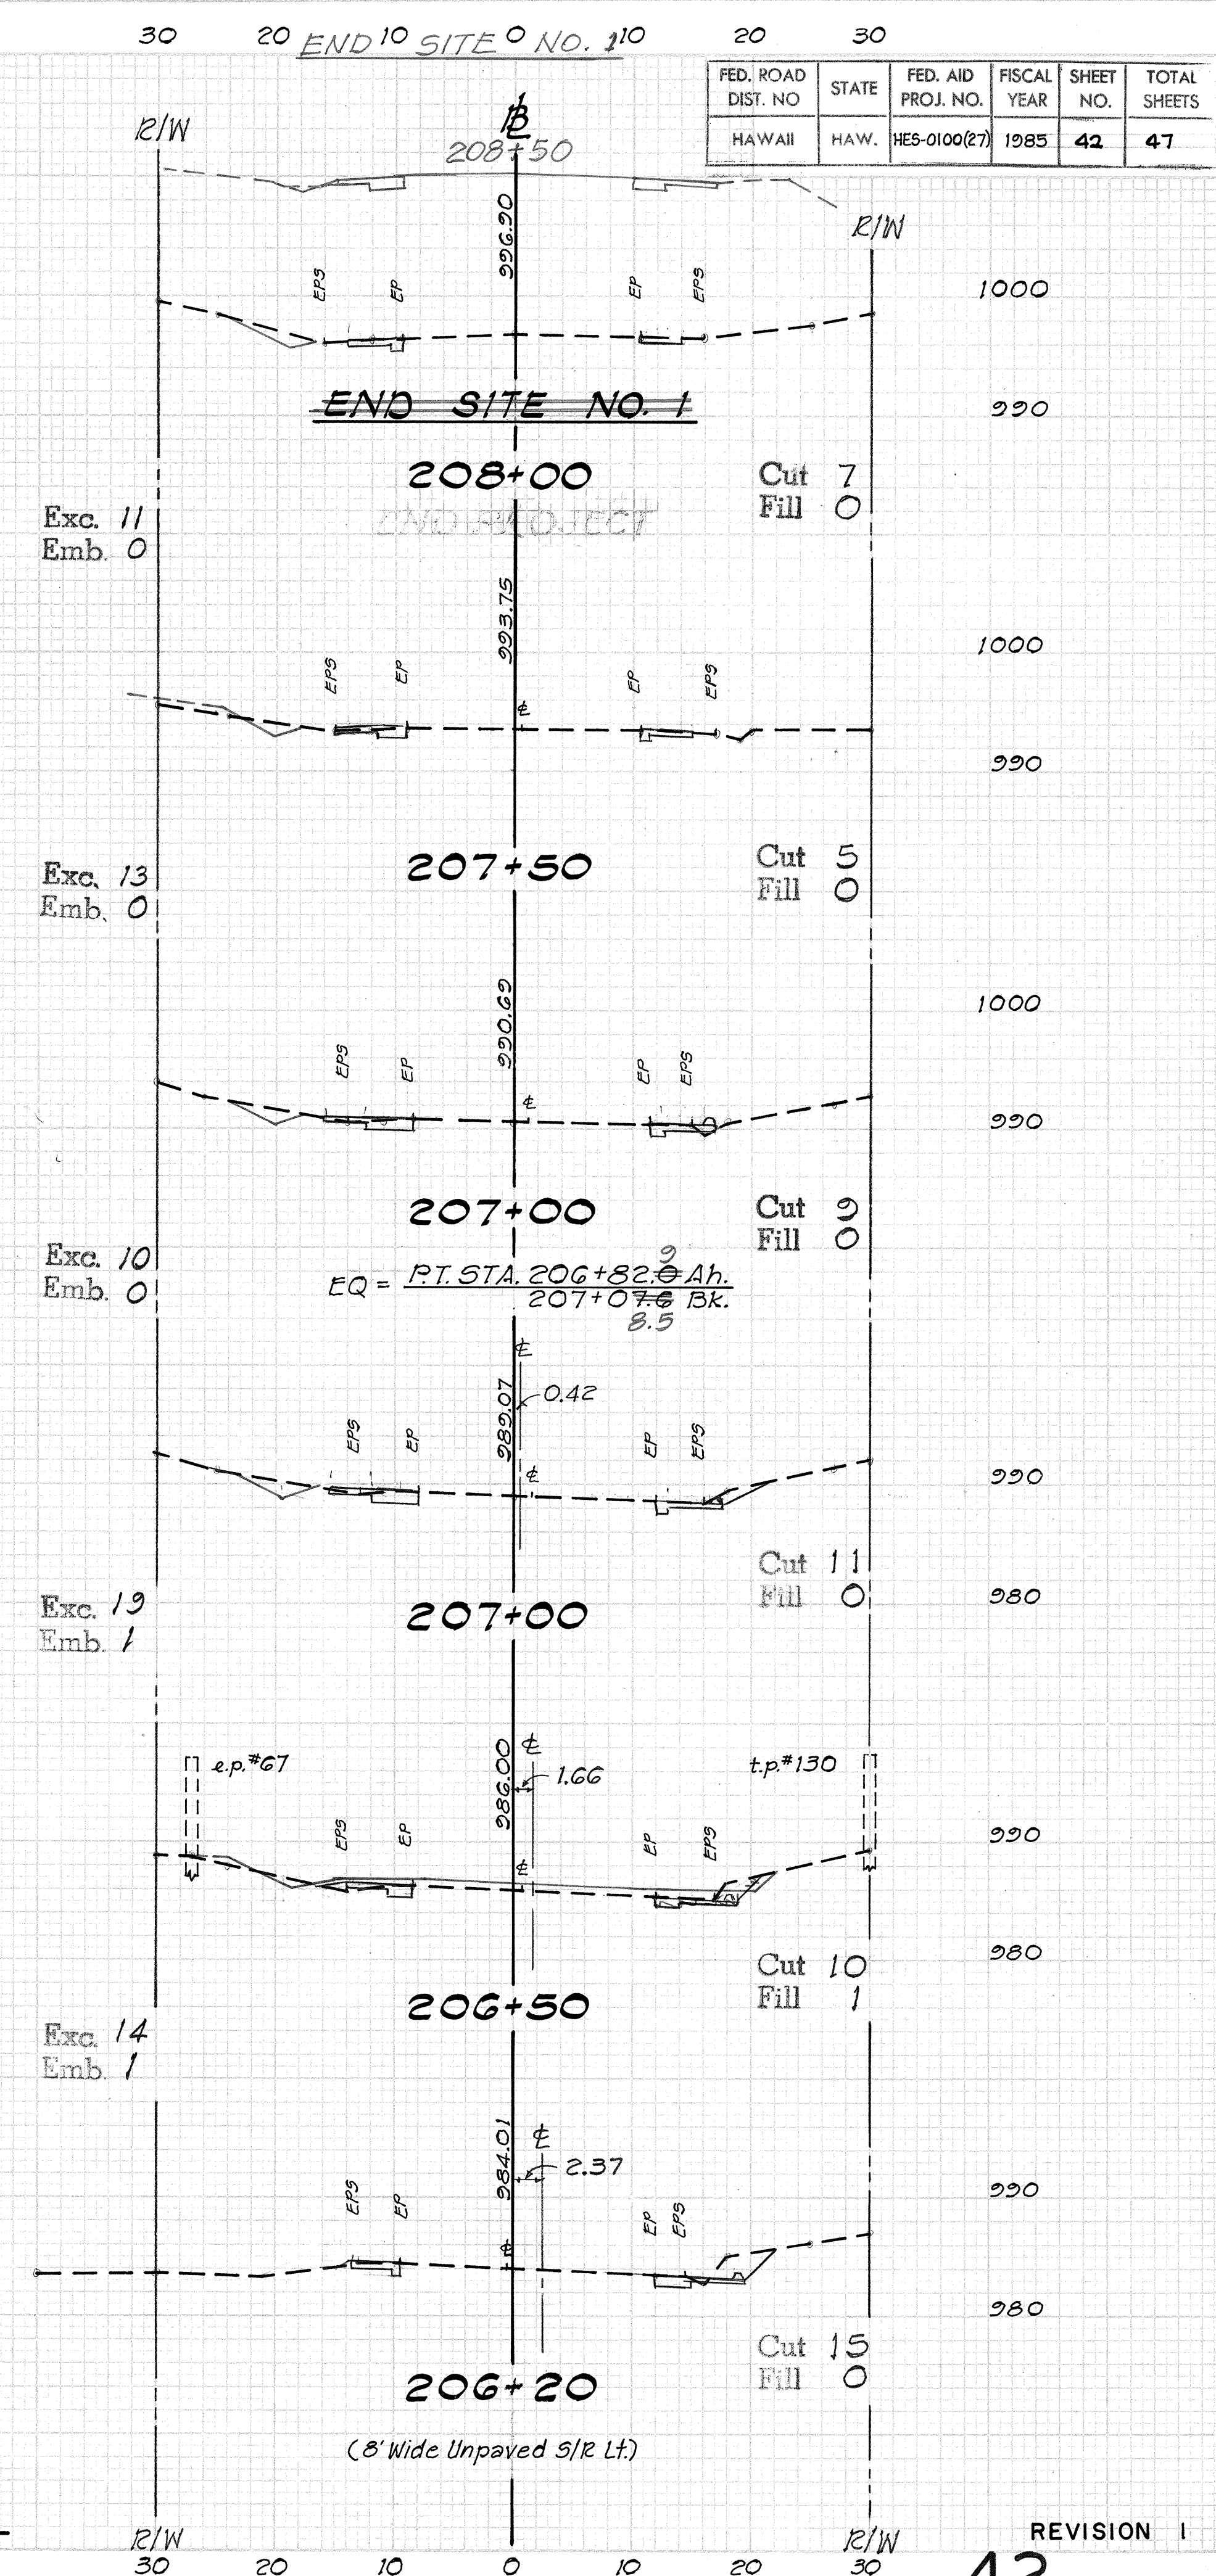


REVISION 1


FINAL SURVEY PLOTTED DATE BY NO. 28-61 AREAS CHECKED

ORIGINAL SURVEY PLOTTED DATE BY NO. 28-61 AREAS CHECKED

FED. PROJ. NO.	STATE	FED. AID PROJ. NO.	FISCAL YEAR	SHEET NO.	TOTAL SHEETS
HAWAII	HAW.	HE5-0100(27)	1985	43	47

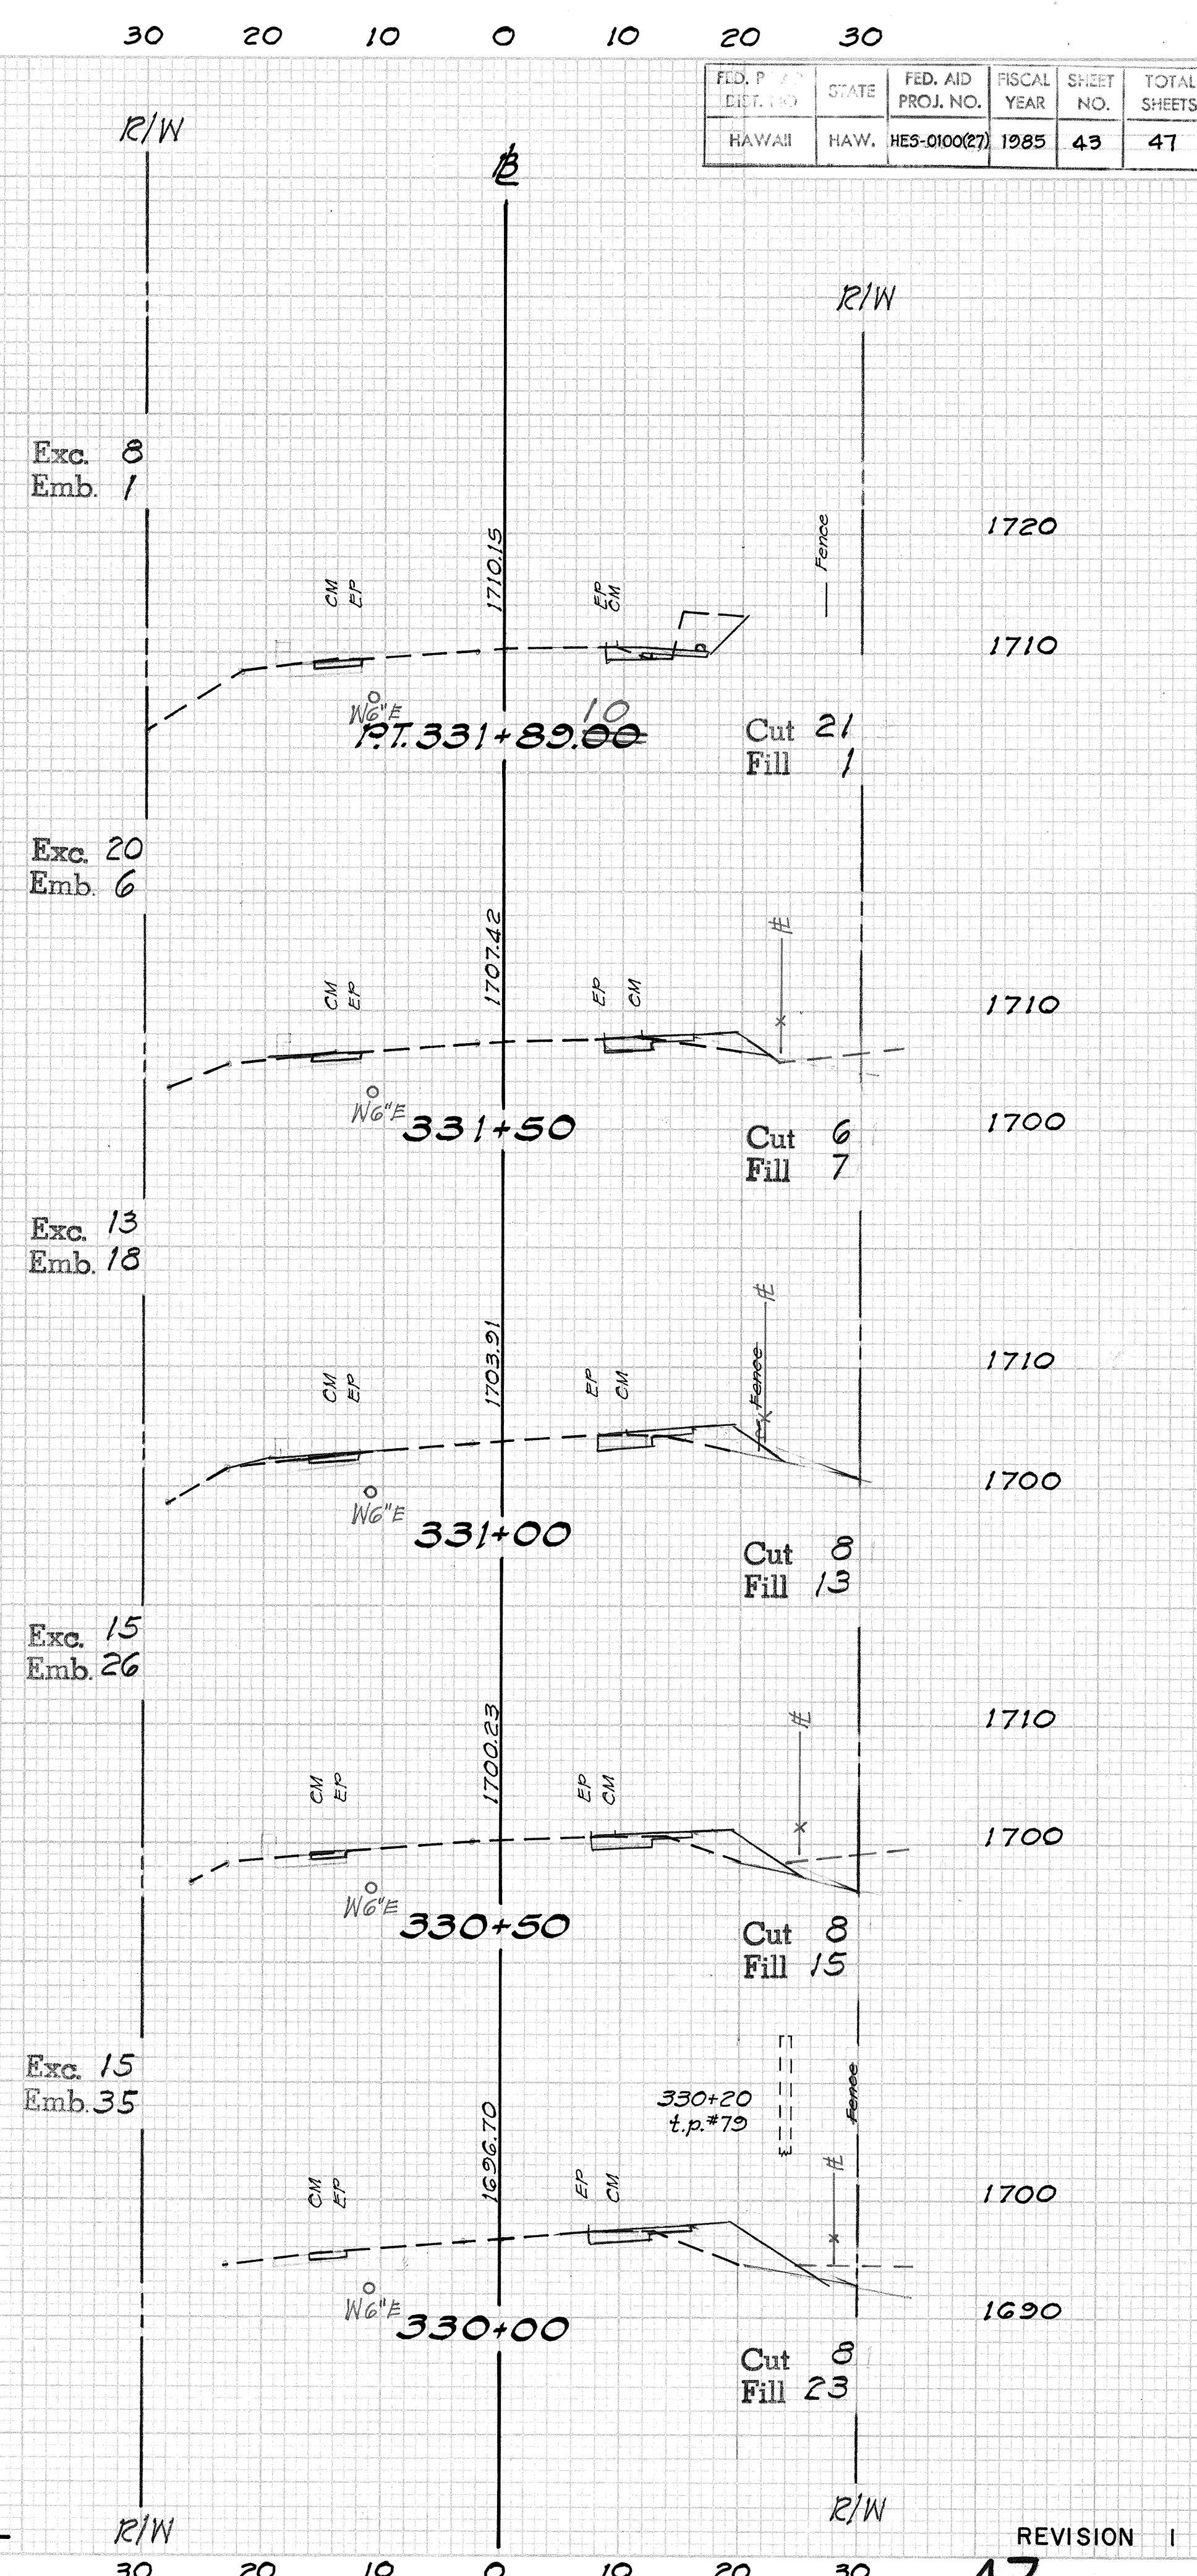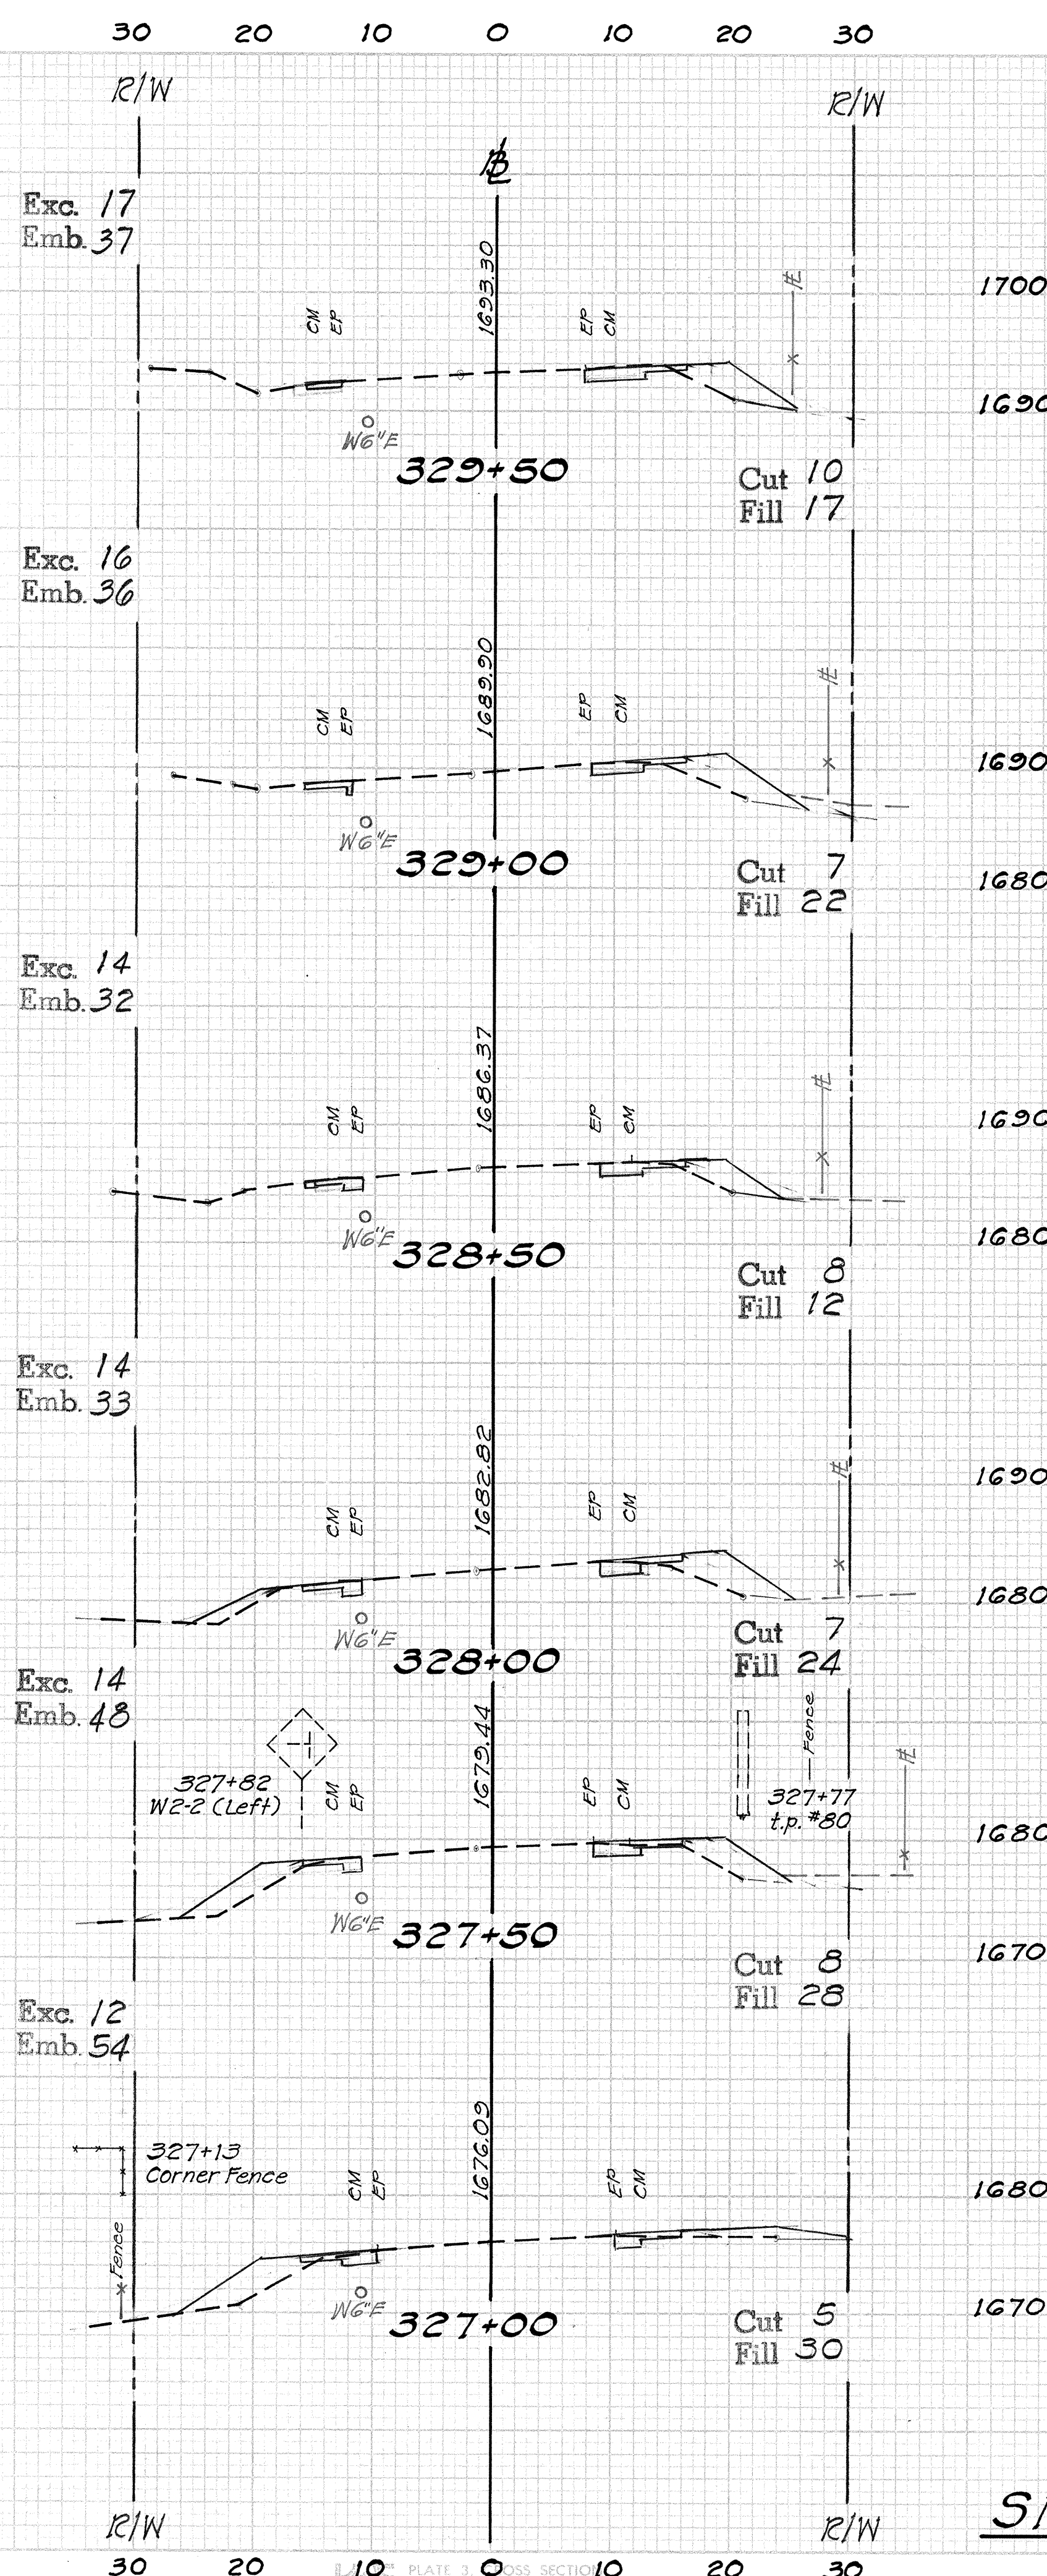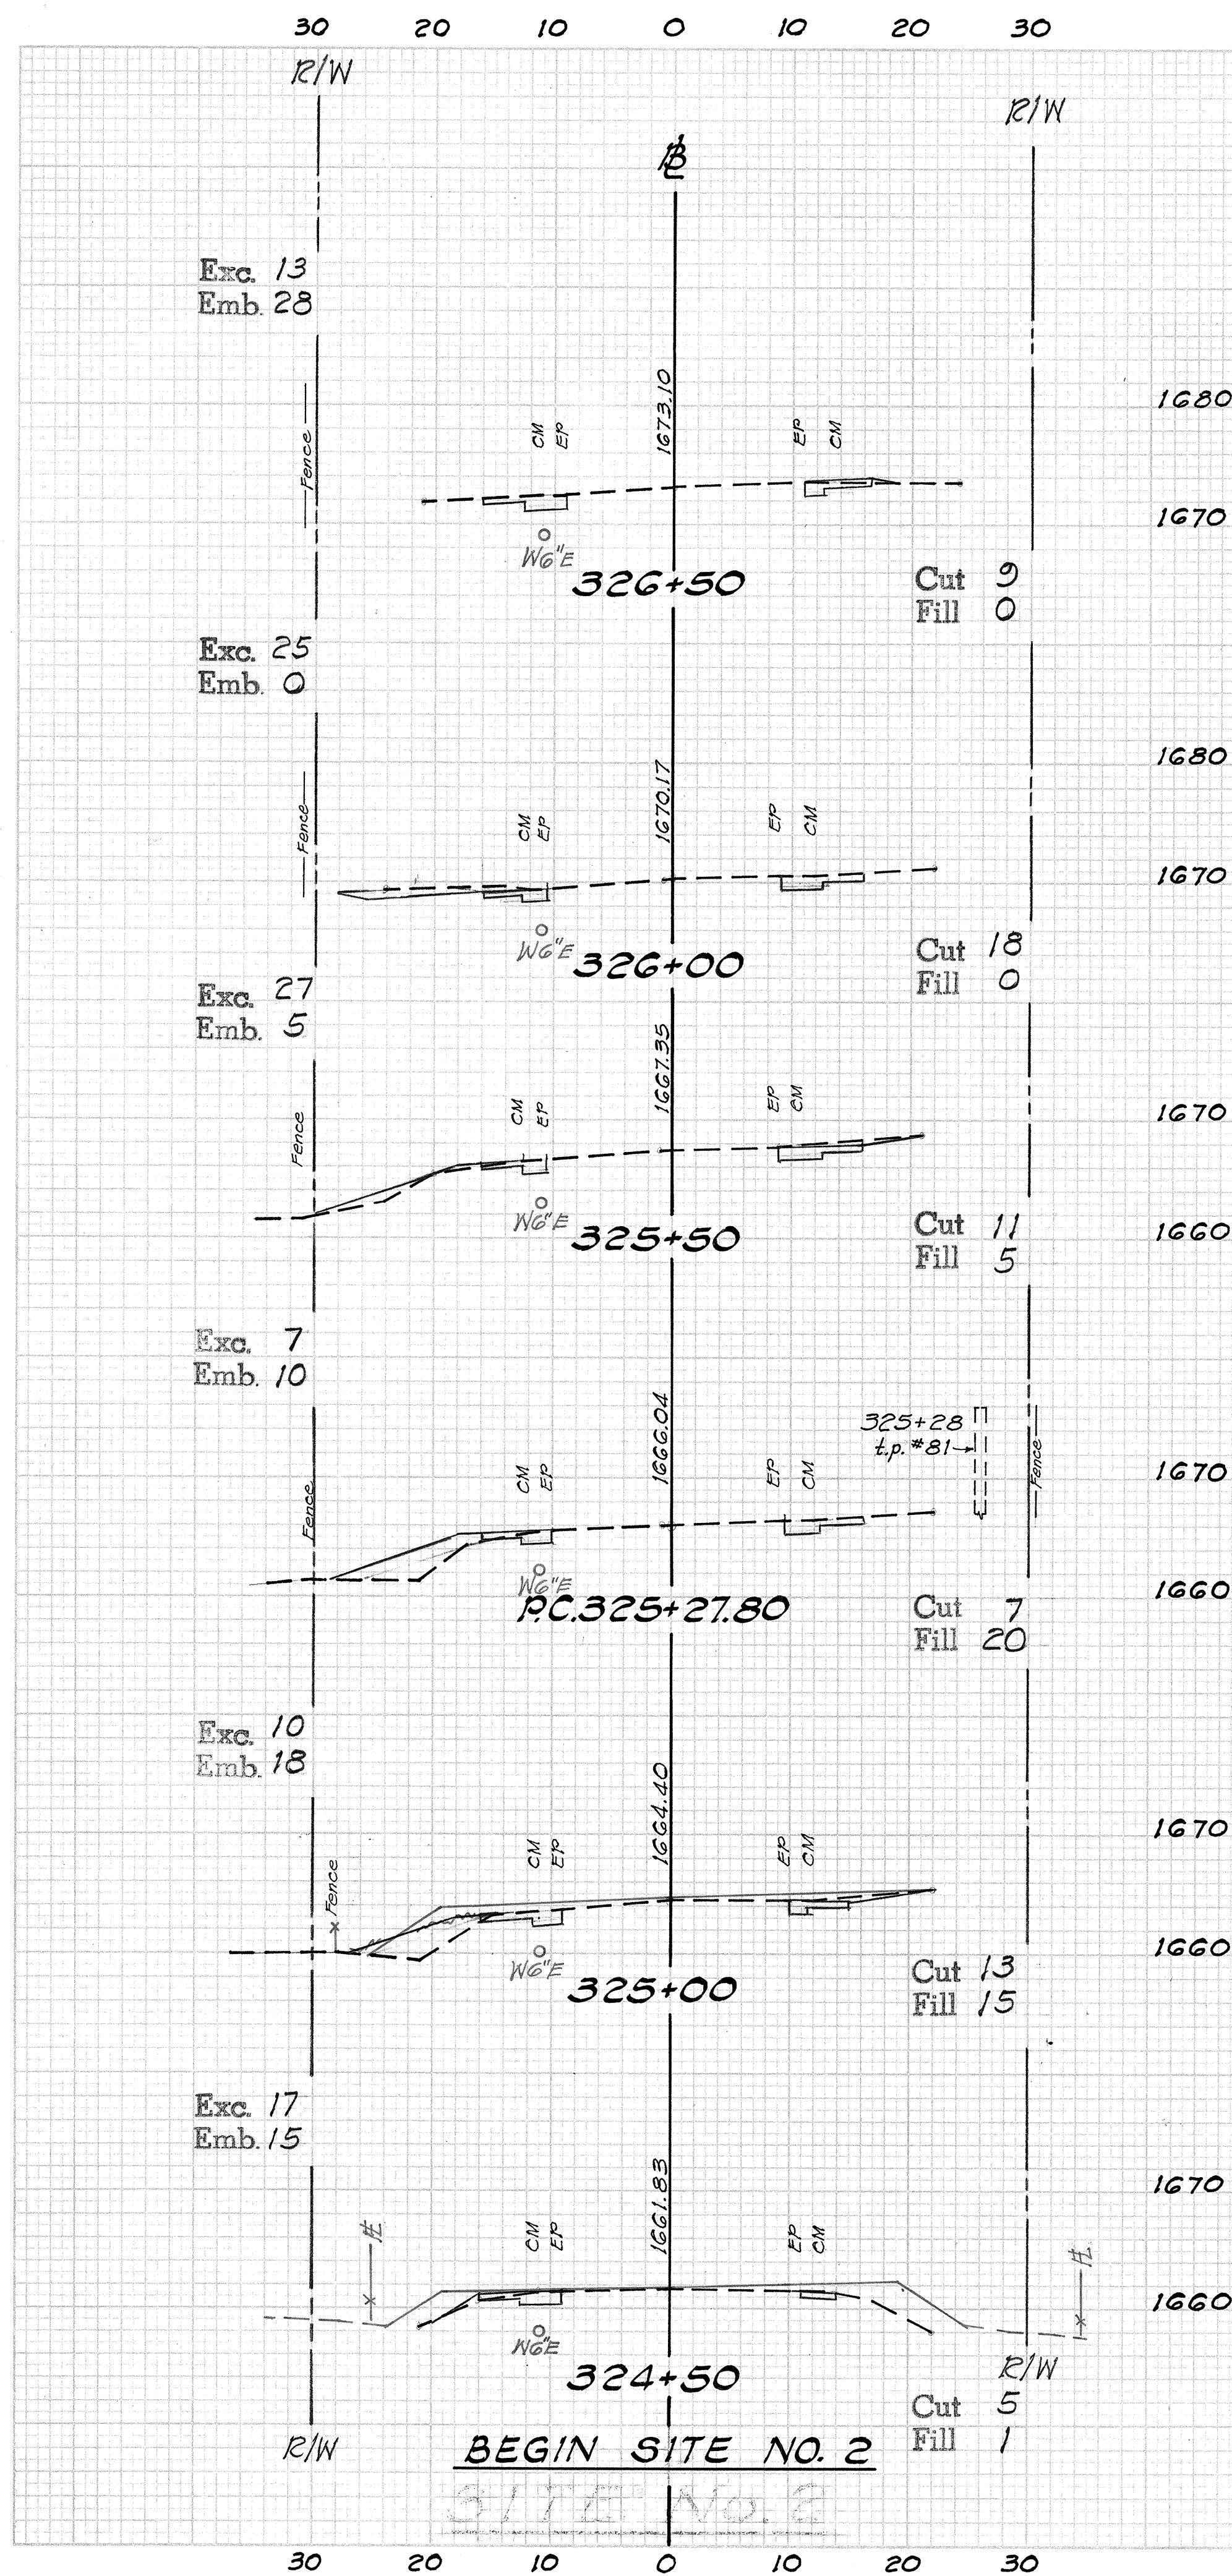

ORIGINAL	SURVEYED	BY	DATE
NOTE BOOK	PLOTTED		<u>Jan. 24</u>
854	TEMPLATE		
854	AREAS		
854	AREAS CHECKED		



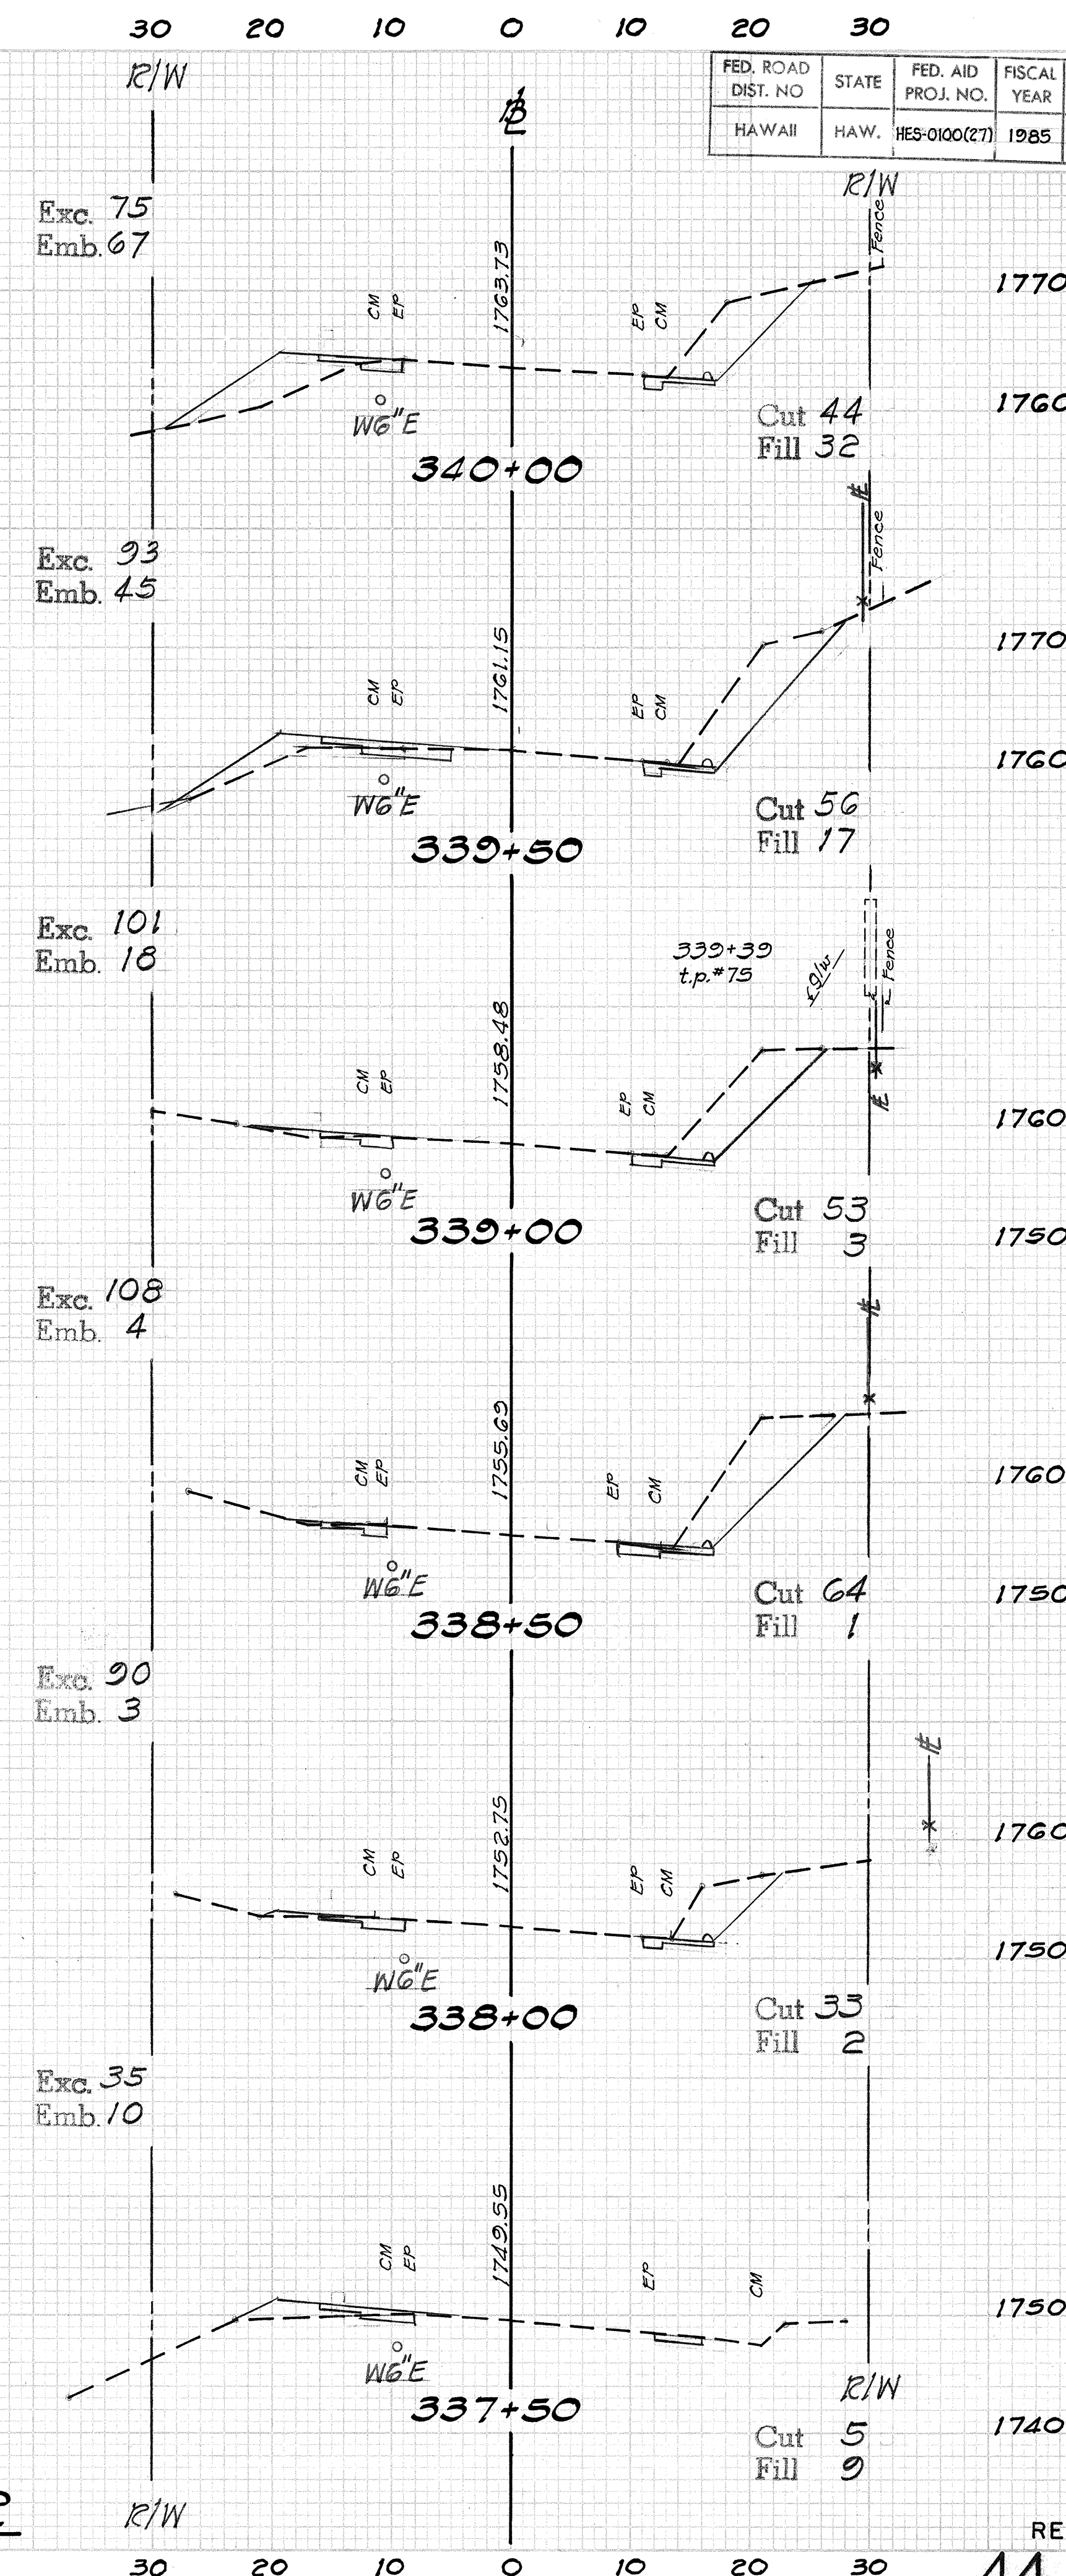


44

DATE	
BY	
FINAL SURVEY	
NOTED	
NO. 65-68	
AREAS CHECKED	

DATE	Jan. 1964
BY	
ORIGINAL SURVEY	
NOTED	
NO. 65-68	
AREAS CHECKED	

FED. ROAD DIST. NO.	STATE	FED. AID PROJ. NO.	FISCAL YEAR	SHEET NO.	TOTAL SHEETS
HAWAII	HAW.	HES-0100(27)	1965	45	47

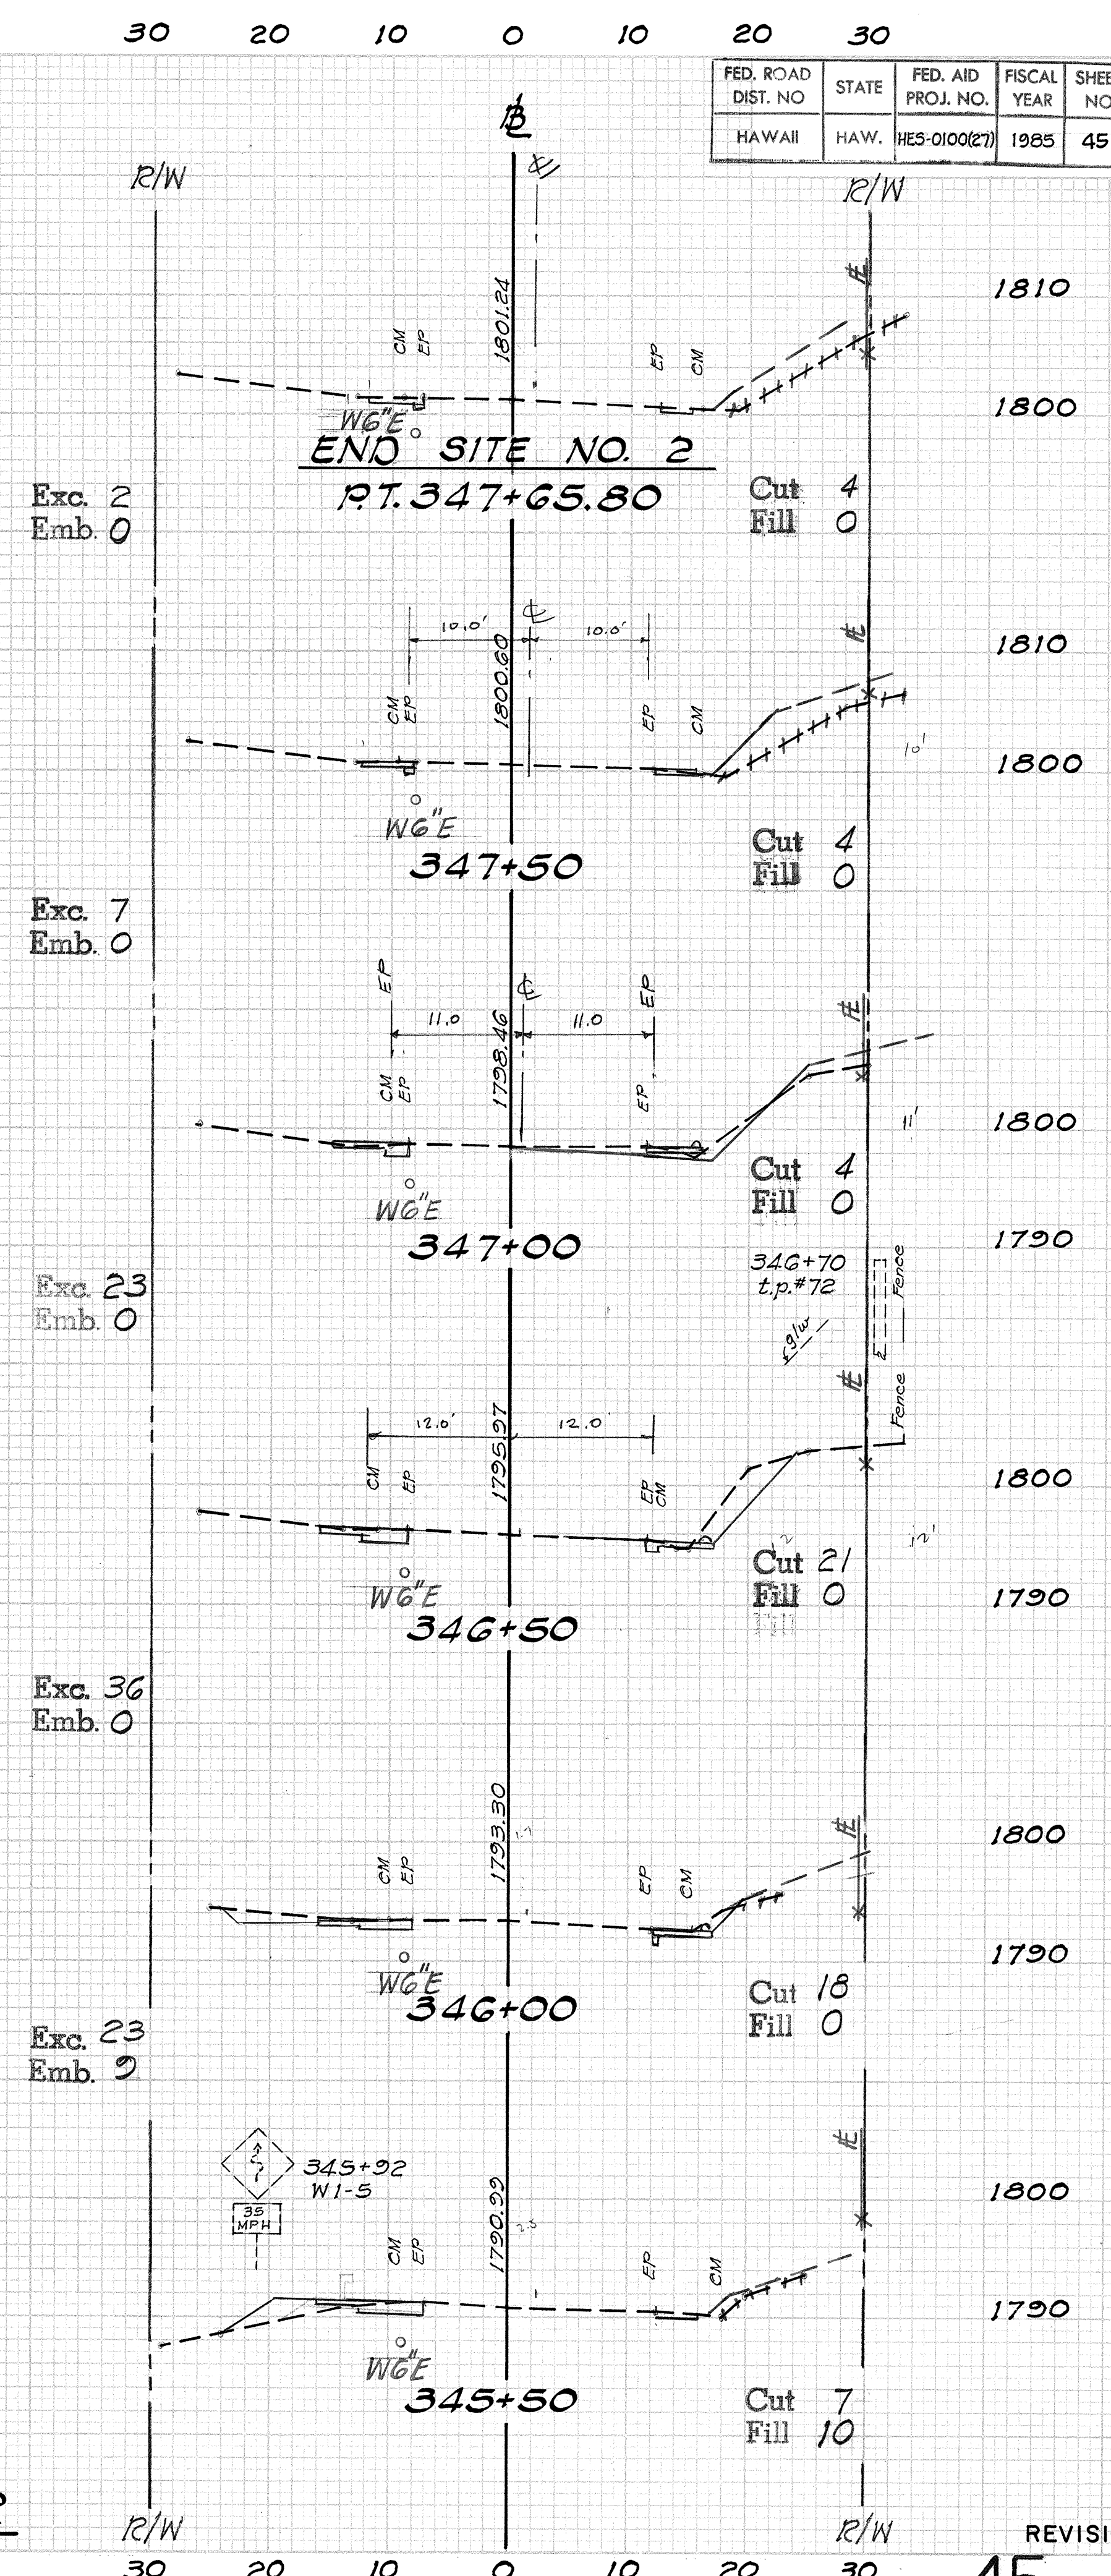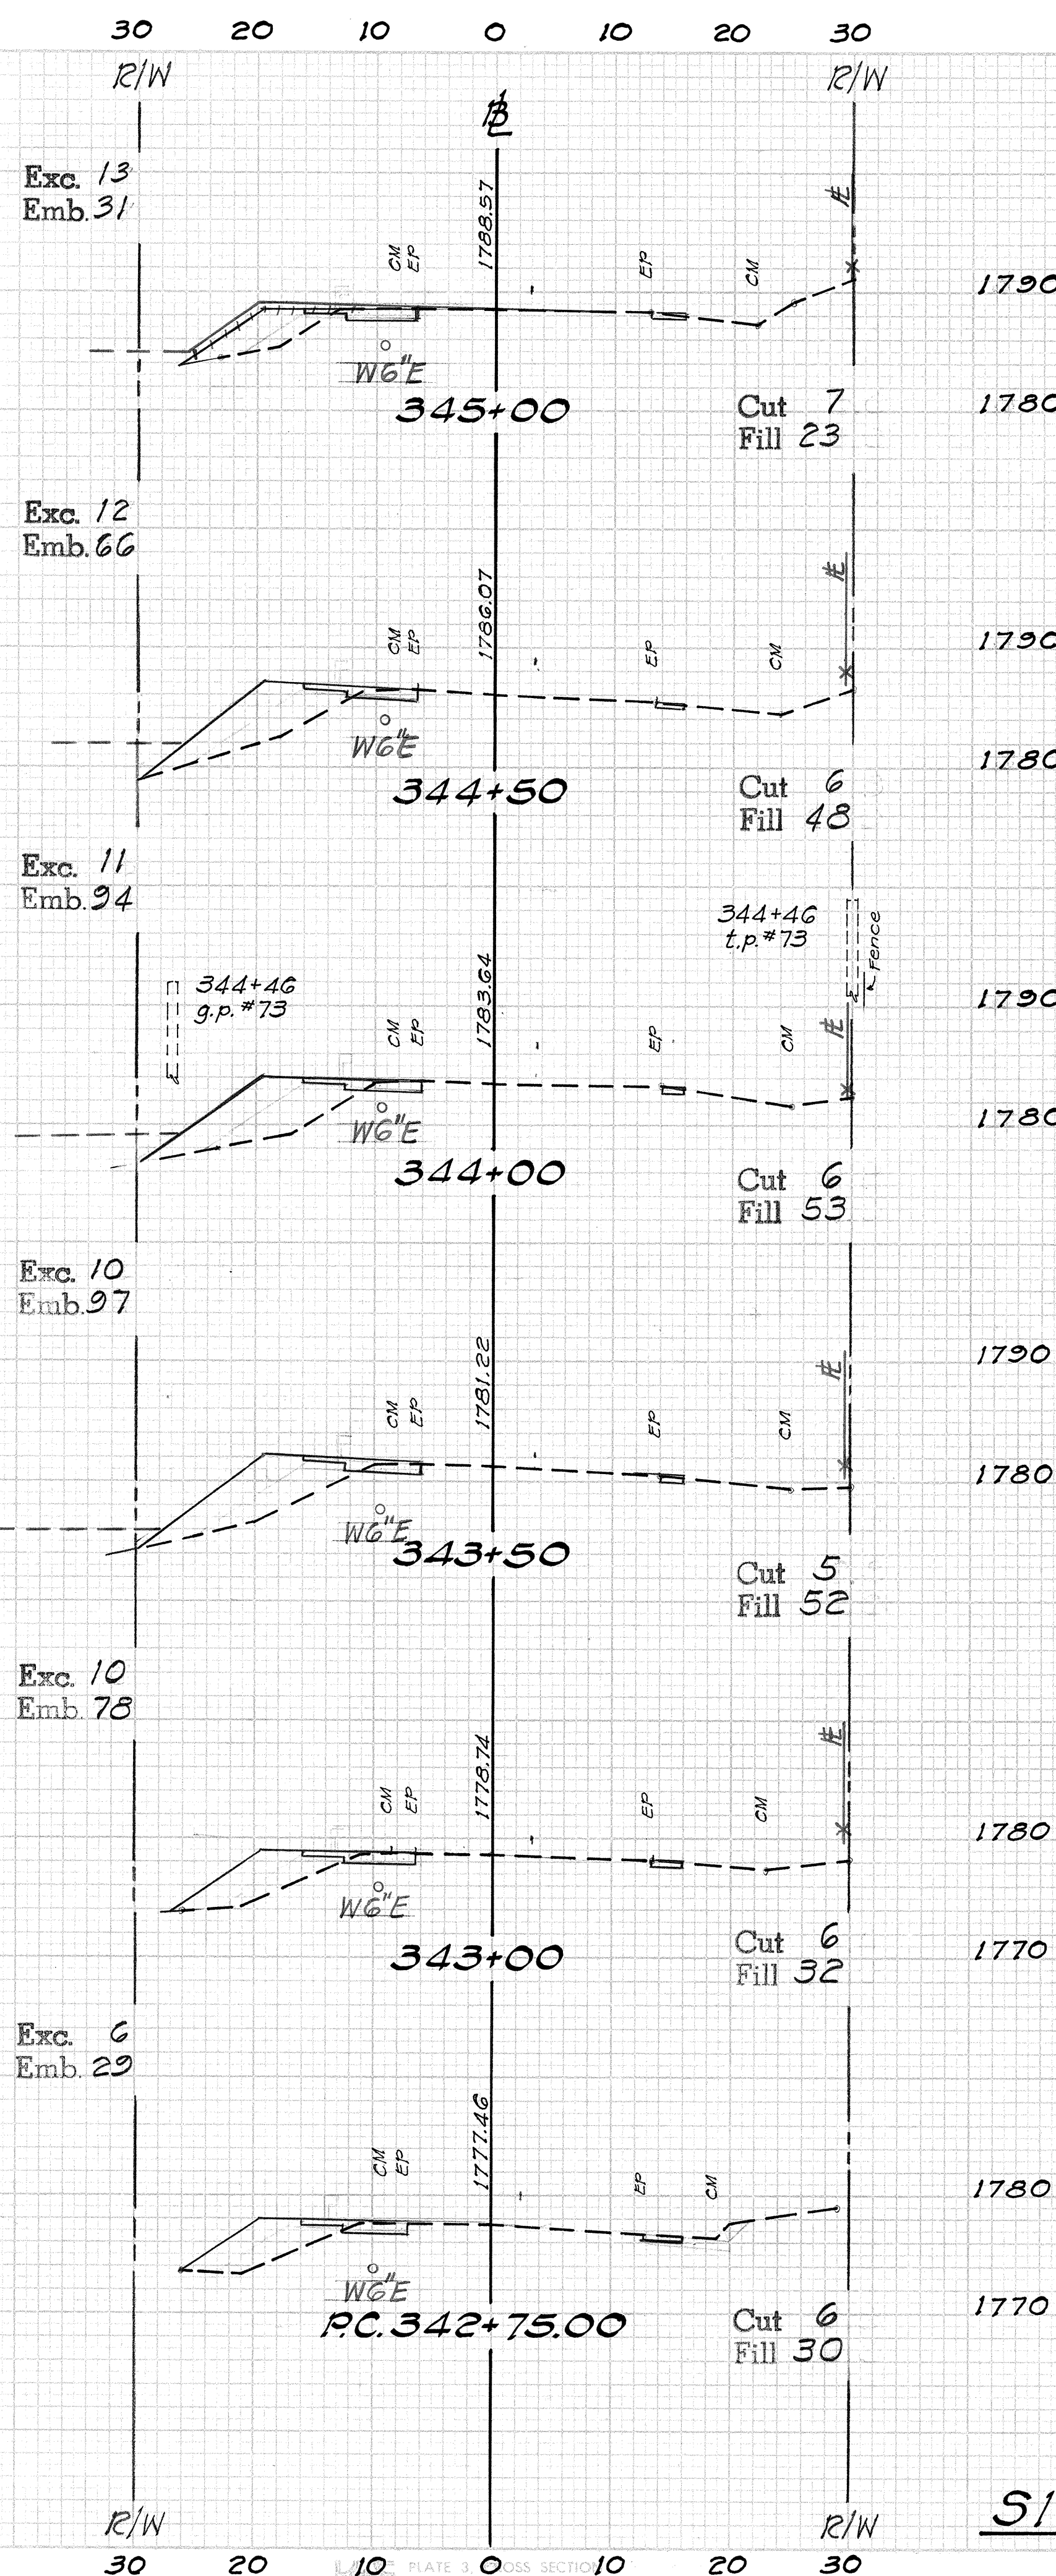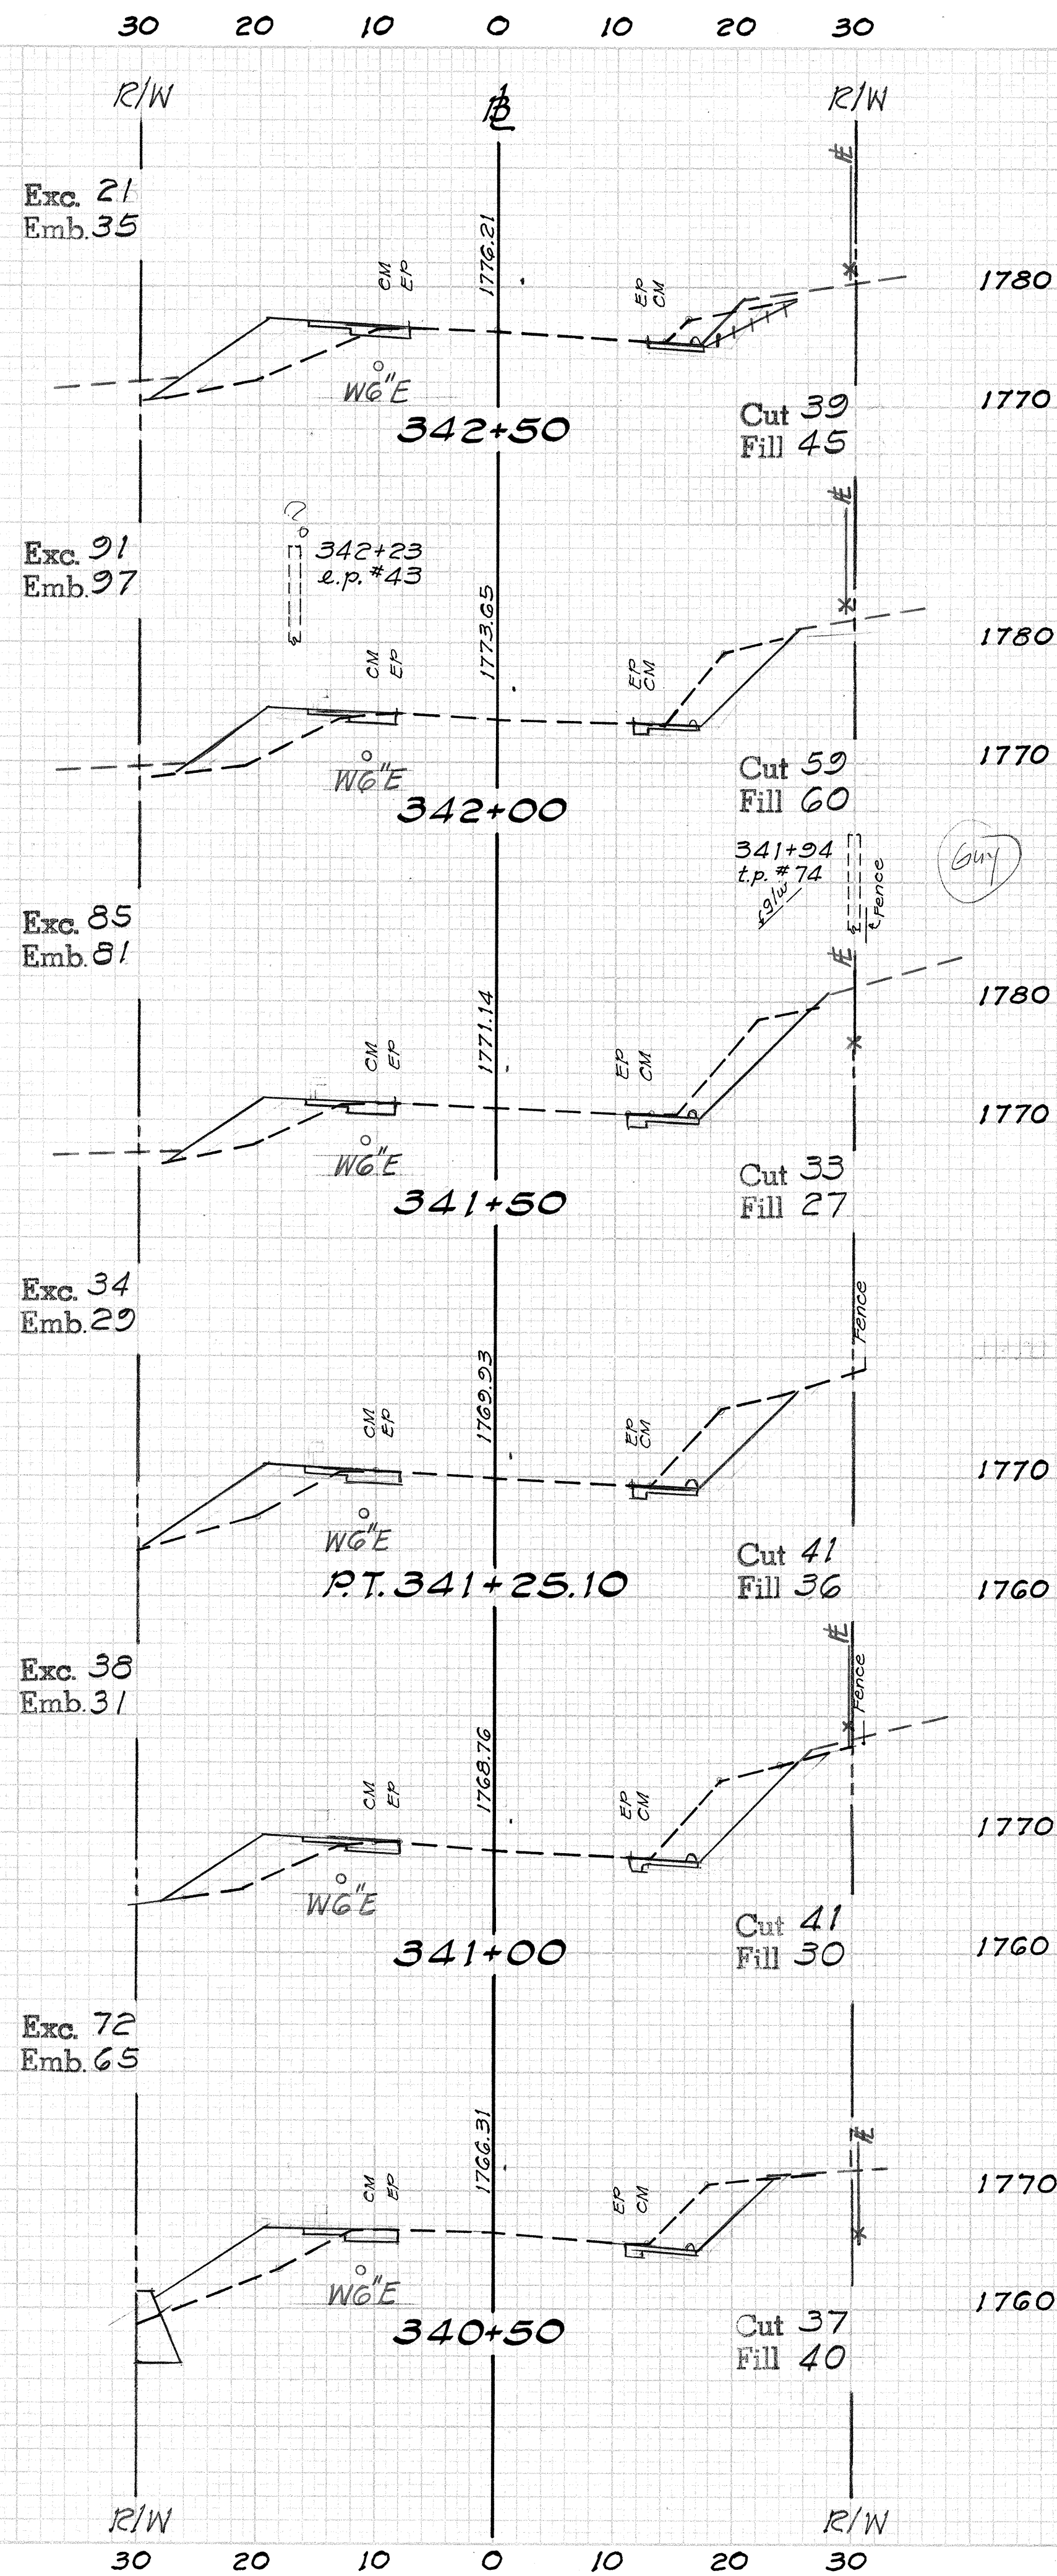




SITE No. 2

REVISION I

DATE	
BY	
REVISION	
NO.	
DESCRIPTION	
DATE	
BY	
REVISION	
NO.	
DESCRIPTION	

DATE	
BY	
REVISION	
NO.	
DESCRIPTION	
DATE	
BY	
REVISION	
NO.	
DESCRIPTION	




FED. ROAD DIST. NO.	STATE	FED. AID PROJ. NO.	FISCAL YEAR	SHEET NO.	TOTAL SHEETS
HAWAII	HAW.	HES-0100(27)	1985	46	47

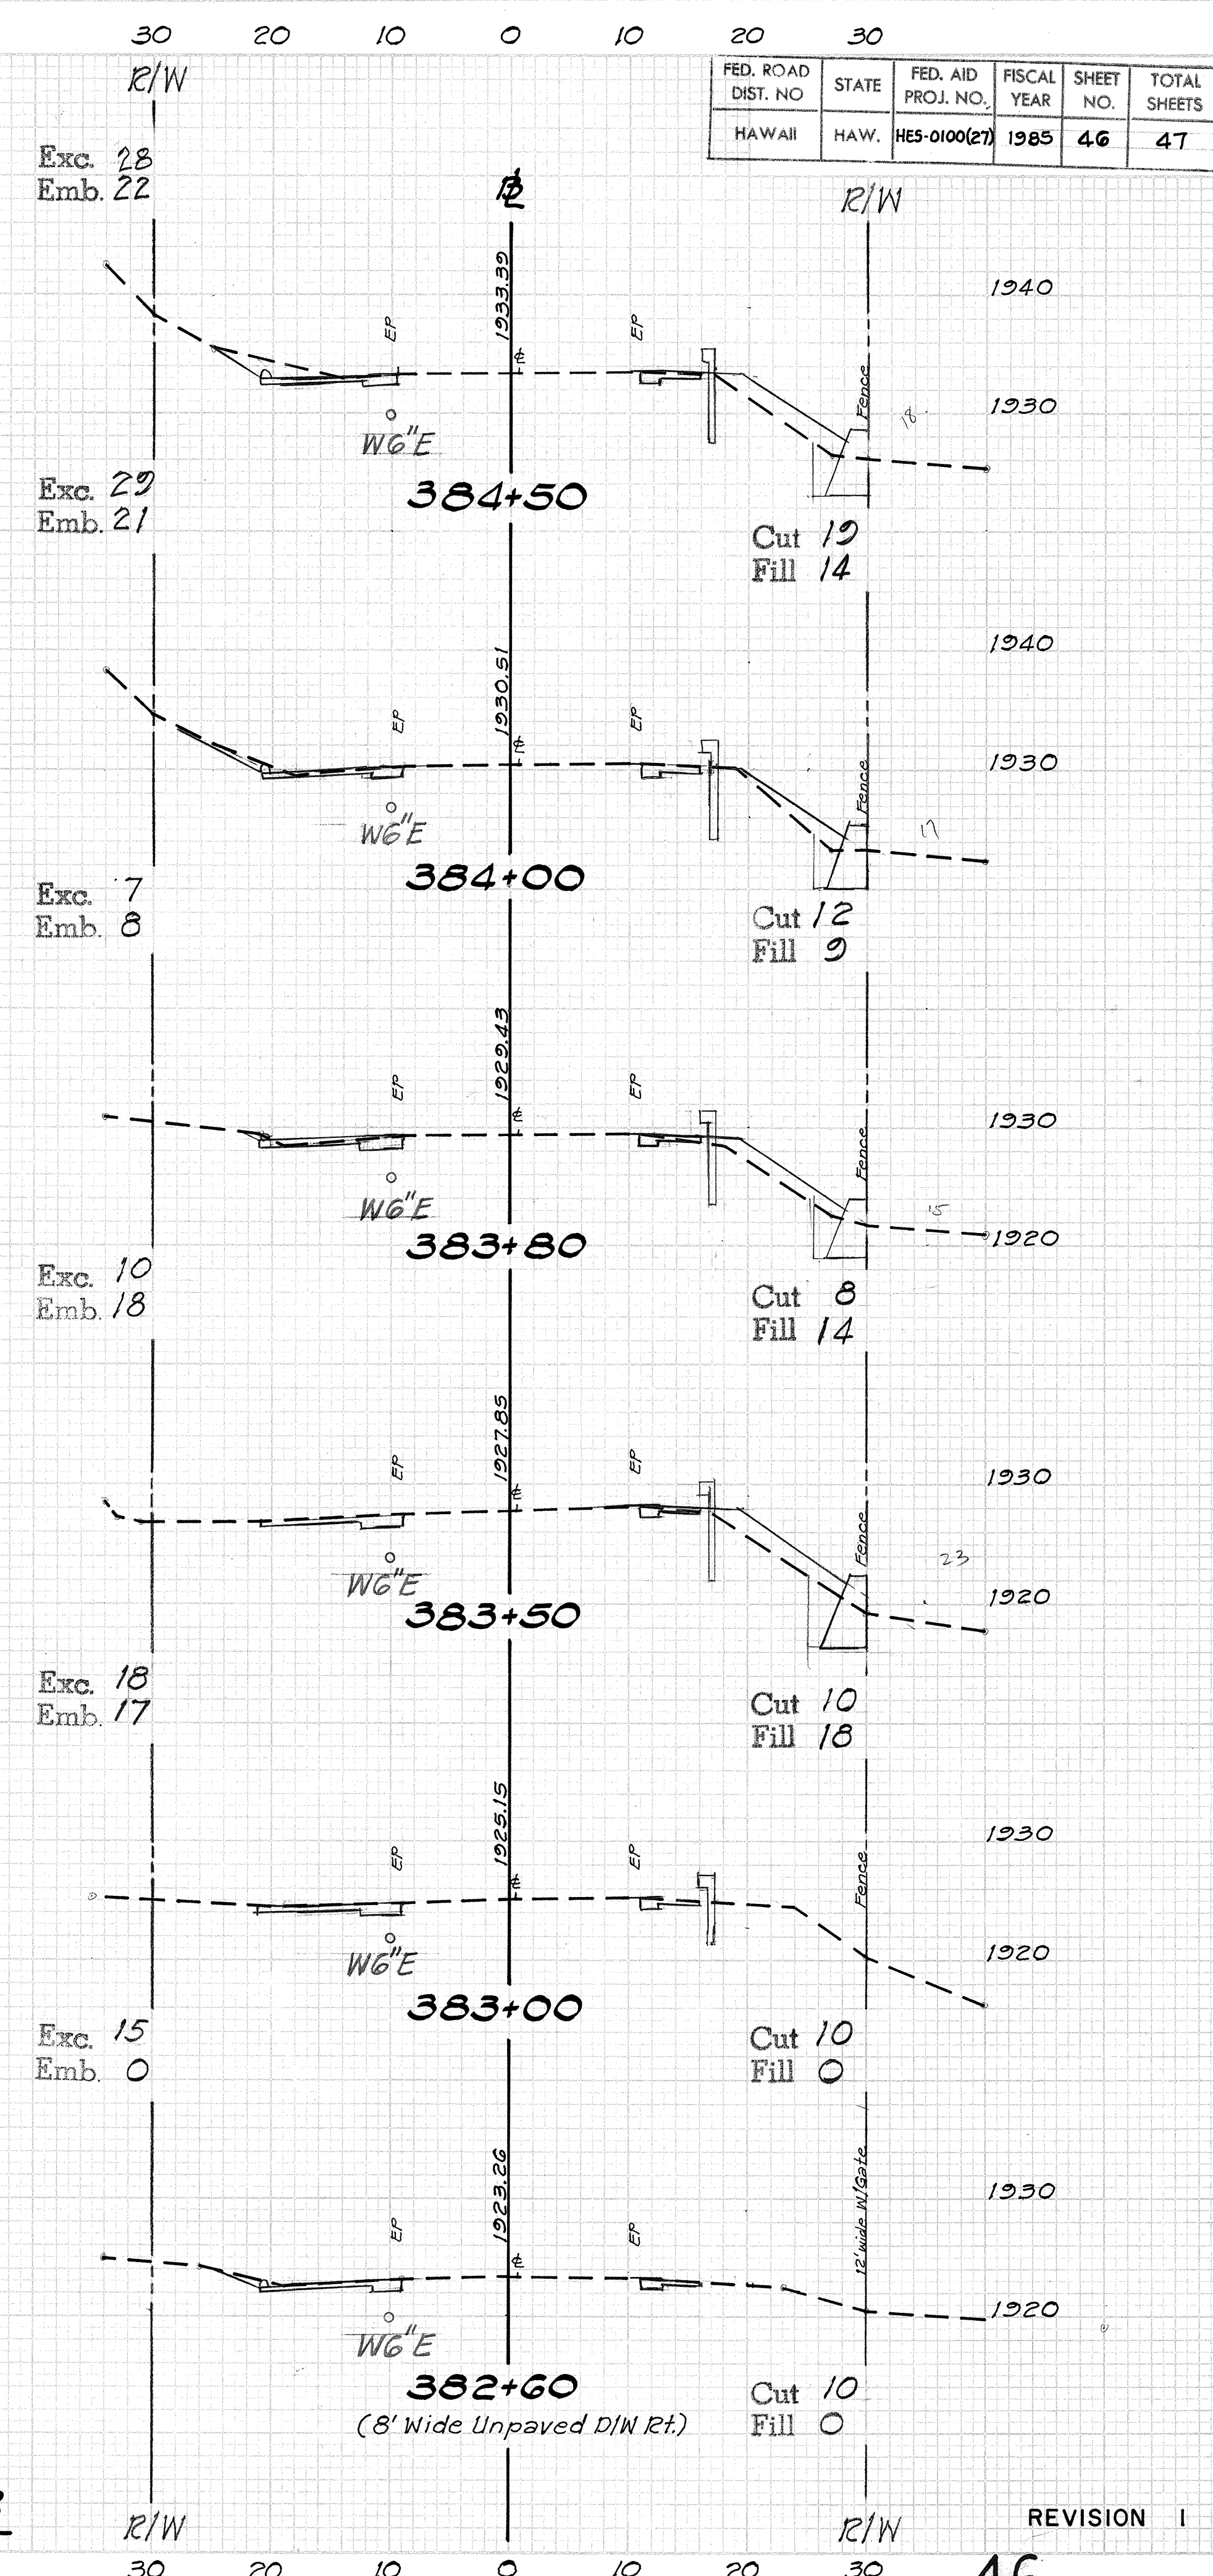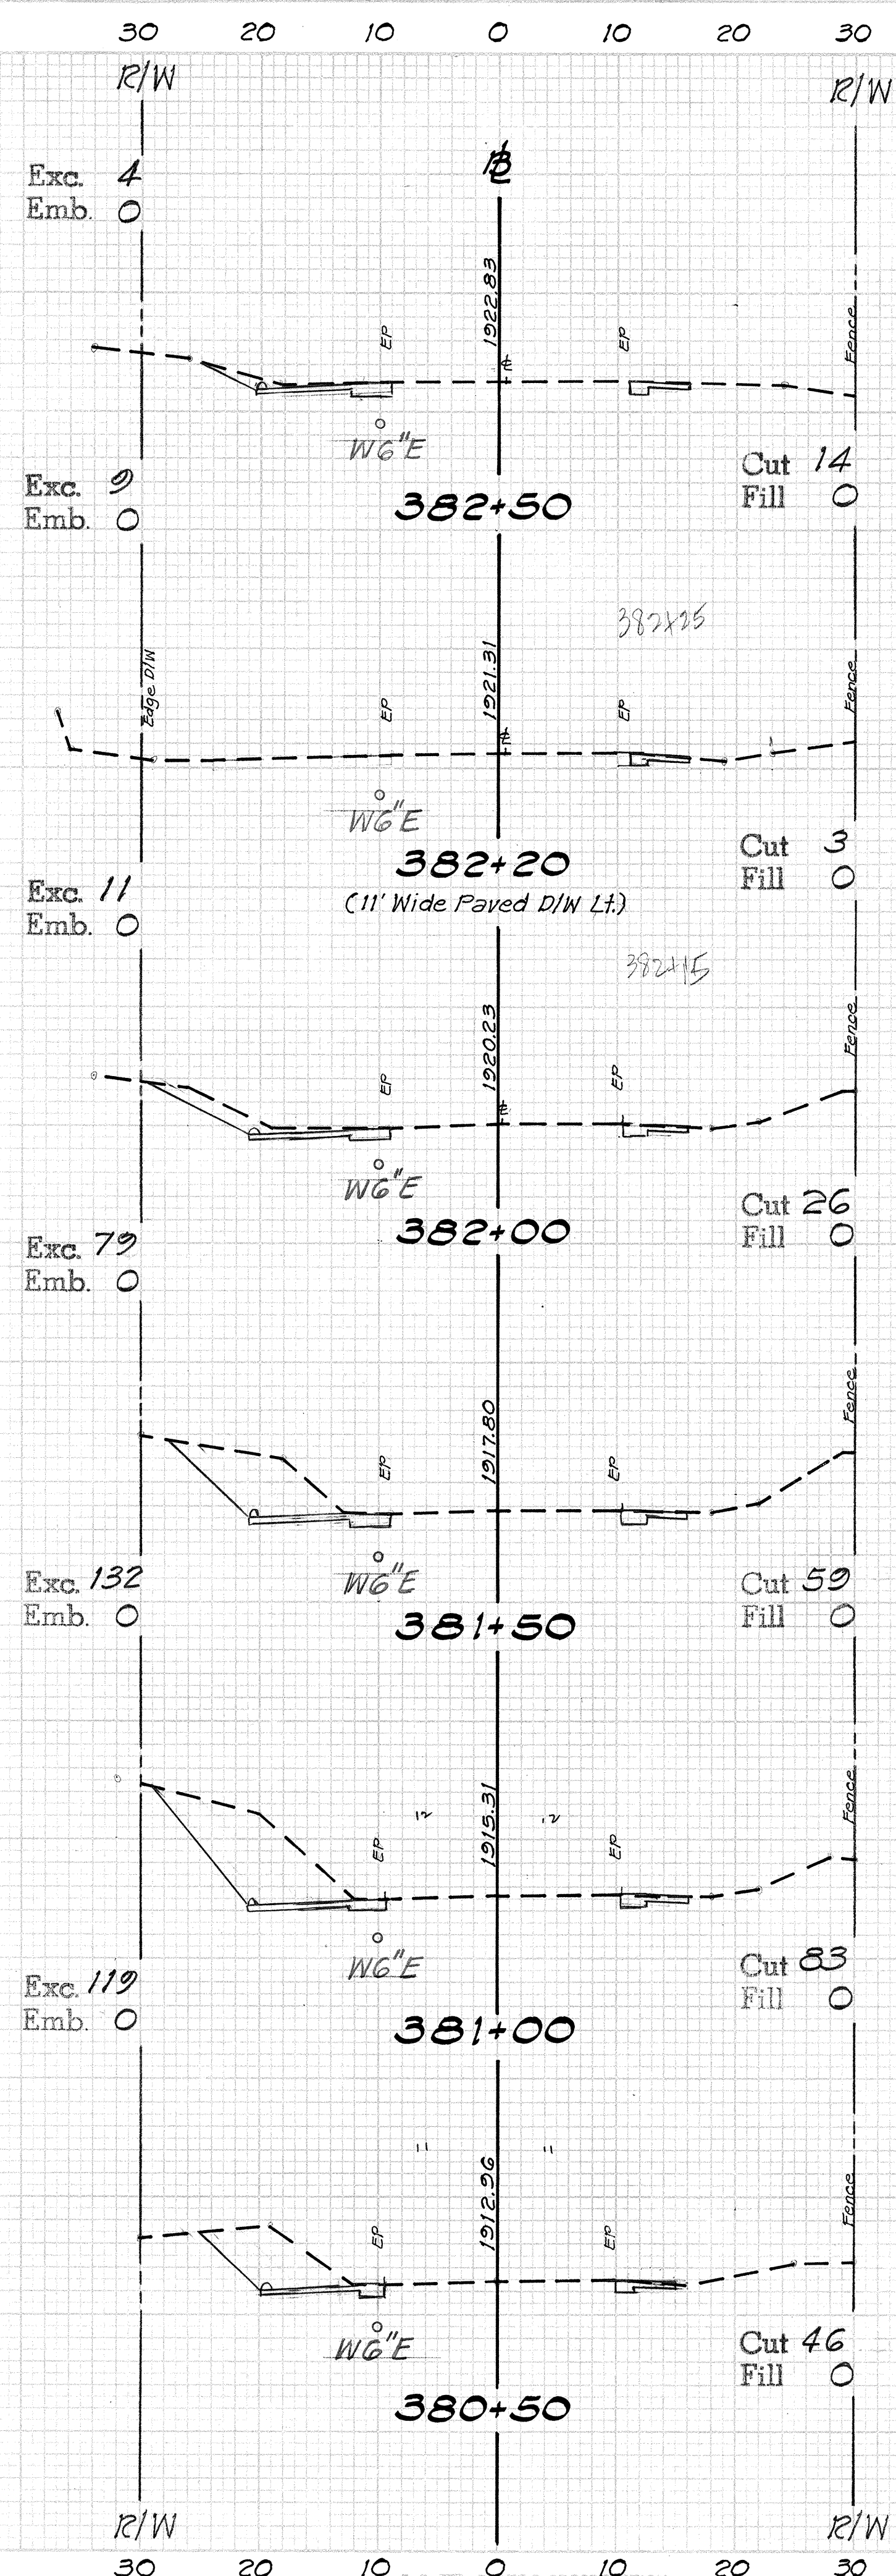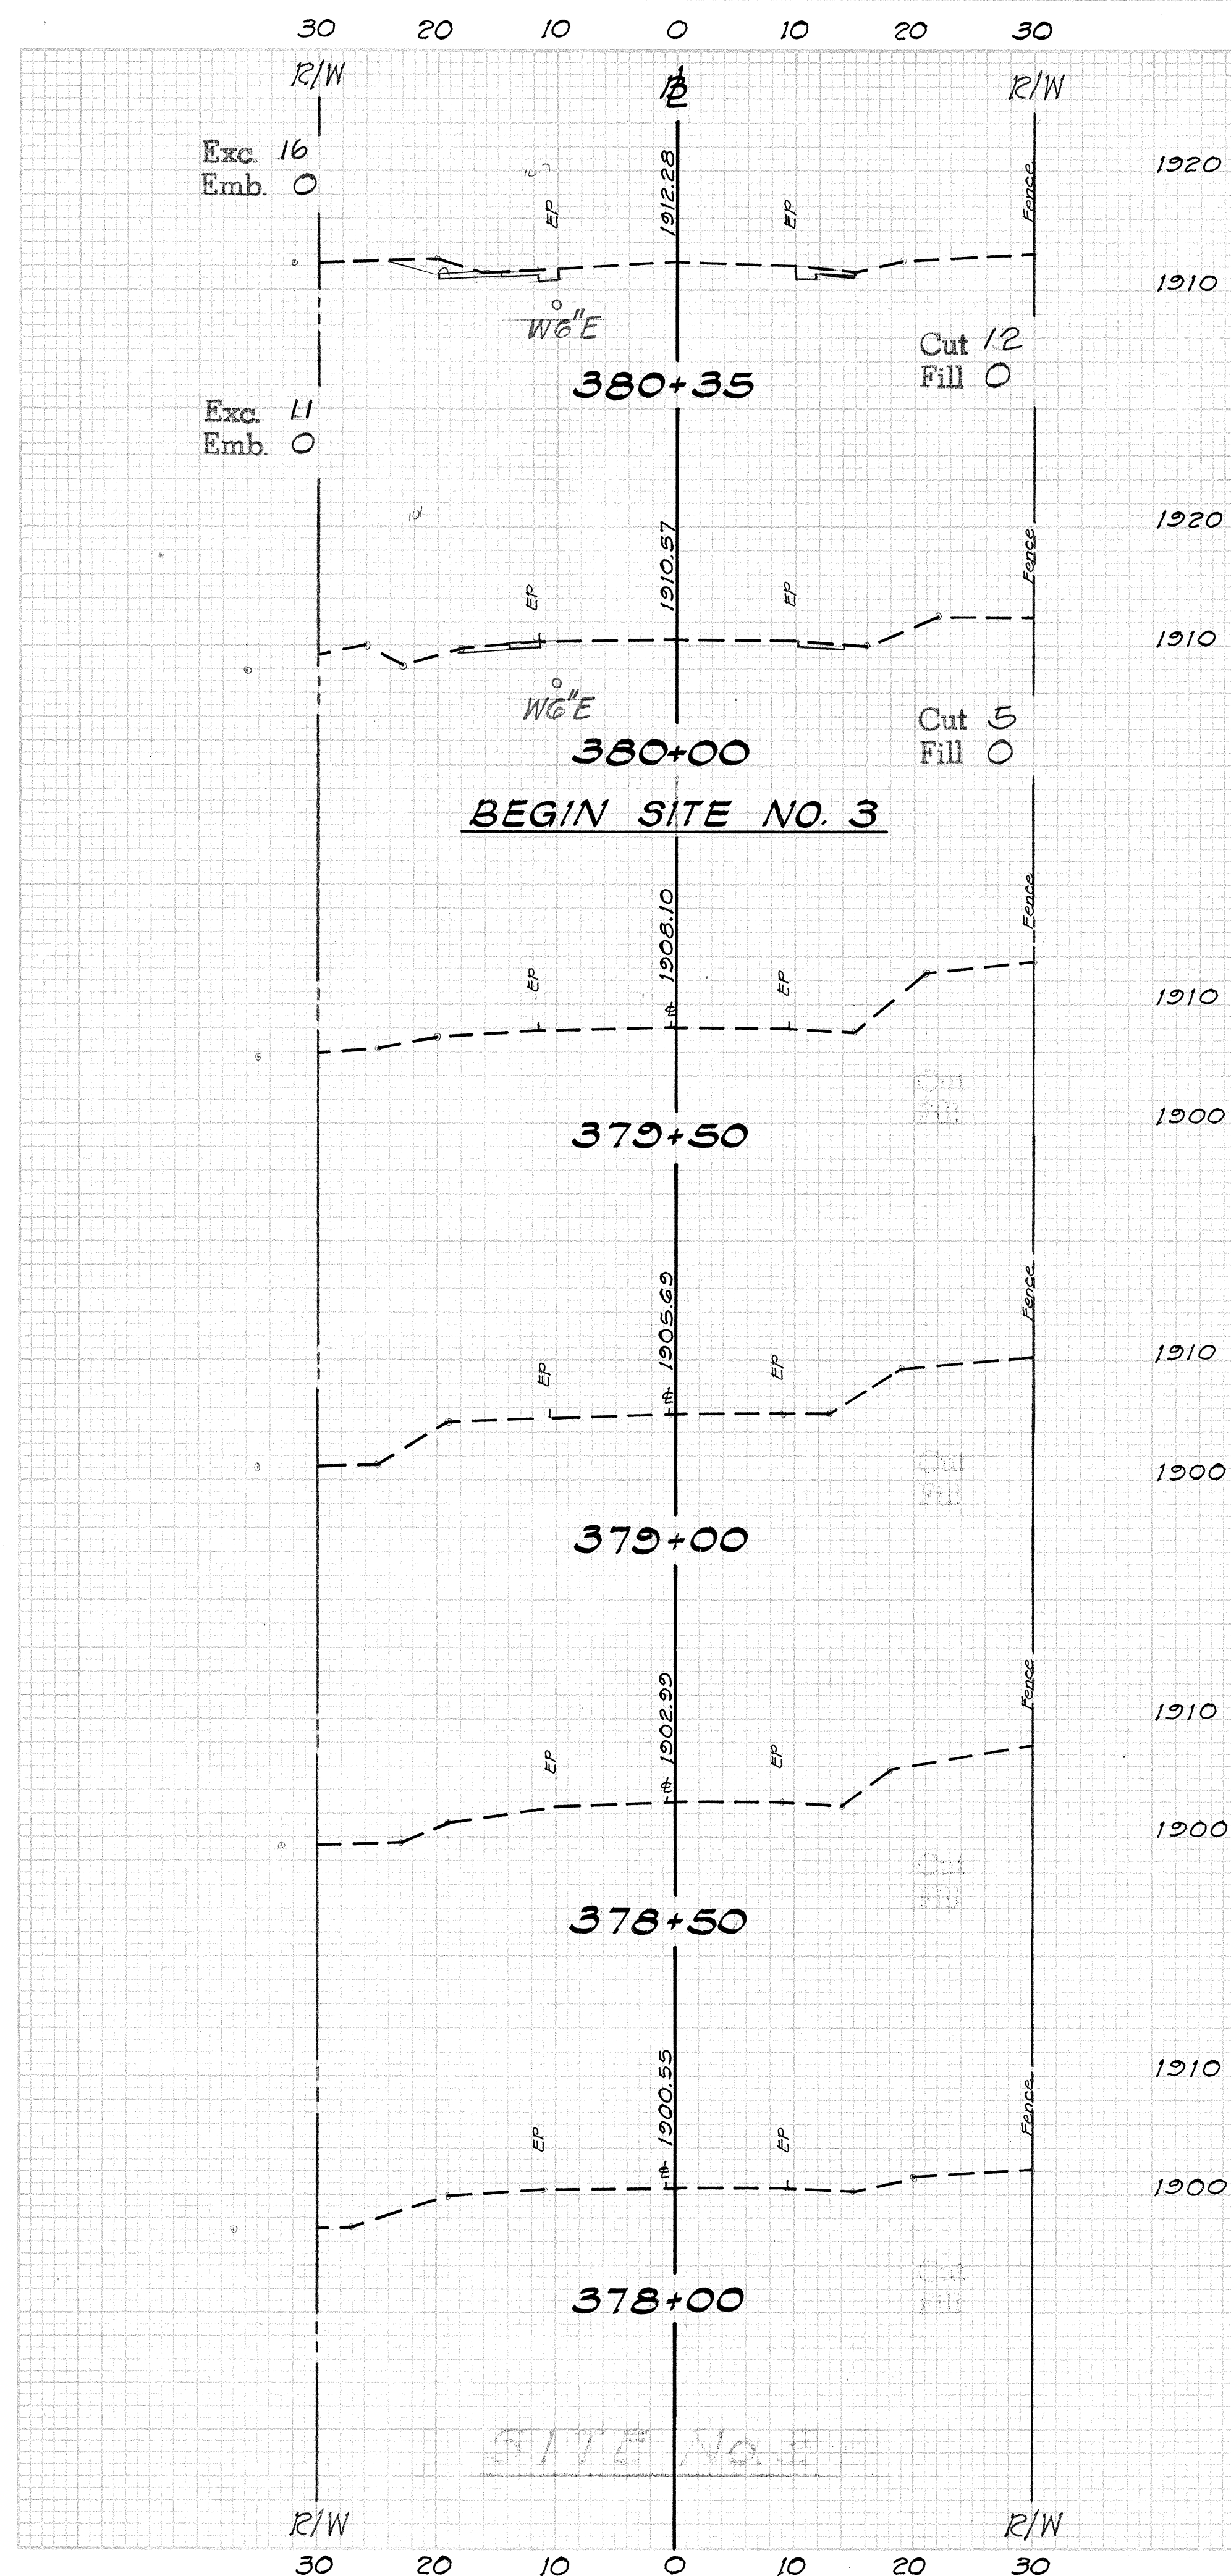

DATE	
BY	
ORIGINAL SURVEY	
NOTE BOOK	
TEMPLATE	
AREAS CHECKED	

DATE	Jan 84
BY	
ORIGINAL SURVEY	
NOTE BOOK	#1061
TEMPLATE	
AREAS CHECKED	

FED. ROAD DIST. NO.	STATE	FED. AID PROJ. NO.	FISCAL YEAR	SHEET NO.	TOTAL SHEETS
HAWAII	HAW.	HE5-0100(27)	1985	47	47

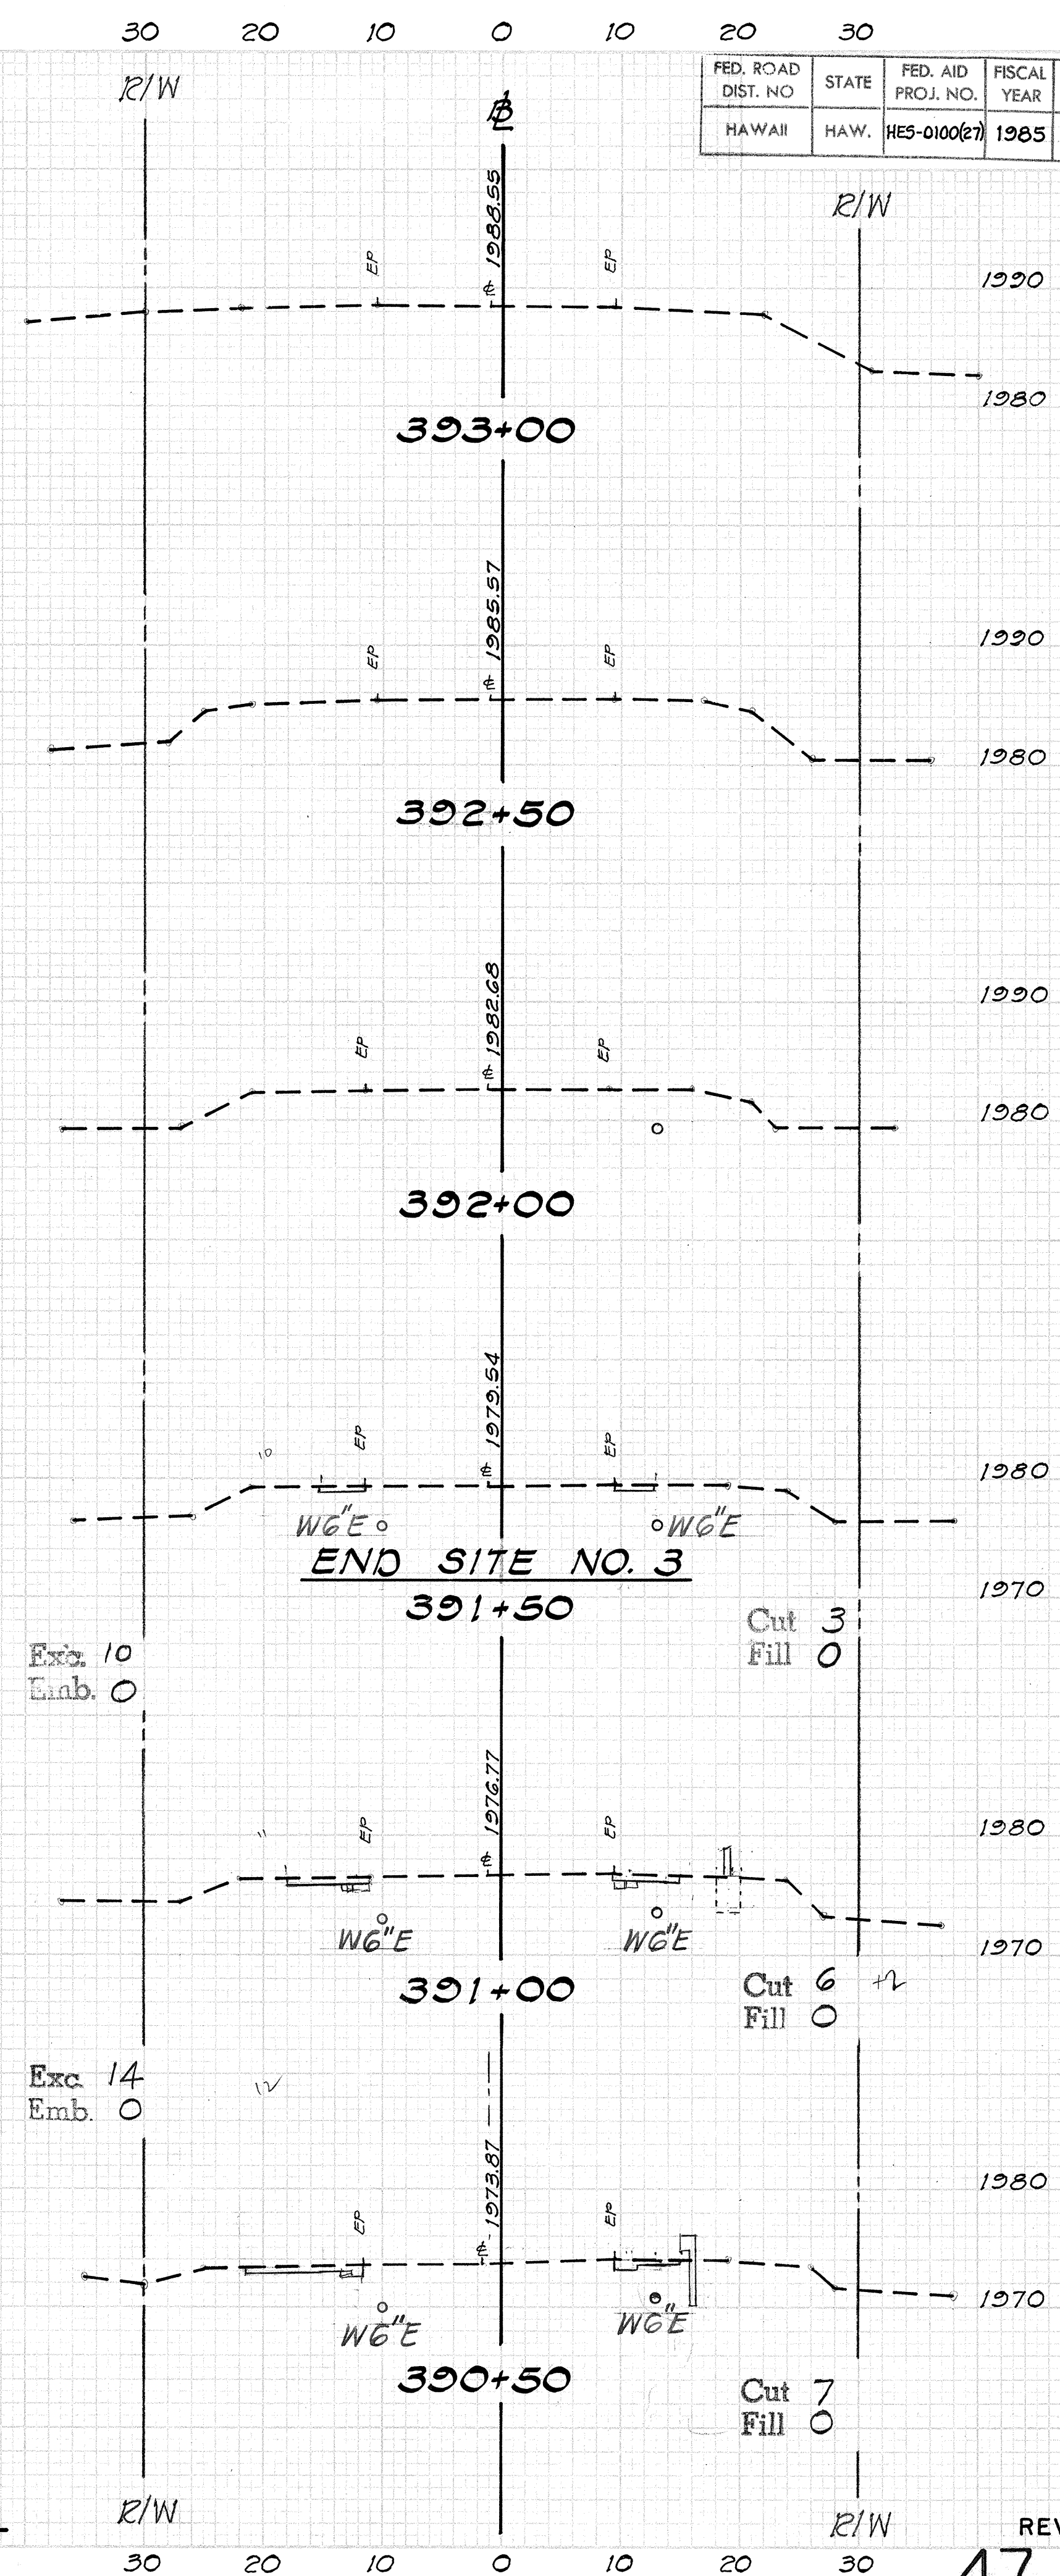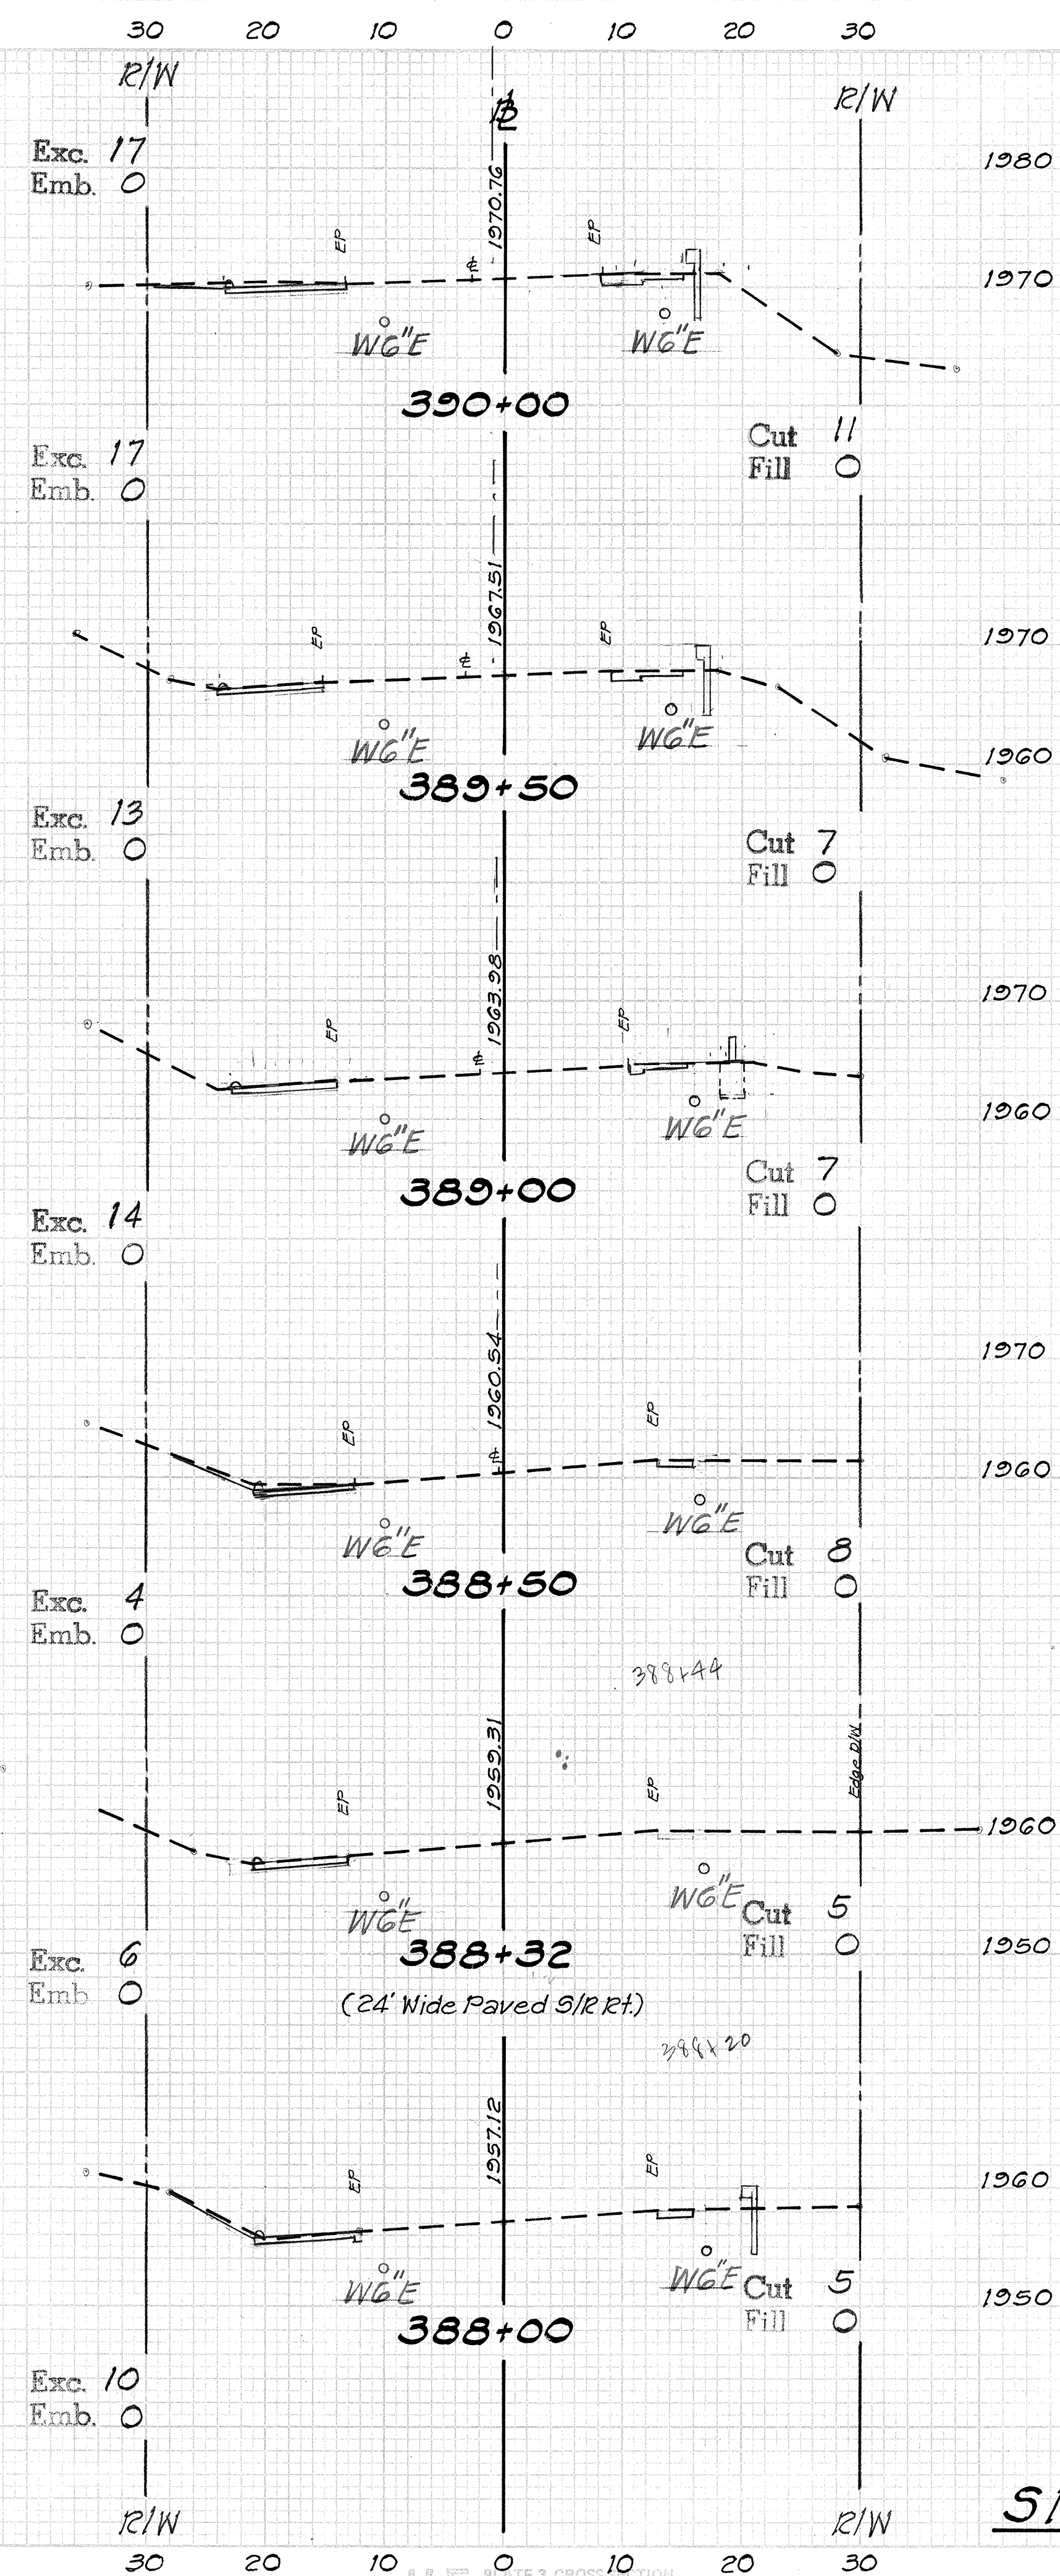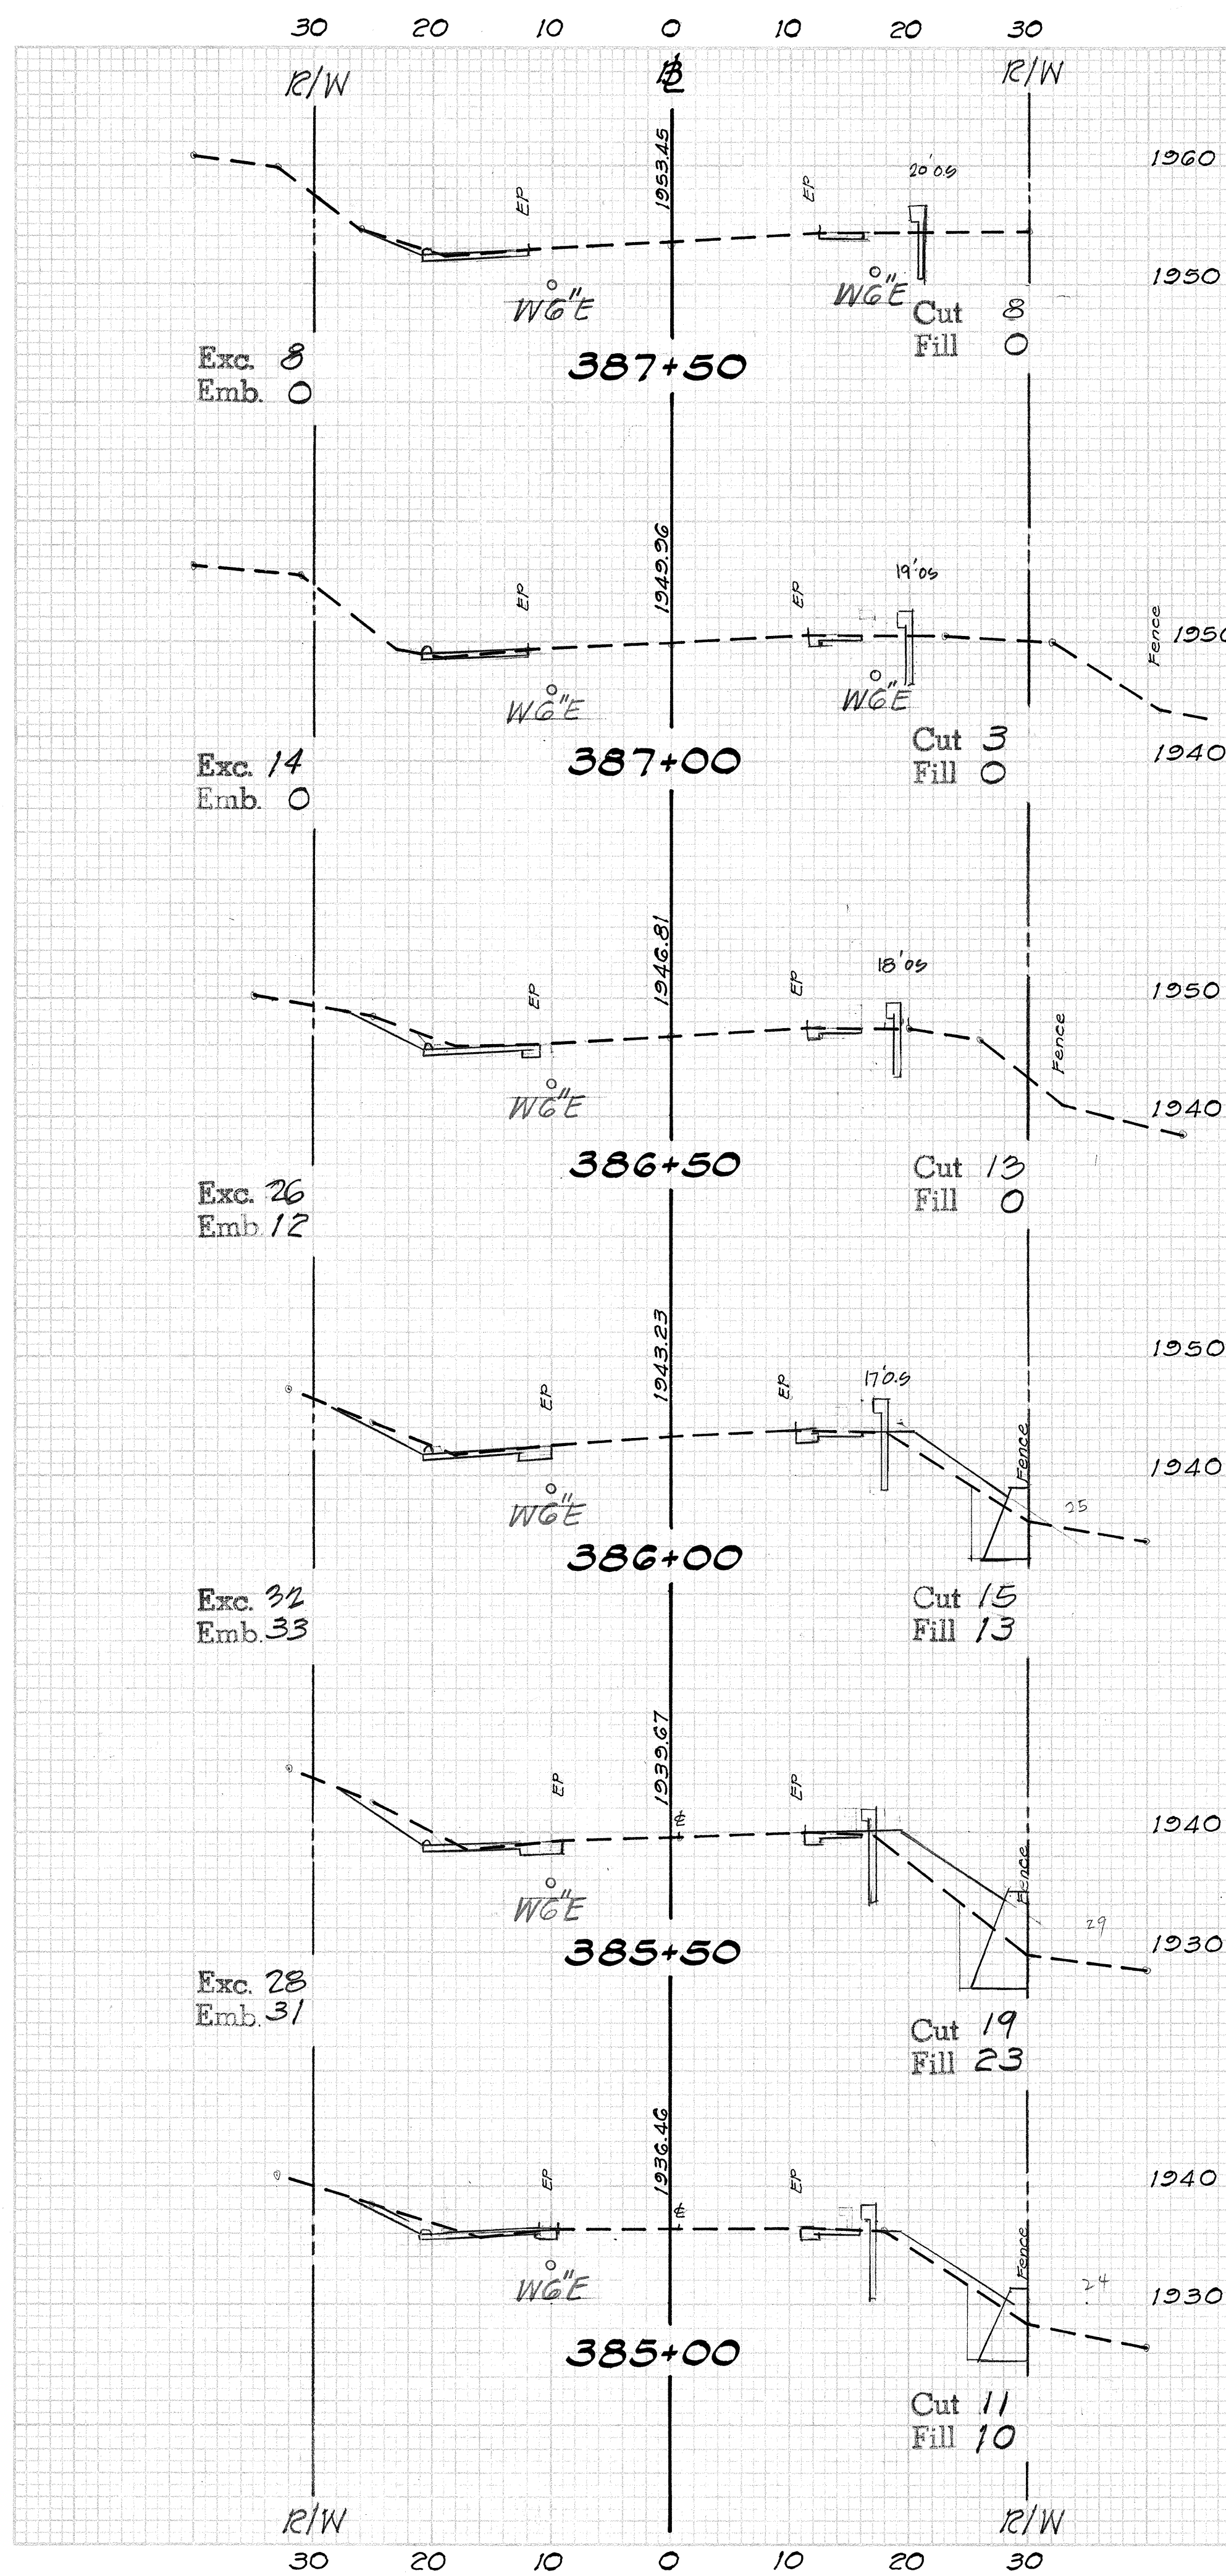

SITE No. 3

REVISION I