


FED. ROAD DIST. NO.	STATE	FED. AID PROJ. NO.	FISCAL YEAR	SHEET NO.	TOTAL SHEETS
HAWAII	HAW.	HES-0100(27)	1985	14	47

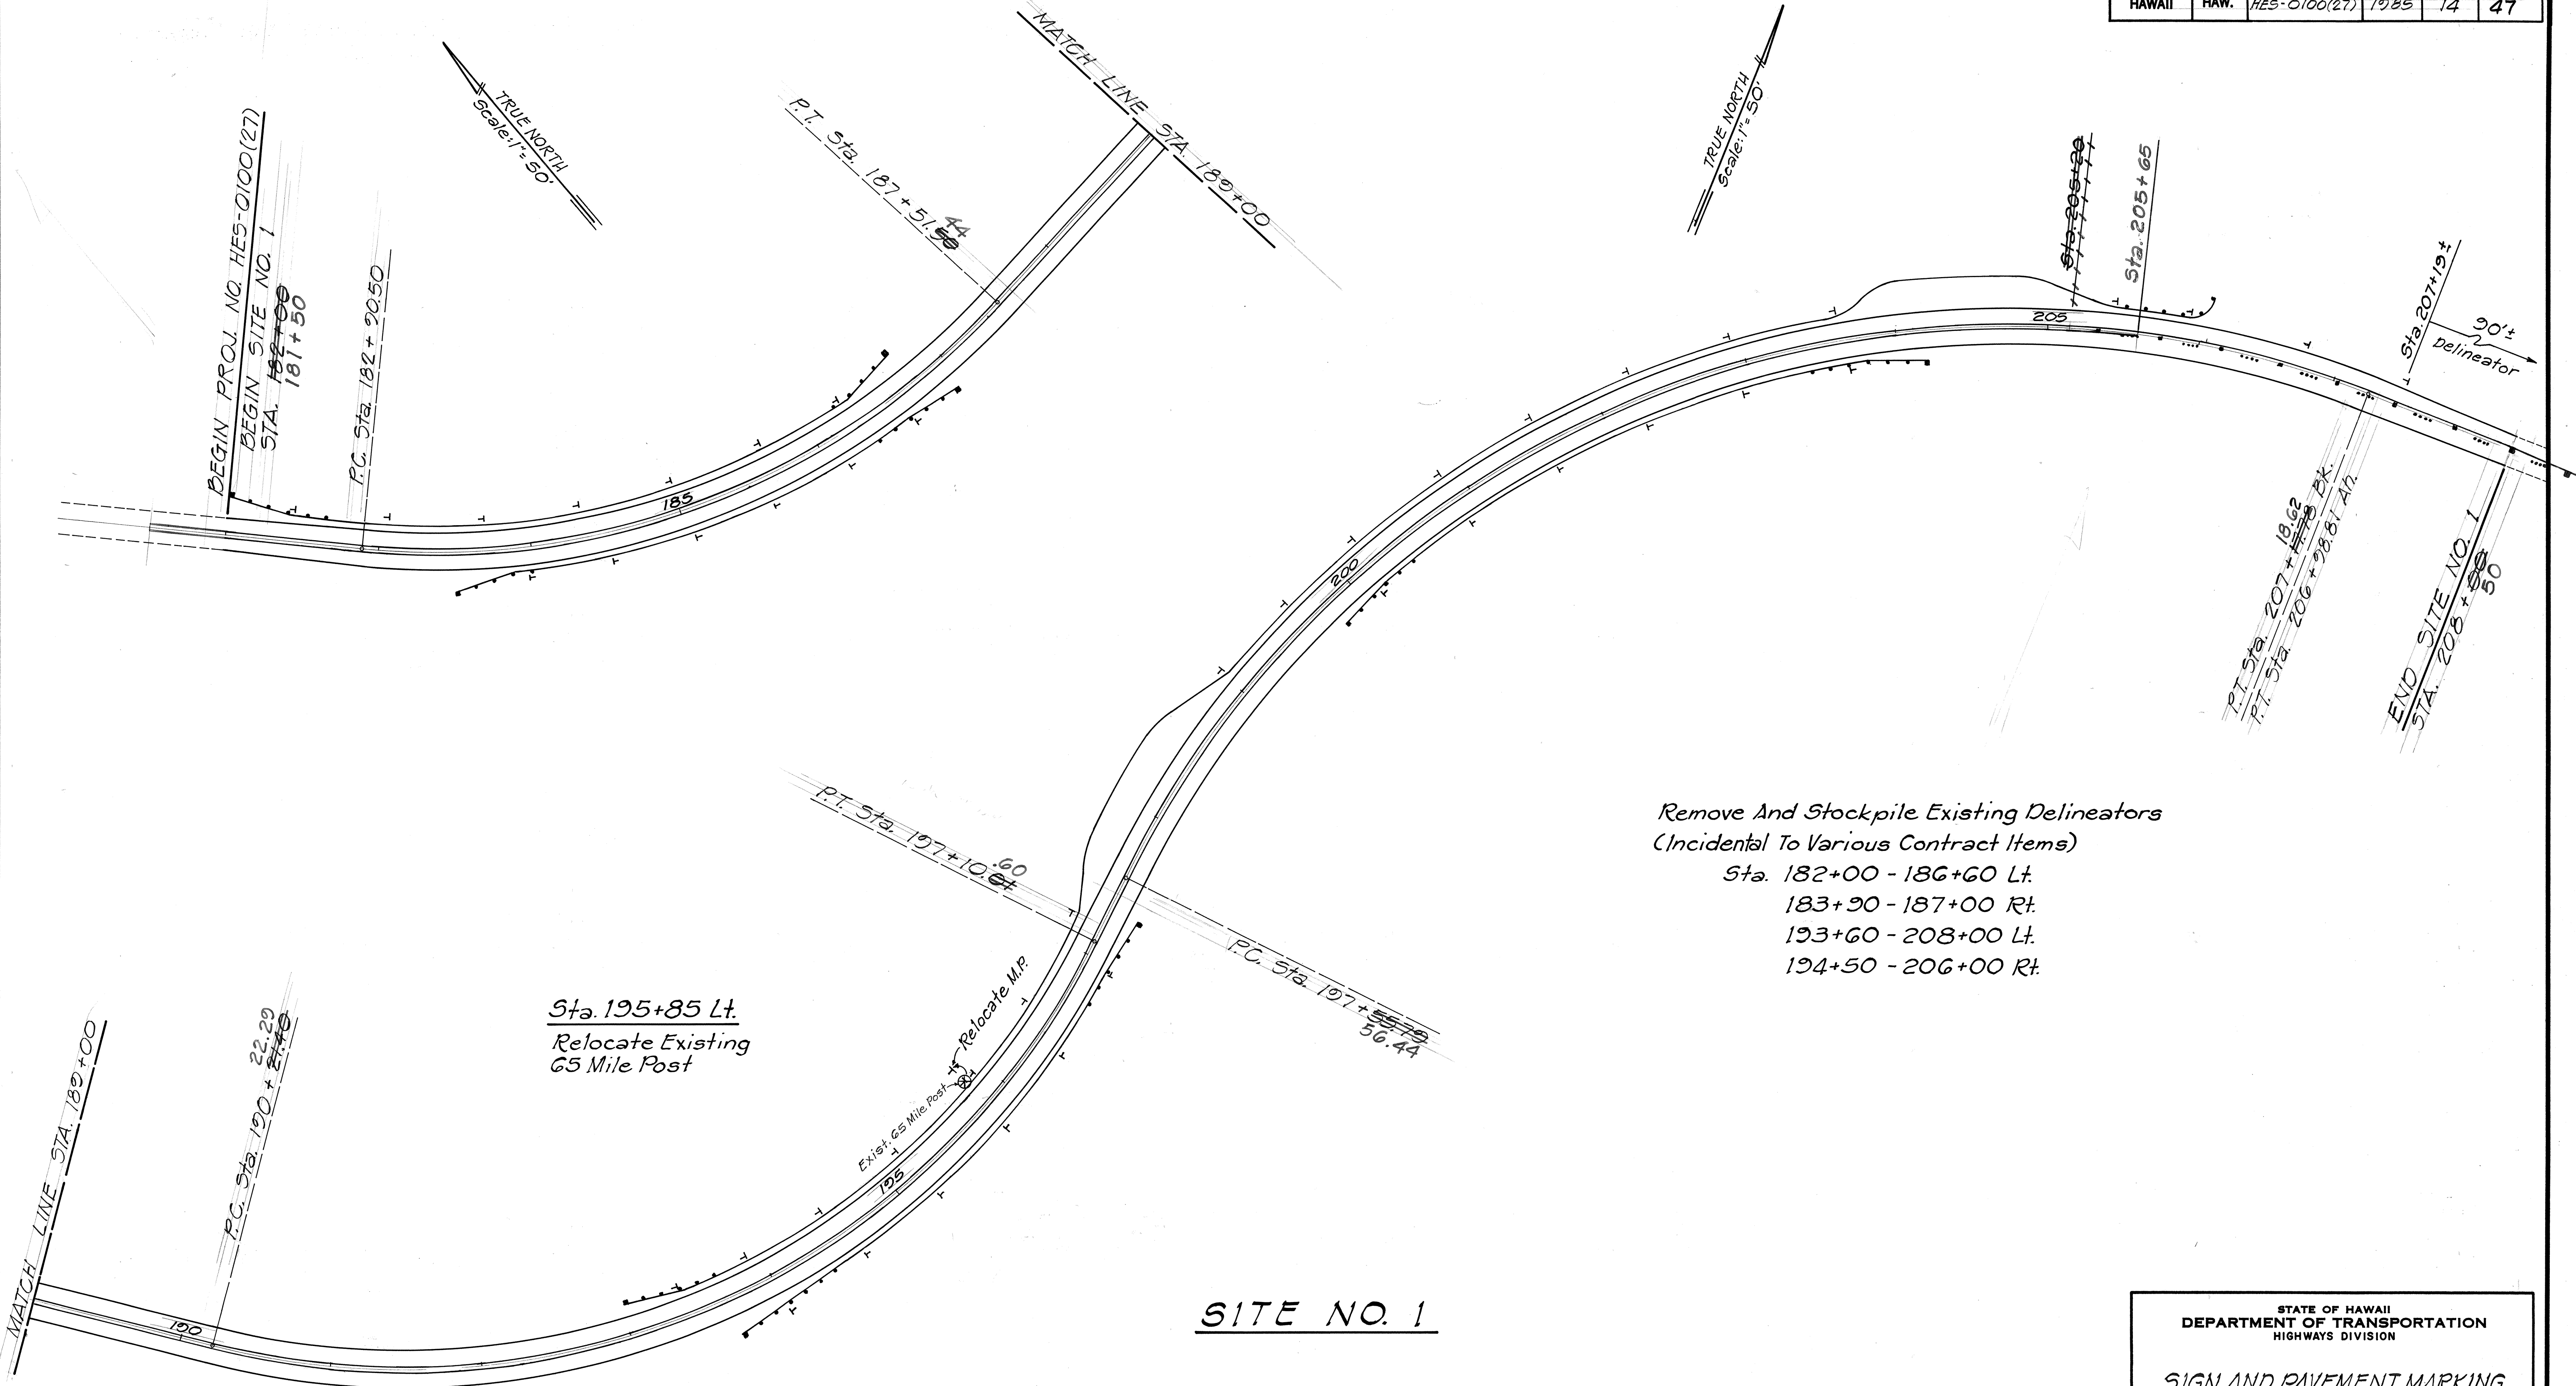

SITE NO. 1

STATE OF HAWAII
DEPARTMENT OF TRANSPORTATION
HIGHWAYS DIVISION

SIGN AND PAVEMENT MARKING


KAWAIHAE ROAD SAFETY IMPROVEMENTS
PHASE I
WAIMA TO KAWAIHAE
FED AID PROJ. NO. HES-0100 (27)
Scale: 1"=50' REV. 1 Date: Feb., 1985

SHEET NO. 1 OF 2 SHEETS

FED. ROAD DIST. NO.	STATE	FED. AID PROJ. NO.	FISCAL YEAR	SHEET NO.	TOTAL SHEETS
HAWAII	HAW.	HES-0100(27)	1985	15	47

Remove And Stockpile Existing Delineators
(Incidental To Various Contract Items)

Sta.330+30 to Sta.338+00 Lt.
Sta.327+60 to Sta.331+30 Rt.

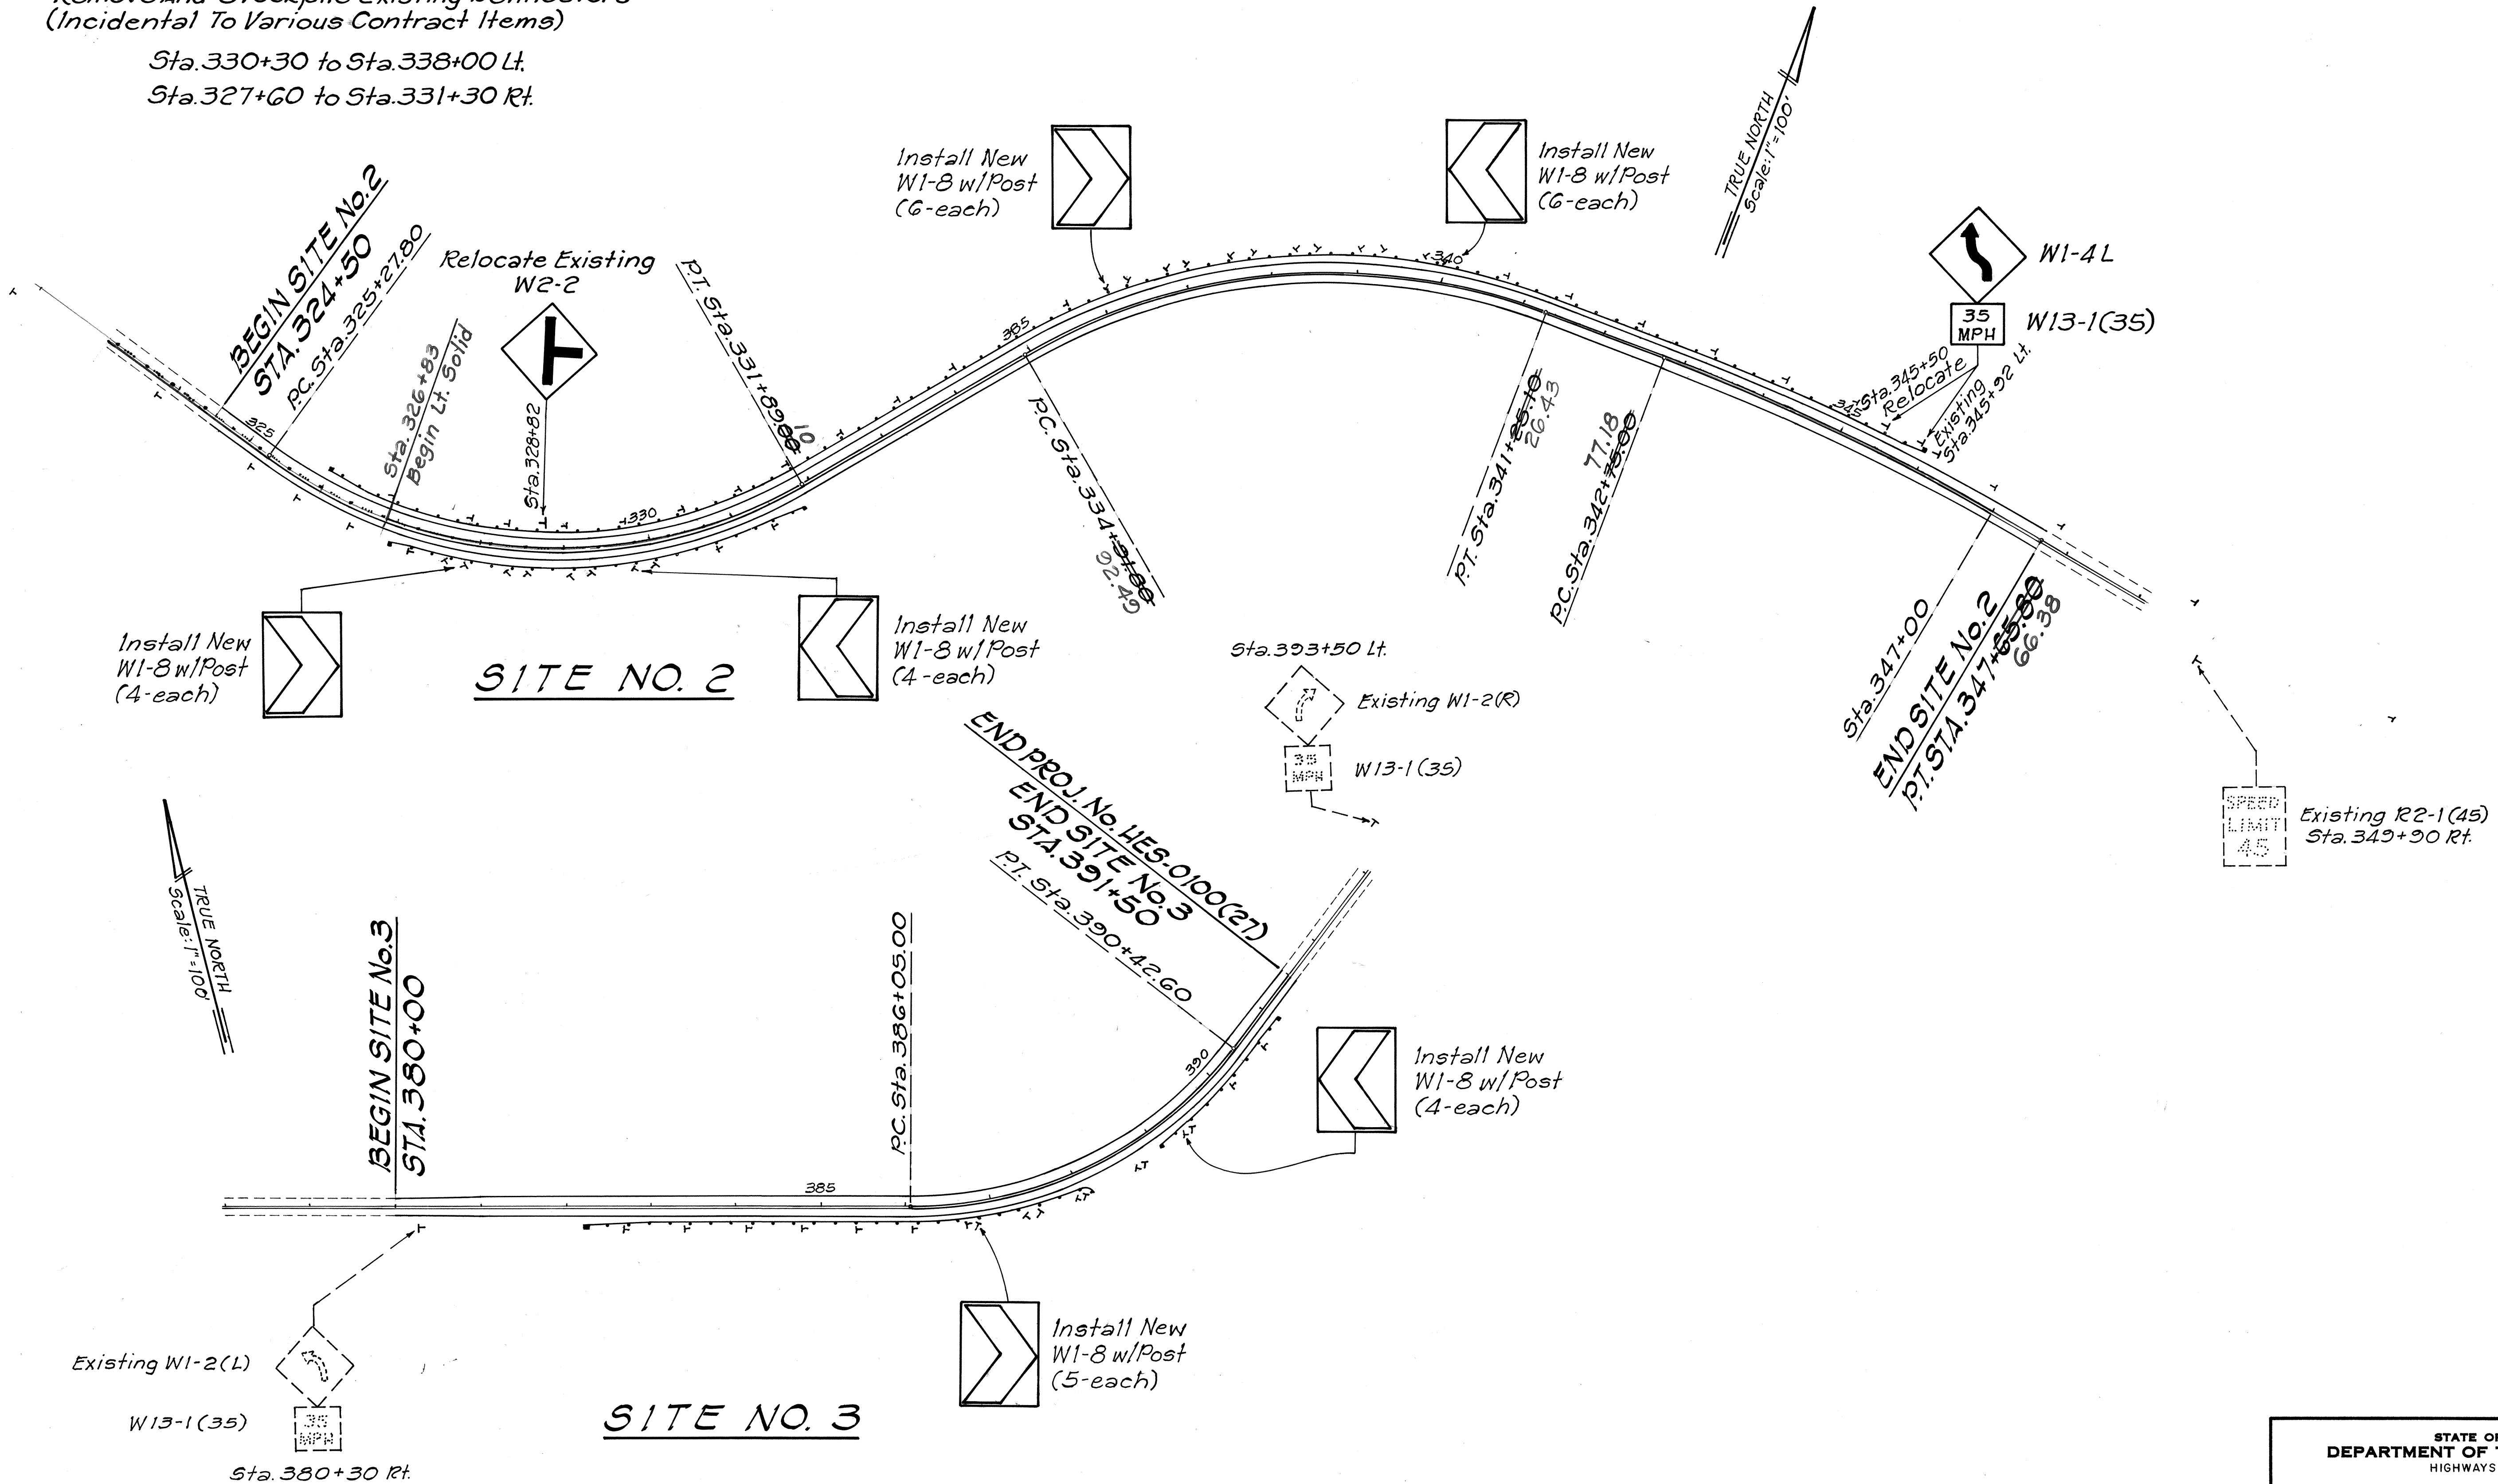

STATE OF HAWAII
DEPARTMENT OF TRANSPORTATION
HIGHWAYS DIVISION

SIGN AND PAVEMENT MARKING

KAWAIHAE ROAD SAFETY IMPROVEMENTS
PHASE I
WAIMEA TO KAWAIHAE
FED. AID PROJ. NO. HES-0100 (27)

REVISION 1

Scale: As Shown Date: Feb., 1985

SHEET NO. 2 OF 2 SHEETS

ORIGINAL PLAN	SURVEY PLOTTED BY	DATE
NOTE BOOK	DRAWN BY	
	DESIGNED BY	
	CHECKED BY	