


INDEX TO DRAWINGS	
SHEET NO.	DESCRIPTION
1	TITLE SHEET
2	TYPICAL SECTIONS & SCHEDULES
3- 4	ROADWAY PLANS
5- 6	PAV'T STRIPING, GUARD RAIL, DRAINAGE, CRM, & A.C. CURB SUMMARIES
7- 9	4'x4' BOX CULVERT EXTENSION PLANS & DETAILS
10-11	CULVERT DETAILS
12-13	CRM RETAINING WALL DETAILS
14-15	SIGN & PAVEMENT MARKING PLANS
16-38	STANDARD DETAILS
39-47	CROSS SECTIONS

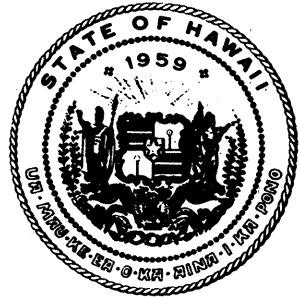

STATE OF HAWAII

DEPARTMENT OF TRANSPORTATION

HIGHWAYS DIVISION

"AS-BUILT"

PLANS FOR

CONSTRUCTION OF

KAWAIHAE ROAD SAFETY IMPROVEMENTS- PHASE I

WAIMEA TO KAWAIHAE

FED. AID PROJ. NO. HES - 0100(27)

REVISION 1

DISTRICT OF SOUTH KOHALA

ISLAND OF HAWAII

CHANGES MADE DURING CONSTRUCTION HAVE

BEEN NOTED ON THESE PLANS AND CHECKED BY:




Stanley Damm

RESIDENT ENGINEER

9/24/87


DATE

FED. ROAD DIST. NO.	STATE	FED. AID PROJ. NO.	FISCAL YEAR	SHEET NO.	TOTAL SHEETS
HAWAII	HAW.	HES-0100(27)	1985	1	47

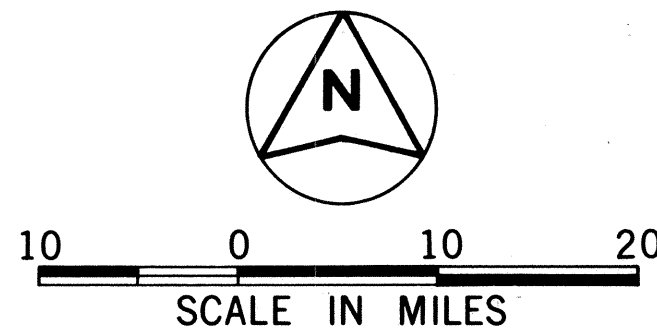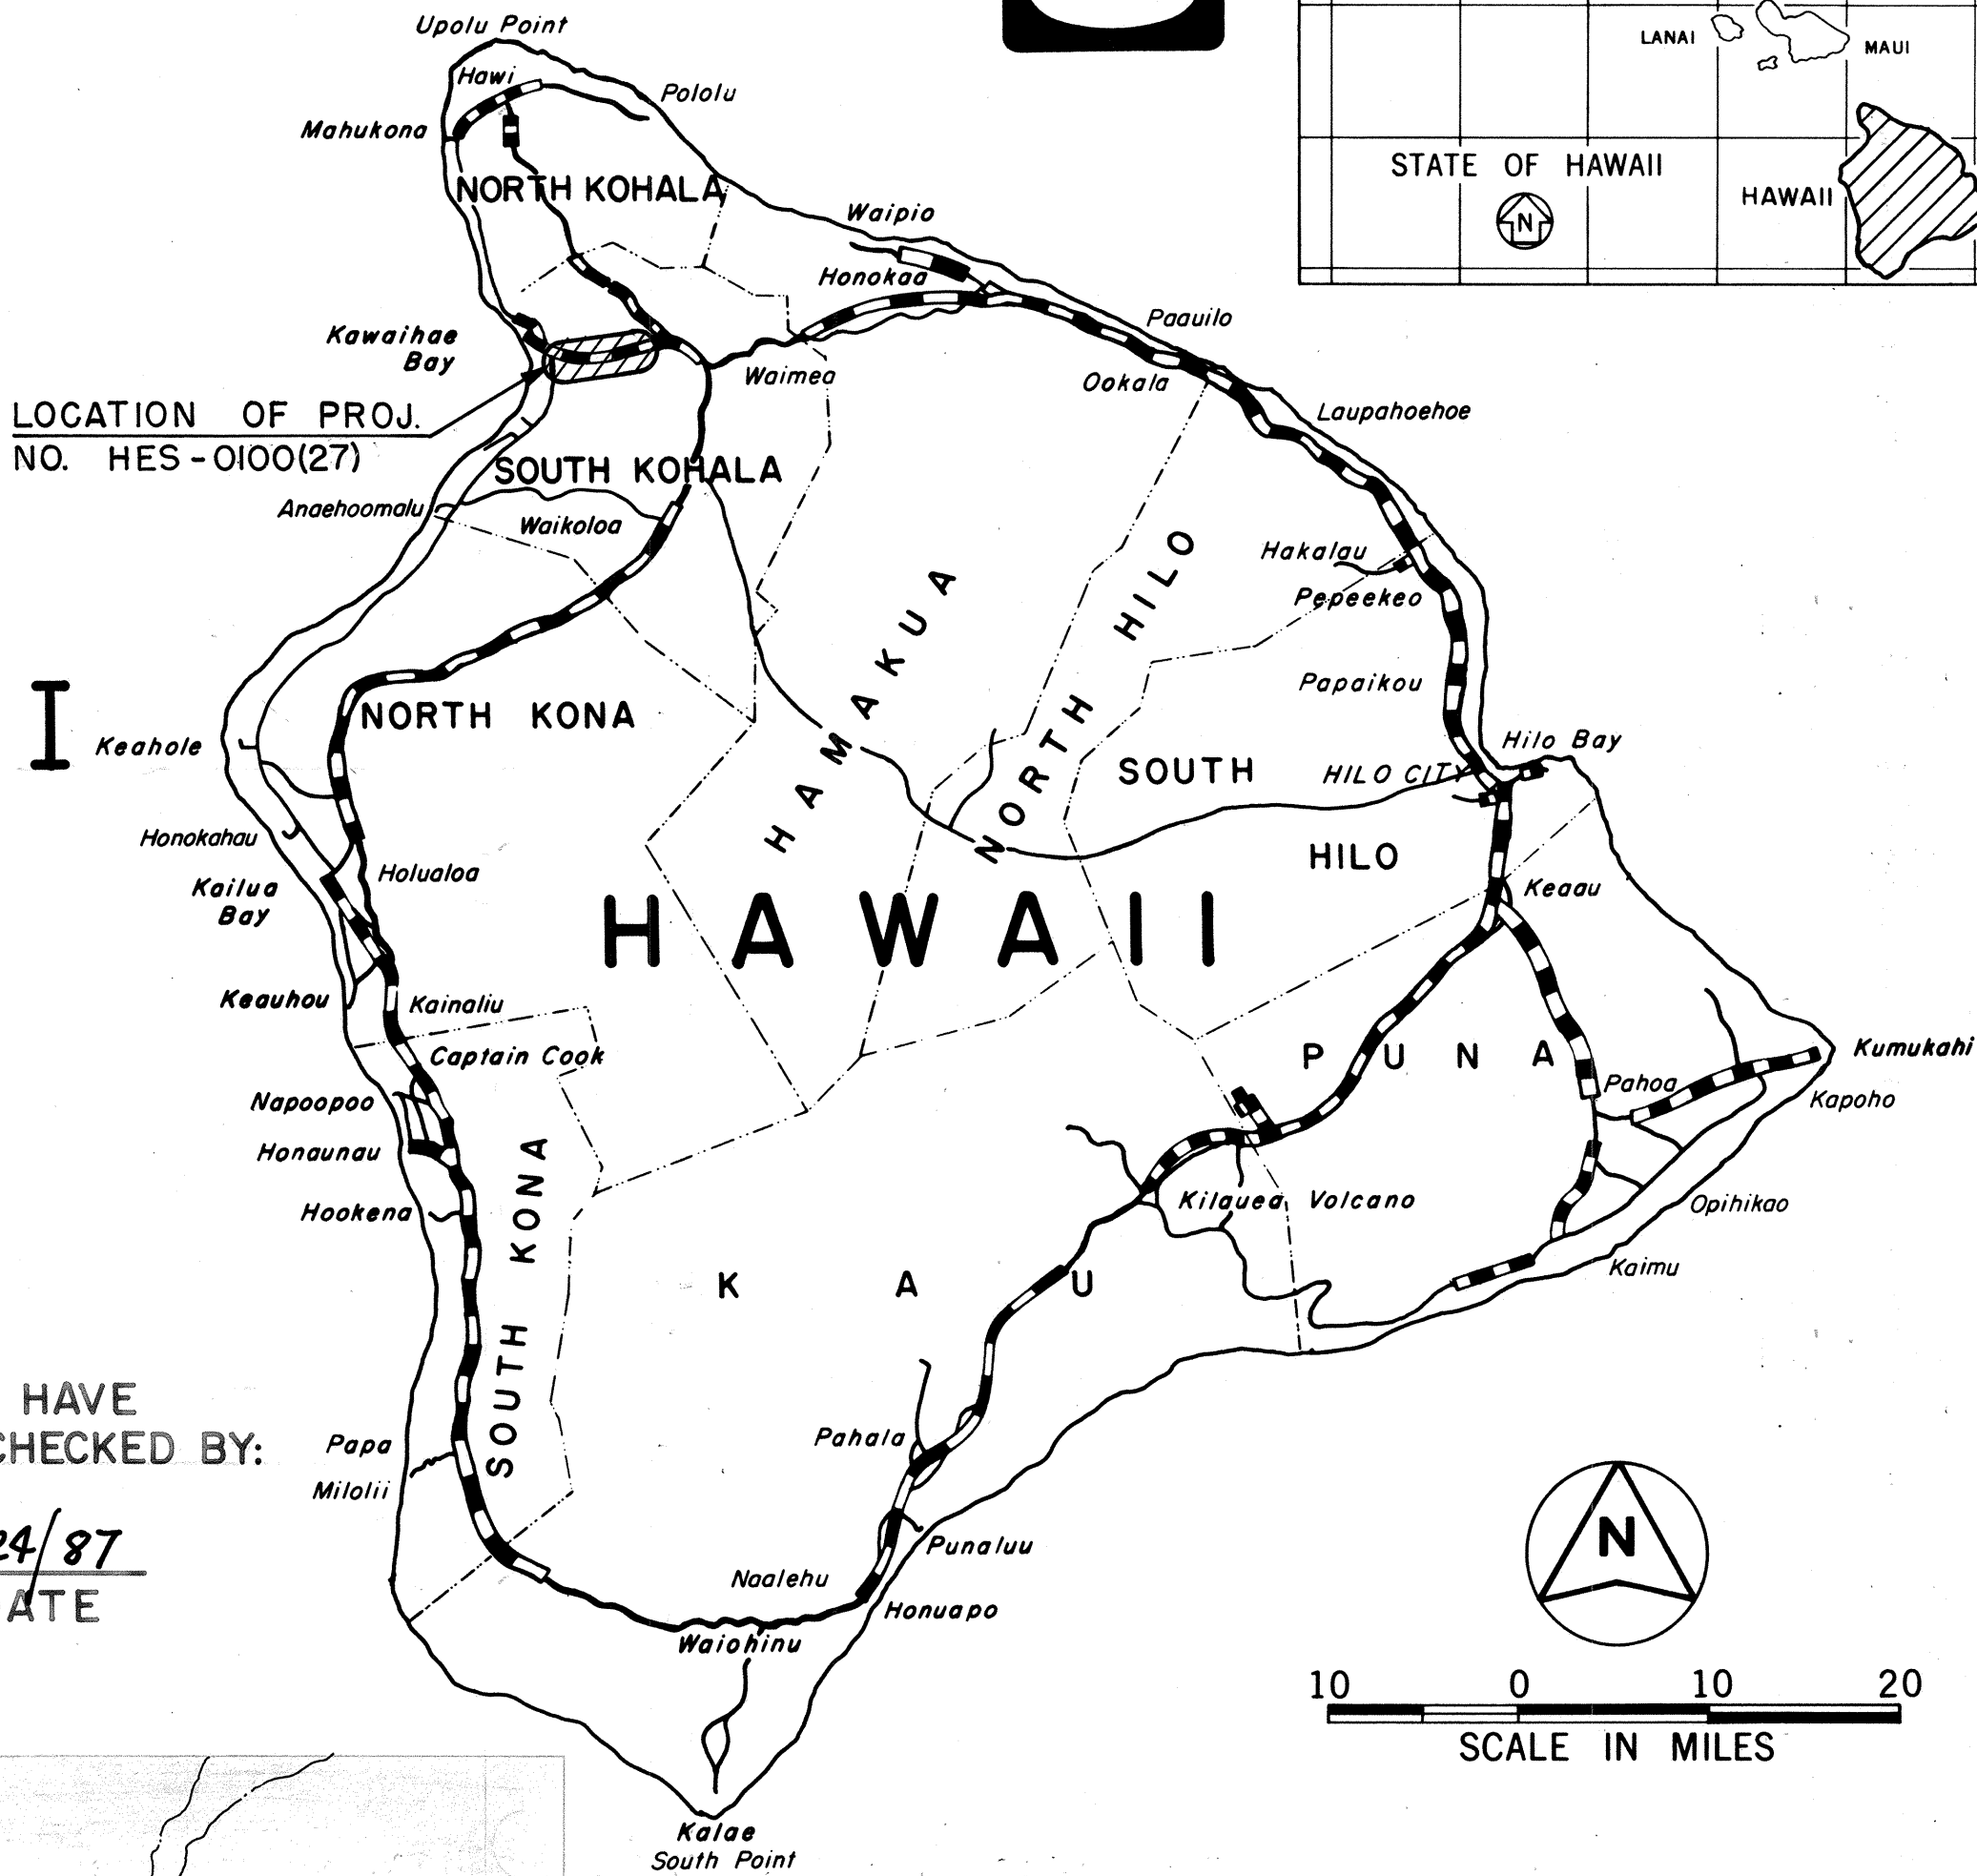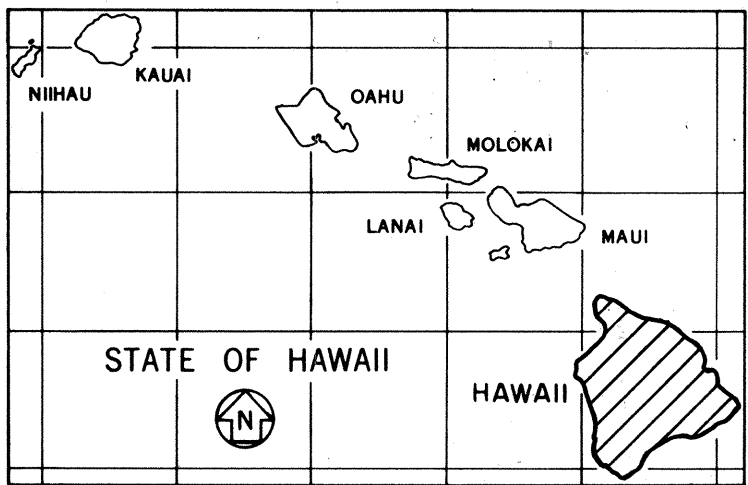


FEDERAL AID PROJECTS PREVIOUSLY CONSTRUCTED

OR UNDER CONSTRUCTION

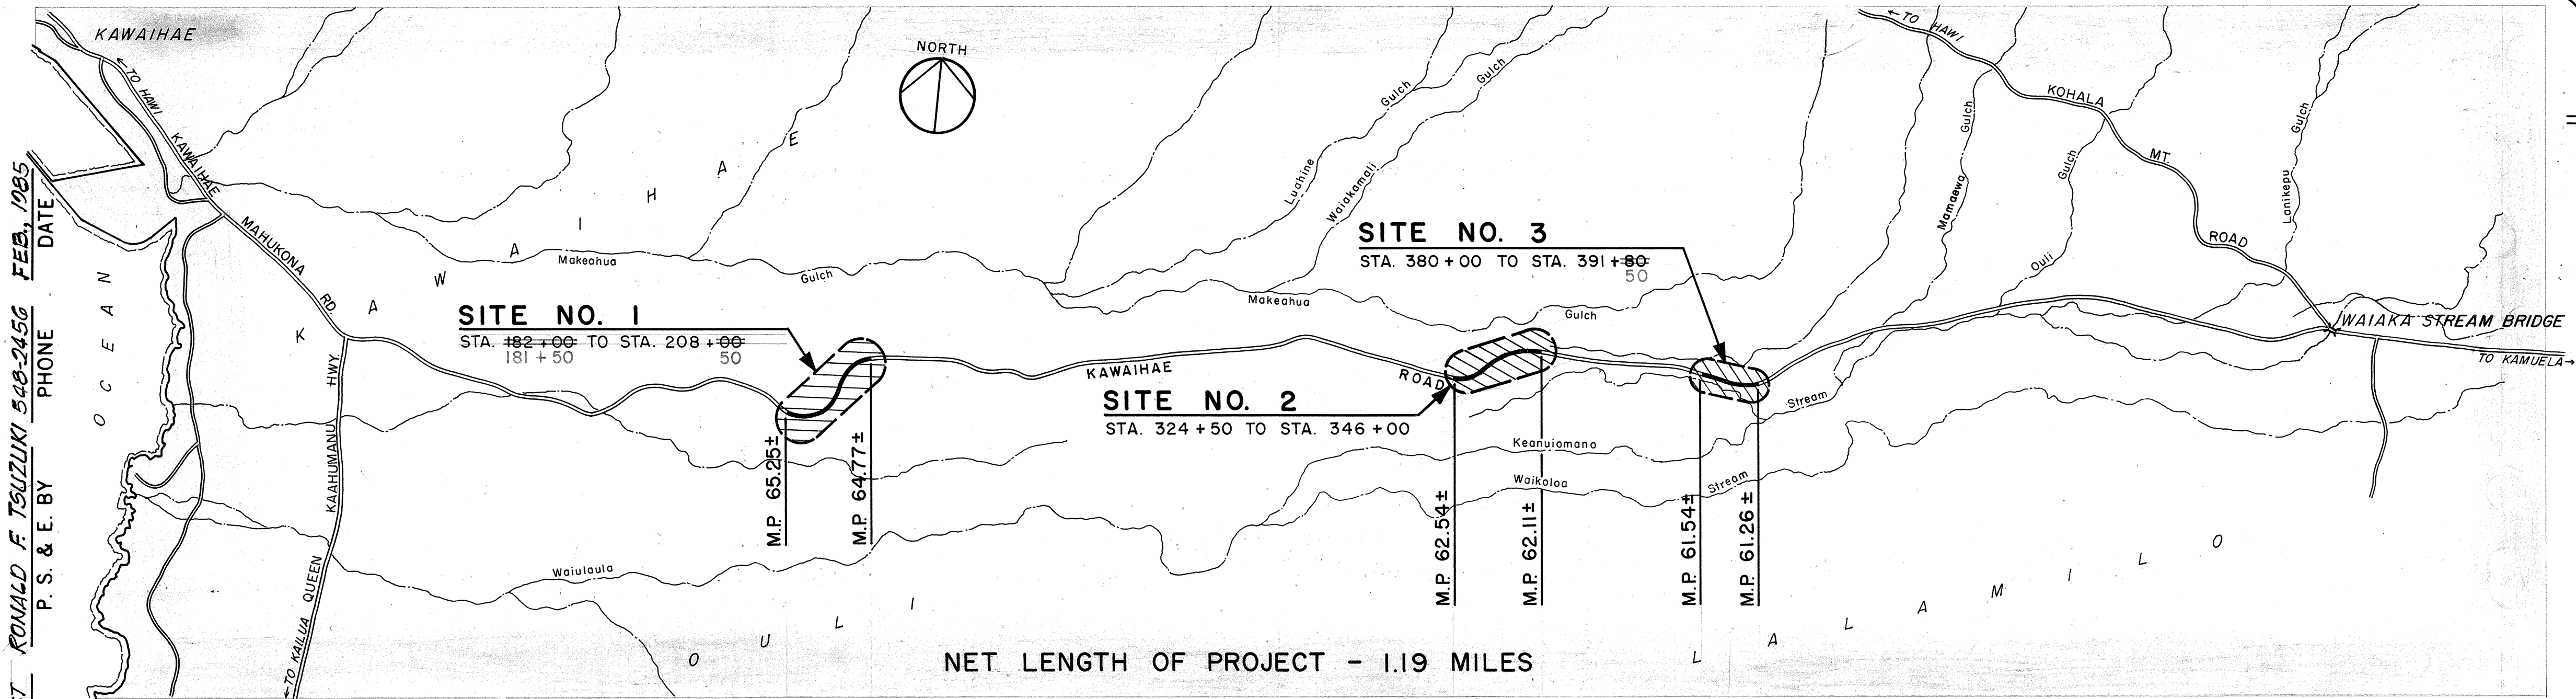

GENERAL LOCATION PLAN

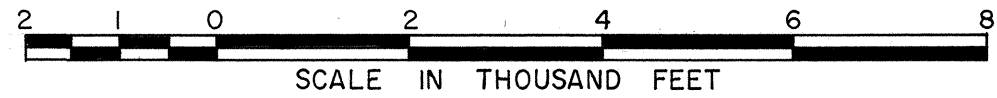

DESIGN DESIGNATION

CURRENT ADT (1984)	3,300
DESIGN ADT (1994)	4,800
DHV	480
T ₂₄	11.5%

DEPARTMENT OF TRANSPORTATION

FEDERAL HIGHWAY ADMINISTRATION

APPROVED:

W. Arthur

DIVISION ADMINISTRATOR

9/13/84

DATE

DEPARTMENT OF TRANSPORTATION

STATE OF HAWAII

APPROVED:

Michael D. Damm

DIR. OF TRANSPORTATION

9/13/84

DATE

HAWAII DISTRICT

DESIGNED BY

RONALD F. TSUZUKI 548-2456

DATE

FEB, 1985

PHONE

P. S. & E. BY