

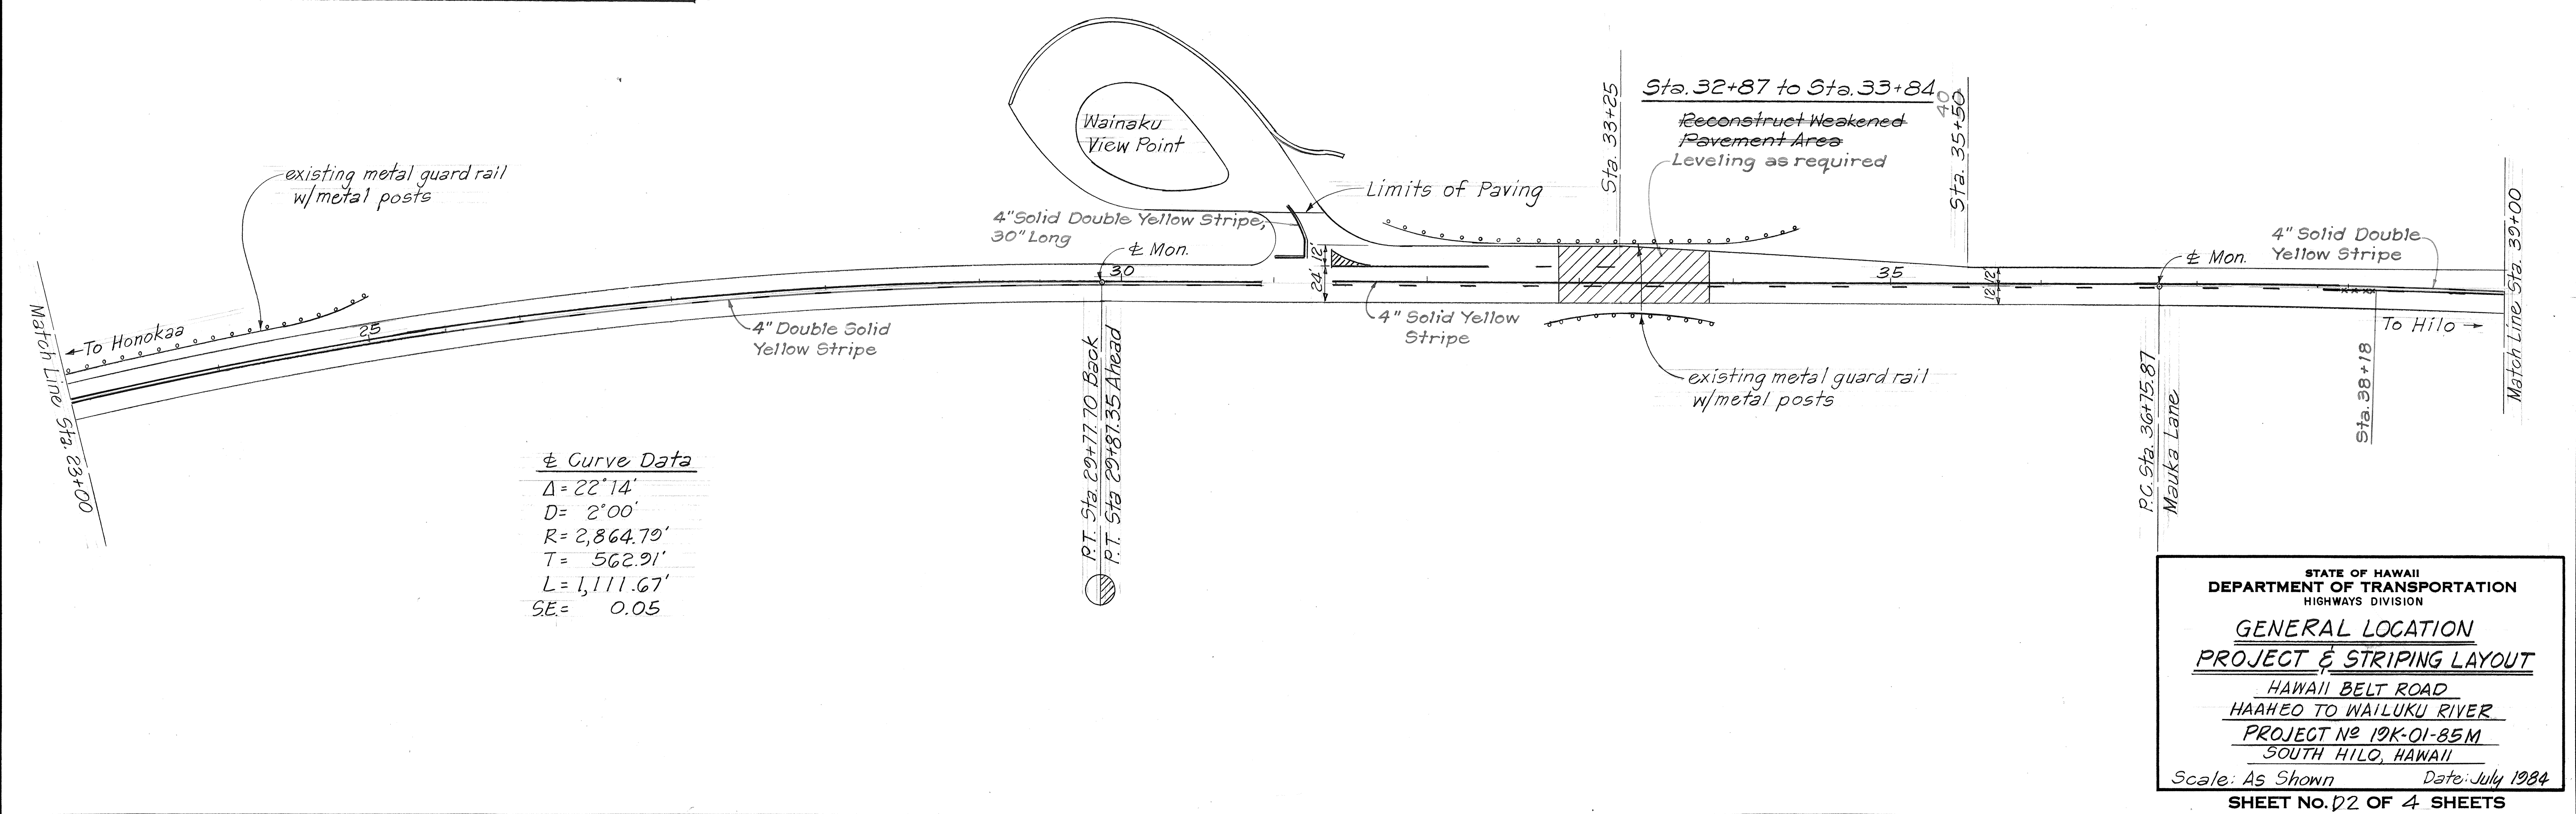
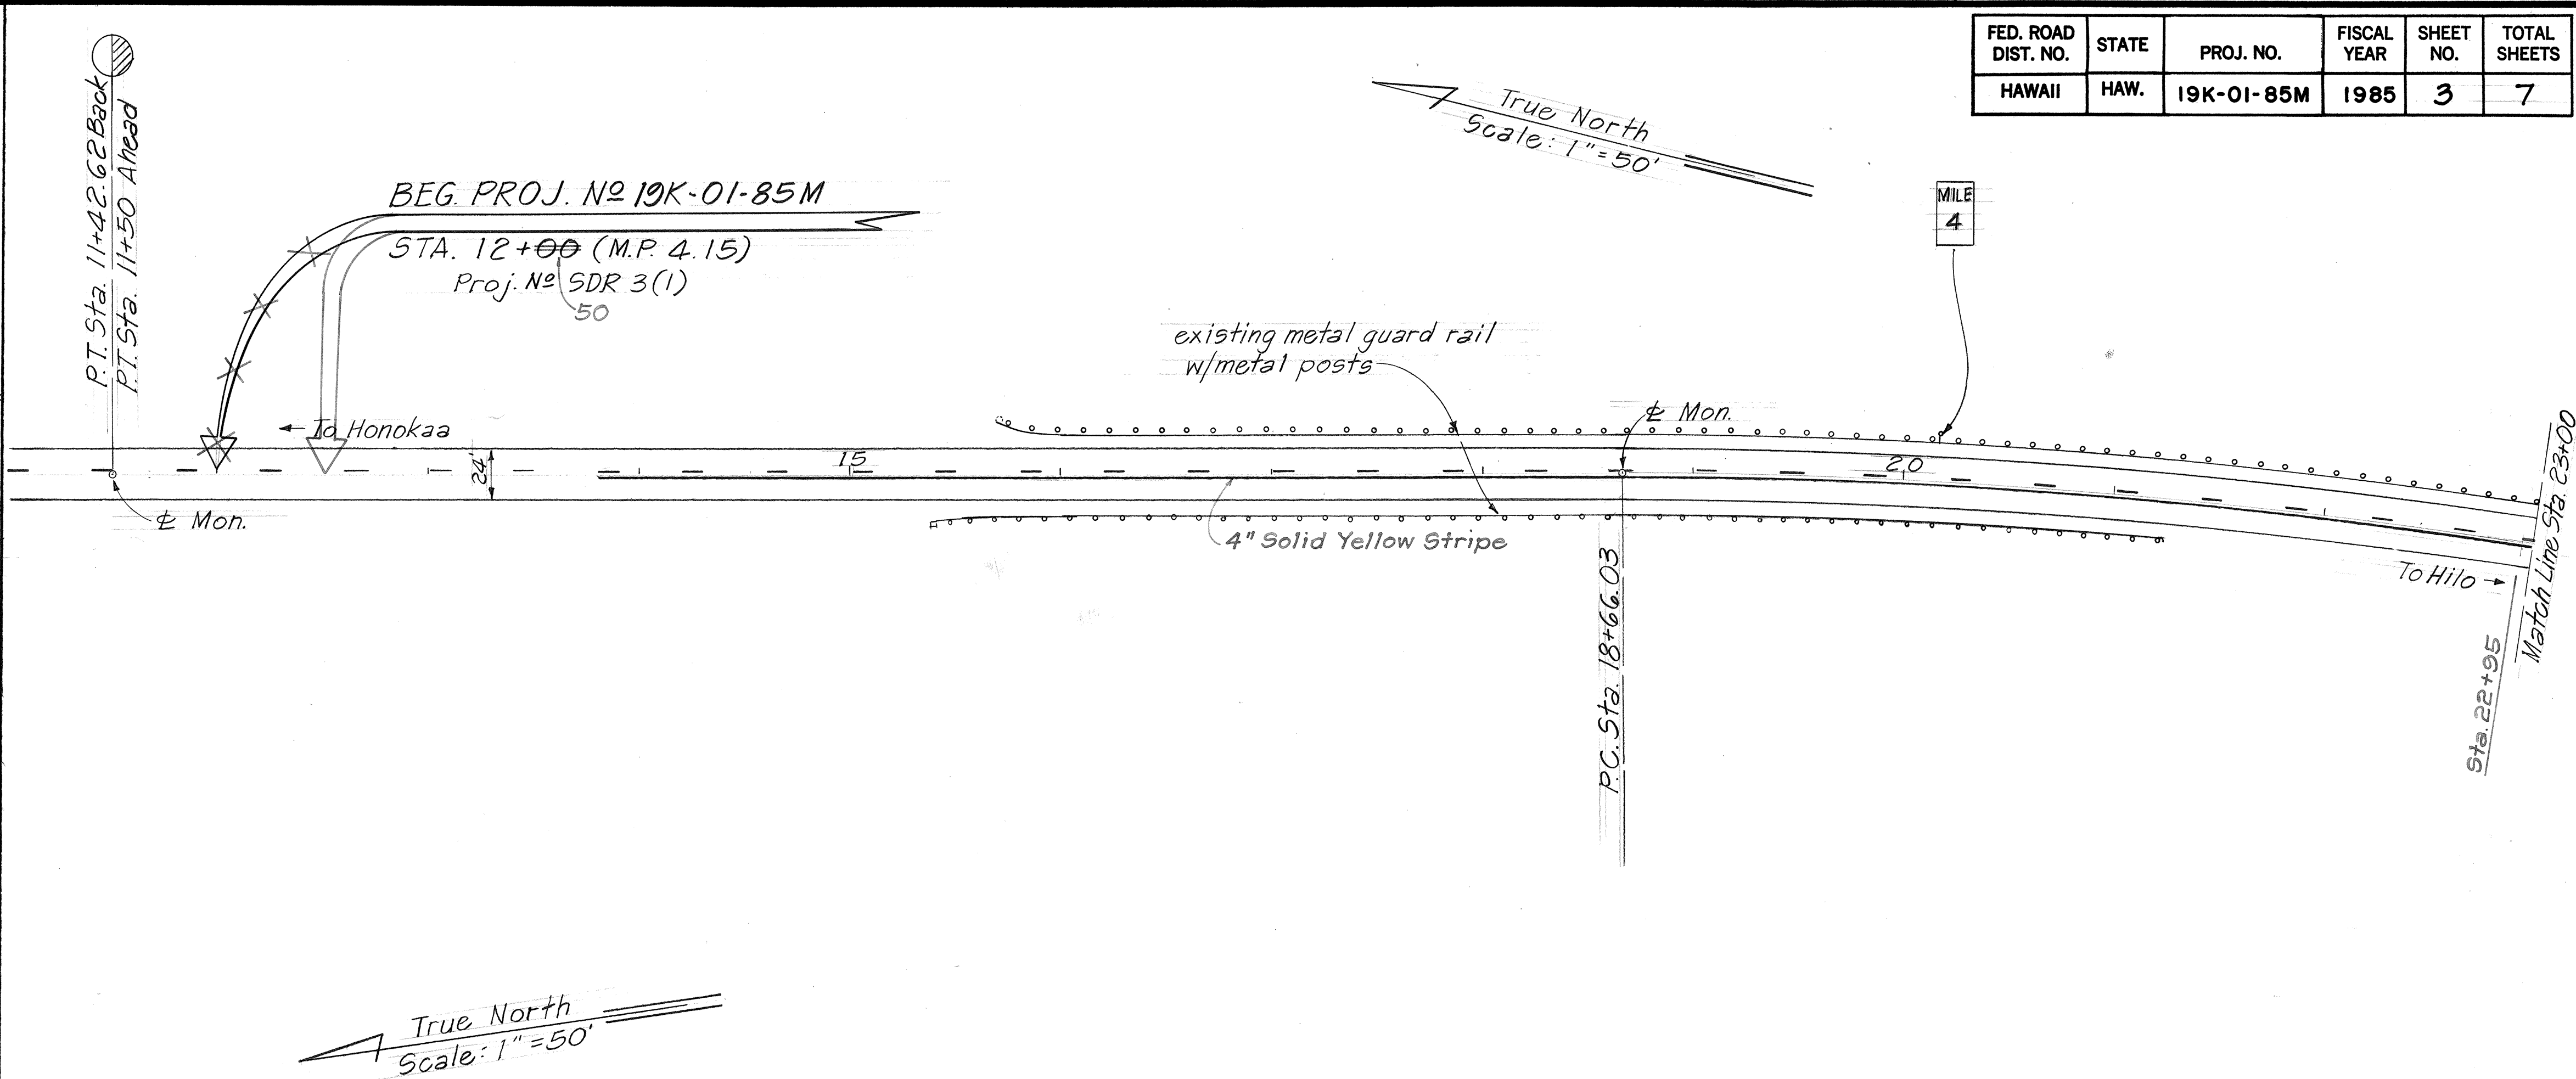


FED. ROAD DIST. NO.	STATE	PROJ. NO.	FISCAL YEAR	SHEET NO.	TOTAL SHEETS
HAWAII	HAW.	19K-01-85M	1985	3	7

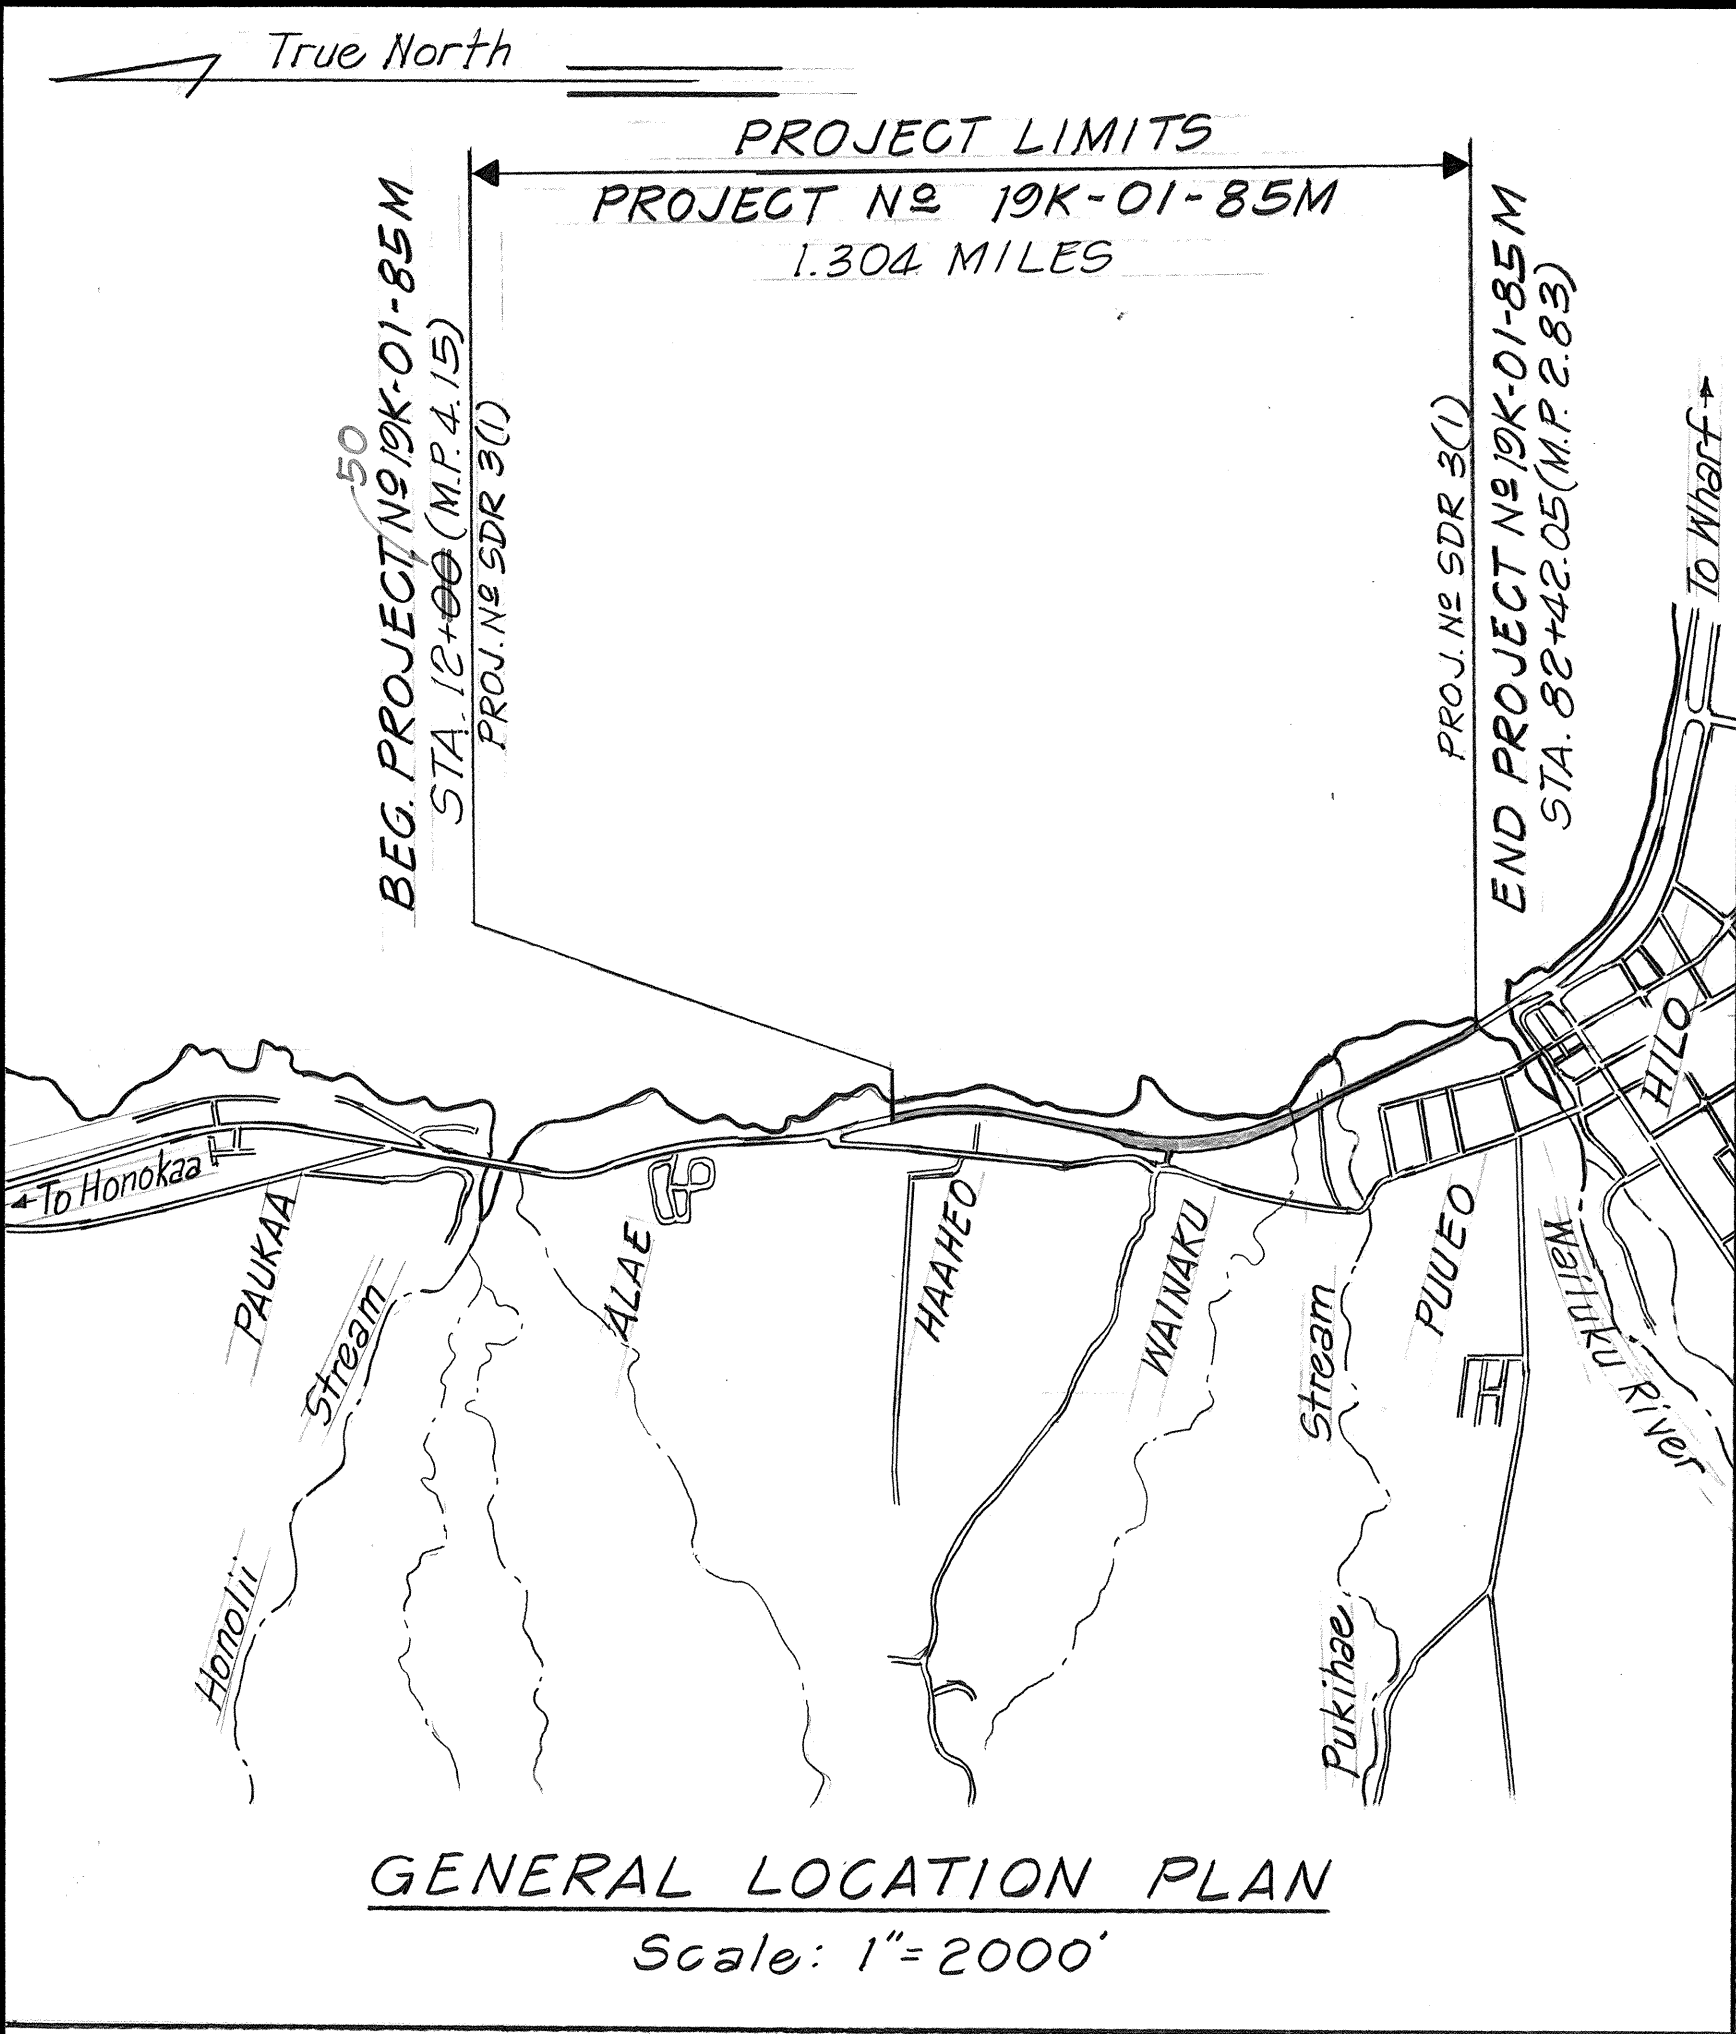

ORIGINAL PLAN	SURVEY PLOTTED BY	DATE
DESIGNED BY	DRAWN BY	" "
NOTED BY	TRACED BY	" "
QUANTITIES BY	CHECKED BY	" "
NO. 10/13/84		

FED. ROAD DIST. NO.	STATE	PROJ. NO.	FISCAL YEAR	SHEET NO.	TOTAL SHEETS
HAWAII	HAW.	19K-01-85M	1985	4	7

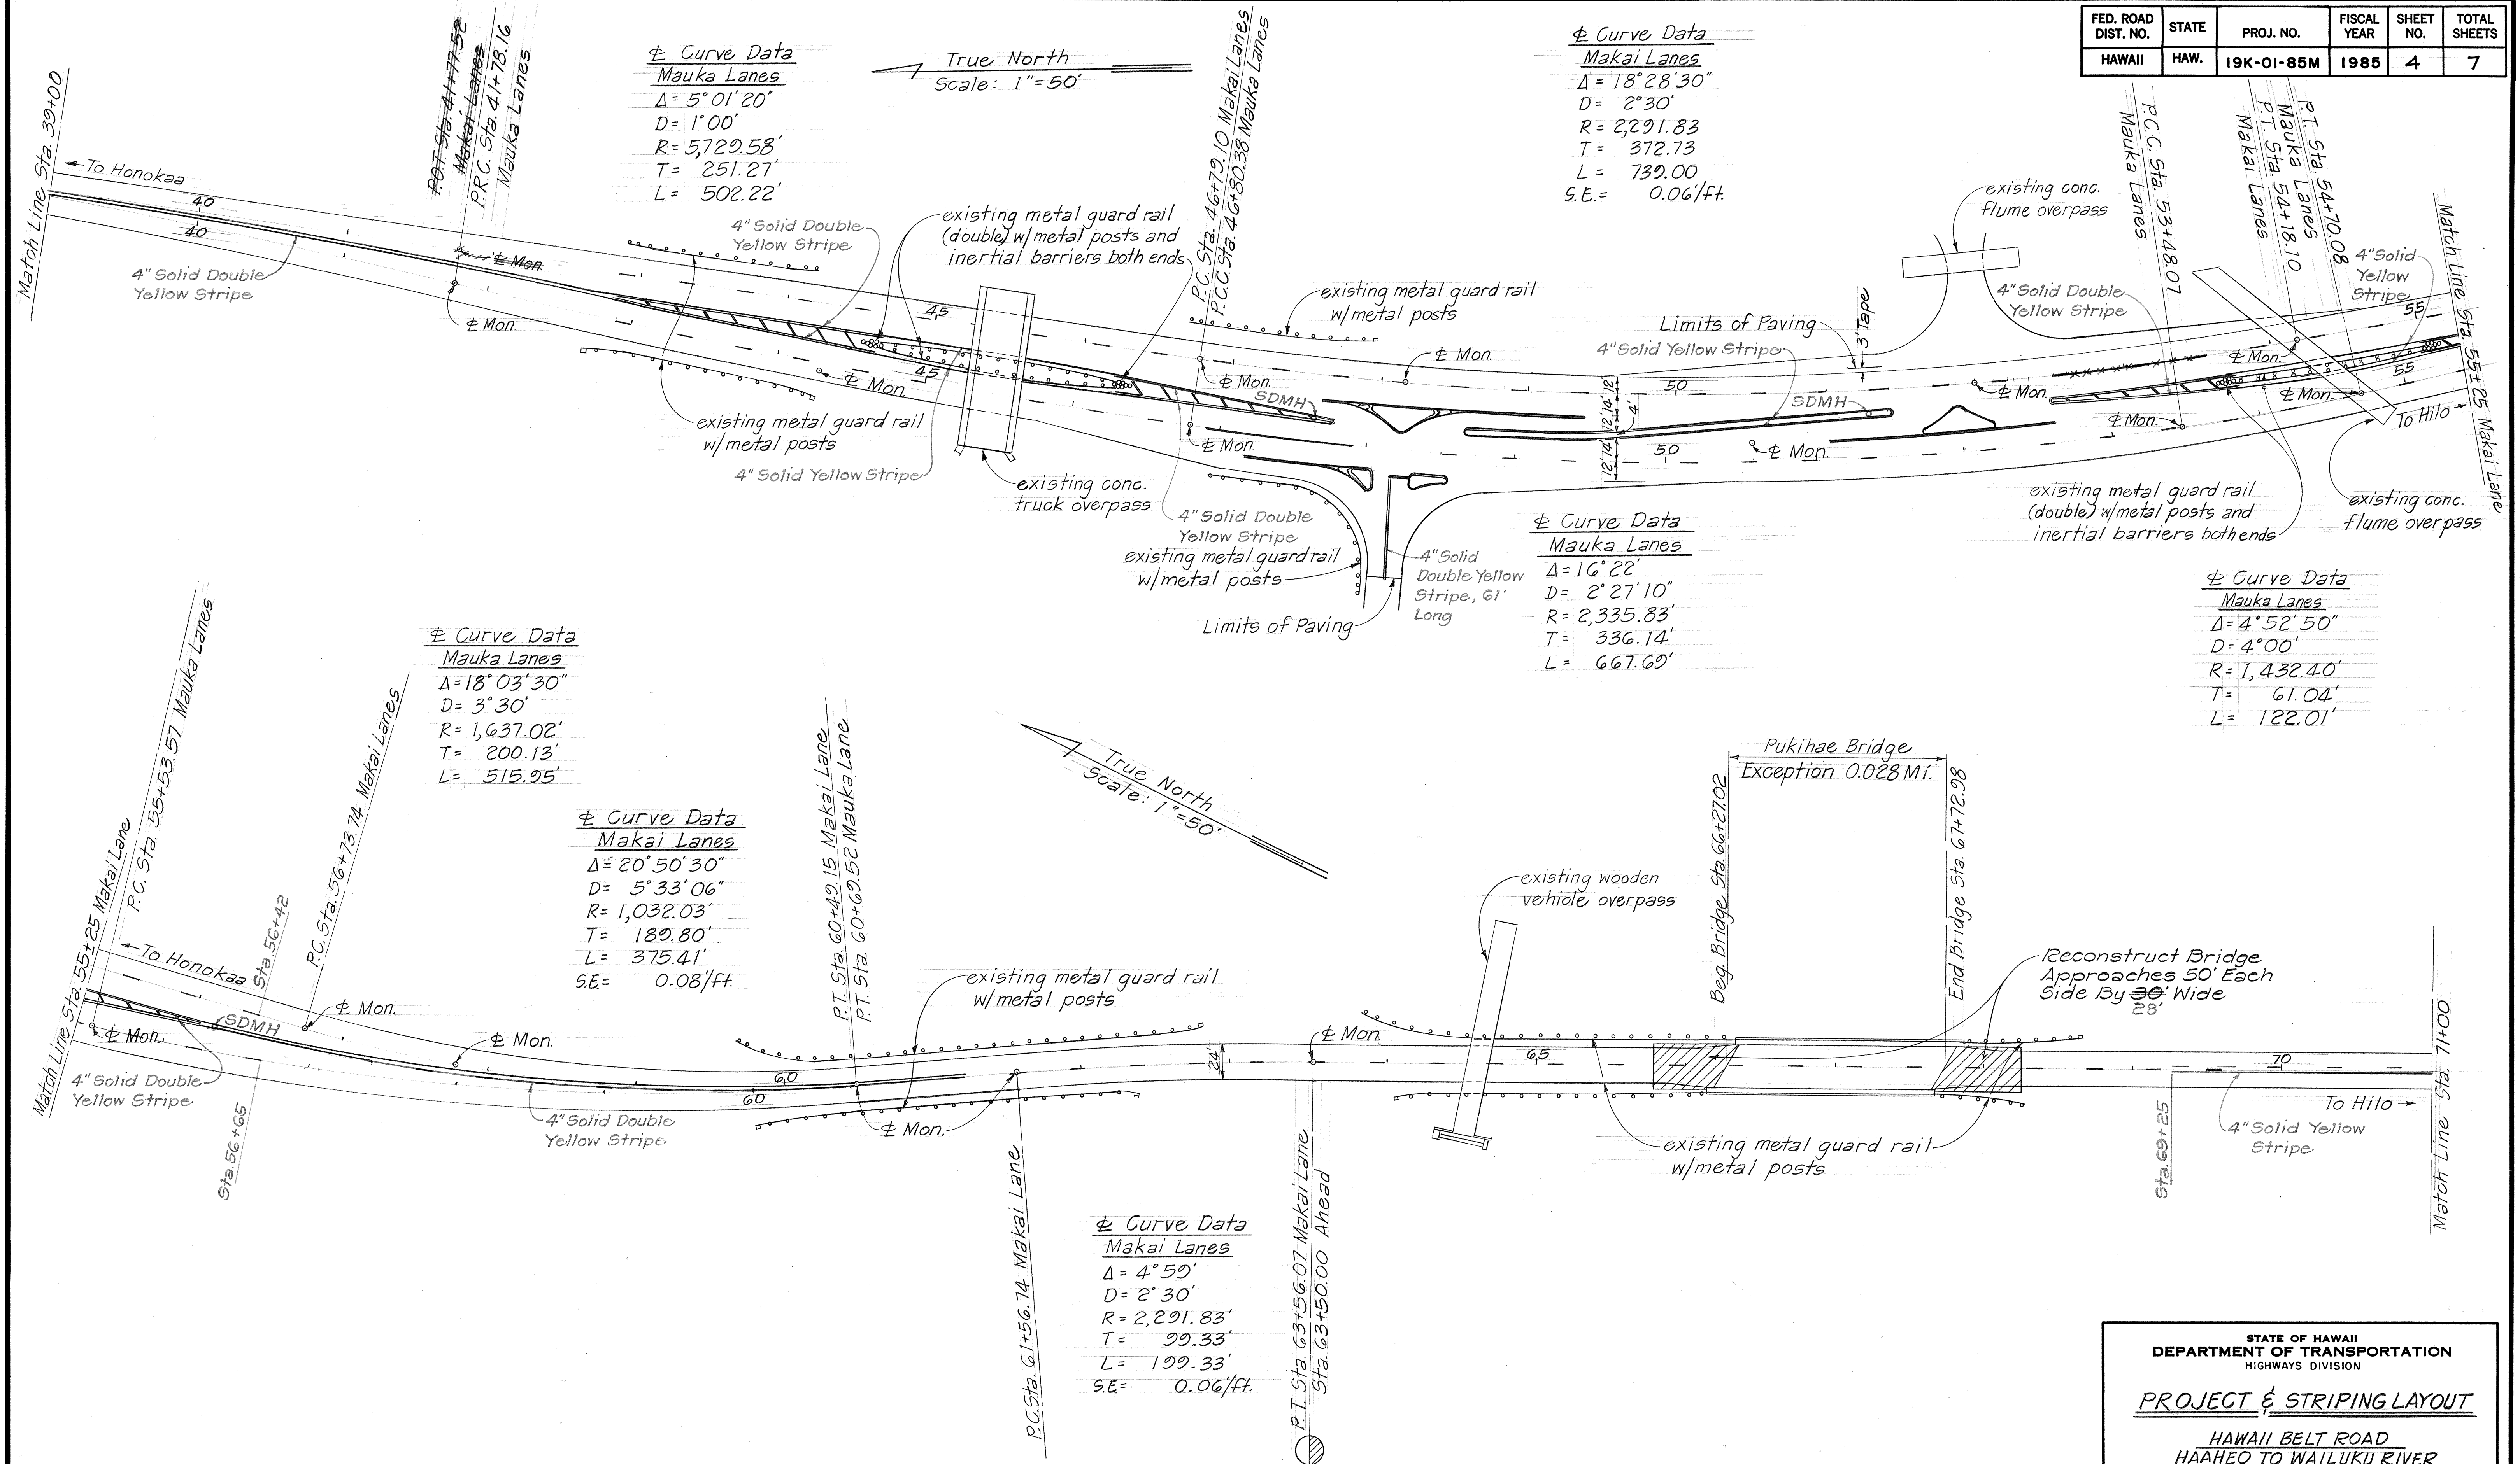

ORIGINAL PLAN	SURVEY PLOTTED BY	DATE
	DRAWN BY	"
	TRACED BY	"
	DESIGNED BY	"
	QUANTITIES BY	"
	CHECKED BY	"
NOTE BOOK F.B. # 1258		
No. 75125-24		

STATE OF HAWAII
DEPARTMENT OF TRANSPORTATION
HIGHWAYS DIVISION


PROJECT 6, STRIPING LAYOUT

HAWAII BELT ROAD
HAAHEO TO WAILUKU RIVER

PROJECT No 19K-01-85M
SOUTH HILO, HAWAII

Scale: As Shown Date: July 1984

SHEET NO. D3 OF 4 SHEETS

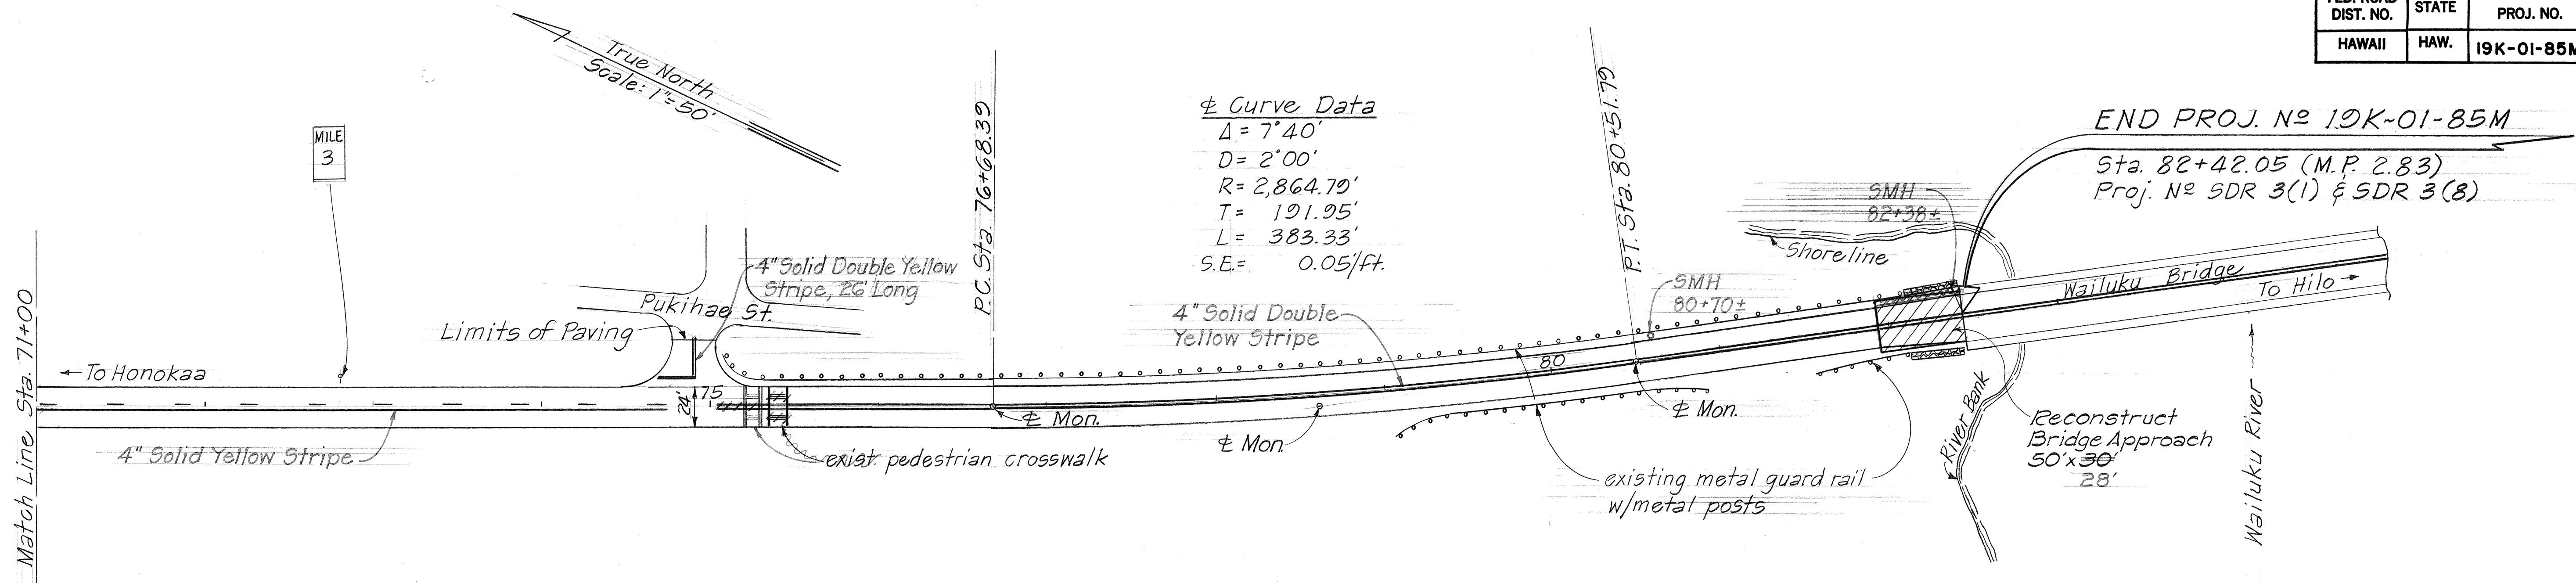

PAVEMENT MARKER SCHEDULE

STATION		DESCRIPTION	TYPE				
FROM	TO		A	C	D	H	J
12+00	13+80	Passing - Both Sides	0	0	4	6	1220
13+80	23+00	Passing-L No Passing-R	0	0	23	4	23
23+00	25+00	No Passing - Both Sides	0	0	40	4	0
25+00	30+00	No Passing-L Passing-R	0	0	8	7	56
30+00	31+40	Open					
31+40	37+80	No Passing-L Passing-R	0	0	17	0	68
37+80	42+80	Passing-L No Passing-R	0	0	22	8	0
31+20	33+24	Lane Island & Channelizing Lane	8	11	0	0	0
47+20	52+60	Lane Islands (4)	0	43	0	0	0
INBOUND LANES							
43+00	46+00	Passing - Both Sides	36	40	10	4	0
46+00	47+00	No Passing - Both Sides	0	6	0	0	0
47+00	48+00	Open	0	0	0	4	0
48+00	56+00	Passing - Both Sides	88	80	23	0	0
42+80	47+75	Median Island	0	0	0	56	50
48+65	51+50	Median Island	0	0	0	31	30
52+40	56+10	Median Island	0	0	0	42	36
OUTBOUND LANES							
43+00	51+40	Passing - Both Sides	136	88	22	0	0
51+40	52+60	Open					
52+60	56+00	Passing - Both Sides	24	12	0	0	0
56+10	57+30	No Passing - Both Sides	0	0	22	6	0
57+30	61+20	No Passing-L Passing-R	0	0	6	5	40
61+20	69+00	Passing - Both Sides	0	0	20	22	0
69+00	74+75	Passing-L No Passing-R	0	0	14	7	156
74+75	75+00	Open & crosswalk	0	0	0	2	0
75+00	82+42	No Passing - Both Sides	0	0	37	38	0
Sideways	31+20, LT.	No Passing - Both Sides	0	0	8	0	0
TOTALS			240	82	145	163	460

Φ AND REFERENCE SURVEY MONUMENT SCHEDULE

PROJ. NO. (EXIST.)	ITEM NO. 613.010 Φ MONUMENTS	ITEM NO. 650.0100 RECOVERED Φ AND REFERENCE SURVEY MONUMENTS	*H
SDR 3(1)	STATION	STATION	
	PT. Sta. 41+77.52 Makai	P.T. Sta. 11+42.62 Back	2 3/16"
	80+15.72	Sta. 11+50.00 Ahead	
	60+49.15	P.C. Sta. 18+66.03	1 1/2"
		P.T. Sta. 29+77.70 Back	1 1/2"
		Sta. 29+87.35 Ahead	
		P.C. Sta. 36+75.87 Mauka Lane	1 1/2"
		P.R.C. Sta. 41+78.16 Mauka Lane	2 3/16"
		R/W Sta. 44+29.00 Mauka Lane	1 1/2"
		P.C. Sta. 46+79.10 Makai Lane	1 1/2"
		P.C.C. Sta. 46+80.38 Mauka Lane	1 1/2"
		R/W Sta. 50+58.00 Mauka Lane	1 1/2"
		P.C.C. Sta. 53+48.07 Mauka Lane	1 1/2"
		P.T. Sta. 54+18.10 Makai Lane	2 3/16"
		P.T. Sta. 54+70.08 Mauka Lane	2 3/16"
		P.C. Sta. 56+73.74 Makai Lane	2 3/16"
		R/W P.T. Sta. 57+77.00 Makai Lane	1 1/2"
		P.T. Sta. 60+49.15 Makai Lane	1 1/2"
		P.T. Sta. 60+69.52 Mauka Lane	
		P.C. Sta. 61+56.74 Makai Lane	1 1/2"
		P.T. Sta. 63+56.07 Mauka Lane	2 3/16"
		Sta. 63+50.00 Ahead	
		P.C. Sta. 76+68.39	1 1/2"
		P.I. Sta. 78+60.34	1 1/2"
		P.T. Sta. 80+51.72	1 1/2"
		P.C. Sta. 55+53.57 Mauka Lane	2 3/16"
		P.O.C. Sta. 48+15 Makai Lane	
		P.O.C. Sta. 52+00 Makai Lane	
TOTALS			21

SIDE ROAD SCHEDULE

PROJ. NO. (EXIST.)	LOCATION
SDR 3(1)	Sta. 31+20 Lt.
	Sta. 48+15 Rt.
	Sta. 74+90 Lt.
TOTAL	3

STATE OF HAWAII
DEPARTMENT OF TRANSPORTATION
HIGHWAYS DIVISION
STRIPING & PROJECT LAYOUT,
PAVEMENT MARKER, Φ MON.
& SIDE ROAD SCHEDULES
HAWAII BELT ROAD
HAAHEO TO WAILUKU RIVER
PROJECT NO. 19K-01-85M
SOUTH HILO, HAWAII
Scale: As Shown Date: July 1984
SHEET NO. 04 OF 4 SHEETS