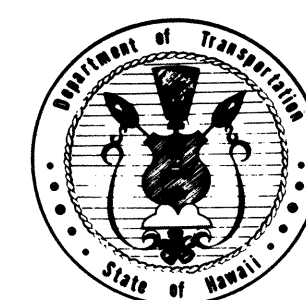


[illegible]

STATE OF HAWAII

DEPARTMENT OF TRANSPORTATION

HIGHWAYS DIVISION

"AS-BUILT"

PLANS FOR

CONSTRUCTION OF

**HAWAII BELT ROAD RESURFACING**




HAAHEO TO WAILUKU RIVER

PROJECT NO. 19K-01-85M

DISTRICT OF SOUTH HILO

ISLAND OF HAWAII

| FED. ROAD<br>DIST. NO. | STATE | PROJ. NO.  | FISCAL<br>YEAR | SHEET<br>NO. | TOTAL<br>SHEET |
|------------------------|-------|------------|----------------|--------------|----------------|
| HAWAII                 | HAW.  | 19K-01-85M | 1985           | 1            | 7              |

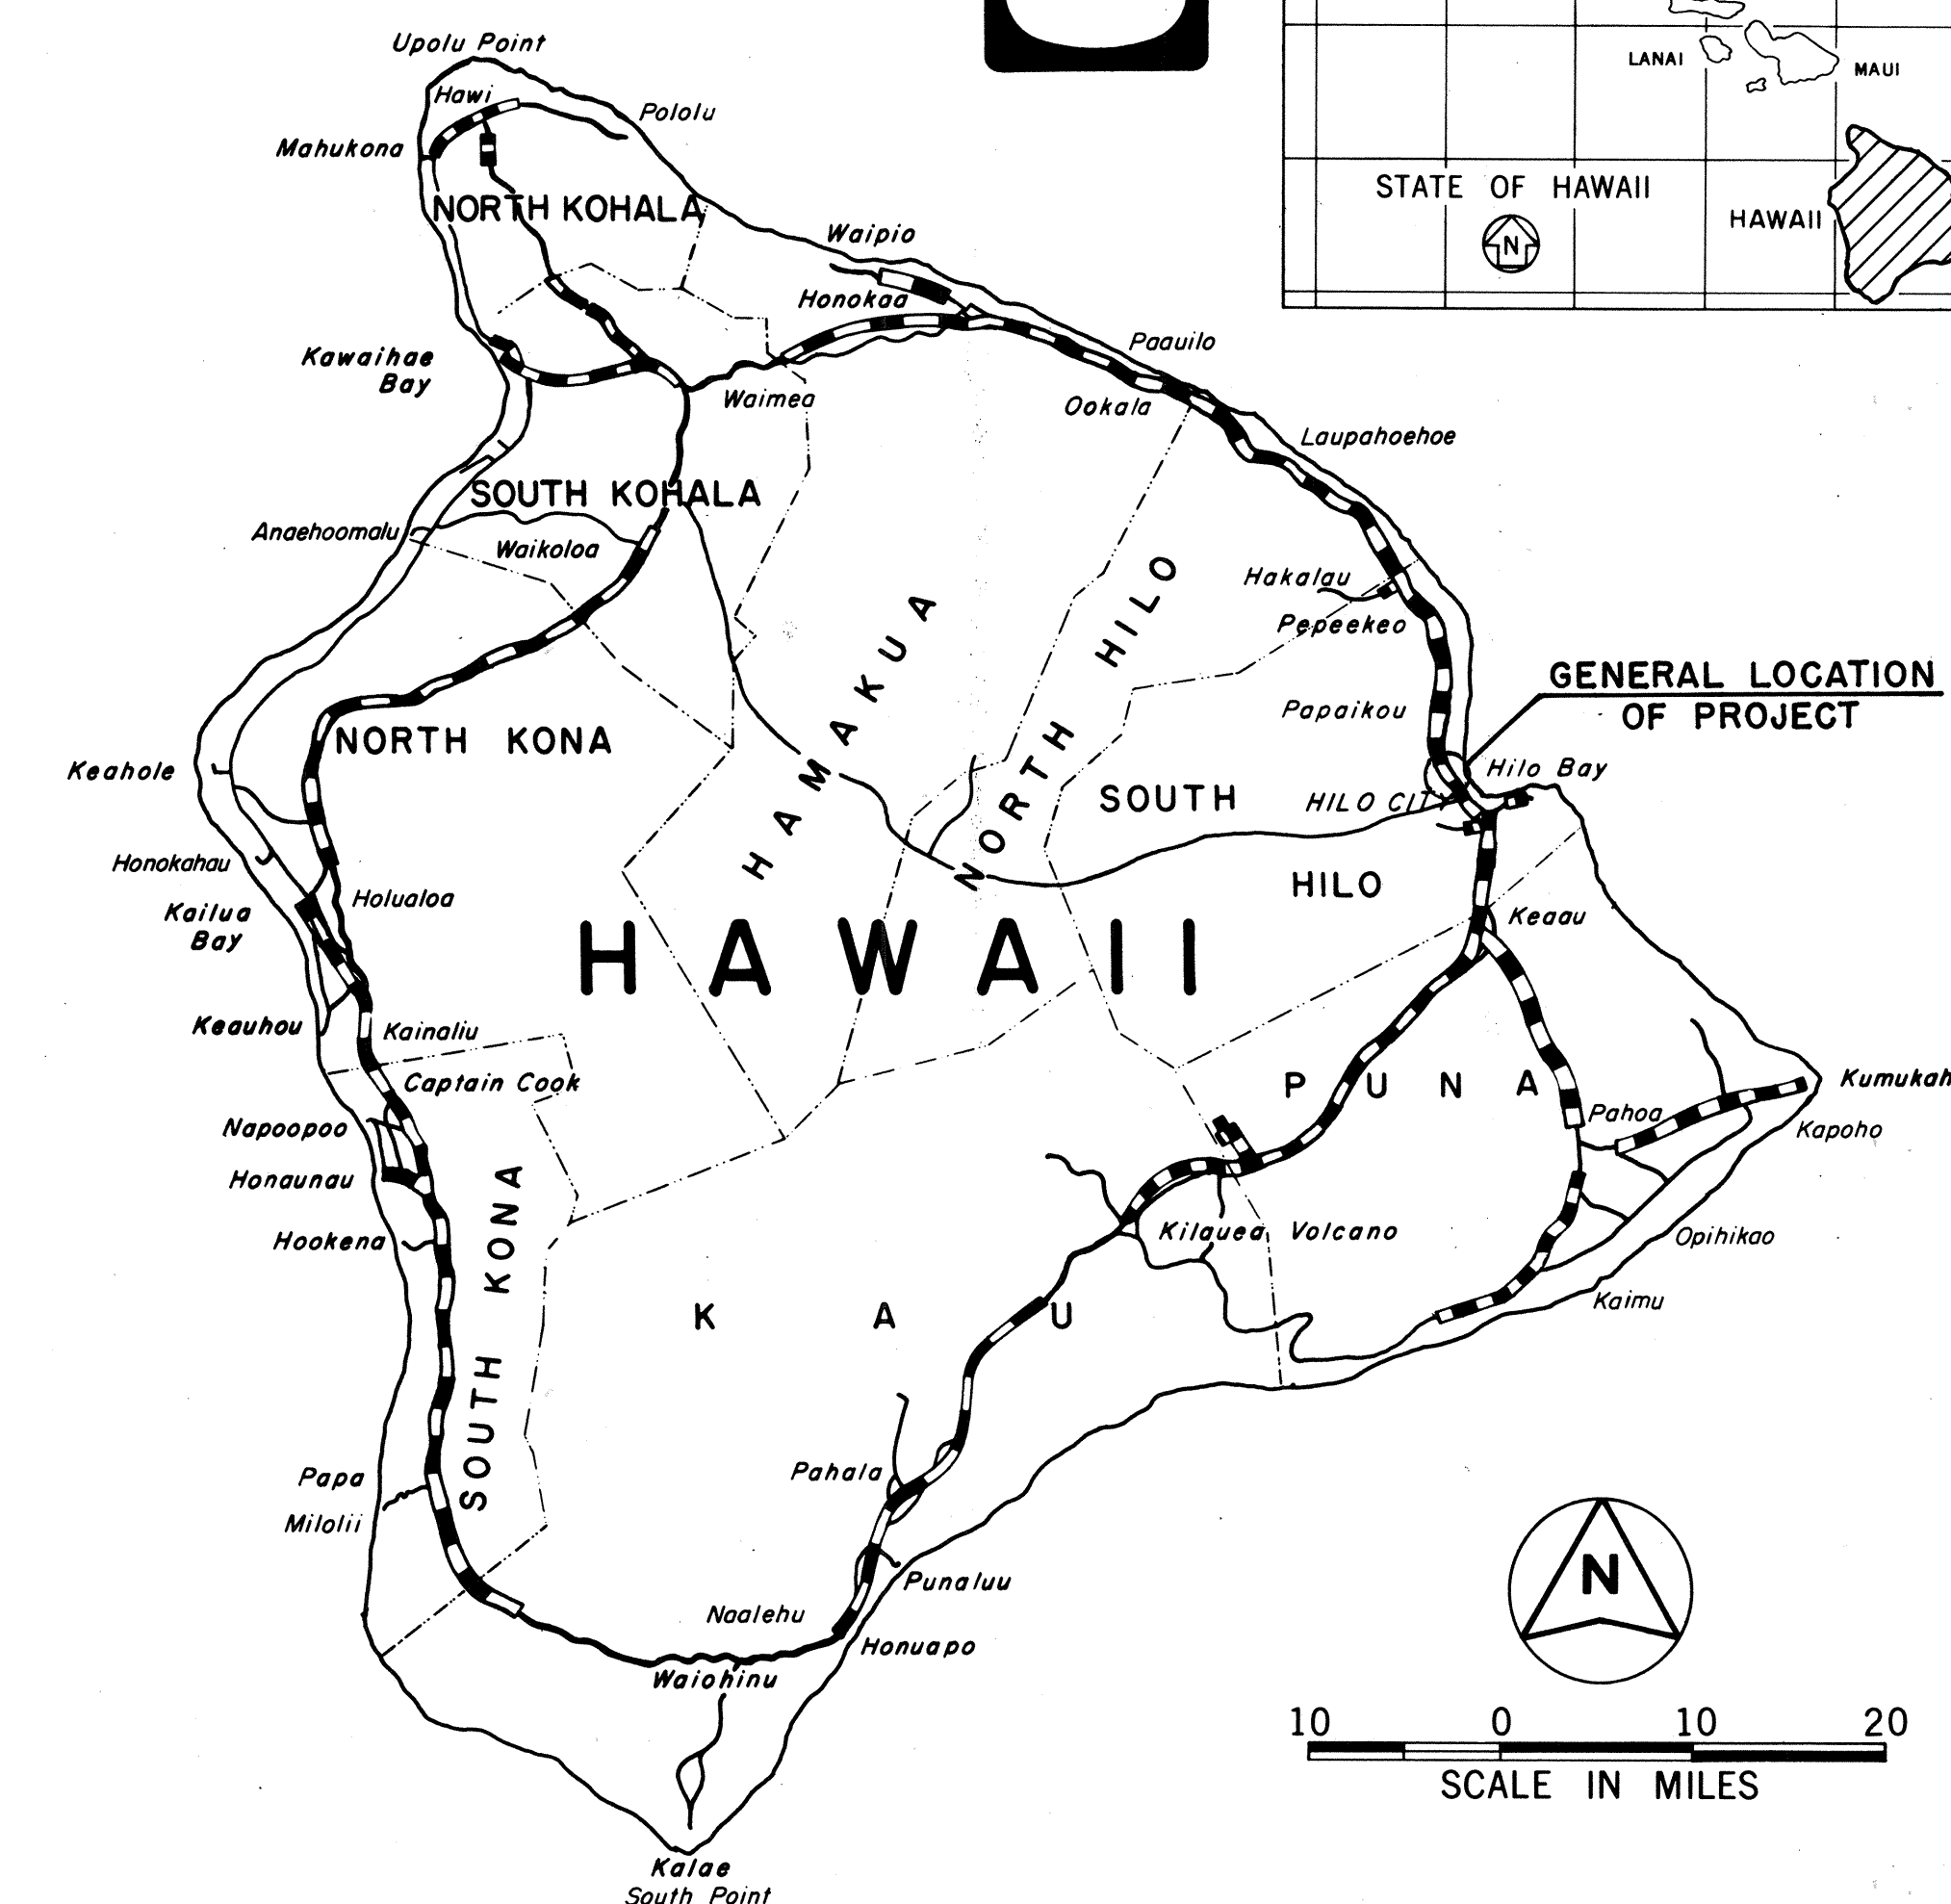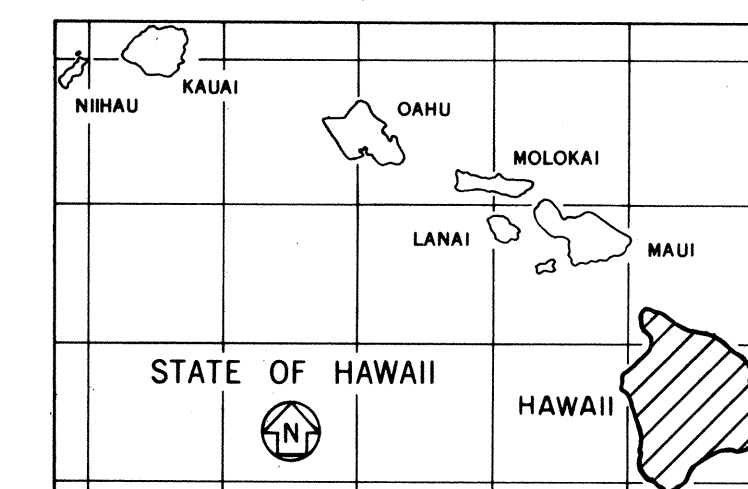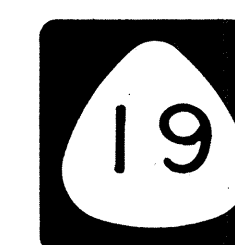


 FEDERAL AID PROJECTS PREVIOUSLY CONSTRUCTED  
OR UNDER CONSTRUCTION

CHANGES MADE DURING CONSTRUCTION HAVE  
BEEN INCORPORATED ON THESE PLANS EXCEPT  
CHANGES IN THE ORIGINAL THEORETICAL  
QUANTITIES. FOR ACTUAL QUANTITIES, REFER TO  
PROJECT LEDGER AND/OR COMPUTATION BOOK.

*Charles S. Nyala*  
RESIDENT ENGINEER

6/12/88  
DATE

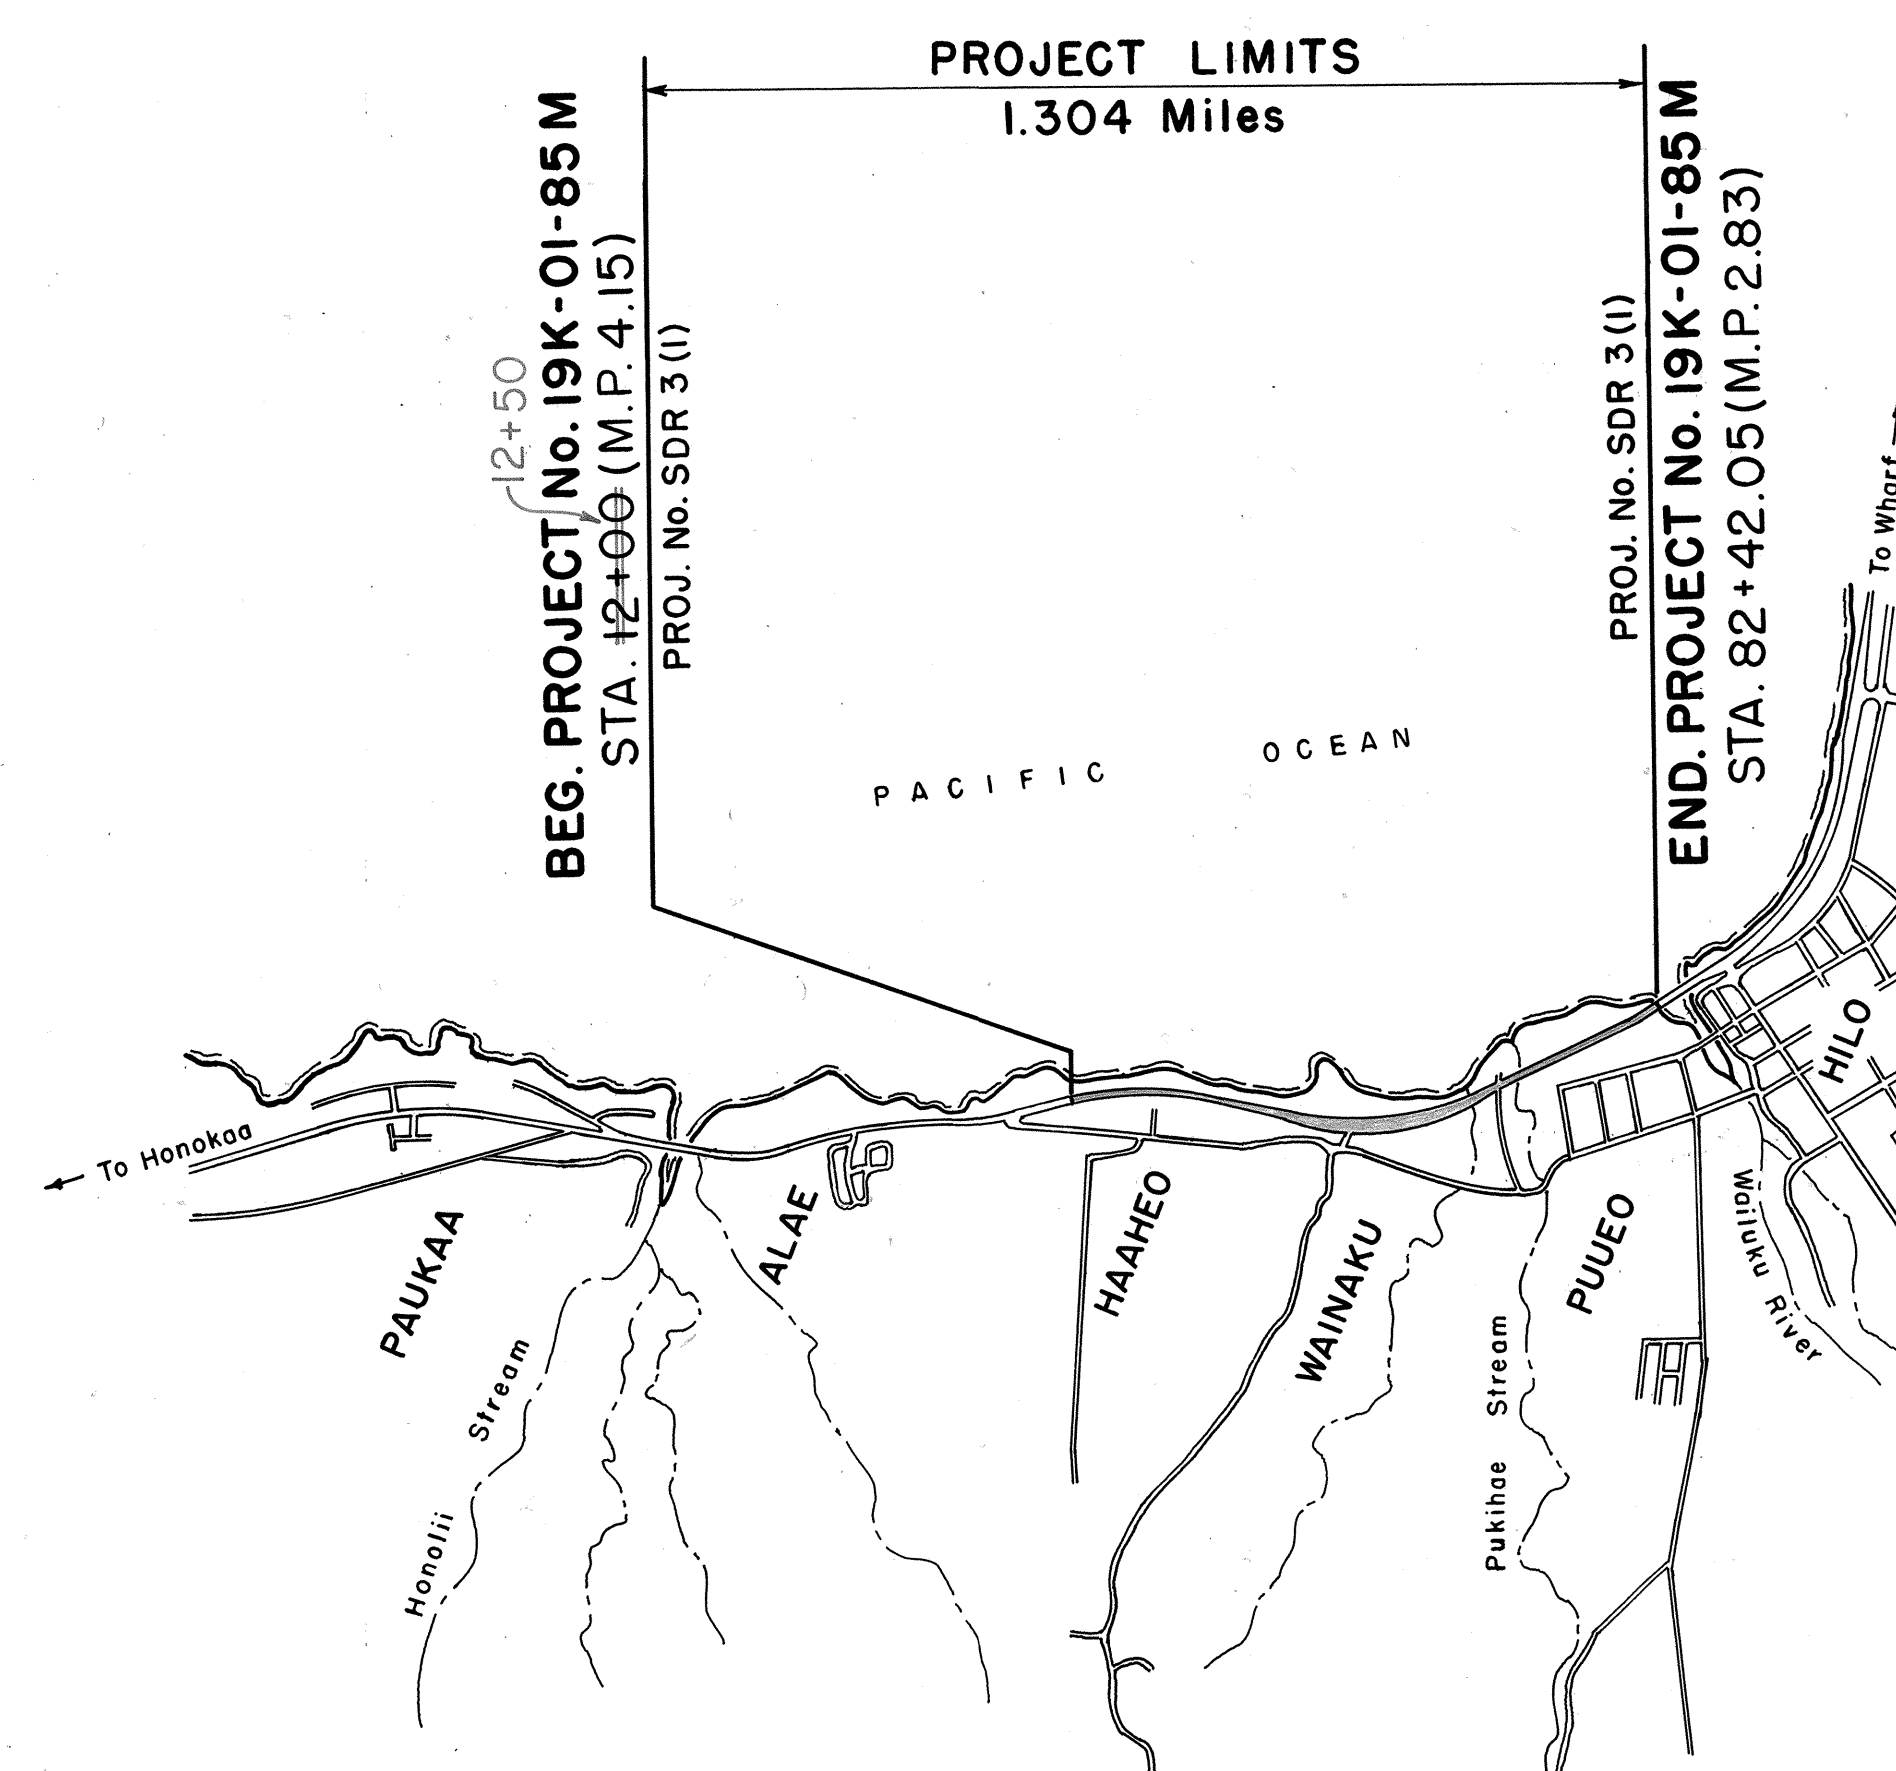

## LAYOUT OF PROJECT

SCALE: 1" = 2000

|  |                                 |
|--|---------------------------------|
| DEPARTMENT OF TRANSPORTATION<br>STATE OF HAWAII                |                                 |
| APPROVED:  |                                 |
| <i>Charles D. Brown</i><br>for _____<br>DIR. OF TRANSPORTATION | <i>5/16/85</i><br>_____<br>DATE |

|                 |               |          |           |
|-----------------|---------------|----------|-----------|
| HAWAII DISTRICT | A. YAMAGUCHI  | 548-4125 | MAY, 1985 |
| DESIGNED BY     | P. S. & E. BY | PHONE    | DATE      |